

京都市岩倉長谷地区土地区画整理事業

画地出来形確認測量図

1 / 2

1 街区～30 街区


平成20年11月28日現在

京都市岩倉長谷土地区画整理組合

第一測量設計株式会社

京都市岩倉長谷地区土地区画整理事業

一般図

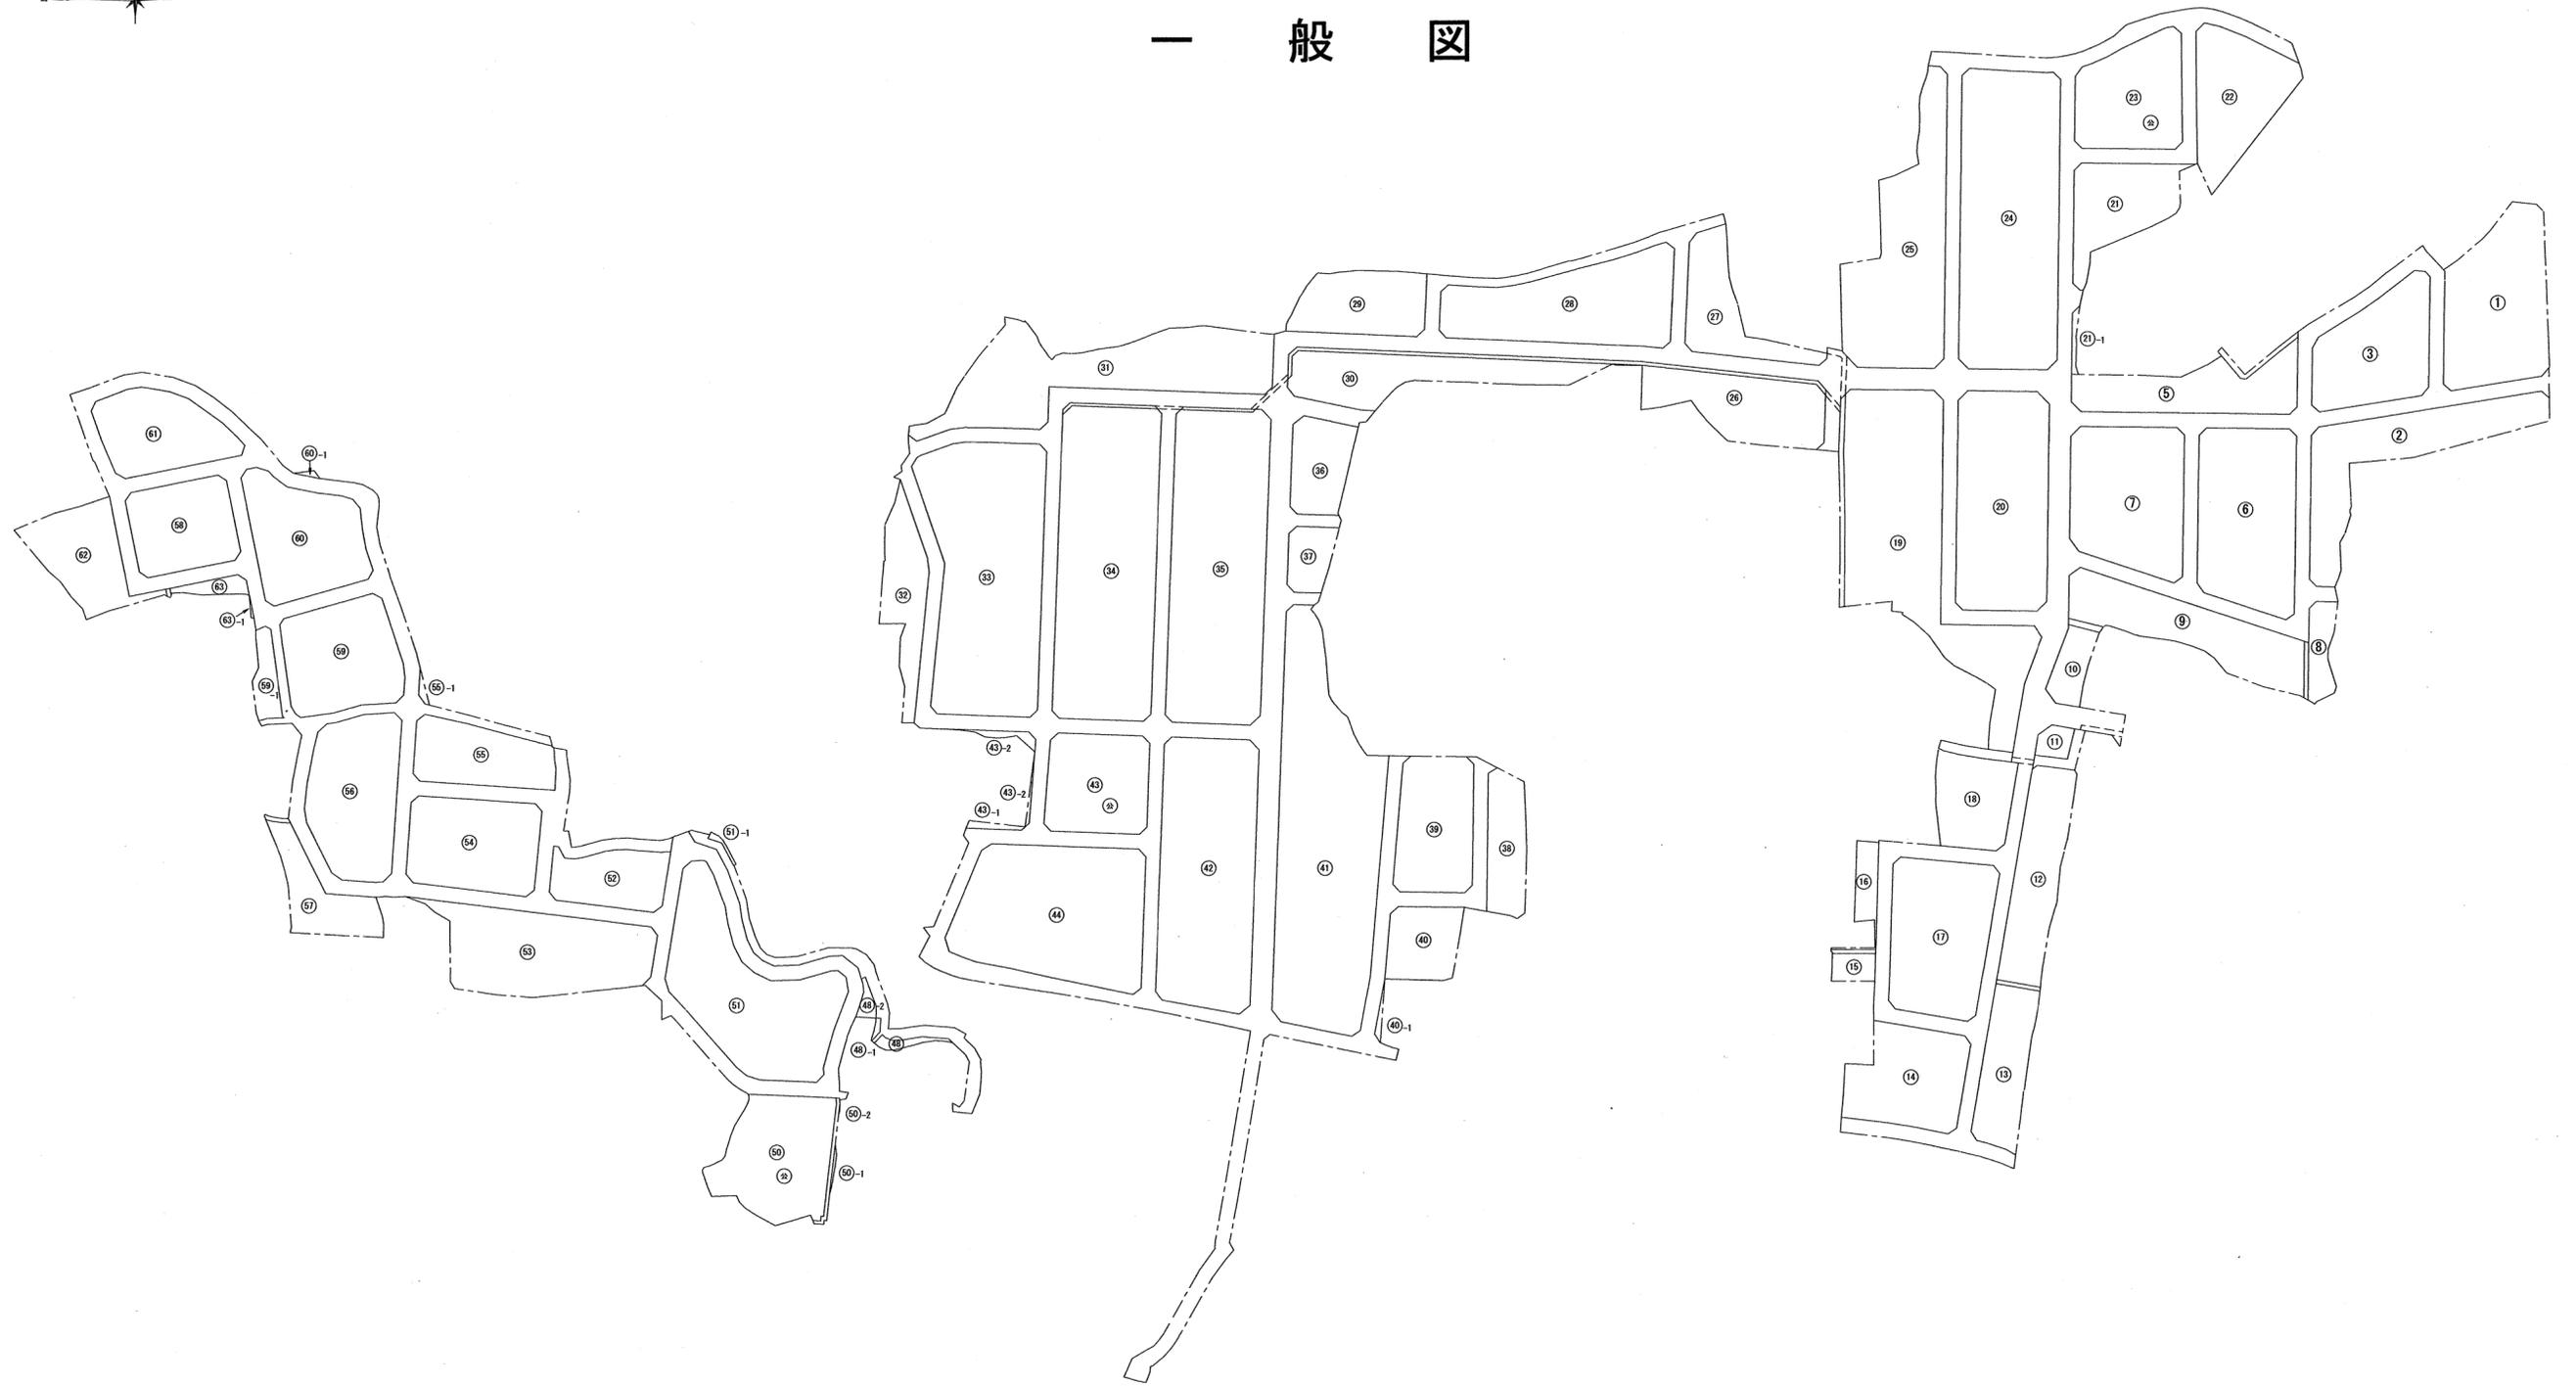



図面の種類	画地出来形確認測量図		
街区名	1	縮尺	1/250
町名	岩倉長谷町		
京都市岩倉長谷土地区画整理組合			

1959

地番 保一ノ一			
NO	X	Y	辺長
1010	-102484.867	-18877.958	
1009	-102488.078	-18880.734	4.244
4314	-102496.818	-18879.415	8.838
4330	-102496.312	-18861.186	18.236
4352	-102485.219	-18861.496	11.097
1011	-102485.188	-18862.968	1.472
1010	-102484.867	-18877.958	14.993
面積	214.0555550		
地積	214.05 m ²		

1960

地番 保一ノ二			
NO	X	Y	辺長
4352	-102485.219	-18861.496	
4330	-102496.312	-18861.186	11.097
4331	-102503.546	-18860.988	7.236
4334	-102506.252	-18860.921	2.706
4451	-102506.036	-18853.159	7.765
4452	-102506.029	-18852.407	0.752
4351	-102485.399	-18852.996	20.638
4352	-102485.219	-18861.496	8.501
面積	177.0756020		
地積	177.07 m ²		

1961

地番 保一ノ三			
NO	X	Y	辺長
4351	-102485.399	-18852.996	
4452	-102506.029	-18852.407	20.638
4453	-102505.819	-18845.420	6.990
4454	-102505.774	-18843.921	1.499
4335	-102485.585	-18844.482	20.196
1012	-102485.506	-18847.966	3.484
4351	-102485.399	-18852.996	5.031
面積	173.5126910		
地積	173.51 m ²		

1962

地番 保一ノ四			
NO	X	Y	辺長
4335	-102485.585	-18844.482	
4454	-102505.774	-18843.921	20.196
4353	-102505.609	-18837.676	6.247
4340	-102505.536	-18834.935	2.741
4336	-102485.789	-18835.475	19.754
4335	-102485.585	-18844.482	9.009
面積	179.6532805		
地積	179.65 m ²		

1963

地番 保一ノ五			
NO	X	Y	辺長
4336	-102485.789	-18835.475	
4340	-102505.536	-18834.935	19.754
4341	-102505.398	-18829.920	5.016
4342	-102505.193	-18822.693	7.229
4348	-102504.991	-18815.485	7.210
4347	-102504.975	-18814.999	0.486
4346	-102504.585	-18815.480	0.619
4350	-102501.222	-18819.029	4.889
4345	-102490.966	-18827.574	13.349
4337	-102485.373	-18831.392	6.771
1021	-102485.869	-18831.940	0.739
4336	-102485.789	-18835.475	3.535
面積	226.3863020		
地積	226.38 m ²		

1964

地番 長谷町一五ノ一〇			
NO	X	Y	辺長
4348	-102504.991	-18815.485	
4358	-102526.359	-18814.912	21.375
4357	-102526.047	-18807.520	7.398
4356	-102523.591	-18804.956	3.550
4355	-102517.318	-18804.369	6.300
4354	-102513.754	-18803.896	3.595
4347	-102504.975	-18814.999	14.154
4348	-102504.991	-18815.485	0.486
面積	179.2698050		
地積	179.26 m ²		

1965

地番 長谷町一五ノ九			
NO	X	Y	辺長
4342	-102505.193	-18822.693	
4359	-102526.663	-18822.125	21.477
4358	-102526.359	-18814.912	7.219
4348	-102504.991	-18815.485	21.375
4342	-102505.193	-18822.693	7.210
面積	154.5860360		
地積	154.58 m ²		

1966

地番 長谷町一五ノ八			
NO	X	Y	辺長
4341	-102505.398	-18829.920	
4360	-102526.967	-18829.336	21.576
4359	-102526.663	-18822.125	7.217
4342	-102505.193	-18822.693	21.477
4341	-102505.398	-18829.920	7.229
面積	155.4958625		
地積	155.49 m ²		

1967

地番 長谷町一五ノ七			
NO	X	Y	辺長
4353	-102505.609	-18837.676	
4323	-102527.294	-18837.083	21.693
4360	-102526.967	-18829.336	7.753
4341	-102505.398	-18829.920	21.576
4340	-102505.536	-18834.935	5.016
4353	-102505.609	-18837.676	2.741
面積	167.7939155		
地積	167.79 m ²		

1968

地番 長谷町一五ノ六			
NO	X	Y	辺長
4453	-102505.819	-18845.420	
4320	-102527.608	-18844.826	21.797
4322	-102527.348	-18838.364	6.467
4323	-102527.294	-18837.083	1.282
4353	-102505.609	-18837.676	21.693
4454	-102505.774	-18843.921	6.247
4453	-102505.819	-18845.420	1.499
面積	168.5007455		
地積	168.50 m ²		

1969

地番 長谷町一五ノ五			
NO	X	Y	辺長
4451	-102506.036	-18853.159	
4319	-102527.885	-18852.578	21.856
4321	-102527.784	-18849.220	3.359
4320	-102527.608	-18844.826	4.397
4453	-102505.819	-18845.420	21.797
4452	-102506.029	-18852.407	6.990
4451	-102506.036	-18853.159	0.752
面積	169.1632785		
地積	169.16 m ²		

1970

地番 長谷町一五ノ一			
NO	X	Y	辺長
4334	-102506.252	-18860.921	
4333	-102511.204	-18860.787	4.953
4318	-102528.117	-18860.331	16.919
4319	-102527.885	-18852.578	7.756
4451	-102506.036	-18853.159	21.856
4334	-102506.252	-18860.921	7.765
面積	169.6827145		
地積	169.68 m ²		

1971

地番 長谷町一四ノ五			
NO	X	Y	辺長
4332	-102511.414	-18868.302	
4317	-102528.192	-18867.835	16.784
1001	-102528.165	-18861.916	5.919
4318	-102528.117	-18860.331	1.585
4333	-102511.204	-18860.787	16.919
4332	-102511.414	-18868.302	7.517
面積	126.6877045		
地積	126.68 m ²		

1972

地番 長谷町一四ノ六			
NO	X	Y	辺長
4316	-102511.671	-18877.173	
1005	-102525.270	-18875.115	13.753
1002	-102528.209	-18871.700	4.505
4317	-102528.192	-18867.835	3.865
4332	-102511.414	-18868.302	16.784
4316	-102511.671	-18877.173	8.874
面積	126.6810955		
地積	126.68 m ²		

1973

地番 長谷町一四ノ四			
NO	X	Y	辺長
4315	-102504.053	-18878.324	
1006	-102506.646	-18877.933	2.622
4316	-102511.671	-18877.173	5.082
4332	-102511.414	-18868.302	8.874
4333	-102511.204	-18860.787	7.517
4334	-102506.252	-18860.921	4.953
4331	-102503.546	-18860.988	2.706
4315	-102504.053	-18878.324	17.343
面積	129.0668500		
地積	129.06 m ²		

1974

地番 長谷町一四ノ三			
NO	X	Y	辺長
4314	-102496.818	-18879.415	
4315	-102504.053	-18878.324	7.316
4331	-102503.546	-18860.988	17.343
4330	-102496.312	-18861.186	7.236
4314	-102496.818	-18879.415	18.236
面積	128.9739355		
地積	128.97 m ²		

図面の種類	画地出来形確認測量図		
街区名	1	求積表	
町名	岩倉長谷町		
京都市岩倉長谷土地区画整理組合			

1948

地番 保二ノ二			
NO	X	Y	辺長
1065	-102429.278	-18957.063	
1071	-102432.229	-18960.117	4.246
1070	-102439.777	-18960.337	7.551
4062	-102441.214	-18957.070	3.569
4061	-102442.261	-18953.429	3.788
4060	-102441.937	-18942.218	11.215
4058	-102443.912	-18938.742	3.997
4059	-102434.799	-18938.550	9.115
4052	-102429.663	-18938.435	5.137
1065	-102429.278	-18957.063	18.631
面積	265.8869850		
地積	265.88 m ²		

1949

地番 長谷町一五ノ三			
NO	X	Y	辺長
4052	-102429.663	-18938.435	
4059	-102434.799	-18938.550	5.137
4246	-102434.914	-18933.428	5.123
4053	-102429.771	-18933.311	5.144
1072	-102429.681	-18937.577	4.266
4052	-102429.663	-18938.435	0.858
面積	26.3428085		
地積	26.34 m ²		

1950

地番 長谷町二〇ノ一			
NO	X	Y	辺長
4053	-102429.771	-18933.311	
4246	-102434.914	-18933.428	5.144
4059	-102434.799	-18938.550	5.123
4058	-102443.912	-18938.742	9.115
4057	-102444.118	-18938.380	0.416
4050	-102446.491	-18931.063	7.692
4049	-102446.077	-18929.276	1.834
4048	-102446.697	-18927.656	1.734
4047	-102446.535	-18924.225	3.434
4054	-102429.969	-18923.870	16.569
4053	-102429.771	-18933.311	9.443
面積	206.9238690		
地積	206.92 m ²		

1951

地番 長谷町一六ノ一, 長谷町一七ノ一 長谷町一九ノ二			
NO	X	Y	辺長
4054	-102429.969	-18923.870	
4047	-102446.535	-18924.225	16.569
4045	-102446.165	-18916.391	7.842
4056	-102430.133	-18916.050	16.035
1051	-102430.091	-18918.082	2.032
4054	-102429.969	-18923.870	5.789
面積	127.5340250		
地積	127.53 m ²		

1952

地番 長谷町二一ノ三			
NO	X	Y	辺長
4056	-102430.133	-18916.050	
4045	-102446.165	-18916.391	16.035
4044	-102446.100	-18915.017	1.375
4043	-102446.076	-18909.904	5.113
4039	-102445.975	-18893.148	16.756
1053	-102433.502	-18895.013	12.611
1052	-102430.492	-18898.473	4.586
4056	-102430.133	-18916.050	17.580
面積	339.6037330		
地積	339.60 m ²		


1953

地番 保二ノ一			
NO	X	Y	辺長
4043	-102446.076	-18909.904	
4041	-102455.828	-18909.131	9.782
4040	-102455.723	-18891.690	17.441
4039	-102445.975	-18893.148	9.856
4043	-102446.076	-18909.904	16.756
面積	166.8252715		
地積	166.82 m ²		

1954

地番 長谷町一四ノ一			
NO	X	Y	辺長
4041	-102455.828	-18909.131	
4042	-102472.137	-18907.837	16.360
1004	-102528.253	-18893.397	57.944
1003	-102528.238	-18884.038	9.359
1008	-102525.000	-18881.235	4.282
1007	-102507.526	-18883.867	17.671
1020	-102488.969	-18886.672	18.767
1019	-102476.708	-18888.532	12.401
1018	-102456.927	-18891.510	20.003
4040	-102455.723	-18891.690	1.217
4041	-102455.828	-18909.131	17.441
面積	1167.2022725		
地積	1167.20 m ²		

図面の種類	画地出来形確認測量図	
街区名	2	求積表
町名	岩倉長谷町	
京都市岩倉長谷土地区画整理組合		

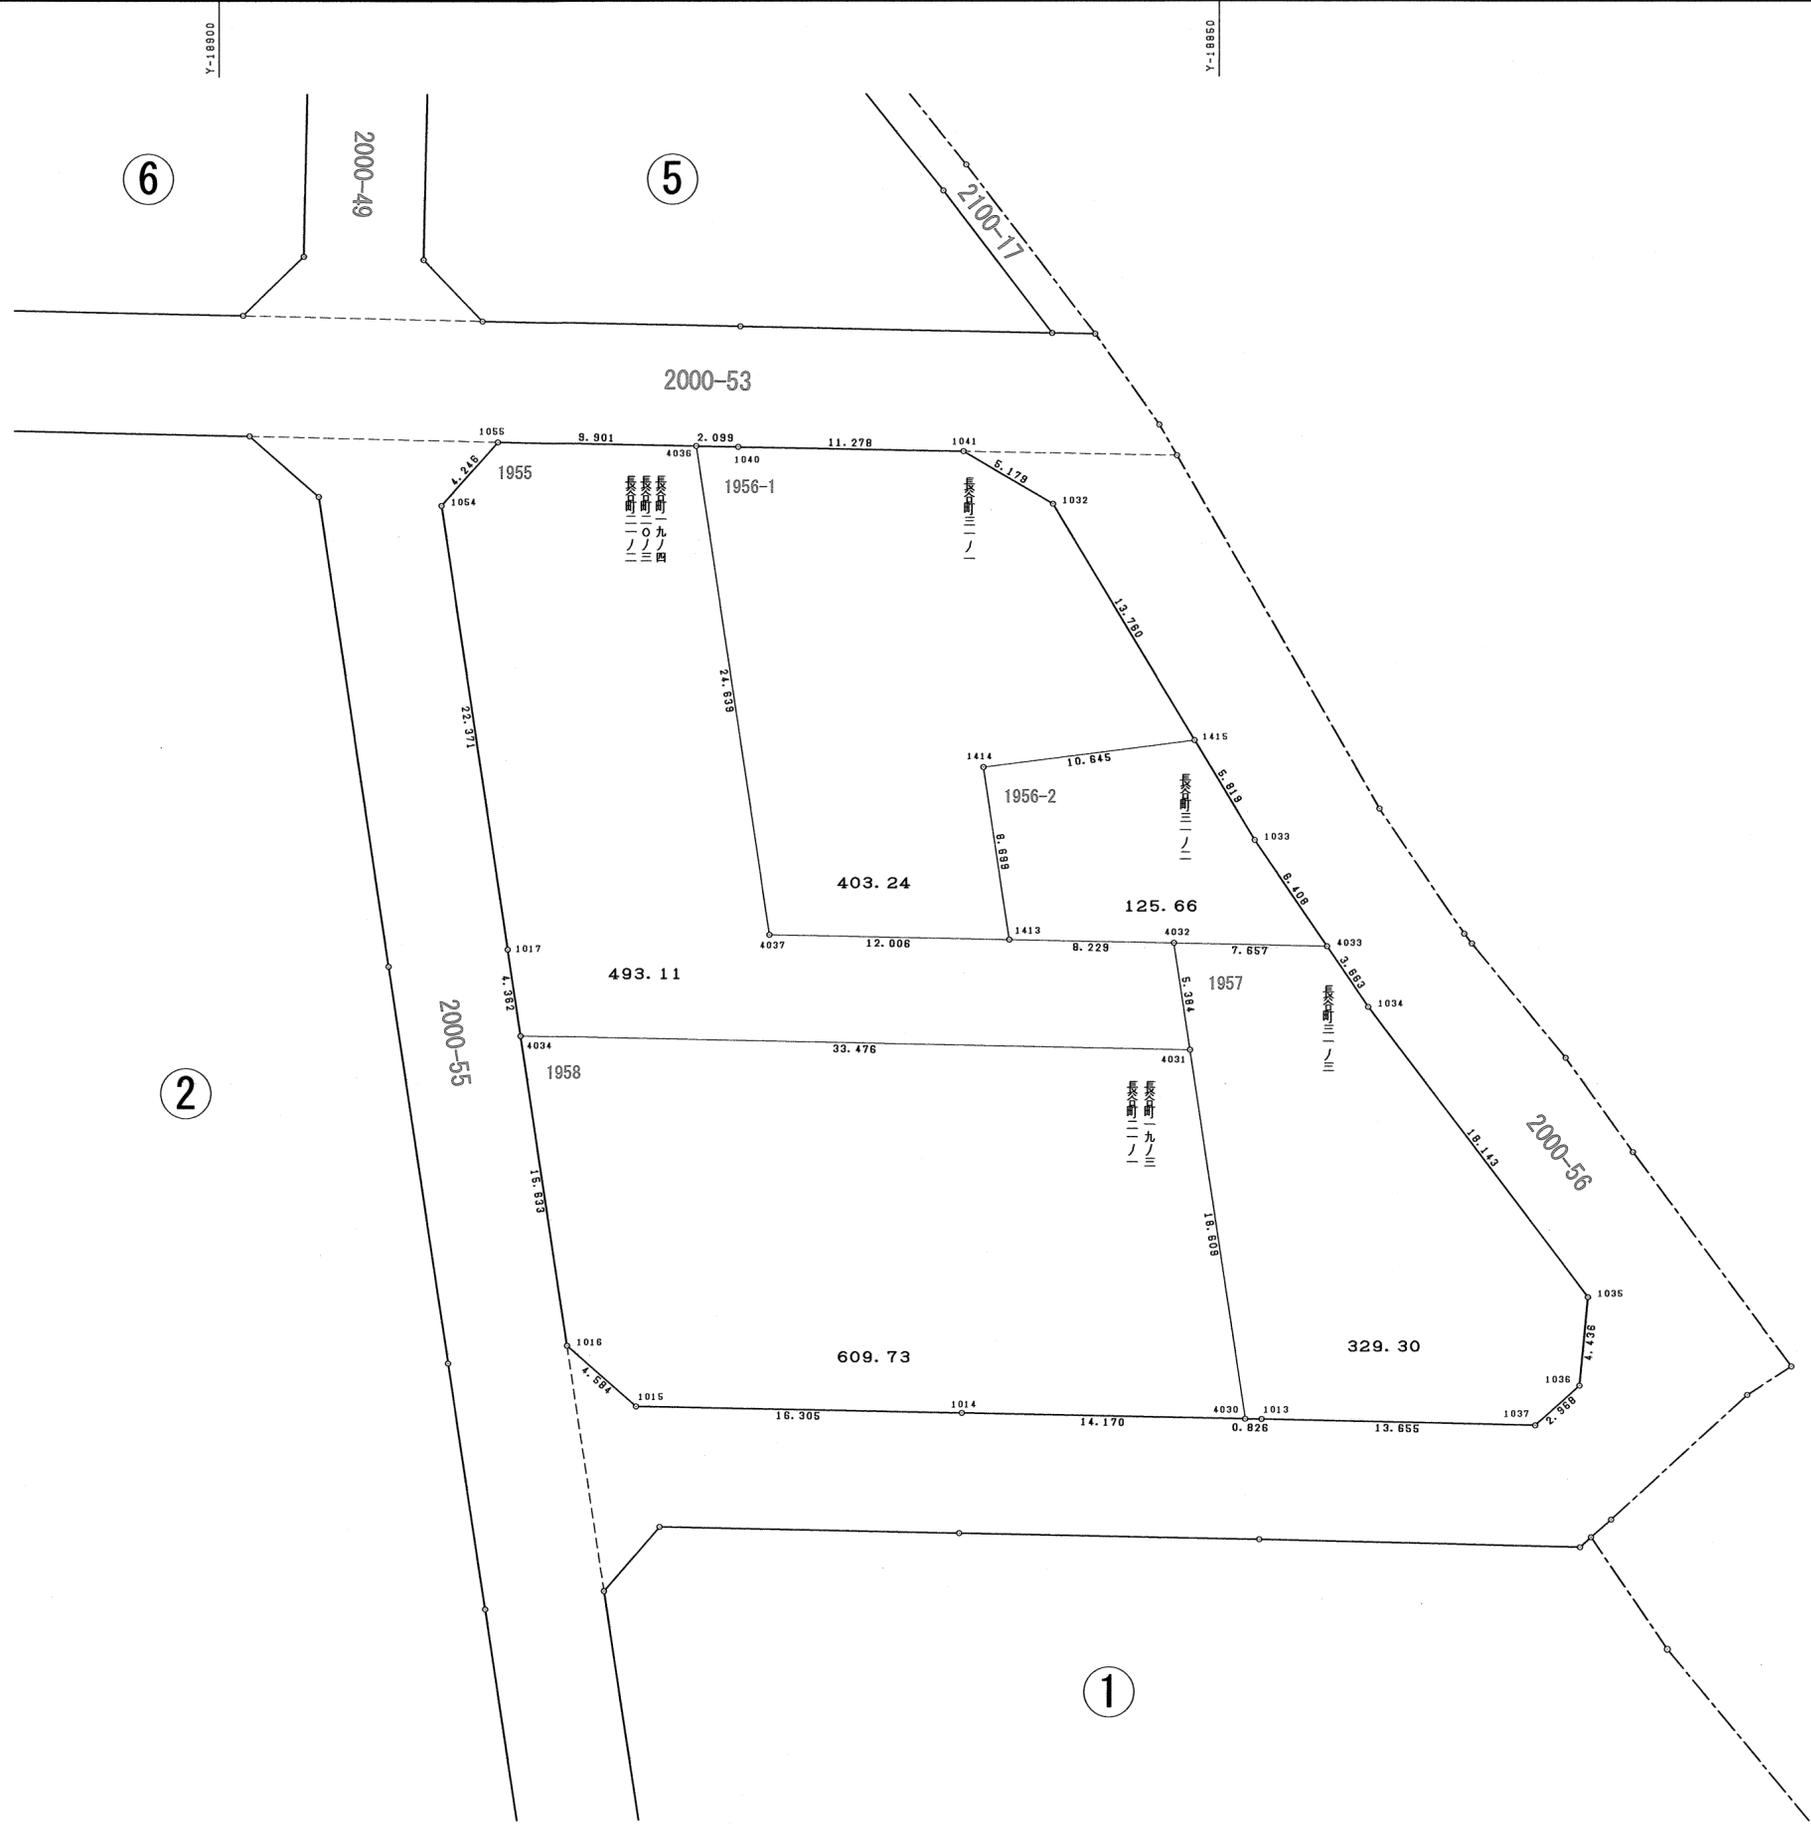

図面の種類	画地出来形確認測量図		
街区名	3	縮尺	1/250
町名	岩倉長谷町		
京都市岩倉長谷土地区画整理組合			

1955

地番 長谷町一九ノ四, 長谷町二〇ノ三 長谷町二一ノ二			
NO	X	Y	辺長
1054	-102433.937	-18888.875	
1017	-102456.061	-18885.557	22.371
4034	-102460.375	-18884.909	4.362
4031	-102461.087	-18851.440	33.476
4032	-102455.763	-18852.242	5.384
1413	-102455.593	-18860.470	8.229
4037	-102455.345	-18872.474	12.006
4036	-102430.981	-18876.145	24.639
1055	-102430.772	-18886.044	9.901
1054	-102433.937	-18888.875	4.246
面積	493.1190390		
地積	493.11 m ²		

1956-1

地番 長谷町三一ノ一			
NO	X	Y	辺長
4036	-102430.981	-18876.145	
4037	-102455.345	-18872.474	24.639
1413	-102455.593	-18860.470	12.006
1414	-102446.991	-18861.767	8.699
1415	-102445.655	-18851.206	10.645
1032	-102433.866	-18858.304	13.760
1041	-102431.243	-18862.770	5.179
1040	-102431.025	-18874.046	11.278
4036	-102430.981	-18876.145	2.099
面積	403.2420210		
地積	403.24 m ²		

1956-2

地番 長谷町三一ノ二			
NO	X	Y	辺長
1415	-102445.655	-18851.206	
1414	-102446.991	-18861.767	10.645
1413	-102455.593	-18860.470	8.699
4032	-102455.763	-18852.242	8.229
4033	-102455.930	-18844.586	7.657
1033	-102450.641	-18848.204	6.408
1415	-102445.655	-18851.206	5.819
面積	125.6606740		
地積	125.66 m ²		


1957

地番 長谷町三一ノ三			
NO	X	Y	辺長
4032	-102455.763	-18852.242	
4031	-102461.087	-18851.440	5.384
4030	-102479.489	-18848.668	18.609
1013	-102479.507	-18847.842	0.826
1037	-102479.798	-18834.190	13.655
1036	-102477.820	-18831.976	2.968
1035	-102473.404	-18831.546	4.436
1034	-102458.954	-18842.518	18.143
4033	-102455.930	-18844.586	3.663
4032	-102455.763	-18852.242	7.657
面積	329.3059020		
地積	329.30 m ²		

1958

地番 長谷町一九ノ三, 長谷町二一ノ一			
NO	X	Y	辺長
4034	-102460.375	-18884.909	
1016	-102475.835	-18882.588	15.633
1015	-102478.853	-18879.137	4.584
1014	-102479.189	-18862.835	16.305
4030	-102479.489	-18848.668	14.170
4031	-102461.087	-18851.440	18.609
4034	-102460.375	-18884.909	33.476
面積	609.7376290		
地積	609.73 m ²		

図面の種類	画地出来形確認測量図		
街区名	3	求積表	
町名	岩倉長谷町		
京都市岩倉長谷土地区画整理組合			

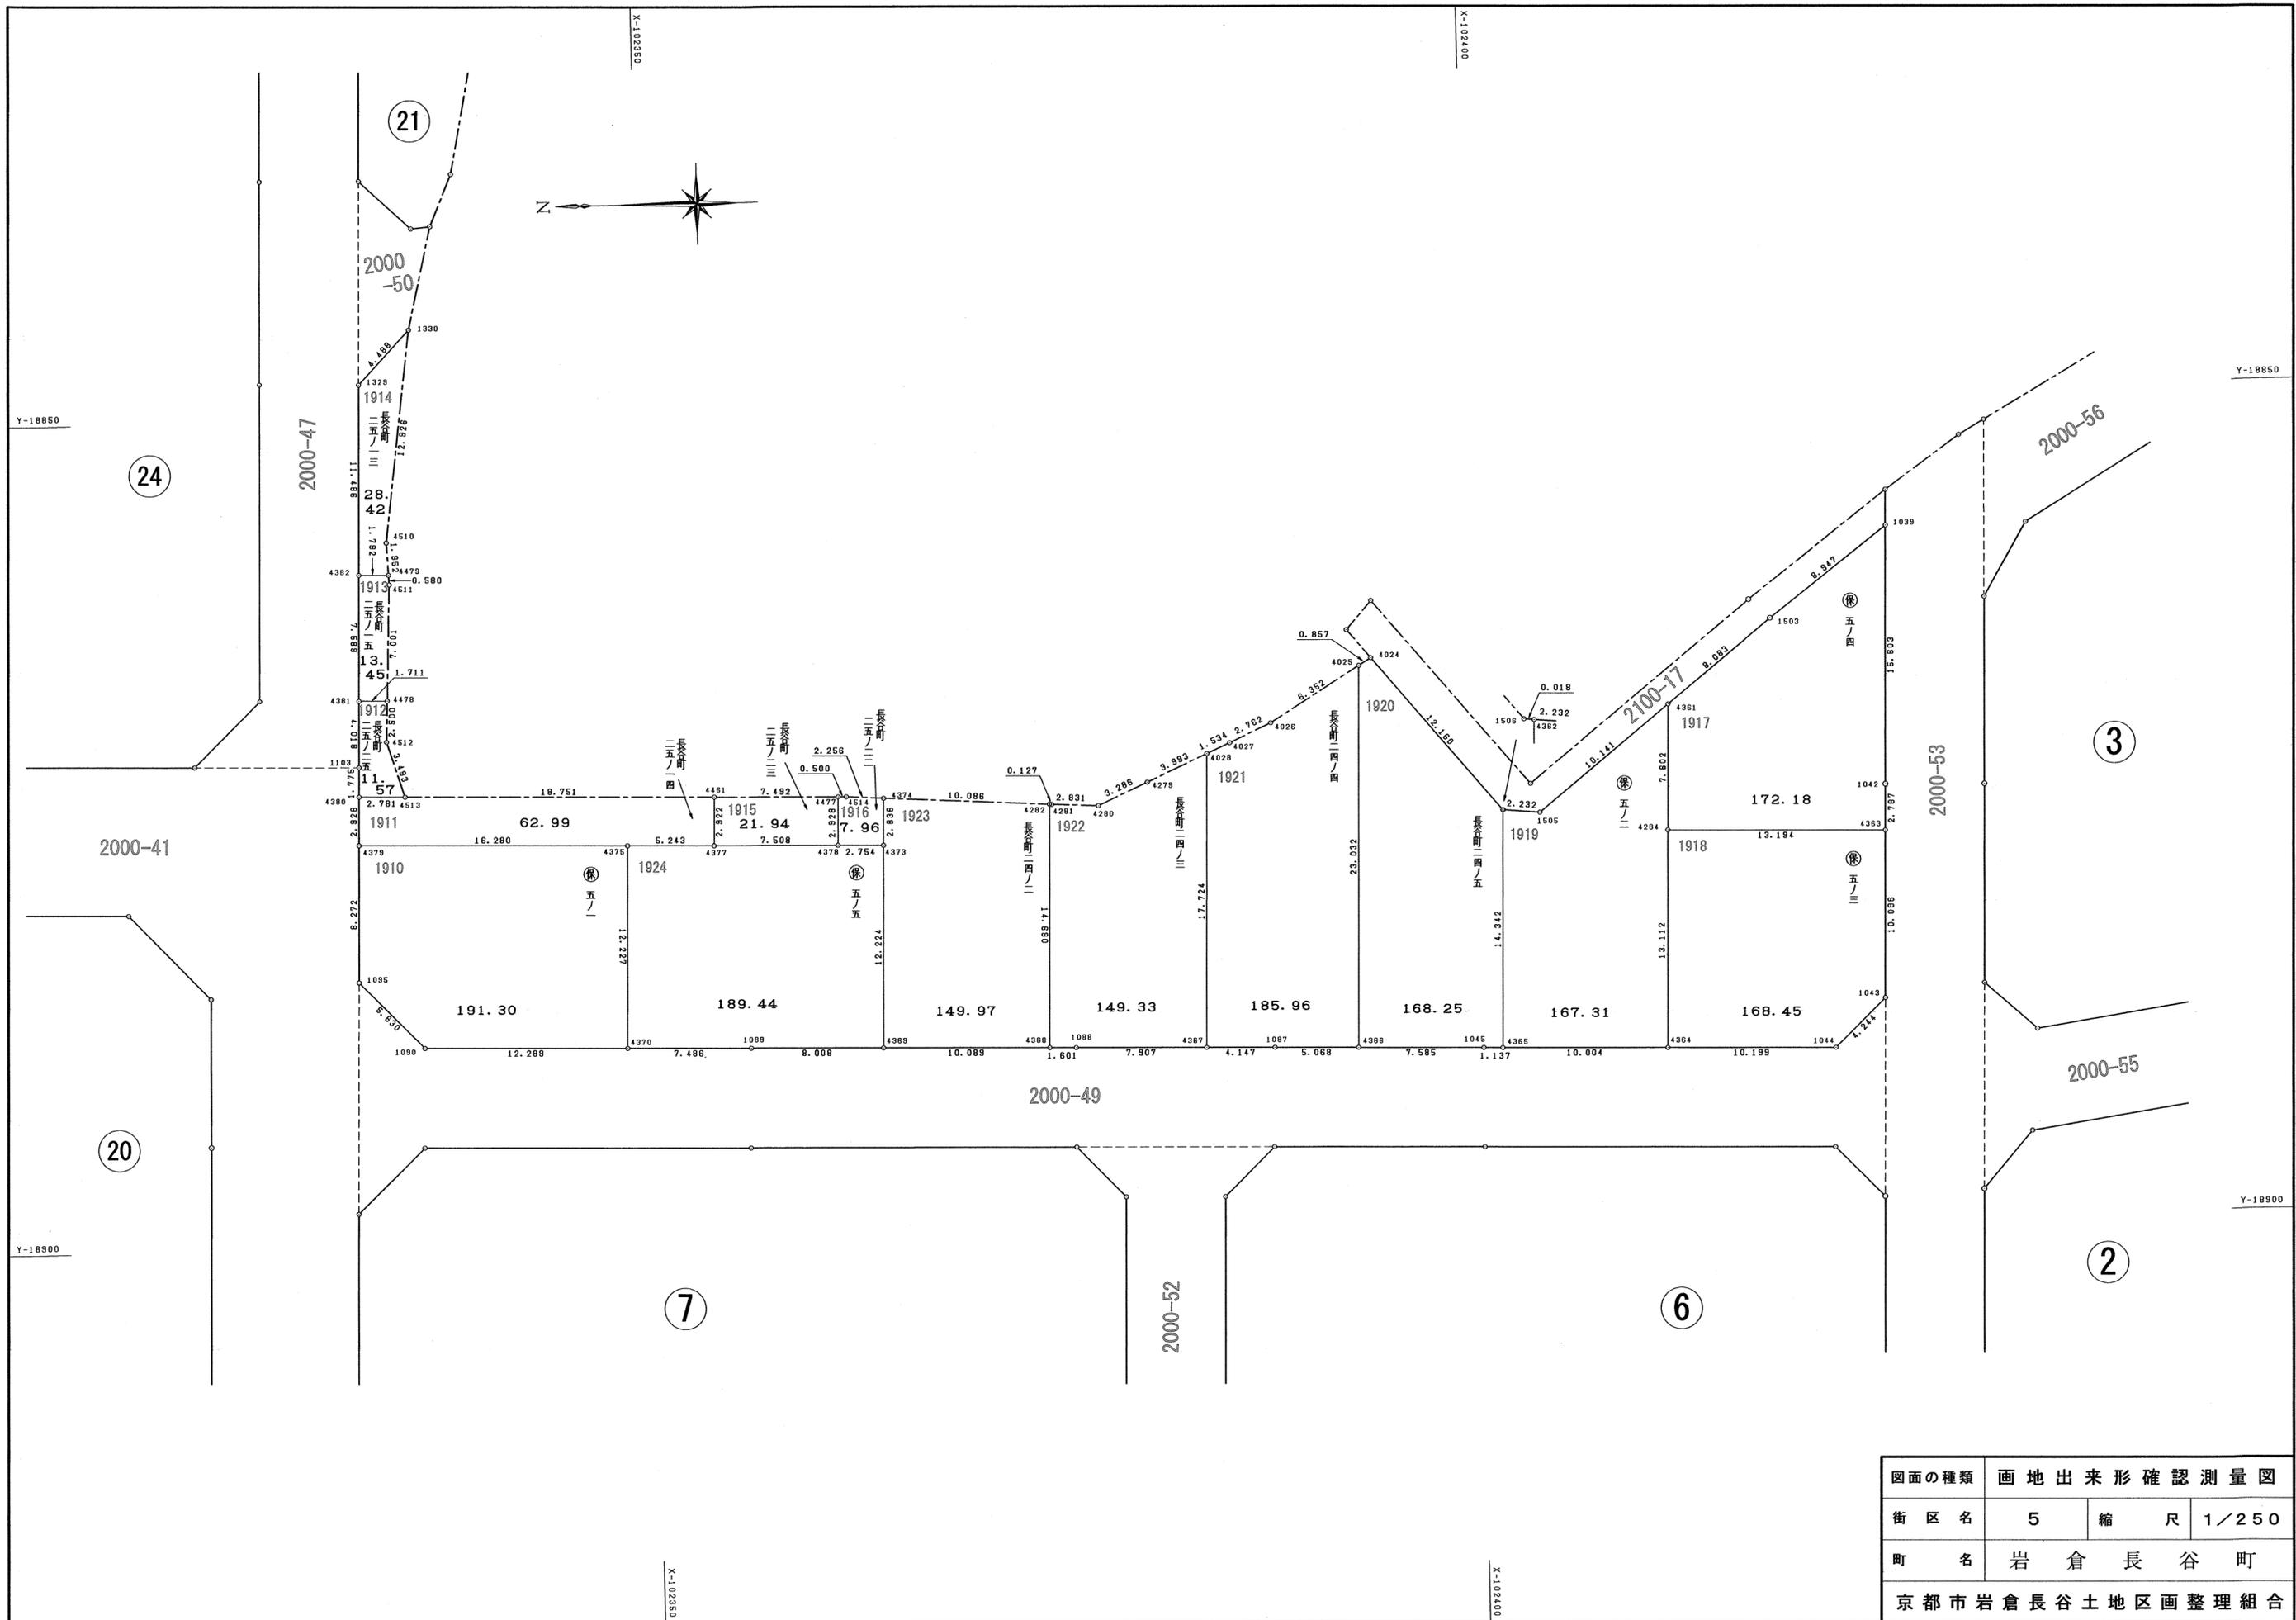

図面の種類	画地出来形確認測量図		
街区名	5	縮尺	1/250
町名	岩倉長谷町		
京都市岩倉長谷土地区画整理組合			

1910

地番 保五ノ一			
NO	X	Y	辺長
1095	-102332.278	-18883.908	
1090	-102336.191	-18887.957	5.630
4370	-102348.478	-18888.207	12.289
4375	-102348.736	-18875.982	12.227
4379	-102332.459	-18875.637	16.280
1095	-102332.278	-18883.908	8.272
面積	191.3077335		
地積	191.30		

1911

地番 長谷町二五ノ一四			
NO	X	Y	辺長
4379	-102332.459	-18875.637	
4375	-102348.736	-18875.982	16.280
4377	-102353.978	-18876.092	5.243
4461	-102354.051	-18873.170	2.922
4513	-102335.304	-18872.768	18.751
4380	-102332.523	-18872.711	2.781
4379	-102332.459	-18875.637	2.926
面積	62.9997200		
地積	62.99		

1912

地番 長谷町二五ノ二五			
NO	X	Y	辺長
4380	-102332.523	-18872.711	
4513	-102335.304	-18872.768	2.781
4512	-102334.262	-18869.434	3.493
4478	-102334.357	-18866.935	2.500
4381	-102332.646	-18866.918	1.711
1103	-102332.562	-18870.936	4.018
4380	-102332.523	-18872.711	1.775
面積	11.5766090		
地積	11.57		

1913

地番 長谷町二五ノ一五			
NO	X	Y	辺長
4381	-102332.646	-18866.918	
4478	-102334.357	-18866.935	1.711
4511	-102334.622	-18859.939	7.001
4479	-102334.586	-18859.359	0.580
4382	-102332.804	-18859.330	1.792
4381	-102332.646	-18866.918	7.589
面積	13.4522365		
地積	13.45		

1914

地番 長谷町二五ノ一三			
NO	X	Y	辺長
4382	-102332.804	-18859.330	
4479	-102334.586	-18859.359	1.792
4510	-102334.507	-18857.409	1.952
1330	-102336.126	-18844.584	12.926
1329	-102333.043	-18847.846	4.488
4382	-102332.804	-18859.330	11.486
面積	28.4241245		
地積	28.42		

1915

地番 長谷町二五ノ二三			
NO	X	Y	辺長
4377	-102353.978	-18876.092	
4378	-102361.485	-18876.259	7.508
4477	-102361.542	-18873.331	2.928
4461	-102354.051	-18873.170	7.492
4377	-102353.978	-18876.092	2.922
面積	21.9452350		
地積	21.94 m ²		

1916

地番 長谷町二五ノ二二			
NO	X	Y	辺長
4378	-102361.485	-18876.259	
4373	-102364.239	-18876.310	2.754
4374	-102364.295	-18873.474	2.836
4514	-102362.042	-18873.342	2.256
4477	-102361.542	-18873.331	0.500
4378	-102361.485	-18876.259	2.928
面積	7.9616760		
地積	7.96 m ²		

1917

地番 保五ノ四			
NO	X	Y	辺長
4284	-102411.775	-18876.445	
4363	-102424.966	-18876.730	13.194
1042	-102425.025	-18873.943	2.787
1039	-102425.358	-18858.343	15.603
1503	-102418.254	-18863.782	8.947
4361	-102411.952	-18868.845	8.083
4284	-102411.775	-18876.445	7.602
面積	172.1823430		
地積	172.18 m ²		

1918

地番 保五ノ三			
NO	X	Y	辺長
4364	-102411.501	-18889.555	
1044	-102421.698	-18889.771	10.199
1043	-102424.753	-18886.824	4.244
4363	-102424.966	-18876.730	10.096
4284	-102411.775	-18876.445	13.194
4364	-102411.501	-18889.555	13.112
面積	168.4532620		
地積	168.45 m ²		

1919

地番 保五ノ二			
NO	X	Y	辺長
4365	-102401.499	-18889.343	
4364	-102411.501	-18889.555	10.004
4284	-102411.775	-18876.445	13.112
4361	-102411.952	-18868.845	7.602
1505	-102404.046	-18875.196	10.141
4362	-102401.822	-18875.004	2.232
4365	-102401.499	-18889.343	14.342
面積	167.3105495		
地積	167.31 m ²		

1920

地番 長谷町二四ノ五			
NO	X	Y	辺長
4366	-102392.778	-18889.148	
1045	-102400.362	-18889.319	7.585
4365	-102401.499	-18889.343	1.137
4362	-102401.822	-18875.004	14.342
1506	-102401.804	-18875.002	0.018
4024	-102394.006	-18865.671	12.160
4025	-102393.276	-18866.121	0.857
4366	-102392.778	-18889.148	23.032
面積	168.2581095		
地積	168.25 m ²		

1921

地番 長谷町二四ノ四			
NO	X	Y	辺長
4367	-102383.564	-18888.947	
1087	-102387.711	-18889.033	4.147
4366	-102392.778	-18889.148	5.068
4025	-102393.276	-18866.121	23.032
4026	-102387.869	-18869.455	6.352
4027	-102385.354	-18870.598	2.762
4028	-102383.954	-18871.227	1.534
4367	-102383.564	-18888.947	17.724
面積	185.9672810		
地積	185.96 m ²		

1922

地番 長谷町二四ノ三			
NO	X	Y	辺長
4368	-102374.057	-18888.749	
1088	-102375.658	-18888.784	1.601
4367	-102383.564	-18888.947	7.907
4028	-102383.954	-18871.227	17.724
4279	-102380.311	-18872.864	3.993
4280	-102377.318	-18874.222	3.286
4281	-102374.491	-18874.069	2.831
4282	-102374.364	-18874.062	0.127
4368	-102374.057	-18888.749	14.690
面積	149.3366485		
地積	149.33 m ²		

1923

地番 長谷町二四ノ二			
NO	X	Y	辺長
4369	-102363.970	-18888.532	
4368	-102374.057	-18888.749	10.089
4282	-102374.364	-18874.062	14.690
4374	-102364.295	-18873.474	10.086
4373	-102364.239	-18876.310	2.836
4369	-102363.970	-18888.532	12.224
面積	149.9730190		
地積	149.97 m ²		

1924

地番 保五ノ五			
NO	X	Y	辺長
4370	-102348.478	-18888.207	
1089	-102355.963	-18888.359	7.486
4369	-102363.970	-18888.532	8.008
4373	-102364.239	-18876.310	12.224
4378	-102361.485	-18876.259	2.754
4377	-102353.978	-18876.092	7.508
4375	-102348.736	-18875.982	5.243
4370	-102348.478	-18888.207	12.227
面積	189.4492860		
地積	189.44 m ²		

図面の種類	画地出来形確認測量図		
街区名	5	求積表	
町名	岩倉長谷町		
京都市岩倉長谷土地区画整理組合			



7

9

5

X-102400

X-102400

2100-18

8

2

3

X-102450

X-102450

Y-18850

Y-18800

Y-18850

Y-18800

2000-52


2000-48

2000-49

2000-53

2000-54

2000-55

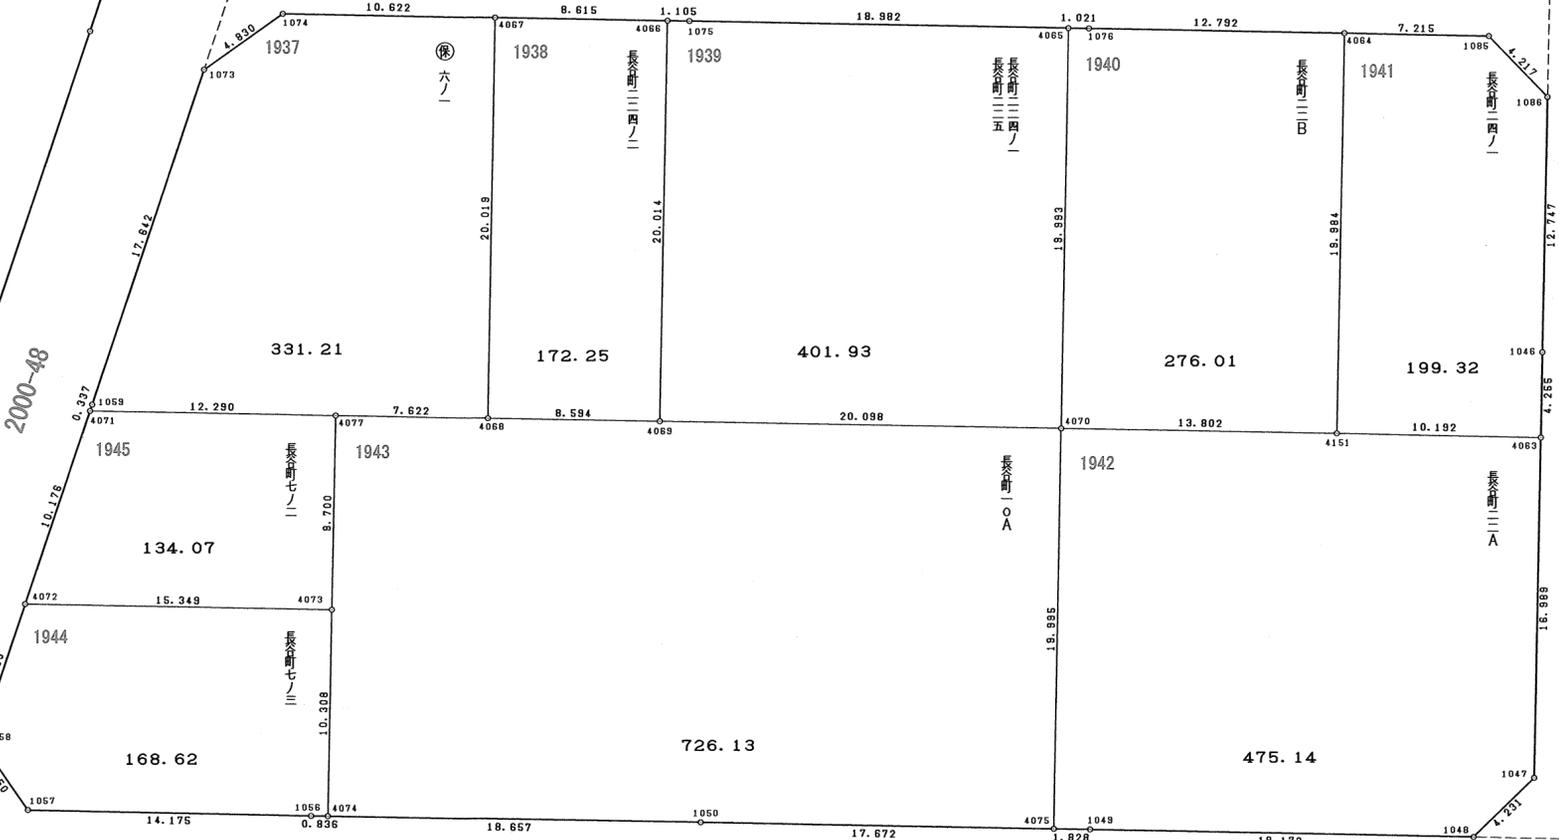

図面の種類	画地出来形確認測量図		
街区名	6	縮尺	1/250
町名	岩倉長谷町		
京都市岩倉長谷土地区画整理組合			

1937

地番 保六ノ一			
NO	X	Y	辺長
1073	-102386.028	-18962.251	
1059	-102402.747	-18967.883	17.642
4071	-102403.067	-18967.991	0.337
4077	-102403.313	-18955.703	12.290
4068	-102403.479	-18948.082	7.622
4067	-102383.463	-18947.685	20.019
1074	-102383.241	-18958.305	10.622
1073	-102386.028	-18962.251	4.830
面積	331.2172900		
地積	331.21 m ²		

1938

地番 長谷町二二四ノ二			
NO	X	Y	辺長
4067	-102383.463	-18947.685	
4068	-102403.479	-18948.082	20.019
4069	-102403.653	-18939.489	8.594
4066	-102383.643	-18939.071	20.014
4067	-102383.463	-18947.685	8.615
面積	172.2539730		
地積	172.25 m ²		

1939

地番 長谷町二二四ノ一, 長谷町二二五			
NO	X	Y	辺長
4066	-102383.643	-18939.071	
4069	-102403.653	-18939.489	20.014
4070	-102404.061	-18919.395	20.098
4065	-102384.072	-18918.988	19.993
1075	-102383.666	-18937.966	18.982
4066	-102383.643	-18939.071	1.105
面積	401.9386550		
地積	401.93 m ²		

1940

地番 長谷町二二B			
NO	X	Y	辺長
4065	-102384.072	-18918.988	
4070	-102404.061	-18919.395	19.993
4151	-102404.343	-18905.595	13.802
4064	-102384.363	-18905.177	19.984
1076	-102384.094	-18917.967	12.792
4065	-102384.072	-18918.988	1.021
面積	276.0108305		
地積	276.01 m ²		

1941

地番 長谷町二四ノ一			
NO	X	Y	辺長
4064	-102384.363	-18905.177	
4151	-102404.343	-18905.595	19.984
4063	-102404.551	-18895.405	10.192
1046	-102400.296	-18895.315	4.255
1086	-102387.552	-18895.038	12.747
1085	-102384.514	-18897.963	4.217
4064	-102384.363	-18905.177	7.215
面積	199.3245750		
地積	199.32 m ²		

1942

地番 長谷町二二A			
NO	X	Y	辺長
4070	-102404.061	-18919.395	
4075	-102424.052	-18919.798	19.995
1049	-102424.090	-18917.970	1.828
1048	-102424.483	-18898.802	19.172
1047	-102421.537	-18895.764	4.231
4063	-102404.551	-18895.405	16.989
4151	-102404.343	-18905.595	10.192
4070	-102404.061	-18919.395	13.802
面積	475.1452965		
地積	475.14 m ²		

1943

地番 長谷町一〇A			
NO	X	Y	辺長
4077	-102403.313	-18955.703	
4073	-102413.011	-18955.907	9.700
4074	-102423.317	-18956.121	10.308
1050	-102423.681	-18937.467	18.657
4075	-102424.052	-18919.798	17.672
4070	-102404.061	-18919.395	19.995
4069	-102403.653	-18939.489	20.098
4068	-102403.479	-18948.082	8.594
4077	-102403.313	-18955.703	7.622
面積	726.1340480		
地積	726.13 m ²		

1944

地番 長谷町七ノ三			
NO	X	Y	辺長
4072	-102412.707	-18971.253	
1058	-102419.511	-18973.556	7.183
1057	-102423.001	-18971.129	4.250
1056	-102423.301	-18956.957	14.175
4074	-102423.317	-18956.121	0.836
4073	-102413.011	-18955.907	10.308
4072	-102412.707	-18971.253	15.349
面積	168.6244630		
地積	168.62 m ²		

1945


地番 長谷町七ノ二			
NO	X	Y	辺長
4071	-102403.067	-18967.991	
4072	-102412.707	-18971.253	10.176
4073	-102413.011	-18955.907	15.349
4077	-102403.313	-18955.703	9.700
4071	-102403.067	-18967.991	12.290
面積	134.0731480		
地積	134.07 m ²		

図面の種類	画地出来形確認測量図		
街区名	6	求積表	
町名	岩倉長谷町		
京都市岩倉長谷土地区画整理組合			



20

2000-41

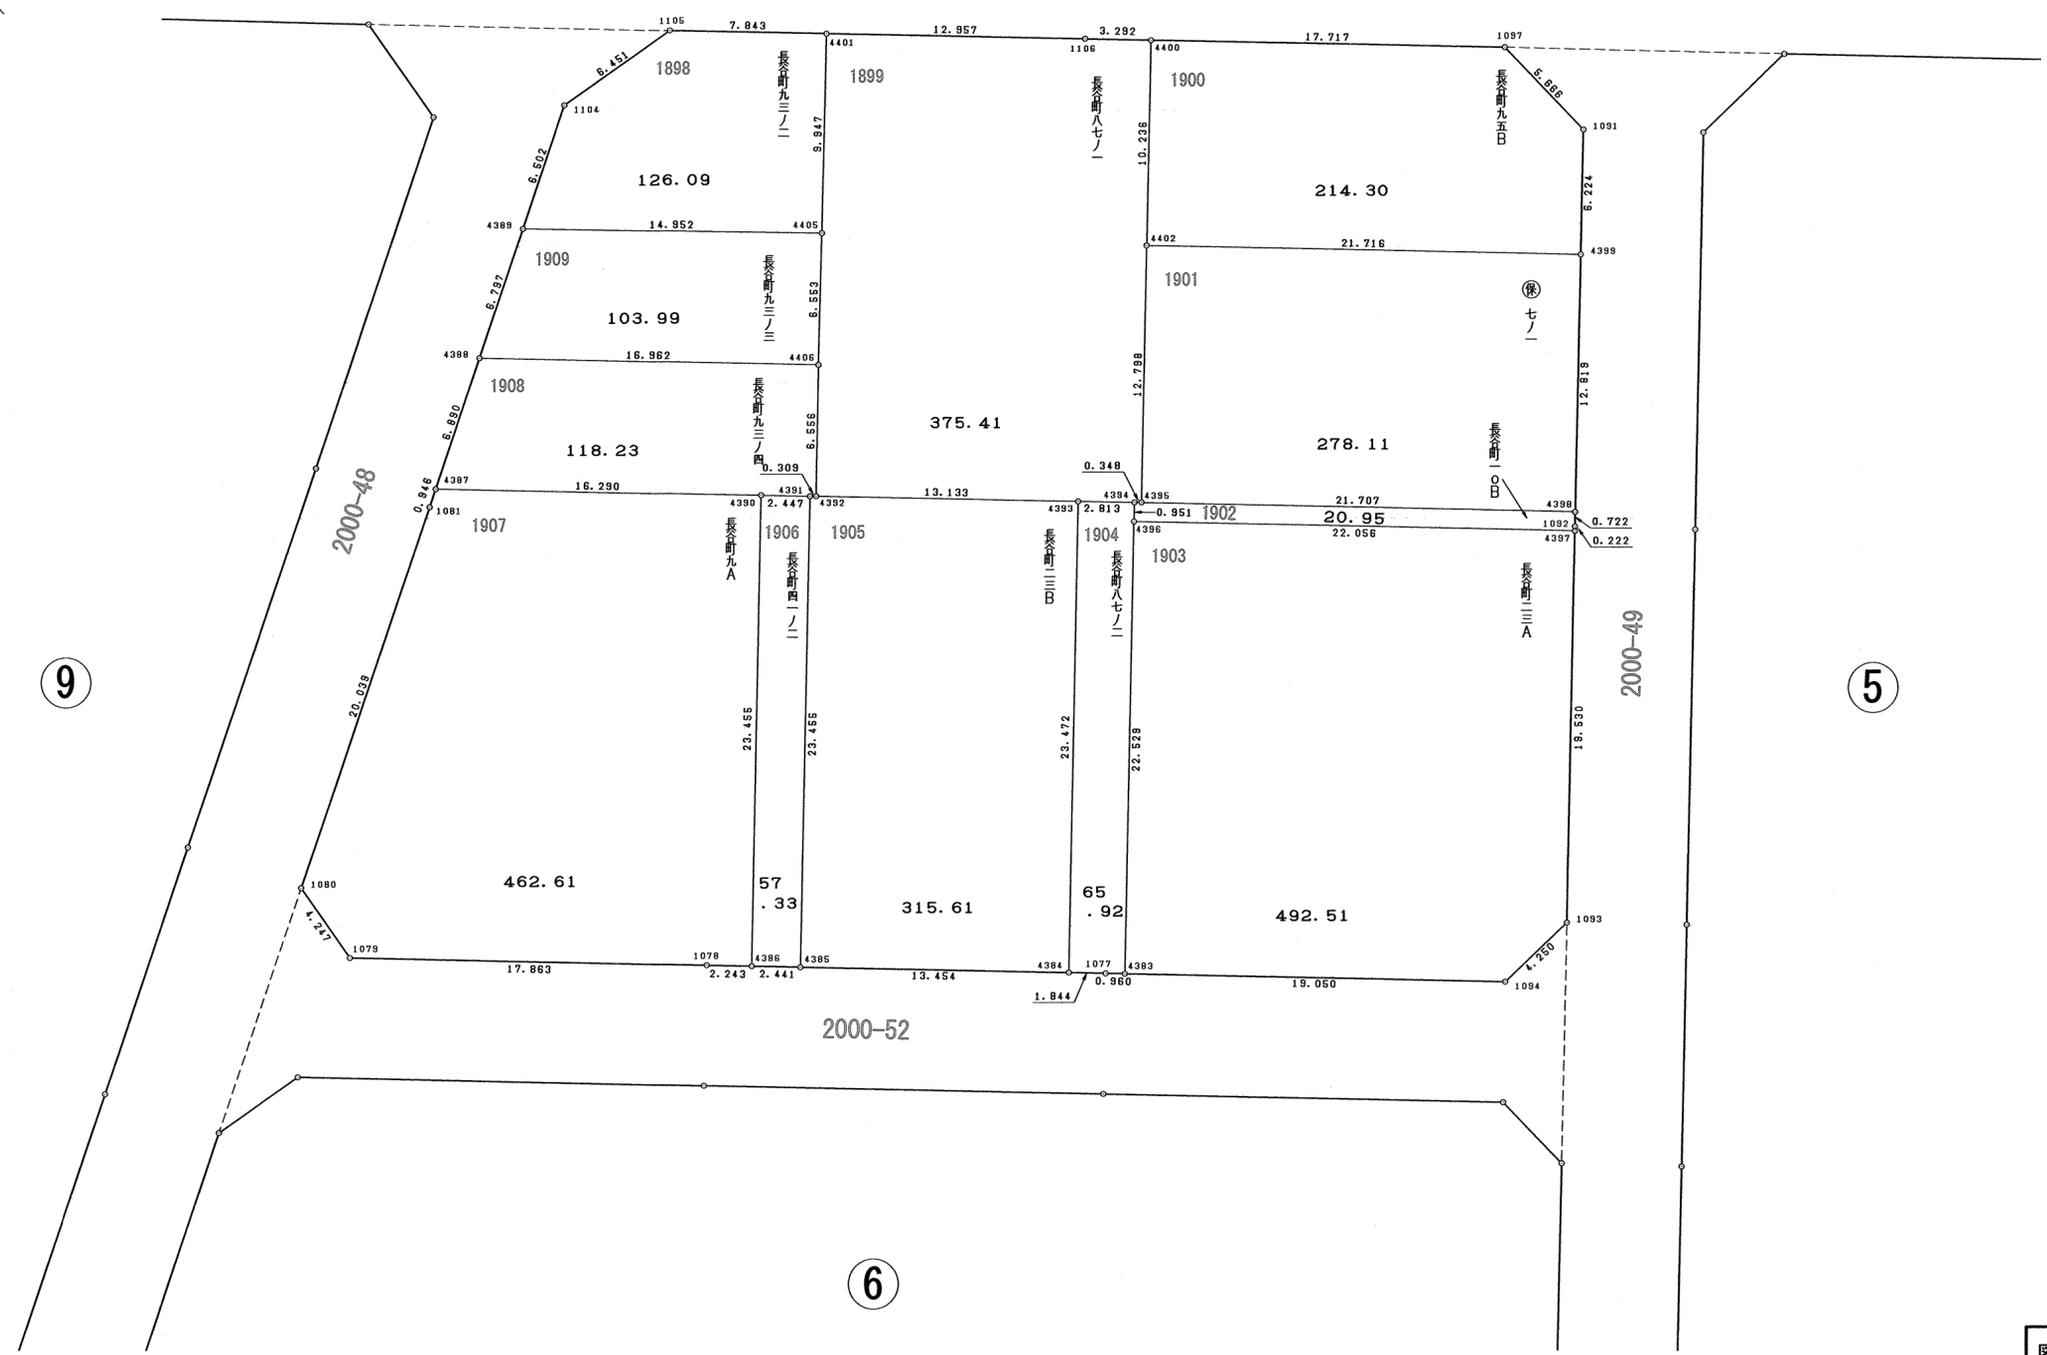

2000-48

2000-49

2000-52

9

5

6

図面の種類	画地出来形確認測量図		
街区名	7	縮尺	1/250
町名	岩倉長谷町		
京都市岩倉長谷土地区画整理組合			

X-102350

X-102350

X-102400

X-102400

Y-18950

Y-18950

1898

地番 長谷町九三ノ二			
NO	X	Y	辺長
1105	-102331.089	-18939.680	
1104	-102334.800	-18944.957	6.451
4389	-102340.962	-18947.033	6.502
4405	-102341.199	-18932.082	14.952
4401	-102331.254	-18931.838	9.947
1105	-102331.089	-18939.680	7.843
面積	126.0978360		
地積	126.09 m ²		

1899

地番 長谷町八七ノ一			
NO	X	Y	辺長
4401	-102331.254	-18931.838	
4405	-102341.199	-18932.082	9.947
4406	-102347.750	-18932.245	6.553
4392	-102354.305	-18932.362	6.556
4393	-102354.570	-18919.231	13.133
4394	-102354.621	-18916.418	2.813
4395	-102354.624	-18916.070	0.348
4402	-102341.828	-18915.806	12.798
4400	-102331.594	-18915.591	10.236
1106	-102331.526	-18918.883	3.292
4401	-102331.254	-18931.838	12.957
面積	375.4173160		
地積	375.41 m ²		

1900

地番 長谷町九五B			
NO	X	Y	辺長
4400	-102331.594	-18915.591	
4402	-102341.828	-18915.806	10.236
4399	-102342.275	-18894.094	21.716
1091	-102336.052	-18893.861	6.224
1097	-102331.957	-18897.877	5.666
4400	-102331.594	-18915.591	17.717
面積	214.3052195		
地積	214.30 m ²		

1901

地番 保七ノ一			
NO	X	Y	辺長
4402	-102341.828	-18915.806	
4395	-102354.624	-18916.070	12.798
4398	-102355.092	-18894.368	21.707
4399	-102342.275	-18894.094	12.819
4402	-102341.828	-18915.806	21.716
面積	278.1137630		
地積	278.11 m ²		

1902

地番 長谷町一〇B			
NO	X	Y	辺長
4394	-102354.621	-18916.418	
4396	-102355.572	-18916.439	0.951
4397	-102356.036	-18894.387	22.056
1092	-102355.814	-18894.383	0.222
4398	-102355.092	-18894.368	0.722
4395	-102354.624	-18916.070	21.707
4394	-102354.621	-18916.418	0.348
面積	20.9513305		
地積	20.95 m ²		

1903

地番 長谷町二三A			
NO	X	Y	辺長
4396	-102355.572	-18916.439	
4383	-102378.097	-18916.896	22.529
1094	-102378.504	-18897.850	19.050
1093	-102375.563	-18894.781	4.250
4397	-102356.036	-18894.387	19.530
4396	-102355.572	-18916.439	22.056
面積	492.5189630		
地積	492.51 m ²		

1904

地番 長谷町八七ノ二			
NO	X	Y	辺長
4393	-102354.570	-18919.231	
4384	-102378.038	-18919.700	23.472
1077	-102378.076	-18917.856	1.844
4383	-102378.097	-18916.896	0.960
4396	-102355.572	-18916.439	22.529
4394	-102354.621	-18916.418	0.951
4393	-102354.570	-18919.231	2.813
面積	65.9268235		
地積	65.92 m ²		

1905

地番 長谷町二三B			
NO	X	Y	辺長
4391	-102354.306	-18932.671	
4385	-102377.757	-18933.152	23.455
4384	-102378.038	-18919.700	13.454
4393	-102354.570	-18919.231	23.472
4392	-102354.305	-18932.362	13.133
4391	-102354.306	-18932.671	0.309
面積	315.6133825		
地積	315.61 m ²		

1906

地番 長谷町四一ノ二			
NO	X	Y	辺長
4390	-102354.255	-18935.118	
4386	-102377.706	-18935.593	23.455
4385	-102377.757	-18933.152	2.441
4391	-102354.306	-18932.671	23.455
4390	-102354.255	-18935.118	2.447
面積	57.3386220		
地積	57.33 m ²		

1907

地番 長谷町九A			
NO	X	Y	辺長
4387	-102353.934	-18951.405	
1081	-102354.831	-18951.707	0.946
1080	-102373.813	-18958.131	20.039
1079	-102377.293	-18955.696	4.247
1078	-102377.659	-18937.836	17.863
4386	-102377.706	-18935.593	2.243
4390	-102354.255	-18935.118	23.455
4387	-102353.934	-18951.405	16.290
面積	462.6103355		
地積	462.61 m ²		

1908

地番 長谷町九三ノ四			
NO	X	Y	辺長
4388	-102347.404	-18949.204	
4387	-102353.934	-18951.405	6.890
4390	-102354.255	-18935.118	16.290
4391	-102354.306	-18932.671	2.447
4392	-102354.305	-18932.362	0.309
4406	-102347.750	-18932.245	6.556
4388	-102347.404	-18949.204	16.962
面積	118.2313100		
地積	118.23 m ²		

1909

地番 長谷町九三ノ三			
NO	X	Y	辺長
4389	-102340.962	-18947.033	
4388	-102347.404	-18949.204	6.797
4406	-102347.750	-18932.245	16.962
4405	-102341.199	-18932.082	6.553
4389	-102340.962	-18947.033	14.952
面積	103.9918380		
地積	103.99 m ²		

図面の種類	画地出来形確認測量図		
街区名	7	求積表	
町名	岩倉長谷町		
京都市岩倉長谷土地区画整理組合			

Y-18050

Y-18000


Y-18950

X-102400

X-102400



岩倉中町

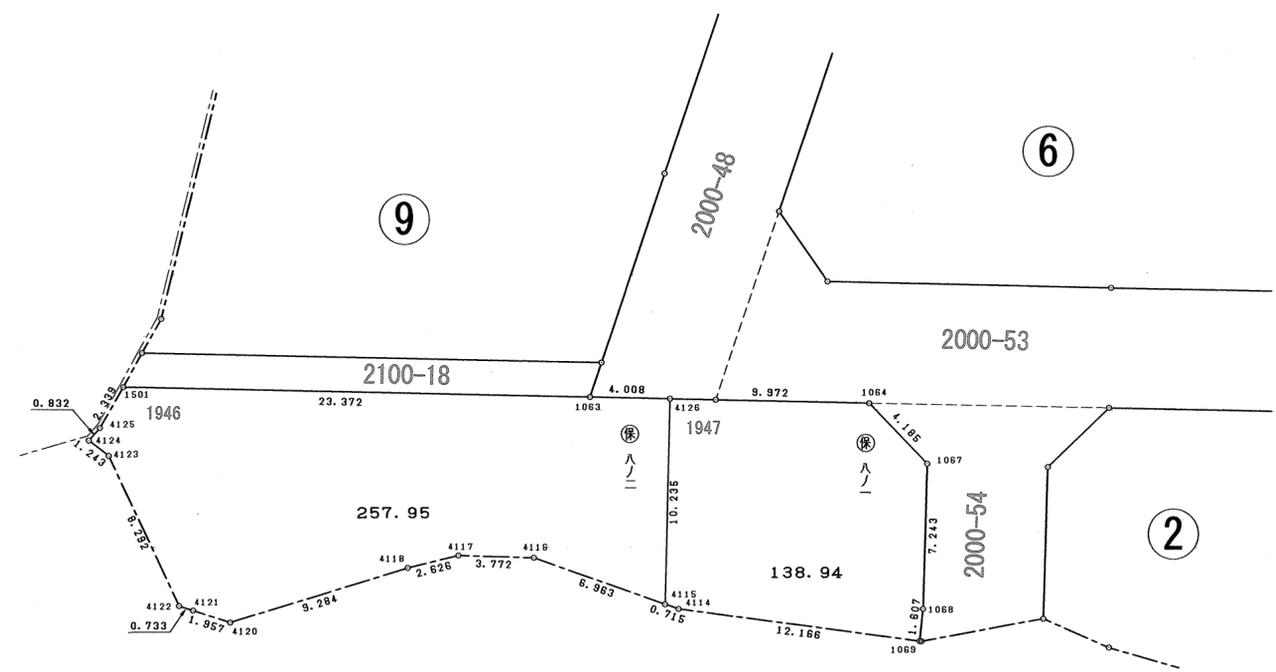

X-102450

X-102450

Y-18050

Y-18000

Y-18950

図面の種類	画地出来形確認測量図		
街区名	8	縮尺	1/250
町名	岩倉長谷町		
京都市岩倉長谷土地区画整理組合			

1946

地番 保八ノ二			
NO	X	Y	辺長
1501	-102428.240	-19006.384	
4125	-102430.268	-19007.550	2.339
4124	-102430.895	-19008.098	0.832
4123	-102431.650	-19007.110	1.243
4122	-102439.156	-19003.586	8.292
4121	-102439.382	-19002.888	0.733
4120	-102439.977	-19001.023	1.957
4118	-102437.265	-18992.143	9.284
4117	-102436.640	-18989.592	2.626
4116	-102436.759	-18985.821	3.772
4115	-102439.067	-18979.251	6.963
4126	-102428.834	-18979.010	10.235
1063	-102428.744	-18983.017	4.008
1501	-102428.240	-19006.384	23.372
面積	257.9551210		
地積	257.95 m ²		

1947

地番 保八ノ一			
NO	X	Y	辺長
4126	-102428.834	-18979.010	
4115	-102439.067	-18979.251	10.235
4114	-102439.304	-18978.576	0.715
1069	-102440.907	-18966.516	12.166
1068	-102439.308	-18966.341	1.607
1067	-102432.069	-18966.132	7.243
1064	-102429.059	-18969.040	4.185
4126	-102428.834	-18979.010	9.972
面積	138.9416560		
地積	138.94 m ²		

図面の種類	画地出来形確認測量図		
街区名	8	求積表	
町名	岩倉長谷町		
京都市岩倉長谷土地区画整理組合			



図面の種類	画地出来形確認測量図		
街区名	9	縮尺	1/250
町名	岩倉長谷町		
京都市岩倉長谷土地区画整理組合			

1893

地番 長谷町九B			
NO	X	Y	辺長
1122	-102330.361	-18972.190	
1550	-102338.853	-18974.420	8.779
4145	-102344.569	-18975.841	5.889
4146	-102351.041	-18956.762	20.146
1111	-102335.402	-18951.501	16.500
1110	-102330.781	-18954.753	5.650
1123	-102330.411	-18970.001	15.252
1122	-102330.361	-18972.190	2.189
面積	362.3586455		
地積	362.35 m ²		

1894

地番 保九ノ一			
NO	X	Y	辺長
4145	-102344.569	-18975.841	
1519	-102344.699	-18975.873	0.133
4144	-102344.866	-18975.610	0.311
4143	-102345.794	-18975.201	1.014
4142	-102347.643	-18975.538	1.879
4141	-102353.194	-18977.424	5.862
4140	-102357.339	-18979.056	4.454
4138	-102357.888	-18979.204	0.568
4147	-102363.971	-18961.150	19.051
1082	-102352.909	-18957.391	11.683
4146	-102351.041	-18956.762	1.971
4145	-102344.569	-18975.841	20.146
面積	259.6521610		
地積	259.65 m ²		

1895

地番 長谷町八ノ二			
NO	X	Y	辺長
4138	-102357.888	-18979.204	
4137	-102359.960	-18979.754	2.143
4139	-102371.876	-18981.484	12.040
4136	-102374.897	-18982.119	3.087
4135	-102377.209	-18982.830	2.418
4148	-102382.410	-18967.379	16.302
1083	-102371.792	-18963.807	11.202
4147	-102363.971	-18961.150	8.260
4138	-102357.888	-18979.204	19.051
面積	341.7608585		
地積	341.76 m ²		

1896

地番 長谷町八ノ一			
NO	X	Y	辺長
4135	-102377.209	-18982.830	
4134	-102380.611	-18983.877	3.559
4133	-102386.172	-18986.061	5.974
4132	-102386.800	-18986.525	0.780
4149	-102392.074	-18970.647	16.730
1084	-102384.100	-18967.948	8.418
4148	-102382.410	-18967.379	1.783
4135	-102377.209	-18982.830	16.302
面積	167.1876995		
地積	167.18 m ²		

1897

地番 長谷町七ノ一			
NO	X	Y	辺長
4132	-102386.800	-18986.525	
4130	-102389.833	-18988.765	3.770
4129	-102395.012	-18995.041	8.136
4128	-102410.289	-19000.913	16.366
4127	-102424.854	-19004.487	14.997
1502	-102426.556	-19005.442	1.951
1062	-102427.036	-18982.442	23.005
1061	-102417.615	-18979.285	9.935
1060	-102400.807	-18973.602	17.742
4149	-102392.074	-18970.647	9.219
4132	-102386.800	-18986.525	16.730
面積	867.1515860		
地積	867.15 m ²		

図面の種類	画地出来形確認測量図		
街区名	9	求積表	
町名	岩倉長谷町		
京都市岩倉長谷土地区画整理組合			

10 街区

1892



地番	長谷町九五A		
N O	X	Y	辺長
1132	-102320.751	-19001.006	
1131	-102324.802	-19006.806	7.074
1133	-102334.589	-19008.541	9.939
4022	-102336.035	-19000.086	8.577
4021	-102338.375	-18991.278	9.113
4020	-102342.902	-18978.306	13.739
1518	-102343.004	-18978.133	0.200
1549	-102338.230	-18976.944	4.919
1121	-102330.359	-18974.828	8.150
1120	-102330.361	-18976.185	1.357
1119	-102327.644	-18983.176	7.500
1132	-102320.751	-19001.006	19.116
面積	422.6970510		
地積	422.69 m ²		

11 街区

1891

地番	保一一ノ一		
N O	X	Y	辺長
1126	-102315.928	-19027.926	
1521	-102329.457	-19029.723	13.647
1129	-102332.598	-19017.327	12.787
1128	-102323.238	-19015.652	9.508
1127	-102317.400	-19019.710	7.109
1126	-102315.928	-19027.926	8.346
面積	171.2351915		
地積	171.23 m ²		

図面の種類	画地出来形確認測量図	
街区名	10・11	求積表
町名	岩倉長谷町	
京都市岩倉長谷土地区画整理組合		

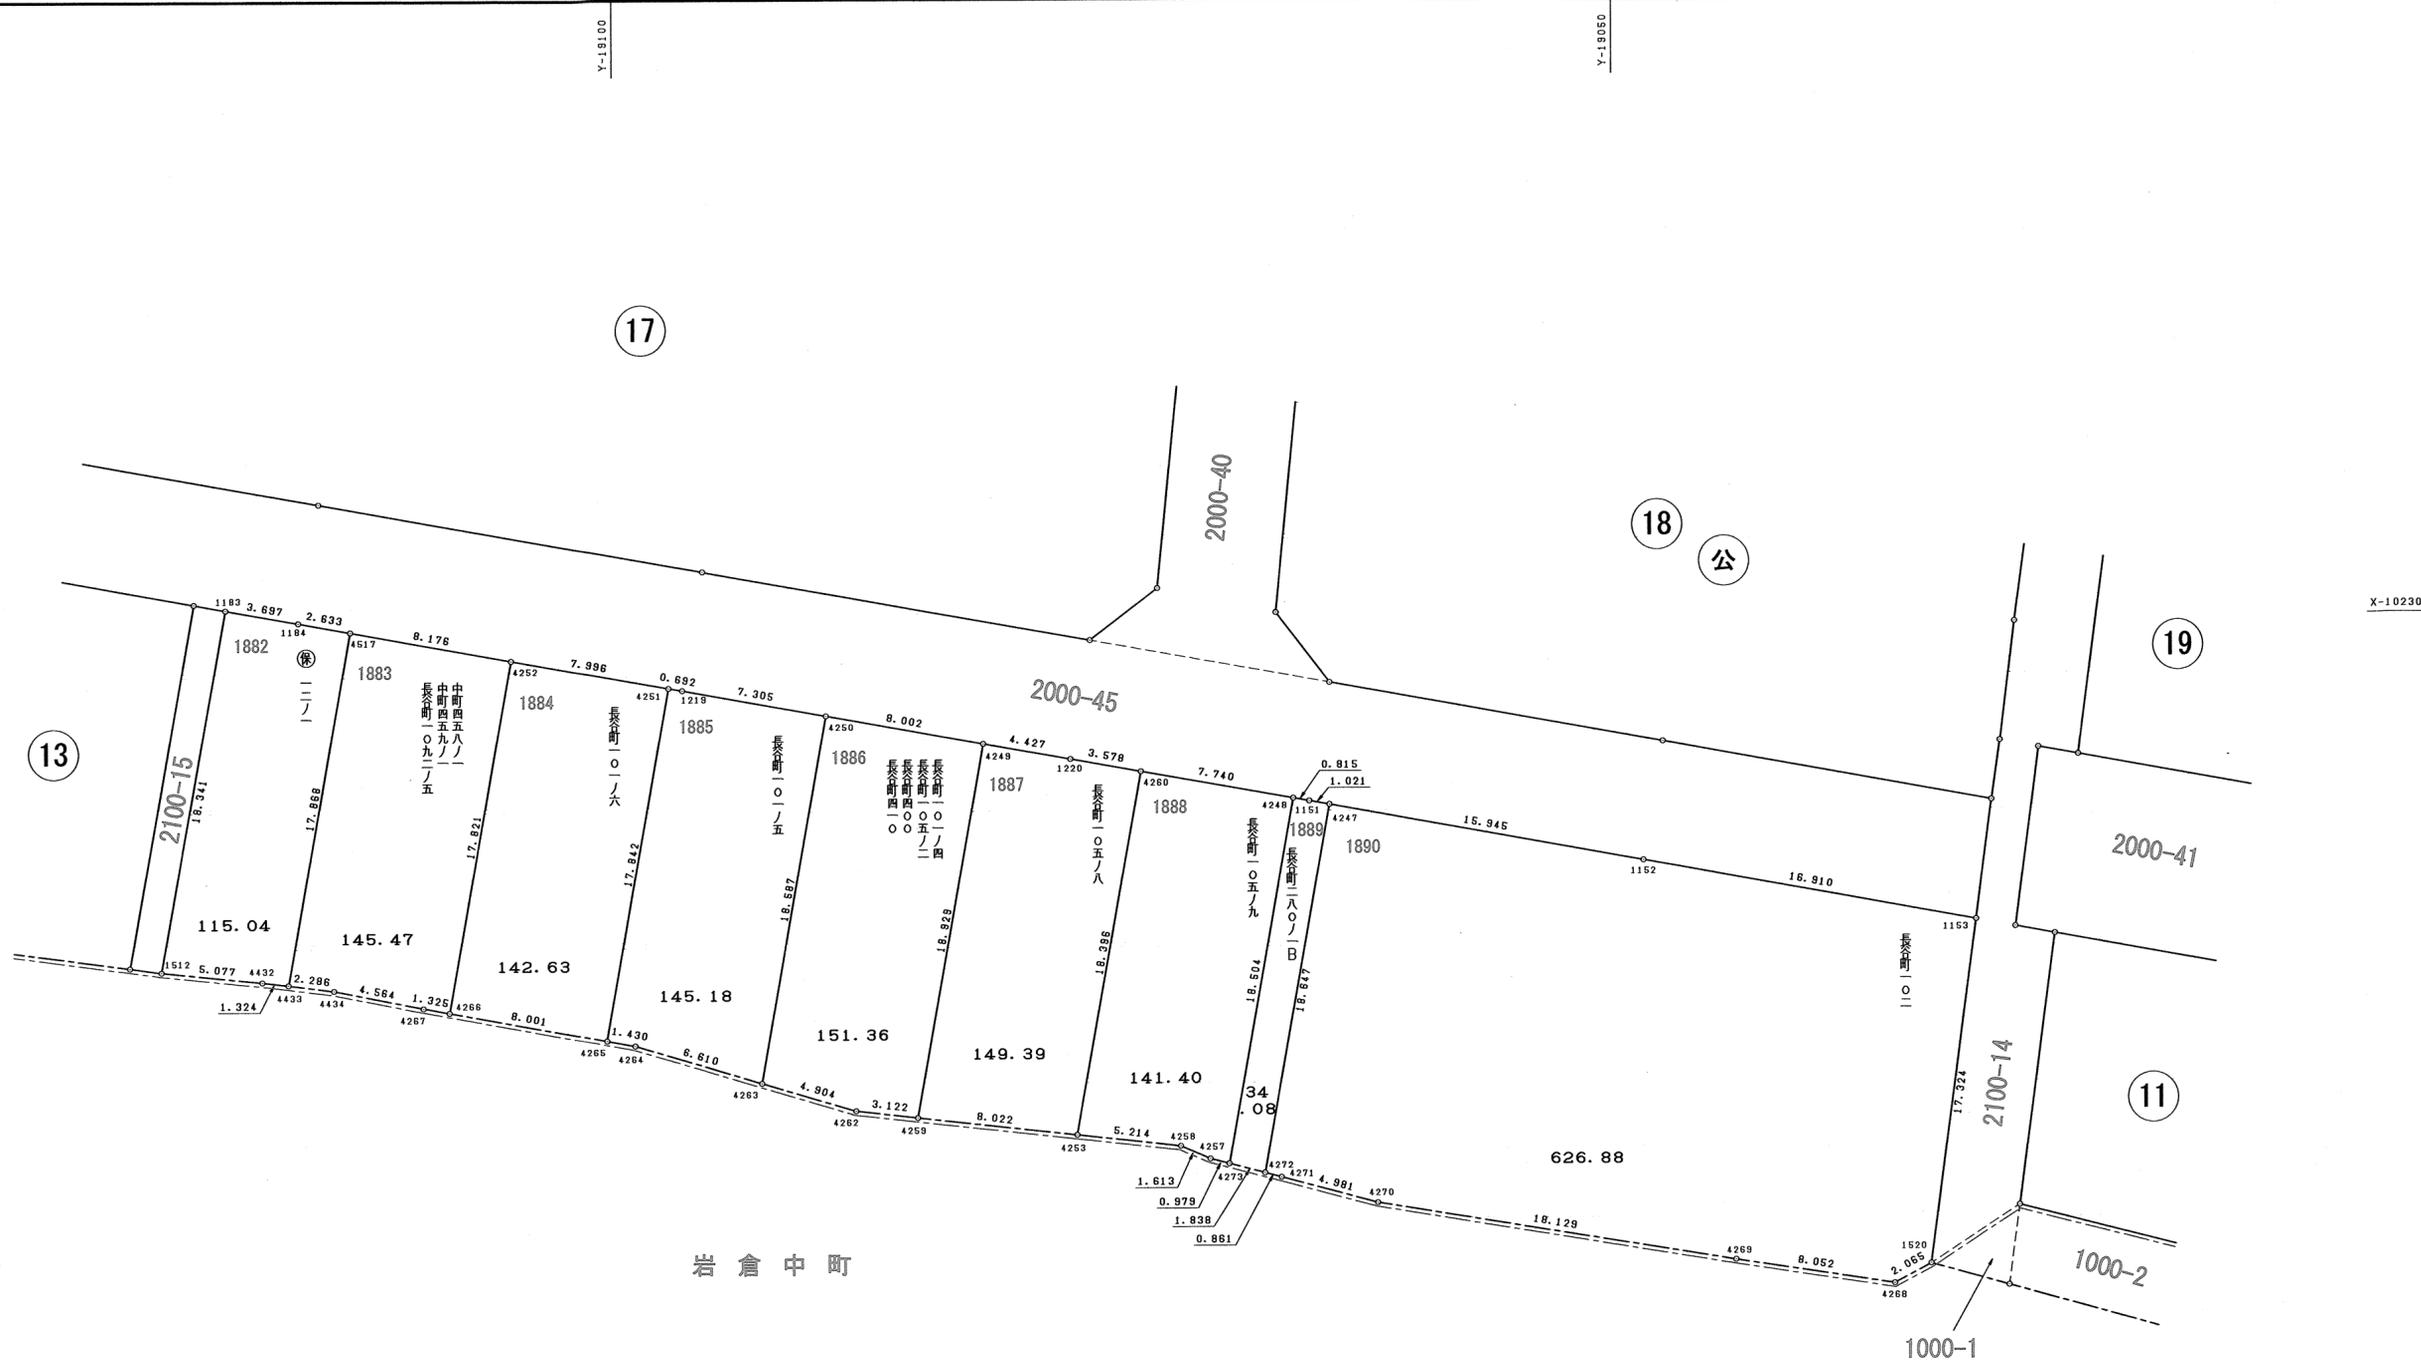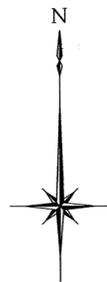

岩倉中町

図面の種類	画地出来形確認測量図		
街区名	12	縮尺	1/250
町名	岩倉長谷町		
京都市岩倉長谷土地区画整理組合			

1882

地番 保一二ノ一			
NO	X	Y	辺長
1183	-102299.552	-19119.420	
1512	-102317.599	-19122.693	18.341
4432	-102318.105	-19117.641	5.077
4433	-102318.256	-19116.325	1.324
4517	-102300.665	-19113.188	17.868
1184	-102300.202	-19115.780	2.633
1183	-102299.552	-19119.420	3.697
面積	115.0479070		
地積	115.04 m ²		

1883

地番 中町四五八ノ一, 中町四五九ノ一 長谷町一〇九二ノ五			
NO	X	Y	辺長
4517	-102300.665	-19113.188	
4433	-102318.256	-19116.325	17.868
4434	-102318.539	-19114.056	2.286
4267	-102319.411	-19109.576	4.564
4266	-102319.647	-19108.272	1.325
4252	-102302.103	-19105.139	17.821
4517	-102300.665	-19113.188	8.176
面積	145.4717140		
地積	145.47 m ²		

1884

地番 長谷町一〇一ノ六			
NO	X	Y	辺長
4252	-102302.103	-19105.139	
4266	-102319.647	-19108.272	17.821
4265	-102321.074	-19100.399	8.001
4251	-102303.509	-19097.267	17.842
4252	-102302.103	-19105.139	7.996
面積	142.6349875		
地積	142.63 m ²		

1885

地番 長谷町一〇一ノ五			
NO	X	Y	辺長
4251	-102303.509	-19097.267	
4265	-102321.074	-19100.399	17.842
4264	-102321.329	-19098.991	1.430
4263	-102323.215	-19092.655	6.610
4250	-102304.916	-19089.393	18.587
1219	-102303.631	-19096.585	7.305
4251	-102303.509	-19097.267	0.692
面積	145.1820350		
地積	145.18 m ²		

1886

地番 長谷町一〇一ノ四, 長谷町一〇五ノ二 長谷町四〇〇, 長谷町四一〇			
NO	X	Y	辺長
4250	-102304.916	-19089.393	
4263	-102323.215	-19092.655	18.587
4262	-102324.614	-19087.954	4.904
4259	-102324.957	-19084.850	3.122
4249	-102306.324	-19081.515	18.929
4250	-102304.916	-19089.393	8.002
面積	151.3613030		
地積	151.36 m ²		

1887

地番 長谷町一〇五ノ八			
NO	X	Y	辺長
4249	-102306.324	-19081.515	
4259	-102324.957	-19084.850	18.929
4253	-102325.840	-19076.876	8.022
4260	-102307.731	-19073.634	18.396
1220	-102307.103	-19077.157	3.578
4249	-102306.324	-19081.515	4.427
面積	149.3976385		
地積	149.39 m ²		

1888

地番 長谷町一〇五ノ九			
NO	X	Y	辺長
4260	-102307.731	-19073.634	
4253	-102325.840	-19076.876	18.396
4258	-102326.413	-19071.693	5.214
4257	-102327.057	-19070.214	1.613
4273	-102327.304	-19069.266	0.979
4248	-102309.088	-19066.013	18.504
4260	-102307.731	-19073.634	7.740
面積	141.4060260		
地積	141.40 m ²		


1889

地番 長谷町二八〇ノ一B			
NO	X	Y	辺長
4248	-102309.088	-19066.013	
4273	-102327.304	-19069.266	18.504
4272	-102327.767	-19067.487	1.838
4247	-102309.411	-19064.204	18.647
1151	-102309.231	-19065.210	1.021
4248	-102309.088	-19066.013	0.815
面積	34.0897490		
地積	34.08 m ²		

1890

地番 長谷町一〇二			
NO	X	Y	辺長
4247	-102309.411	-19064.204	
4272	-102327.767	-19067.487	18.647
4271	-102327.984	-19066.653	0.861
4270	-102329.266	-19061.839	4.981
4269	-102332.152	-19043.941	18.129
4268	-102333.351	-19035.978	8.052
1520	-102332.373	-19034.159	2.065
1153	-102315.201	-19031.862	17.324
1152	-102312.220	-19048.508	16.910
4247	-102309.411	-19064.204	15.945
面積	626.8807525		
地積	626.88 m ²		

図面の種類	画地出来形確認測量図	
街区名	12	求積表
町名	岩倉長谷町	
京都市岩倉長谷土地区画整理組合		

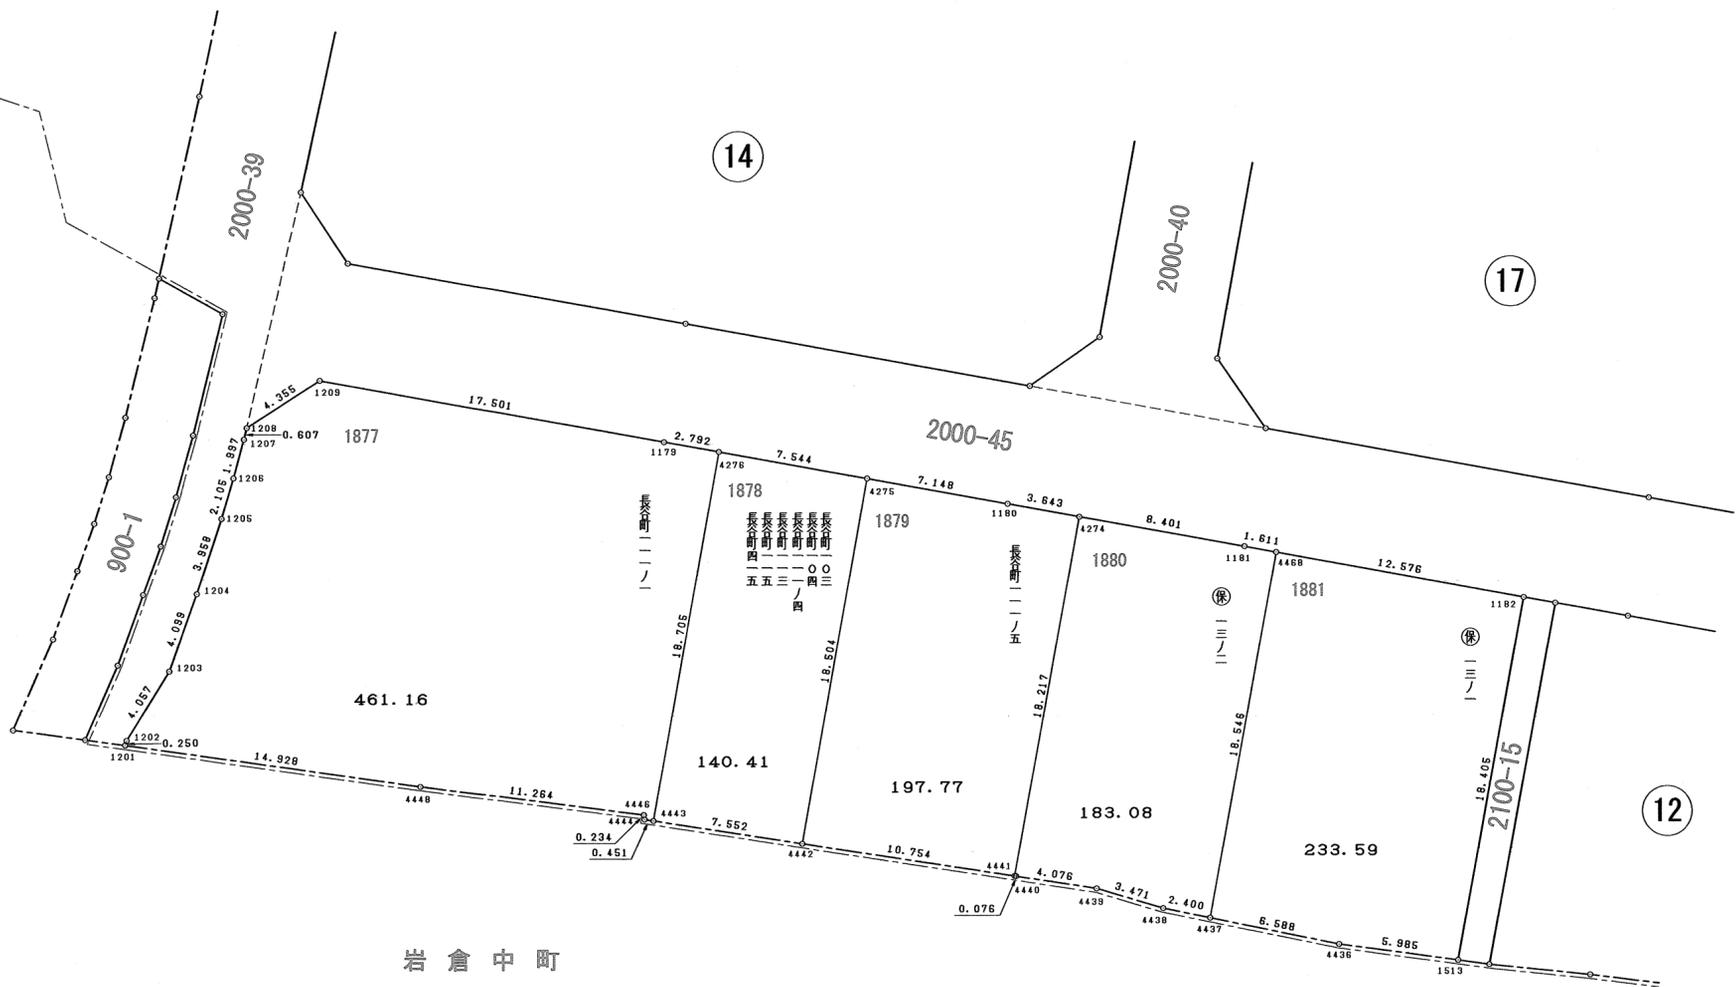

岩倉中町

図面の種類	画地出来形確認測量図		
街区名	13	縮尺	1/250
町名	岩倉長谷町		
京都市岩倉長谷土地区画整理組合			

1877

地番	長谷町一ノ一		
N O	X	Y	辺長
1209	-102288.511	-19181.269	
1208	-102290.874	-19184.928	4.355
1207	-102291.466	-19185.066	0.607
1206	-102293.396	-19185.581	1.997
1205	-102295.416	-19186.175	2.105
1204	-102299.175	-19187.417	3.958
1203	-102303.038	-19188.789	4.099
1202	-102306.492	-19190.918	4.057
1201	-102306.731	-19190.992	0.250
4448	-102308.769	-19176.203	14.928
4446	-102310.187	-19165.028	11.264
4444	-102310.418	-19164.990	0.234
4443	-102310.485	-19164.544	0.451
4276	-102292.065	-19161.289	18.705
1179	-102291.574	-19164.038	2.792
1209	-102288.511	-19181.269	17.501
面積	461.1617545		
地積	461.16 m ²		

1878

地番	長谷町一〇三, 長谷町一〇四, 長谷町一ノ四 長谷町一一三, 長谷町一一五, 長谷町四一五		
N O	X	Y	辺長
4276	-102292.065	-19161.289	
4443	-102310.485	-19164.544	18.705
4442	-102311.614	-19157.076	7.552
4275	-102293.391	-19153.862	18.504
4276	-102292.065	-19161.289	7.544
面積	140.4197200		
地積	140.41 m ²		

1879

地番	長谷町一ノ五		
N O	X	Y	辺長
4275	-102293.391	-19153.862	
4442	-102311.614	-19157.076	18.504
4441	-102313.221	-19146.442	10.754
4274	-102295.287	-19143.238	18.217
1180	-102294.647	-19146.825	3.643
4275	-102293.391	-19153.862	7.148
面積	197.7761440		
地積	197.77 m ²		

1880

地番	保一三ノ二		
N O	X	Y	辺長
4274	-102295.287	-19143.238	
4441	-102313.221	-19146.442	18.217
4440	-102313.233	-19146.366	0.076
4439	-102313.839	-19142.335	4.076
4438	-102314.830	-19139.008	3.471
4437	-102315.303	-19136.655	2.400
4468	-102297.048	-19133.381	18.546
1181	-102296.764	-19134.967	1.611
4274	-102295.287	-19143.238	8.401
面積	183.0801685		
地積	183.08 m ²		

1881

地番	保一三ノ一		
N O	X	Y	辺長
4468	-102297.048	-19133.381	
4437	-102315.303	-19136.655	18.546
4436	-102316.602	-19130.196	6.588
1513	-102317.382	-19124.262	5.985
1182	-102299.267	-19121.002	18.405
4468	-102297.048	-19133.381	12.576
面積	233.5953160		
地積	233.59 m ²		

図面の種類	画地出来形確認測量図	
街区名	13	求積表
町名	岩倉長谷町	
京都市岩倉長谷土地区画整理組合		

1806

地番	長谷町一一二		
NO	X	Y	辺長
1218	-102235.421	-19175.042	
1215	-102236.192	-19175.113	0.774
1214	-102248.151	-19176.643	12.056
1192	-102256.085	-19177.681	8.001
4106	-102262.094	-19178.712	6.096
4287	-102266.013	-19156.808	22.251
4110	-102248.898	-19153.738	17.388
4109	-102237.128	-19153.147	11.784
4108	-102236.360	-19165.038	11.915
1218	-102235.421	-19175.042	10.047
面積	626.7810510		
地積	626.78 m ²		

1807

地番	長谷町一一〇A		
NO	X	Y	辺長
4110	-102248.898	-19153.738	
4287	-102266.013	-19156.808	17.388
4288	-102266.856	-19156.959	0.856
4104	-102269.993	-19139.318	17.917
1170	-102267.607	-19138.894	2.423
1175	-102249.046	-19135.587	18.853
4110	-102248.898	-19153.738	18.151
面積	353.8227735		
地積	353.82 m ²		

1808

地番	長谷町一一四B		
NO	X	Y	辺長
4288	-102266.856	-19156.959	
4105	-102286.122	-19160.415	19.573
1177	-102288.765	-19145.713	14.937
1176	-102286.330	-19142.220	4.257
4104	-102269.993	-19139.318	16.592
4288	-102266.856	-19156.959	17.917
面積	346.7998390		
地積	346.79 m ²		

1809

地番	長谷町一一四A		
NO	X	Y	辺長
4106	-102262.094	-19178.712	
1191	-102264.017	-19179.042	1.951
1190	-102267.961	-19179.834	4.022
1189	-102279.114	-19182.217	11.404
1188	-102282.660	-19179.869	4.252
1178	-102285.664	-19162.960	17.173
4105	-102286.122	-19160.415	2.585
4288	-102266.856	-19156.959	19.573
4287	-102266.013	-19156.808	0.856
4106	-102262.094	-19178.712	22.251
面積	454.6538830		
地積	454.65 m ²		

図面の種類	画地出来形確認測量図	
街区名	14	求積表
町名	岩倉長谷町	
京都市岩倉長谷土地区画整理組合		


Y-18150

Y-18100

Y-18050

X-102200

X-102200

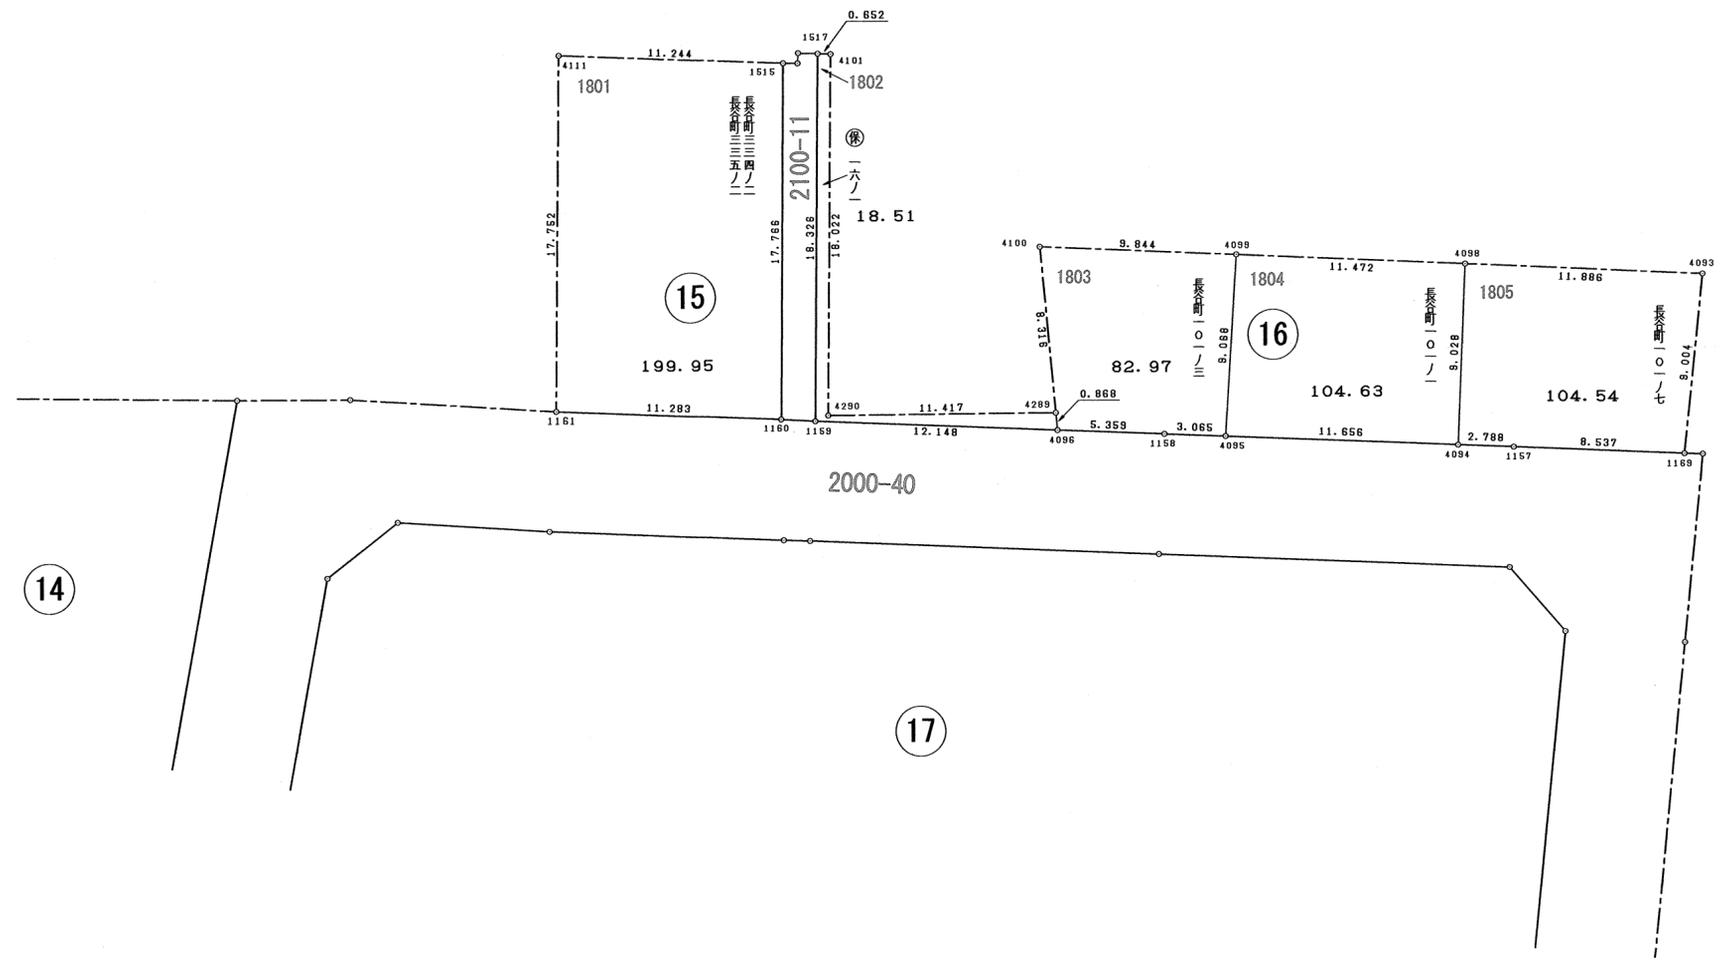

X-102250

X-102250

Y-18150

Y-18100

Y-18050

図面の種類	画地出来形確認測量図		
街区名	15・16	縮尺	1/250
町名	岩倉長谷町		
京都市岩倉長谷土地区画整理組合			

15街区

1801

地番	長谷町三三四ノ二, 長谷町三三五ノ二		
NO	X	Y	辺長
4111	-102231.860	-19119.464	
1161	-102249.612	-19119.601	17.752
1160	-102250.030	-19108.325	11.283
1515	-102232.264	-19108.227	17.766
4111	-102231.860	-19119.464	11.244
面積	199.9524760		
地積	199.95 m ²		

16街区

1802

地番	保一六ノ一		
NO	X	Y	辺長
1517	-102231.797	-19106.492	
1159	-102250.123	-19106.614	18.326
4096	-102250.588	-19094.474	12.148
4289	-102249.723	-19094.557	0.868
4290	-102249.843	-19105.974	11.417
4101	-102231.821	-19105.840	18.022
1517	-102231.797	-19106.492	0.652
面積	18.5152525		
地積	18.51 m ²		

1803

地番	長谷町一〇一ノ三		
NO	X	Y	辺長
4100	-102241.445	-19095.353	
4289	-102249.723	-19094.557	8.316
4096	-102250.588	-19094.474	0.868
1158	-102250.793	-19089.118	5.359
4095	-102250.911	-19086.055	3.065
4099	-102241.858	-19085.517	9.068
4100	-102241.445	-19095.353	9.844
面積	82.9764715		
地積	82.97 m ²		

1804

地番	長谷町一〇一ノ一		
NO	X	Y	辺長
4099	-102241.858	-19085.517	
4095	-102250.911	-19086.055	9.068
4094	-102251.361	-19074.407	11.656
4098	-102242.339	-19074.055	9.028
4099	-102241.858	-19085.517	11.472
面積	104.6354600		
地積	104.63 m ²		

1805

地番	長谷町一〇一ノ七		
NO	X	Y	辺長
4098	-102242.339	-19074.055	
4094	-102251.361	-19074.407	9.028
1157	-102251.468	-19071.621	2.788
1169	-102251.795	-19063.090	8.537
4093	-102242.837	-19062.179	9.004
4098	-102242.339	-19074.055	11.886
面積	104.5477115		
地積	104.54 m ²		

図面の種類	画地出来形確認測量図	
街区名	15・16	求積表
町名	岩倉長谷町	
京都市岩倉長谷土地区画整理組合		




X-102250

X-102250

X-102300

X-102300

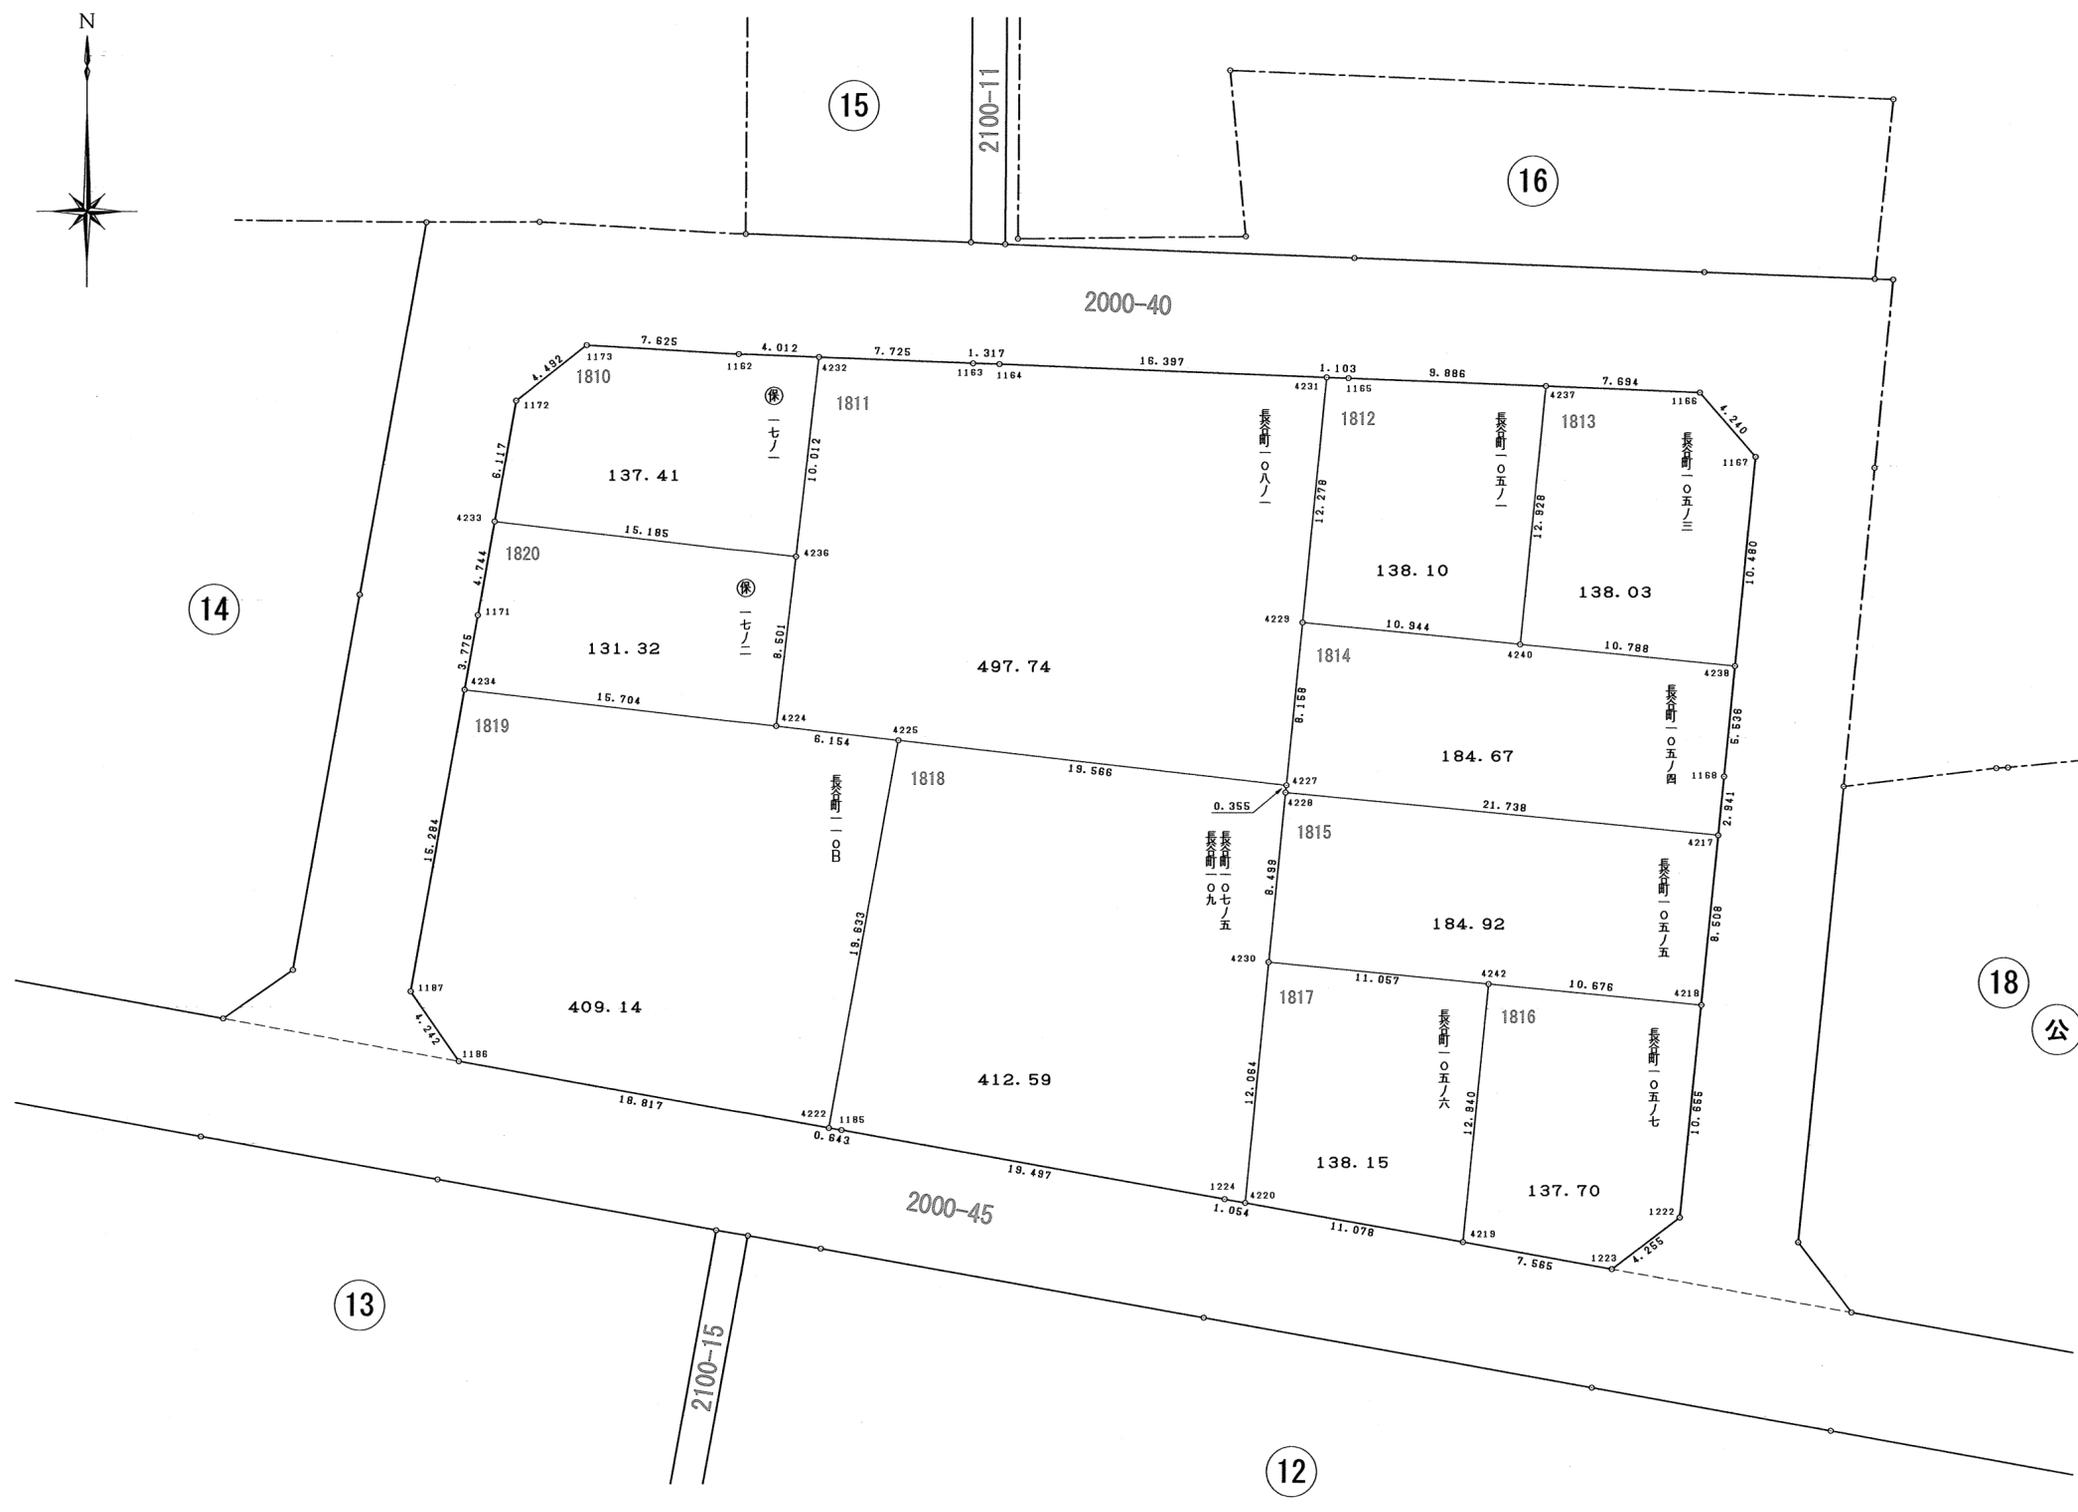

Y-19150

Y-19100

Y-19050

Y-19150

Y-19100

Y-19050

図面の種類	画地出来形確認測量図		
街区名	17	縮尺	1/250
町名	岩倉長谷町		
京都市岩倉長谷土地区画整理組合			

1810

地番 保一七ノ一			
NO	X	Y	辺長
1173	-102255.146	-19127.549	
1172	-102257.931	-19131.074	4.492
4233	-102263.954	-19132.147	6.117
4236	-102265.699	-19117.062	15.185
4232	-102255.751	-19115.928	10.012
1162	-102255.593	-19119.937	4.012
1173	-102255.146	-19127.549	7.625
面積	137.4187055		
地積	137.41 m ²		

1811

地番 長谷町一〇八ノ一			
NO	X	Y	辺長
4232	-102255.751	-19115.928	
4236	-102265.699	-19117.062	10.012
4224	-102274.144	-19118.042	8.501
4225	-102274.850	-19111.928	6.154
4227	-102277.084	-19092.489	19.566
4229	-102268.965	-19091.688	8.158
4231	-102256.744	-19090.506	12.278
1164	-102256.095	-19106.891	16.397
1163	-102256.054	-19108.208	1.317
4232	-102255.751	-19115.928	7.725
面積	497.7476705		
地積	497.74 m ²		

1812

地番 長谷町一〇五ノ一			
NO	X	Y	辺長
4231	-102256.744	-19090.506	
4229	-102268.965	-19091.688	12.278
4240	-102270.039	-19080.796	10.944
4237	-102257.173	-19079.524	12.928
1165	-102256.788	-19089.403	9.886
4231	-102256.744	-19090.506	1.103
面積	138.1053395		
地積	138.10 m ²		

1813

地番 長谷町一〇五ノ三			
NO	X	Y	辺長
4237	-102257.173	-19079.524	
4240	-102270.039	-19080.796	12.928
4238	-102271.096	-19070.059	10.788
1167	-102260.665	-19069.044	10.480
1166	-102257.472	-19071.835	4.240
4237	-102257.173	-19079.524	7.694
面積	138.0322370		
地積	138.03 m ²		

1814

地番 長谷町一〇五ノ四			
NO	X	Y	辺長
4229	-102268.965	-19091.688	
4227	-102277.084	-19092.489	8.158
4228	-102277.438	-19092.523	0.355
4217	-102279.533	-19070.886	21.738
1168	-102276.606	-19070.595	2.941
4238	-102271.096	-19070.059	5.536
4240	-102270.039	-19080.796	10.788
4229	-102268.965	-19091.688	10.944
面積	184.6745940		
地積	184.67 m ²		

1815

地番 長谷町一〇五ノ五			
NO	X	Y	辺長
4228	-102277.438	-19092.523	
4230	-102285.896	-19093.359	8.499
4242	-102286.974	-19082.354	11.057
4218	-102288.000	-19071.727	10.676
4217	-102279.533	-19070.886	8.508
4228	-102277.438	-19092.523	21.738
面積	184.9247750		
地積	184.92 m ²		

1816

地番 長谷町一〇五ノ七			
NO	X	Y	辺長
4242	-102286.974	-19082.354	
4219	-102298.853	-19083.612	12.940
1223	-102301.184	-19076.184	7.565
1222	-102298.603	-19072.780	4.255
4218	-102288.000	-19071.727	10.655
4242	-102286.974	-19082.354	10.676
面積	137.7093395		
地積	137.70 m ²		

1817

地番 長谷町一〇五ノ六			
NO	X	Y	辺長
4230	-102285.896	-19093.359	
4220	-102297.905	-19094.518	12.064
4219	-102298.853	-19083.612	11.078
4242	-102286.974	-19082.354	12.940
4230	-102285.896	-19093.359	11.057
面積	138.1587025		
地積	138.15 m ²		

1818

地番 長谷町一〇七ノ五, 長谷町一〇九			
NO	X	Y	辺長
4225	-102274.850	-19111.928	
4222	-102294.177	-19115.384	19.633
1185	-102294.290	-19114.750	0.643
1224	-102297.719	-19095.556	19.497
4220	-102297.905	-19094.518	1.054
4230	-102285.896	-19093.359	12.064
4228	-102277.438	-19092.523	8.499
4227	-102277.084	-19092.489	0.355
4225	-102274.850	-19111.928	19.566
面積	412.5952645		
地積	412.59 m ²		


1819

地番 長谷町一一〇B			
NO	X	Y	辺長
4234	-102272.342	-19133.643	
1187	-102287.388	-19136.331	15.284
1186	-102290.871	-19133.909	4.242
4222	-102294.177	-19115.384	18.817
4225	-102274.850	-19111.928	19.633
4224	-102274.144	-19118.042	6.154
4234	-102272.342	-19133.643	15.704
面積	409.1415840		
地積	409.14 m ²		

1820

地番 保一七ノ二			
NO	X	Y	辺長
4233	-102263.954	-19132.147	
1171	-102268.625	-19132.979	4.744
4234	-102272.342	-19133.643	3.775
4224	-102274.144	-19118.042	15.704
4236	-102265.699	-19117.062	8.501
4233	-102263.954	-19132.147	15.185
面積	131.3254525		
地積	131.32 m ²		

図面の種類	画地出来形確認測量図	
街区名	17	求積表
町名	岩倉長谷町	
京都市岩倉長谷土地区画整理組合		

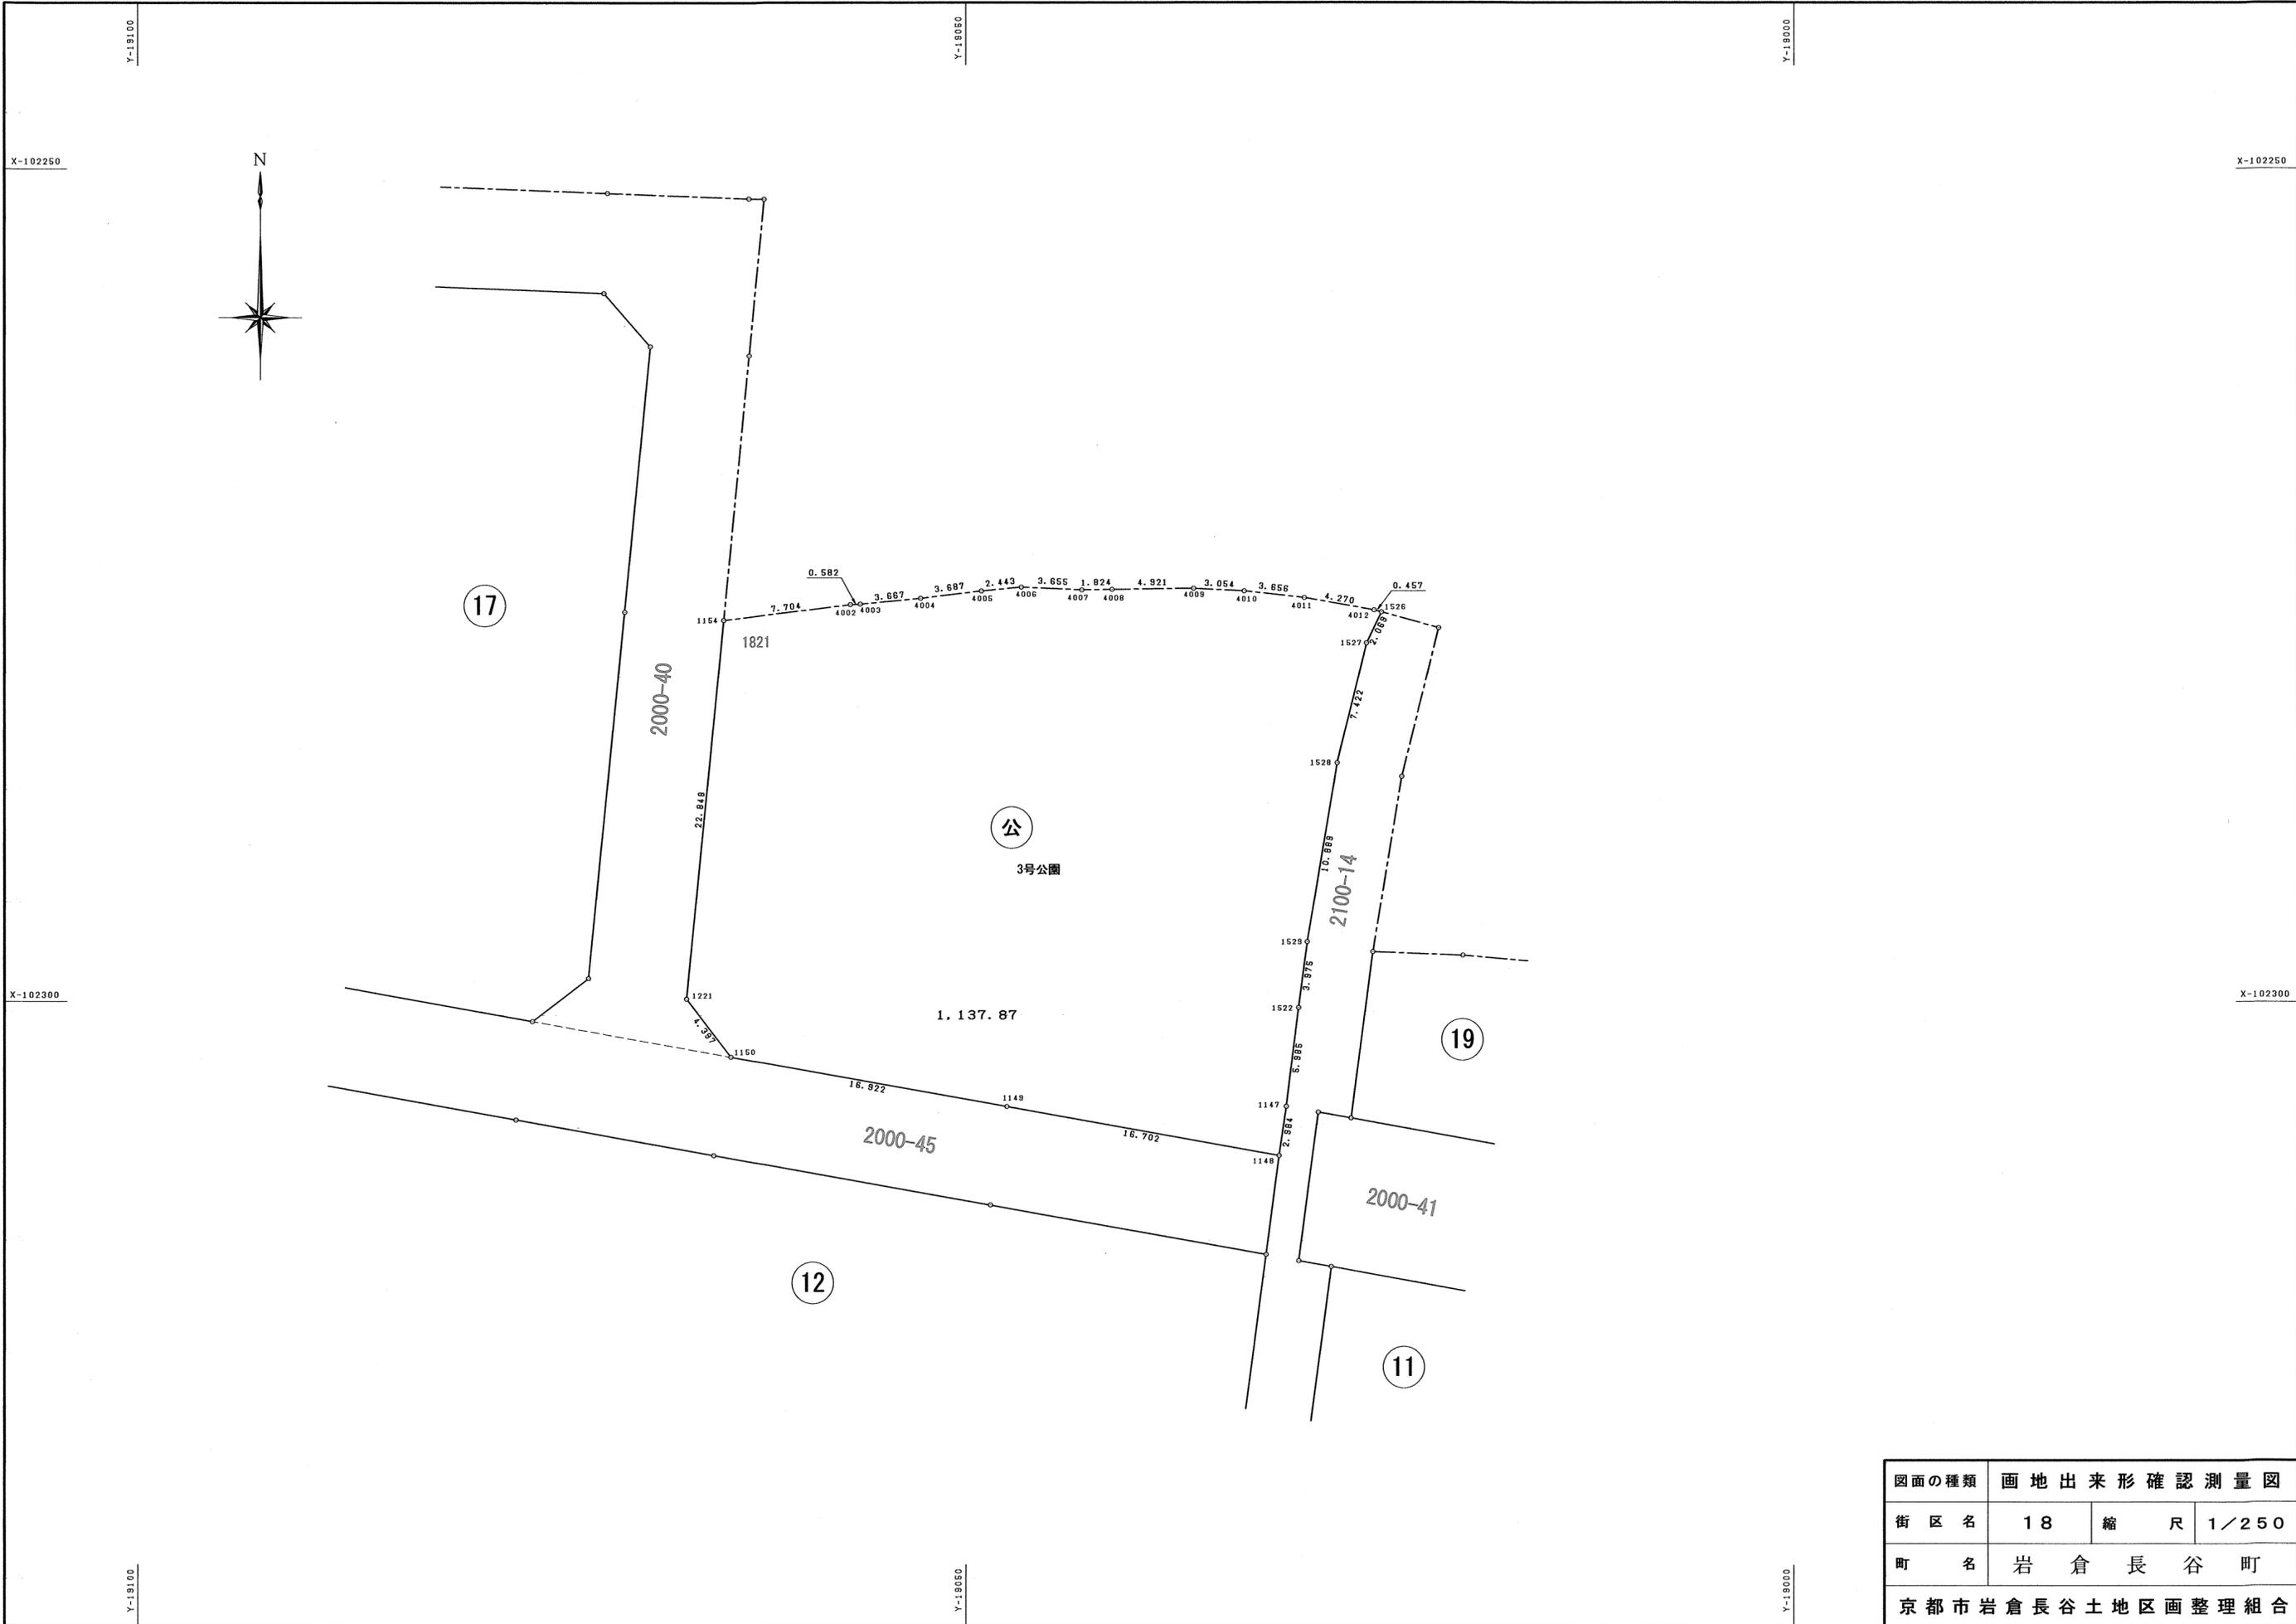


図面の種類	画地出来形確認測量図		
街区名	18	縮尺	1/250
町名	岩倉長谷町		
京都市岩倉長谷土地区画整理組合			


1821

地番 3号公園			
NO	X	Y	辺長
1154	-102277.095	-19064.612	
1221	-102299.833	-19066.855	22.848
1150	-102303.320	-19064.176	4.397
1149	-102306.296	-19047.517	16.922
1148	-102309.252	-19031.078	16.702
1147	-102306.300	-19030.642	2.984
1522	-102300.360	-19029.904	5.985
1529	-102296.420	-19029.376	3.975
1528	-102285.680	-19027.576	10.889
1527	-102278.473	-19025.799	7.422
1526	-102276.605	-19024.908	2.069
4012	-102276.488	-19025.350	0.457
4011	-102275.749	-19029.556	4.270
4010	-102275.344	-19033.190	3.656
4009	-102275.190	-19036.241	3.054
4008	-102275.254	-19041.162	4.921
4007	-102275.278	-19042.986	1.824
4006	-102275.114	-19046.638	3.655
4005	-102275.346	-19049.070	2.443
4004	-102275.780	-19052.732	3.687
4003	-102276.134	-19056.382	3.667
4002	-102276.167	-19056.964	0.582
1154	-102277.095	-19064.612	7.704
面積	1137.8773400		
地積	1137.87 m ²		

図面の種類	画地出来形確認測量図	
街区名	18	求積表
町名	岩倉長谷町	
京都市岩倉長谷土地区画整理組合		

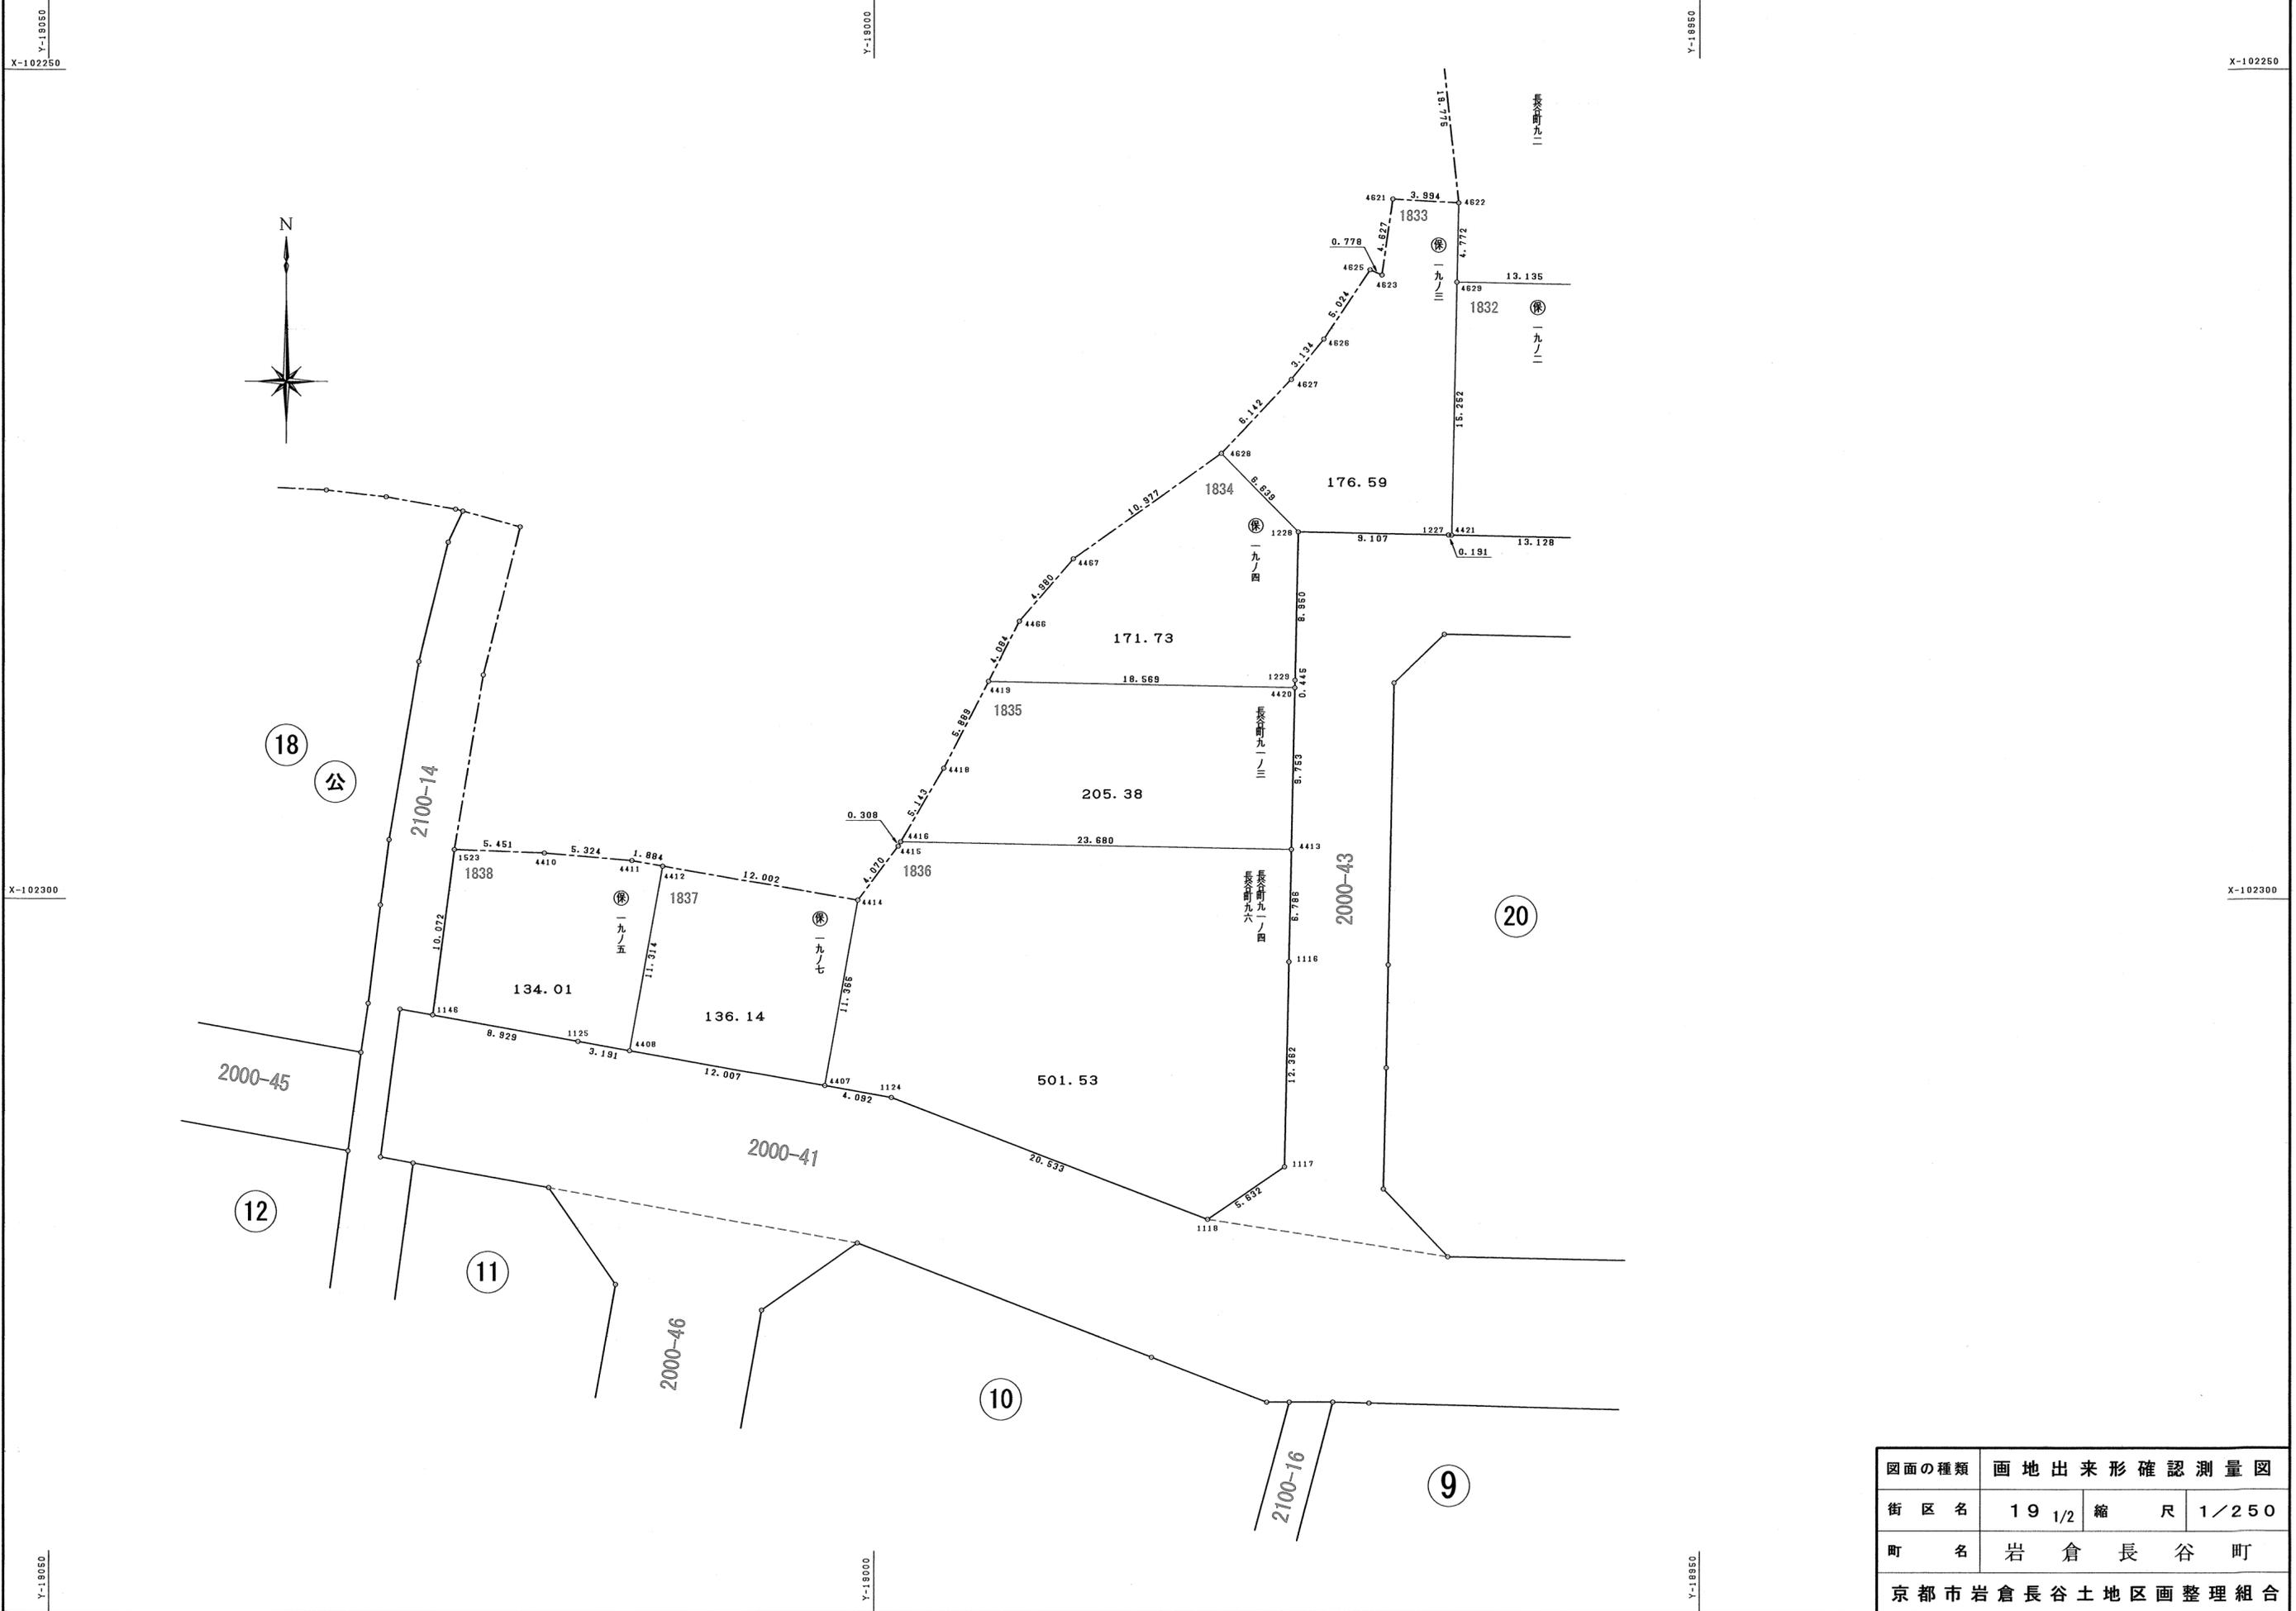

図面の種類	画地出来形確認測量図		
街区名	19 1/2	縮尺	1/250
町名	岩倉長谷町		
京都市岩倉長谷土地区画整理組合			

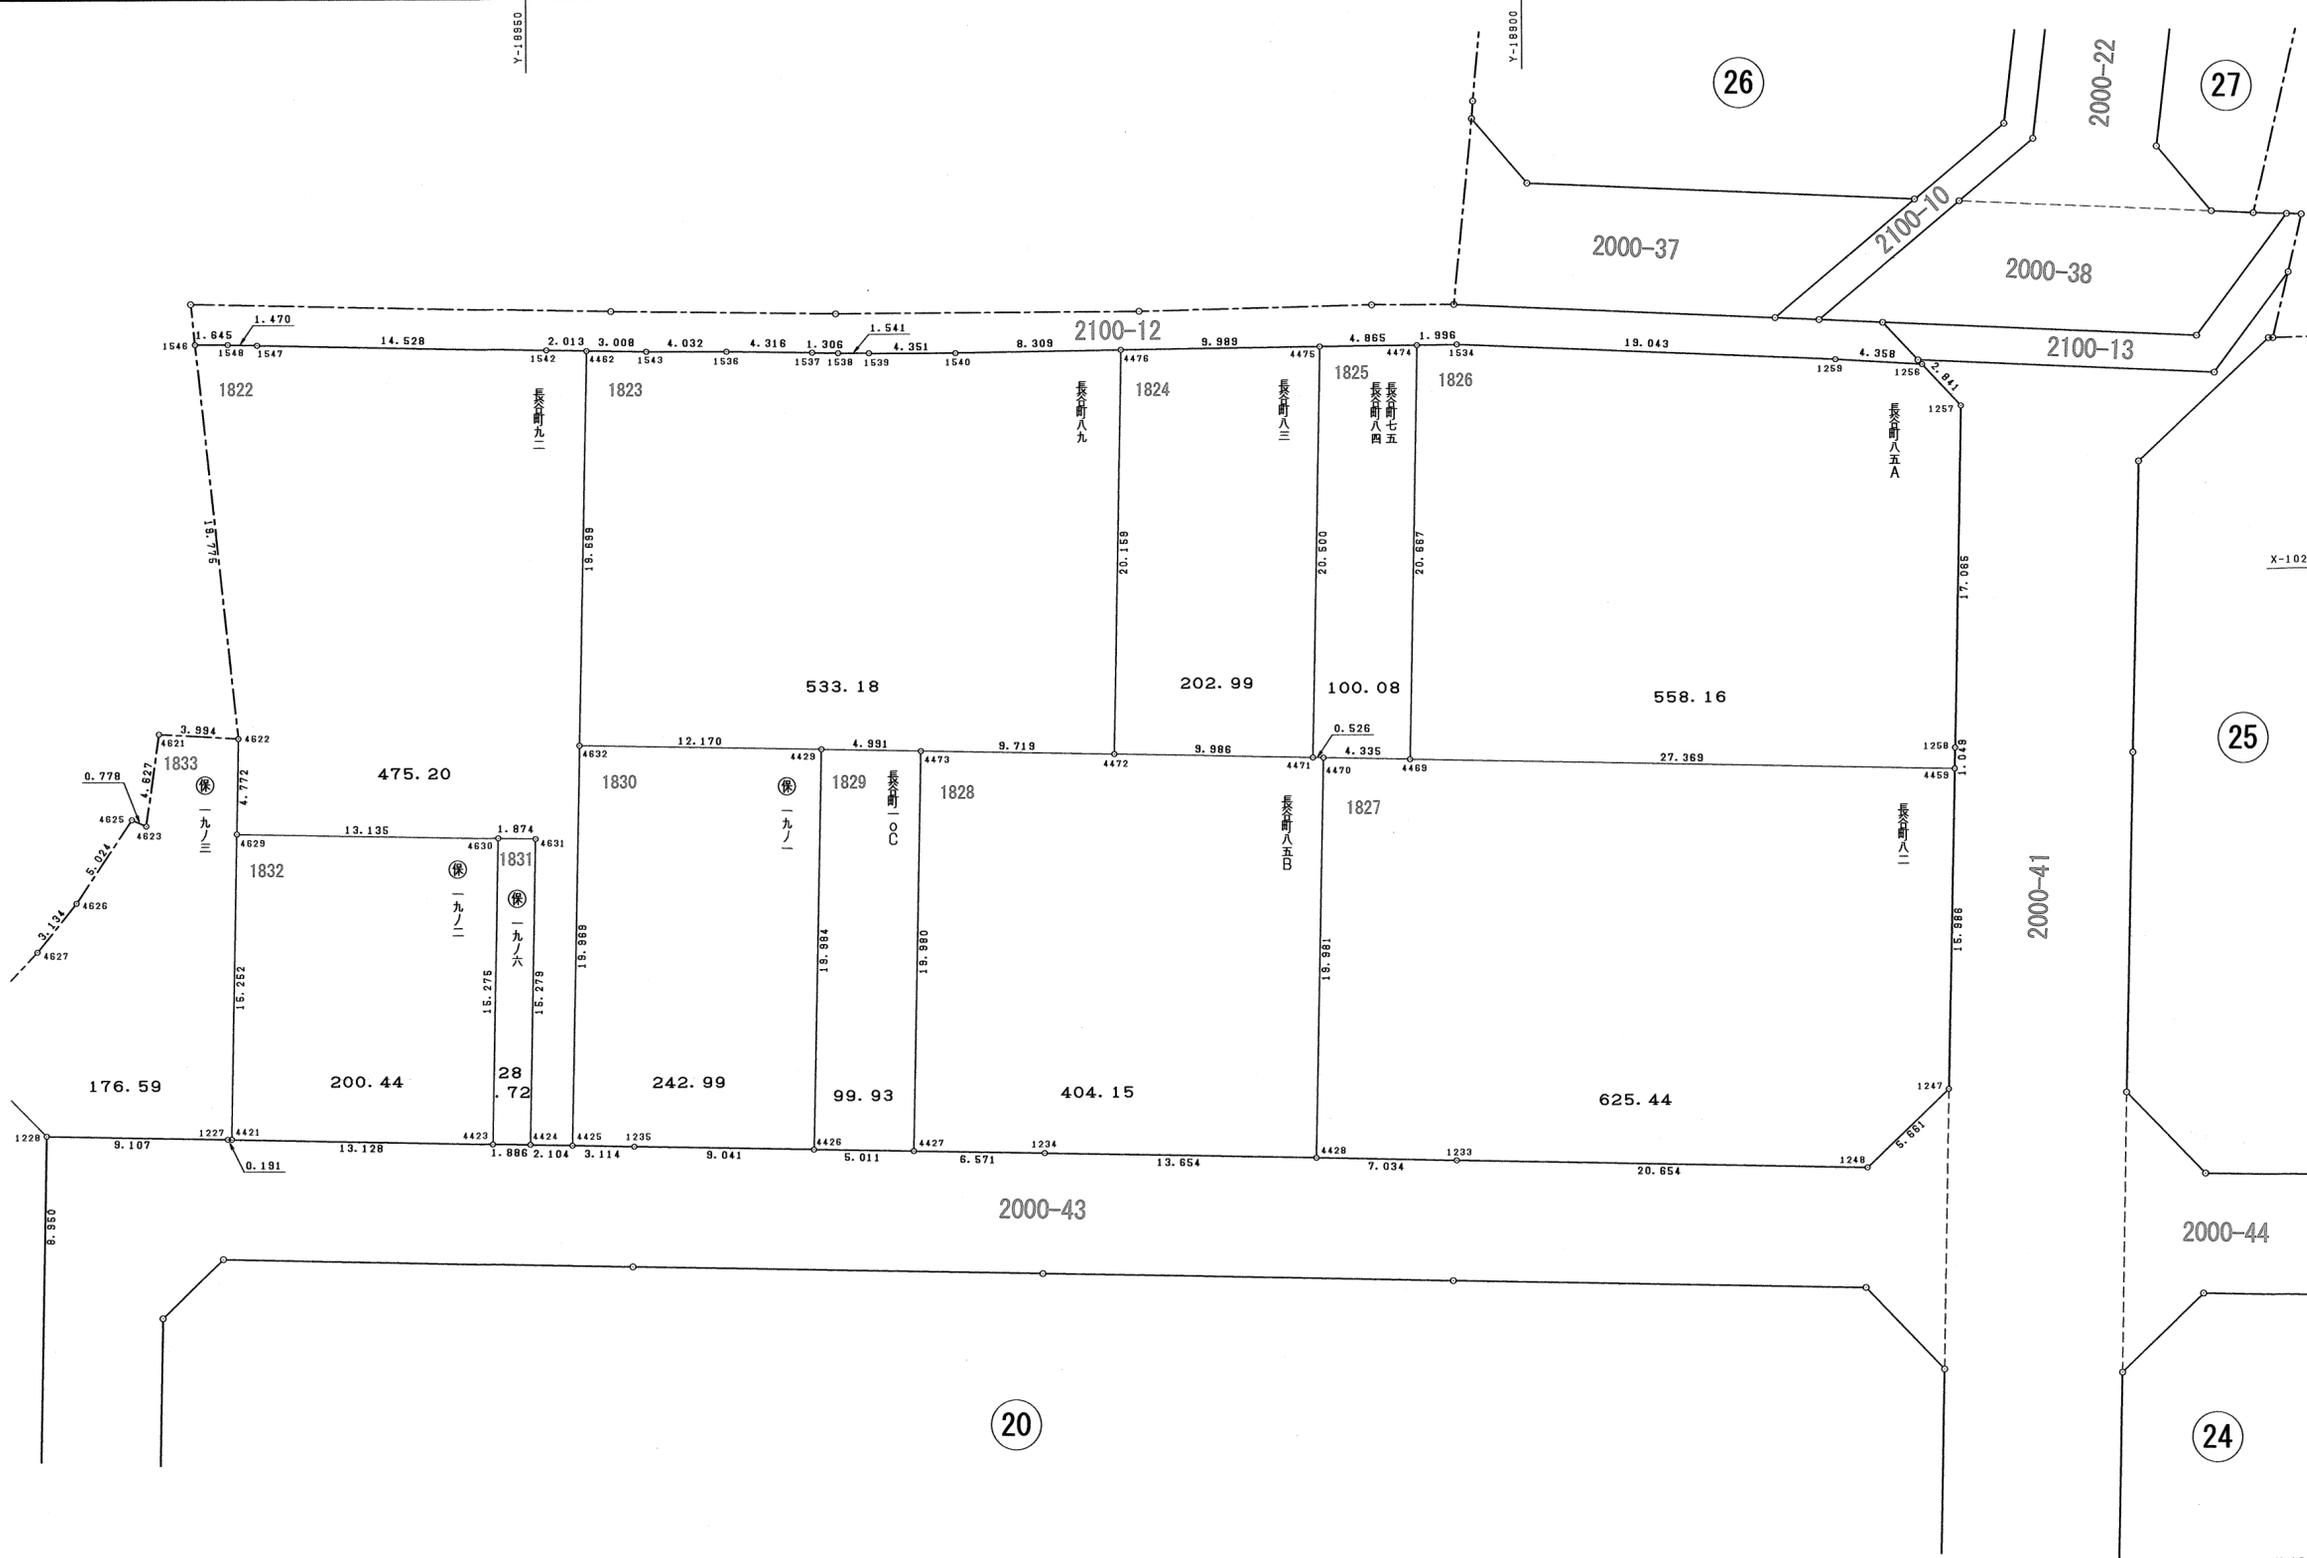

図面の種類	画地出来形確認測量図		
街区名	19 2/2	縮尺	1/250
町名	岩倉長谷町		
京都市岩倉長谷土地区画整理組合			

1822

地番 長谷町九二			
NO	X	Y	辺長
1546	-102238.388	-18966.690	
4622	-102258.052	-18964.592	19.775
4629	-102262.823	-18964.692	4.772
4630	-102263.078	-18951.559	13.135
4631	-102263.114	-18949.685	1.874
4424	-102278.390	-18949.999	15.279
4425	-102278.435	-18947.895	2.104
4632	-102258.470	-18947.459	19.969
4462	-102238.775	-18947.037	19.699
1542	-102238.736	-18949.050	2.013
1547	-102238.426	-18963.575	14.528
1548	-102238.391	-18965.045	1.470
1546	-102238.388	-18966.690	1.645
面積	475.2053185		
地積	475.20 m ²		

1823

地番 長谷町八九			
NO	X	Y	辺長
4462	-102238.775	-18947.037	
4632	-102258.470	-18947.459	19.699
4429	-102258.709	-18935.291	12.170
4473	-102258.815	-18930.301	4.991
4472	-102259.021	-18920.584	9.719
4476	-102238.866	-18920.174	20.159
1540	-102238.975	-18928.483	8.309
1539	-102238.964	-18932.834	4.351
1538	-102238.945	-18934.375	1.541
1537	-102238.919	-18935.681	1.306
1536	-102238.857	-18939.997	4.316
1543	-102238.833	-18944.029	4.032
4462	-102238.775	-18947.037	3.008
面積	533.1868765		
地積	533.18 m ²		

1824

地番 長谷町八三			
NO	X	Y	辺長
4476	-102238.866	-18920.174	
4472	-102259.021	-18920.584	20.159
4471	-102259.232	-18910.600	9.986
4475	-102238.736	-18910.185	20.500
4476	-102238.866	-18920.174	9.989
面積	202.9973120		
地積	202.99 m ²		

1825

地番 長谷町七五, 長谷町八四			
NO	X	Y	辺長
4475	-102238.736	-18910.185	
4471	-102259.232	-18910.600	20.500
4470	-102259.243	-18910.074	0.526
4469	-102259.335	-18905.739	4.335
4474	-102238.672	-18905.320	20.667
4475	-102238.736	-18910.185	4.865
面積	100.0858865		
地積	100.08 m ²		

1826

地番 長谷町八五A			
NO	X	Y	辺長
4474	-102238.672	-18905.320	
4469	-102259.335	-18905.739	20.667
4459	-102259.914	-18878.376	27.369
1258	-102258.865	-18878.353	1.049
1257	-102241.803	-18878.004	17.065
1256	-102239.729	-18879.947	2.841
1259	-102239.466	-18884.298	4.358
1534	-102238.646	-18903.324	19.043
4474	-102238.672	-18905.320	1.996
面積	558.1653710		
地積	558.16 m ²		

1827

地番 長谷町八二			
NO	X	Y	辺長
4470	-102259.243	-18910.074	
4428	-102279.220	-18910.510	19.981
1233	-102279.371	-18903.477	7.034
1248	-102279.807	-18882.827	20.654
1247	-102275.896	-18878.734	5.661
4459	-102259.914	-18878.376	15.986
4469	-102259.335	-18905.739	27.369
4470	-102259.243	-18910.074	4.335
面積	625.4463385		
地積	625.44 m ²		

1828

地番 長谷町八五B			
NO	X	Y	辺長
4473	-102258.815	-18930.301	
4427	-102278.791	-18930.731	19.980
1234	-102278.927	-18924.161	6.571
4428	-102279.220	-18910.510	13.654
4470	-102259.243	-18910.074	19.981
4471	-102259.232	-18910.600	0.526
4472	-102259.021	-18920.584	9.986
4473	-102258.815	-18930.301	9.719
面積	404.1515155		
地積	404.15 m ²		

1829

地番 長谷町一〇C			
NO	X	Y	辺長
4429	-102258.709	-18935.291	
4426	-102278.688	-18935.741	19.984
4427	-102278.791	-18930.731	5.011
4473	-102258.815	-18930.301	19.980
4429	-102258.709	-18935.291	4.991
面積	99.9334800		
地積	99.93 m ²		

1830

地番 保一九ノ一			
NO	X	Y	辺長
4632	-102258.470	-18947.459	
4425	-102278.435	-18947.895	19.969
1235	-102278.501	-18944.781	3.114
4426	-102278.688	-18935.741	9.041
4429	-102258.709	-18935.291	19.984
4632	-102258.470	-18947.459	12.170
面積	242.9956310		
地積	242.99 m ²		

1831

地番 保一九ノ六			
NO	X	Y	辺長
4630	-102263.078	-18951.559	
4423	-102278.350	-18951.885	15.275
4424	-102278.390	-18949.999	1.886
4631	-102263.114	-18949.685	15.279
4630	-102263.078	-18951.559	1.874
面積	28.7272800		
地積	28.72 m ²		

1832

地番 保一九ノ二			
NO	X	Y	辺長
4629	-102262.823	-18964.692	
4421	-102278.072	-18965.011	15.252
4423	-102278.350	-18951.885	13.128
4630	-102263.078	-18951.559	15.275
4629	-102262.823	-18964.692	13.135
面積	200.4486810		
地積	200.44 m ²		

1833

地番 保一九ノ三			
NO	X	Y	辺長
4621	-102257.826	-18968.580	
4623	-102262.406	-18969.243	4.627
4625	-102262.091	-18969.955	0.778
4626	-102266.262	-18972.757	5.024
4627	-102268.695	-18974.734	3.134
4628	-102273.148	-18978.965	6.142
1228	-102277.880	-18974.308	6.639
1227	-102278.068	-18965.202	9.107
4421	-102278.072	-18965.011	0.191
4629	-102262.823	-18964.692	15.252
4622	-102258.052	-18964.592	4.772
4621	-102257.826	-18968.580	3.994
面積	176.5928285		
地積	176.59 m ²		

1834

地番 保一九ノ四			
NO	X	Y	辺長
4628	-102273.148	-18978.965	
4467	-102279.496	-18987.921	10.977
4466	-102283.255	-18991.189	4.980
4419	-102286.883	-18993.066	4.084
4420	-102287.274	-18974.501	18.569
1229	-102286.829	-18974.491	0.445
1228	-102277.880	-18974.308	8.950
4628	-102273.148	-18978.965	6.639
面積	171.7355640		
地積	171.73 m ²		

1835

地番 長谷町九一ノ三			
NO	X	Y	辺長
4419	-102286.883	-18993.066	
4418	-102292.113	-18995.775	5.889
4416	-102296.545	-18998.386	5.143
4413	-102297.025	-18974.710	23.680
4420	-102287.274	-18974.501	9.753
4419	-102286.883	-18993.066	18.569
面積	205.3854520		
地積	205.38 m ²		

1836

地番 長谷町九一ノ四, 長谷町九六			
NO	X	Y	辺長
4416	-102296.545	-18998.386	
4415	-102296.811	-18998.543	0.308
4414	-102300.068	-19000.984	4.070
4407	-102311.257	-19002.981	11.365
1124	-102311.978	-18998.953	4.092
1118	-102319.336	-18979.783	20.533
1117	-102316.170	-18975.124	5.632
1116	-102303.810	-18974.856	12.362
4413	-102297.025	-18974.710	6.786
4416	-102296.545	-18998.386	23.680
面積	501.5305440		
地積	501.53 m ²		


1837

地番 保一九ノ七			
NO	X	Y	辺長
4412	-102298.004	-19012.808	
4408	-102309.142	-19014.801	11.314
4407	-102311.257	-19002.981	12.007
4414	-102300.068	-19000.984	11.365
4412	-102298.004	-19012.808	12.002
面積	136.1434495		
地積	136.14 m ²		

1838

地番 保一九ノ五			
NO	X	Y	辺長
1523	-102297.012	-19025.416	
1146	-102306.998	-19026.731	10.072
1125	-102308.580	-19017.943	8.929
4408	-102309.142	-19014.801	3.191
4412	-102298.004	-19012.808	11.314
4411	-102297.676	-19014.664	1.884
4410	-102297.224	-19019.969	5.324
1523	-102297.012	-19025.416	5.451
面積	134.0103720		
地積	134.01 m ²		

図面の種類	画地出来形確認測量図	
街区名	19	求積表
町名	岩倉長谷町	
京都市岩倉長谷土地区画整理組合		

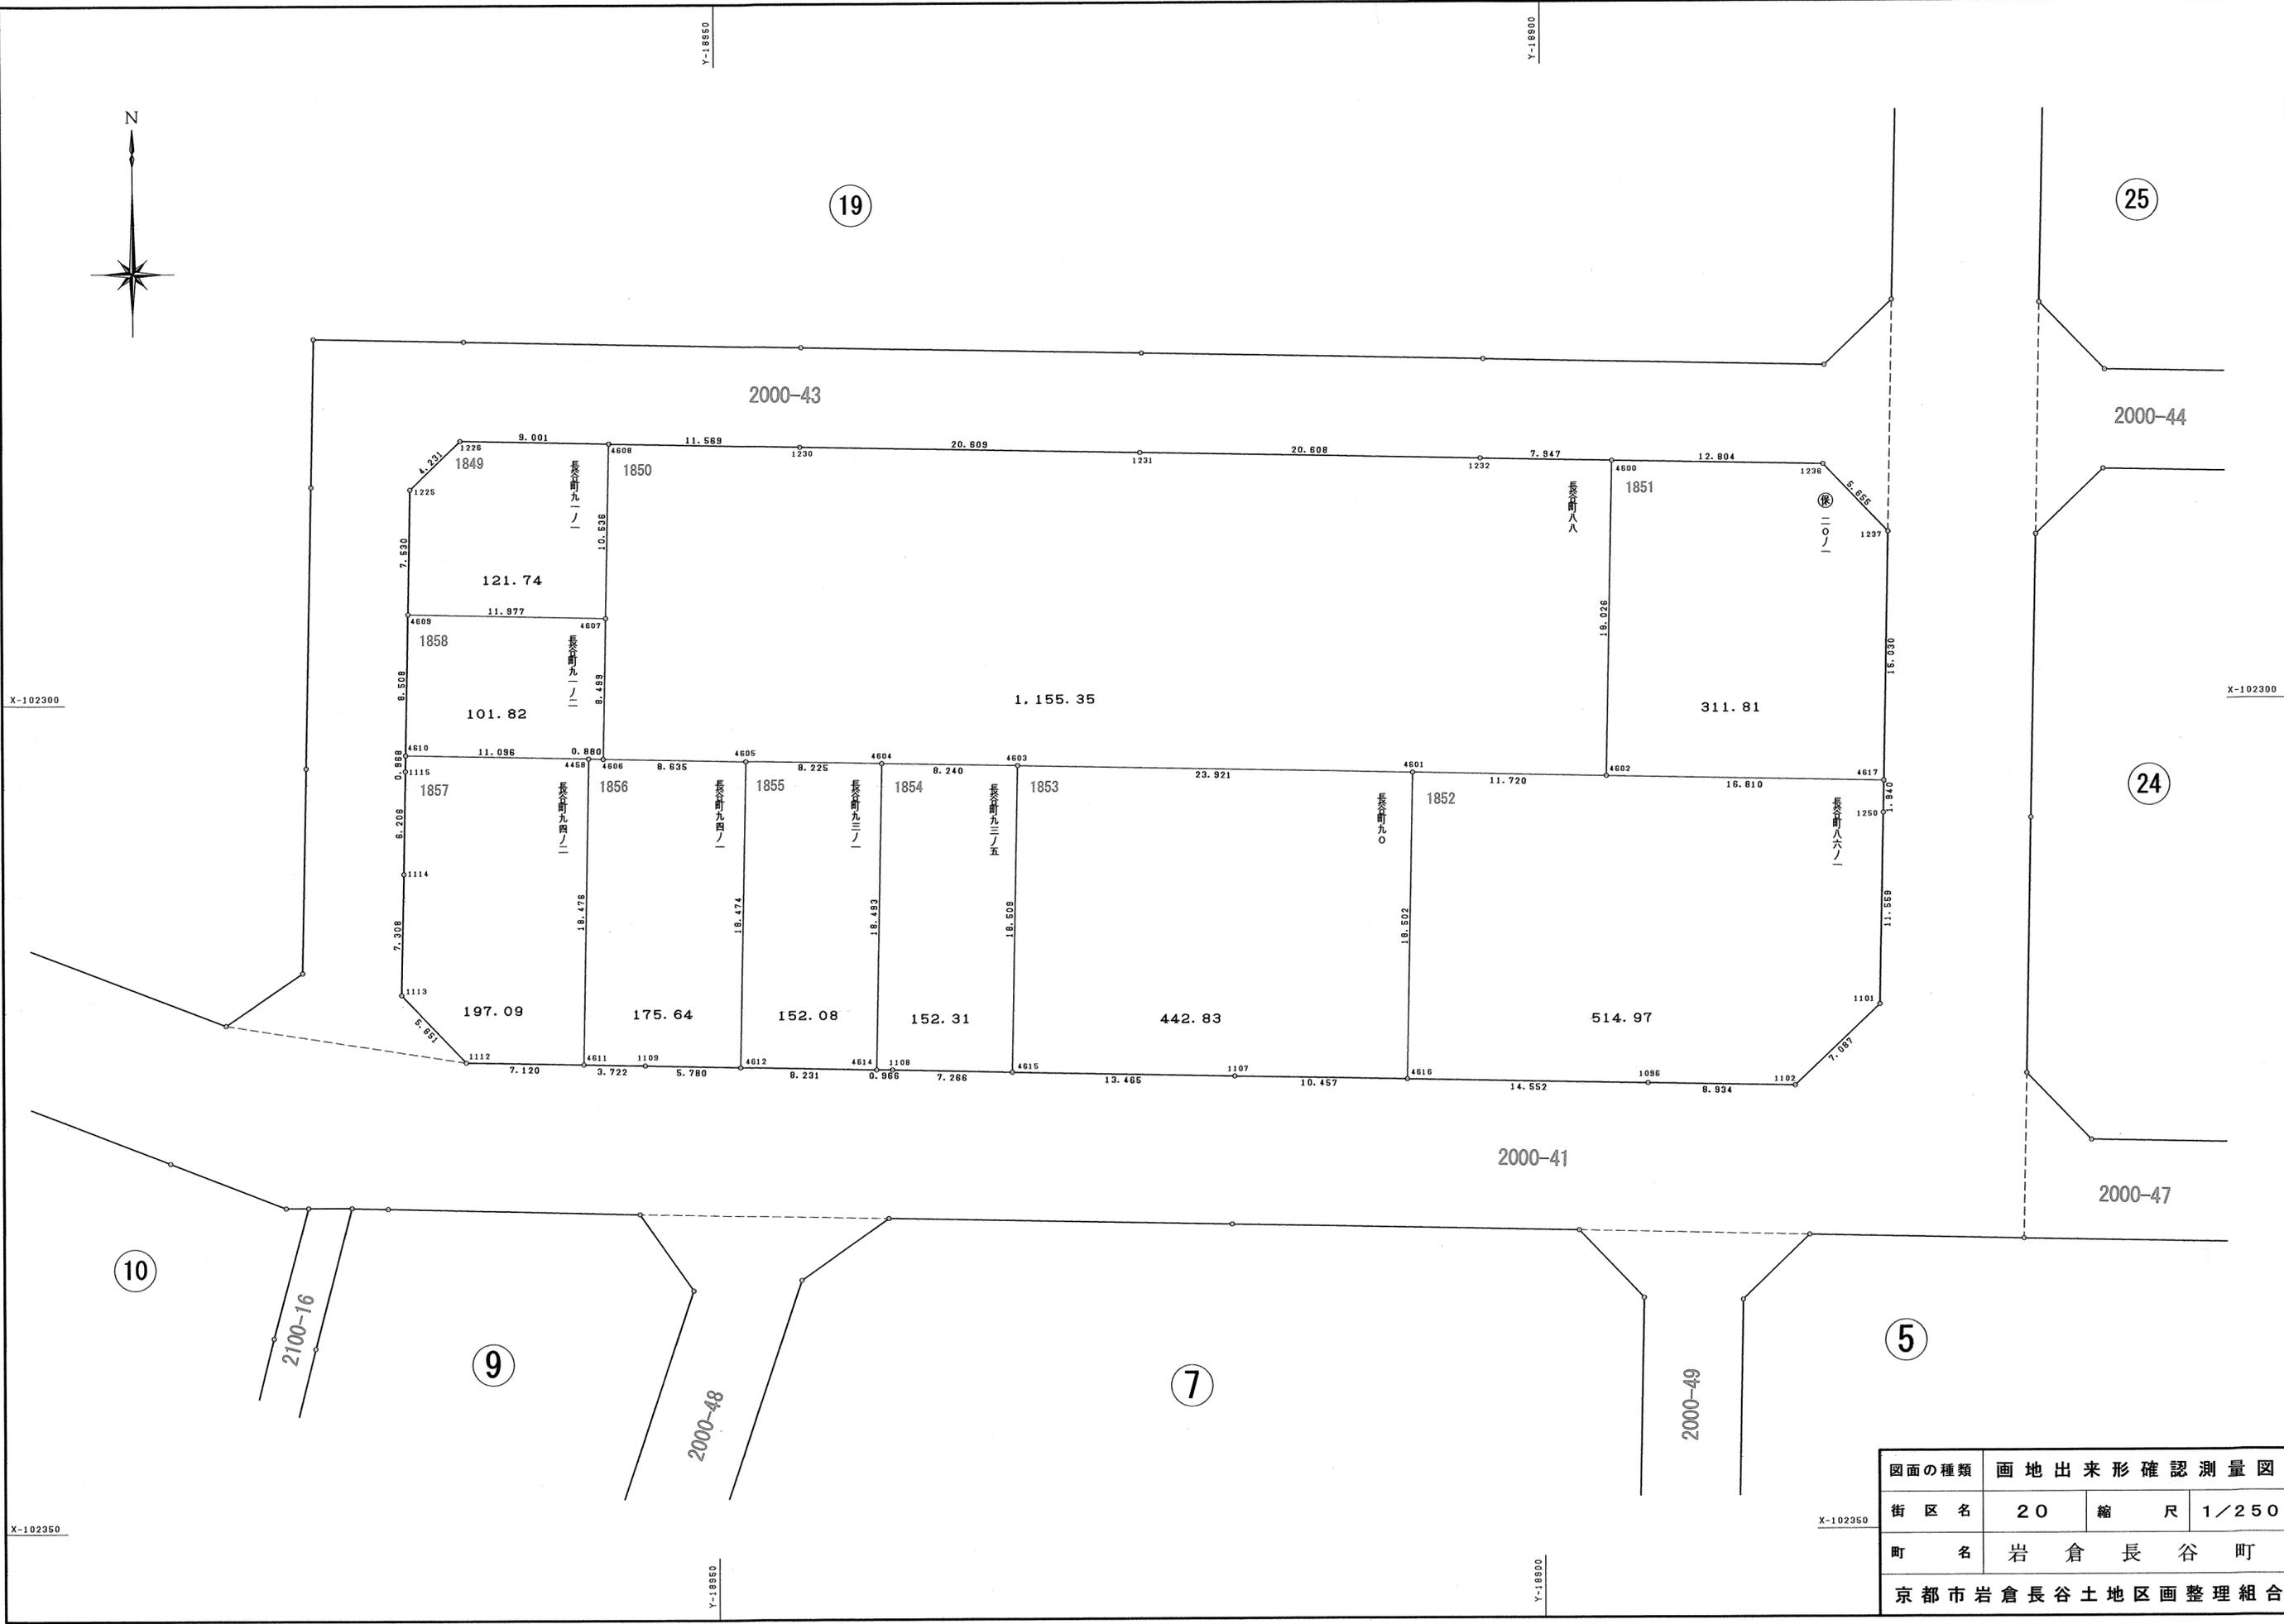

図面の種類	画地出来形確認測量図		
街区名	20	縮尺	1/250
町名	岩倉長谷町		
京都市岩倉長谷土地区画整理組合			

X-102300

X-102300

X-102350

X-102350

Y-18850

Y-18850

Y-18850

Y-18850

1849

地番 長谷町九一ノ一			
N O	X	Y	辺長
1226	-102284.049	-18965.446	
1225	-102286.986	-18968.492	4.231
4609	-102294.515	-18968.649	7.530
4607	-102294.781	-18956.674	11.977
4608	-102284.247	-18956.447	10.536
1226	-102284.049	-18965.446	9.001
面積	121.7474925		
地積	121.74 m ²		

1850

地番 長谷町八八			
N O	X	Y	辺長
4608	-102284.247	-18956.447	
4607	-102294.781	-18956.674	10.536
4606	-102303.279	-18956.853	8.499
4605	-102303.460	-18948.219	8.635
4604	-102303.624	-18939.995	8.225
4603	-102303.791	-18931.756	8.240
4601	-102304.308	-18907.840	23.921
4602	-102304.553	-18896.122	11.720
4600	-102285.531	-18895.725	19.026
1232	-102285.369	-18903.671	7.947
1231	-102284.931	-18924.275	20.608
1230	-102284.502	-18944.880	20.609
4608	-102284.247	-18956.447	11.569
面積	1155.3582065		
地積	1155.35 m ²		

1851

地番 保二〇ノ一			
N O	X	Y	辺長
4600	-102285.531	-18895.725	
4602	-102304.553	-18896.122	19.026
4617	-102304.899	-18879.315	16.810
1237	-102289.872	-18879.006	15.030
1236	-102285.792	-18882.923	5.655
4600	-102285.531	-18895.725	12.804
面積	311.8138605		
地積	311.81 m ²		

1852

地番 長谷町八六ノ一			
N O	X	Y	辺長
4601	-102304.308	-18907.840	
4616	-102322.806	-18908.233	18.502
1096	-102323.099	-18893.683	14.552
1102	-102323.270	-18884.750	8.934
1101	-102318.396	-18879.604	7.087
1250	-102306.839	-18879.355	11.559
4617	-102304.899	-18879.315	1.940
4602	-102304.553	-18896.122	16.810
4601	-102304.308	-18907.840	11.720
面積	514.9747670		
地積	514.97 m ²		

1853

地番 長谷町九〇			
N O	X	Y	辺長
4603	-102303.791	-18931.756	
4615	-102322.296	-18932.150	18.509
1107	-102322.595	-18918.688	13.465
4616	-102322.806	-18908.233	10.457
4601	-102304.308	-18907.840	18.502
4603	-102303.791	-18931.756	23.921
面積	442.8359685		
地積	442.83 m ²		

1854

地番 長谷町九三ノ五			
N O	X	Y	辺長
4604	-102303.624	-18939.995	
4614	-102322.113	-18940.380	18.493
1108	-102322.118	-18939.414	0.966
4615	-102322.296	-18932.150	7.266
4603	-102303.791	-18931.756	18.509
4604	-102303.624	-18939.995	8.240
面積	152.3138950		
地積	152.31 m ²		

1855

地番 長谷町九三ノ一			
N O	X	Y	辺長
4605	-102303.460	-18948.219	
4612	-102321.930	-18948.609	18.474
4614	-102322.113	-18940.380	8.231
4604	-102303.624	-18939.995	18.493
4605	-102303.460	-18948.219	8.225
面積	152.0888380		
地積	152.08 m ²		

1856

地番 長谷町九四ノ一			
N O	X	Y	辺長
4458	-102303.254	-18957.733	
4611	-102321.727	-18958.110	18.476
1109	-102321.801	-18954.388	3.722
4612	-102321.930	-18948.609	5.780
4605	-102303.460	-18948.219	18.474
4606	-102303.279	-18956.853	8.635
4458	-102303.254	-18957.733	0.880
面積	175.6416810		
地積	175.64 m ²		

1857

地番 長谷町九四ノ二			
N O	X	Y	辺長
4610	-102303.022	-18968.827	
1115	-102303.990	-18968.847	0.968
1114	-102310.195	-18968.959	6.206
1113	-102317.501	-18969.135	7.308
1112	-102321.585	-18965.229	5.651
4611	-102321.727	-18958.110	7.120
4458	-102303.254	-18957.733	18.476
4610	-102303.022	-18968.827	11.096
面積	197.0982405		
地積	197.09 m ²		

1858

地番 長谷町九一ノ二			
N O	X	Y	辺長
4609	-102294.515	-18968.649	
4610	-102303.022	-18968.827	8.508
4458	-102303.254	-18957.733	11.096
4606	-102303.279	-18956.853	0.880
4607	-102294.781	-18956.674	8.499
4609	-102294.515	-18968.649	11.977
面積	101.8232690		
地積	101.82 m ²		

図面の種類	画地出来形確認測量図	
街区名	20	求積表
町名	岩倉長谷町	
京都市岩倉長谷土地区画整理組合		

1925

地番 保二一ノ一			
NO	X	Y	辺長
1333	-102333.301	-18835.578	
1332	-102336.401	-18838.491	4.253
1331	-102337.571	-18838.386	1.174
4294	-102338.895	-18835.264	3.391
4293	-102340.349	-18827.821	7.583
4303	-102340.643	-18822.874	4.955
4301	-102333.562	-18822.736	7.082
1333	-102333.301	-18835.578	12.844
面積	92.7590730		
地積	92.75 m ²		

1926

地番 長谷町二七ノ一, 長谷町四〇ノ二, 長谷町四一ノ三			
NO	X	Y	辺長
4301	-102333.562	-18822.736	
4303	-102340.643	-18822.874	7.082
4313	-102364.251	-18813.291	25.478
4311	-102372.825	-18809.250	9.478
4310	-102375.958	-18807.200	3.744
4309	-102377.422	-18804.967	2.670
4308	-102377.647	-18803.137	1.843
4306	-102377.341	-18790.319	12.821
4305	-102377.430	-18787.335	2.985
1314	-102375.680	-18787.297	1.750
4304	-102371.705	-18787.215	3.975
4509	-102371.470	-18798.473	11.260
4508	-102365.493	-18798.348	5.978
4507	-102346.282	-18806.155	20.736
4506	-102346.259	-18807.283	1.128
4505	-102342.177	-18808.940	4.405
4504	-102345.238	-18816.475	8.133
4300	-102333.606	-18820.920	12.452
4301	-102333.562	-18822.736	1.816
面積	548.5659965		
地積	548.56 m ²		

1927

地番 長谷町四一ノ一, 長谷町六八ノ一 長谷町七六			
NO	X	Y	辺長
4300	-102333.606	-18820.920	
4504	-102345.238	-18816.475	12.452
4505	-102342.177	-18808.940	8.133
4506	-102346.259	-18807.283	4.405
4507	-102346.282	-18806.155	1.128
4633	-102346.448	-18798.487	7.669
4634	-102345.763	-18797.481	1.217
4635	-102345.984	-18786.681	10.802
1325	-102337.328	-18786.499	8.657
1324	-102334.273	-18789.439	4.239
1335	-102333.932	-18805.516	16.080
1334	-102333.607	-18820.525	15.012
4300	-102333.606	-18820.920	0.395
面積	361.3129420		
地積	361.31 m ²		



1928

地番 長谷町二七ノ二, 長谷町四〇ノ三, 長谷町四一ノ四, 長谷町六七, 長谷町六八ノ二			
NO	X	Y	辺長
4507	-102346.282	-18806.155	
4508	-102365.493	-18798.348	20.736
4509	-102371.470	-18798.473	5.978
4304	-102371.705	-18787.215	11.260
1313	-102356.330	-18786.899	15.378
4635	-102345.984	-18786.681	10.348
4634	-102345.763	-18797.481	10.802
4633	-102346.448	-18798.487	1.217
4507	-102346.282	-18806.155	7.669
面積	367.7246030		
地積	367.72 m ²		

1929

地番 保二一ノ二			
NO	X	Y	辺長
4306	-102377.341	-18790.319	
1315	-102383.925	-18787.478	7.170
4305	-102377.430	-18787.335	6.496
4306	-102377.341	-18790.319	2.985
面積	9.6969035		
地積	9.69 m ²		

図面の種類	画地出来形確認測量図	
街区名	21	求積表
町名	岩倉長谷町	
京都市岩倉長谷土地区画整理組合		

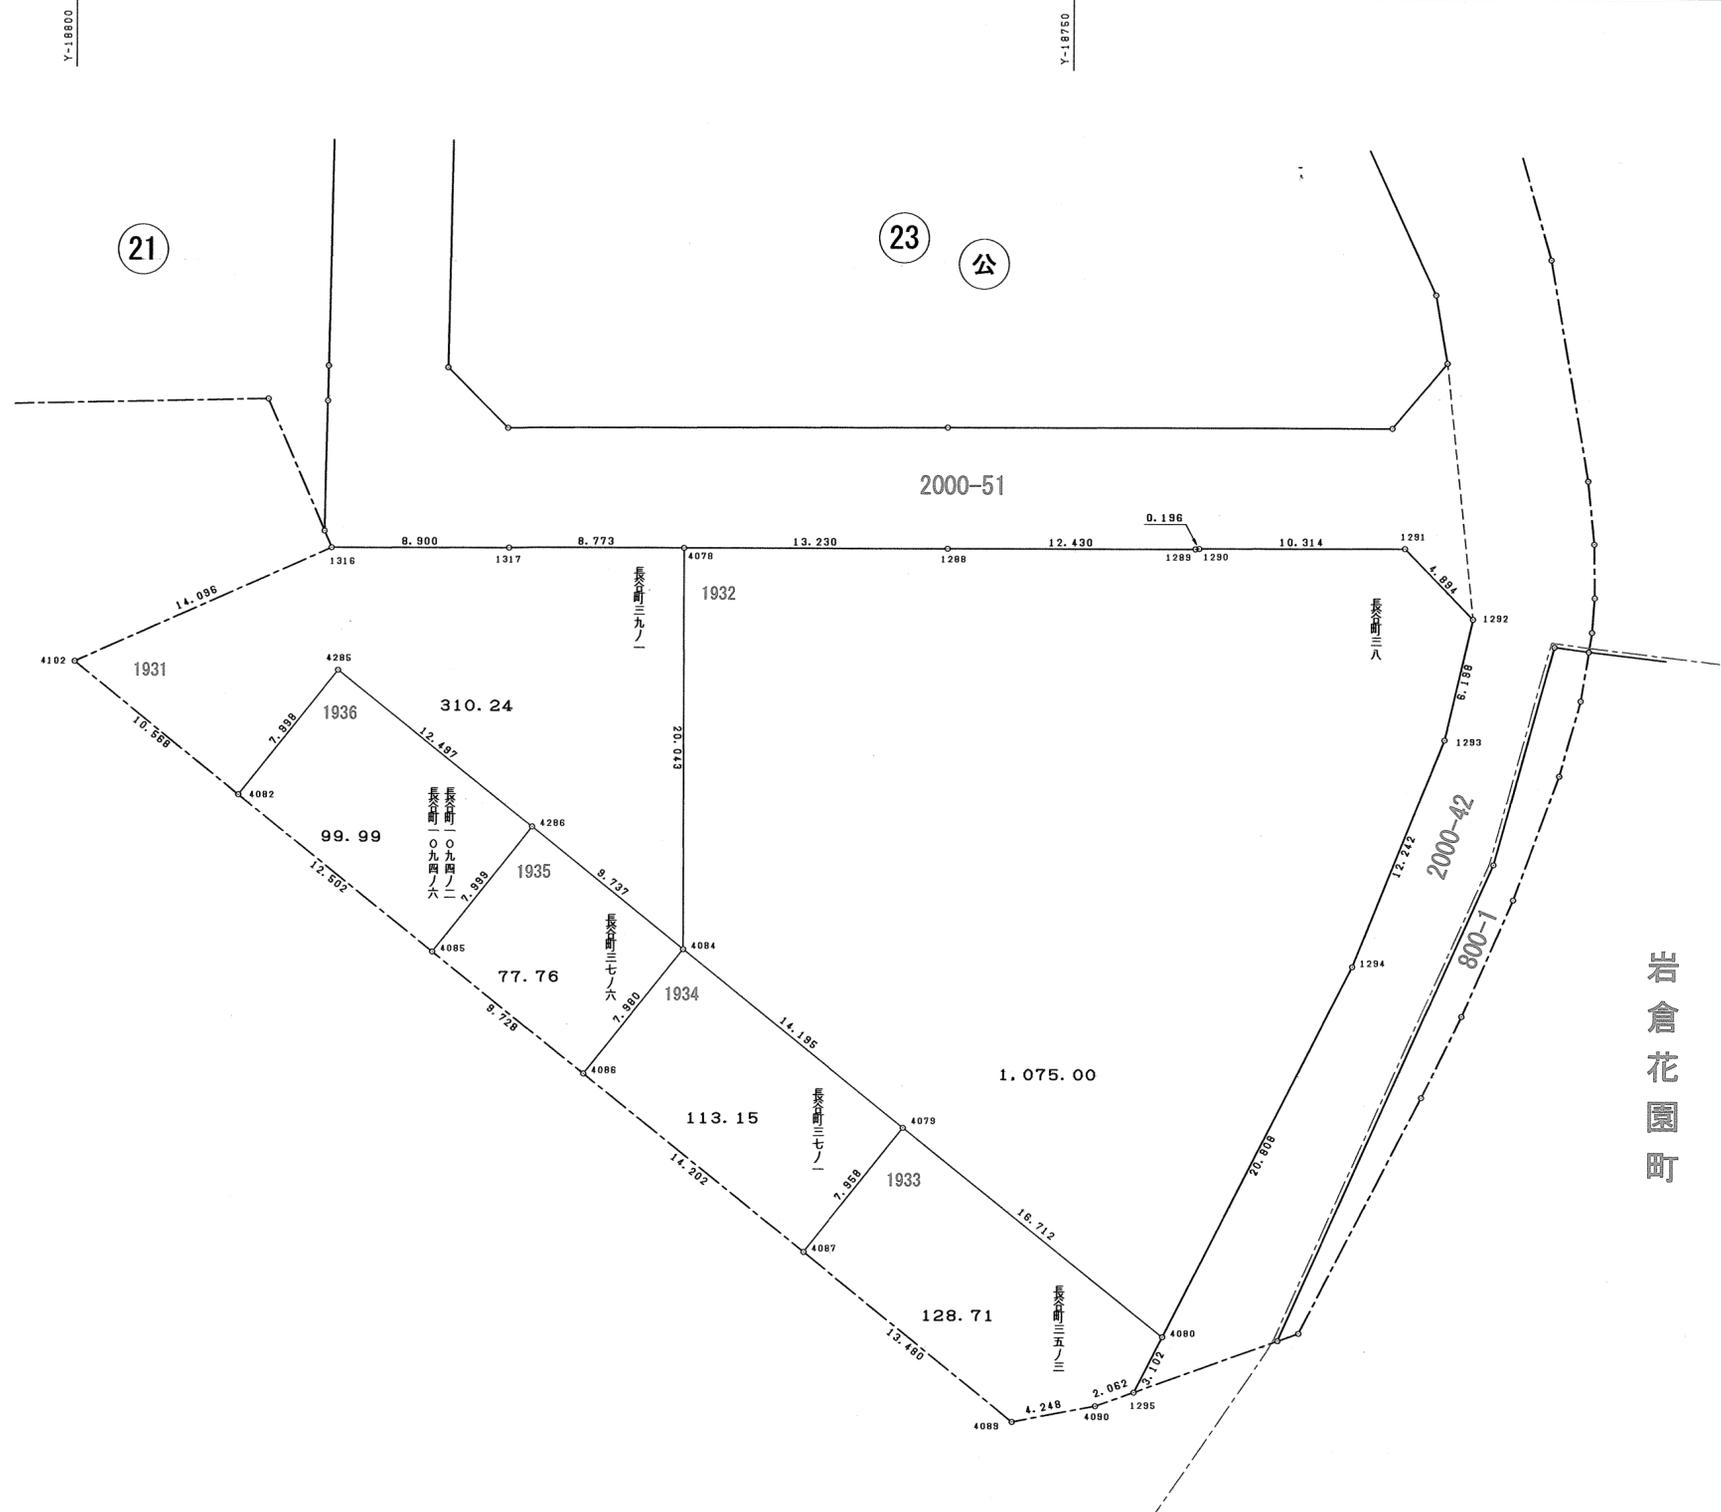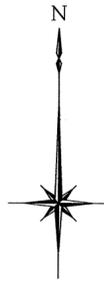

岩倉花園町

図面の種類	画地出来形確認測量図		
街区名	22	縮尺	1/250
町名	岩倉長谷町		
京都市岩倉長谷土地区画整理組合			

1931

地番 長谷町三九ノ一			
N O	X	Y	辺長
1316	-102384.760	-18787.117	
4102	-102390.497	-18799.993	14.096
4082	-102397.123	-18791.759	10.568
4285	-102390.873	-18786.767	7.998
4286	-102398.667	-18776.998	12.497
4084	-102404.768	-18769.409	9.737
4078	-102384.725	-18769.444	20.043
1317	-102384.730	-18778.217	8.773
1316	-102384.760	-18787.117	8.900
面積	310.2462425		
地積	310.24 m ²		

1932

地番 長谷町三八			
N O	X	Y	辺長
4078	-102384.725	-18769.444	
4084	-102404.768	-18769.409	20.043
4079	-102413.655	-18758.340	14.195
4080	-102424.084	-18745.281	16.712
1294	-102405.546	-18735.830	20.808
1293	-102394.188	-18731.260	12.242
1292	-102388.149	-18729.865	6.198
1291	-102384.639	-18733.276	4.894
1290	-102384.682	-18743.590	10.314
1289	-102384.711	-18743.784	0.196
1288	-102384.718	-18756.214	12.430
4078	-102384.725	-18769.444	13.230
面積	1075.0077020		
地積	1075.00 m ²		

1933

地番 長谷町三五ノ三			
N O	X	Y	辺長
4079	-102413.655	-18758.340	
4087	-102419.876	-18763.304	7.958
4089	-102428.334	-18752.807	13.480
4090	-102427.538	-18748.634	4.248
1295	-102426.848	-18746.690	2.062
4080	-102424.084	-18745.281	3.102
4079	-102413.655	-18758.340	16.712
面積	128.7111565		
地積	128.71 m ²		

1934

地番 長谷町三七ノ一			
N O	X	Y	辺長
4084	-102404.768	-18769.409	
4086	-102411.001	-18774.392	7.980
4087	-102419.876	-18763.304	14.202
4079	-102413.655	-18758.340	7.958
4084	-102404.768	-18769.409	14.195
面積	113.1554730		
地積	113.15 m ²		

1935

地番 長谷町三七ノ六			
N O	X	Y	辺長
4286	-102398.667	-18776.998	
4085	-102404.921	-18781.986	7.999
4086	-102411.001	-18774.392	9.728
4084	-102404.768	-18769.409	7.980
4286	-102398.667	-18776.998	9.737
面積	77.7617180		
地積	77.76 m ²		

1936


地番 長谷町一〇九四ノ二, 長谷町一〇九四ノ六			
N O	X	Y	辺長
4285	-102390.873	-18786.767	
4082	-102397.123	-18791.759	7.998
4085	-102404.921	-18781.986	12.502
4286	-102398.667	-18776.998	7.999
4285	-102390.873	-18786.767	12.497
面積	99.9903320		
地積	99.99 m ²		

図面の種類	画地出来形確認測量図	
街区名	22	求積表
町名	岩倉長谷町	
京都市岩倉長谷土地区画整理組合		

1930

4号公園			
地番	X	Y	辺長
1321	-102334.536	-18777.468	
1320	-102337.490	-18780.514	4.243
1319	-102356.530	-18780.916	19.044
1312	-102375.733	-18781.306	19.206
1311	-102378.741	-18778.295	4.256
1310	-102378.664	-18756.225	22.070
1298	-102378.637	-18733.937	22.288
1297	-102375.364	-18731.200	4.266
1296	-102371.959	-18731.788	3.455
1303	-102353.752	-18740.176	20.046
1302	-102347.967	-18743.395	6.620
1301	-102340.964	-18746.380	7.612
1300	-102337.985	-18747.305	3.119
1281	-102335.051	-18751.205	4.880
1337	-102334.814	-18763.975	12.772
1321	-102334.536	-18777.468	13.495
面積	1818.9695350		
地積	1818.96 m ²		

図面の種類	画地出来形確認測量図	
街区名	23	求積表
町名	岩倉長谷町	
京都市岩倉長谷土地区画整理組合		

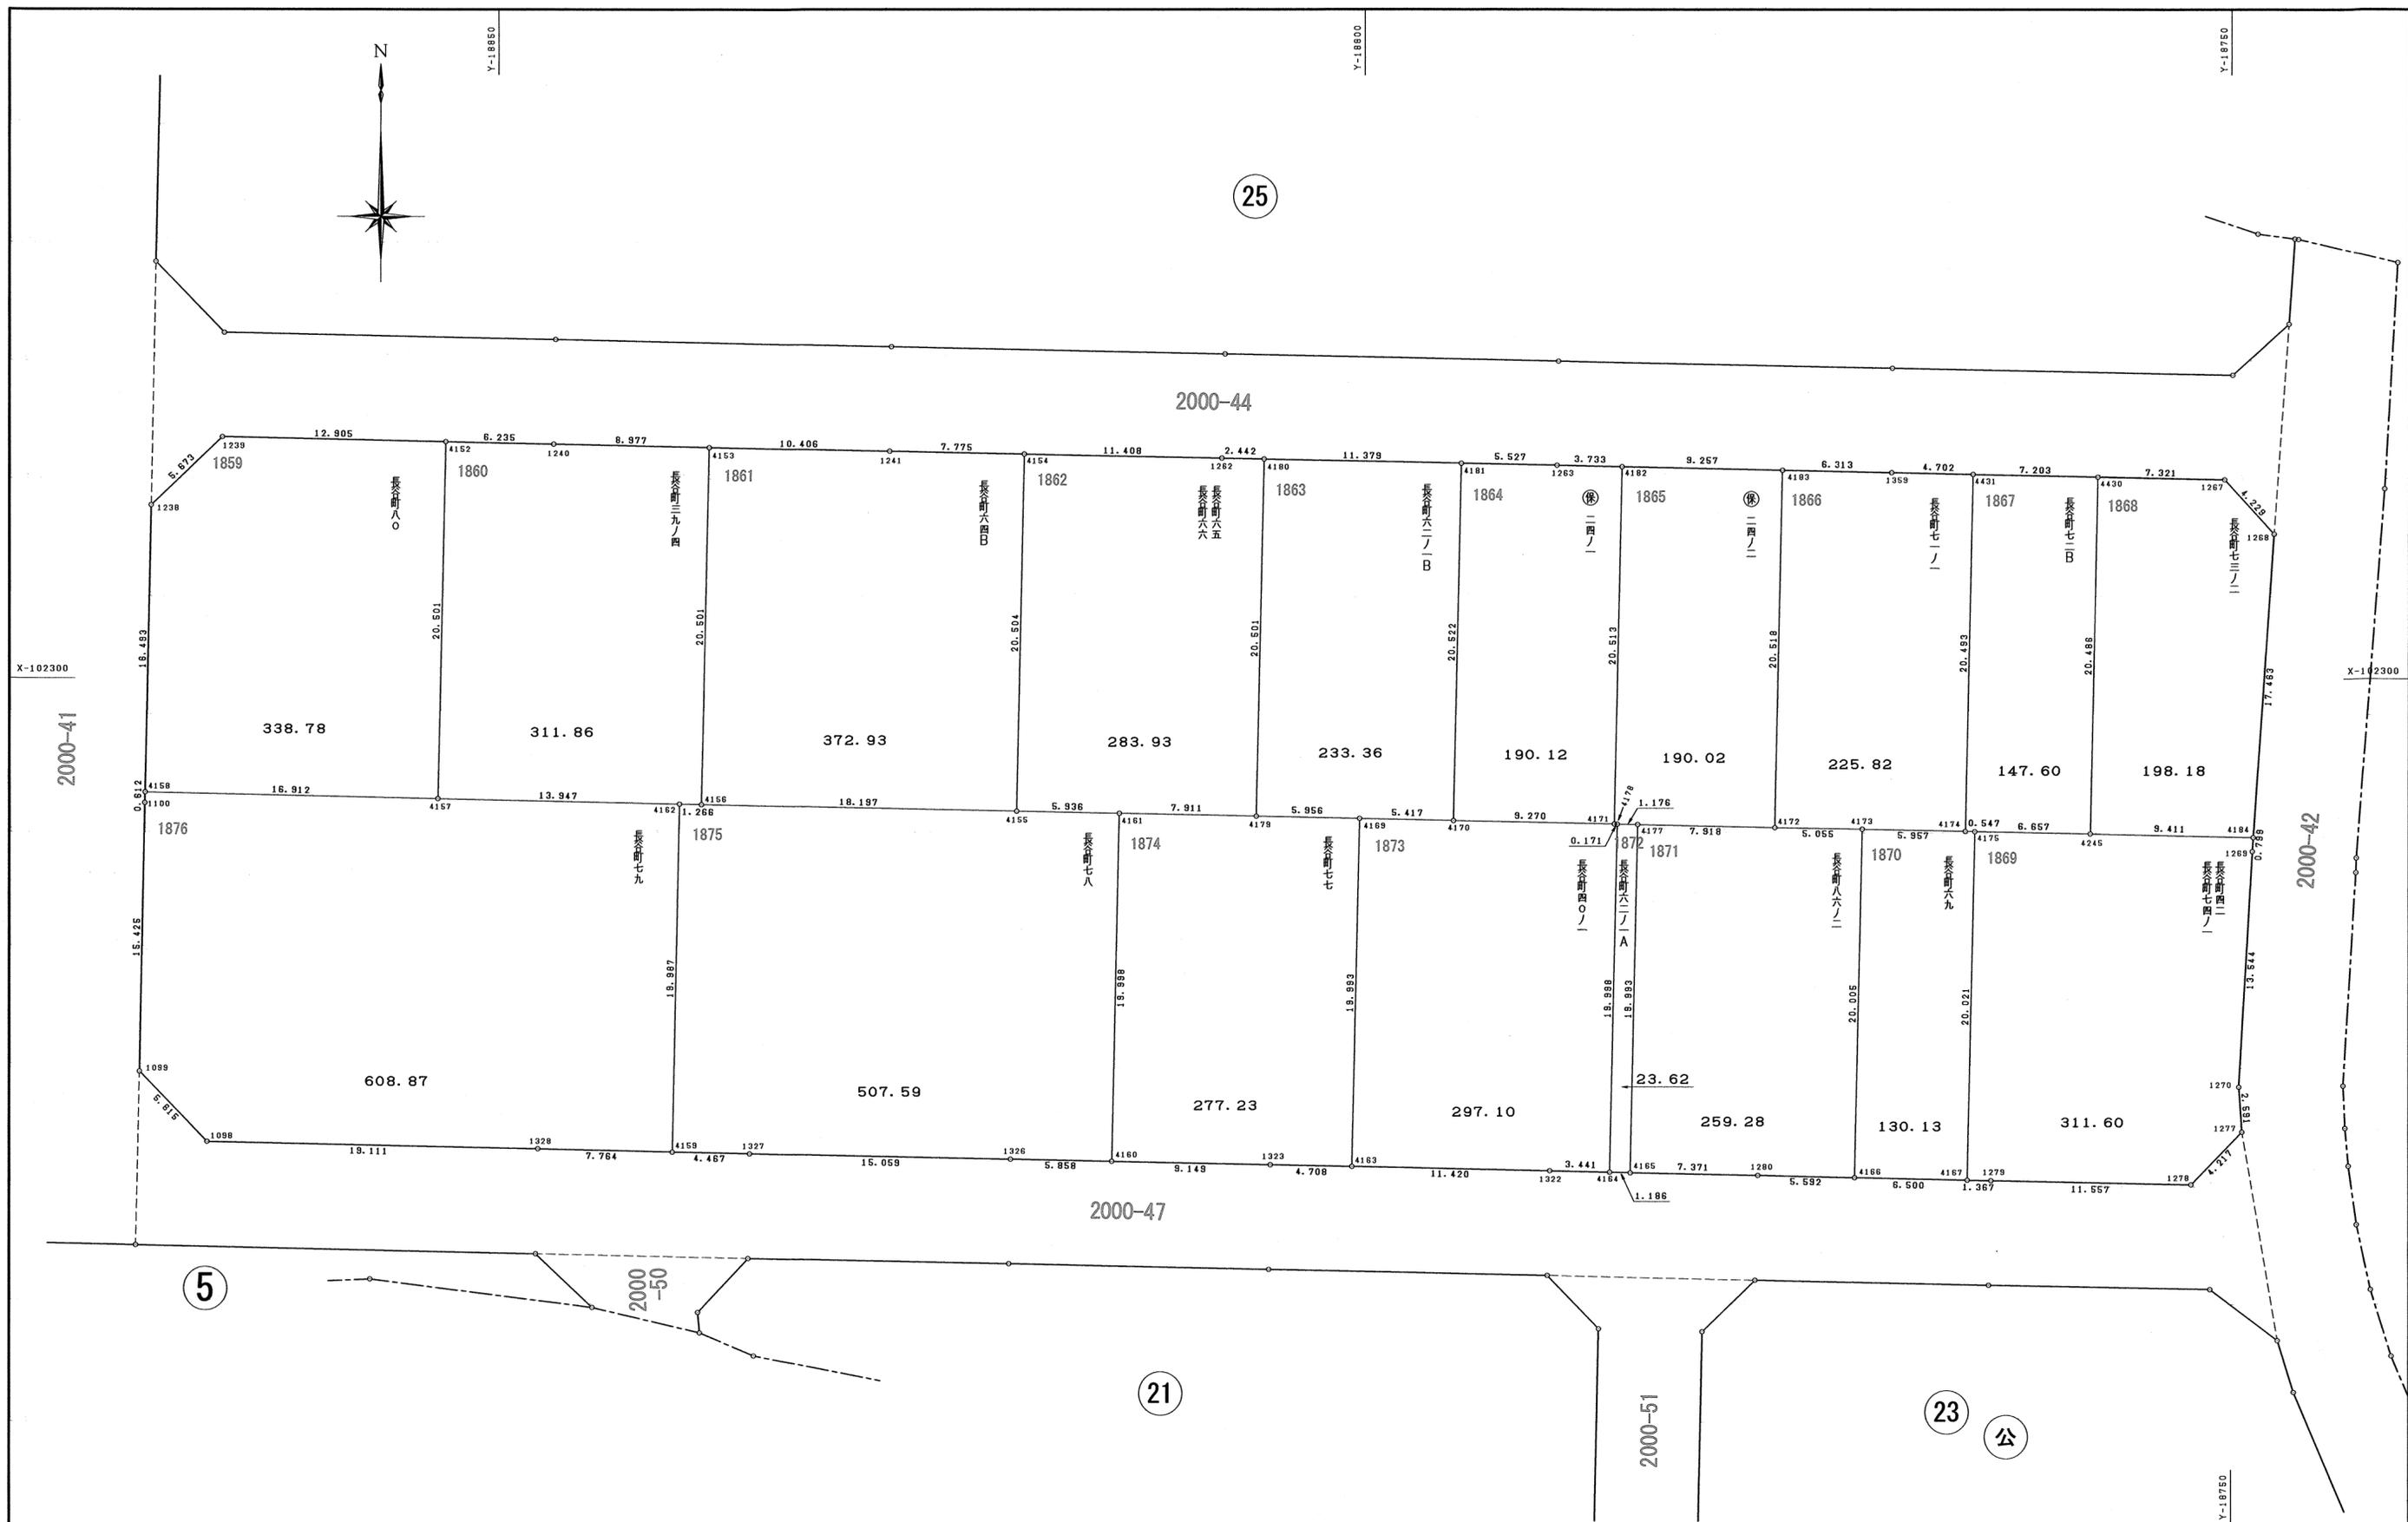

5

21

23

公

X-102350		Y-18850		Y-18850		Y-18750		X-102350	
図面の種類	画地出来形確認測量図								
街区名	24	縮尺	1/250						
町名	岩倉長谷町								
京都市岩倉長谷土地区画整理組合									

1859

地番 長谷町八〇			
NO	X	Y	辺長
1239	-102286.142	-18865.960	
1238	-102290.062	-18870.061	5.673
4158	-102306.552	-18870.409	16.493
4157	-102306.913	-18853.500	16.912
4152	-102286.416	-18853.057	20.501
1239	-102286.142	-18865.960	12.905
面積	338.7871410		
地積	338.78 m ²		

1860

地番 長谷町三九ノ四			
NO	X	Y	辺長
4152	-102286.416	-18853.057	
4157	-102306.913	-18853.500	20.501
4162	-102307.203	-18839.556	13.947
4156	-102307.233	-18838.290	1.266
4153	-102286.736	-18837.847	20.501
1240	-102286.548	-18846.823	8.977
4152	-102286.416	-18853.057	6.235
面積	311.8691200		
地積	311.86 m ²		

1861

地番 長谷町六四B			
NO	X	Y	辺長
4153	-102286.736	-18837.847	
4156	-102307.233	-18838.290	20.501
4155	-102307.614	-18820.096	18.197
4154	-102287.114	-18819.669	20.504
1241	-102286.954	-18827.443	7.775
4153	-102286.736	-18837.847	10.406
面積	372.9357575		
地積	372.93 m ²		

1862

地番 長谷町六五, 長谷町六六			
NO	X	Y	辺長
4154	-102287.114	-18819.669	
4155	-102307.614	-18820.096	20.504
4161	-102307.732	-18814.161	5.936
4179	-102307.897	-18806.251	7.911
4180	-102287.400	-18805.821	20.501
1262	-102287.349	-18808.263	2.442
4154	-102287.114	-18819.669	11.408
面積	283.9353590		
地積	283.93 m ²		

1863

地番 長谷町六二ノ一B			
NO	X	Y	辺長
4180	-102287.400	-18805.821	
4179	-102307.897	-18806.251	20.501
4169	-102308.032	-18800.296	5.956
4170	-102308.153	-18794.880	5.417
4181	-102287.635	-18794.444	20.522
4180	-102287.400	-18805.821	11.379
面積	233.3639090		
地積	233.36 m ²		

1864

地番 保二四ノ一			
NO	X	Y	辺長
4181	-102287.635	-18794.444	
4170	-102308.153	-18794.880	20.522
4171	-102308.340	-18785.611	9.270
4182	-102287.831	-18785.185	20.513
1263	-102287.750	-18788.918	3.733
4181	-102287.635	-18794.444	5.527
面積	190.1287560		
地積	190.12 m ²		

1865

地番 保二四ノ二			
NO	X	Y	辺長
4182	-102287.831	-18785.185	
4171	-102308.340	-18785.611	20.513
4178	-102308.343	-18785.440	0.171
4177	-102308.373	-18784.264	1.176
4172	-102308.547	-18776.347	7.918
4183	-102288.033	-18775.930	20.518
4182	-102287.831	-18785.185	9.257
面積	190.0250715		
地積	190.02 m ²		

1866

地番 長谷町七一ノ一			
NO	X	Y	辺長
4183	-102288.033	-18775.930	
4172	-102308.547	-18776.347	20.518
4173	-102308.639	-18771.292	5.055
4174	-102308.756	-18765.336	5.957
4431	-102288.267	-18764.916	20.493
1359	-102288.171	-18769.618	4.702
4183	-102288.033	-18775.930	6.313
面積	225.8222630		
地積	225.82 m ²		

1867

地番 長谷町七二B			
NO	X	Y	辺長
4431	-102288.267	-18764.916	
4174	-102308.756	-18765.336	20.493
4175	-102308.765	-18764.789	0.547
4245	-102308.899	-18758.133	6.657
4430	-102288.417	-18757.714	20.486
4431	-102288.267	-18764.916	7.203
面積	147.6015735		
地積	147.60 m ²		

1868

地番 長谷町七三ノ二			
NO	X	Y	辺長
4430	-102288.417	-18757.714	
4245	-102308.899	-18758.133	20.486
4184	-102309.111	-18748.724	9.411
1268	-102291.688	-18747.538	17.463
1267	-102288.569	-18750.394	4.229
4430	-102288.417	-18757.714	7.321
面積	198.1883940		
地積	198.18 m ²		

1869

地番 長谷町四二, 長谷町七四ノ一			
NO	X	Y	辺長
4175	-102308.765	-18764.789	
4167	-102328.782	-18765.217	20.021
1279	-102328.812	-18763.850	1.367
1278	-102329.046	-18752.295	11.557
1277	-102326.017	-18749.360	4.217
1270	-102323.432	-18749.547	2.591
1269	-102309.909	-18748.778	13.544
4184	-102309.111	-18748.724	0.799
4245	-102308.899	-18758.133	9.411
4175	-102308.765	-18764.789	6.657
面積	311.6058245		
地積	311.60 m ²		

1870

地番 長谷町六九			
NO	X	Y	辺長
4173	-102308.639	-18771.292	
4166	-102328.640	-18771.716	20.005
4167	-102328.782	-18765.217	6.500
4175	-102308.765	-18764.789	20.021
4174	-102308.756	-18765.336	0.547
4173	-102308.639	-18771.292	5.957
面積	130.1303955		
地積	130.13 m ²		

1871

地番 長谷町八六ノ二			
NO	X	Y	辺長
4177	-102308.373	-18784.264	
4165	-102328.362	-18784.677	19.993
1280	-102328.517	-18777.307	7.371
4166	-102328.640	-18771.716	5.592
4173	-102308.639	-18771.292	20.005
4172	-102308.547	-18776.347	5.055
4177	-102308.373	-18784.264	7.918
面積	259.2834440		
地積	259.28 m ²		

1872

地番 長谷町六二ノ一A			
NO	X	Y	辺長
4178	-102308.343	-18785.440	
4164	-102328.337	-18785.863	19.998
4165	-102328.362	-18784.677	1.186
4177	-102308.373	-18784.264	19.993
4178	-102308.343	-18785.440	1.176
面積	23.6214565		
地積	23.62 m ²		

1873

地番 長谷町四〇ノ一			
NO	X	Y	辺長
4169	-102308.032	-18800.296	
4163	-102328.021	-18800.722	19.993
1322	-102328.265	-18789.304	11.420
4164	-102328.337	-18785.863	3.441
4178	-102308.343	-18785.440	19.998
4171	-102308.340	-18785.611	0.171
4170	-102308.153	-18794.880	9.270
4169	-102308.032	-18800.296	5.417
面積	297.1068610		
地積	297.10 m ²		

1874

地番 長谷町七七			
NO	X	Y	辺長
4161	-102307.732	-18814.161	
4160	-102327.726	-18814.576	19.998
1323	-102327.920	-18805.429	9.149
4163	-102328.021	-18800.722	4.708
4169	-102308.032	-18800.296	19.993
4179	-102307.897	-18806.251	5.956
4161	-102307.732	-18814.161	7.911
面積	277.2345860		
地積	277.23 m ²		

1875

地番 長谷町七八			
NO	X	Y	辺長
4162	-102307.203	-18839.556	
4159	-102327.187	-18839.955	19.987
1327	-102327.283	-18835.489	4.467
1326	-102327.602	-18820.433	15.059
4160	-102327.726	-18814.576	5.858
4161	-102307.732	-18814.161	19.998
4155	-102307.614	-18820.096	5.936
4156	-102307.233	-18838.290	18.197
4162	-102307.203	-18839.556	1.266
面積	507.5901660		
地積	507.59 m ²		

1876

地番 長谷町七九			
NO	X	Y	辺長
4158	-102306.552	-18870.409	
1100	-102307.164	-18870.422	0.612
1099	-102322.586	-18870.727	15.425
1098	-102326.625	-18866.825	5.615
1328	-102327.019	-18847.718	19.111
4159	-102327.187	-18839.955	7.764
4162	-102307.203	-18839.556	19.987
4157	-102306.913	-18853.500	13.947
4158	-102306.552	-18870.409	16.912
面積	608.8773855		
地積	608.87 m ²		

図面の種類	画地出来形確認測量図		
街区名	24	求積表	
町名	岩倉長谷町		
京都市岩倉長谷土地区画整理組合			

1839

地番 長谷町八一			
NO	X	Y	辺長
1254	-102238.495	-18862.315	
1253	-102238.490	-18862.535	0.220
1252	-102244.609	-18869.083	8.962
1251	-102259.131	-18869.424	14.526
1246	-102276.085	-18869.803	16.958
1245	-102280.156	-18865.850	5.674
4208	-102280.437	-18851.867	13.985
4209	-102259.543	-18851.419	20.898
4215	-102238.284	-18850.987	21.263
1254	-102238.495	-18862.315	11.329
面積	725.3606140		
地積	725.36 m ²		

1840

地番 長谷町六三ノ一			
NO	X	Y	辺長
4215	-102238.284	-18850.987	
4209	-102259.543	-18851.419	21.263
4210	-102259.879	-18835.670	15.752
4211	-102260.114	-18824.730	10.942
4212	-102254.238	-18824.602	5.877
4216	-102237.835	-18826.961	16.571
4215	-102238.284	-18850.987	24.030
面積	559.9204945		
地積	559.92 m ²		

1841

地番 保二五ノ二			
NO	X	Y	辺長
4211	-102260.114	-18824.730	
4206	-102280.999	-18825.173	20.889
4205	-102281.228	-18814.454	10.721
4456	-102254.620	-18813.911	26.613
4214	-102254.820	-18822.569	8.660
4212	-102254.238	-18824.602	2.114
4211	-102260.114	-18824.730	5.877
面積	283.1400640		
地積	283.14 m ²		

1842

地番 保二五ノ一			
NO	X	Y	辺長
4456	-102254.620	-18813.911	
4205	-102281.228	-18814.454	26.613
1266	-102281.364	-18808.084	6.371
4188	-102281.456	-18803.746	4.338
4203	-102254.382	-18803.192	27.079
4456	-102254.620	-18813.911	10.721
面積	287.5602750		
地積	287.56 m ²		

1843

地番 長谷町三九ノ三			
NO	X	Y	辺長
4203	-102254.382	-18803.192	
4188	-102281.456	-18803.746	27.079
4204	-102281.646	-18794.860	8.888
4202	-102254.067	-18794.283	27.585
4203	-102254.382	-18803.192	8.914
面積	243.1021900		
地積	243.10 m ²		

1844

地番 長谷町六一ノ一			
NO	X	Y	辺長
4202	-102254.067	-18794.283	
4204	-102281.646	-18794.860	27.585
1265	-102281.774	-18788.832	6.029
4187	-102281.819	-18786.628	2.204
4199	-102270.481	-18786.387	11.340
4200	-102260.499	-18790.999	10.995
4201	-102254.018	-18792.883	6.749
4202	-102254.067	-18794.283	1.400
面積	166.4519215		
地積	166.45 m ²		

1845

地番 長谷町七二A			
NO	X	Y	辺長
4199	-102270.481	-18786.387	
4187	-102281.819	-18786.628	11.340
1264	-102282.170	-18769.577	17.054
4186	-102282.187	-18768.759	0.818
4194	-102271.017	-18768.533	11.172
4195	-102270.862	-18772.976	4.445
4196	-102269.795	-18778.923	6.041
4197	-102269.682	-18781.672	2.751
4199	-102270.481	-18786.387	4.782
面積	208.6969375		
地積	208.69 m ²		

1846

地番 長谷町七三ノ一			
NO	X	Y	辺長
4194	-102271.017	-18768.533	
4186	-102282.187	-18768.759	11.172
1276	-102282.573	-18749.930	18.832
1275	-102279.650	-18746.688	4.365
1274	-102274.758	-18746.354	4.903
4001	-102274.479	-18748.496	2.160
4189	-102273.416	-18751.625	3.304
4190	-102272.096	-18755.687	4.271
4191	-102271.266	-18758.455	2.889
4192	-102270.816	-18762.901	4.468
4193	-102271.118	-18765.624	2.739
4194	-102271.017	-18768.533	2.910
面積	221.5813680		
地積	221.58 m ²		



1847

地番 長谷町七〇			
NO	X	Y	辺長
4210	-102259.879	-18835.670	
4207	-102280.766	-18836.118	20.891
1243	-102280.953	-18827.349	8.770
4206	-102280.999	-18825.173	2.176
4211	-102260.114	-18824.730	20.889
4210	-102259.879	-18835.670	10.942
面積	228.6510710		
地積	228.65 m ²		

1848

地番 長谷町六四A			
NO	X	Y	辺長
4209	-102259.543	-18851.419	
4208	-102280.437	-18851.867	20.898
1244	-102280.541	-18846.720	5.148
4207	-102280.766	-18836.118	10.604
4210	-102259.879	-18835.670	20.891
4209	-102259.543	-18851.419	15.752
面積	329.1257110		
地積	329.12 m ²		

図面の種類	画地出来形確認測量図	
街区名	25	求積表
町名	岩倉長谷町	
京都市岩倉長谷土地区画整理組合		

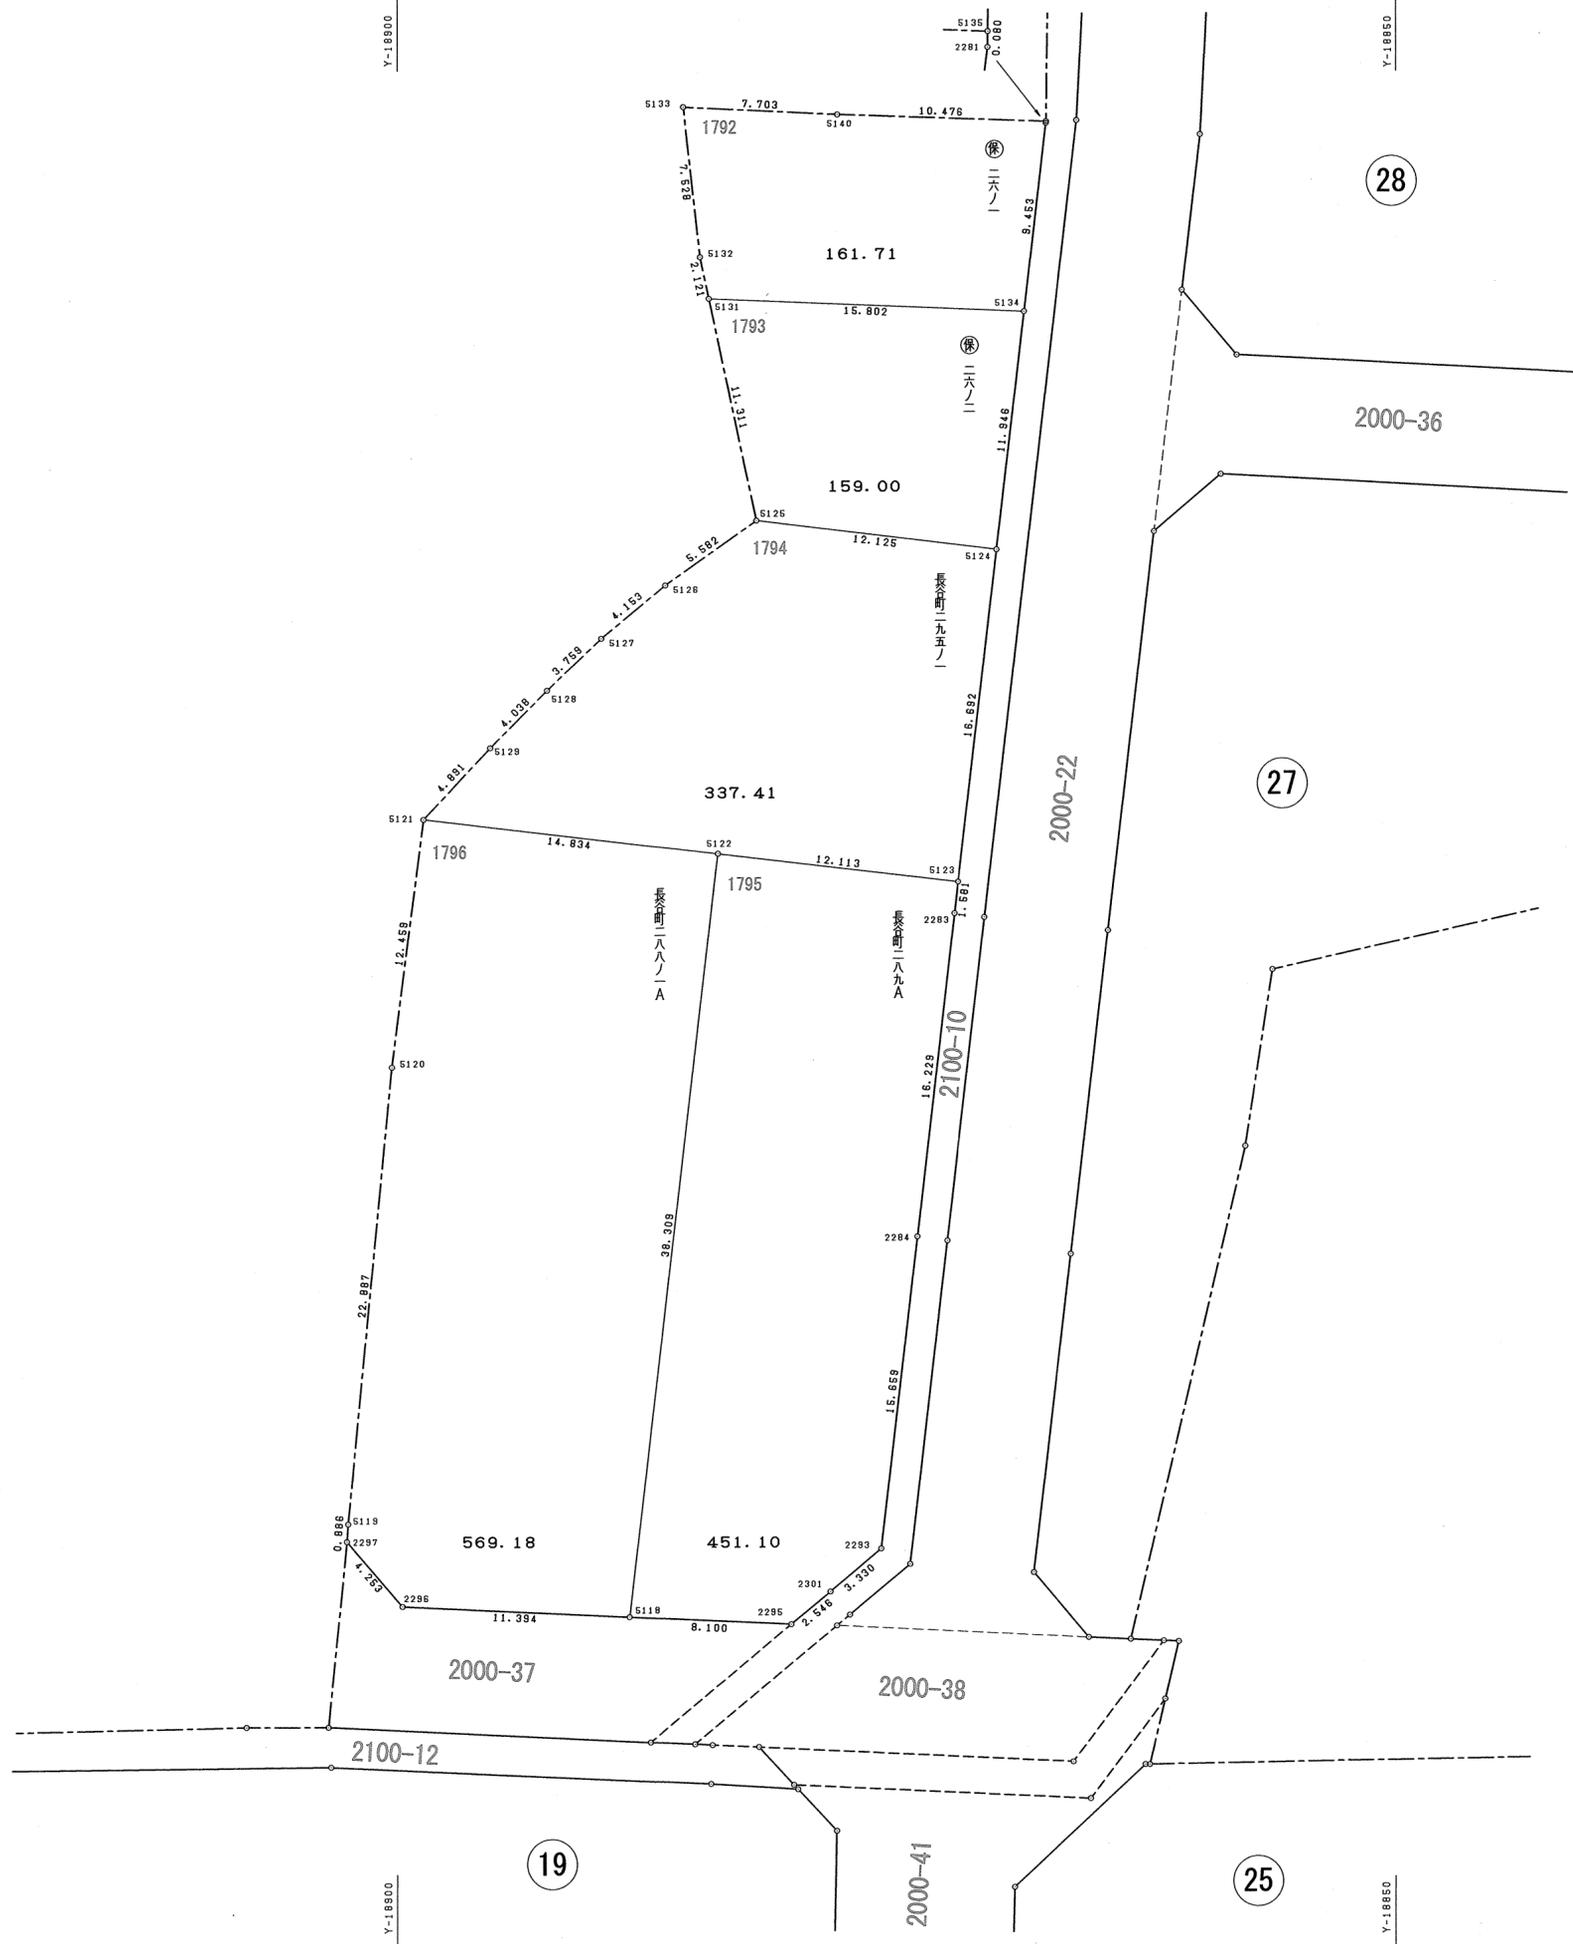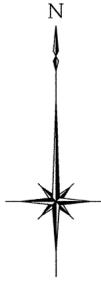

X-102300

X-102300

Y-18850

Y-18850

図面の種類	画地出来形確認測量図		
街区名	26	縮尺	1/250
町名	岩倉長谷町		
京都市岩倉長谷土地区画整理組合			

1792

地番	保二六ノ一		
NO	X	Y	辺長
5133	-102155.846	-18885.679	
5132	-102163.328	-18884.844	7.528
5131	-102165.403	-18884.400	2.121
5134	-102166.033	-18868.610	15.802
2281	-102156.643	-18867.517	9.453
5135	-102156.563	-18867.513	0.080
5140	-102156.212	-18877.984	10.476
5133	-102155.846	-18885.679	7.703
面積	161.7128255		
地積	161.71 m ²		

1793

地番	保二六ノ二		
NO	X	Y	辺長
5131	-102165.403	-18884.400	
5125	-102176.464	-18882.031	11.311
5124	-102177.899	-18869.991	12.125
5134	-102166.033	-18868.610	11.946
5131	-102165.403	-18884.400	15.802
面積	159.0045475		
地積	159.00 m ²		

1794

地番	長谷町二九五ノ一		
NO	X	Y	辺長
5125	-102176.464	-18882.031	
5126	-102179.692	-18886.586	5.582
5127	-102182.337	-18889.788	4.153
5128	-102184.931	-18892.509	3.759
5129	-102187.801	-18895.350	4.038
5121	-102191.375	-18898.689	4.891
5122	-102193.082	-18883.953	14.834
5123	-102194.480	-18871.920	12.113
5124	-102177.899	-18869.991	16.692
5125	-102176.464	-18882.031	12.125
面積	337.4182635		
地積	337.41 m ²		

1795

地番	長谷町二八九A		
NO	X	Y	辺長
5122	-102193.082	-18883.953	
5118	-102231.135	-18888.380	38.309
2295	-102231.499	-18880.288	8.100
2301	-102229.871	-18878.330	2.546
2293	-102227.727	-18875.781	3.330
2284	-102212.173	-18873.968	15.659
2283	-102196.051	-18872.103	16.229
5123	-102194.480	-18871.920	1.581
5122	-102193.082	-18883.953	12.113
面積	451.1077590		
地積	451.10 m ²		

1796

地番	長谷町二八八ノ一A		
NO	X	Y	辺長
5121	-102191.375	-18898.689	
5120	-102203.732	-18900.282	12.459
5119	-102226.514	-18902.477	22.887
2297	-102227.398	-18902.537	0.886
2296	-102230.623	-18899.763	4.253
5118	-102231.135	-18888.380	11.394
5122	-102193.082	-18883.953	38.309
5121	-102191.375	-18898.689	14.834
面積	569.1808670		
地積	569.18 m ²		

図面の種類	画地出来形確認測量図	
街区名	26	求積表
町名	岩倉長谷町	
京都市岩倉長谷土地区画整理組合		




Y-18800

Y-18850

Y-18900

X-102200

X-102250

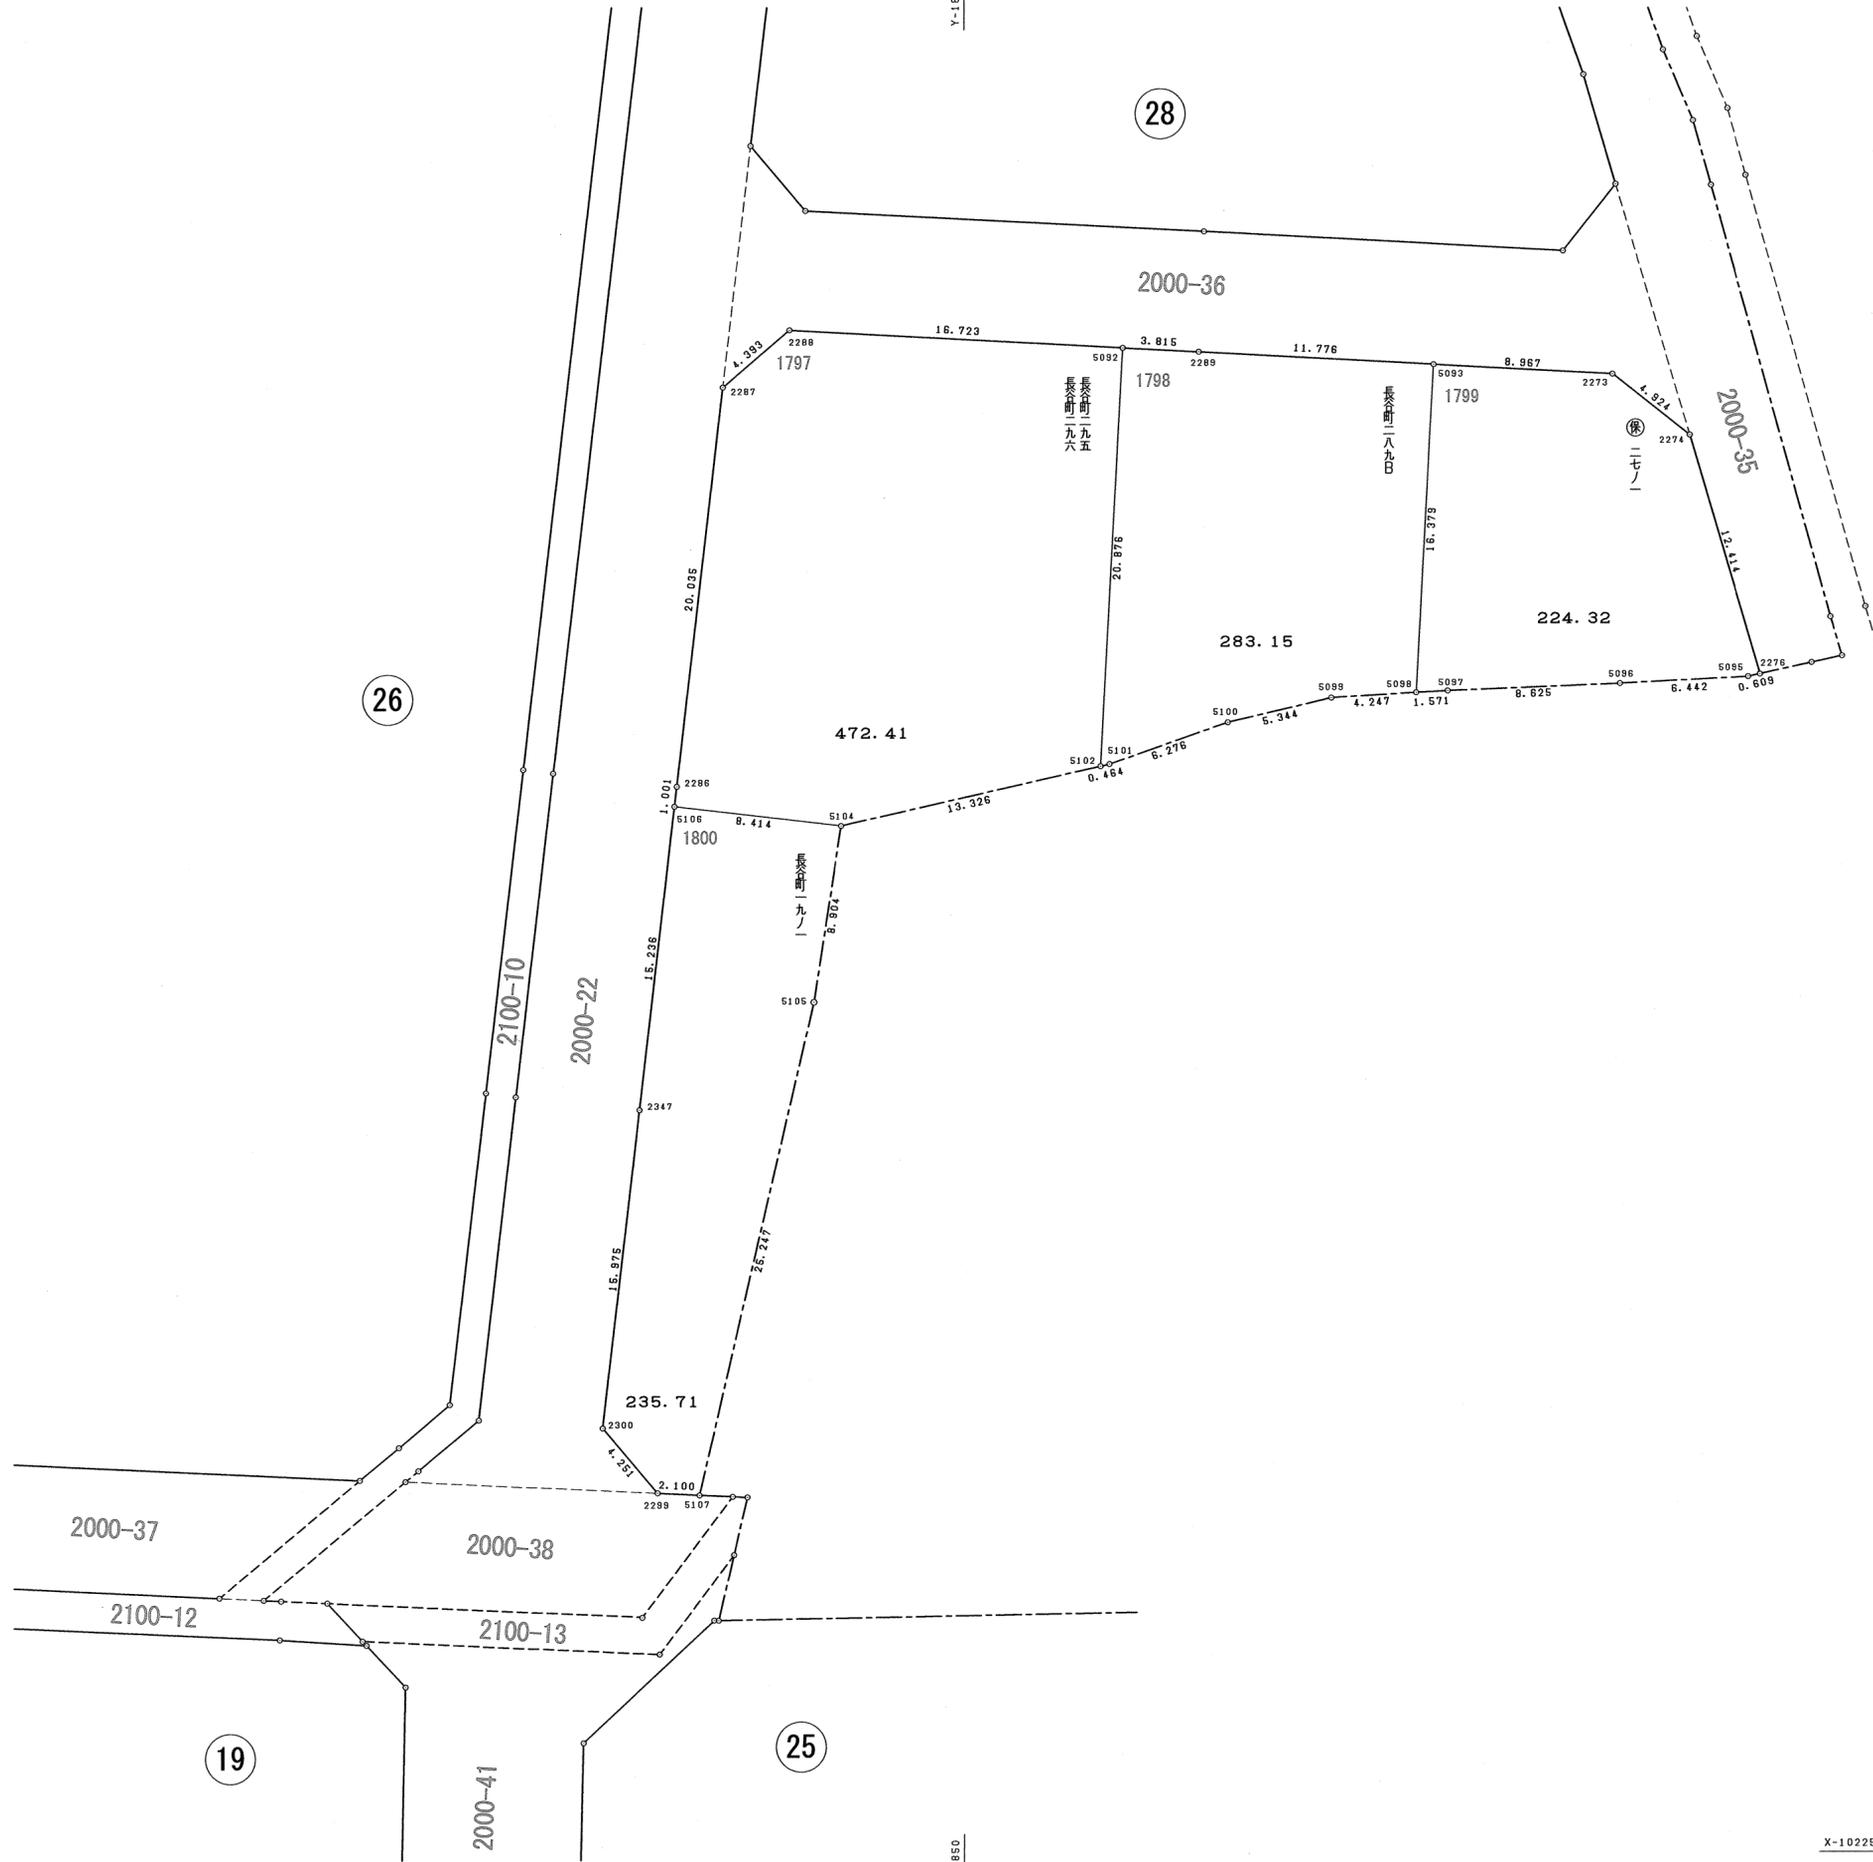

X-102250

Y-18900

Y-18950

X-102250

図面の種類	画地出来形確認測量図		
街区名	27	縮尺	1/250
町名	岩倉長谷町		
京都市岩倉長谷土地区画整理組合			

1797

地番	長谷町二九五, 長谷町二九六		
N O	X	Y	辺長
2288	-102174.156	-18858.765	
2287	-102177.006	-18862.109	4.393
2286	-102196.908	-18864.417	20.035
5106	-102197.903	-18864.532	1.001
5104	-102198.860	-18856.172	8.414
5102	-102195.903	-18843.178	13.326
5092	-102175.056	-18842.066	20.876
2288	-102174.156	-18858.765	16.723
面積	472.4109085		
地積	472.41 m ²		

1798

地番	長谷町二八九B		
N O	X	Y	辺長
5092	-102175.056	-18842.066	
5102	-102195.903	-18843.178	20.876
5101	-102195.800	-18842.725	0.464
5100	-102193.719	-18836.803	6.276
5099	-102192.491	-18831.601	5.344
5098	-102192.230	-18827.362	4.247
5093	-102175.873	-18826.495	16.379
2289	-102175.261	-18838.256	11.776
5092	-102175.056	-18842.066	3.815
面積	283.1569325		
地積	283.15 m ²		


1799

地番	保二七ノ一		
N O	X	Y	辺長
5093	-102175.873	-18826.495	
5098	-102192.230	-18827.362	16.379
5097	-102192.135	-18825.793	1.571
5096	-102191.766	-18817.175	8.625
5095	-102191.418	-18810.742	6.442
2276	-102191.284	-18810.147	0.609
2274	-102179.379	-18813.667	12.414
2273	-102176.337	-18817.540	4.924
5093	-102175.873	-18826.495	8.967
面積	224.3250930		
地積	224.32 m ²		

1800

地番	長谷町一九ノ一		
N O	X	Y	辺長
5106	-102197.903	-18864.532	
2347	-102213.039	-18866.279	15.236
2300	-102228.907	-18868.129	15.975
2299	-102232.147	-18865.377	4.251
5107	-102232.245	-18863.279	2.100
5105	-102207.659	-18857.539	25.247
5104	-102198.860	-18856.172	8.904
5106	-102197.903	-18864.532	8.414
面積	235.7105015		
地積	235.71 m ²		

図面の種類	画地出来形確認測量図	
街区名	27	求積表
町名	岩倉長谷町	
京都市岩倉長谷土地区画整理組合		

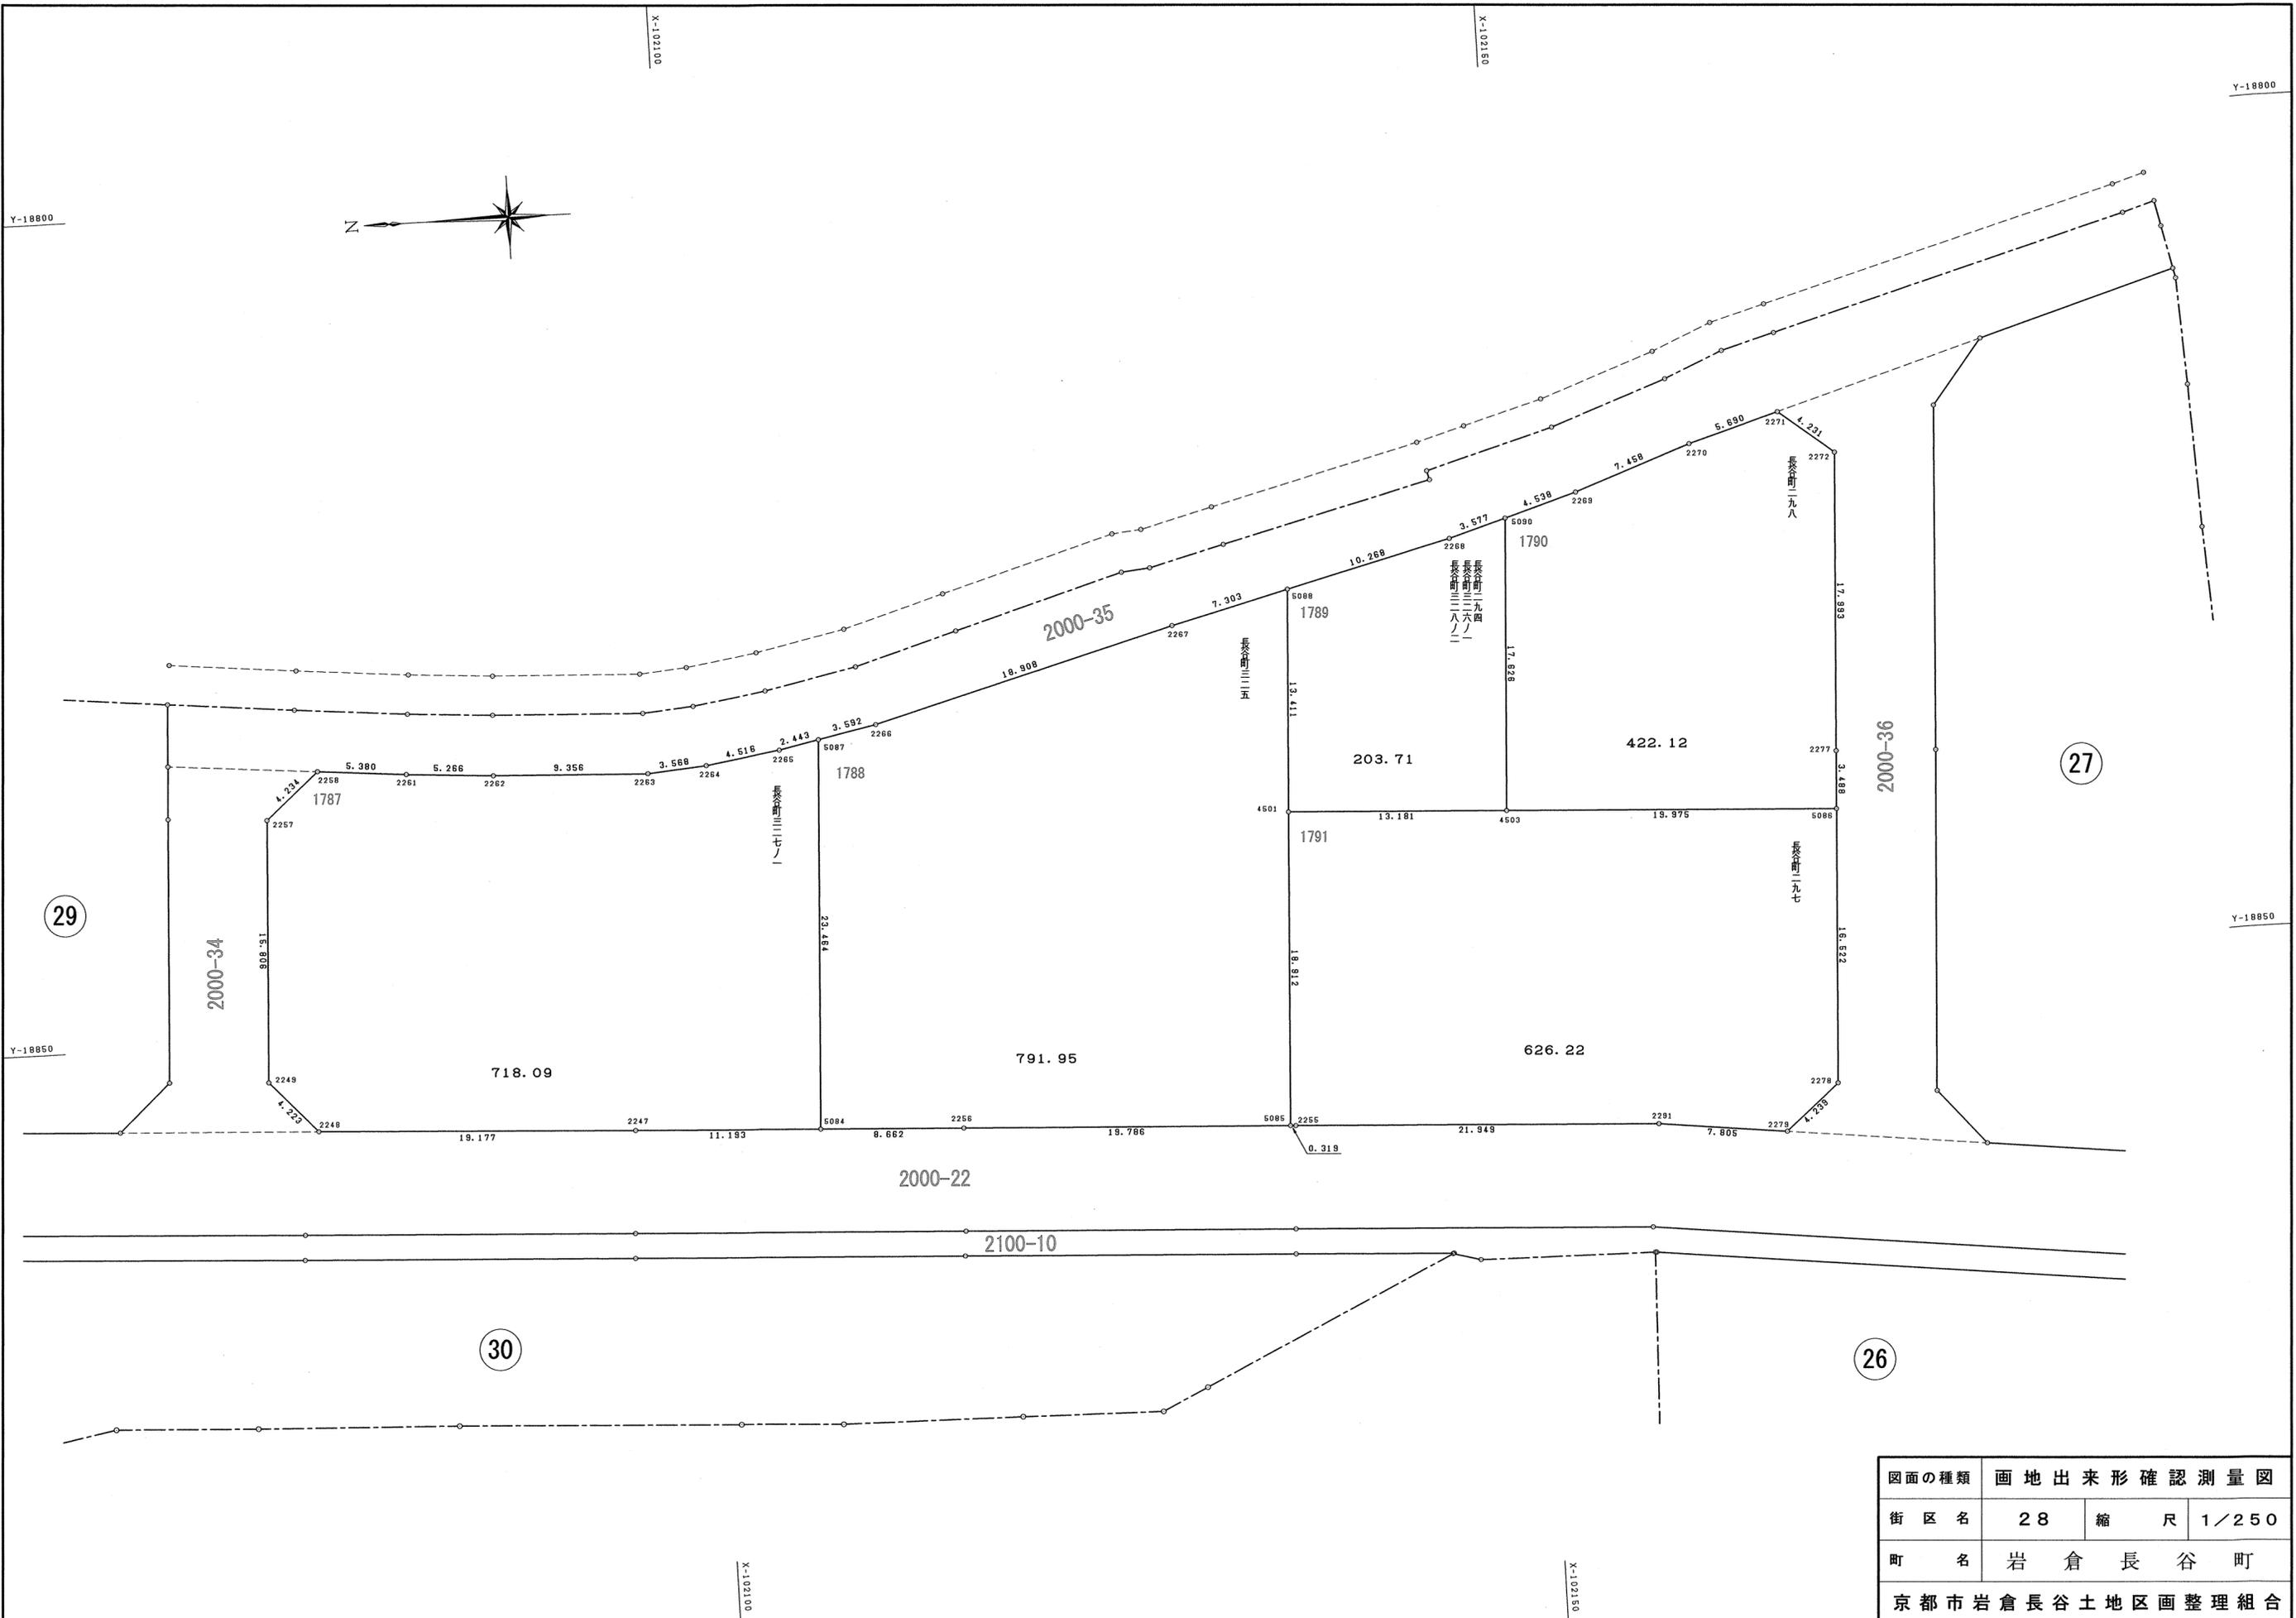

図面の種類	画地出来形確認測量図		
街区名	28	縮尺	1/250
町名	岩倉長谷町		
京都市岩倉長谷土地区画整理組合			

1787

地番 長谷町三二七ノ一			
NO	X	Y	辺長
2249	-102073.397	-18852.400	
2248	-102076.243	-18855.520	4.223
2247	-102095.393	-18856.550	19.177
5084	-102106.571	-18857.137	11.193
5087	-102107.791	-18833.704	23.464
2265	-102105.396	-18834.186	2.443
2264	-102100.929	-18834.850	4.516
2263	-102097.372	-18835.131	3.568
2262	-102088.025	-18834.708	9.356
2261	-102082.772	-18834.331	5.266
2258	-102077.413	-18833.850	5.380
2257	-102074.205	-18836.614	4.234
2249	-102073.397	-18852.400	15.806
面積	718.0982720		
地積	718.09 m ²		

1788

地番 長谷町三二五			
NO	X	Y	辺長
5084	-102106.571	-18857.137	
2256	-102115.222	-18857.591	8.662
5085	-102134.982	-18858.621	19.786
4501	-102135.960	-18839.734	19.912
5088	-102136.666	-18826.341	13.411
2267	-102129.580	-18828.110	7.303
2266	-102111.313	-18832.995	18.908
5087	-102107.791	-18833.704	3.592
5084	-102106.571	-18857.137	23.464
面積	791.9582345		
地積	791.95 m ²		

1789

地番 長谷町二九四, 長谷町三二六ノ一, 長谷町三二八ノ二			
NO	X	Y	辺長
4501	-102135.960	-18839.734	
4503	-102149.123	-18840.424	13.181
5090	-102150.055	-18822.822	17.626
2268	-102146.629	-18823.853	3.577
5088	-102136.666	-18826.341	10.268
4501	-102135.960	-18839.734	13.411
面積	203.7123520		
地積	203.71 m ²		

1790

地番 長谷町二九八			
NO	X	Y	辺長
4503	-102149.123	-18840.424	
5086	-102169.071	-18841.469	19.975
2277	-102169.253	-18837.985	3.488
2272	-102170.195	-18820.016	17.993
2271	-102166.880	-18817.386	4.231
2270	-102161.422	-18818.996	5.690
2269	-102154.397	-18821.501	7.458
5090	-102150.055	-18822.822	4.538
4503	-102149.123	-18840.424	17.626
面積	422.1256925		
地積	422.12 m ²		

1791

地番 長谷町二九七			
NO	X	Y	辺長
5085	-102134.982	-18858.621	
2255	-102135.301	-18858.638	0.319
2291	-102157.220	-18859.796	21.949
2279	-102164.972	-18860.706	7.805
2278	-102168.209	-18857.969	4.239
5086	-102169.071	-18841.469	16.522
4503	-102149.123	-18840.424	19.975
4501	-102135.960	-18839.734	13.181
5085	-102134.982	-18858.621	18.912
面積	626.2229970		
地積	626.22 m ²		

図面の種類	画地出来形確認測量図	
街区名	28	求積表
町名	岩倉長谷町	
京都市岩倉長谷土地区画整理組合		



X-102000

X-102000

Y-18800

Y-18850

Y-18800


X-102050

X-102050

Y-18800

Y-18850

Y-18800

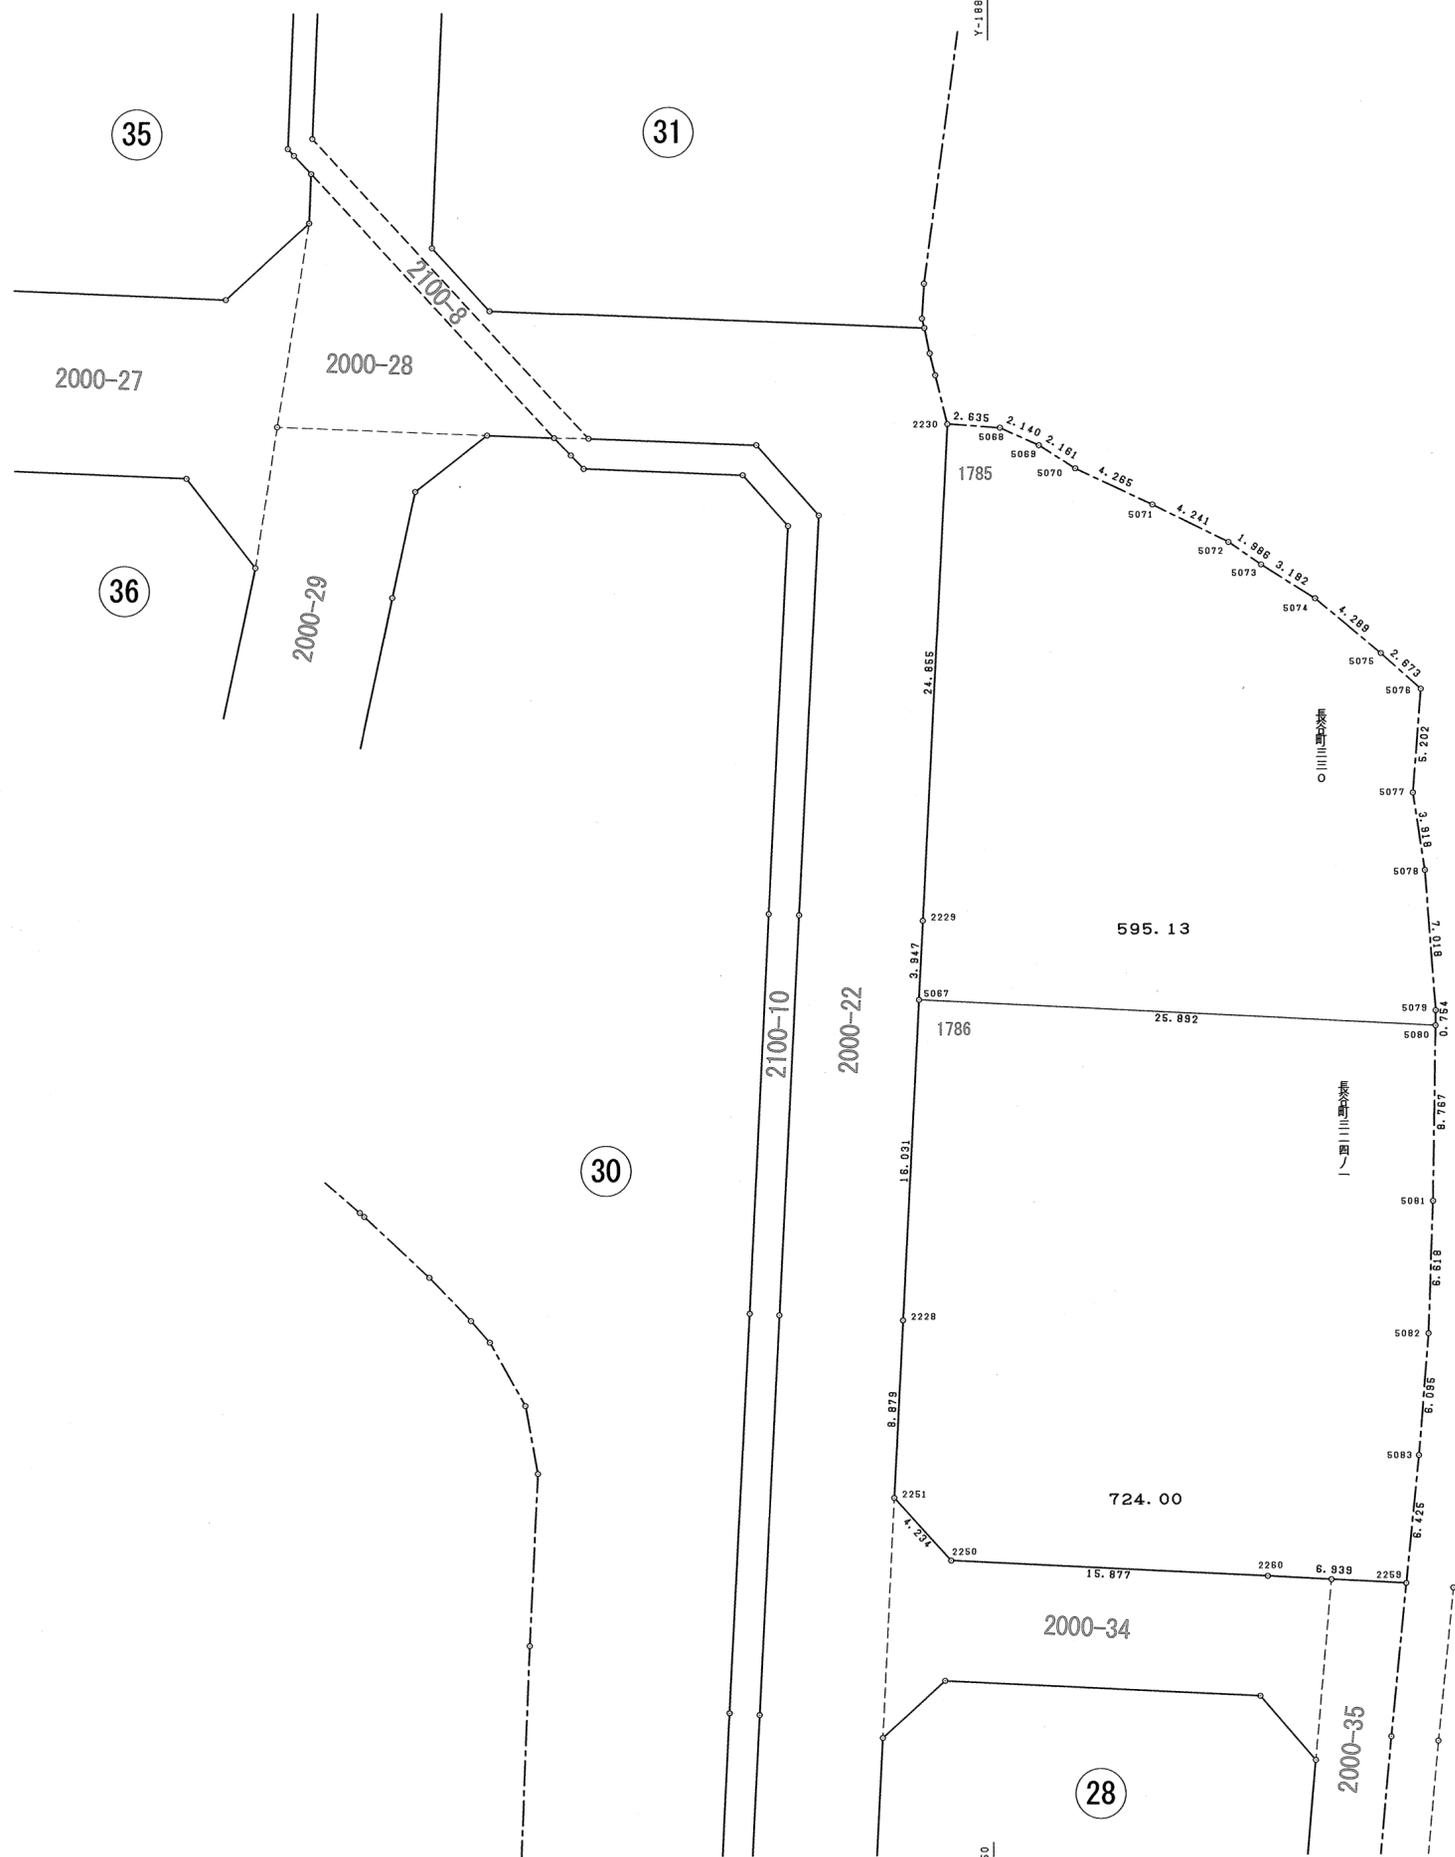

図面の種類	画地出来形確認測量図		
街区名	29	縮尺	1/250
町名	岩倉長谷町		
京都市岩倉長谷土地区画整理組合			


1785

地番 長谷町三三〇			
NO	X	Y	辺長
2230	-102010.597	-18852.088	
2229	-102035.418	-18853.398	24.855
5067	-102039.360	-18853.605	3.947
5080	-102040.738	-18827.749	25.892
5079	-102039.984	-18827.736	0.754
5078	-102032.985	-18828.261	7.018
5077	-102029.110	-18828.840	3.918
5076	-102023.924	-18828.432	5.202
5075	-102022.139	-18830.422	2.673
5074	-102019.387	-18833.712	4.289
5073	-102017.694	-18836.407	3.182
5072	-102016.556	-18838.035	1.986
5071	-102014.670	-18841.834	4.241
5070	-102012.847	-18845.690	4.265
5069	-102011.682	-18847.511	2.161
5068	-102010.797	-18849.460	2.140
2230	-102010.597	-18852.088	2.635
面積	595.1335385		
地積	595.13 m ²		

1786

地番 長谷町三二四ノ一			
NO	X	Y	辺長
5067	-102039.360	-18853.605	
2228	-102055.369	-18854.448	16.031
2251	-102064.236	-18854.915	8.879
2250	-102067.378	-18852.076	4.234
2260	-102068.217	-18836.221	15.877
2259	-102068.585	-18829.291	6.939
5083	-102062.193	-18828.639	6.425
5082	-102056.118	-18828.143	6.095
5081	-102049.504	-18827.903	6.618
5080	-102040.738	-18827.749	8.767
5067	-102039.360	-18853.605	25.892
面積	724.0094105		
地積	724.00 m ²		

図面の種類	画地出来形確認測量図	
街区名	29	求積表
町名	岩倉長谷町	
京都市岩倉長谷土地区画整理組合		

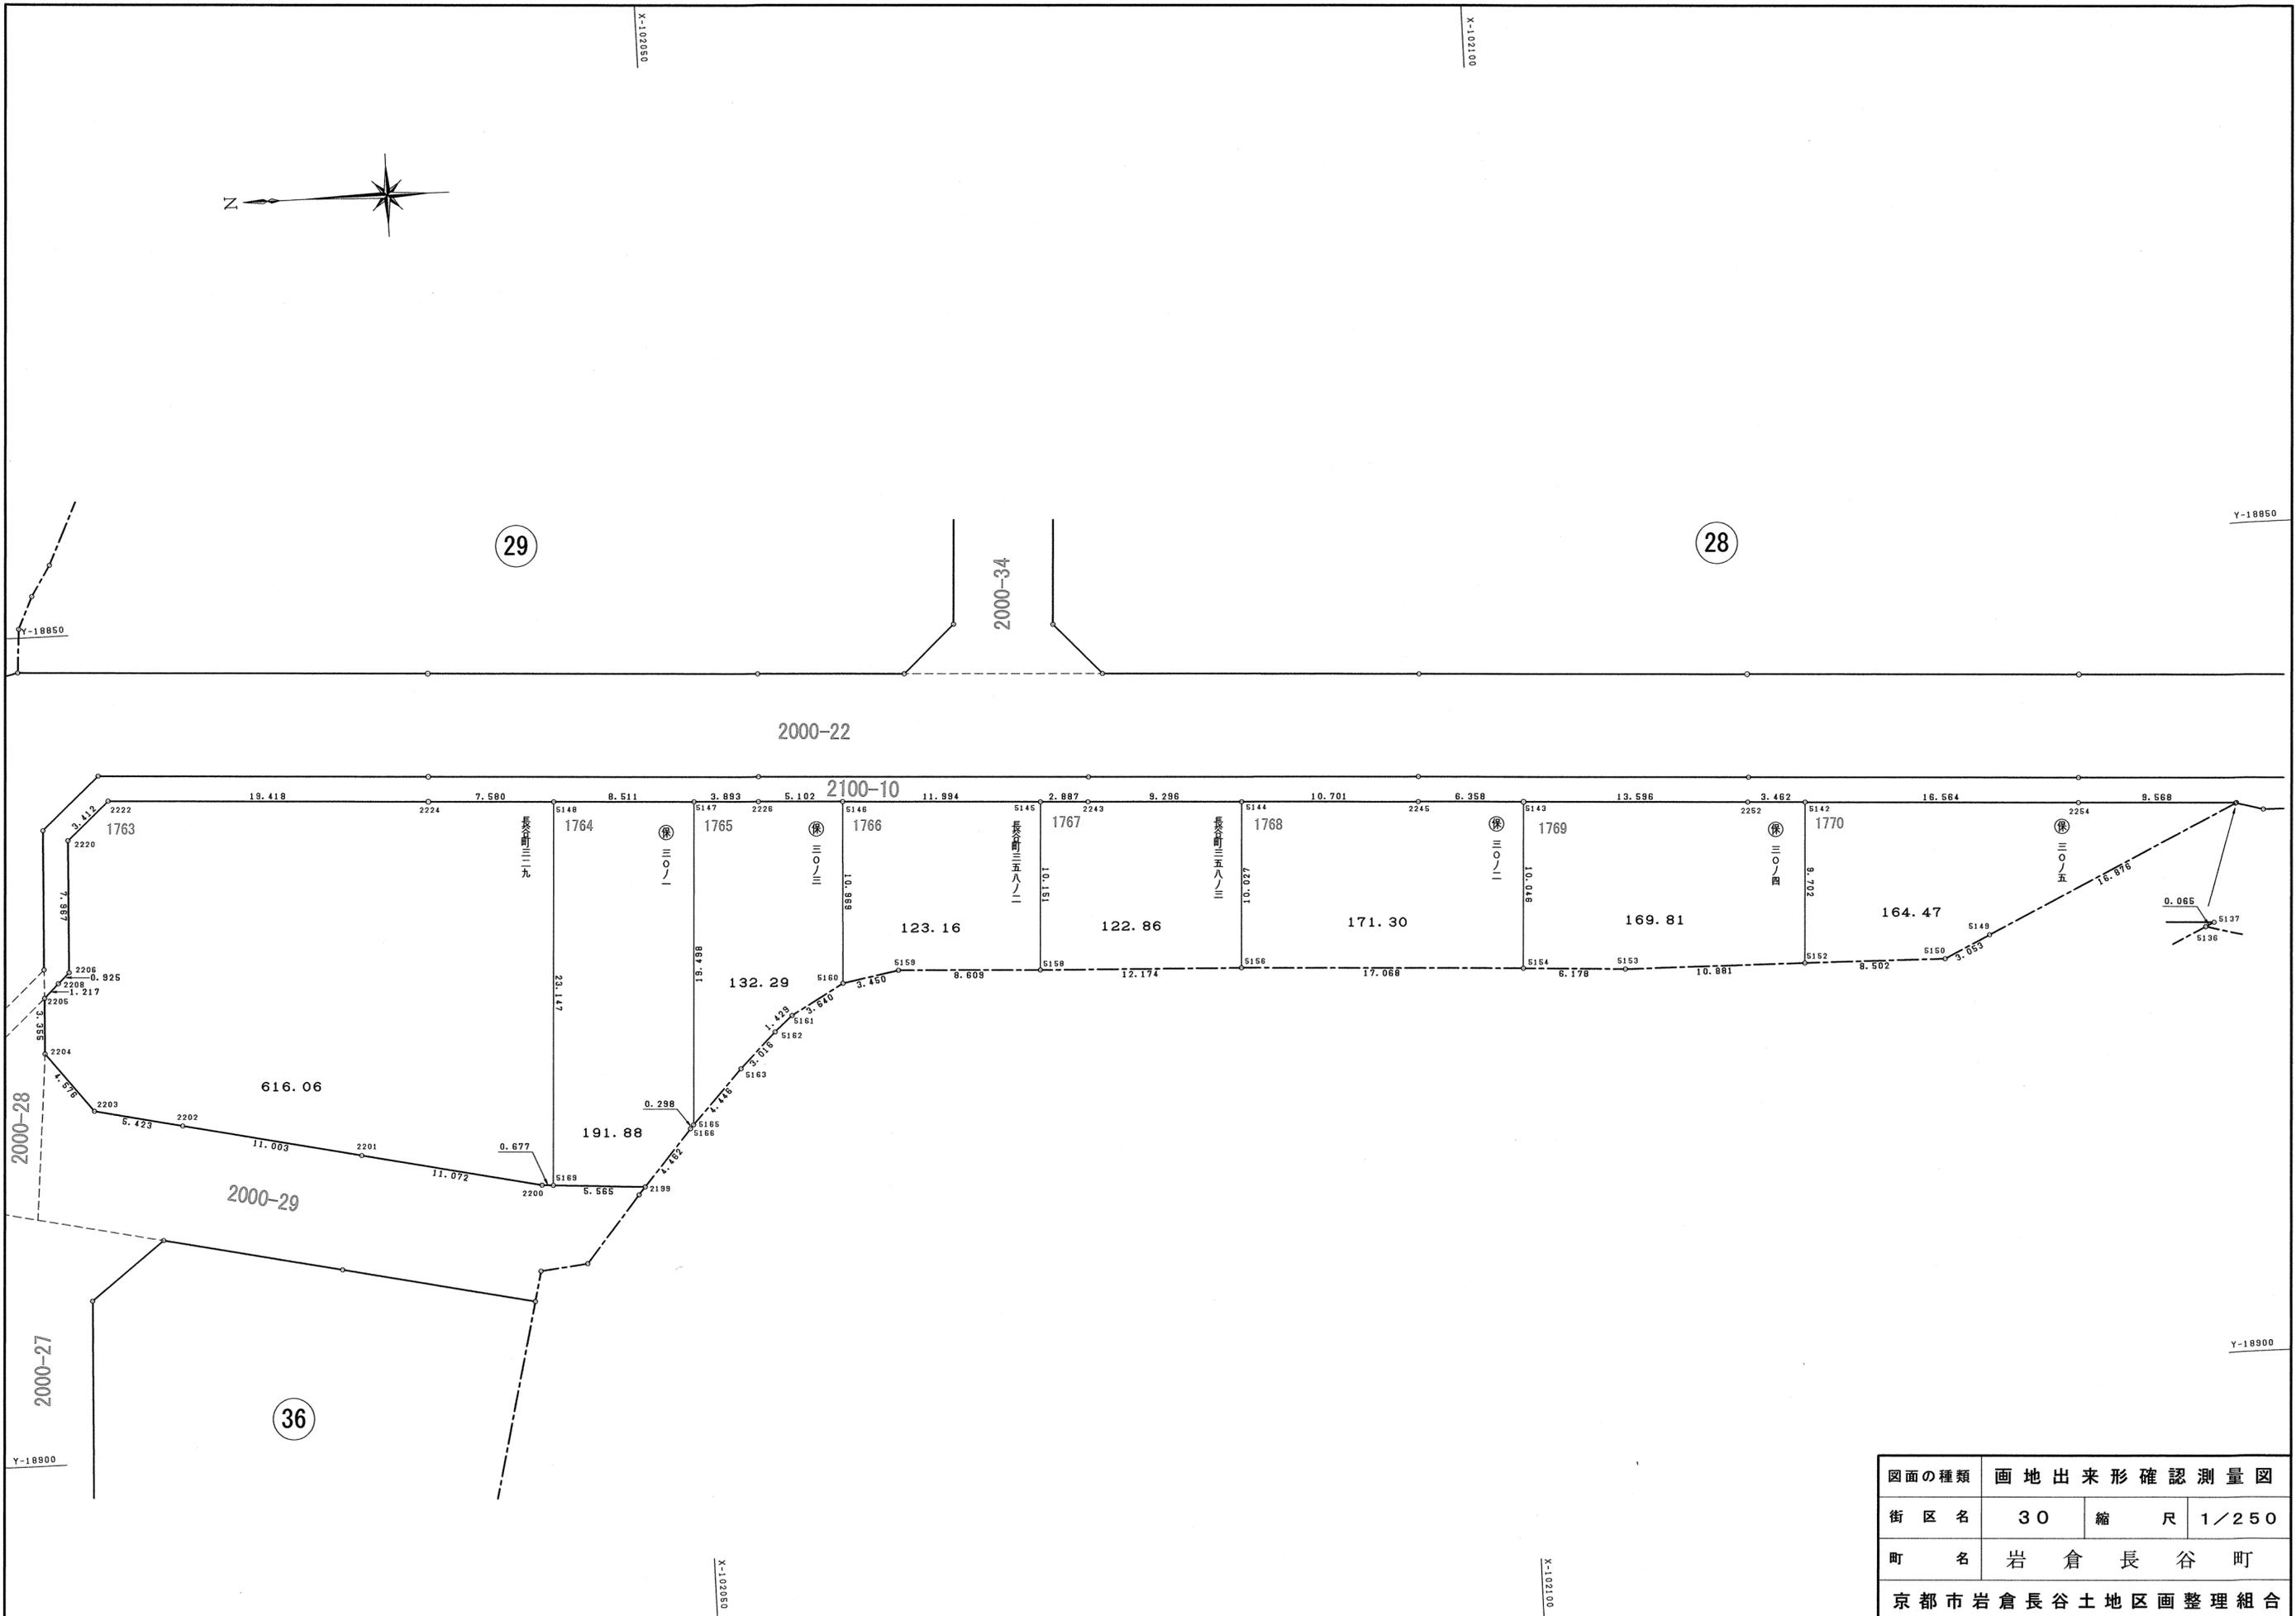

図面の種類	画地出来形確認測量図		
街区名	30	縮尺	1/250
町名	岩倉長谷町		
京都市岩倉長谷土地区画整理組合			

1763

地番 長谷町三二九			
NO	X	Y	辺長
2204	-102011.058	-18875.136	
2203	-102013.864	-18878.751	4.576
2202	-102019.162	-18879.911	5.423
2201	-102029.917	-18882.236	11.003
2200	-102040.737	-18884.585	11.072
5169	-102041.413	-18884.631	0.677
5148	-102042.626	-18861.515	23.147
2224	-102035.055	-18861.128	7.580
2222	-102015.664	-18860.093	19.418
2220	-102013.110	-18862.356	3.412
2206	-102012.761	-18870.316	7.967
2208	-102012.084	-18870.947	0.925
2205	-102011.199	-18871.783	1.217
2204	-102011.058	-18875.136	3.355
面積	616.0634995		
地積	616.06 m ²		

1764

地番 保三〇ノ一			
NO	X	Y	辺長
5169	-102041.413	-18884.631	
2199	-102046.965	-18885.012	5.565
5166	-102049.895	-18881.646	4.462
5165	-102050.090	-18881.420	0.298
5147	-102051.126	-18861.949	19.498
5148	-102042.626	-18861.515	8.511
5169	-102041.413	-18884.631	23.147
面積	191.8874660		
地積	191.88 m ²		

1765

地番 保三〇ノ三			
NO	X	Y	辺長
5165	-102050.090	-18881.420	
5163	-102053.135	-18878.180	4.446
5162	-102055.307	-18876.087	3.016
5161	-102056.386	-18875.150	1.429
5160	-102059.566	-18873.377	3.640
5146	-102060.109	-18862.421	10.969
2226	-102055.014	-18862.148	5.102
5147	-102051.126	-18861.949	3.893
5165	-102050.090	-18881.420	19.498
面積	132.2951730		
地積	132.29 m ²		

1766

地番 長谷町三五八ノ二			
NO	X	Y	辺長
5160	-102059.566	-18873.377	
5159	-102062.962	-18872.765	3.450
5158	-102071.560	-18873.201	8.609
5145	-102072.086	-18863.063	10.151
5146	-102060.109	-18862.421	11.994
5160	-102059.566	-18873.377	10.969
面積	123.1642910		
地積	123.16 m ²		

1767

地番 長谷町三五八ノ三			
NO	X	Y	辺長
5158	-102071.560	-18873.201	
5156	-102083.724	-18873.713	12.174
5144	-102084.253	-18863.699	10.027
2243	-102074.969	-18863.217	9.296
5145	-102072.086	-18863.063	2.887
5158	-102071.560	-18873.201	10.151
面積	122.8622980		
地積	122.86 m ²		

1768

地番 保三〇ノ二			
NO	X	Y	辺長
5156	-102083.724	-18873.713	
5154	-102100.768	-18874.621	17.068
5143	-102101.290	-18864.588	10.046
2245	-102094.940	-18864.253	6.358
5144	-102084.253	-18863.699	10.701
5156	-102083.724	-18873.713	10.027
面積	171.3087360		
地積	171.30 m ²		

1769

地番 保三〇ノ四			
NO	X	Y	辺長
5154	-102100.768	-18874.621	
5153	-102106.936	-18874.984	6.178
5152	-102117.816	-18875.175	10.881
5142	-102118.326	-18865.486	9.702
2252	-102114.868	-18865.303	3.462
5143	-102101.290	-18864.588	13.596
5154	-102100.768	-18874.621	10.046
面積	169.8176060		
地積	169.81 m ²		

1770

地番 保三〇ノ五			
NO	X	Y	辺長
5152	-102117.816	-18875.175	
5150	-102126.317	-18875.358	8.502
5149	-102129.079	-18874.055	3.053
5136	-102144.363	-18866.899	16.876
5137	-102144.422	-18866.871	0.065
2254	-102134.867	-18866.361	9.568
5142	-102118.326	-18865.486	16.564
5152	-102117.816	-18875.175	9.702
面積	164.4715040		
地積	164.47 m ²		

図面の種類	画地出来形確認測量図	
街区名	30	求積表
町名	岩倉長谷町	
京都市岩倉長谷土地区画整理組合		