

京都市西賀茂第三地区土地区画整理事業

画地出来形確認測量図


平成20年8月29日現在

西賀茂第三土地区画整理組合
北陽測地株式会社

京都市西賀茂第三地区土地区画整理事業

新町界図

縮尺 貳千分之壹

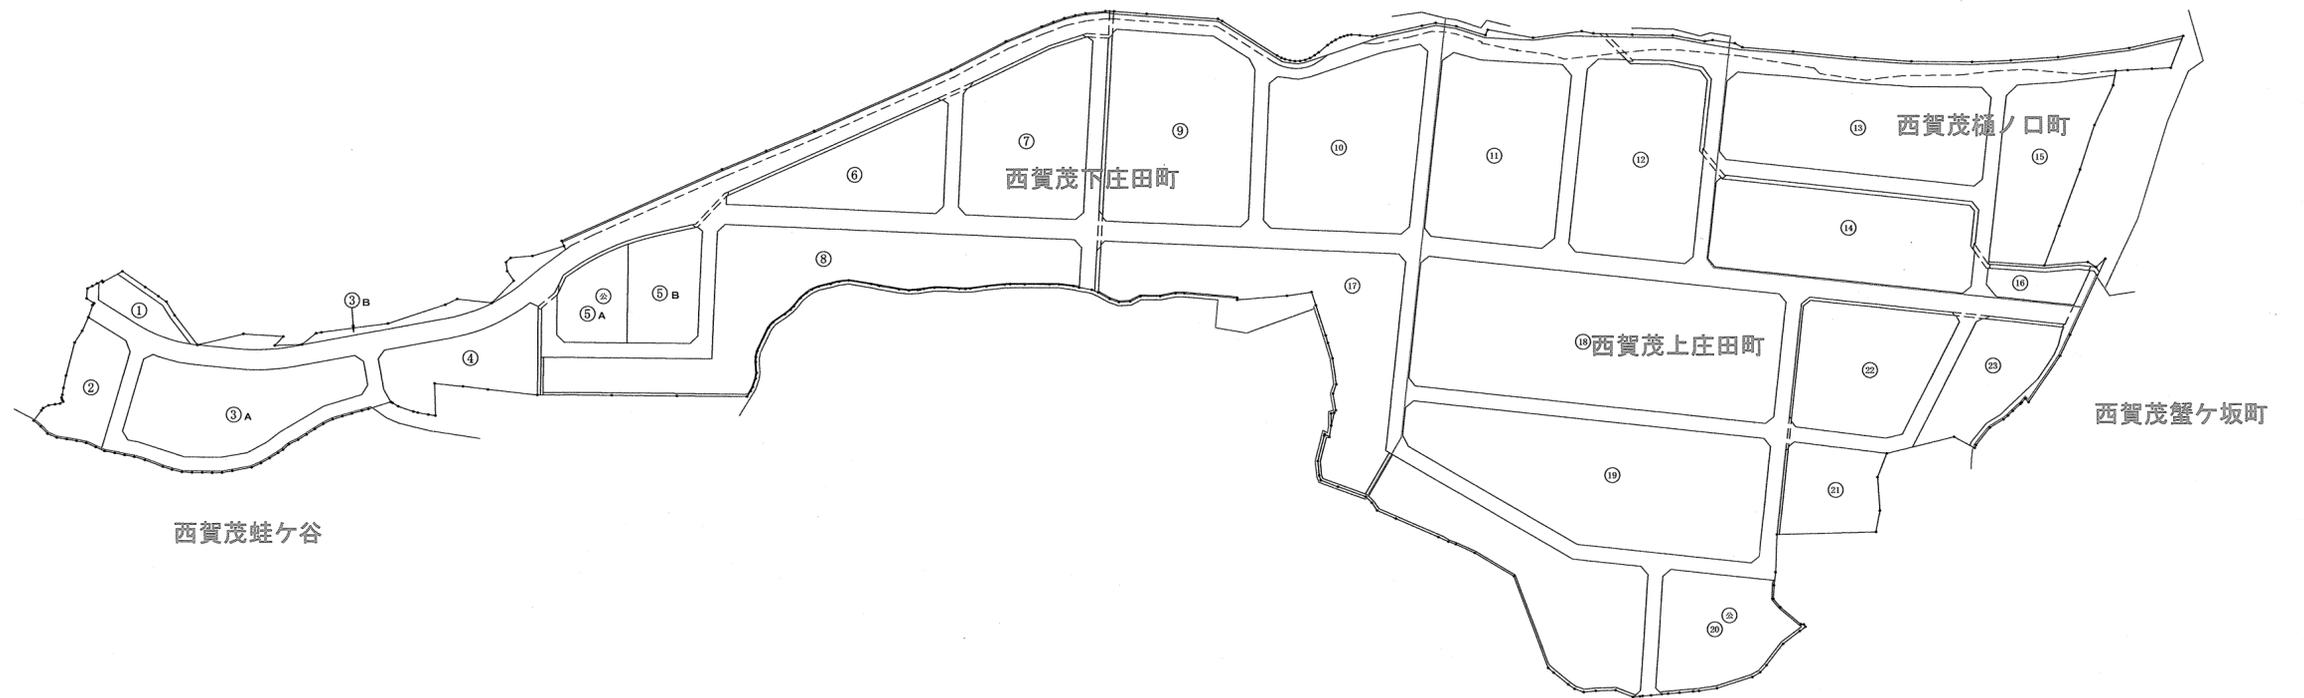

107

地番	下ノ一, 下六ノ四, 下七ノ五, 下七ノ九 下八ノ二, 下三二ノ二, 下三二ノ三, 下三二ノ四		
N O	X	Y	辺長
597	-102023.050	-23673.095	
3437	-102036.668	-23681.594	16.052
3469	-102043.097	-23671.291	12.144
1379	-102030.597	-23662.729	15.151
1377	-102024.767	-23665.987	6.678
1376	-102024.441	-23665.453	0.625
596	-102023.219	-23666.131	1.397
597	-102023.050	-23673.095	6.966
面積	218.3069525		
地積	218.30 m ²		


108

地番	保一ノ一		
N O	X	Y	辺長
3437	-102036.668	-23681.594	
591	-102038.440	-23682.700	2.088
598	-102041.029	-23684.226	3.005
599	-102043.690	-23685.598	2.993
600	-102046.436	-23686.846	3.016
592	-102049.226	-23687.938	2.996
593	-102052.093	-23688.869	3.014
3443	-102052.407	-23688.956	0.325
1457	-102055.211	-23684.475	5.285
1449	-102051.984	-23680.293	5.282
1450	-102048.778	-23675.182	6.033
3469	-102043.097	-23671.291	6.885
3437	-102036.668	-23681.594	12.144
面積	170.1269545		
地積	170.12 m ²		

109

地番	下五ノ四		
N O	X	Y	辺長
3443	-102052.407	-23688.956	
594	-102054.988	-23689.673	2.678
595	-102057.929	-23690.269	3.000
1382	-102059.915	-23690.571	2.008
1457	-102055.211	-23684.475	7.699
3443	-102052.407	-23688.956	5.286
面積	19.8411015		
地積	19.84 m ²		

図面の種類	画地出来形確認測量図	
街区名	1	求積表
町名	西賀茂下庄田町	
京都市西賀茂第三土地区画整理組合		

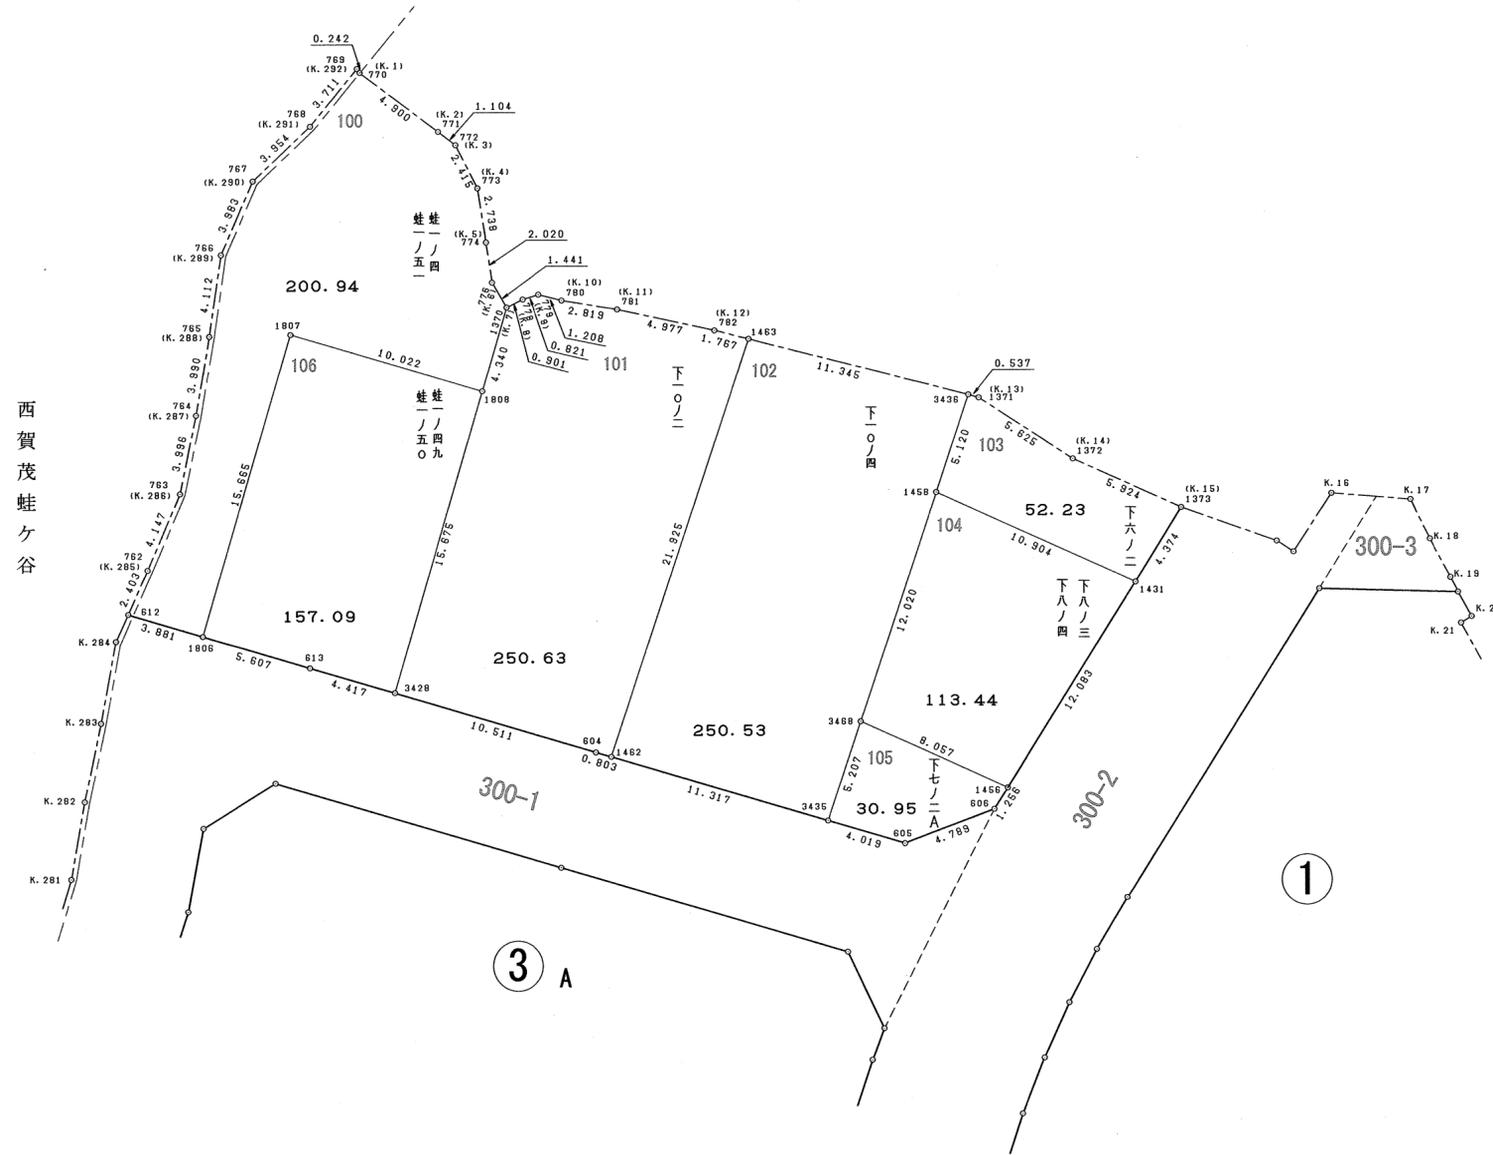

図面の種類	画地出来形確認測量図		
街区名	2	縮尺	1/250
町名	西賀茂下庄田町		
京都市西賀茂第三土地区画整理組合			

100

地番 蛙一ノ四, 蛙一ノ五一			
NO	X	Y	辺長
769	-101997.123	-23721.284	
768	-101999.994	-23723.636	3.711
767	-102002.723	-23726.498	3.954
766	-102006.371	-23728.097	3.983
765	-102010.443	-23728.676	4.112
764	-102014.377	-23729.344	3.990
763	-102018.292	-23730.146	3.996
762	-102022.109	-23731.768	4.147
612	-102024.305	-23732.745	2.403
1806	-102025.404	-23729.022	3.881
1807	-102010.369	-23724.622	15.665
1808	-102013.191	-23715.005	10.022
1370	-102009.025	-23713.786	4.340
776	-102007.781	-23714.515	1.441
774	-102005.783	-23714.818	2.020
773	-102003.078	-23715.244	2.738
772	-102000.927	-23716.344	2.415
771	-102000.256	-23717.221	1.104
770	-101997.322	-23721.146	4.900
769	-101997.123	-23721.284	0.242
面積	200.9451400		
地積	200.94 m ²		

101

地番 下一〇ノ二			
NO	X	Y	辺長
1370	-102009.025	-23713.786	
1808	-102013.191	-23715.005	4.340
3428	-102028.236	-23719.405	15.675
604	-102031.197	-23709.319	10.511
1462	-102031.424	-23708.548	0.803
1463	-102010.608	-23701.662	21.925
782	-102010.173	-23703.375	1.767
781	-102009.120	-23708.240	4.977
780	-102008.673	-23711.024	2.819
779	-102008.377	-23712.196	1.208
778	-102008.619	-23712.981	0.821
1370	-102009.025	-23713.786	0.901
面積	250.6361935		
地積	250.63 m ²		

102

地番 下一〇ノ四			
NO	X	Y	辺長
1463	-102010.608	-23701.662	
1462	-102031.424	-23708.548	21.925
3435	-102034.615	-23697.690	11.317
3468	-102029.674	-23696.047	5.207
1458	-102018.262	-23692.272	12.020
3436	-102013.400	-23690.665	5.120
1463	-102010.608	-23701.662	11.345
面積	250.5345975		
地積	250.53 m ²		

103

地番 下六ノ二			
NO	X	Y	辺長
3436	-102013.400	-23690.665	
1458	-102018.262	-23692.272	5.120
1431	-102022.712	-23682.317	10.904
1373	-102018.997	-23680.007	4.374
1372	-102016.584	-23685.418	5.924
1371	-102013.532	-23690.144	5.625
3436	-102013.400	-23690.665	0.537
面積	52.2372735		
地積	52.23 m ²		

104

地番 下八ノ三, 下八ノ四			
NO	X	Y	辺長
1458	-102018.262	-23692.272	
3468	-102029.674	-23696.047	12.020
1456	-102032.974	-23688.696	8.057
1431	-102022.712	-23682.317	12.083
1458	-102018.262	-23692.272	10.904
面積	113.4459360		
地積	113.44 m ²		



105

地番 下七ノ二A			
NO	X	Y	辺長
3468	-102029.674	-23696.047	
3435	-102034.615	-23697.690	5.207
605	-102035.749	-23693.834	4.019
606	-102034.041	-23689.359	4.789
1456	-102032.974	-23688.696	1.256
3468	-102029.674	-23696.047	8.057
面積	30.9562520		
地積	30.95 m ²		

106

地番 蛙一ノ四九, 蛙一ノ五〇			
NO	X	Y	辺長
1807	-102010.369	-23724.622	
1806	-102025.404	-23729.022	15.665
613	-102026.992	-23723.644	5.607
3428	-102028.236	-23719.405	4.417
1808	-102013.191	-23715.005	15.675
1807	-102010.369	-23724.622	10.022
面積	157.0991300		
地積	157.09 m ²		

図面の種類	画地出来形確認測量図	
街区名	2	求積表
町名	西賀茂下庄田町	
京都市西賀茂第三土地区画整理組合		

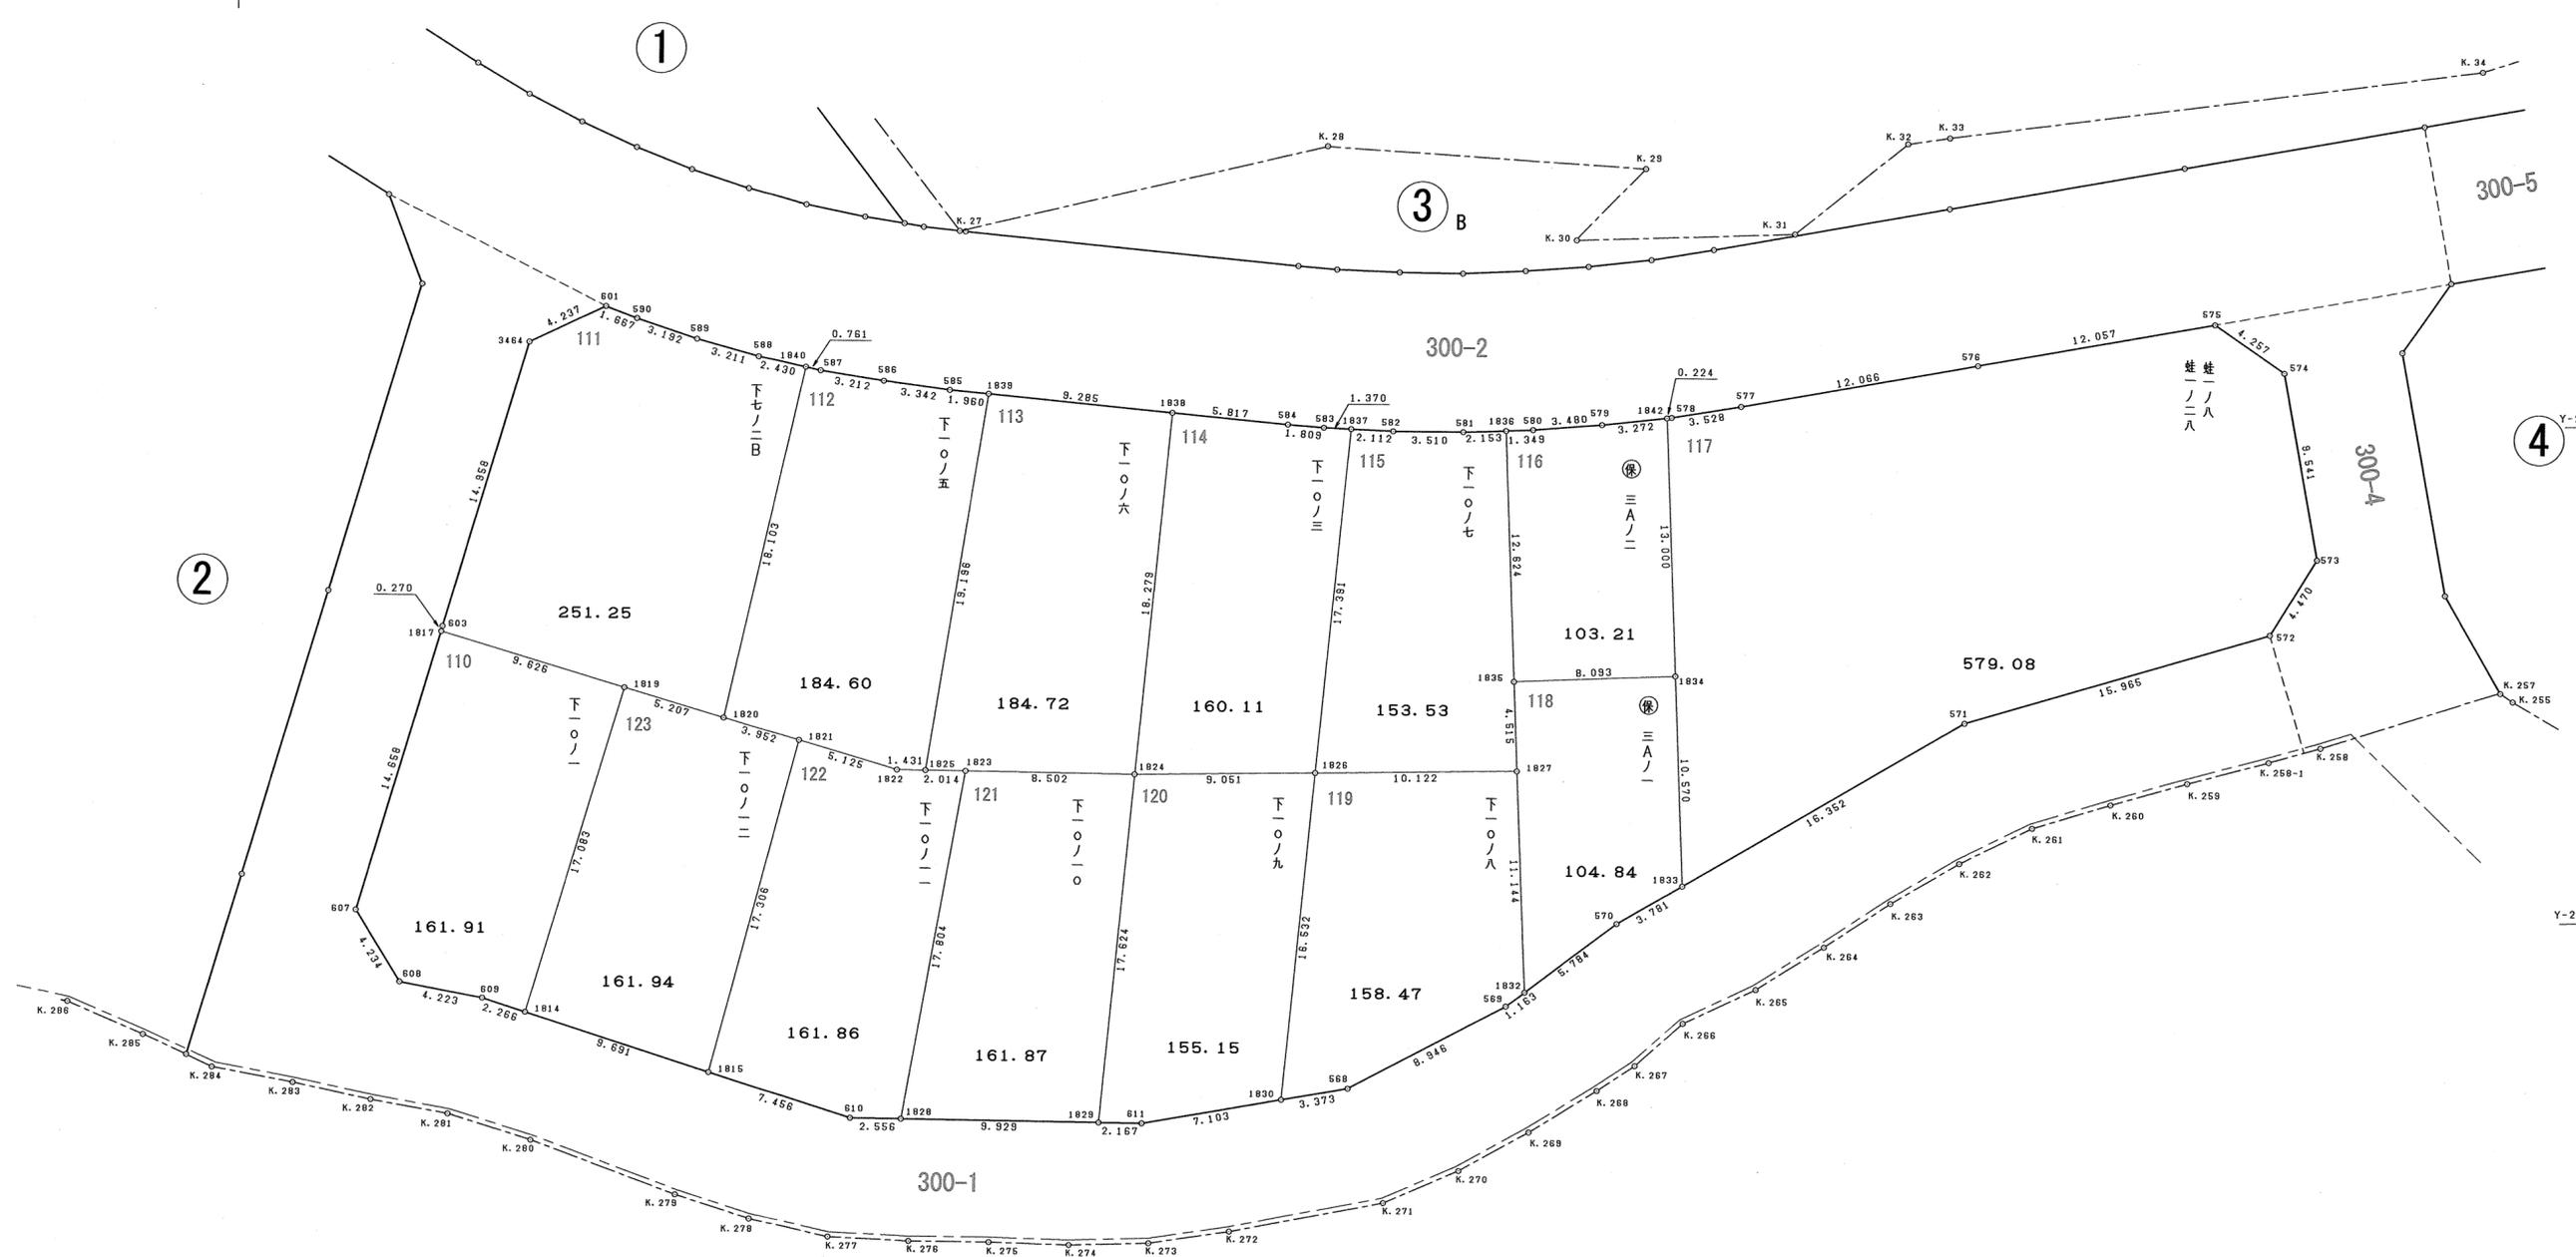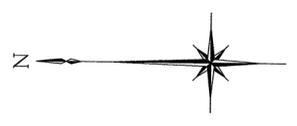

西賀茂蛙ヶ谷

図面の種類	画地出来形確認測量図		
街区名	3A	縮尺	1/250
町名	西賀茂下庄田町		
京都市西賀茂第三土地区画整理組合			

110

地番	下〇ノ一		
NO	X	Y	辺長
1817	-102036.871	-23711.312	
607	-102032.736	-23725.375	14.658
608	-102034.868	-23728.974	4.234
609	-102039.120	-23729.747	4.223
1814	-102041.281	-23730.431	2.266
1819	-102046.102	-23714.042	17.083
1817	-102036.871	-23711.312	9.626
面積	161.9110160		
地積	161.91 m ²		

111

地番	下七ノ二B		
NO	X	Y	辺長
601	-102044.985	-23694.870	
3464	-102041.163	-23696.700	4.237
603	-102036.947	-23711.052	14.958
1817	-102036.871	-23711.312	0.270
1819	-102046.102	-23714.042	9.626
1820	-102051.097	-23715.514	5.207
1840	-102055.043	-23697.846	18.103
588	-102052.671	-23697.317	2.430
589	-102049.575	-23696.463	3.211
590	-102046.543	-23695.463	3.192
601	-102044.985	-23694.870	1.667
面積	251.2514780		
地積	251.25 m ²		

112

地番	下〇ノ五		
NO	X	Y	辺長
1840	-102055.043	-23697.846	
1820	-102051.097	-23715.514	18.103
1821	-102054.894	-23716.611	3.952
1822	-102059.811	-23718.059	5.125
1825	-102061.242	-23718.073	1.431
1839	-102064.228	-23699.110	19.196
585	-102062.276	-23698.927	1.960
586	-102058.960	-23698.508	3.342
587	-102055.786	-23698.012	3.212
1840	-102055.043	-23697.846	0.761
面積	184.6030635		
地積	184.60 m ²		

113

地番	下〇ノ六		
NO	X	Y	辺長
1839	-102064.228	-23699.110	
1825	-102061.242	-23718.073	19.196
1823	-102063.256	-23718.092	2.014
1824	-102071.758	-23718.177	8.502
1838	-102073.473	-23699.978	18.279
1839	-102064.228	-23699.110	9.285
面積	184.7270875		
地積	184.72 m ²		

114

地番	下〇ノ三		
NO	X	Y	辺長
1838	-102073.473	-23699.978	
1824	-102071.758	-23718.177	18.279
1826	-102080.808	-23718.033	9.051
1837	-102082.438	-23700.718	17.391
583	-102081.069	-23700.660	1.370
584	-102079.265	-23700.521	1.809
1838	-102073.473	-23699.978	5.817
面積	160.1107955		
地積	160.11 m ²		

115

地番	下〇ノ七		
NO	X	Y	辺長
1837	-102082.438	-23700.718	
1826	-102080.808	-23718.033	17.391
1827	-102090.929	-23717.856	10.122
1835	-102090.741	-23713.344	4.515
1836	-102090.211	-23700.731	12.624
581	-102088.059	-23700.822	2.153
582	-102084.549	-23700.807	3.510
1837	-102082.438	-23700.718	2.112
面積	153.5319840		
地積	153.53 m ²		

116

地番	保三Aノ二		
NO	X	Y	辺長
1836	-102090.211	-23700.731	
1835	-102090.741	-23713.344	12.624
1834	-102098.827	-23712.994	8.093
1842	-102098.278	-23700.005	13.000
579	-102095.028	-23700.388	3.272
580	-102091.559	-23700.674	3.480
1836	-102090.211	-23700.731	1.349
面積	103.2185495		
地積	103.21 m ²		

117

地番	蛙ノ八、蛙ノ二八		
NO	X	Y	辺長
1842	-102098.278	-23700.005	
1834	-102098.827	-23712.994	13.000
1833	-102099.271	-23723.555	10.570
571	-102113.336	-23715.214	16.352
572	-102128.627	-23710.623	15.965
573	-102130.953	-23706.805	4.470
574	-102129.219	-23697.422	9.541
575	-102125.705	-23695.018	4.257
576	-102113.848	-23697.208	12.057
577	-102101.981	-23699.395	12.066
578	-102098.501	-23699.979	3.528
1842	-102098.278	-23700.005	0.224
面積	579.0840370		
地積	579.08 m ²		

118

地番	保三Aノ一		
NO	X	Y	辺長
1835	-102090.741	-23713.344	
1827	-102090.929	-23717.856	4.515
1832	-102091.417	-23728.990	11.144
570	-102096.018	-23725.484	5.784
1833	-102099.271	-23723.555	3.781
1834	-102098.827	-23712.994	10.570
1835	-102090.741	-23713.344	8.093
面積	104.8441825		
地積	104.84 m ²		

119

地番	下〇ノ八		
NO	X	Y	辺長
1826	-102080.808	-23718.033	
1830	-102079.274	-23734.494	16.532
568	-102082.595	-23733.900	3.373
569	-102090.492	-23729.695	8.946
1832	-102091.417	-23728.990	1.163
1827	-102090.929	-23717.856	11.144
1826	-102080.808	-23718.033	10.122
面積	158.4799895		
地積	158.47 m ²		

120

地番	下〇ノ九		
NO	X	Y	辺長
1824	-102071.758	-23718.177	
1829	-102070.115	-23735.725	17.624
611	-102072.282	-23735.746	2.167
1830	-102079.274	-23734.494	7.103
1826	-102080.808	-23718.033	16.532
1824	-102071.758	-23718.177	9.051
面積	155.1553345		
地積	155.15 m ²		

121

地番	下〇ノ一〇		
NO	X	Y	辺長
1823	-102063.256	-23718.092	
1828	-102060.186	-23735.630	17.804
1829	-102070.115	-23735.725	9.929
1824	-102071.758	-23718.177	17.624
1823	-102063.256	-23718.092	8.502
面積	161.8796015		
地積	161.87 m ²		


122

地番	下〇ノ一一		
NO	X	Y	辺長
1821	-102054.894	-23716.611	
1815	-102050.521	-23733.356	17.306
610	-102057.630	-23735.606	7.456
1828	-102060.186	-23735.630	2.556
1823	-102063.256	-23718.092	17.804
1825	-102061.242	-23718.073	2.014
1822	-102059.811	-23718.059	1.431
1821	-102054.894	-23716.611	5.125
面積	161.8686655		
地積	161.86 m ²		


123

地番	下〇ノ一二		
NO	X	Y	辺長
1819	-102046.102	-23714.042	
1814	-102041.281	-23730.431	17.083
1815	-102050.521	-23733.356	9.691
1821	-102054.894	-23716.611	17.306
1820	-102051.097	-23715.514	3.952
1819	-102046.102	-23714.042	5.207
面積	161.9411965		
地積	161.94 m ²		

図面の種類	画地出来形確認測量図	
街区名	3A	求積表
町名	西賀茂下庄田町	
京都市西賀茂第三土地区画整理組合		

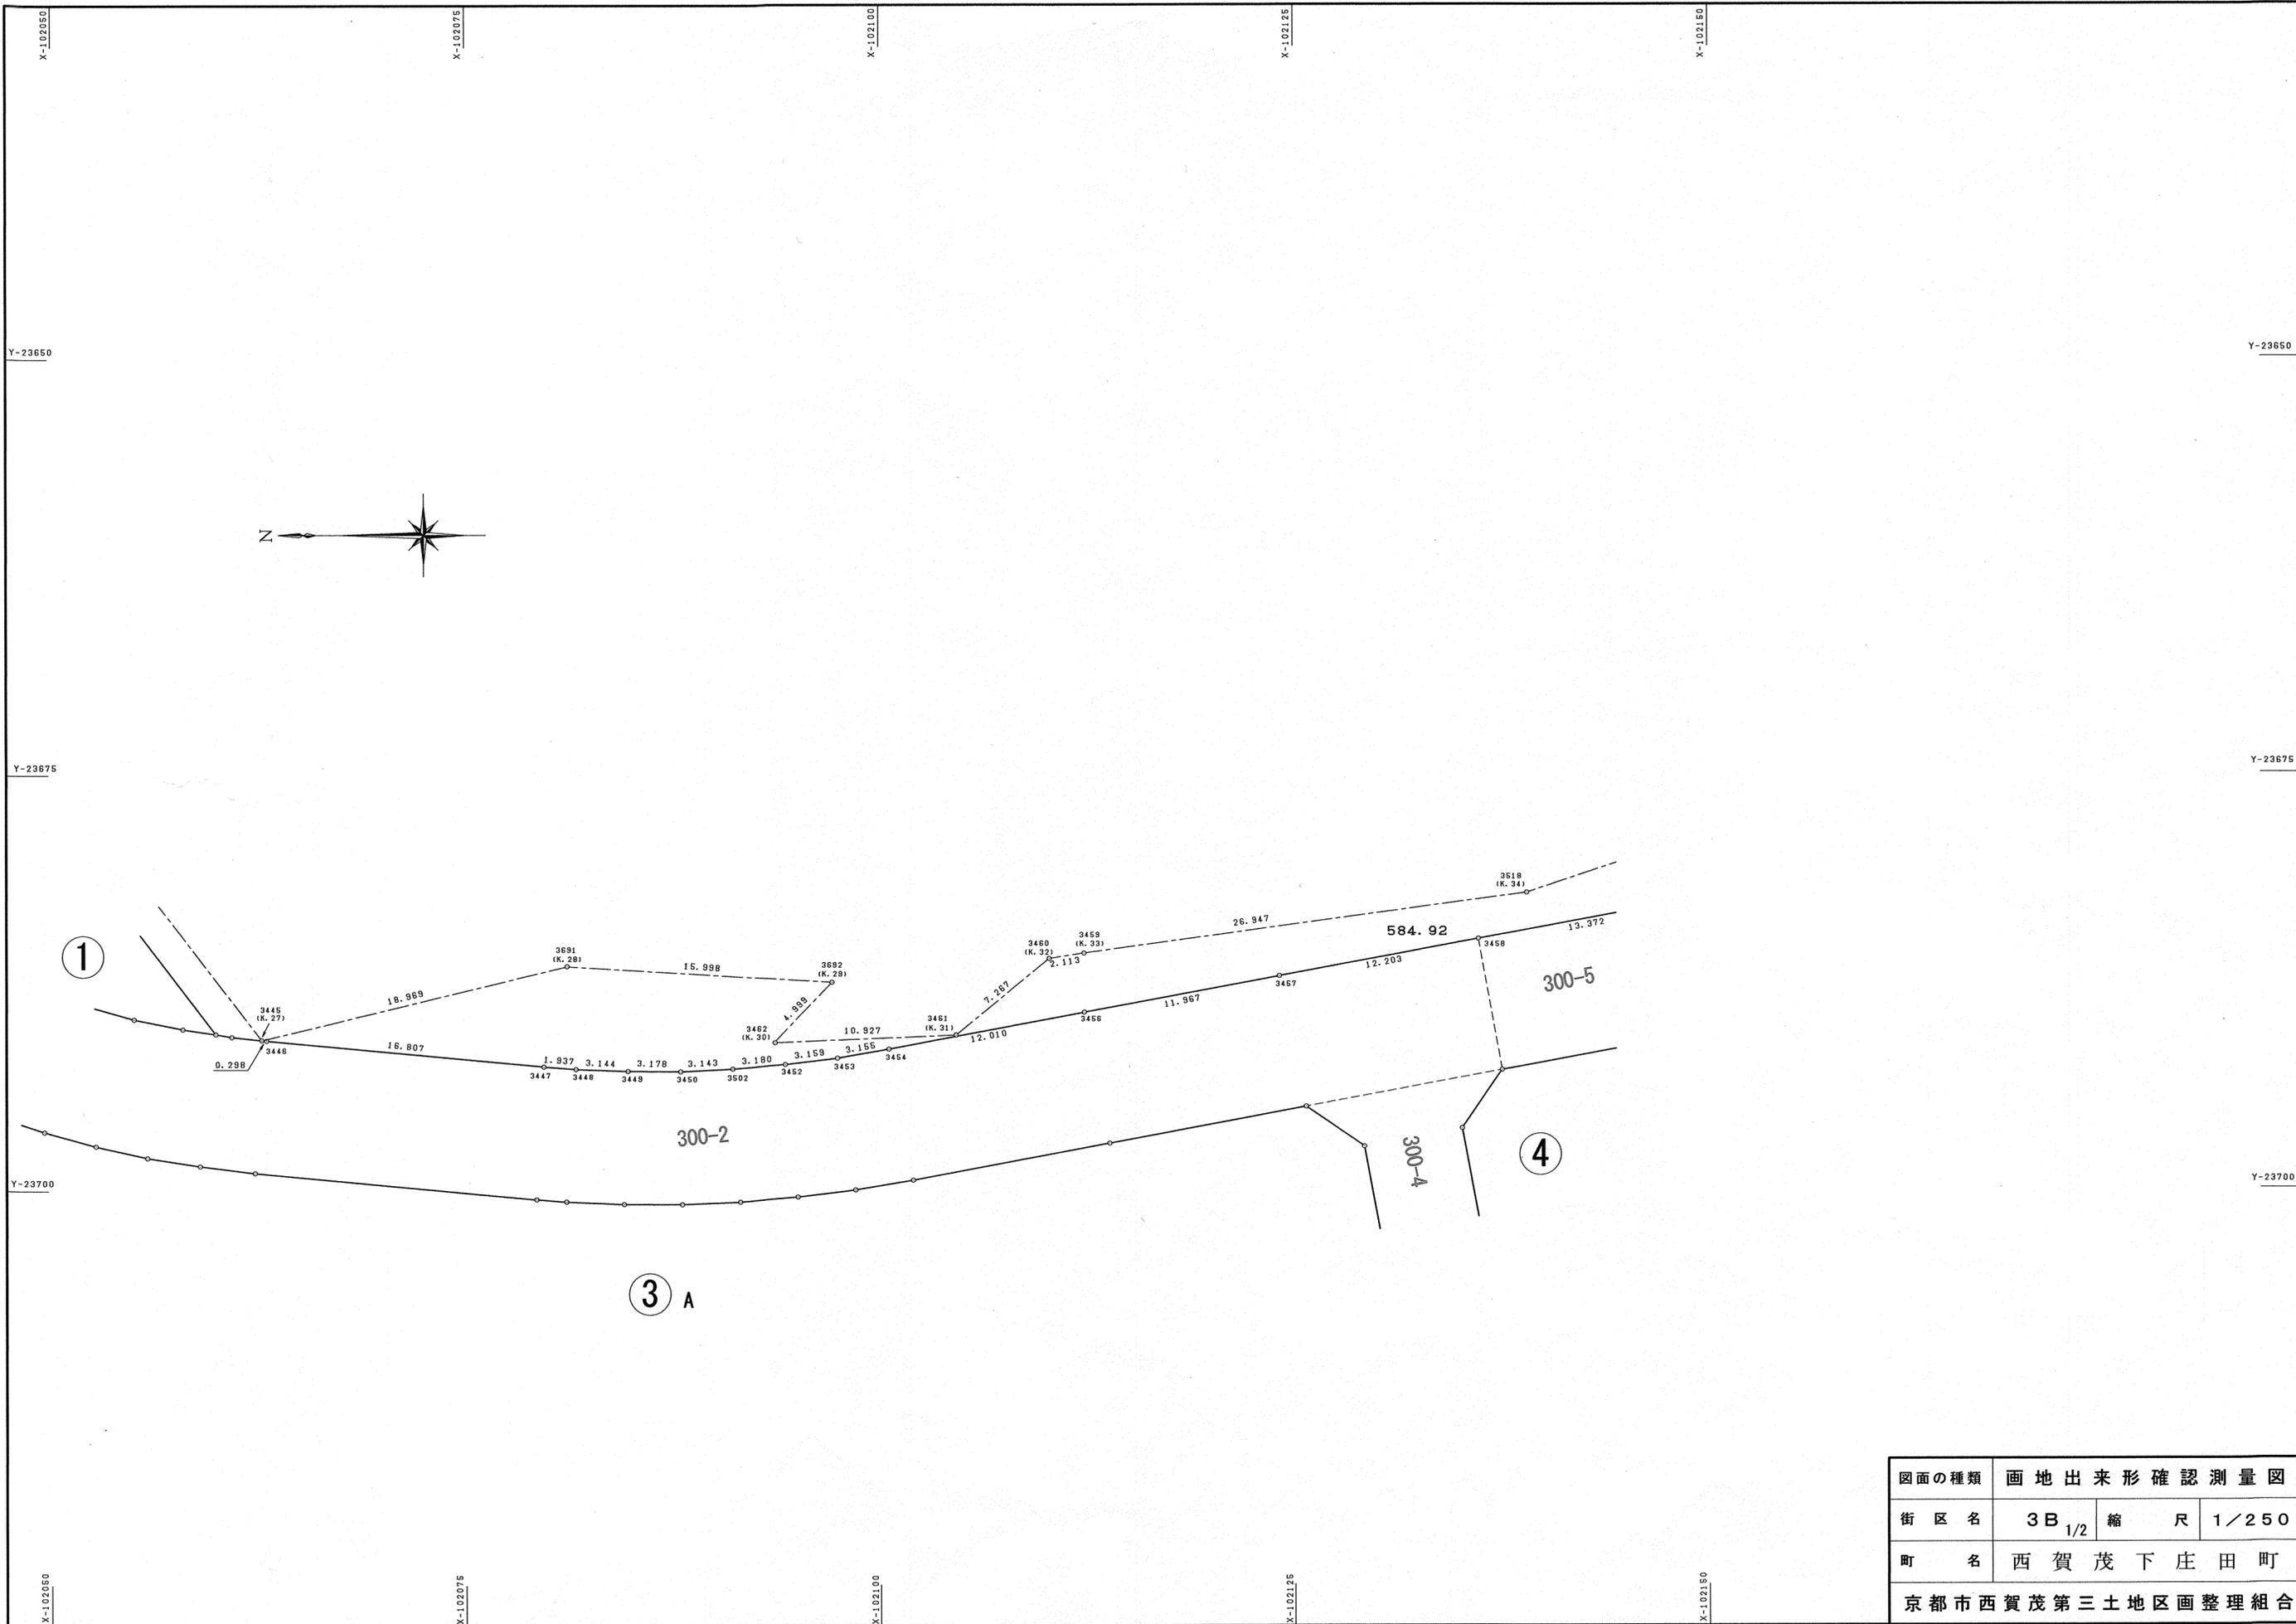

図面の種類	画地出来形確認測量図		
街区名	3B _{1/2}	縮尺	1/250
町名	西賀茂下庄田町		
京都市西賀茂第三土地区画整理組合			

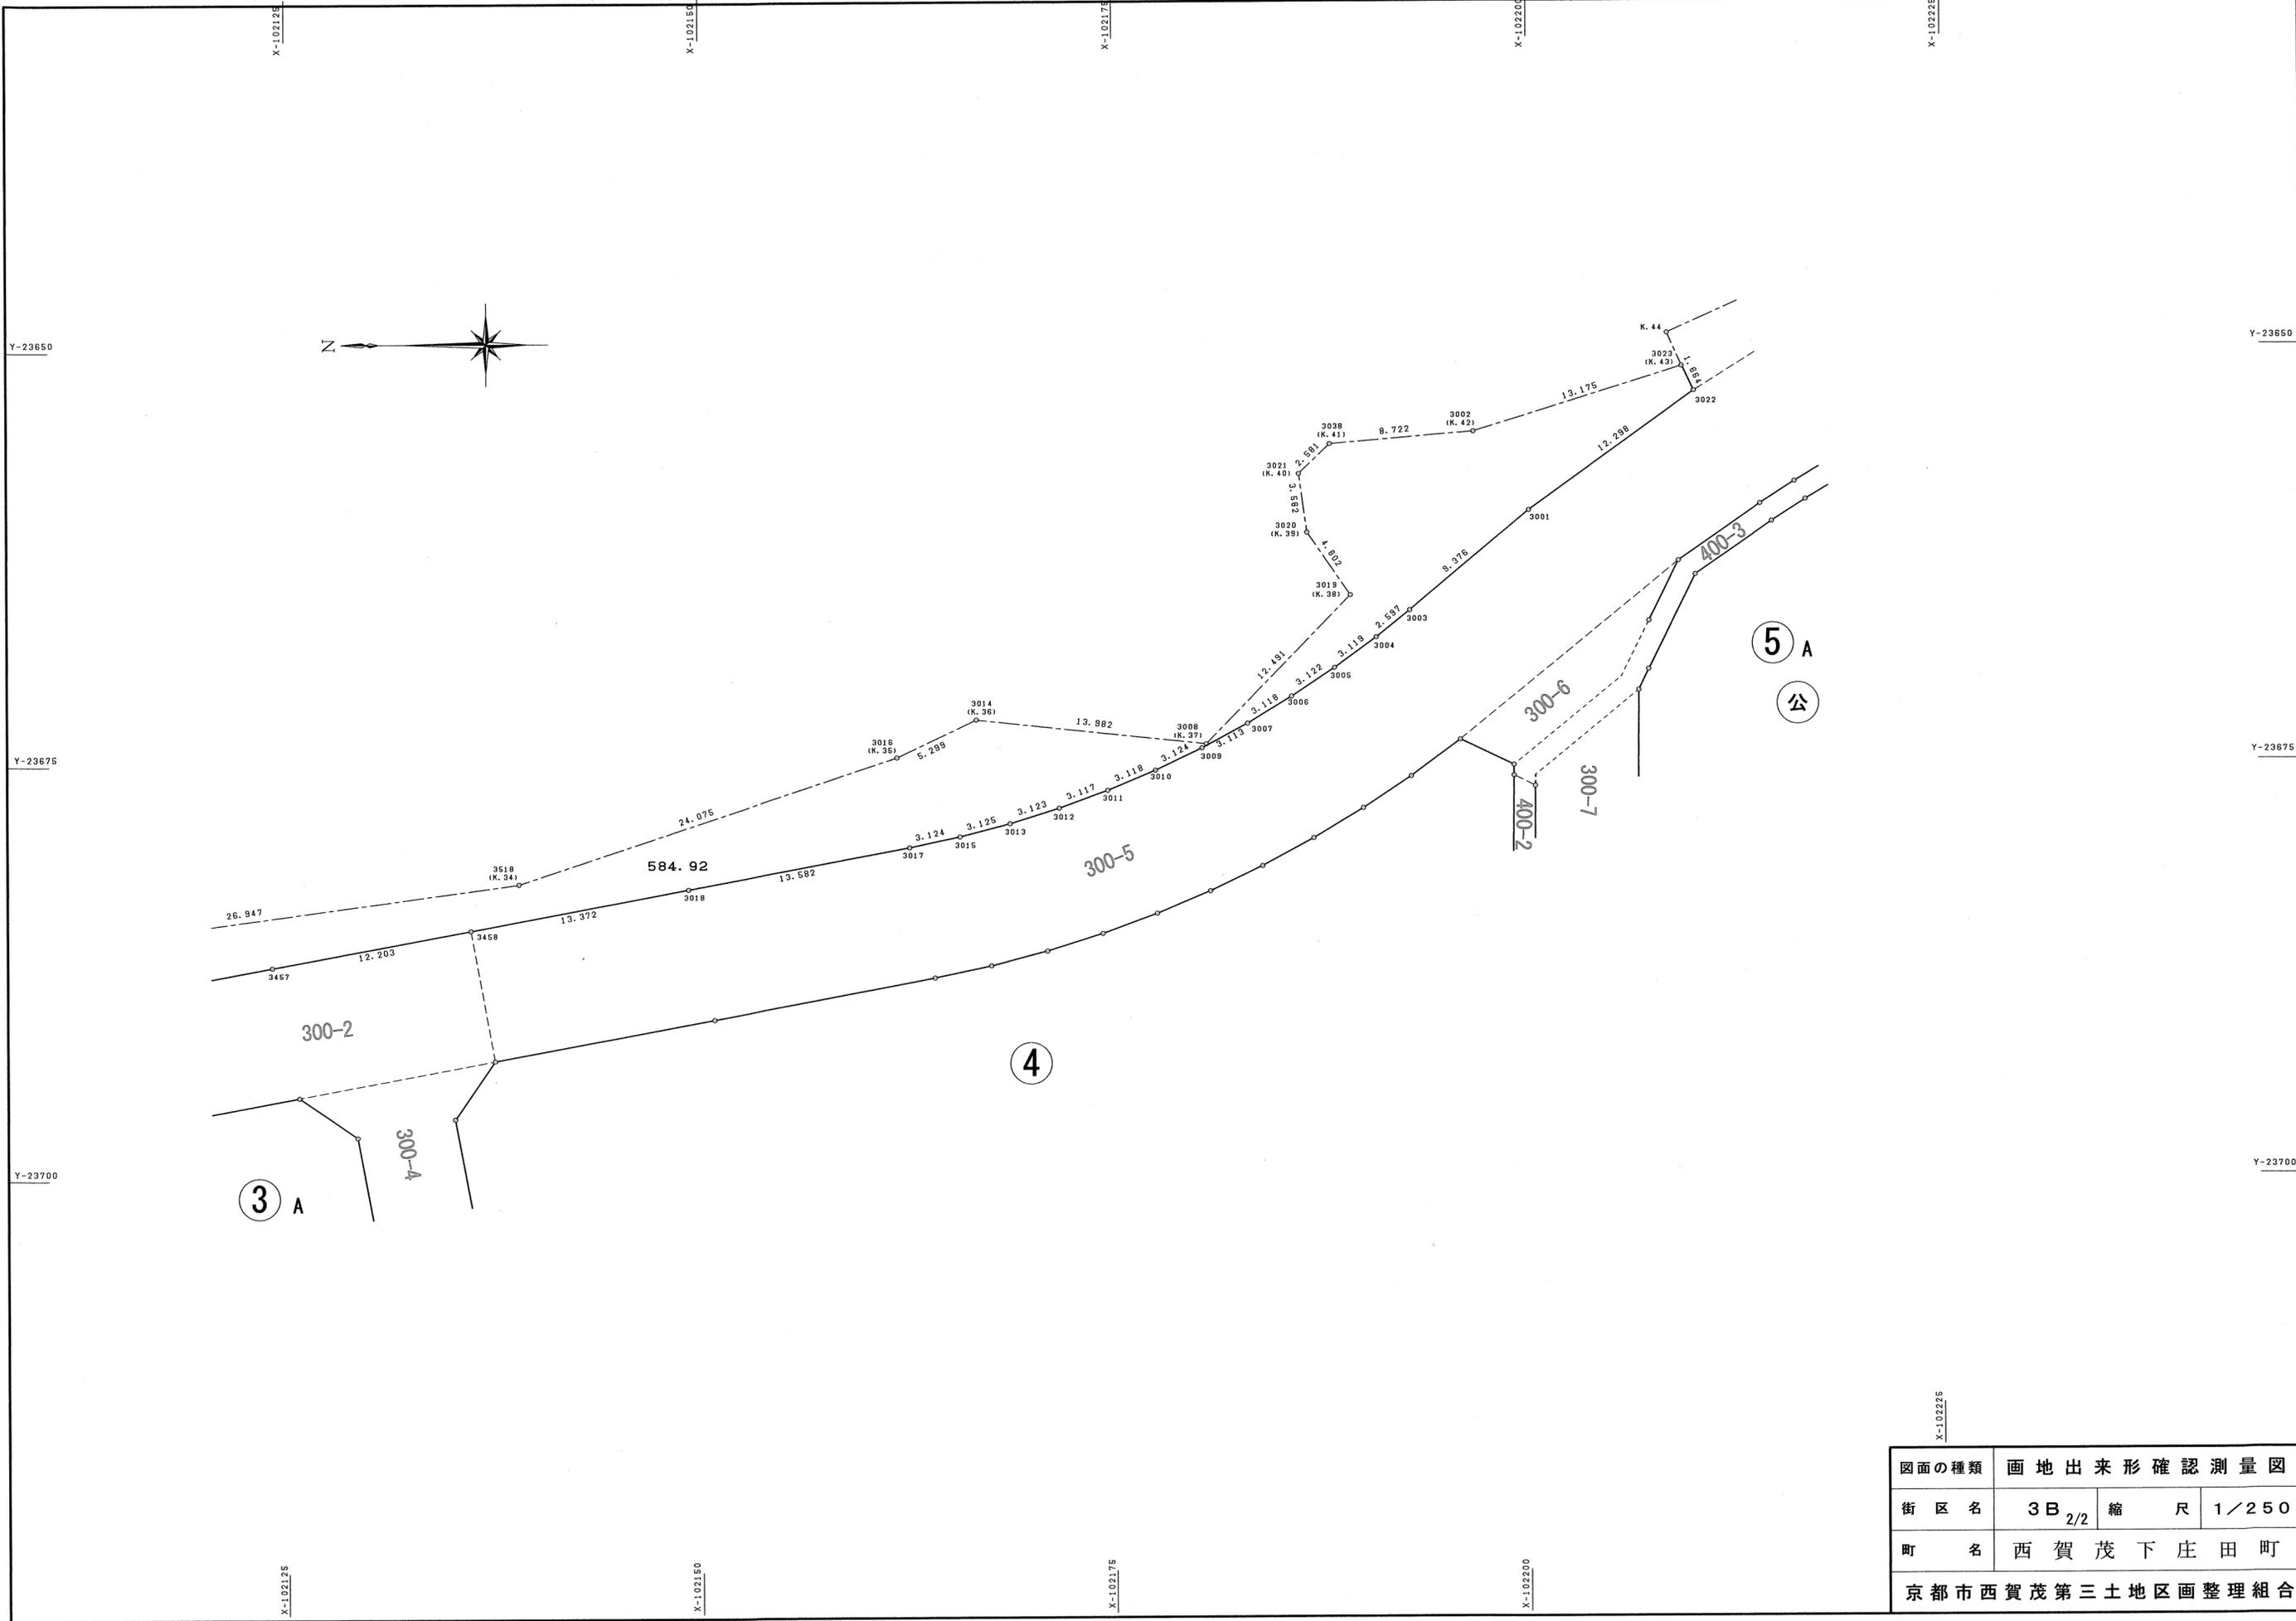


図面の種類	画地出来形確認測量図		
街区名	3B _{2/2}	縮尺	1/250
町名	西賀茂下庄田町		
京都市西賀茂第三土地区画整理組合			

河川敷地			
地番	X	Y	辺長
3445	-102062.683	-23690.926	
3446	-102062.980	-23690.958	0.298
3447	-102079.714	-23692.533	16.807
3448	-102081.645	-23692.687	1.937
3449	-102084.787	-23692.804	3.144
3450	-102087.965	-23692.838	3.178
3502	-102091.104	-23692.676	3.143
3452	-102094.275	-23692.425	3.180
3453	-102097.413	-23692.056	3.159
3454	-102100.521	-23691.511	3.155
3456	-102112.332	-23689.330	12.010
3457	-102124.101	-23687.160	11.967
3458	-102136.103	-23684.949	12.203
3018	-102149.251	-23682.508	13.372
3017	-102162.606	-23680.033	13.582
3015	-102165.664	-23679.393	3.124
3013	-102168.691	-23678.615	3.125
3012	-102171.674	-23677.689	3.123
3011	-102174.606	-23676.629	3.117
3010	-102177.484	-23675.427	3.118
3009	-102180.309	-23674.092	3.124
3007	-102183.054	-23672.623	3.113
3006	-102185.724	-23671.011	3.118
3005	-102188.329	-23669.289	3.122
3004	-102190.852	-23667.454	3.119
3003	-102192.879	-23665.830	2.597
3001	-102200.070	-23659.813	9.376
3022	-102210.062	-23652.643	12.298
3023	-102209.338	-23651.144	1.664
3002	-102196.757	-23655.058	13.175
3038	-102188.065	-23655.791	8.722
3021	-102186.200	-23657.576	2.581
3020	-102186.689	-23661.125	3.582
3019	-102189.298	-23664.917	4.602
3008	-102180.566	-23673.849	12.491
3014	-102166.664	-23672.355	13.982
3016	-102161.864	-23674.602	5.299
3518	-102139.009	-23682.169	24.075
3459	-102112.302	-23685.764	26.947
3460	-102110.213	-23686.083	2.113
3461	-102104.584	-23690.680	7.267
3462	-102093.665	-23691.108	10.927
3692	-102097.097	-23687.473	4.999
3691	-102081.128	-23686.495	15.998
3445	-102062.683	-23690.926	18.969
面積	584.9209920		
地積	584.92 m ²		

図面の種類	画地出来形確認測量図	
街区名	3B	求積表
町名	西賀茂下庄田町	
京都市西賀茂第三土地区画整理組合		



西賀茂蛙ヶ谷町

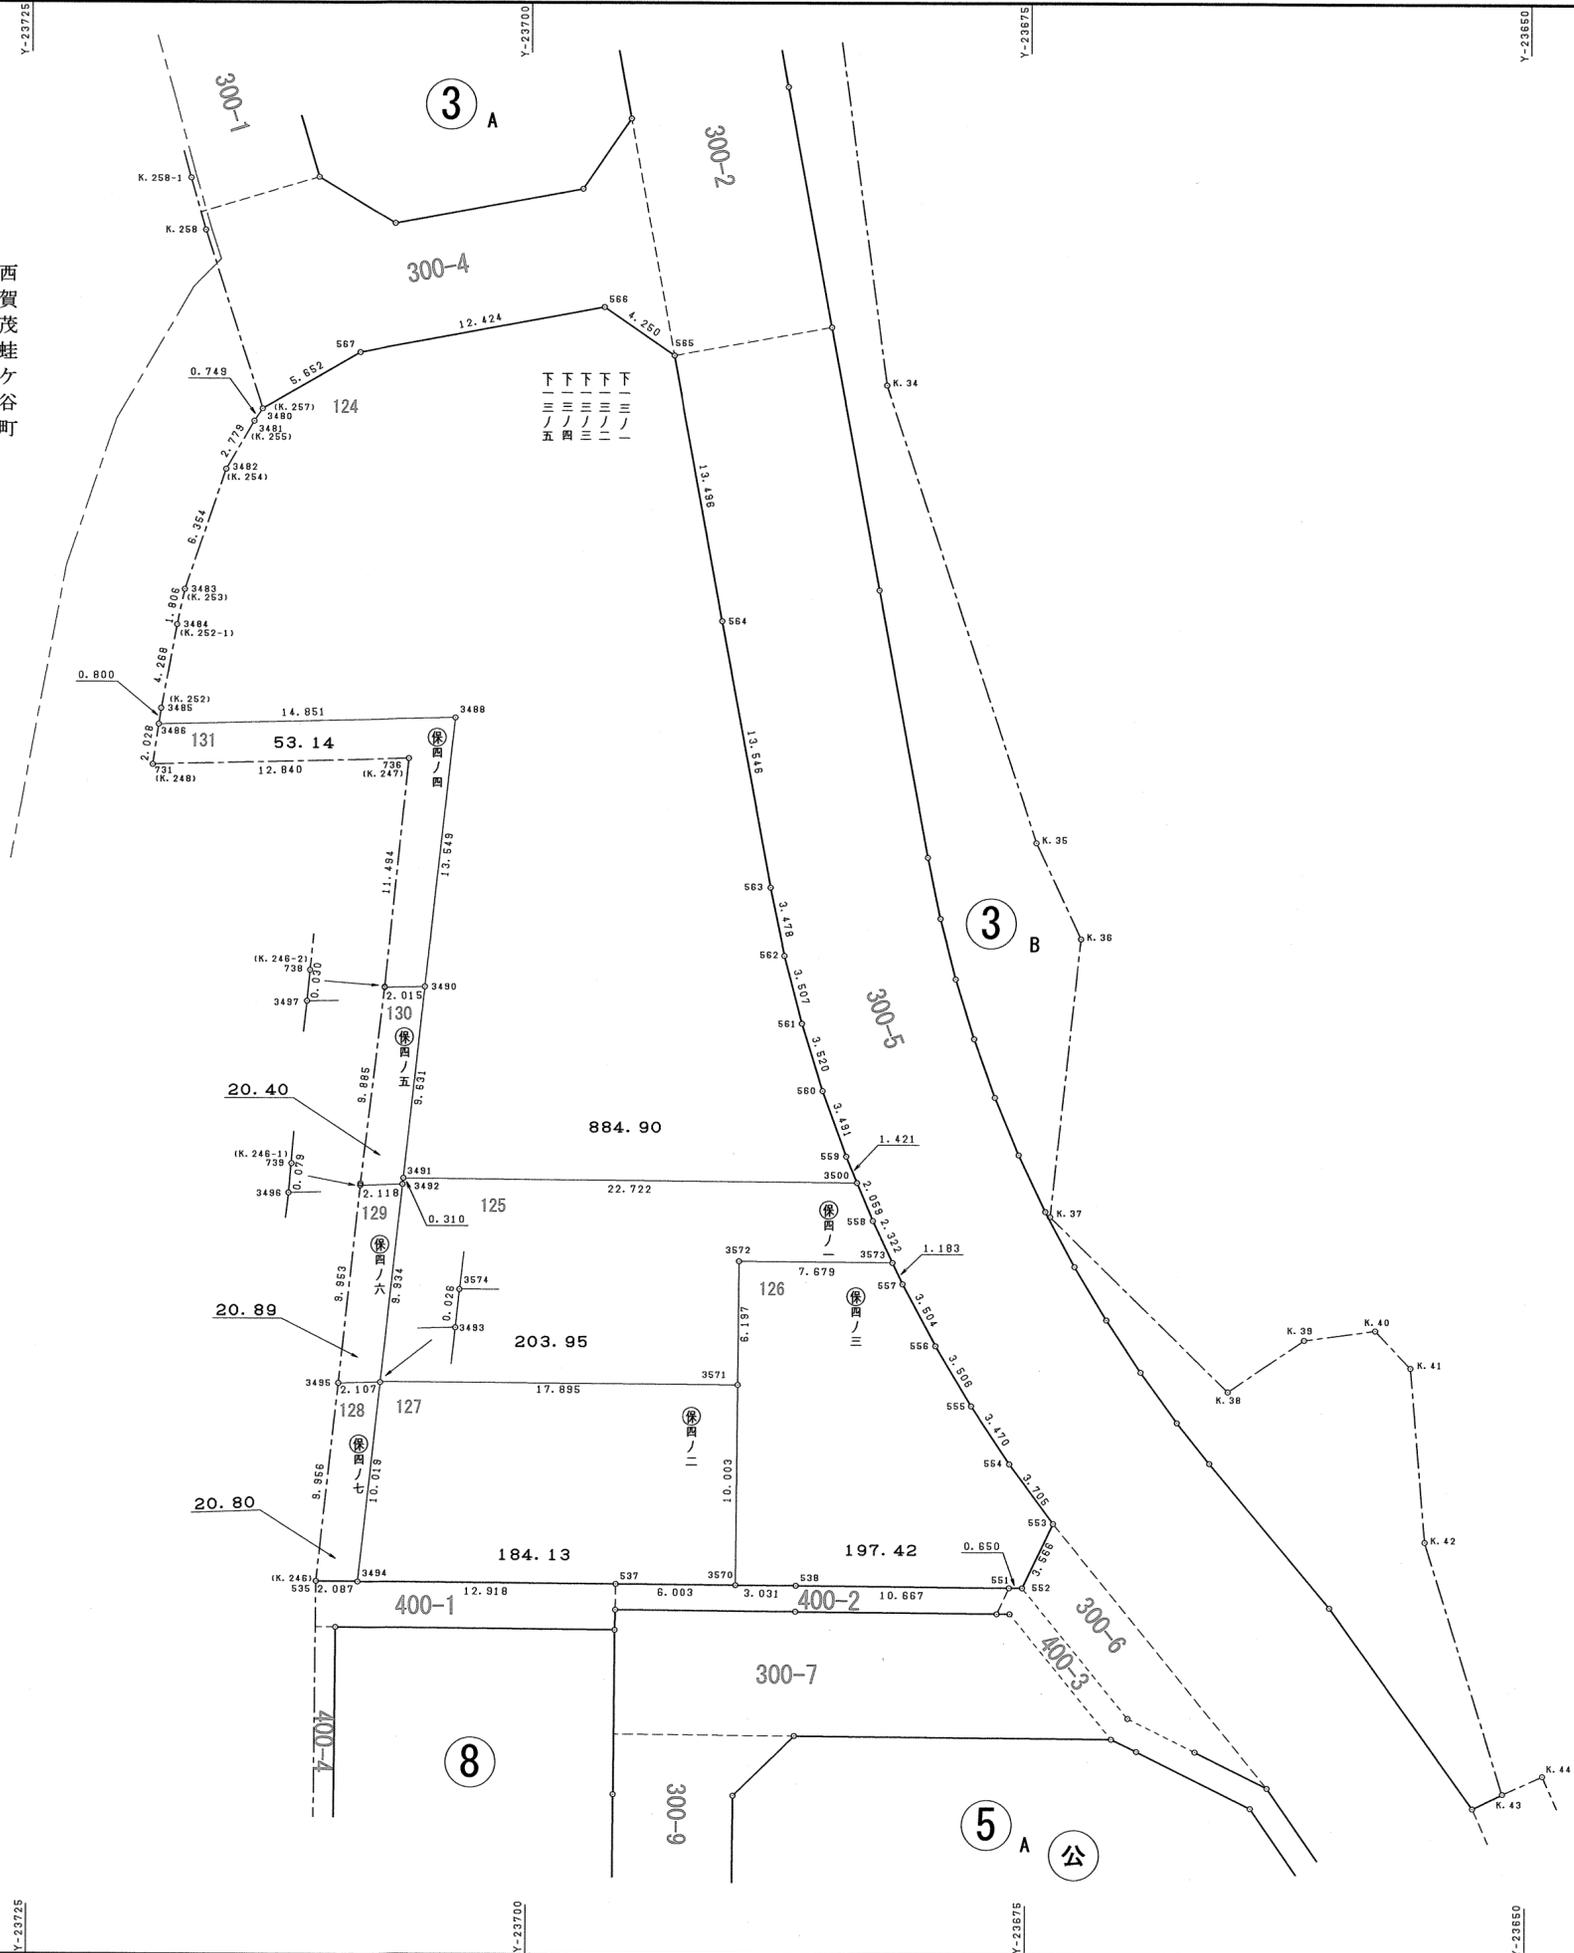

図面の種類	画地出来形確認測量図		
街区名	4	縮尺	1/250
町名	西賀茂下庄田町		
京都市西賀茂第三土地区画整理組合			

124

地番	下一三ノ一, 下一三ノ二, 下一三ノ三 下一三ノ四, 下一三ノ五		
NO	X	Y	辺長
3480	-102140.218	-23713.431	
3481	-102140.841	-23713.847	0.749
3482	-102143.244	-23715.244	2.779
3483	-102149.262	-23717.283	6.354
3484	-102151.028	-23717.663	1.806
3485	-102155.224	-23718.444	4.268
3486	-102156.015	-23718.564	0.800
3488	-102155.653	-23703.717	14.851
3490	-102169.122	-23705.189	13.549
3491	-102178.697	-23706.234	9.631
3500	-102178.876	-23683.512	22.722
559	-102177.564	-23684.060	1.421
560	-102174.284	-23685.256	3.491
561	-102170.922	-23686.301	3.520
562	-102167.529	-23687.190	3.507
563	-102164.124	-23687.900	3.478
564	-102150.806	-23690.380	13.546
565	-102137.533	-23692.827	13.496
566	-102135.118	-23696.325	4.250
567	-102137.383	-23708.541	12.424
3480	-102140.218	-23713.431	5.652
面積	884.9088640		
地積	884.90 m ²		

125

地番	保四ノ一		
NO	X	Y	辺長
3491	-102178.697	-23706.234	
3492	-102179.005	-23706.270	0.310
3574	-102188.881	-23707.343	9.934
3571	-102189.014	-23689.448	17.895
3572	-102182.817	-23689.399	6.197
3573	-102182.873	-23681.720	7.679
558	-102180.776	-23682.718	2.322
3500	-102178.876	-23683.512	2.059
3491	-102178.697	-23706.234	22.723
面積	203.9531040		
地積	203.95 m ²		

126

地番	保四ノ三		
NO	X	Y	辺長
3572	-102182.817	-23689.399	
3571	-102189.014	-23689.448	6.197
3570	-102199.017	-23689.523	10.003
538	-102199.038	-23686.492	3.031
551	-102199.128	-23675.825	10.667
552	-102199.135	-23675.175	0.650
553	-102195.915	-23673.641	3.566
554	-102192.932	-23675.839	3.705
555	-102190.043	-23677.762	3.470
556	-102187.033	-23679.560	3.506
557	-102183.942	-23681.212	3.504
3573	-102182.873	-23681.720	1.183
3572	-102182.817	-23689.399	7.679
面積	197.4207620		
地積	197.42 m ²		

127

地番	保四ノ二		
NO	X	Y	辺長
3574	-102188.881	-23707.343	
3493	-102188.906	-23707.352	0.026
3494	-102198.866	-23708.444	10.019
537	-102198.974	-23695.526	12.918
3570	-102199.017	-23689.523	6.003
3571	-102189.014	-23689.448	10.003
3574	-102188.881	-23707.343	17.895
面積	184.1306430		
地積	184.13 m ²		

128

地番	保四ノ七		
NO	X	Y	辺長
3495	-102188.949	-23709.459	
535	-102198.848	-23710.531	9.956
3494	-102198.866	-23708.444	2.087
3493	-102188.906	-23707.352	10.019
3495	-102188.949	-23709.459	2.107
面積	20.8086365		
地積	20.80 m ²		

129

地番	保四ノ六		
NO	X	Y	辺長
3496	-102179.053	-23708.388	
3495	-102188.949	-23709.459	9.953
3493	-102188.906	-23707.352	2.107
3574	-102188.881	-23707.343	0.026
3492	-102179.005	-23706.270	9.934
3496	-102179.053	-23708.388	2.118
面積	20.8926300		
地積	20.89 m ²		


130

地番	保四ノ五		
NO	X	Y	辺長
3497	-102169.159	-23707.204	
739	-102178.974	-23708.379	9.885
3496	-102179.053	-23708.388	0.079
3492	-102179.005	-23706.270	2.118
3491	-102178.697	-23706.234	0.310
3490	-102169.122	-23705.189	9.631
3497	-102169.159	-23707.204	2.015
面積	20.4001190		
地積	20.40 m ²		

131

地番	保四ノ四		
NO	X	Y	辺長
3486	-102156.015	-23718.564	
731	-102158.021	-23718.864	2.028
736	-102157.694	-23706.028	12.840
738	-102169.129	-23707.200	11.494
3497	-102169.159	-23707.204	0.030
3490	-102169.122	-23705.189	2.015
3488	-102155.653	-23703.717	13.549
3486	-102156.015	-23718.564	14.851
面積	53.1437255		
地積	53.14 m ²		

図面の種類	画地出来形確認測量図	
街区名	4	求積表
町名	西賀茂下庄田町	
京都市西賀茂第三土地区画整理組合		

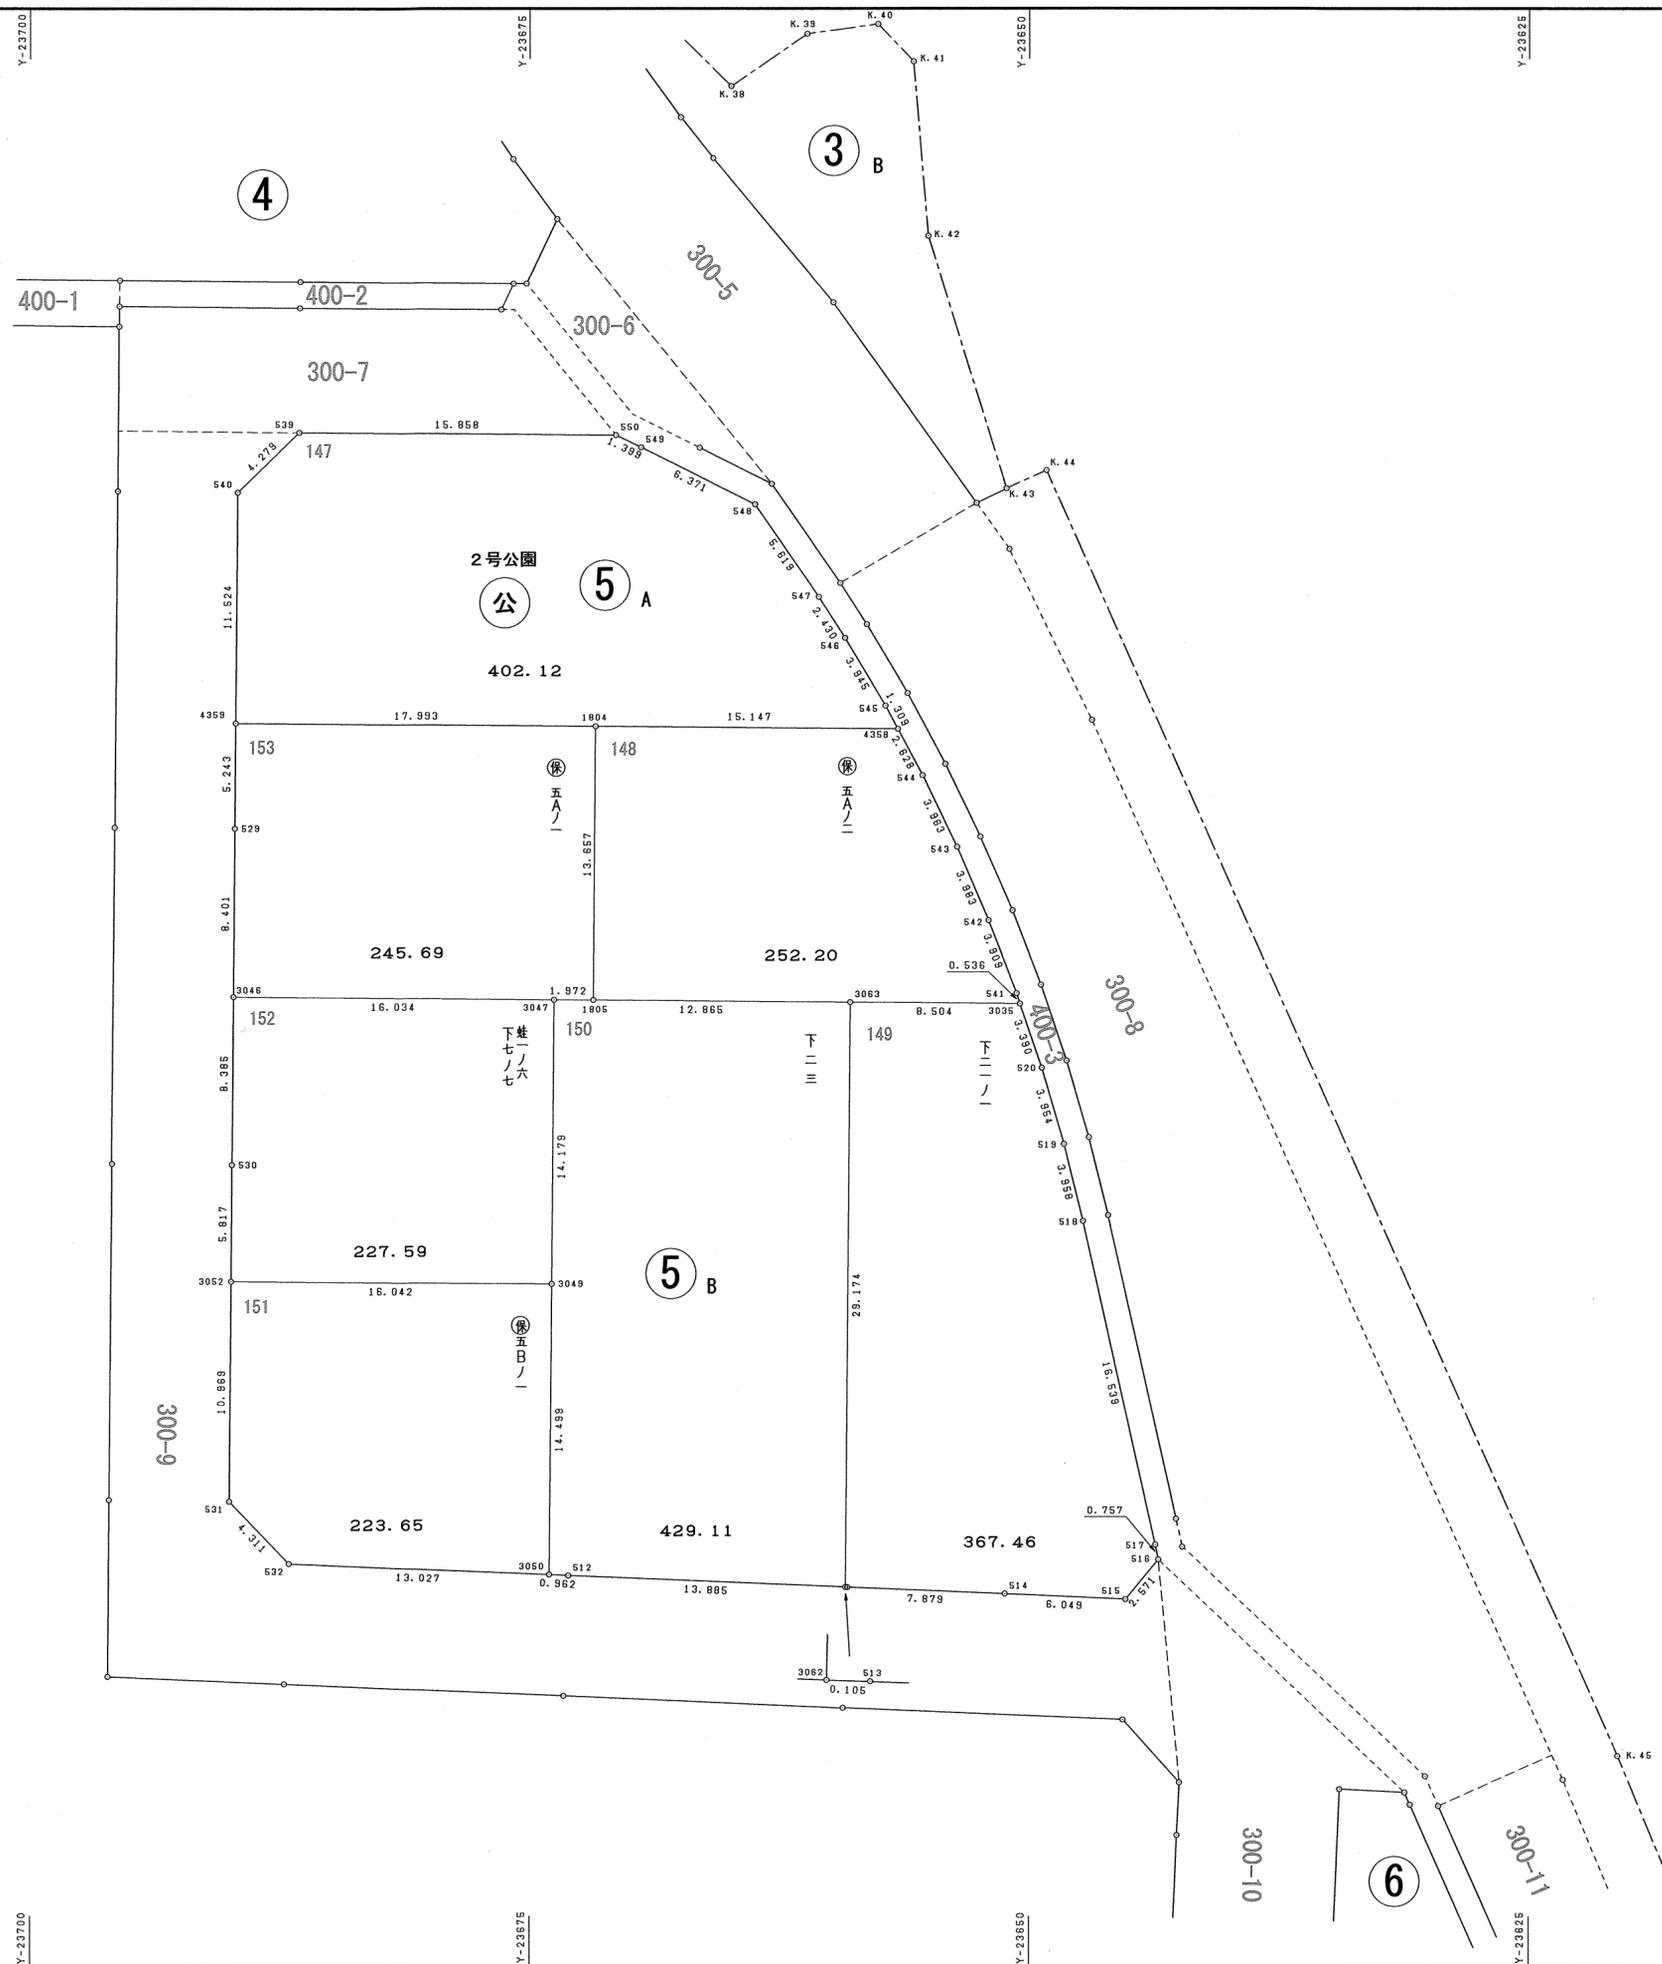

図面の種類	画地出来形確認測量図		
街区名	5AB	縮尺	1/250
町名	西賀茂下庄田町		
京都市西賀茂第三土地区画整理組合			

147

地番 2号公園			
NO	X	Y	辺長
539	-102206.554	-23686.554	
540	-102209.542	-23689.617	4.279
4359	-102221.066	-23689.713	11.524
1804	-102221.209	-23671.720	17.993
4358	-102221.335	-23656.573	15.147
545	-102220.182	-23657.193	1.309
546	-102216.794	-23659.215	3.945
547	-102214.751	-23660.532	2.430
548	-102210.129	-23663.729	5.619
549	-102207.293	-23669.435	6.371
550	-102206.685	-23670.696	1.399
539	-102206.554	-23686.554	15.858
面積	402.1276190		
地積	402.12 m ²		

148

地番 保五Aノ二			
NO	X	Y	辺長
1804	-102221.209	-23671.720	
1805	-102234.866	-23671.818	13.657
3063	-102234.965	-23658.953	12.865
3035	-102235.033	-23650.449	8.504
541	-102234.525	-23650.620	0.536
542	-102230.878	-23652.029	3.909
543	-102227.222	-23653.610	3.983
544	-102223.651	-23655.329	3.963
4358	-102221.335	-23656.573	2.628
1804	-102221.209	-23671.720	15.147
面積	252.2064365		
地積	252.20 m ²		

149

地番 下二一ノ一			
NO	X	Y	辺長
3063	-102234.965	-23658.953	
3062	-102264.139	-23659.180	29.174
513	-102264.143	-23659.075	0.105
514	-102264.465	-23651.202	7.879
515	-102264.748	-23645.159	6.049
516	-102262.763	-23643.524	2.571
517	-102262.021	-23643.676	0.757
518	-102245.884	-23647.304	16.539
519	-102242.042	-23648.256	3.958
520	-102238.246	-23649.365	3.954
3035	-102235.033	-23650.449	3.390
3063	-102234.965	-23658.953	8.504
面積	367.4647750		
地積	367.46 m ²		

150

地番 下二三			
NO	X	Y	辺長
3047	-102234.845	-23673.790	
3049	-102249.024	-23673.895	14.179
3050	-102263.523	-23674.016	14.499
512	-102263.563	-23673.054	0.962
3062	-102264.139	-23659.180	13.885
3063	-102234.965	-23658.953	29.174
1805	-102234.866	-23671.818	12.865
3047	-102234.845	-23673.790	1.972
面積	429.1102745		
地積	429.11 m ²		

151

地番 保五Bノ一			
NO	X	Y	辺長
3052	-102248.912	-23689.937	
531	-102259.881	-23690.026	10.969
532	-102262.984	-23687.032	4.311
3050	-102263.523	-23674.016	13.027
3049	-102249.024	-23673.895	14.499
3052	-102248.912	-23689.937	16.042
面積	223.6596100		
地積	223.65 m ²		


152

地番 蛙一ノ六, 下七ノ七			
NO	X	Y	辺長
3046	-102234.710	-23689.824	
530	-102243.095	-23689.890	8.385
3052	-102248.912	-23689.937	5.817
3049	-102249.024	-23673.895	16.042
3047	-102234.845	-23673.790	14.179
3046	-102234.710	-23689.824	16.034
面積	227.5956140		
地積	227.59 m ²		

153

地番 保五Aノ一			
NO	X	Y	辺長
4359	-102221.066	-23689.713	
529	-102226.309	-23689.757	5.243
3046	-102234.710	-23689.824	8.401
3047	-102234.845	-23673.790	16.034
1805	-102234.866	-23671.818	1.972
1804	-102221.209	-23671.720	13.657
4359	-102221.066	-23689.713	17.993
面積	245.6917320		
地積	245.69 m ²		

図面の種類	画地出来形確認測量図	
街区名	5AB	求積表
町名	西賀茂下庄田町	
京都市西賀茂第三土地区画整理組合		

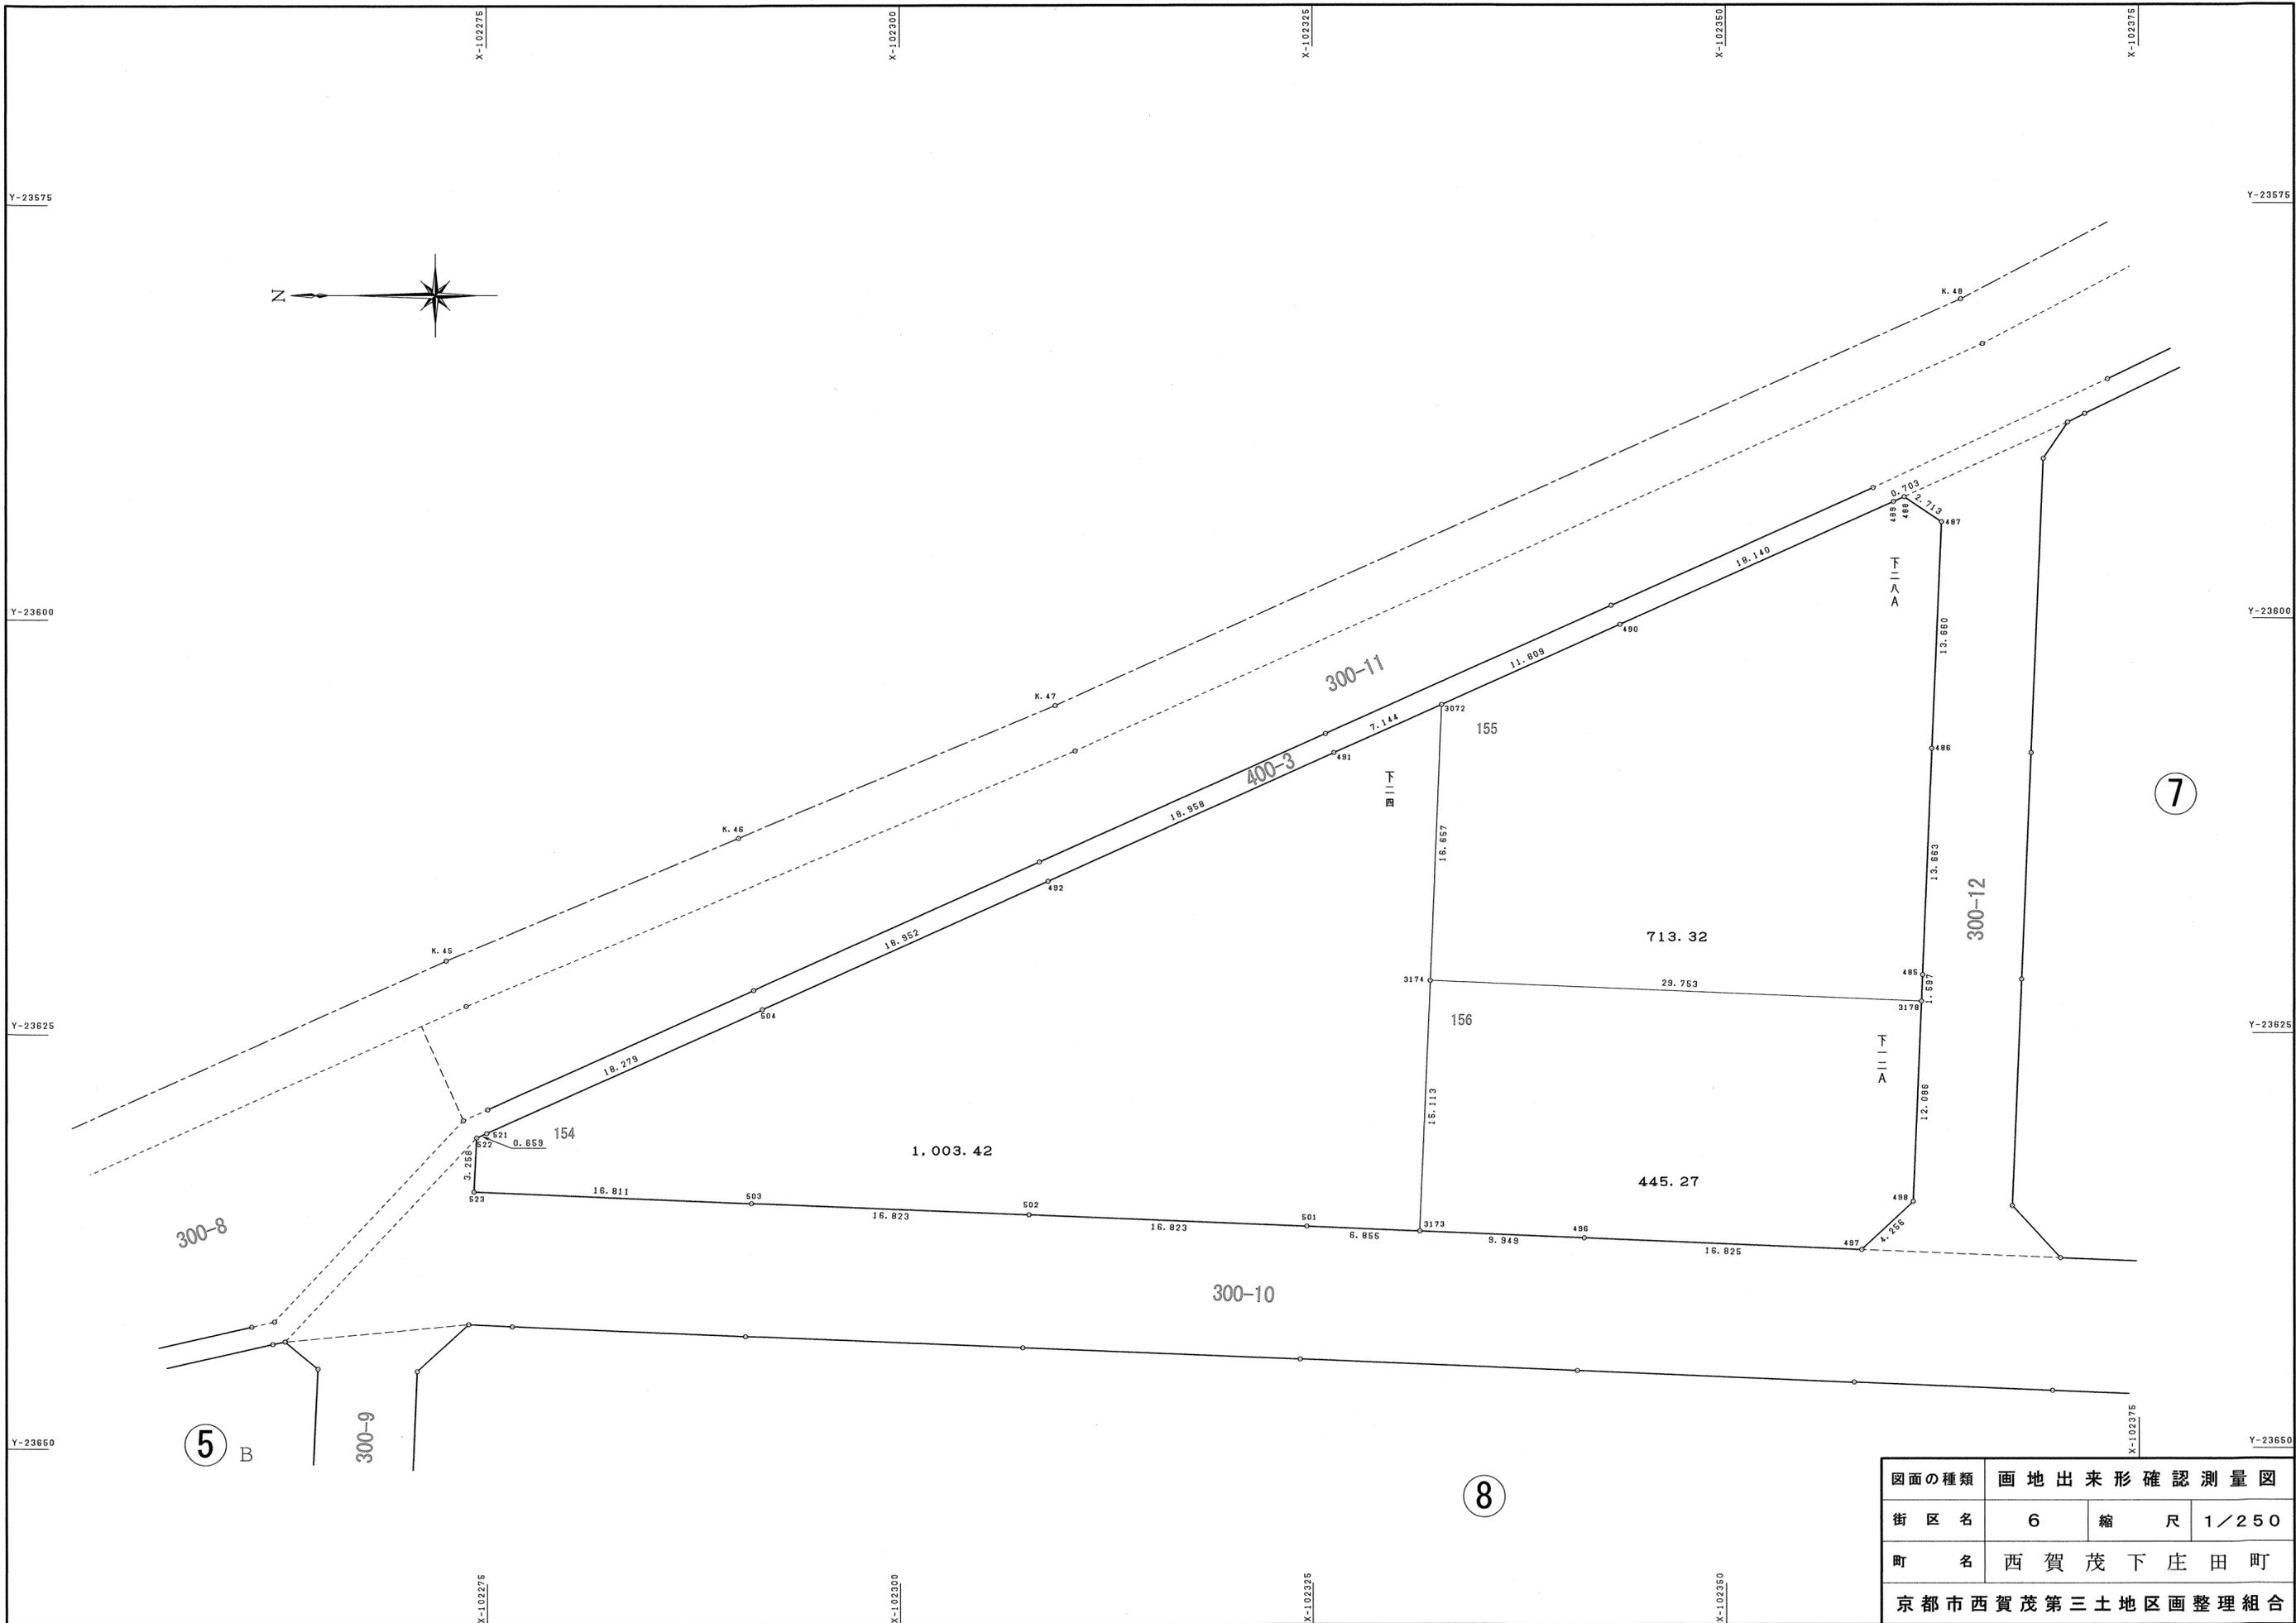

図面の種類	画地出来形確認測量図		
街区名	6	縮尺	1/250
町名	西賀茂下庄田町		
京都市西賀茂第三土地区画整理組合			

154

地番	下二四		
NO	X	Y	辺長
522	-102274.368	-23631.220	
523	-102274.207	-23634.475	3.258
503	-102291.004	-23635.183	16.811
502	-102307.813	-23635.891	16.823
501	-102324.621	-23636.603	16.823
3173	-102331.470	-23636.894	6.855
3174	-102332.120	-23621.794	15.113
3072	-102332.813	-23605.151	16.657
491	-102326.290	-23608.065	7.144
492	-102308.975	-23615.787	18.958
504	-102291.666	-23623.507	18.952
521	-102274.970	-23630.950	18.279
522	-102274.368	-23631.220	0.659
面積	1003.4229905		
地積	1003.42 m ²		

155

地番	下二八A		
NO	X	Y	辺長
3072	-102332.813	-23605.151	
3174	-102332.120	-23621.794	16.657
3178	-102361.847	-23623.055	29.753
485	-102361.914	-23621.459	1.597
486	-102362.482	-23607.807	13.663
487	-102363.066	-23594.159	13.660
488	-102360.805	-23592.659	2.713
489	-102360.160	-23592.939	0.703
490	-102343.596	-23600.335	18.140
3072	-102332.813	-23605.151	11.809
面積	713.3273630		
地積	713.32 m ²		

156

地番	下一二A		
NO	X	Y	辺長
3174	-102332.120	-23621.794	
3173	-102331.470	-23636.894	15.113
496	-102341.411	-23637.316	9.949
497	-102358.221	-23638.028	16.825
498	-102361.339	-23635.131	4.256
3178	-102361.847	-23623.055	12.086
3174	-102332.120	-23621.794	29.753
面積	445.2745385		
地積	445.27 m ²		

図面の種類	画地出来形確認測量図	
街区名	6	求積表
町名	西賀茂下庄田町	
京都市西賀茂第三土地区画整理組合		



X-102375


X-102375

X-102400

X-102400

X-102425

X-102425

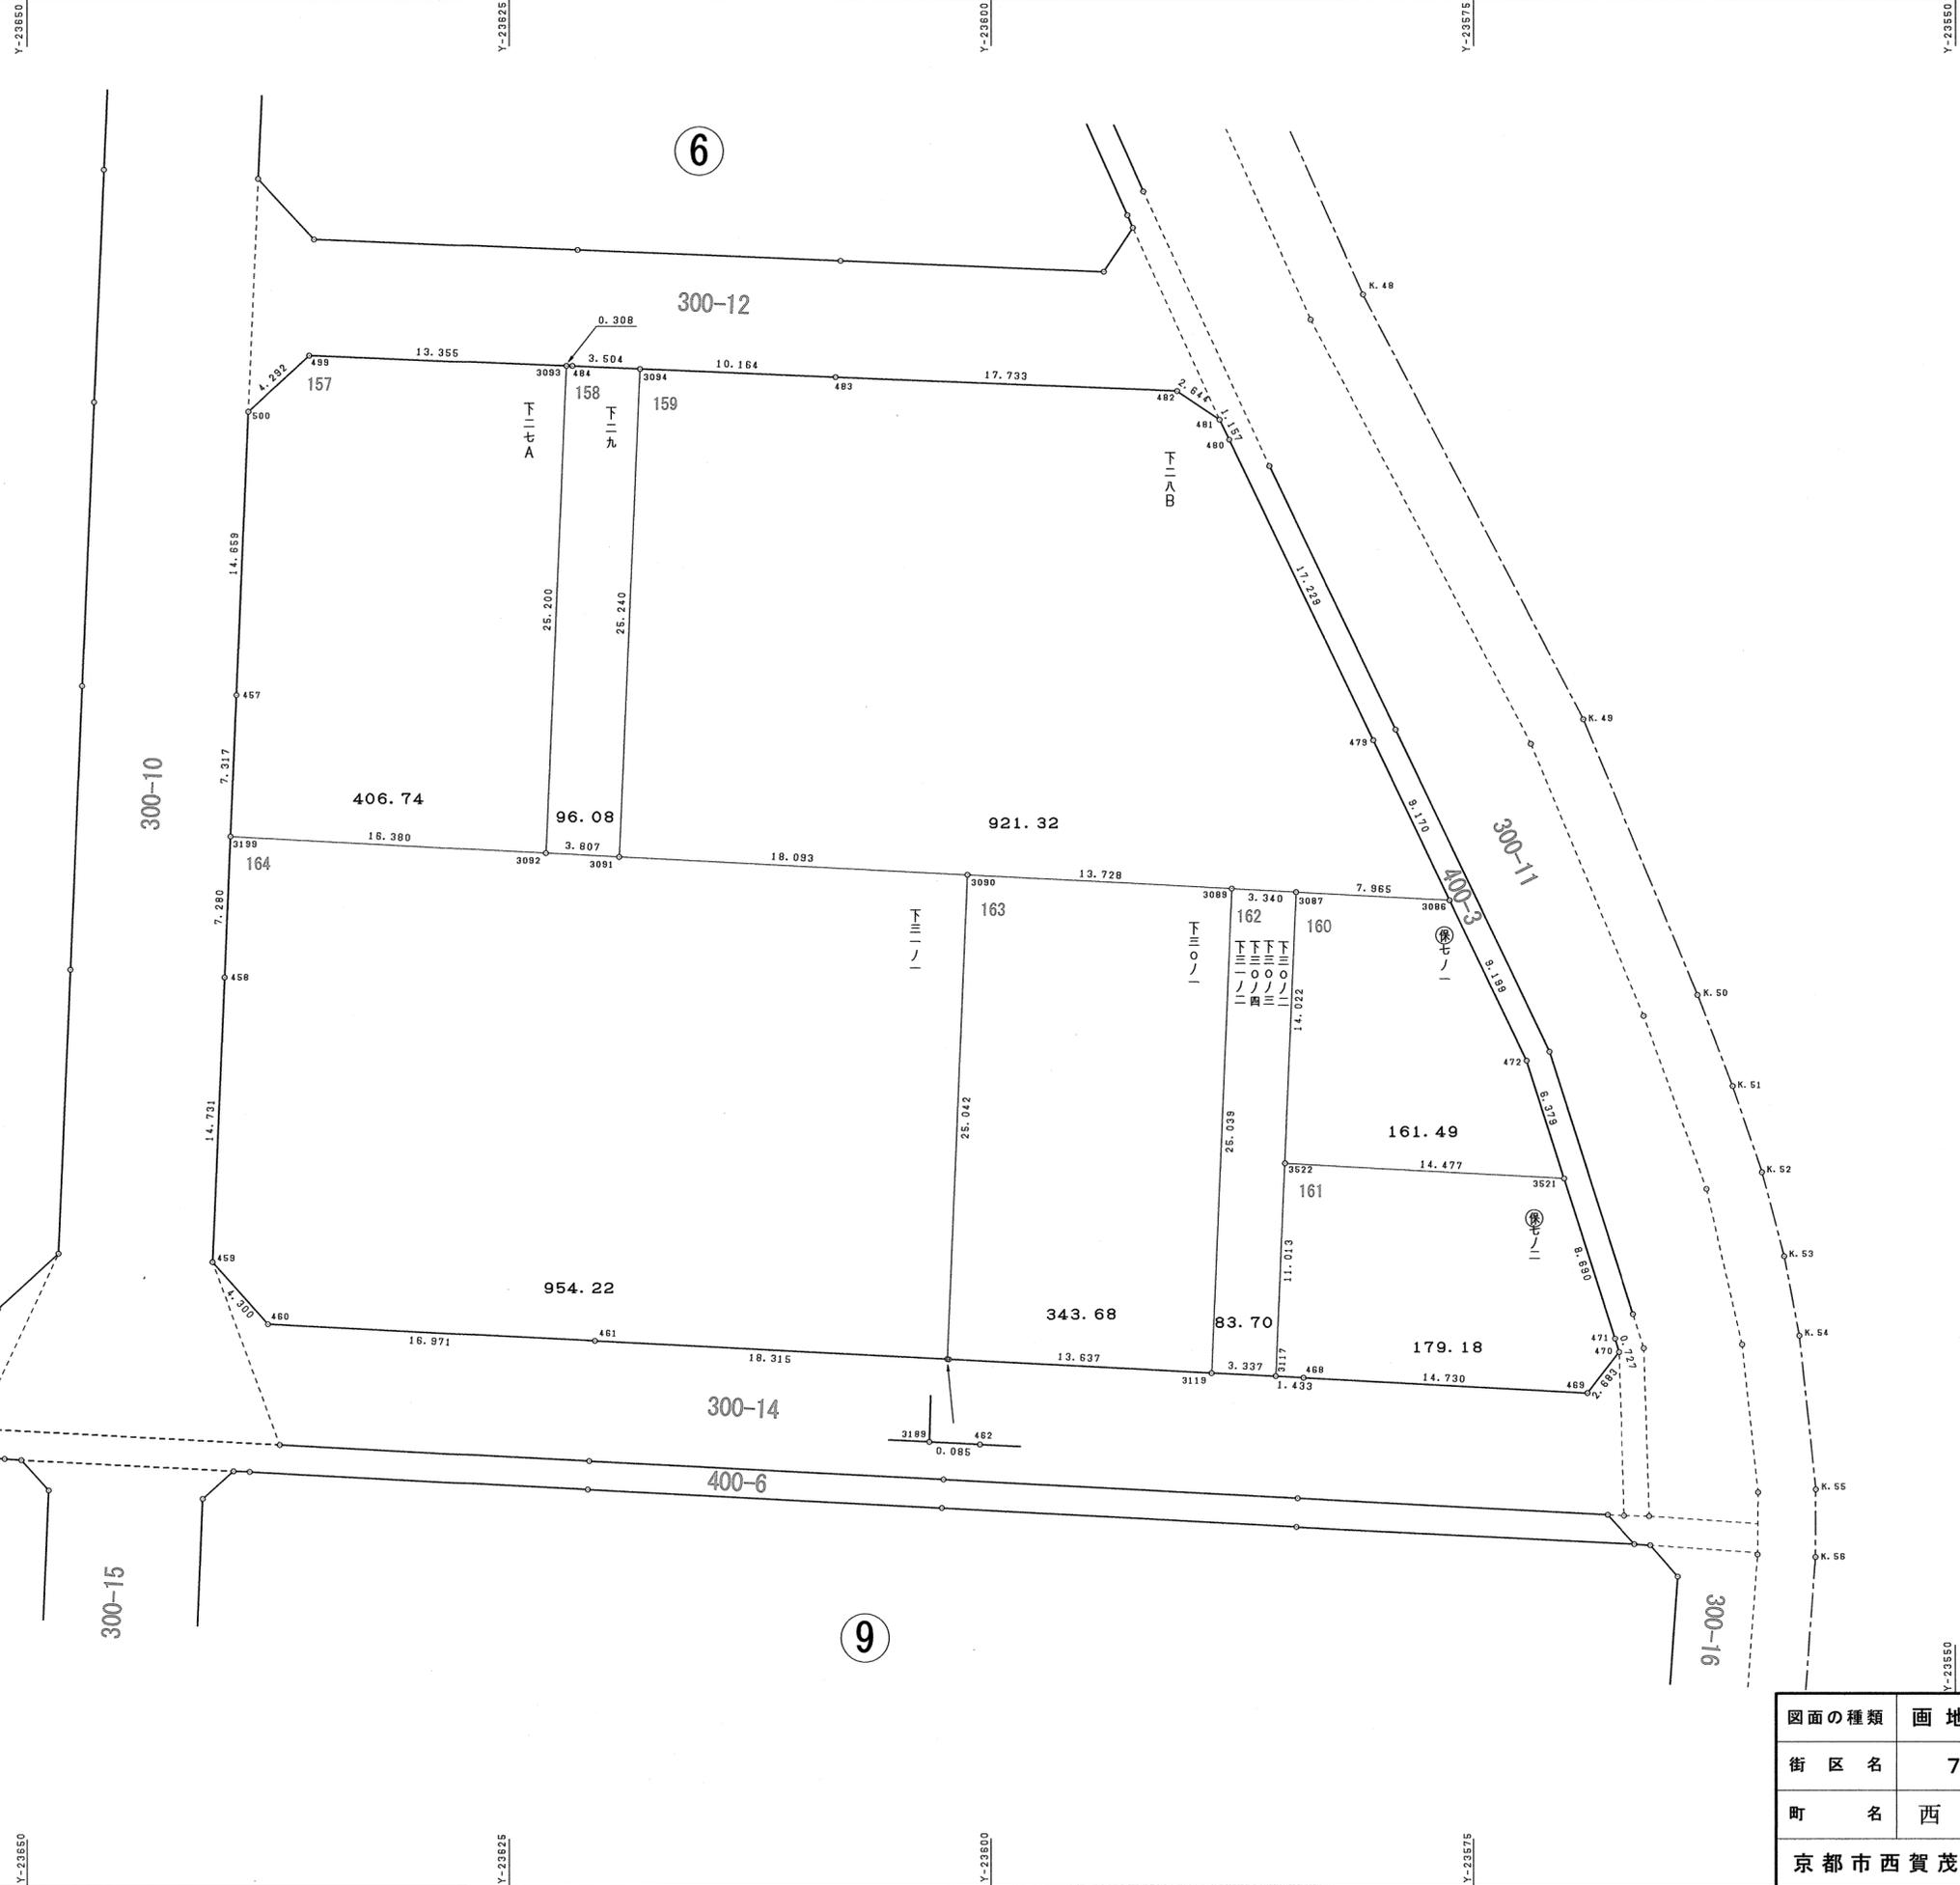

8

6

17

9

図面の種類	画地出来形確認測量図		
街区名	7	縮尺	1/250
町名	西賀茂下庄田町		
京都市西賀茂第三土地区画整理組合			

157

地番 下二七A			
NO	X	Y	辺長
499	-102367.338	-23635.378	
500	-102370.252	-23638.530	4.292
457	-102384.899	-23639.143	14.659
3199	-102392.210	-23639.448	7.317
3092	-102393.075	-23623.090	16.380
3093	-102367.897	-23622.034	25.200
499	-102367.338	-23635.378	13.355
面積	406.7465670		
地積	406.74 m ²		

158

地番 下二九			
NO	X	Y	辺長
3093	-102367.897	-23622.034	
3092	-102393.075	-23623.090	25.200
3091	-102393.276	-23619.288	3.807
3094	-102368.058	-23618.225	25.240
484	-102367.910	-23621.726	3.504
3093	-102367.897	-23622.034	0.308
面積	96.0827940		
地積	96.08 m ²		

159

地番 下二八B			
NO	X	Y	辺長
3094	-102368.058	-23618.225	
3091	-102393.276	-23619.288	25.240
3090	-102394.225	-23601.219	18.093
3089	-102394.951	-23587.510	13.728
3087	-102395.131	-23584.174	3.340
3086	-102395.542	-23576.219	7.965
479	-102387.275	-23580.189	9.170
480	-102371.742	-23587.645	17.229
481	-102370.705	-23588.160	1.157
482	-102369.226	-23590.352	2.644
483	-102368.488	-23608.070	17.733
3094	-102368.058	-23618.225	10.164
面積	921.3220485		
地積	921.32 m ²		

160

地番 保七ノ一			
NO	X	Y	辺長
3087	-102395.131	-23584.174	
3522	-102409.142	-23584.754	14.022
3521	-102409.911	-23570.297	14.477
472	-102403.834	-23572.237	6.379
3086	-102395.542	-23576.219	9.199
3087	-102395.131	-23584.174	7.965
面積	161.4933170		
地積	161.49 m ²		

161

地番 保七ノ二			
NO	X	Y	辺長
3522	-102409.142	-23584.754	
3117	-102420.145	-23585.224	11.013
468	-102420.221	-23583.793	1.433
469	-102421.008	-23569.084	14.730
470	-102418.886	-23567.442	2.683
471	-102418.190	-23567.654	0.727
3521	-102409.911	-23570.297	8.690
3522	-102409.142	-23584.754	14.477
面積	179.1809445		
地積	179.18 m ²		

162

地番 下三〇ノ二, 下三〇ノ三, 下三〇ノ四, 下三一ノ二			
NO	X	Y	辺長
3089	-102394.951	-23587.510	
3119	-102419.969	-23588.557	25.039
3117	-102420.145	-23585.224	3.337
3522	-102409.142	-23584.754	11.013
3087	-102395.131	-23584.174	14.022
3089	-102394.951	-23587.510	3.340
面積	83.7042000		
地積	83.70 m ²		


163

地番 下三〇ノ一			
NO	X	Y	辺長
3090	-102394.225	-23601.219	
3189	-102419.246	-23602.261	25.042
462	-102419.250	-23602.176	0.085
3119	-102419.969	-23588.557	13.637
3089	-102394.951	-23587.510	25.039
3090	-102394.225	-23601.219	13.728
面積	343.6831975		
地積	343.68 m ²		


164

地番 下三一ノ一			
NO	X	Y	辺長
3199	-102392.210	-23639.448	
458	-102399.484	-23639.751	7.280
459	-102414.202	-23640.376	14.731
460	-102417.400	-23637.500	4.300
461	-102418.281	-23620.551	16.971
3189	-102419.246	-23602.261	18.315
3090	-102394.225	-23601.219	25.042
3091	-102393.276	-23619.288	18.093
3092	-102393.075	-23623.090	3.807
3199	-102392.210	-23639.448	16.380
面積	954.2295500		
地積	954.22 m ²		

図面の種類	画地出来形確認測量図		
街区名	7	求積表	
町名	西賀茂下庄田町		
京都市西賀茂第三土地区画整理組合			

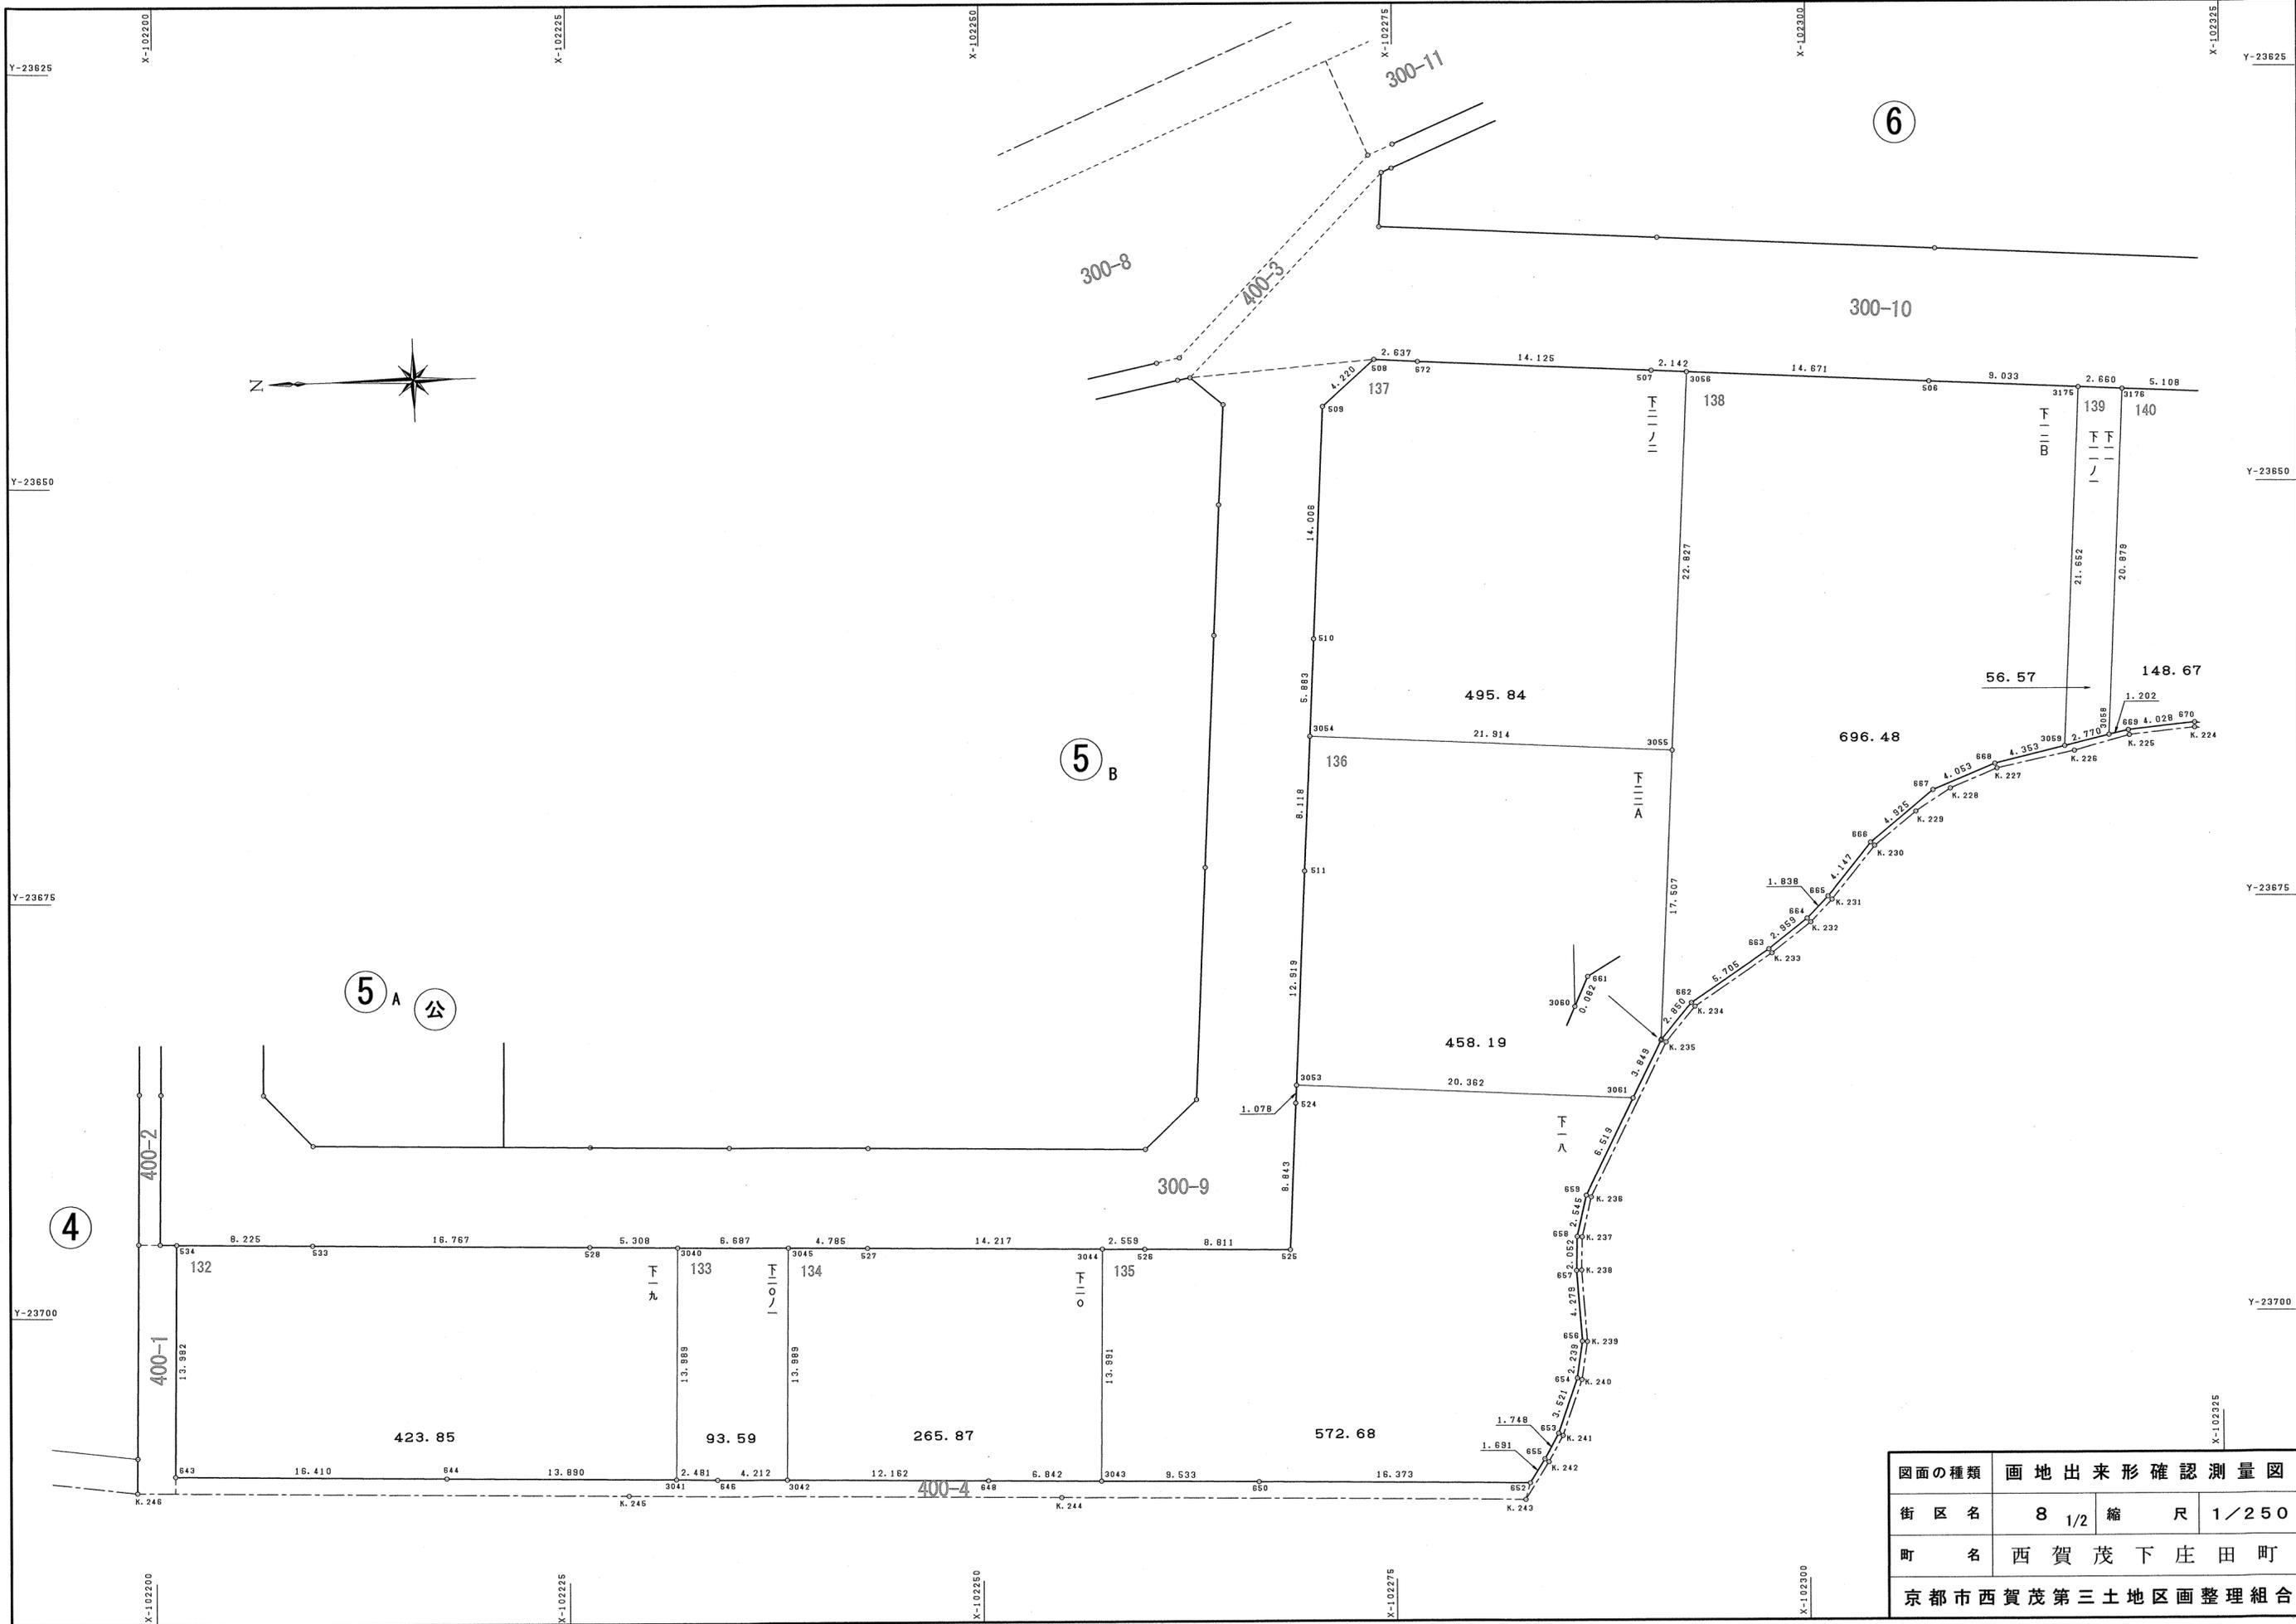

図面の種類	画地出来形確認測量図		
街区名	8 1/2	縮尺	1/250
町名	西賀茂下庄田町		
京都市西賀茂第三土地区画整理組合			

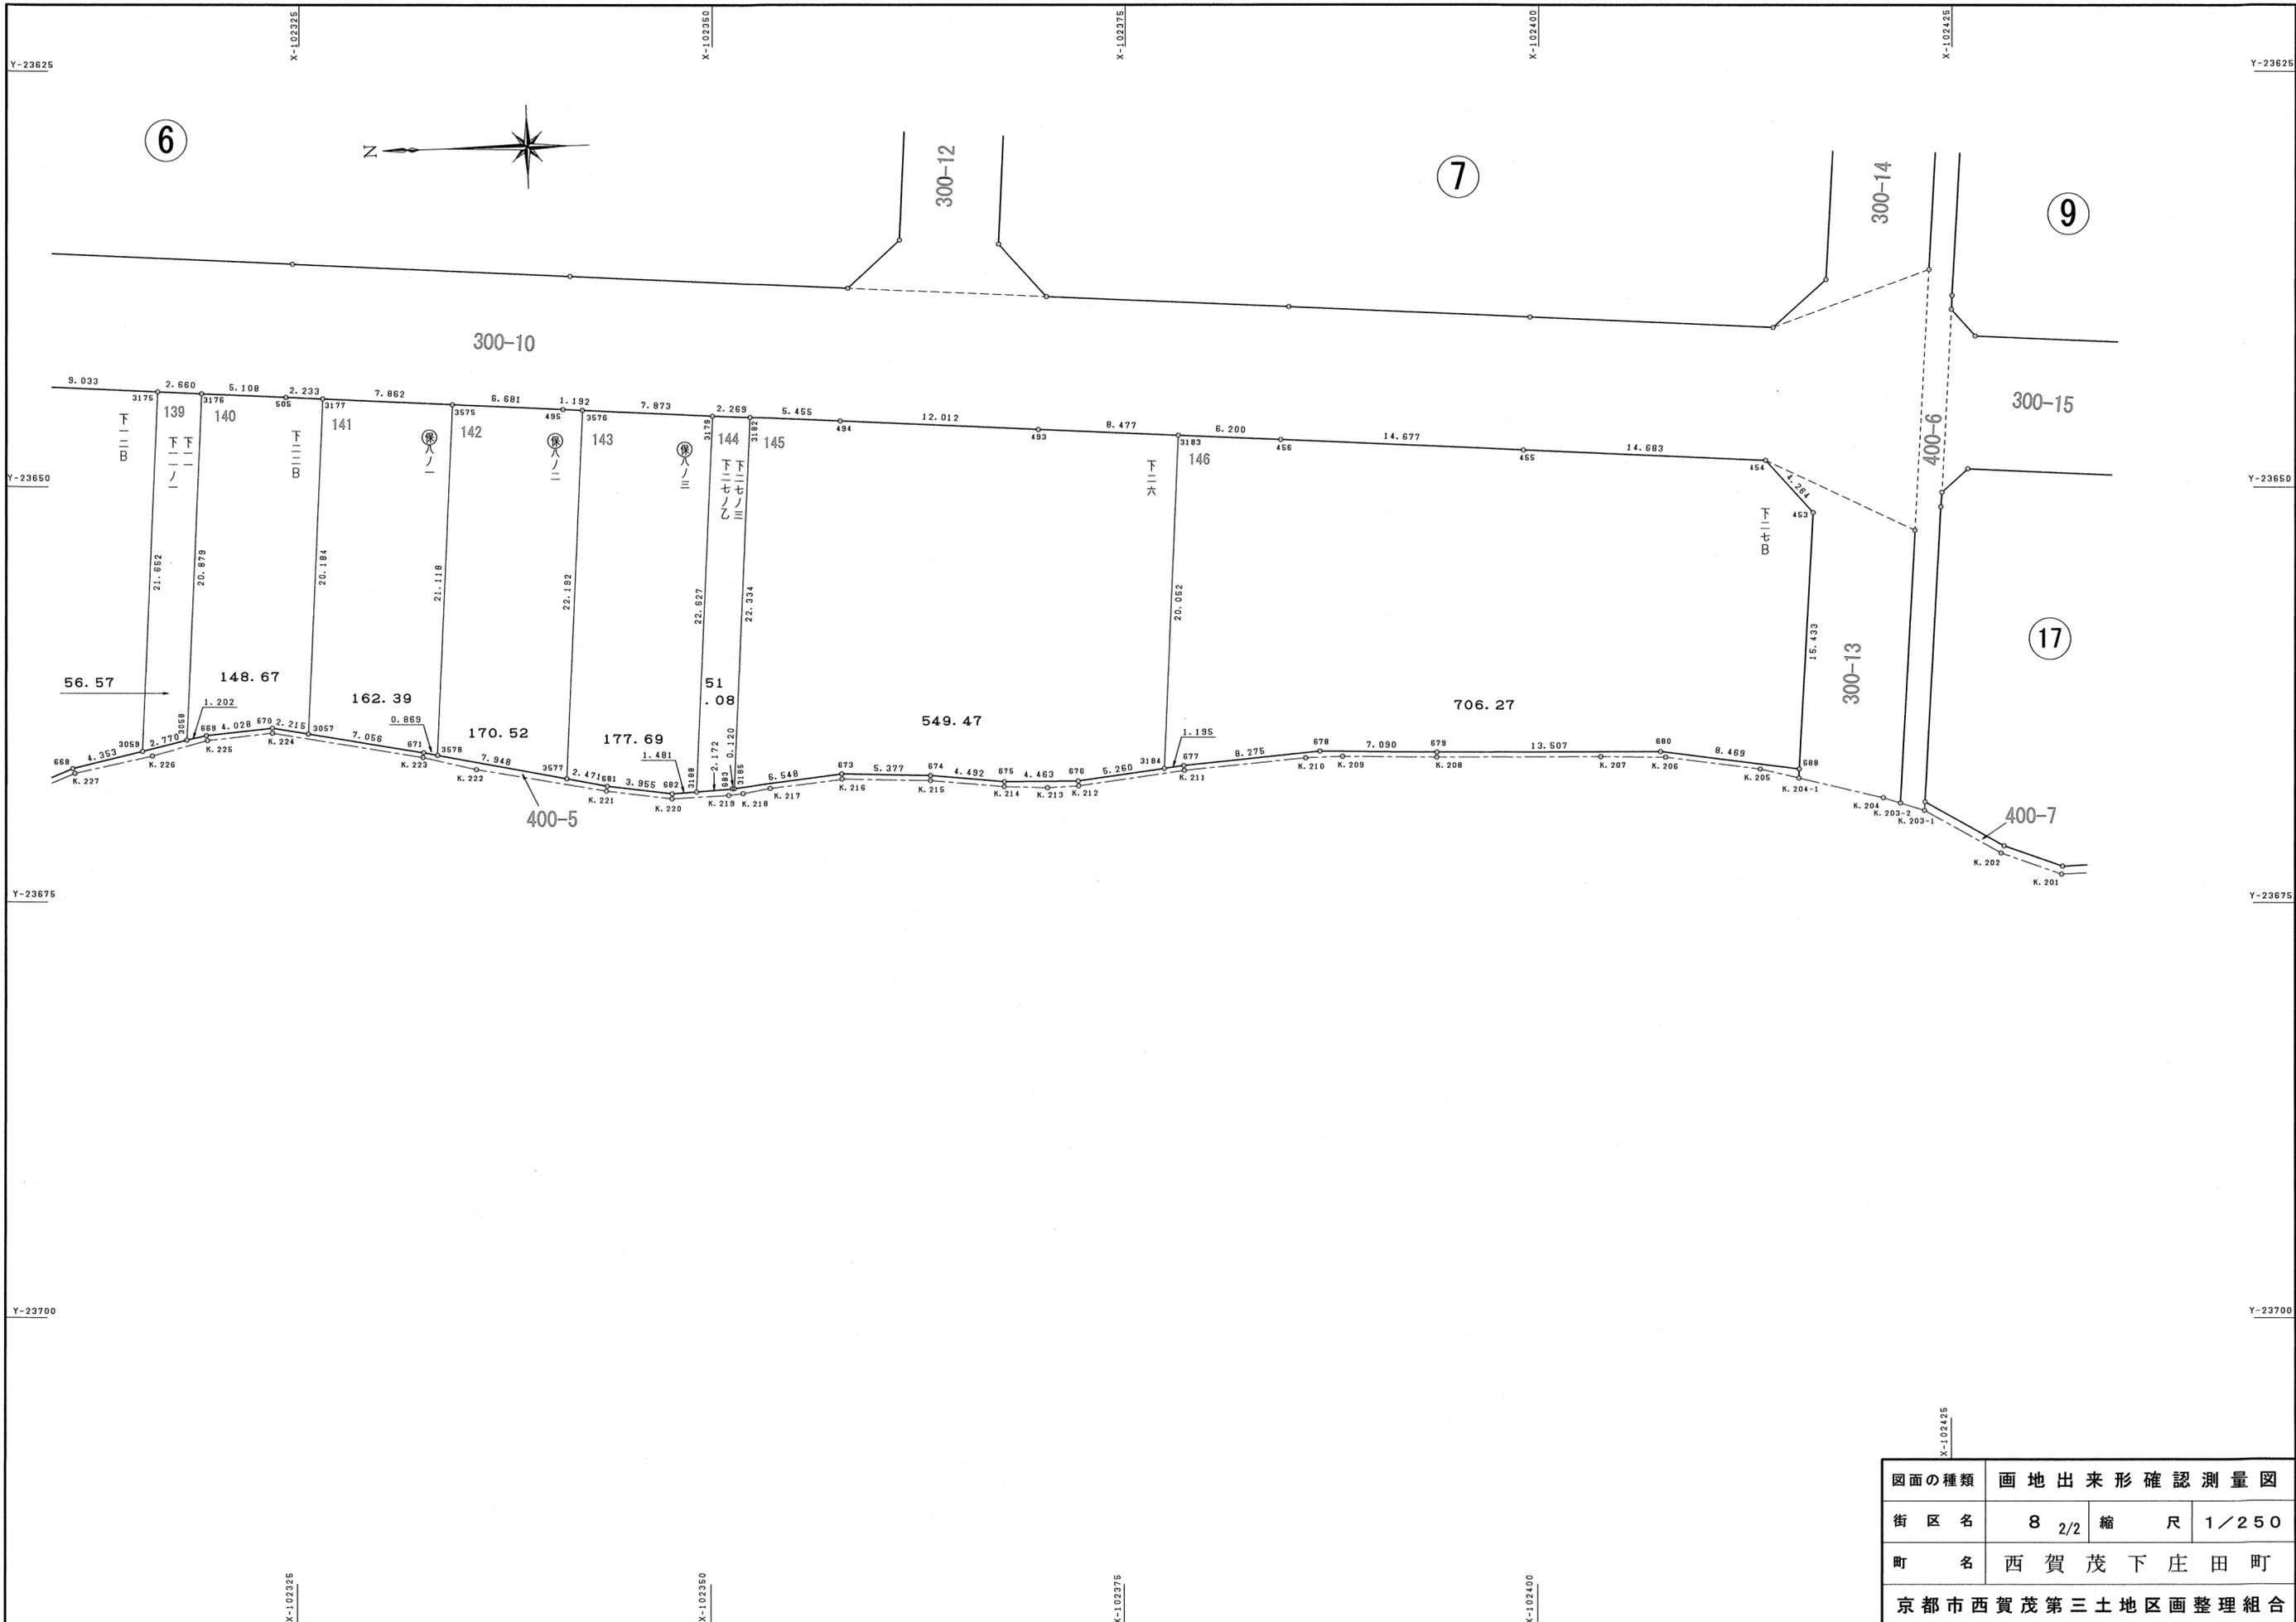

図面の種類	画地出来形確認測量図		
街区名	8	2/2	縮尺 1/250
町名	西賀茂下庄田町		
京都市西賀茂第三土地区画整理組合			

132

地番	下一九		
NO	X	Y	辺長
534	-102201.267	-23695.560	
643	-102201.147	-23709.542	13.982
644	-102217.557	-23709.679	16.410
3041	-102231.447	-23709.794	13.890
3040	-102231.567	-23695.805	13.989
528	-102226.259	-23695.761	5.308
533	-102209.492	-23695.623	16.767
534	-102201.267	-23695.560	8.225
面積	423.8540945		
地積	423.85 m ²		

133

地番	下二〇ノ一		
NO	X	Y	辺長
3040	-102231.567	-23695.805	
3041	-102231.447	-23709.794	13.990
646	-102233.928	-23709.814	2.481
3042	-102238.140	-23709.849	4.212
3045	-102238.254	-23695.860	13.989
3040	-102231.567	-23695.805	6.687
面積	93.5915475		
地積	93.59 m ²		

134

地番	下二〇		
NO	X	Y	辺長
3045	-102238.254	-23695.860	
3042	-102238.140	-23709.849	13.989
648	-102250.302	-23709.951	12.162
3043	-102257.144	-23710.008	6.842
3044	-102257.256	-23696.017	13.991
527	-102243.039	-23695.899	14.217
3045	-102238.254	-23695.860	4.785
面積	265.8772325		
地積	265.87 m ²		

135

地番	下一八		
NO	X	Y	辺長
3044	-102257.256	-23696.017	
3043	-102257.144	-23710.008	13.991
650	-102266.677	-23710.088	9.533
652	-102283.050	-23710.223	16.373
655	-102283.943	-23708.787	1.691
653	-102284.781	-23707.252	1.748
654	-102285.920	-23703.920	3.521
656	-102286.235	-23701.703	2.239
657	-102285.906	-23697.436	4.279
658	-102285.949	-23695.384	2.052
659	-102286.512	-23692.902	2.545
3061	-102289.375	-23687.045	6.519
3053	-102269.030	-23686.197	20.362
524	-102268.985	-23687.275	1.078
525	-102268.626	-23696.111	8.843
526	-102259.815	-23696.040	8.811
3044	-102257.256	-23696.017	2.559
面積	572.6831580		
地積	572.68 m ²		

136

地番	下二二A		
NO	X	Y	辺長
3054	-102269.918	-23665.178	
511	-102269.572	-23673.289	8.118
3053	-102269.030	-23686.197	12.919
3061	-102289.375	-23687.045	20.362
3060	-102291.066	-23683.587	3.849
3055	-102291.813	-23666.095	17.507
3054	-102269.918	-23665.178	21.914
面積	458.1931635		
地積	458.19 m ²		

137

地番	下二一ノ二		
NO	X	Y	辺長
508	-102273.885	-23642.472	
509	-102270.758	-23645.306	4.220
510	-102270.168	-23659.300	14.006
3054	-102269.918	-23665.178	5.883
3055	-102291.813	-23666.095	21.914
3056	-102292.773	-23643.288	22.827
507	-102290.632	-23643.197	2.142
672	-102276.519	-23642.607	14.125
508	-102273.885	-23642.472	2.637
面積	495.8484230		
地積	495.84 m ²		

138

地番	下一二B		
NO	X	Y	辺長
3056	-102292.773	-23643.288	
3055	-102291.813	-23666.095	22.827
3060	-102291.066	-23683.587	17.507
661	-102291.102	-23683.513	0.082
662	-102292.918	-23681.316	2.850
663	-102297.625	-23678.092	5.705
664	-102299.945	-23676.254	2.959
665	-102301.217	-23674.927	1.838
666	-102303.810	-23671.690	4.147
667	-102307.598	-23668.542	4.925
668	-102311.331	-23666.961	4.053
3059	-102315.558	-23665.921	4.353
3175	-102316.457	-23644.287	21.652
506	-102307.431	-23643.912	9.033
3056	-102292.773	-23643.288	14.671
面積	696.4800830		
地積	696.48 m ²		

139

地番	下一一, 下一一ノ一		
NO	X	Y	辺長
3175	-102316.457	-23644.287	
3059	-102315.558	-23665.921	21.652
3058	-102318.248	-23665.259	2.770
3176	-102319.115	-23644.398	20.879
3175	-102316.457	-23644.287	2.660
面積	56.5725485		
地積	56.57 m ²		

140

地番	下二二B		
NO	X	Y	辺長
3176	-102319.115	-23644.398	
3058	-102318.248	-23665.259	20.879
669	-102319.416	-23664.971	1.202
670	-102323.419	-23664.522	4.028
3057	-102325.607	-23664.871	2.215
3177	-102326.451	-23644.704	20.184
505	-102324.219	-23644.610	2.233
3176	-102319.115	-23644.398	5.108
面積	148.6720020		
地積	148.67 m ²		

141

地番	保八ノ一		
NO	X	Y	辺長
3177	-102326.451	-23644.704	
3057	-102325.607	-23664.871	20.184
671	-102332.575	-23665.982	7.056
3578	-102333.431	-23666.135	0.869
3575	-102334.307	-23645.035	21.118
3177	-102326.451	-23644.704	7.862
面積	162.3949460		
地積	162.39 m ²		

142

地番	保八ノ二		
NO	X	Y	辺長
3575	-102334.307	-23645.035	
3578	-102333.431	-23666.135	21.118
3577	-102341.255	-23667.539	7.948
3576	-102342.174	-23645.366	22.192
495	-102340.883	-23645.316	1.192
3575	-102334.307	-23645.035	6.681
面積	170.5273065		
地積	170.52 m ²		

143

地番	保八ノ三		
NO	X	Y	辺長
3576	-102342.174	-23645.366	
3577	-102341.255	-23667.539	22.192
681	-102343.688	-23667.975	2.471
682	-102347.618	-23668.427	3.955
3188	-102349.094	-23668.303	1.481
3179	-102350.041	-23645.695	22.627
3576	-102342.174	-23645.366	7.873
面積	177.6992130		
地積	177.69 m ²		

144

地番	下二七ノ乙, 下二七ノ三		
NO	X	Y	辺長
3188	-102349.094	-23668.303	
683	-102351.259	-23668.121	2.172
3185	-102351.378	-23668.105	0.120
3182	-102352.309	-23645.790	22.334
3179	-102350.041	-23645.695	2.269
3188	-102349.094	-23668.303	22.627
面積	51.0805065		
地積	51.08 m ²		

145

地番	下二六		
NO	X	Y	辺長
3182	-102352.309	-23645.790	
3185	-102351.378	-23668.105	22.334
673	-102357.870	-23667.249	6.548
674	-102363.247	-23667.338	5.377
675	-102367.724	-23667.712	4.492
676	-102372.187	-23667.667	4.463
3184	-102377.394	-23666.916	5.260
3183	-102378.232	-23646.881	20.052
493	-102369.762	-23646.528	8.477
494	-102357.760	-23646.018	12.012
3182	-102352.309	-23645.790	5.455
面積	549.4751930		
地積	549.47 m ²		

146

地番	下二七B		
NO	X	Y	辺長
3183	-102378.232	-23646.881	
3184	-102377.394	-23666.916	20.052
677	-102378.577	-23666.745	1.195
678	-102386.808	-23665.885	8.275
679	-102393.898	-23665.935	7.090
680	-102407.405	-23665.889	13.507
688	-102415.810	-23666.929	8.469
453	-102416.641	-23651.518	15.433
454	-102413.762	-23648.372	4.264
455	-102399.092	-23647.753	14.683
456	-102384.427	-23647.140	14.677
3183	-102378.232	-23646.881	6.200
面積	706.2744610		
地積	706.27 m ²		

図面の種類	画地出来形確認測量図	
街区名	8	求積表
町名	西賀茂下庄田町	
京都市西賀茂第三土地区画整理組合		

179

地番	下三二ノ一		
NO	X	Y	辺長
465	-102425.032	-23638.456	
466	-102424.996	-23639.290	0.834
467	-102426.427	-23640.890	2.146
430	-102444.366	-23641.642	17.954
3194	-102454.339	-23642.066	9.982
3163	-102455.048	-23625.069	17.011
3193	-102425.821	-23623.516	29.268
465	-102425.032	-23638.456	14.960
面積	503.0045840		
地積	503.00 m ²		

180

地番	下七ノ三		
NO	X	Y	辺長
3193	-102425.821	-23623.516	
3163	-102455.048	-23625.069	29.268
3164	-102455.146	-23622.862	2.209
3165	-102455.227	-23620.719	2.144
3192	-102426.054	-23619.158	29.214
464	-102425.960	-23620.922	1.766
3193	-102425.821	-23623.516	2.597
面積	127.4724855		
地積	127.47 m ²		

181

地番	下三三ノ一		
NO	X	Y	辺長
3192	-102426.054	-23619.158	
3165	-102455.227	-23620.719	29.214
3166	-102455.393	-23616.804	3.918
3191	-102426.263	-23615.244	29.171
3192	-102426.054	-23619.158	3.918
面積	114.4061405		
地積	114.40 m ²		

182

地番	下三三ノ二, 下三三ノ三		
NO	X	Y	辺長
3191	-102426.263	-23615.244	
3166	-102455.393	-23616.804	29.171
3167	-102455.404	-23616.596	0.208
1851	-102447.707	-23616.180	7.708
1850	-102439.090	-23615.723	8.629
3190	-102426.275	-23615.036	12.833
3191	-102426.263	-23615.244	0.208
面積	6.1003360		
地積	6.10 m ²		

183

地番	保九ノ一		
NO	X	Y	辺長
3190	-102426.275	-23615.036	
1850	-102439.090	-23615.723	12.833
1852	-102439.598	-23603.862	11.871
1846	-102426.908	-23603.188	12.707
3190	-102426.275	-23615.036	11.864
面積	151.5627365		
地積	151.56 m ²		

184

地番	保九ノ五		
NO	X	Y	辺長
1846	-102426.908	-23603.188	
1852	-102439.598	-23603.862	12.707
1850	-102439.090	-23615.723	11.871
1851	-102447.707	-23616.180	8.629
1848	-102448.290	-23602.274	13.918
1847	-102427.018	-23601.139	21.302
463	-102426.942	-23602.548	1.411
1846	-102426.908	-23603.188	0.640
面積	146.0527905		
地積	146.05 m ²		

185

地番	保九ノ六		
NO	X	Y	辺長
1847	-102427.018	-23601.139	
1848	-102448.290	-23602.274	21.302
1851	-102447.707	-23616.180	13.918
3167	-102455.404	-23616.596	7.708
3168	-102456.123	-23599.634	16.977
3203	-102427.182	-23598.088	28.982
1847	-102427.018	-23601.139	3.055
面積	195.9216330		
地積	195.92 m ²		

186

地番	下三五		
NO	X	Y	辺長
3203	-102427.182	-23598.088	
3168	-102456.123	-23599.634	28.982
3125	-102456.720	-23585.377	14.269
3124	-102456.991	-23578.883	6.499
3115	-102428.279	-23577.353	28.752
478	-102427.931	-23584.165	6.820
3203	-102427.182	-23598.088	13.943
面積	599.3373180		
地積	599.33 m ²		

187

地番	下三四		
NO	X	Y	辺長
3115	-102428.279	-23577.353	
3124	-102456.991	-23578.883	28.752
3123	-102457.264	-23572.469	6.419
3122	-102457.523	-23566.319	6.155
473	-102456.356	-23566.236	1.169
474	-102443.436	-23565.317	12.952
475	-102430.500	-23564.396	12.968
476	-102428.882	-23565.819	2.154
477	-102428.826	-23566.650	0.832
3115	-102428.279	-23577.353	10.716
面積	366.9568160		
地積	366.95 m ²		

188

地番	上三九		
NO	X	Y	辺長
3123	-102457.264	-23572.469	
3131	-102479.239	-23573.363	21.993
449	-102469.281	-23567.151	11.736
3122	-102457.523	-23566.319	11.787
3123	-102457.264	-23572.469	6.155
面積	100.0667180		
地積	100.06 m ²		

189

地番	下三七, 下三八ノ二		
NO	X	Y	辺長
3125	-102456.720	-23585.377	
3126	-102485.701	-23586.584	29.006
447	-102485.958	-23580.610	5.979
448	-102483.505	-23576.024	5.200
3131	-102479.239	-23573.363	5.027
3123	-102457.264	-23572.469	21.993
3124	-102456.991	-23578.883	6.419
3125	-102456.720	-23585.377	6.499
面積	357.2853495		
地積	357.28 m ²		

190

地番	下三六		
NO	X	Y	辺長
3164	-102455.146	-23622.862	
3582	-102464.639	-23623.253	9.501
3581	-102474.136	-23623.645	9.505
3162	-102484.106	-23624.065	9.978
434	-102484.259	-23620.389	3.679
435	-102485.103	-23600.502	19.904
3126	-102485.701	-23586.584	13.930
3125	-102456.720	-23585.377	29.006
3168	-102456.123	-23599.634	14.269
3167	-102455.404	-23616.596	16.977
3166	-102455.393	-23616.804	0.208
3165	-102455.227	-23620.719	3.918
3164	-102455.146	-23622.862	2.144
面積	1087.6453190		
地積	1087.64 m ²		

191

地番	保九ノ四		
NO	X	Y	辺長
3580	-102473.311	-23642.872	
432	-102480.289	-23643.169	6.984
433	-102483.430	-23640.290	4.260
3162	-102484.106	-23624.065	16.239
3581	-102474.136	-23623.645	9.978
3580	-102473.311	-23642.872	19.244
面積	187.7487860		
地積	187.74 m ²		



192

地番	保九ノ三		
NO	X	Y	辺長
3579	-102463.823	-23642.468	
3580	-102473.311	-23642.872	9.496
3581	-102474.136	-23623.645	19.244
3582	-102464.639	-23623.253	9.505
3579	-102463.823	-23642.468	19.232
面積	182.7819015		
地積	182.78 m ²		

193

地番	保九ノ二		
NO	X	Y	辺長
3194	-102454.339	-23642.066	
431	-102462.333	-23642.405	8.001
3579	-102463.823	-23642.468	1.491
3582	-102464.639	-23623.253	19.232
3164	-102455.146	-23622.862	9.501
3163	-102455.048	-23625.069	2.209
3194	-102454.339	-23642.066	17.011
面積	182.6423160		
地積	182.64 m ²		

図面の種類	画地出来形確認測量図	
街区名	9	求積表
町名	西賀茂下庄田町	
京都市西賀茂第三土地区画整理組合		

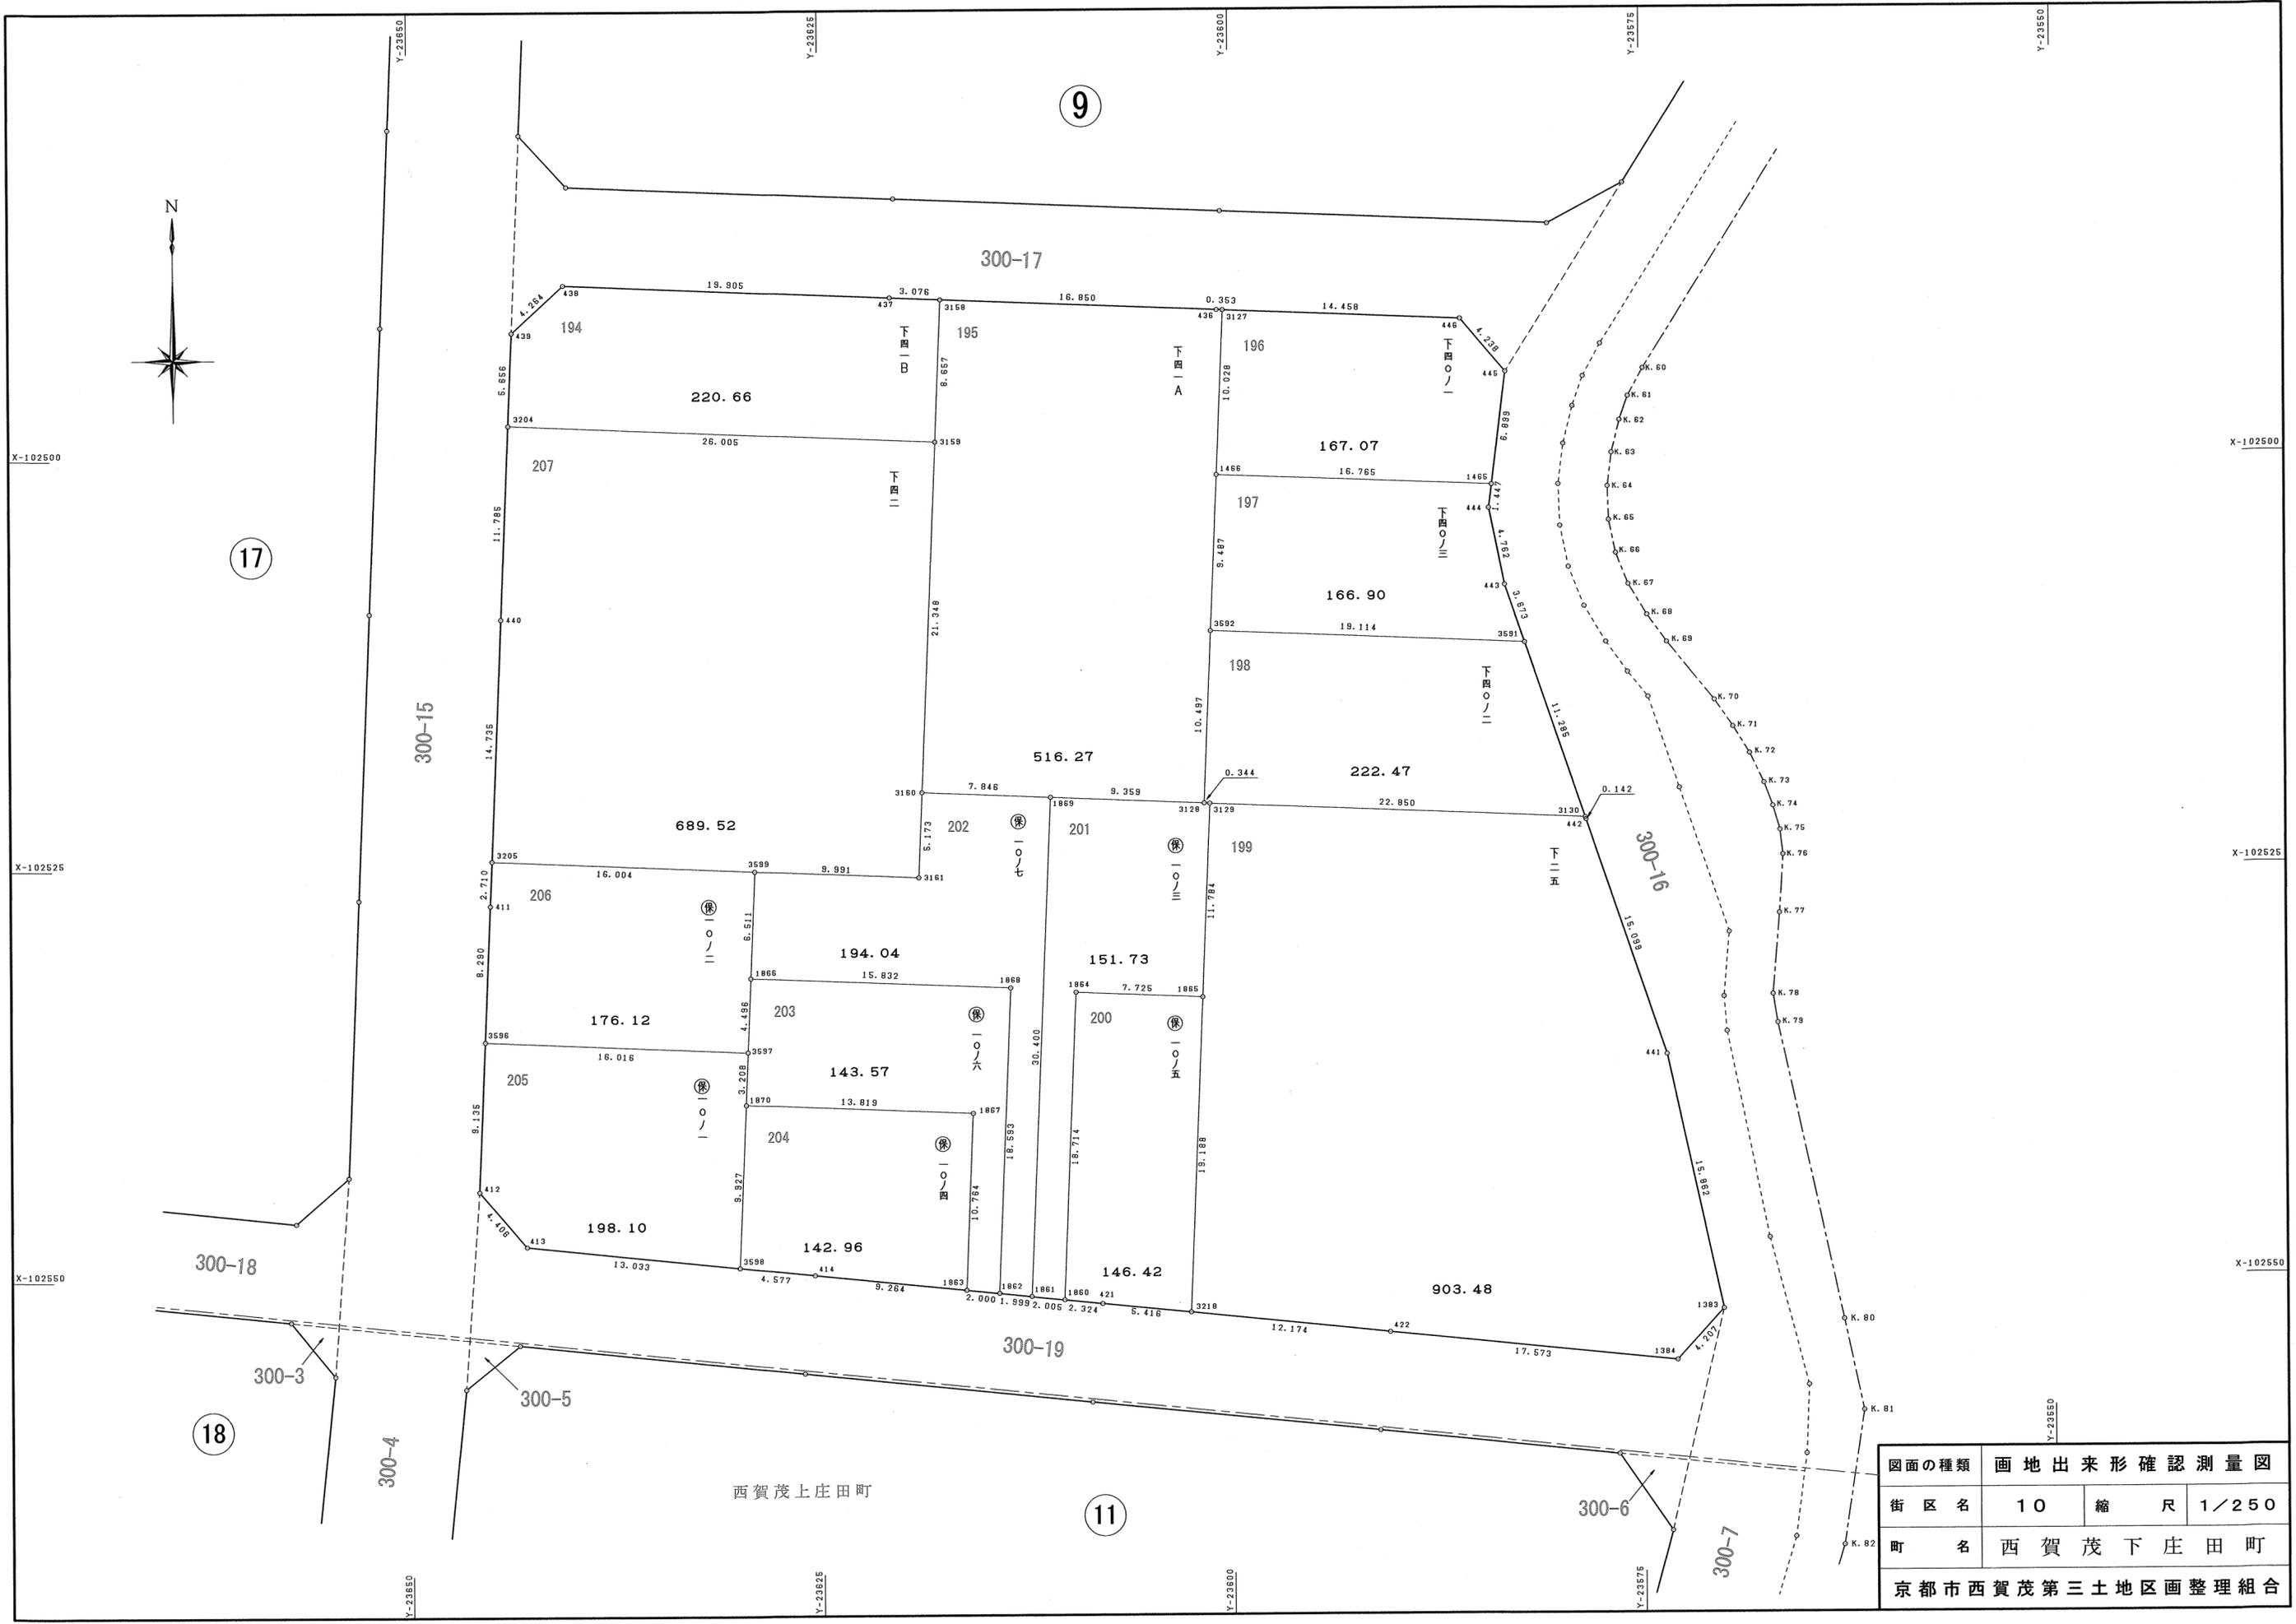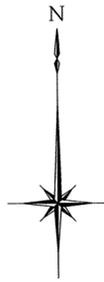

図面の種類	画地出来形確認測量図		
街区名	10	縮尺	1/250
町名	西賀茂下庄田町		
京都市西賀茂第三土地区画整理組合			

194

地番 下四一B			
NO	X	Y	辺長
438	-102489.426	-23640.523	
439	-102492.301	-23643.673	4.264
3204	-102497.953	-23643.910	5.656
3159	-102499.054	-23617.928	26.005
3158	-102490.404	-23617.562	8.657
437	-102490.275	-23620.636	3.076
438	-102489.426	-23640.523	19.905
面積	220.6631105		
地積	220.66 m ²		

195

地番 下四一A			
NO	X	Y	辺長
3158	-102490.404	-23617.562	
3159	-102499.054	-23617.928	8.657
3160	-102520.383	-23618.829	21.348
1869	-102520.707	-23610.989	7.846
3128	-102521.113	-23601.638	9.359
3592	-102510.625	-23601.195	10.497
1466	-102501.146	-23600.795	9.487
3127	-102491.126	-23600.373	10.028
436	-102491.111	-23600.726	0.353
3158	-102490.404	-23617.562	16.850
面積	516.2704860		
地積	516.27 m ²		

196

地番 下四〇ノ一			
NO	X	Y	辺長
3127	-102491.126	-23600.373	
1466	-102501.146	-23600.795	10.028
1465	-102501.817	-23584.043	16.765
445	-102494.970	-23583.191	6.899
446	-102491.733	-23585.927	4.238
3127	-102491.126	-23600.373	14.458
面積	167.0786970		
地積	167.07 m ²		

197

地番 下四〇ノ三			
NO	X	Y	辺長
1466	-102501.146	-23600.795	
3592	-102510.625	-23601.195	9.487
3591	-102511.399	-23582.096	19.114
443	-102507.921	-23583.279	3.673
444	-102503.253	-23584.222	4.762
1465	-102501.817	-23584.043	1.447
1466	-102501.146	-23600.795	16.765
面積	166.9033440		
地積	166.90 m ²		

198

地番 下四〇ノ二			
NO	X	Y	辺長
3592	-102510.625	-23601.195	
3128	-102521.113	-23601.638	10.497
3129	-102521.136	-23601.294	0.344
3130	-102522.084	-23578.463	22.850
3591	-102511.399	-23582.096	11.285
3592	-102510.625	-23601.195	19.114
面積	222.4747135		
地積	222.47 m ²		

199

地番 下二五			
NO	X	Y	辺長
3129	-102521.136	-23601.294	
1865	-102532.910	-23601.793	11.784
3218	-102552.082	-23602.599	19.188
422	-102553.338	-23590.489	12.174
1384	-102555.134	-23573.008	17.573
1383	-102552.015	-23570.184	4.207
441	-102536.516	-23573.561	15.862
442	-102522.219	-23578.417	15.099
3130	-102522.084	-23578.463	0.142
3129	-102521.136	-23601.294	22.850
面積	903.4856985		
地積	903.48 m ²		

200

地番 保一〇ノ五			
NO	X	Y	辺長
1864	-102532.586	-23609.512	
1860	-102551.284	-23610.299	18.714
421	-102551.523	-23607.987	2.324
3218	-102552.082	-23602.599	5.416
1865	-102532.910	-23601.793	19.188
1864	-102532.586	-23609.512	7.725
面積	146.4238810		
地積	146.42 m ²		

201

地番 保一〇ノ三			
NO	X	Y	辺長
1869	-102520.707	-23610.989	
1861	-102551.079	-23612.294	30.400
1860	-102551.284	-23610.299	2.005
1864	-102532.586	-23609.512	18.714
1865	-102532.910	-23601.793	7.725
3129	-102521.136	-23601.294	11.784
3128	-102521.113	-23601.638	0.344
1869	-102520.707	-23610.989	9.359
面積	151.7396235		
地積	151.73 m ²		

202

地番 保一〇ノ七			
NO	X	Y	辺長
3160	-102520.383	-23618.829	
3161	-102525.552	-23619.053	5.173
3599	-102525.124	-23629.035	9.991
1866	-102531.629	-23629.315	6.511
1868	-102532.296	-23613.497	15.832
1862	-102550.873	-23614.283	18.593
1861	-102551.079	-23612.294	1.999
1869	-102520.707	-23610.989	30.400
3160	-102520.383	-23618.829	7.846
面積	194.0421810		
地積	194.04 m ²		

203

地番 保一〇ノ六			
NO	X	Y	辺長
1866	-102531.629	-23629.315	
3597	-102536.122	-23629.491	4.496
1870	-102539.328	-23629.628	3.208
1867	-102539.913	-23615.821	13.819
1863	-102550.668	-23616.273	10.764
1862	-102550.873	-23614.283	2.000
1868	-102532.296	-23613.497	18.593
1866	-102531.629	-23629.315	15.832
面積	143.5744115		
地積	143.57 m ²		

204

地番 保一〇ノ四			
NO	X	Y	辺長
1870	-102539.328	-23629.628	
3598	-102549.247	-23630.042	9.927
414	-102549.717	-23625.489	4.577
1863	-102550.668	-23616.273	9.264
1867	-102539.913	-23615.821	10.764
1870	-102539.328	-23629.628	13.819
面積	142.9616635		
地積	142.96 m ²		

205

地番 保一〇ノ一			
NO	X	Y	辺長
3596	-102535.441	-23645.493	
412	-102544.568	-23645.881	9.135
413	-102547.908	-23643.007	4.406
3598	-102549.247	-23630.042	13.033
1870	-102539.328	-23629.628	9.927
3597	-102536.122	-23629.491	3.208
3596	-102535.441	-23645.493	16.016
面積	198.1013405		
地積	198.10 m ²		

206

地番 保一〇ノ二			
NO	X	Y	辺長
3205	-102524.450	-23645.025	
411	-102527.158	-23645.140	2.710
3596	-102535.441	-23645.493	8.290
3597	-102536.122	-23629.491	16.016
1866	-102531.629	-23629.315	4.496
3599	-102525.124	-23629.035	6.511
3205	-102524.450	-23645.025	16.004
面積	176.1227575		
地積	176.12 m ²		

207

地番 下四二			
NO	X	Y	辺長
3204	-102497.953	-23643.910	
440	-102509.728	-23644.403	11.785
3205	-102524.450	-23645.025	14.735
3599	-102525.124	-23629.035	16.004
3161	-102525.552	-23619.053	9.991
3160	-102520.383	-23618.829	5.173
3159	-102499.054	-23617.928	21.348
3204	-102497.953	-23643.910	26.005
面積	689.5284730		
地積	689.52 m ²		

図面の種類	画地出来形確認測量図	
街区名	10	求積表
町名	西賀茂下庄田町	
京都市西賀茂第三土地区画整理組合		



図面の種類	画地出来形確認測量図		
街区名	11	縮尺	1/250
町名	西賀茂上庄田町		
京都市西賀茂第三土地区画整理組合			

132

地番	上一六ノ二 上一六ノ三〇	上一六ノ二五 上一六ノ三三	上一六ノ二七	辺長
N O	X	Y		
416	-102553.900	-23643.458		
417	-102556.565	-23646.748		4.233
282	-102571.331	-23648.278		14.845
1390	-102579.455	-23649.117		8.167
4015	-102580.412	-23639.854		9.312
4014	-102554.550	-23637.175		26.000
416	-102553.900	-23643.458		6.316
面積				237.6998425
地積				237.69 m ²

133

地番	上一六ノ九	上一六ノ一四	上一六ノ一八	辺長
N O	X	Y		
4014	-102554.550	-23637.175		
4015	-102580.412	-23639.854		26.000
1405	-102580.436	-23639.638		0.217
1391	-102581.509	-23629.268		10.425
1389	-102555.646	-23626.589		26.001
4014	-102554.550	-23637.175		10.642
面積				276.7265045
地積				276.72 m ²

134

地番	上一六ノ一一	上一六ノ一六	辺長
N O	X	Y	
1389	-102555.646	-23626.589	
1391	-102581.509	-23629.268	26.001
1392	-102582.703	-23617.831	11.499
1403	-102583.638	-23608.733	9.145
1399	-102583.908	-23606.113	2.633
1400	-102558.045	-23603.435	26.001
424	-102557.510	-23608.627	5.219
415	-102555.693	-23626.133	17.600
1389	-102555.646	-23626.589	0.458
面積			605.3408045
地積			605.34 m ²

135

地番	上一六	辺長	
N O	X	Y	
1400	-102558.045	-23603.435	
1399	-102583.908	-23606.113	26.001
1396	-102584.761	-23597.826	8.330
1402	-102585.087	-23594.678	3.164
1395	-102586.931	-23576.840	17.933
4223	-102576.299	-23576.289	10.646
4224	-102565.507	-23573.366	11.180
4231	-102560.825	-23576.578	5.677
423	-102559.315	-23591.121	14.621
1400	-102558.045	-23603.435	12.379
面積			763.5208405
地積			763.52 m ²

136

地番	上一六ノ一 上一六ノ四	上一六ノ二 上一六ノ五	上一六ノ三	辺長
N O	X	Y		
1402	-102585.087	-23594.678		
1401	-102610.945	-23597.348		25.995
269	-102611.031	-23596.514		0.838
270	-102612.506	-23582.259		14.331
4226	-102608.852	-23577.959		5.642
4227	-102596.722	-23577.347		12.145
1395	-102586.931	-23576.840		9.804
1402	-102585.087	-23594.678		17.933
面積				475.2740770
地積				475.27 m ²

137

地番	上一六ノ一二	辺長	
N O	X	Y	
1396	-102584.761	-23597.826	
1394	-102610.618	-23600.496	25.994
1401	-102610.945	-23597.348	3.164
1402	-102585.087	-23594.678	25.995
1396	-102584.761	-23597.826	3.164
面積			82.2711650
地積			82.27 m ²

138

地番	上一六ノ七	上一六ノ一三	上一六ノ一七	辺長
N O	X	Y		
1403	-102583.638	-23608.733		
1404	-102609.488	-23611.402		25.987
1394	-102610.618	-23600.496		10.964
1396	-102584.761	-23597.826		25.994
1399	-102583.908	-23606.113		8.330
1403	-102583.638	-23608.733		2.633
面積				284.9770745
地積				284.97 m ²

139

地番	上一六ノ二二 上一六ノ三一	上一六ノ二三 上一六ノ三二	上一六ノ二八	辺長
N O	X	Y		
1392	-102582.703	-23617.831		
1393	-102608.548	-23620.506		25.983
354	-102609.224	-23613.946		6.594
1404	-102609.488	-23611.402		2.557
1403	-102583.638	-23608.733		25.987
1392	-102582.703	-23617.831		9.145
面積				237.7370495
地積				237.73 m ²

140

地番	上一六ノ一〇	上一六ノ一五	上一六ノ一九	辺長
N O	X	Y		
1405	-102580.436	-23639.638		
1406	-102606.294	-23642.314		25.996
286	-102607.427	-23631.372		11.000
1393	-102608.548	-23620.506		10.923
1392	-102582.703	-23617.831		25.983
1391	-102581.509	-23629.268		11.499
1405	-102580.436	-23639.638		10.425
面積				569.8820915
地積				569.88 m ²

141

地番	上一六ノ二〇 上一六ノ二九	上一六ノ二四 上一六ノ三四	上一六ノ二六	辺長
N O	X	Y		
1390	-102579.455	-23649.117		
283	-102586.092	-23649.803		6.672
284	-102600.839	-23651.335		14.826
285	-102605.776	-23647.312		6.368
1406	-102606.294	-23642.314		5.024
1405	-102580.436	-23639.638		25.996
4015	-102580.412	-23639.854		0.217
1390	-102579.455	-23649.117		9.312
面積				237.6463810
地積				237.64 m ²

図面の種類	画地出来形確認測量図	
街区名	11	求積表
町名	西賀茂上庄田町	
京都市西賀茂第三土地区画整理組合		



西賀茂樋ノ口町

図面の種類	画地出来形確認測量図		
街区名	12	縮尺	1/250
町名	西賀茂上庄田町		
京都市西賀茂第三土地区画整理組合			

142

地番 上一九A			
NO	X	Y	辺長
272	-102611.589	-23649.442	
273	-102614.266	-23652.726	4.236
274	-102628.852	-23654.238	14.664
3220	-102636.150	-23654.995	7.337
3226	-102639.369	-23623.961	31.200
3223	-102614.495	-23621.397	25.005
271	-102613.397	-23632.034	10.693
272	-102611.589	-23649.442	17.501
面積	775.4058500		
地積	775.40 m2		

143

地番 上一八			
NO	X	Y	辺長
3223	-102614.495	-23621.397	
3226	-102639.369	-23623.961	25.005
3227	-102639.719	-23620.543	3.435
3225	-102640.147	-23616.436	4.129
3221	-102615.273	-23613.867	25.006
353	-102615.198	-23614.590	0.726
3223	-102614.495	-23621.397	6.843
面積	189.2241730		
地積	189.22 m2		

144

地番 上一六ノ八			
NO	X	Y	辺長
3221	-102615.273	-23613.867	
3225	-102640.147	-23616.436	25.006
3224	-102640.392	-23614.100	2.348
3322	-102641.363	-23604.780	9.370
3222	-102616.486	-23602.190	25.011
3221	-102615.273	-23613.867	11.739
面積	293.3503955		
地積	293.35 m2		

145

地番 樋一ノB			
NO	X	Y	辺長
3222	-102616.486	-23602.190	
3322	-102641.363	-23604.780	25.011
3321	-102641.830	-23600.269	4.535
3320	-102642.503	-23593.806	6.497
3319	-102644.167	-23577.716	16.175
261	-102636.116	-23577.596	8.051
262	-102635.069	-23576.577	1.461
263	-102634.454	-23575.963	0.869
264	-102623.238	-23575.778	11.217
352	-102618.818	-23579.702	5.910
266	-102617.010	-23597.144	17.535
3222	-102616.486	-23602.190	5.073
面積	670.7951365		
地積	670.79 m2		

146

地番 樋一ノA			
NO	X	Y	辺長
3320	-102642.503	-23593.806	
3306	-102665.554	-23596.209	23.175
258	-102666.816	-23584.064	12.210
259	-102664.045	-23580.283	4.687
260	-102651.816	-23577.830	12.472
3319	-102644.167	-23577.716	7.649
3320	-102642.503	-23593.806	16.175
面積	371.6934575		
地積	371.69 m2		

147

地番 樋九ノ五			
NO	X	Y	辺長
3321	-102641.830	-23600.269	
3323	-102664.883	-23602.662	23.176
312	-102665.405	-23597.639	5.050
3306	-102665.554	-23596.209	1.437
3320	-102642.503	-23593.806	23.175
3321	-102641.830	-23600.269	6.497
面積	150.4802885		
地積	150.48 m2		

148

地番 樋四			
NO	X	Y	辺長
3224	-102640.392	-23614.100	
3238	-102665.248	-23616.693	24.990
309	-102665.498	-23614.267	2.438
310	-102664.973	-23613.617	0.835
311	-102663.884	-23612.286	1.719
3323	-102664.883	-23602.662	9.675
3321	-102641.830	-23600.269	23.176
3322	-102641.363	-23604.780	4.535
3224	-102640.392	-23614.100	9.370
面積	328.4788435		
地積	328.47 m2		


149

地番 上二一A			
NO	X	Y	辺長
3227	-102639.719	-23620.543	
3237	-102664.585	-23623.136	25.000
3238	-102665.248	-23616.693	6.477
3224	-102640.392	-23614.100	24.990
3225	-102640.147	-23616.436	2.348
3227	-102639.719	-23620.543	4.129
面積	161.9147505		
地積	161.91 m2		

150

地番 上一九B			
NO	X	Y	辺長
3220	-102636.150	-23654.995	
275	-102643.431	-23655.750	7.320
3234	-102658.021	-23657.255	14.667
288	-102661.317	-23654.583	4.243
289	-102662.903	-23639.262	15.402
308	-102664.498	-23623.976	15.368
3237	-102664.585	-23623.136	0.844
3227	-102639.719	-23620.543	25.000
3226	-102639.369	-23623.961	3.435
3220	-102636.150	-23654.995	31.200
面積	860.8195445		
地積	860.81 m2		

図面の種類	画地出来形確認測量図	
街区名	12	求積表
町名	西賀茂上庄田町	
京都市西賀茂第三土地区画整理組合		

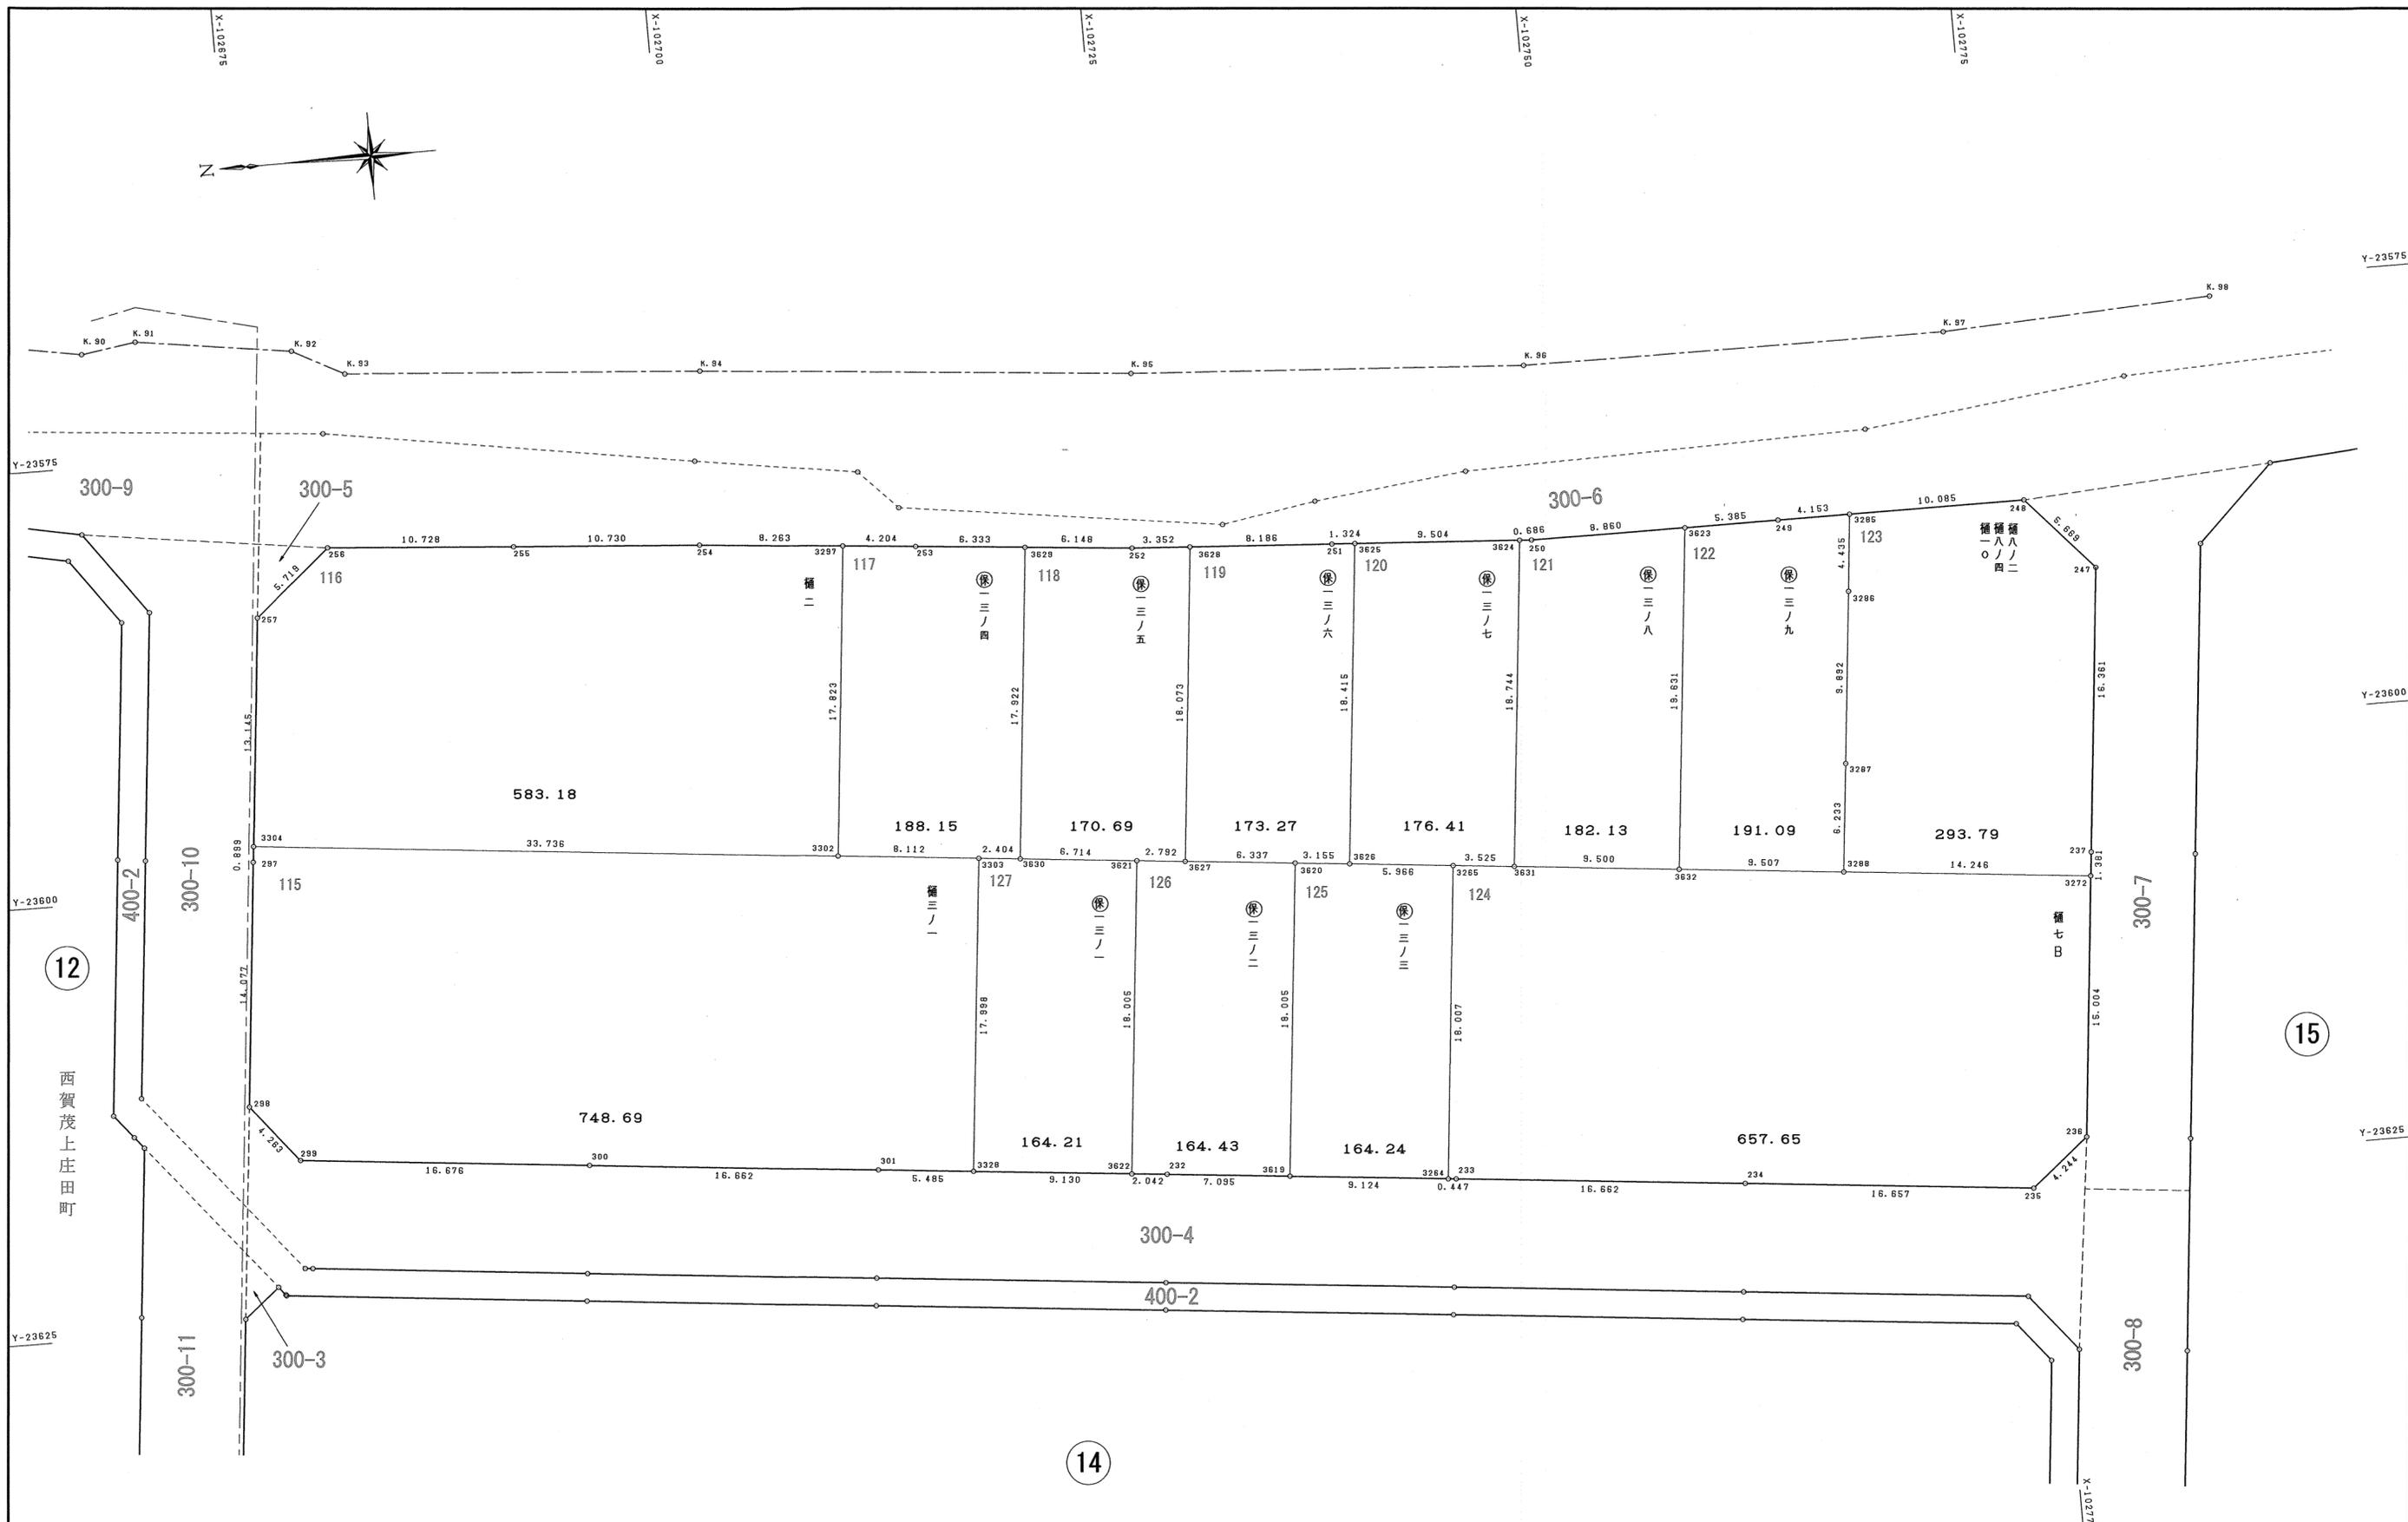

12

15

14

西賀茂上庄田町

図面の種類	画地出来形確認測量図		
街区名	13	縮尺	1/250
町名	西賀茂樋ノ口町		
京都市西賀茂第三土地区画整理組合			

115

地番 樋三ノ一			
NO	X	Y	辺長
3304	-102673.268	-23597.539	
297	-102673.175	-23598.434	0.899
298	-102671.732	-23612.437	14.077
299	-102674.414	-23615.751	4.263
300	-102691.002	-23617.462	16.676
301	-102707.576	-23619.175	16.662
3328	-102713.033	-23619.738	5.485
3303	-102714.896	-23601.836	17.998
3302	-102706.827	-23600.994	8.112
3304	-102673.268	-23597.539	33.736
面積	748.6915710		
地積	748.69 m ²		

116

地番 樋二			
NO	X	Y	辺長
256	-102679.019	-23580.795	
257	-102674.632	-23584.464	5.719
3304	-102673.268	-23597.539	13.145
3302	-102706.827	-23600.994	33.736
3297	-102708.639	-23583.263	17.823
254	-102700.412	-23582.485	8.263
255	-102689.714	-23581.648	10.730
256	-102679.019	-23580.795	10.728
面積	583.1838955		
地積	583.18 m ²		

117

地番 保一三ノ四			
NO	X	Y	辺長
3297	-102708.639	-23583.263	
3302	-102706.827	-23600.994	17.823
3303	-102714.896	-23601.836	8.112
3630	-102717.287	-23602.091	2.404
3628	-102719.130	-23584.264	17.922
253	-102712.825	-23583.659	6.333
3297	-102708.639	-23583.263	4.204
面積	188.1566505		
地積	188.15 m ²		

118

地番 保一三ノ五			
NO	X	Y	辺長
3629	-102719.130	-23584.264	
3630	-102717.287	-23602.091	17.922
3621	-102723.968	-23602.764	6.714
3627	-102726.745	-23603.057	2.792
3628	-102728.595	-23585.078	18.073
252	-102725.250	-23584.852	3.352
3629	-102719.130	-23584.264	6.148
面積	170.6964435		
地積	170.69 m ²		

119

地番 保一三ノ六			
NO	X	Y	辺長
3628	-102728.595	-23585.078	
3627	-102726.745	-23603.057	18.073
3620	-102733.049	-23603.705	6.337
3626	-102736.187	-23604.036	3.155
3625	-102738.085	-23585.719	18.415
251	-102736.763	-23585.630	1.324
3628	-102728.595	-23585.078	8.186
面積	173.2789120		
地積	173.27 m ²		

120

地番 保一三ノ七			
NO	X	Y	辺長
3625	-102738.085	-23585.719	
3626	-102736.187	-23604.036	18.415
3265	-102742.122	-23604.645	5.966
3631	-102745.629	-23605.004	3.525
3624	-102747.568	-23586.360	18.744
3625	-102738.085	-23585.719	9.504
面積	176.4177135		
地積	176.41 m ²		

121

地番 保一三ノ八			
NO	X	Y	辺長
3624	-102747.568	-23586.360	
3631	-102745.629	-23605.004	18.744
3632	-102755.079	-23605.981	9.500
3623	-102757.113	-23586.455	19.631
250	-102748.253	-23586.406	8.860
3624	-102747.568	-23586.360	0.686
面積	182.1375540		
地積	182.13 m ²		

122

地番 保一三ノ九			
NO	X	Y	辺長
3623	-102757.113	-23586.455	
3632	-102755.079	-23605.981	19.631
3288	-102764.536	-23606.961	9.507
3287	-102765.189	-23600.762	6.233
3286	-102766.206	-23590.922	9.892
3285	-102766.651	-23586.509	4.435
249	-102762.498	-23586.485	4.153
3623	-102757.113	-23586.455	5.385
面積	191.0971150		
地積	191.09 m ²		

123

地番 樋八ノ二, 樋八ノ四, 樋一〇			
NO	X	Y	辺長
3285	-102766.651	-23586.509	
3286	-102766.206	-23590.922	4.435
3287	-102765.189	-23600.762	9.892
3288	-102764.536	-23606.961	6.233
3272	-102778.707	-23608.427	14.246
237	-102778.849	-23607.053	1.381
247	-102780.531	-23590.778	16.361
248	-102776.736	-23586.566	5.669
3285	-102766.651	-23586.509	10.085
面積	293.7944265		
地積	293.79 m ²		

124

地番 樋七B			
NO	X	Y	辺長
3265	-102742.122	-23604.645	
3264	-102740.281	-23622.558	18.007
233	-102740.726	-23622.604	0.447
234	-102757.301	-23624.312	16.662
235	-102773.870	-23626.026	16.657
236	-102777.166	-23623.352	4.244
3272	-102778.707	-23608.427	15.004
3288	-102764.536	-23606.961	14.246
3632	-102755.079	-23605.981	9.507
3631	-102745.629	-23605.004	9.500
3265	-102742.122	-23604.645	3.525
面積	657.6587905		
地積	657.65 m ²		

125

地番 保一三ノ三			
NO	X	Y	辺長
3620	-102733.049	-23603.705	
3619	-102731.205	-23621.616	18.005
3264	-102740.281	-23622.558	9.124
3265	-102742.122	-23604.645	18.007
3626	-102736.187	-23604.036	5.966
3620	-102733.049	-23603.705	3.155
面積	164.2495150		
地積	164.24 m ²		


126

地番 保一三ノ二			
NO	X	Y	辺長
3621	-102723.968	-23602.764	
3622	-102722.115	-23620.674	18.005
232	-102724.147	-23620.884	2.042
3619	-102731.205	-23621.616	7.095
3620	-102733.049	-23603.705	18.005
3627	-102726.745	-23603.057	6.337
3621	-102723.968	-23602.764	2.792
面積	164.4398005		
地積	164.43 m ²		

127

地番 保一三ノ一			
NO	X	Y	辺長
3303	-102714.896	-23601.836	
3328	-102713.033	-23619.738	17.998
3622	-102722.115	-23620.674	9.130
3621	-102723.968	-23602.764	18.005
3630	-102717.287	-23602.091	6.714
3303	-102714.896	-23601.836	2.404
面積	164.2171620		
地積	164.21 m ²		

図面の種類	画地出来形確認測量図	
街区名	13	求積表
町名	西賀茂樋ノ口町	
京都市西賀茂第三土地区画整理組合		

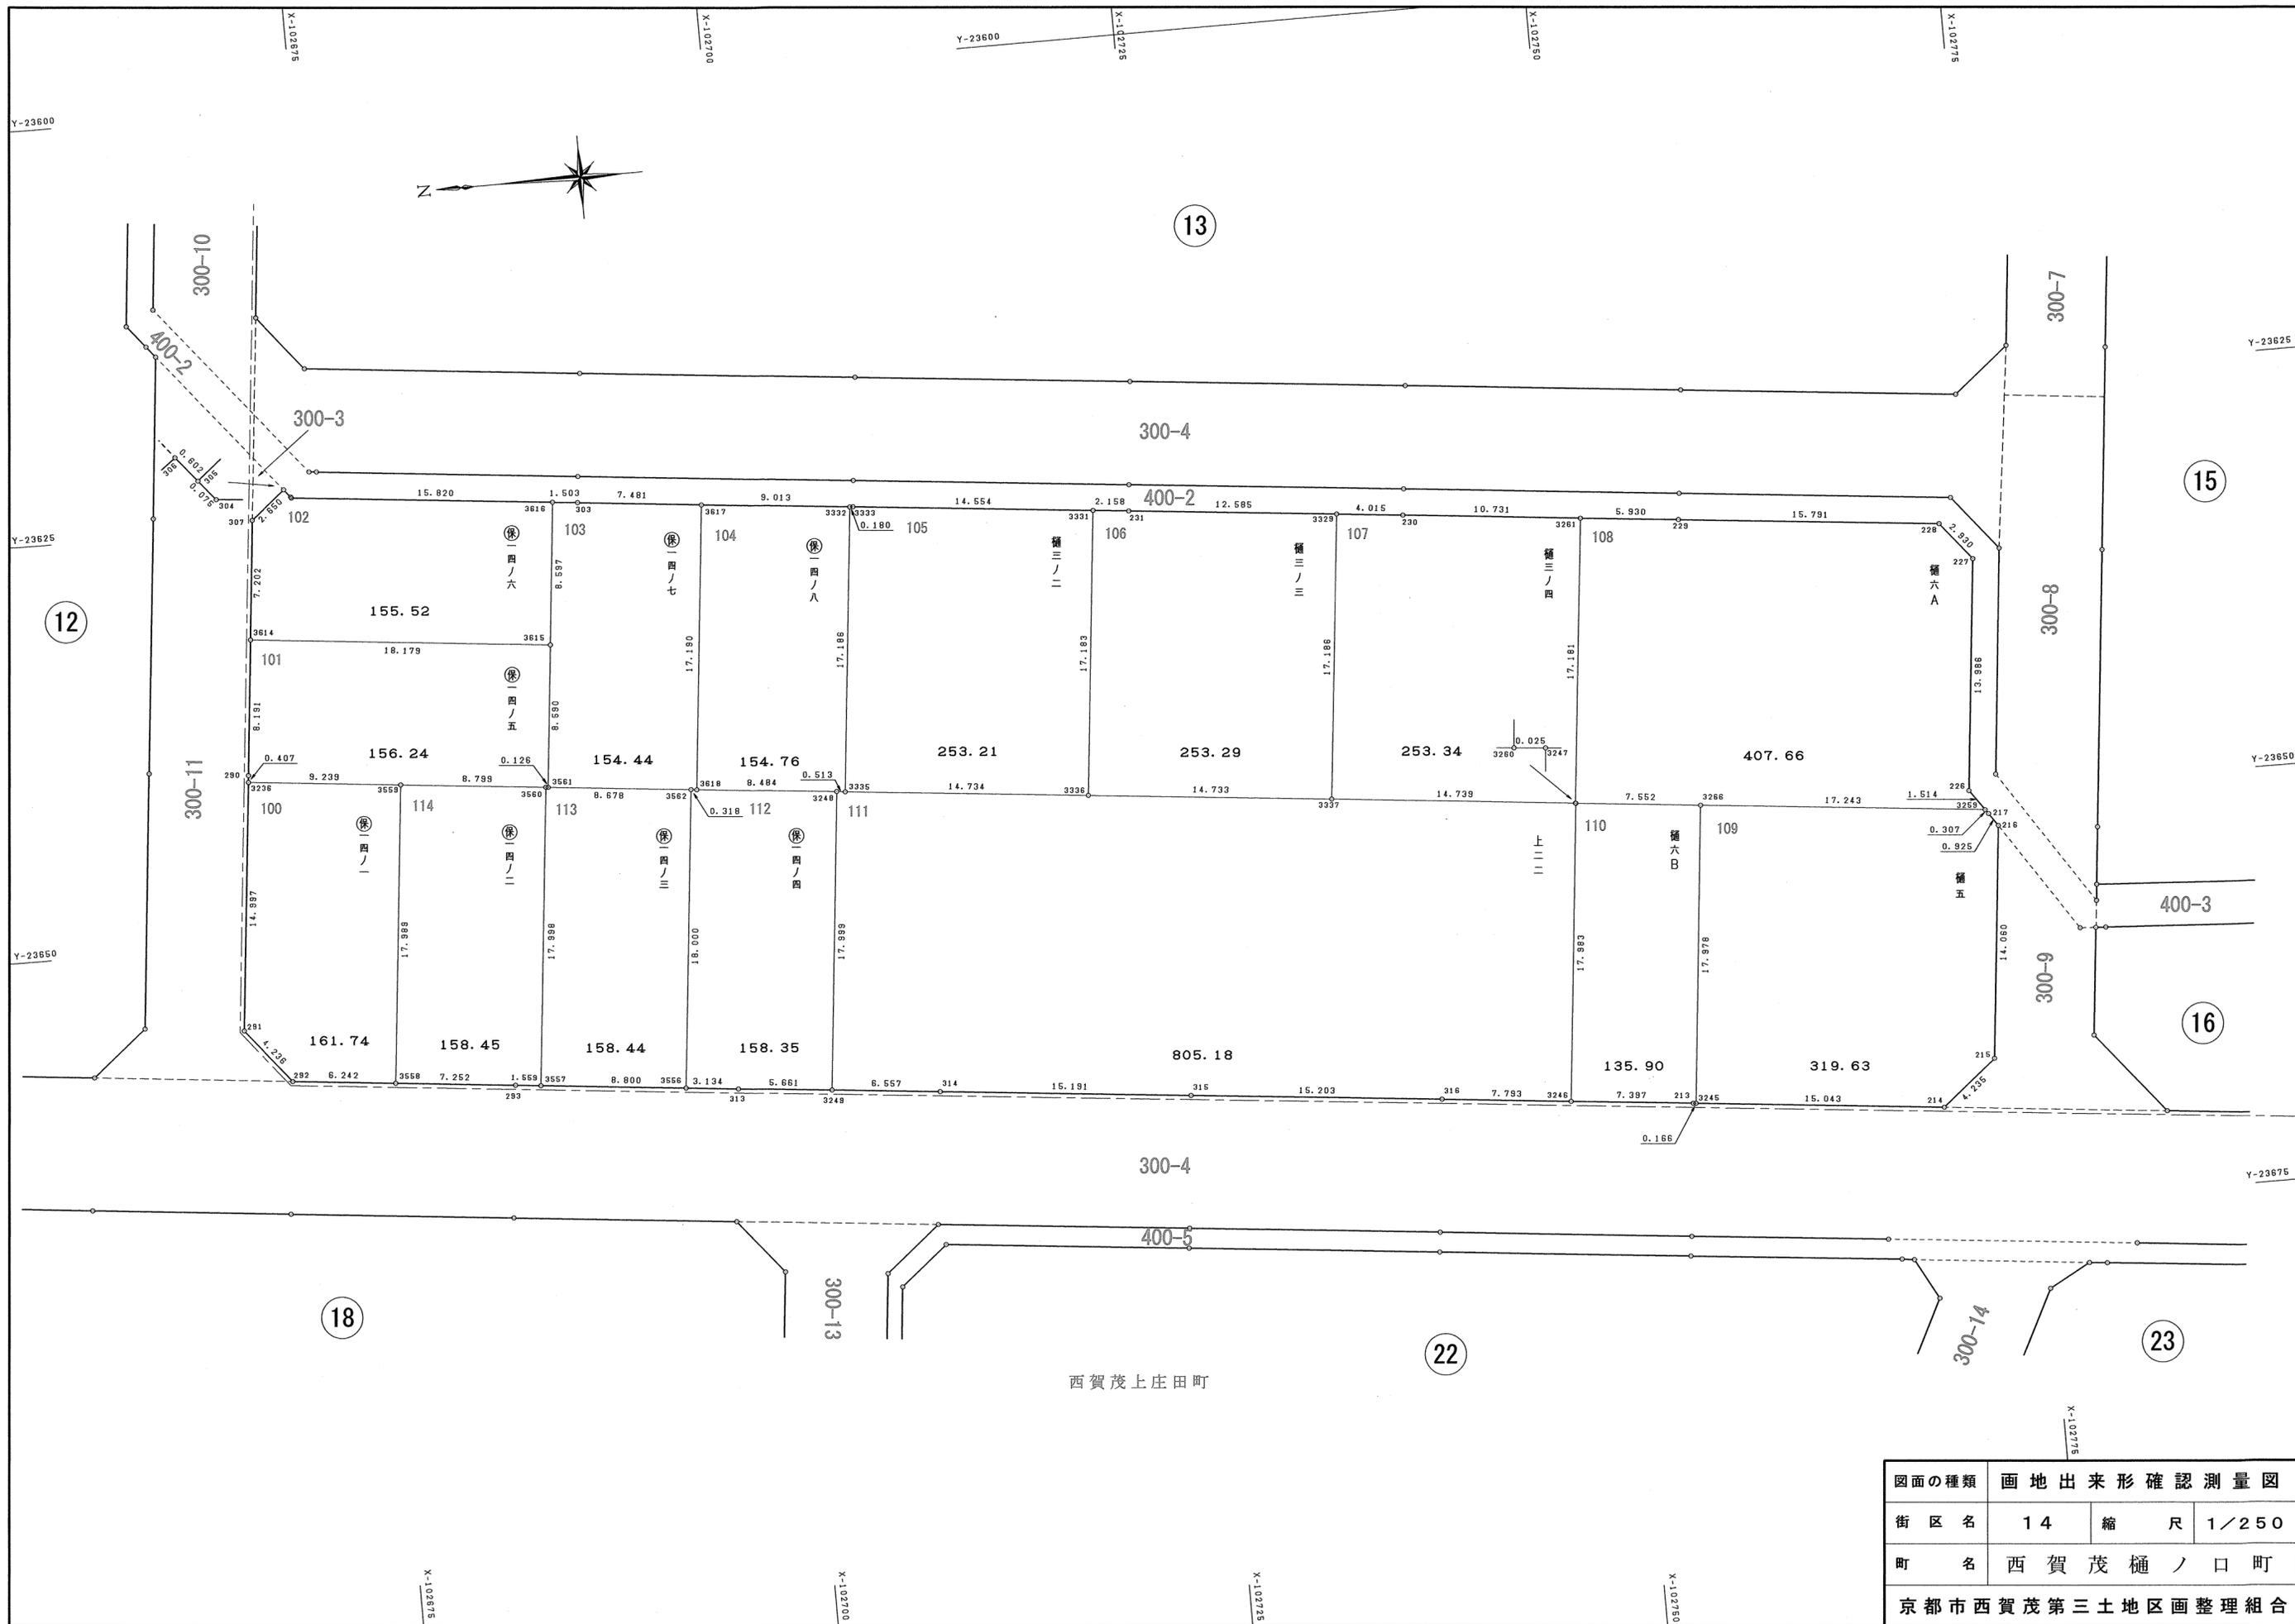

図面の種類	画地出来形確認測量図		
街区名	14	縮尺	1/250
町名	西賀茂樋ノ口町		
京都市西賀茂第三土地区画整理組合			

100

地番	保一四ノ一		
NO	X	Y	辺長
3236	-102668.842	-23640.293	
291	-102667.292	-23655.210	14.997
292	-102669.964	-23658.498	4.236
3558	-102676.173	-23659.141	6.242
3559	-102678.032	-23641.248	17.989
3236	-102668.842	-23640.293	9.239
面積	161.7400190		
地積	161.74 m ²		

101

地番	保一四ノ五		
NO	X	Y	辺長
3614	-102669.726	-23631.740	
290	-102668.884	-23639.888	8.191
3236	-102668.842	-23640.293	0.407
3559	-102678.032	-23641.248	9.239
3560	-102686.786	-23642.145	8.799
3561	-102686.912	-23642.159	0.126
3615	-102687.809	-23633.615	8.590
3614	-102669.726	-23631.740	18.179
面積	156.2414255		
地積	156.24 m ²		

102

地番	保一四ノ六		
NO	X	Y	辺長
304	-102672.953	-23623.433	
305	-102672.907	-23623.373	0.075
306	-102672.525	-23622.907	0.602
307	-102670.466	-23624.576	2.650
3614	-102669.726	-23631.740	7.202
3615	-102687.809	-23633.615	18.179
3616	-102688.689	-23625.063	8.597
304	-102672.953	-23623.433	15.820
面積	155.5223380		
地積	155.52 m ²		

103

地番	保一四ノ七		
NO	X	Y	辺長
3616	-102688.689	-23625.063	
3615	-102687.809	-23633.615	8.597
3561	-102686.912	-23642.159	8.590
3562	-102695.545	-23643.049	8.678
3618	-102695.861	-23643.090	0.318
3617	-102697.626	-23625.990	17.190
303	-102690.184	-23625.218	7.481
3616	-102688.689	-23625.063	1.503
面積	154.4404195		
地積	154.44 m ²		

104

地番	保一四ノ八		
NO	X	Y	辺長
3617	-102697.626	-23625.990	
3618	-102695.861	-23643.090	17.190
3248	-102704.301	-23643.955	8.484
3335	-102704.811	-23644.014	0.513
3332	-102706.591	-23626.920	17.186
3617	-102697.626	-23625.990	9.013
面積	154.7610800		
地積	154.76 m ²		

105

地番	樋三ノ二		
NO	X	Y	辺長
3332	-102706.591	-23626.920	
3335	-102704.811	-23644.014	17.186
3336	-102719.468	-23645.525	14.734
3331	-102721.248	-23628.434	17.183
3333	-102706.770	-23626.939	14.554
3332	-102706.591	-23626.920	0.180
面積	253.2132840		
地積	253.21 m ²		

106

地番	樋三ノ三		
NO	X	Y	辺長
3331	-102721.248	-23628.434	
3336	-102719.468	-23645.525	17.183
3337	-102734.123	-23647.048	14.733
3329	-102735.913	-23629.955	17.186
231	-102723.395	-23628.656	12.585
3331	-102721.248	-23628.434	2.158
面積	253.2904685		
地積	253.29 m ²		

107

地番	樋三ノ四		
NO	X	Y	辺長
3329	-102735.913	-23629.955	
3337	-102734.123	-23647.048	17.186
3260	-102748.784	-23648.565	14.739
3261	-102750.581	-23631.478	17.181
230	-102739.907	-23630.370	10.731
3329	-102735.913	-23629.955	4.015
面積	253.3402460		
地積	253.34 m ²		

108

地番	樋六A		
NO	X	Y	辺長
3261	-102750.581	-23631.478	
3260	-102748.784	-23648.565	17.181
3247	-102748.807	-23648.575	0.025
3266	-102756.319	-23649.354	7.552
3259	-102773.471	-23651.124	17.243
226	-102772.591	-23649.892	1.514
227	-102774.036	-23635.980	13.986
228	-102772.189	-23633.705	2.930
229	-102756.480	-23632.091	15.791
3261	-102750.581	-23631.478	5.930
面積	407.6690615		
地積	407.66 m ²		

109

地番	樋五		
NO	X	Y	辺長
3266	-102756.319	-23649.354	
3245	-102754.475	-23667.238	17.978
214	-102769.438	-23668.791	15.043
215	-102772.724	-23666.119	4.235
216	-102774.178	-23652.134	14.060
217	-102773.650	-23651.374	0.925
3259	-102773.471	-23651.124	0.307
3266	-102756.319	-23649.354	17.243
面積	319.6311895		
地積	319.63 m ²		

110

地番	樋六B		
NO	X	Y	辺長
3247	-102748.807	-23648.575	
3246	-102746.951	-23666.462	17.983
213	-102754.309	-23667.221	7.397
3245	-102754.475	-23667.238	0.166
3266	-102756.319	-23649.354	17.978
3247	-102748.807	-23648.575	7.552
面積	135.9020180		
地積	135.90 m ²		

111

地番	上二二		
NO	X	Y	辺長
3248	-102704.301	-23643.955	
3249	-102702.442	-23661.858	17.999
314	-102708.965	-23662.533	6.557
315	-102724.076	-23664.097	15.191
316	-102739.199	-23665.662	15.203
3246	-102746.951	-23666.462	7.793
3247	-102748.807	-23648.575	17.983
3260	-102748.784	-23648.565	0.025
3337	-102734.123	-23647.048	14.739
3336	-102719.468	-23645.525	14.733
3335	-102704.811	-23644.014	14.734
3248	-102704.301	-23643.955	0.513
面積	805.1851460		
地積	805.18 m ²		

112

地番	保一四ノ四		
NO	X	Y	辺長
3562	-102695.545	-23643.049	
3556	-102693.692	-23660.954	18.000
313	-102696.810	-23661.276	3.134
3249	-102702.442	-23661.858	5.661
3248	-102704.301	-23643.955	17.999
3618	-102695.861	-23643.090	8.484
3562	-102695.545	-23643.049	0.318
面積	158.3564560		
地積	158.35 m ²		


113

地番	保一四ノ三		
NO	X	Y	辺長
3560	-102686.786	-23642.145	
3557	-102684.938	-23660.048	17.998
3556	-102693.692	-23660.954	8.800
3562	-102695.545	-23643.049	18.000
3561	-102686.912	-23642.159	8.678
3560	-102686.786	-23642.145	0.126
面積	158.4467175		
地積	158.44 m ²		

114

地番	保一四ノ二		
NO	X	Y	辺長
3559	-102678.032	-23641.248	
3558	-102676.173	-23659.141	17.989
293	-102683.387	-23659.888	7.252
3557	-102684.938	-23660.048	1.559
3560	-102686.786	-23642.145	17.998
3559	-102678.032	-23641.248	8.799
面積	158.4515665		
地積	158.45 m ²		

図面の種類	画地出来形確認測量図	
街区名	14	求積表
町名	西賀茂樋ノ口町	
京都市西賀茂第三土地区画整理組合		

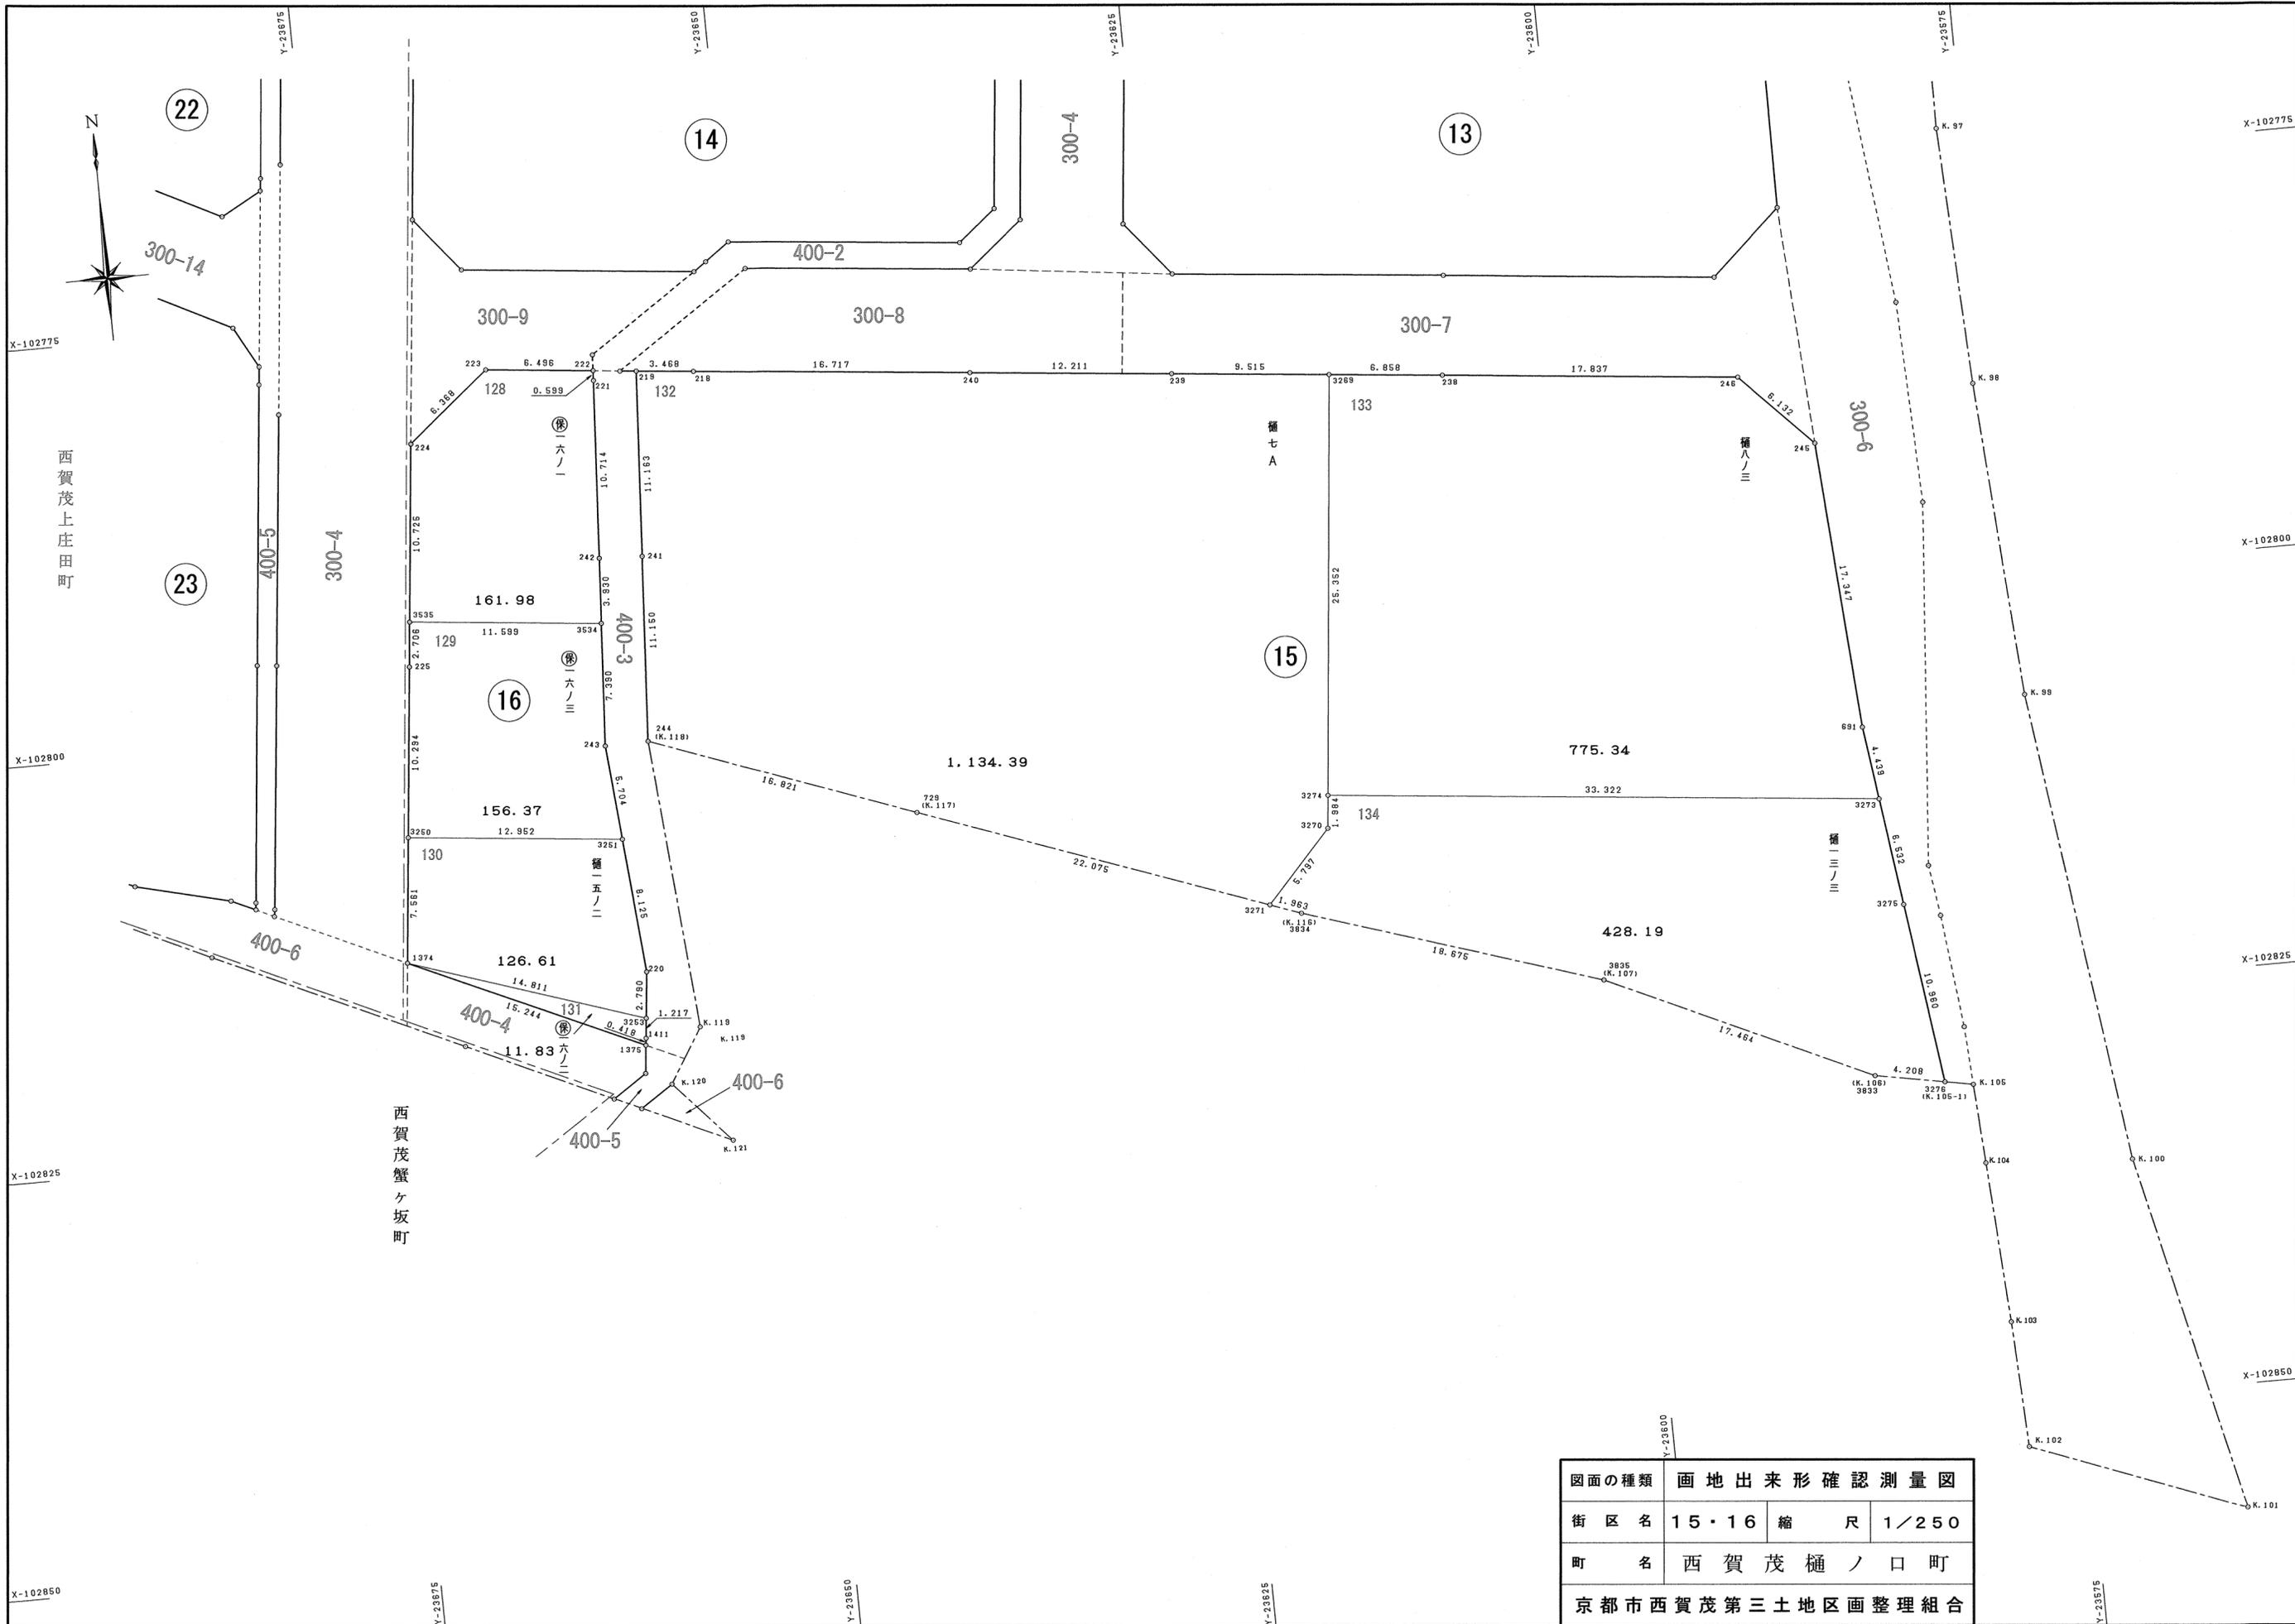

図面の種類	画地出来形確認測量図		
街区名	15・16	縮尺	1/250
町名	西賀茂樋ノ口町		
京都市西賀茂第三土地区画整理組合			

15街区

132

地番 樋七A			
NO	X	Y	辺長
219	-102779.806	-23656.197	
241	-102790.946	-23656.917	11.163
244	-102802.073	-23657.641	11.150
729	-102807.936	-23641.874	16.821
3271	-102815.575	-23621.162	22.075
3270	-102811.321	-23617.223	5.797
3274	-102809.347	-23617.022	1.984
3269	-102784.120	-23614.506	25.352
239	-102783.138	-23623.971	9.515
240	-102781.880	-23636.118	12.211
218	-102780.157	-23652.746	16.717
219	-102779.806	-23656.197	3.468
面積	1134.3954790		
地積	1134.39 m ²		

133

地番 樋八ノ三			
NO	X	Y	辺長
3269	-102784.120	-23614.506	
3274	-102809.347	-23617.022	25.352
3273	-102812.777	-23583.876	33.322
691	-102808.376	-23584.461	4.439
245	-102791.071	-23585.675	17.347
246	-102786.665	-23589.941	6.132
238	-102784.827	-23607.684	17.837
3269	-102784.120	-23614.506	6.858
面積	775.3476015		
地積	775.34 m ²		

134

地番 樋一三ノ三			
NO	X	Y	辺長
3274	-102809.347	-23617.022	
3270	-102811.321	-23617.223	1.984
3271	-102815.575	-23621.162	5.797
3834	-102816.255	-23619.320	1.963
3835	-102822.017	-23601.556	18.675
3833	-102829.354	-23585.707	17.464
3276	-102830.118	-23581.568	4.208
3275	-102819.253	-23583.015	10.960
3273	-102812.777	-23583.876	6.532
3274	-102809.347	-23617.022	33.322
面積	428.1954360		
地積	428.19 m ²		

16街区

128

地番 保一六ノ一			
NO	X	Y	辺長
223	-102778.858	-23665.248	
224	-102782.872	-23670.192	6.368
3535	-102793.540	-23671.297	10.725
3534	-102794.740	-23659.760	11.599
242	-102790.818	-23659.506	3.930
221	-102780.125	-23658.822	10.714
222	-102779.527	-23658.786	0.599
223	-102778.858	-23665.248	6.496
面積	161.9891630		
地積	161.98 m ²		

129

地番 保一六ノ三			
NO	X	Y	辺長
3535	-102793.540	-23671.297	
225	-102796.232	-23671.576	2.706
3250	-102806.472	-23672.637	10.294
3251	-102807.799	-23659.753	12.952
243	-102802.115	-23660.238	5.704
3534	-102794.740	-23659.760	7.390
3535	-102793.540	-23671.297	11.599
面積	156.3771360		
地積	156.37 m ²		


130

地番 樋一五ノ二			
NO	X	Y	辺長
3250	-102806.472	-23672.637	
1374	-102813.993	-23673.416	7.561
3253	-102818.669	-23659.362	14.811
220	-102815.895	-23659.061	2.790
3251	-102807.799	-23659.753	8.125
3250	-102806.472	-23672.637	12.952
面積	126.6147325		
地積	126.61 m ²		

131

地番 保一六ノ二			
NO	X	Y	辺長
1374	-102813.993	-23673.416	
1375	-102820.296	-23659.536	15.244
1411	-102819.879	-23659.498	0.418
3253	-102818.669	-23659.362	1.217
1374	-102813.993	-23673.416	14.811
面積	11.8343750		
地積	11.83 m ²		

図面の種類	画地出来形確認測量図	
街区名	15・16	求積表
町名	西賀茂樋ノ口町	
京都市西賀茂第三土地区画整理組合		

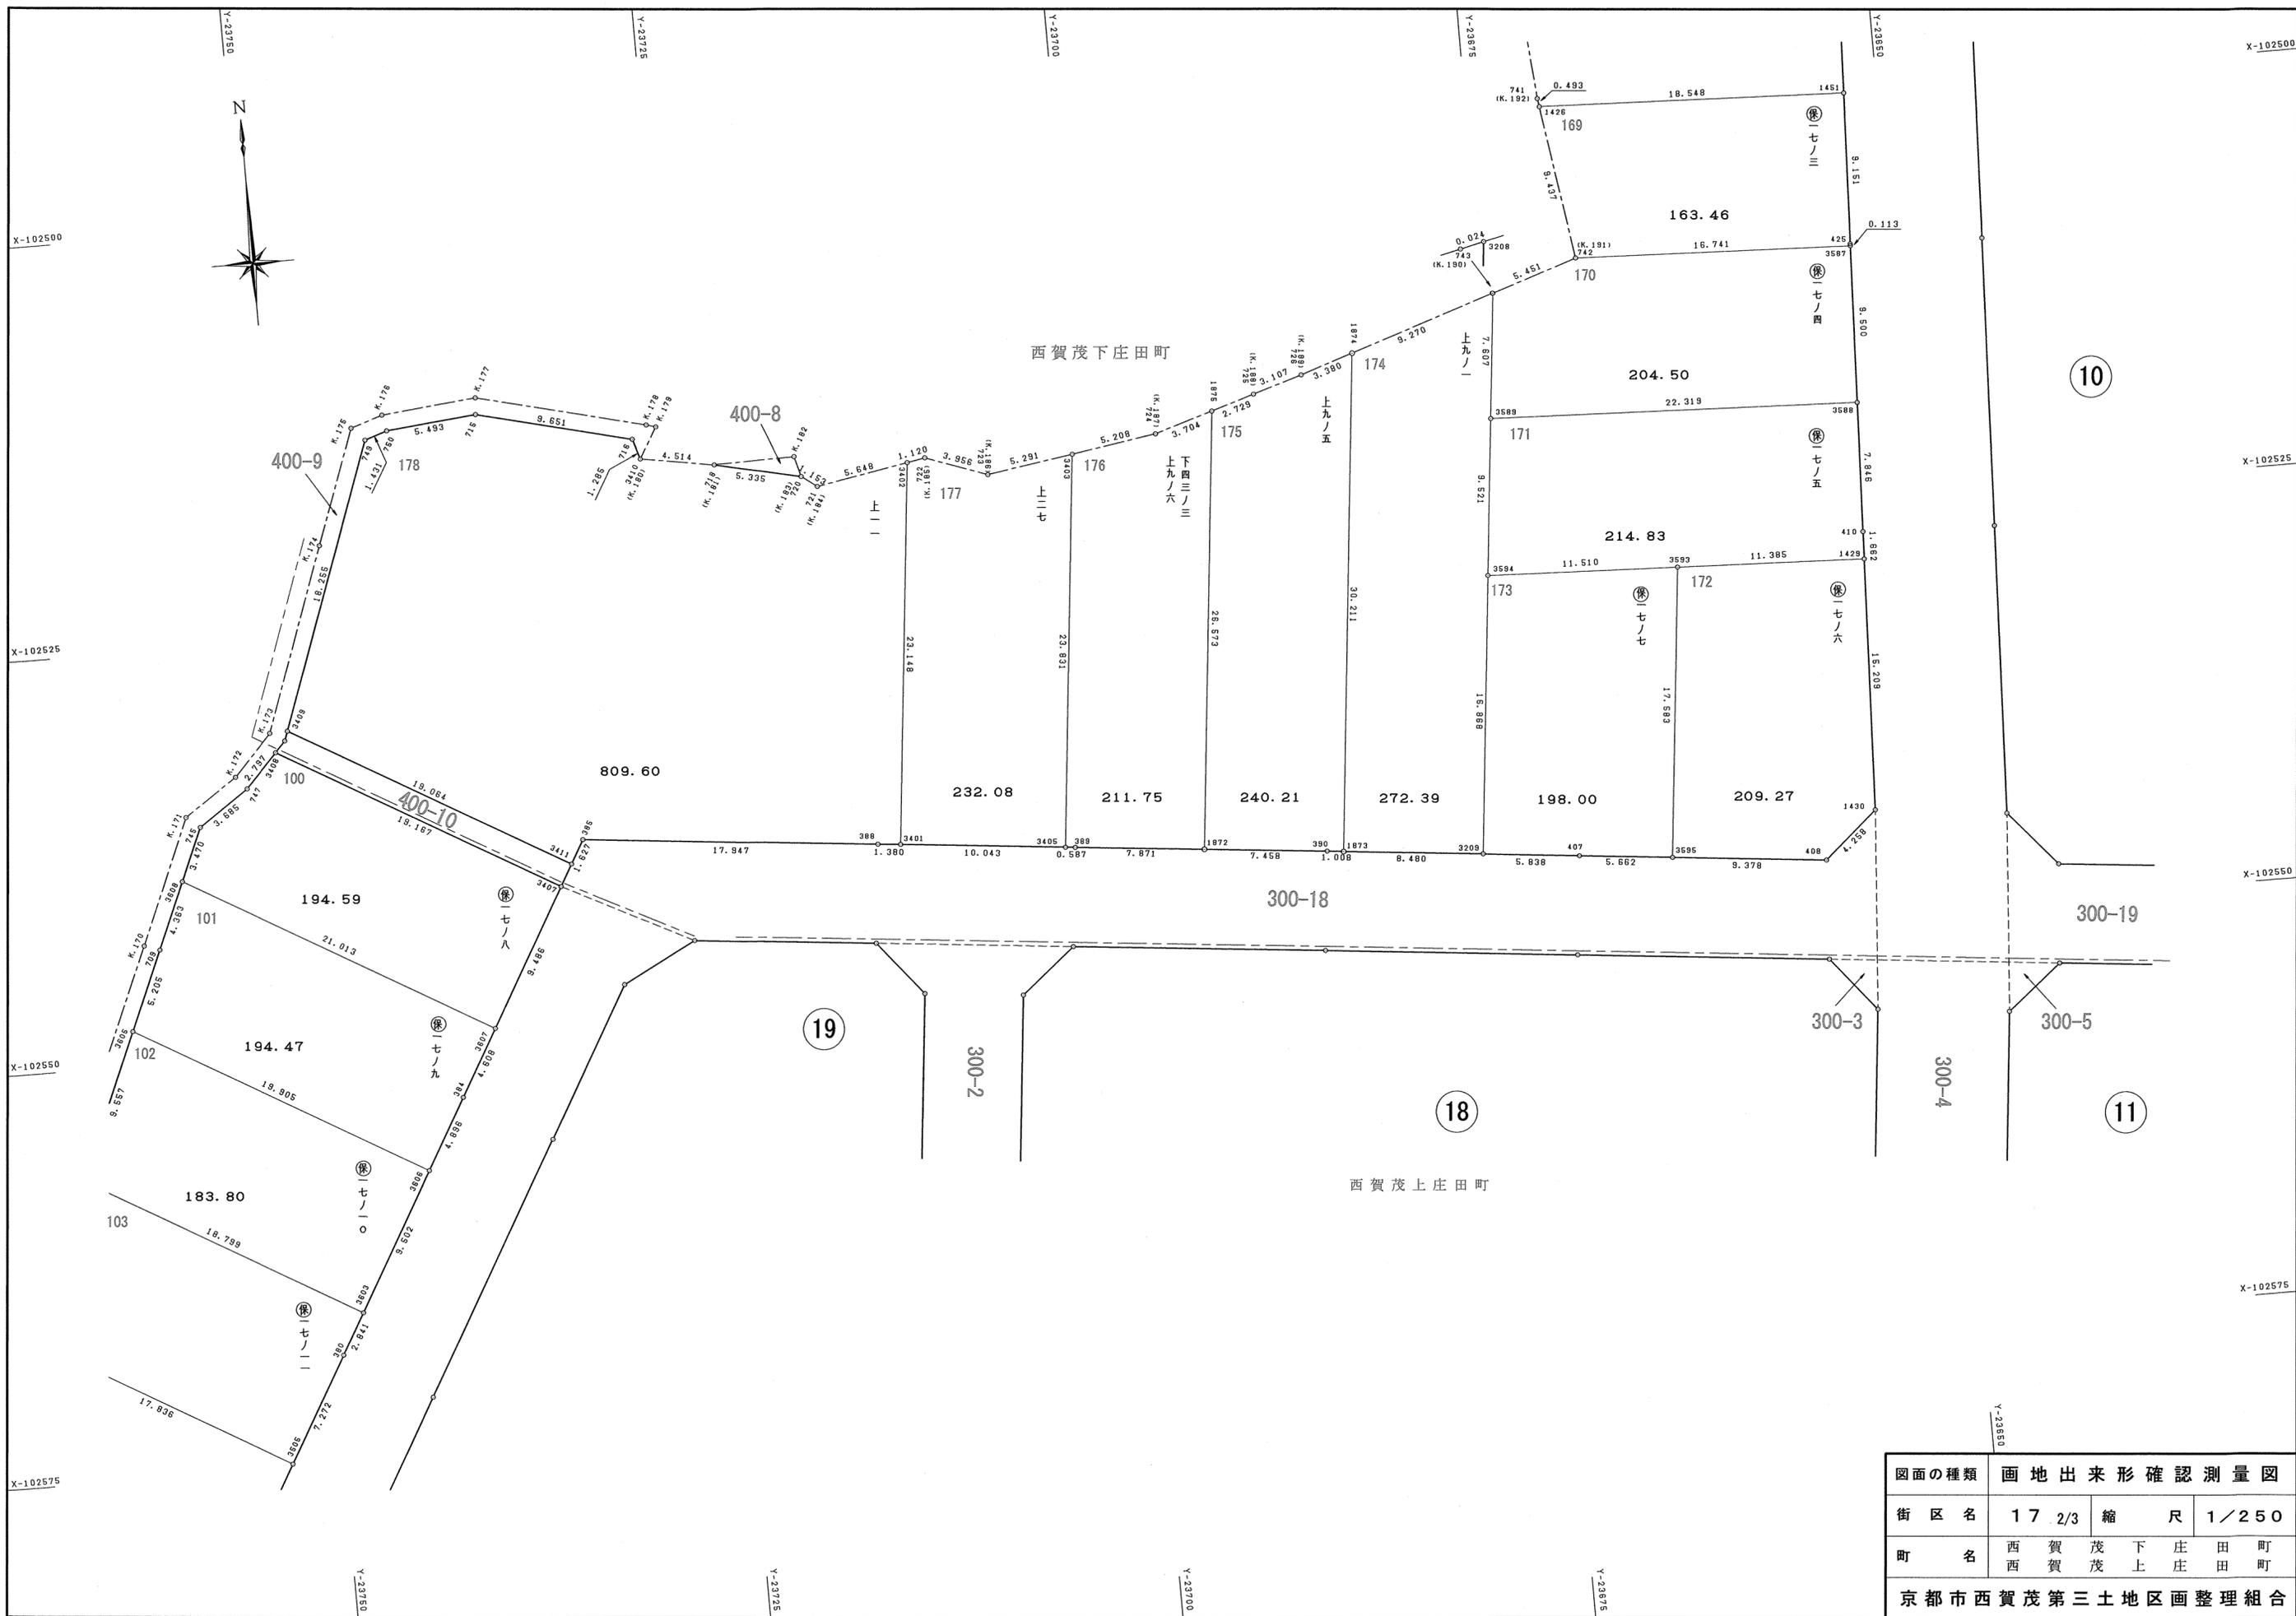


図面の種類	画地出来形確認測量図		
街区名	17 2/3	縮尺	1/250
町名	西賀茂下庄田町		西賀茂上庄田町
京都市西賀茂第三土地区画整理組合			



19

西賀茂上庄田町

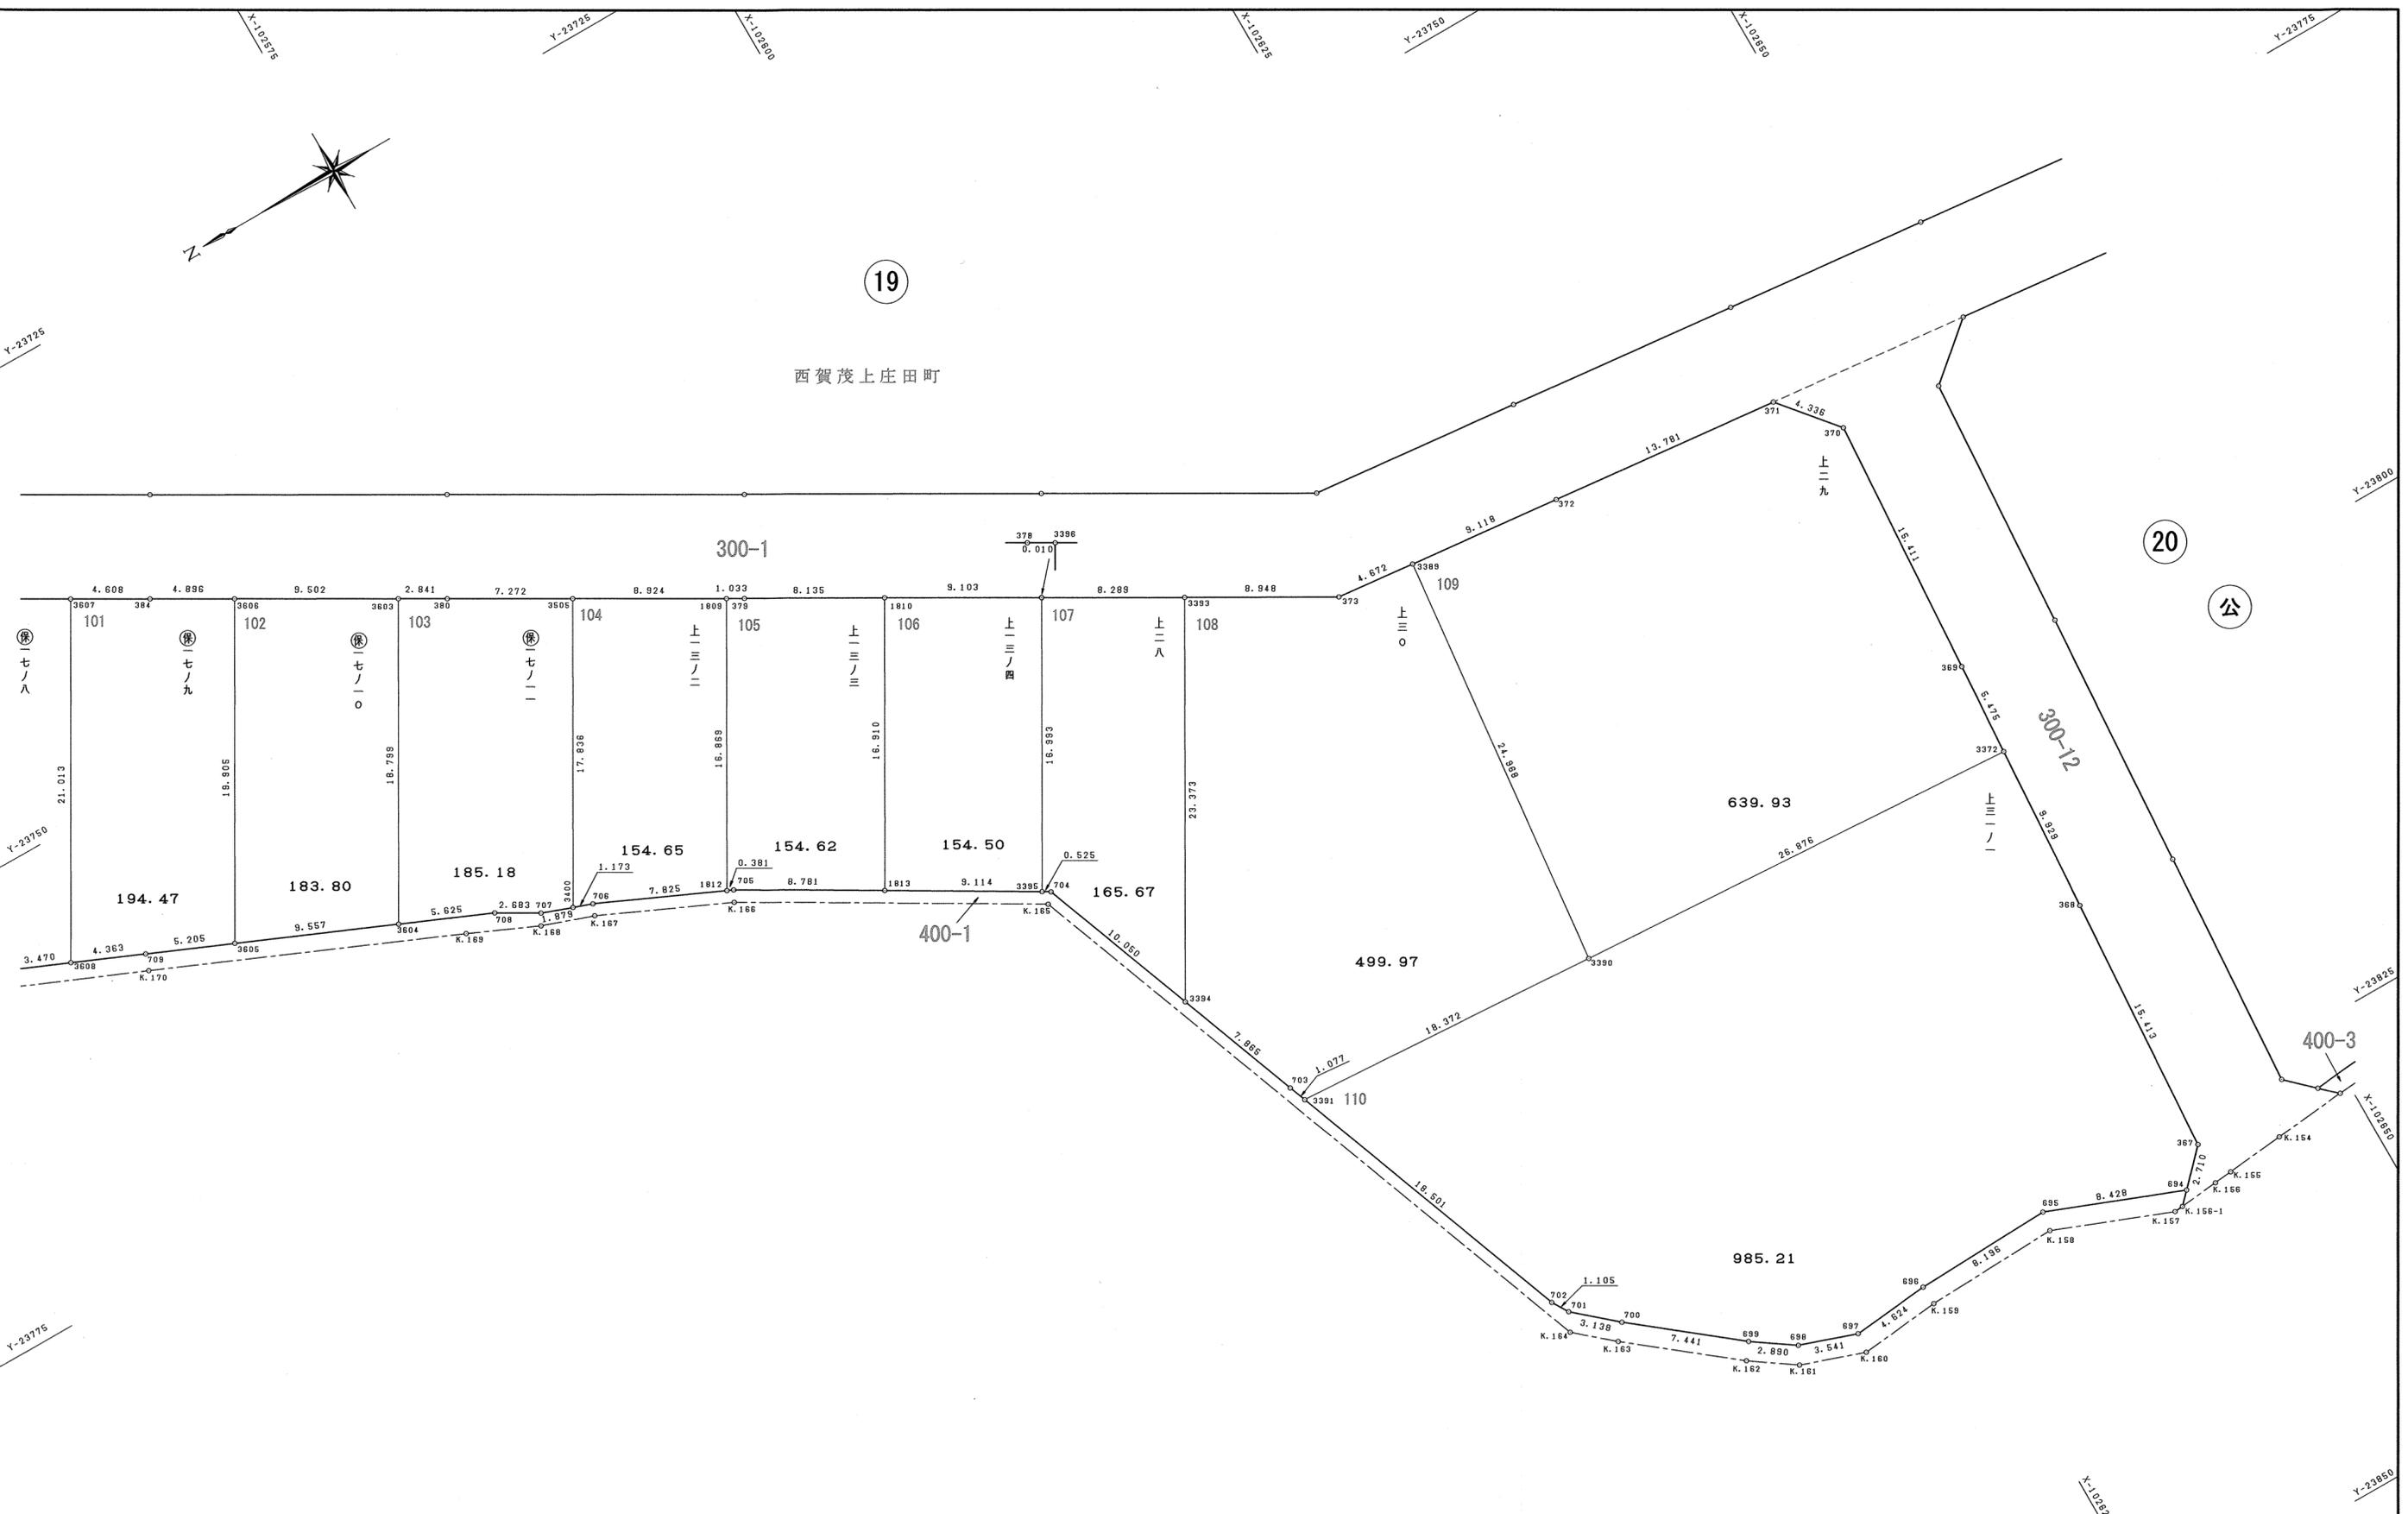

20

公

図面の種類	画地出来形確認測量図		
街区名	17 3/3	縮尺	1/250
町名	西賀茂下庄田町 西賀茂上庄田町		
京都市西賀茂第三土地区画整理組合			

165

地番 下二七ノ四, 下二七ノ五			
NO	X	Y	辺長
752	-102423.415	-23668.912	
753	-102428.208	-23671.569	5.480
754	-102431.733	-23672.785	3.728
755	-102436.025	-23672.545	4.298
756	-102440.231	-23670.407	4.718
3197	-102445.424	-23670.441	5.193
3195	-102446.293	-23649.747	20.712
429	-102444.025	-23649.652	2.269
450	-102425.991	-23648.880	18.050
451	-102424.431	-23650.296	2.106
452	-102424.365	-23651.167	0.873
752	-102423.415	-23668.912	17.770
面積	482.6018015		
地積	482.60 m ²		

166

地番 下四三			
NO	X	Y	辺長
3195	-102446.293	-23649.747	
3197	-102445.424	-23670.441	20.712
757	-102448.239	-23670.460	2.815
758	-102454.267	-23669.247	6.148
759	-102457.893	-23669.274	3.626
760	-102479.049	-23671.164	21.240
1361	-102479.031	-23671.627	0.463
740	-102478.997	-23672.316	0.689
3207	-102480.842	-23672.159	1.851
3206	-102481.720	-23651.230	20.947
427	-102479.938	-23651.155	1.783
428	-102461.978	-23650.402	17.975
3195	-102446.293	-23649.747	15.698
面積	698.9534875		
地積	698.95 m ²		

167

地番 保一七ノ一			
NO	X	Y	辺長
3206	-102481.720	-23651.230	
3207	-102480.842	-23672.159	20.947
1461	-102490.151	-23671.369	9.342
3583	-102490.982	-23651.622	19.764
3206	-102481.720	-23651.230	9.270
面積	188.6784535		
地積	188.67 m ²		

168

地番 保一七ノ二			
NO	X	Y	辺長
3583	-102490.982	-23651.622	
1461	-102490.151	-23671.369	19.764
741	-102498.972	-23670.620	8.852
1426	-102499.460	-23670.546	0.493
1451	-102500.238	-23652.014	18.548
426	-102491.939	-23651.662	8.306
3583	-102490.982	-23651.622	0.957
面積	177.6351120		
地積	177.63 m ²		

169

地番 保一七ノ三			
NO	X	Y	辺長
1451	-102500.238	-23652.014	
1426	-102499.460	-23670.546	18.548
742	-102508.791	-23669.134	9.437
3587	-102509.494	-23652.407	16.741
425	-102509.381	-23652.402	0.113
1451	-102500.238	-23652.014	9.151
面積	163.4634090		
地積	163.46 m ²		

170

地番 保一七ノ四			
NO	X	Y	辺長
3587	-102509.494	-23652.407	
742	-102508.791	-23669.134	16.741
3208	-102510.485	-23674.316	5.451
3589	-102518.051	-23675.106	7.607
3588	-102518.986	-23652.806	22.319
3587	-102509.494	-23652.407	9.500
面積	204.5018765		
地積	204.50 m ²		

171

地番 保一七ノ五			
NO	X	Y	辺長
3588	-102518.986	-23652.806	
3589	-102518.051	-23675.106	22.319
3594	-102527.523	-23676.079	9.521
3593	-102528.000	-23664.578	11.510
1429	-102528.487	-23653.203	11.385
410	-102526.826	-23653.135	1.662
3588	-102518.986	-23652.806	7.846
面積	214.8372390		
地積	214.83 m ²		

172

地番 保一七ノ六			
NO	X	Y	辺長
1429	-102528.487	-23653.203	
3593	-102528.000	-23664.578	11.385
3595	-102545.491	-23666.383	17.583
408	-102546.462	-23657.055	9.378
1430	-102543.684	-23653.828	4.258
1429	-102528.487	-23653.203	15.209
面積	209.2773605		
地積	209.27 m ²		

173

地番 保一七ノ七			
NO	X	Y	辺長
3593	-102528.000	-23664.578	
3594	-102527.523	-23676.079	11.510
3209	-102544.301	-23677.822	16.868
407	-102544.904	-23672.015	5.838
3595	-102545.491	-23666.383	5.662
3593	-102528.000	-23664.578	17.583
面積	198.0050375		
地積	198.00 m ²		

174

地番 上九ノ一			
NO	X	Y	辺長
3208	-102510.485	-23674.316	
743	-102510.493	-23674.339	0.024
1874	-102513.374	-23683.150	9.270
1873	-102543.425	-23686.257	30.211
3209	-102544.301	-23677.822	8.480
3594	-102527.523	-23676.079	16.868
3589	-102518.051	-23675.106	9.521
3208	-102510.485	-23674.316	7.607
面積	272.3979300		
地積	272.39 m ²		

175

地番 上九ノ五			
NO	X	Y	辺長
1874	-102513.374	-23683.150	
726	-102514.425	-23686.363	3.380
725	-102515.328	-23689.336	3.107
1875	-102516.121	-23691.948	2.729
1872	-102542.554	-23694.679	26.573
390	-102543.321	-23687.260	7.458
1873	-102543.425	-23686.257	1.008
1874	-102513.374	-23683.150	30.211
面積	240.2136435		
地積	240.21 m ²		

176

地番 下九ノ六, 下四三ノ三			
NO	X	Y	辺長
1875	-102516.121	-23691.948	
724	-102517.198	-23695.492	3.704
3403	-102517.980	-23700.641	5.208
3405	-102541.685	-23703.093	23.831
389	-102541.745	-23702.509	0.587
1872	-102542.554	-23694.679	7.871
1875	-102516.121	-23691.948	26.573
面積	211.7565385		
地積	211.75 m ²		

177

地番 上二七			
NO	X	Y	辺長
3403	-102517.980	-23700.641	
723	-102518.774	-23705.873	5.291
722	-102517.435	-23709.596	3.956
3402	-102517.627	-23710.700	1.120
3401	-102540.653	-23713.083	23.148
3405	-102541.685	-23703.093	10.043
3403	-102517.980	-23700.641	23.831
面積	232.0812385		
地積	232.08 m ²		

図面の種類	画地出来形確認測量図		
街区名	17 1/2	求積表	
町名	西賀茂下庄田町	西賀茂上庄田町	
京都市西賀茂第三土地区画整理組合			

100

地番 保一七ノ八			
NO	X	Y	辺長
3407	-102541.385	-23733.873	
3408	-102531.821	-23750.484	19.167
747	-102533.859	-23752.400	2.797
745	-102535.939	-23755.443	3.685
3608	-102539.127	-23756.814	3.470
3607	-102549.609	-23738.602	21.013
3407	-102541.385	-23733.873	9.486
面積	194.5960560		
地積	194.59 m ²		

101

地番 保一七ノ九			
NO	X	Y	辺長
3607	-102549.609	-23738.602	
3608	-102539.127	-23756.814	21.013
709	-102543.136	-23758.538	4.363
3605	-102547.919	-23760.593	5.205
3606	-102557.849	-23743.341	19.905
384	-102553.604	-23740.900	4.896
3607	-102549.609	-23738.602	4.608
面積	194.4751570		
地積	194.47 m ²		

102

地番 保一七ノ一〇			
NO	X	Y	辺長
3606	-102557.849	-23743.341	
3605	-102547.919	-23760.593	19.905
3604	-102556.700	-23764.366	9.557
3603	-102566.087	-23748.078	18.799
3606	-102557.849	-23743.341	9.502
面積	183.8012325		
地積	183.80 m ²		

103

地番 保一七ノ一一			
NO	X	Y	辺長
3603	-102566.087	-23748.078	
3604	-102556.700	-23764.366	18.799
708	-102561.868	-23766.587	5.625
707	-102564.183	-23767.945	2.683
3400	-102565.953	-23768.577	1.879
3505	-102574.854	-23753.120	17.836
380	-102568.550	-23749.494	7.272
3603	-102566.087	-23748.078	2.841
面積	185.1826505		
地積	185.18 m ²		

104

地番 上一三ノ二			
NO	X	Y	辺長
3505	-102574.854	-23753.120	
3400	-102565.953	-23768.577	17.836
706	-102567.058	-23768.972	1.173
1812	-102574.187	-23772.199	7.825
1809	-102582.589	-23757.571	16.869
3505	-102574.854	-23753.120	8.924
面積	154.6536810		
地積	154.65 m ²		

105

地番 上一三ノ三			
NO	X	Y	辺長
1809	-102582.589	-23757.571	
1812	-102574.187	-23772.199	16.869
705	-102574.535	-23772.356	0.381
1813	-102582.106	-23776.805	8.781
1810	-102590.536	-23762.145	16.910
379	-102583.485	-23758.086	8.135
1809	-102582.589	-23757.571	1.033
面積	154.6232890		
地積	154.62 m ²		

106

地番 上一三ノ四			
NO	X	Y	辺長
1810	-102590.536	-23762.145	
1813	-102582.106	-23776.805	16.910
3395	-102589.964	-23781.423	9.114
3396	-102598.435	-23766.691	16.993
378	-102598.428	-23766.686	0.010
1810	-102590.536	-23762.145	9.103
面積	154.5019175		
地積	154.50 m ²		

107

地番 上二八			
NO	X	Y	辺長
3396	-102598.435	-23766.691	
3395	-102589.964	-23781.423	16.993
704	-102590.417	-23781.689	0.525
3394	-102593.971	-23791.090	10.050
3393	-102605.619	-23770.826	23.373
3396	-102598.435	-23766.691	8.289
面積	165.6740240		
地積	165.67 m ²		

108

地番 上三〇			
NO	X	Y	辺長
3393	-102605.619	-23770.826	
3394	-102593.971	-23791.090	23.373
703	-102596.752	-23798.447	7.865
3391	-102597.134	-23799.455	1.077
3390	-102615.470	-23800.610	18.372
3389	-102618.022	-23775.772	24.968
373	-102613.374	-23775.290	4.672
3393	-102605.619	-23770.826	8.948
面積	499.9781705		
地積	499.97 m ²		

109

地番 上二九			
NO	X	Y	辺長
3389	-102618.022	-23775.772	
3390	-102615.470	-23800.610	24.968
3372	-102642.294	-23802.282	26.876
369	-102642.635	-23786.817	5.475
370	-102643.595	-23781.435	15.411
371	-102640.801	-23778.119	4.336
372	-102627.092	-23776.712	13.781
3389	-102618.022	-23775.772	9.118
面積	639.9304440		
地積	639.93 m ²		


110

地番 上一三ノ一			
NO	X	Y	辺長
3391	-102597.134	-23799.455	
702	-102603.685	-23816.758	18.501
701	-102604.259	-23817.703	1.105
700	-102606.627	-23819.763	3.138
699	-102612.441	-23824.407	7.441
698	-102614.827	-23826.038	2.890
697	-102618.173	-23827.197	3.541
696	-102622.776	-23826.753	4.624
695	-102630.968	-23826.470	8.196
694	-102638.823	-23829.525	8.428
367	-102640.706	-23827.575	2.710
368	-102641.675	-23812.192	15.413
3372	-102642.294	-23802.282	9.929
3390	-102615.470	-23800.610	26.876
3391	-102597.134	-23799.455	18.372
面積	985.2116985		
地積	985.21 m ²		

178

地番 上一一			
NO	X	Y	辺長
3402	-102517.627	-23710.700	
721	-102518.596	-23716.265	5.648
720	-102517.906	-23717.189	1.153
718	-102516.732	-23722.394	5.335
3410	-102515.984	-23726.846	4.514
716	-102514.758	-23727.232	1.285
715	-102512.442	-23736.602	9.651
750	-102512.964	-23742.071	5.493
749	-102513.414	-23743.430	1.431
3409	-102530.577	-23749.650	18.255
3411	-102540.076	-23733.120	19.064
385	-102538.665	-23732.308	1.627
388	-102540.511	-23714.456	17.947
3401	-102540.653	-23713.083	1.380
3402	-102517.627	-23710.700	23.148
面積	809.6011665		
地積	809.60 m ²		

図面の種類	画地出来形確認測量図		
街区名	17 2/2	求積表	
町名	西賀茂下庄田町	西賀茂上庄田町	
京都市西賀茂第三土地区画整理組合			

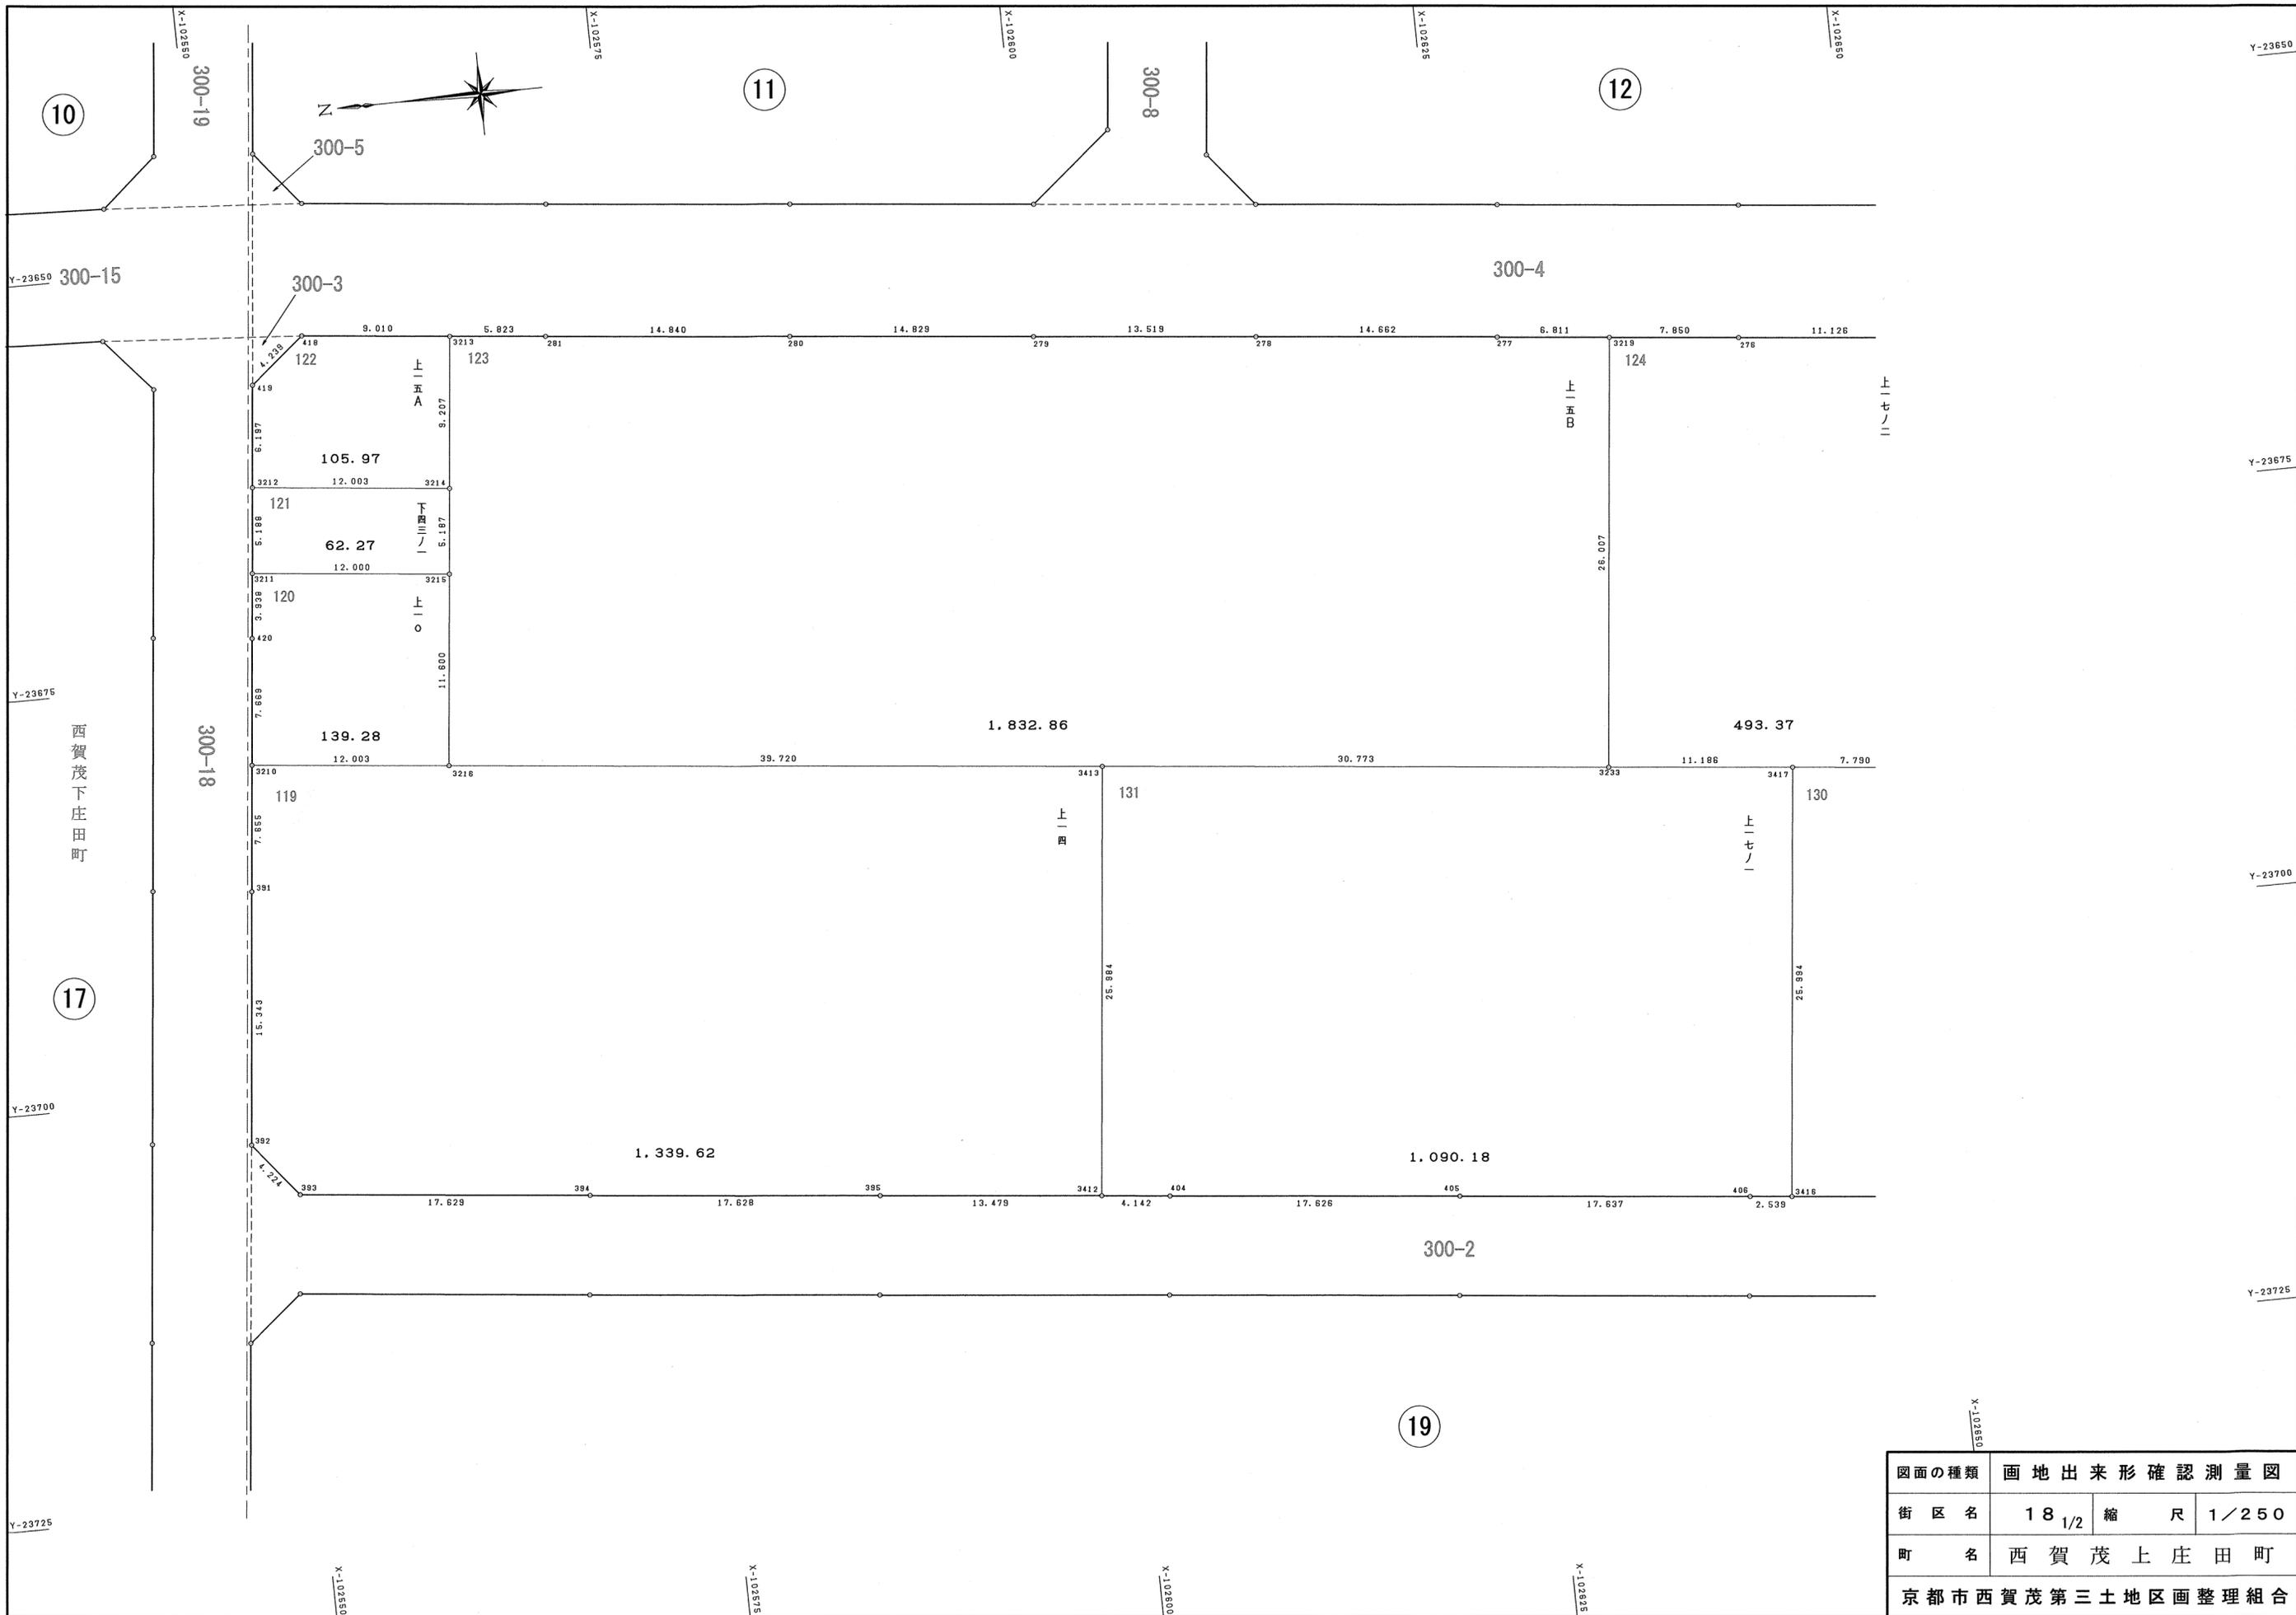

図面の種類	画地出来形確認測量図		
街区名	18 1/2	縮尺	1/250
町名	西賀茂上庄田町		
京都市西賀茂第三土地区画整理組合			

119

地番 上一四			
NO	X	Y	辺長
3210	-102550.090	-23680.262	
391	-102549.302	-23687.877	7.655
392	-102547.725	-23703.139	15.343
393	-102550.389	-23706.417	4.224
394	-102567.924	-23708.236	17.629
395	-102585.459	-23710.054	17.628
3412	-102598.867	-23711.445	13.479
3413	-102601.538	-23695.598	25.984
3216	-102562.030	-23681.499	39.720
3210	-102550.090	-23680.262	12.003
面積	1339.6263770		
地積	1339.62 m ²		

120

地番 上一〇			
NO	X	Y	辺長
3211	-102551.286	-23668.716	
420	-102550.879	-23672.633	3.938
3210	-102550.090	-23680.262	7.669
3216	-102562.030	-23681.499	12.003
3215	-102563.222	-23669.960	11.600
3211	-102551.286	-23668.716	12.000
面積	139.2827670		
地積	139.28 m ²		

121

地番 下四三ノ一			
NO	X	Y	辺長
3212	-102551.821	-23663.555	
3211	-102551.286	-23668.716	5.188
3215	-102563.222	-23669.960	12.000
3214	-102563.760	-23664.800	5.187
3212	-102551.821	-23663.555	12.003
面積	62.2711430		
地積	62.27 m ²		

122

地番 上一五A			
NO	X	Y	辺長
418	-102555.748	-23654.714	
419	-102552.461	-23657.391	4.239
3212	-102551.821	-23663.555	6.197
3214	-102563.760	-23664.800	12.003
3213	-102564.711	-23655.642	9.207
418	-102555.748	-23654.714	9.010
面積	105.9776420		
地積	105.97 m ²		

123

地番 上一五B			
NO	X	Y	辺長
3213	-102564.711	-23655.642	
3214	-102563.760	-23664.800	9.207
3215	-102563.222	-23669.960	5.187
3216	-102562.030	-23681.499	11.600
3413	-102601.538	-23695.598	39.720
3233	-102632.147	-23688.775	30.773
3219	-102634.824	-23662.906	26.007
277	-102628.049	-23662.202	6.811
278	-102613.464	-23660.694	14.662
279	-102600.016	-23659.301	13.519
280	-102585.265	-23657.773	14.829
281	-102570.504	-23656.241	14.840
3213	-102564.711	-23655.642	5.823
面積	1832.8630265		
地積	1832.86 m ²		

124

地番 上一七ノ二			
NO	X	Y	辺長
3219	-102634.824	-23662.906	
3233	-102632.147	-23688.775	26.007
3417	-102643.275	-23689.916	11.186
3232	-102651.023	-23690.731	7.790
3228	-102653.699	-23664.867	26.002
276	-102642.632	-23663.717	11.126
3219	-102634.824	-23662.906	7.850
面積	493.3725515		
地積	493.37 m ²		

125

地番 上一二-B			
NO	X	Y	辺長
3228	-102653.699	-23664.867	
3232	-102651.023	-23690.731	26.002
3231	-102678.047	-23693.540	27.169
3235	-102680.723	-23667.661	26.016
295	-102669.162	-23666.467	11.622
296	-102657.206	-23665.231	12.019
3228	-102653.699	-23664.867	3.525
面積	706.6221750		
地積	706.62 m ²		

126

地番 上三五			
NO	X	Y	辺長
3235	-102680.723	-23667.661	
3231	-102678.047	-23693.540	26.016
3230	-102681.046	-23693.836	3.013
3555	-102682.374	-23680.908	12.996
3229	-102683.728	-23667.972	13.006
294	-102682.590	-23667.854	1.144
3235	-102680.723	-23667.661	1.876
面積	78.3169035		
地積	78.31 m ²		

127

地番 保一八ノ一			
NO	X	Y	辺長
3229	-102683.728	-23667.972	
3555	-102682.374	-23680.908	13.006
3554	-102697.643	-23682.486	15.350
323	-102698.679	-23672.528	10.011
324	-102696.005	-23669.241	4.237
3229	-102683.728	-23667.972	12.342
面積	195.1098315		
地積	195.10 m ²		

128

地番 保一八ノ二			
NO	X	Y	辺長
3555	-102682.374	-23680.908	
3230	-102681.046	-23693.836	12.996
3353	-102683.081	-23694.044	2.045
3354	-102696.304	-23695.427	13.295
322	-102697.091	-23687.795	7.672
3554	-102697.643	-23682.486	5.337
3555	-102682.374	-23680.908	15.350
面積	199.4893205		
地積	199.48 m ²		

129

地番 上二三ノ二			
NO	X	Y	辺長
3353	-102683.081	-23694.044	
3352	-102680.390	-23719.897	25.992
345	-102690.651	-23720.961	10.316
346	-102693.933	-23718.292	4.230
347	-102695.519	-23703.031	15.343
3354	-102696.304	-23695.427	7.644
3353	-102683.081	-23694.044	13.295
面積	341.1949140		
地積	341.19 m ²		


130

地番 上二三ノ一			
NO	X	Y	辺長
3417	-102643.275	-23689.916	
3416	-102640.589	-23715.771	25.994
343	-102655.597	-23717.325	15.088
344	-102673.128	-23719.144	17.625
3352	-102680.390	-23719.897	7.300
3353	-102683.081	-23694.044	25.992
3230	-102681.046	-23693.836	2.045
3231	-102678.047	-23693.540	3.013
3232	-102651.023	-23690.731	27.169
3417	-102643.275	-23689.916	7.790
面積	1039.6648070		
地積	1039.66 m ²		


131

地番 上一七ノ一			
NO	X	Y	辺長
3413	-102601.538	-23685.598	
3412	-102598.867	-23711.445	25.984
404	-102602.987	-23711.873	4.142
405	-102620.519	-23713.693	17.626
406	-102638.063	-23715.510	17.637
3416	-102640.589	-23715.771	2.539
3417	-102643.275	-23689.916	25.994
3233	-102632.147	-23688.775	11.186
3413	-102601.538	-23685.598	30.773
面積	1090.1816670		
地積	1090.18 m ²		

図面の種類	画地出来形確認測量図	
街区名	18	求積表
町名	西賀茂上庄田町	
京都市西賀茂第三土地区画整理組合		

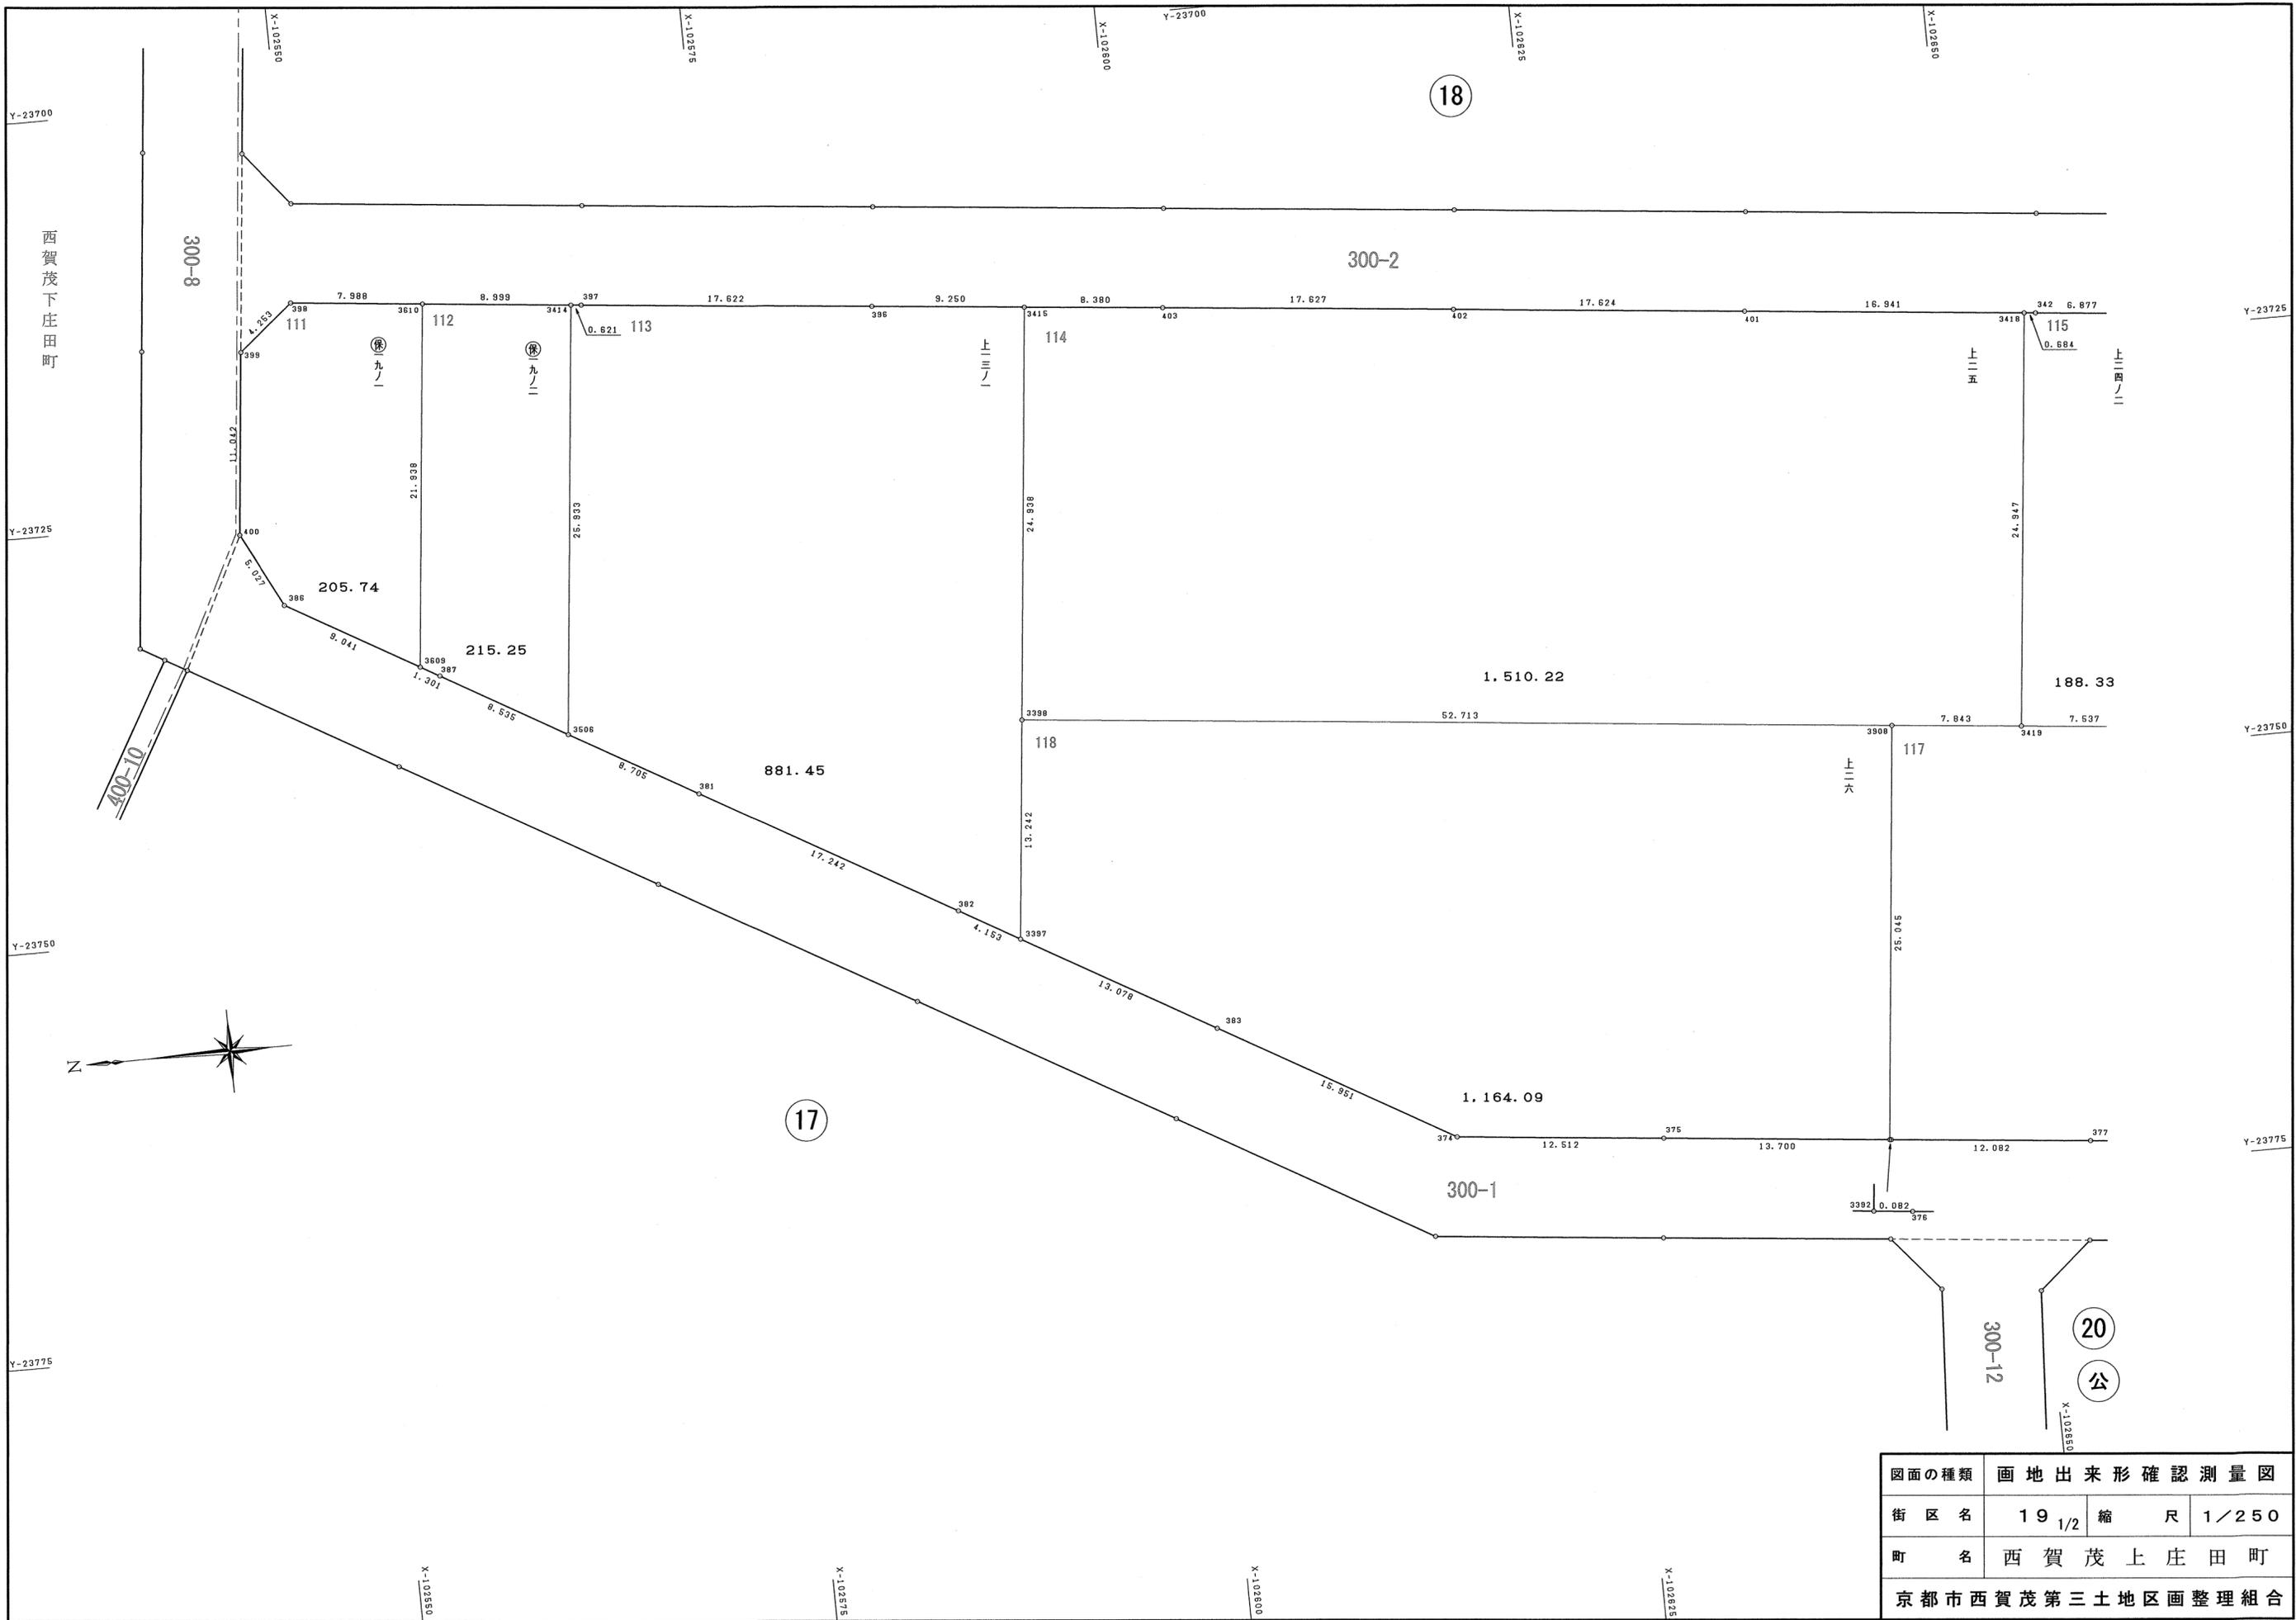

図面の種類	画地出来形確認測量図		
街区名	19/2	縮尺	1/250
町名	西賀茂上庄田町		
京都市西賀茂第三土地区画整理組合			

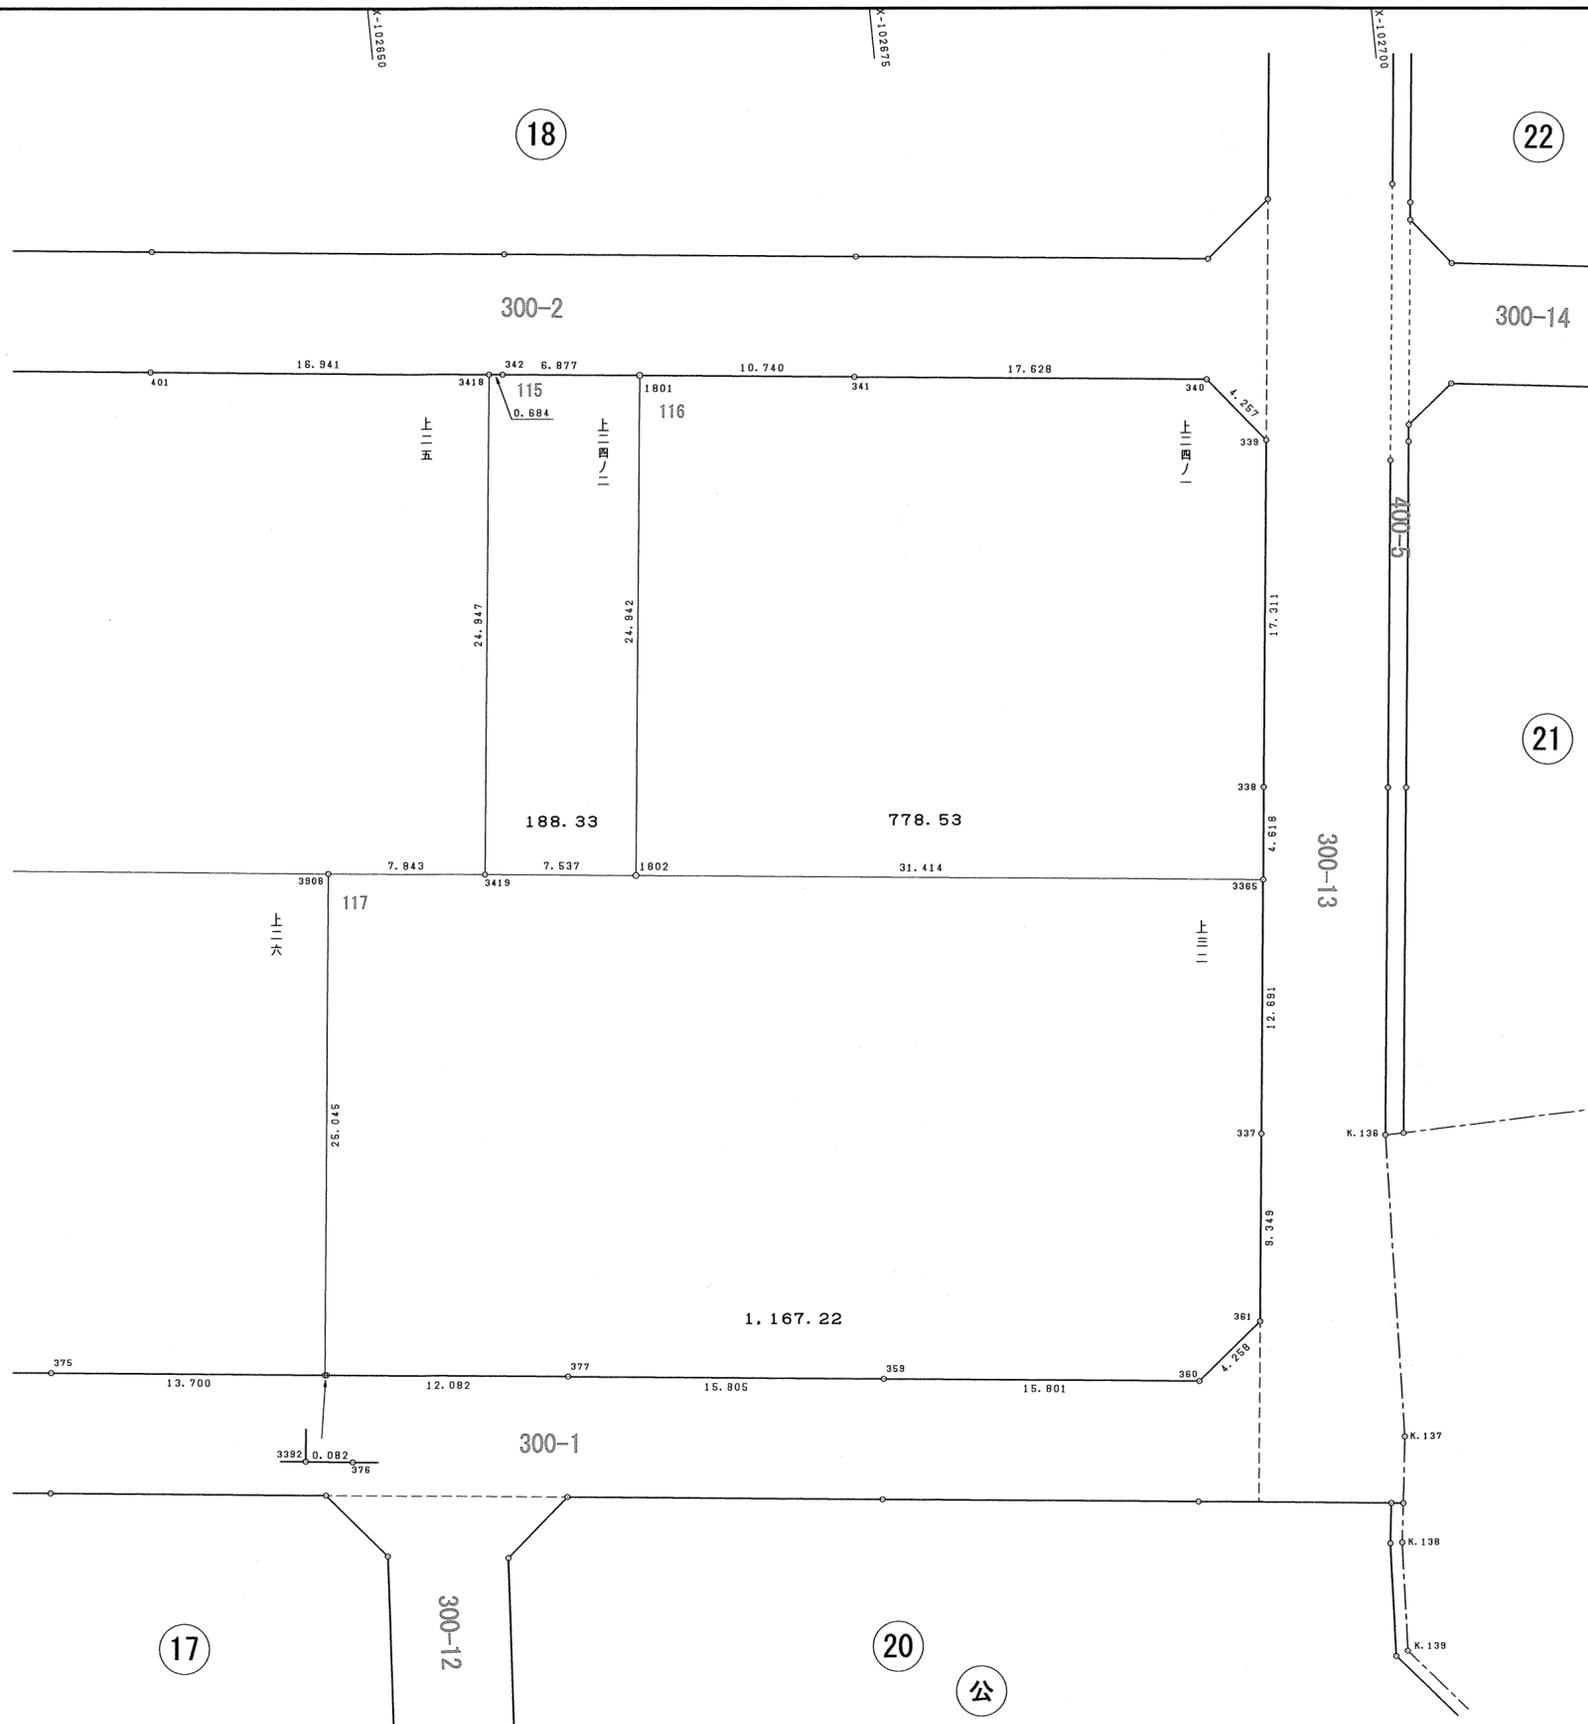

図面の種類	画地出来形確認測量図		
街区名	19 ^{2/2}	縮尺	1/250
町名	西賀茂上庄田町		
京都市西賀茂第三土地区画整理組合			

111

地番 保一九ノ一			
NO	X	Y	辺長
398	-102549.781	-23712.389	
399	-102546.482	-23715.074	4.253
400	-102545.344	-23726.058	11.042
386	-102547.638	-23730.532	5.027
3609	-102555.475	-23735.040	9.041
3610	-102557.726	-23713.217	21.938
398	-102549.781	-23712.389	7.988
面積	205.7417040		
地積	205.74 m ²		

112

地番 保一九ノ二			
NO	X	Y	辺長
3610	-102557.726	-23713.217	
3609	-102555.475	-23735.040	21.938
387	-102556.603	-23735.689	1.301
3506	-102564.002	-23739.945	8.535
3414	-102566.677	-23714.150	25.933
3610	-102557.726	-23713.217	8.999
面積	215.2569395		
地積	215.25 m ²		

113

地番 上一三ノ一			
NO	X	Y	辺長
3414	-102566.677	-23714.150	
3506	-102564.002	-23739.945	25.933
381	-102571.548	-23744.286	8.705
382	-102586.493	-23752.885	17.242
3397	-102590.093	-23754.957	4.153
3398	-102591.458	-23741.785	13.242
3415	-102594.025	-23716.979	24.938
396	-102584.824	-23716.028	9.250
397	-102567.295	-23714.214	17.622
3414	-102566.677	-23714.150	0.621
面積	881.4582185		
地積	881.45 m ²		

114

地番 上二五			
NO	X	Y	辺長
3415	-102594.025	-23716.979	
3398	-102591.458	-23741.785	24.938
3908	-102643.890	-23747.225	52.713
3419	-102651.691	-23748.043	7.843
3418	-102654.275	-23723.230	24.947
401	-102637.423	-23721.492	16.941
402	-102619.893	-23719.668	17.624
403	-102602.361	-23717.840	17.627
3415	-102594.025	-23716.979	8.380
面積	1510.2244240		
地積	1510.22 m ²		

115

地番 上二四ノ二			
NO	X	Y	辺長
3418	-102654.275	-23723.230	
3419	-102651.691	-23748.043	24.947
1802	-102659.189	-23748.815	7.537
1801	-102661.797	-23724.009	24.942
342	-102654.956	-23723.300	6.877
3418	-102654.275	-23723.230	0.684
面積	188.3345225		
地積	188.33 m ²		

116

地番 上二四ノ一			
NO	X	Y	辺長
1801	-102661.797	-23724.009	
1802	-102659.189	-23748.815	24.942
3365	-102690.436	-23752.052	31.414
338	-102690.911	-23747.458	4.618
339	-102692.701	-23730.239	17.311
340	-102690.014	-23726.937	4.257
341	-102672.480	-23725.116	17.628
1801	-102661.797	-23724.009	10.740
面積	778.5397240		
地積	778.53 m ²		

117

地番 上三二			
NO	X	Y	辺長
3908	-102643.890	-23747.225	
3392	-102641.325	-23772.139	25.045
376	-102641.407	-23772.148	0.082
377	-102653.426	-23773.389	12.082
359	-102669.147	-23775.026	15.805
360	-102684.864	-23776.656	15.801
361	-102688.174	-23773.977	4.258
337	-102689.129	-23764.676	8.349
3365	-102690.436	-23752.052	12.691
1802	-102659.189	-23748.815	31.414
3419	-102651.691	-23748.043	7.537
3908	-102643.890	-23747.225	7.843
面積	1167.2222630		
地積	1167.22 m ²		

118

地番 上二六			
NO	X	Y	辺長
3398	-102591.458	-23741.785	
3397	-102590.093	-23754.957	13.242
383	-102601.427	-23761.482	13.078
374	-102615.252	-23769.440	15.951
375	-102627.698	-23770.726	12.512
3392	-102641.325	-23772.139	13.700
3908	-102643.890	-23747.225	25.045
3398	-102591.458	-23741.785	52.713
面積	1164.0935885		
地積	1164.09 m ²		

図面の種類	画地出来形確認測量図	
街区名	19	求積表
町名	西賀茂上庄田町	
京都市西賀茂第三土地区画整理組合		

151

地番 保二〇ノ一			
NO	X	Y	辺長
366	-102646.789	-23826.752	
3373	-102648.344	-23828.238	2.150
3388	-102661.734	-23827.026	13.444
3378	-102663.959	-23826.803	2.236
4356	-102665.478	-23826.565	1.537
4355	-102665.992	-23818.602	7.979
4347	-102647.374	-23817.428	18.654
366	-102646.789	-23826.752	9.342
面積	176.4469625		
地積	176.44 m ²		

152

地番 保二〇ノ二			
NO	X	Y	辺長
4347	-102647.374	-23817.428	
4355	-102665.992	-23818.602	18.654
4354	-102666.567	-23809.301	9.318
4348	-102647.957	-23808.140	18.646
365	-102647.678	-23812.573	4.441
4347	-102647.374	-23817.428	4.864
面積	173.6872620		
地積	173.68 m ²		

153

地番 保二〇ノ三			
NO	X	Y	辺長
4348	-102647.957	-23808.140	
4354	-102666.567	-23809.301	18.646
4353	-102667.150	-23800.021	9.298
4349	-102648.541	-23798.848	18.645
4348	-102647.957	-23808.140	9.310
面積	173.4887615		
地積	173.48 m ²		

154

地番 保二〇ノ四			
NO	X	Y	辺長
4349	-102648.541	-23798.848	
4353	-102667.150	-23800.021	18.645
4352	-102667.731	-23790.729	9.310
4350	-102649.119	-23789.554	18.649
364	-102648.645	-23797.187	7.647
4349	-102648.541	-23798.848	1.664
面積	173.6244505		
地積	173.62 m ²		


155

地番 保二〇ノ五			
NO	X	Y	辺長
4350	-102649.119	-23789.554	
4352	-102667.731	-23790.729	18.649
4351	-102668.336	-23780.983	9.764
362	-102652.813	-23779.366	15.606
363	-102649.582	-23782.110	4.238
4350	-102649.119	-23789.554	7.458
面積	184.5030205		
地積	184.50 m ²		

156

地番 1号公園			
NO	X	Y	辺長
4356	-102665.478	-23826.565	
3380	-102671.079	-23825.689	5.669
3382	-102684.991	-23821.242	14.605
3384	-102688.094	-23819.431	3.592
3386	-102690.529	-23816.808	3.579
3363	-102697.080	-23808.203	10.814
3371	-102705.198	-23802.092	10.161
3362	-102696.331	-23794.727	11.526
3359	-102693.345	-23791.251	4.582
3357	-102693.586	-23785.625	5.631
3356	-102693.831	-23783.628	2.011
357	-102684.241	-23782.634	9.641
358	-102668.521	-23781.002	15.804
4351	-102668.336	-23780.983	0.185
4352	-102667.731	-23790.729	9.764
4353	-102667.150	-23800.021	9.310
4354	-102666.567	-23809.301	9.298
4355	-102665.992	-23818.602	9.318
4356	-102665.478	-23826.565	7.979
面積	1172.2182885		
地積	1172.21 m ²		

図面の種類	画地出来形確認測量図	
街区名	20	求積表
町名	西賀茂上庄田町	
京都市西賀茂第三土地区画整理組合		

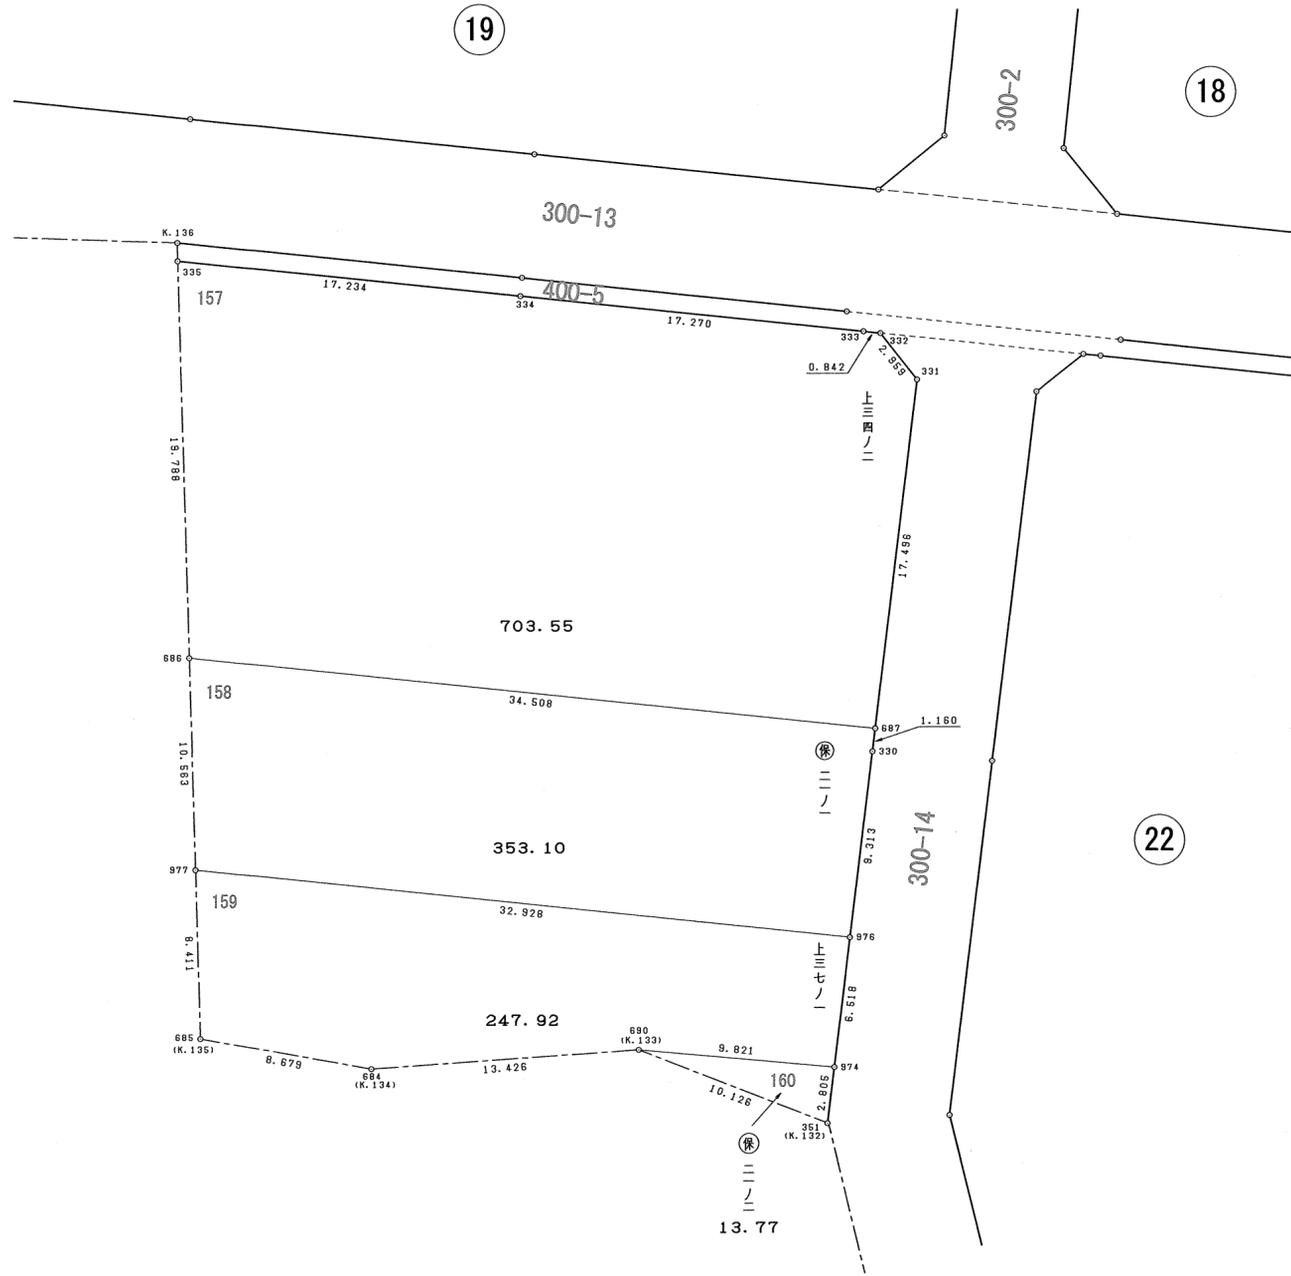

図面の種類	画地出来形確認測量図		
街区名	21	縮尺	1/250
町名	西賀茂上庄田町		
京都市西賀茂第三土地区画整理組合			

157

地番 上三四ノ二			
NO	X	Y	辺長
335	-102696.205	-23765.306	
686	-102715.985	-23764.733	19.788
687	-102719.541	-23730.408	34.508
331	-102702.171	-23728.305	17.496
332	-102699.854	-23730.147	2.959
333	-102699.766	-23730.985	0.842
334	-102697.979	-23748.163	17.270
335	-102696.205	-23765.306	17.234
面積	703.5518120		
地積	703.55 m ²		

158

地番 保二一ノ一			
NO	X	Y	辺長
686	-102715.985	-23764.733	
977	-102726.544	-23764.428	10.563
976	-102729.938	-23731.675	32.928
330	-102720.693	-23730.547	9.313
687	-102719.541	-23730.408	1.160
686	-102715.985	-23764.733	34.508
面積	353.1003175		
地積	353.10 m ²		


159

地番 上三七ノ一			
NO	X	Y	辺長
977	-102726.544	-23764.428	
685	-102734.952	-23764.184	8.411
684	-102736.474	-23755.639	8.679
690	-102735.533	-23742.246	13.426
974	-102736.409	-23732.464	9.821
976	-102729.938	-23731.675	6.518
977	-102726.544	-23764.428	32.928
面積	247.9297130		
地積	247.92 m ²		

160

地番 保二一ノ二			
NO	X	Y	辺長
974	-102736.409	-23732.464	
690	-102735.533	-23742.246	9.821
351	-102739.194	-23732.804	10.126
974	-102736.409	-23732.464	2.805
面積	13.7703550		
地積	13.77 m ²		

図面の種類	画地出来形確認測量図	
街区名	21	求積表
町名	西賀茂上庄田町	
京都市西賀茂第三土地区画整理組合		

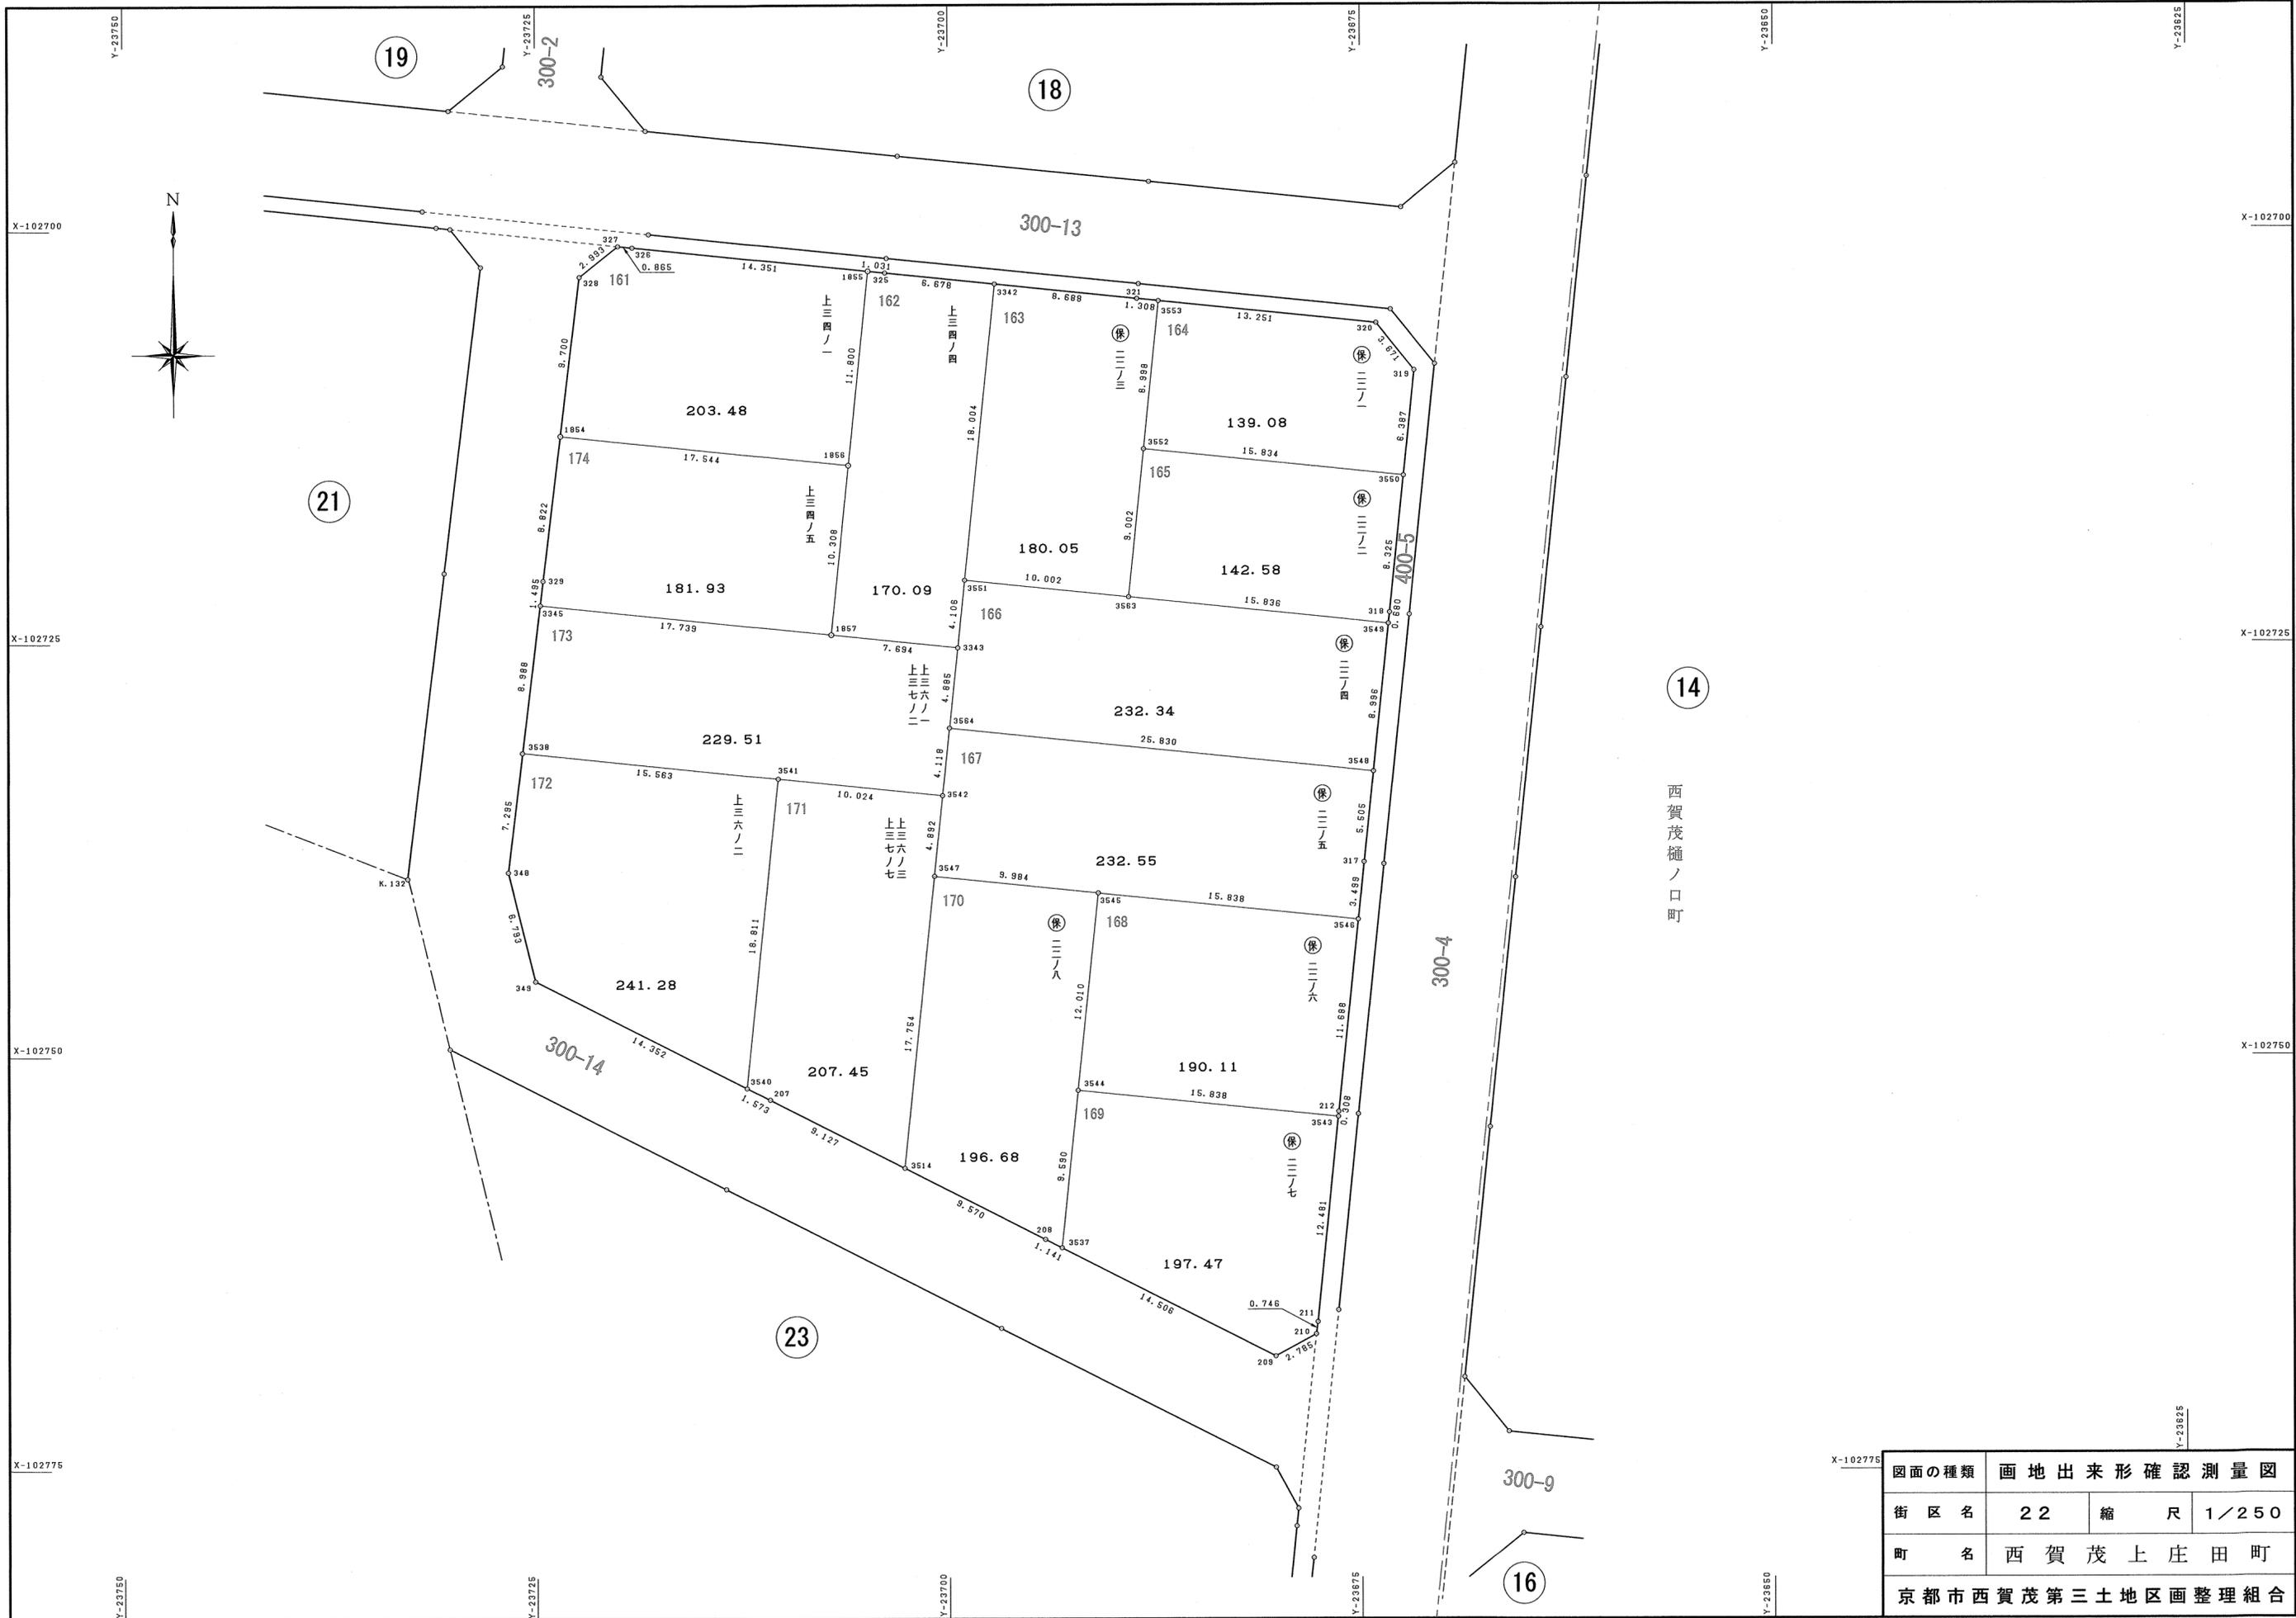

14
西賀茂樋ノ口町

図面の種類	画地出来形確認測量図		
街区名	22	縮尺	1/250
町名	西賀茂上庄田町		
京都市西賀茂第三土地区画整理組合			

161

地番 上三四ノ一			
NO	X	Y	辺長
326	-102700.993	-23719.121	
327	-102700.910	-23719.983	0.865
328	-102702.771	-23722.328	2.993
1854	-102712.401	-23723.494	9.700
1856	-102714.211	-23706.043	17.544
1855	-102702.471	-23704.846	11.800
326	-102700.993	-23719.121	14.351
面積	203.4814415		
地積	203.48 m ²		

162

地番 上三四ノ四			
NO	X	Y	辺長
1855	-102702.471	-23704.846	
1856	-102714.211	-23706.043	11.800
1857	-102724.466	-23707.089	10.308
3343	-102725.260	-23699.436	7.694
3551	-102721.173	-23699.034	4.106
3342	-102703.265	-23697.177	18.004
325	-102702.577	-23703.820	6.678
1855	-102702.471	-23704.846	1.031
面積	170.0941800		
地積	170.09 m ²		

163

地番 保二ノ三			
NO	X	Y	辺長
3342	-102703.265	-23697.177	
3551	-102721.173	-23699.034	18.004
3563	-102722.199	-23689.084	10.002
3552	-102713.245	-23688.155	9.002
3553	-102704.294	-23687.233	8.998
321	-102704.159	-23688.535	1.308
3342	-102703.265	-23697.177	8.688
面積	180.0522270		
地積	180.05 m ²		

164

地番 保二ノ一			
NO	X	Y	辺長
3553	-102704.294	-23687.233	
3552	-102713.245	-23688.155	8.998
3550	-102714.875	-23672.405	15.834
319	-102708.521	-23671.748	6.387
320	-102705.663	-23674.052	3.671
3553	-102704.294	-23687.233	13.251
面積	139.0835305		
地積	139.08 m ²		

165

地番 保二ノ二			
NO	X	Y	辺長
3552	-102713.245	-23688.155	
3563	-102722.199	-23689.084	9.002
3549	-102723.833	-23673.332	15.836
318	-102723.156	-23673.262	0.680
3550	-102714.875	-23672.405	8.325
3552	-102713.245	-23688.155	15.834
面積	142.5801925		
地積	142.58 m ²		

166

地番 保二ノ四			
NO	X	Y	辺長
3551	-102721.173	-23699.034	
3343	-102725.260	-23699.436	4.106
3564	-102730.118	-23699.951	4.885
3548	-102732.782	-23674.258	25.830
3549	-102723.833	-23673.332	8.996
3563	-102722.199	-23689.084	15.836
3551	-102721.173	-23699.034	10.002
面積	232.3409950		
地積	232.34 m ²		

167

地番 保二ノ五			
NO	X	Y	辺長
3564	-102730.118	-23699.951	
3542	-102734.216	-23700.366	4.118
3547	-102739.082	-23700.871	4.892
3545	-102740.104	-23690.939	9.984
3546	-102741.739	-23675.185	15.838
317	-102738.258	-23674.825	3.499
3548	-102732.782	-23674.258	5.505
3564	-102730.118	-23699.951	25.830
面積	232.5523870		
地積	232.55 m ²		

168

地番 保二ノ六			
NO	X	Y	辺長
3545	-102740.104	-23690.939	
3544	-102752.051	-23692.172	12.010
3543	-102753.673	-23676.417	15.838
212	-102753.366	-23676.386	0.308
3546	-102741.739	-23675.185	11.689
3545	-102740.104	-23690.939	15.838
面積	190.1195985		
地積	190.11 m ²		

169

地番 保二ノ七			
NO	X	Y	辺長
3544	-102752.051	-23692.172	
3537	-102761.590	-23693.165	9.590
209	-102768.160	-23680.232	14.506
210	-102766.830	-23677.785	2.785
211	-102766.090	-23677.689	0.746
3543	-102753.673	-23676.417	12.481
3544	-102752.051	-23692.172	15.838
面積	197.4745015		
地積	197.47 m ²		

170

地番 保二ノ八			
NO	X	Y	辺長
3547	-102739.082	-23700.871	
3514	-102756.740	-23702.716	17.754
208	-102761.073	-23694.183	9.570
3537	-102761.590	-23693.165	1.141
3544	-102752.051	-23692.172	9.590
3545	-102740.104	-23690.939	12.010
3547	-102739.082	-23700.871	9.984
面積	196.6874745		
地積	196.68 m ²		

171

地番 上三六ノ三, 上三七ノ七			
NO	X	Y	辺長
3541	-102733.182	-23710.337	
3540	-102751.895	-23712.257	18.811
207	-102752.607	-23710.854	1.573
3514	-102756.740	-23702.716	9.127
3547	-102739.082	-23700.871	17.754
3542	-102734.216	-23700.366	4.892
3541	-102733.182	-23710.337	10.024
面積	207.4579870		
地積	207.45 m ²		

172

地番 上三六ノ二			
NO	X	Y	辺長
3538	-102731.567	-23725.816	
348	-102738.809	-23726.694	7.295
349	-102745.402	-23725.057	6.793
3540	-102751.895	-23712.257	14.352
3541	-102733.182	-23710.337	18.811
3538	-102731.567	-23725.816	15.563
面積	241.2814740		
地積	241.28 m ²		


173

地番 上三六ノ一, 上三七ノ二			
NO	X	Y	辺長
3345	-102722.644	-23724.735	
3538	-102731.567	-23725.816	8.988
3541	-102733.182	-23710.337	15.563
3542	-102734.216	-23700.366	10.024
3564	-102730.118	-23699.951	4.118
3343	-102725.260	-23699.436	4.885
1857	-102724.466	-23707.089	7.694
3345	-102722.644	-23724.735	17.739
面積	229.5176400		
地積	229.51 m ²		

174

地番 上三四ノ五			
NO	X	Y	辺長
1854	-102712.401	-23723.494	
329	-102721.159	-23724.555	8.822
3345	-102722.644	-23724.735	1.495
1857	-102724.466	-23707.089	17.739
1856	-102714.211	-23706.043	10.308
1854	-102712.401	-23723.494	17.544
面積	181.9307450		
地積	181.93 m ²		

図面の種類	画地出来形確認測量図	
街区名	22	求積表
町名	西賀茂上庄田町	
京都市西賀茂第三土地区画整理組合		

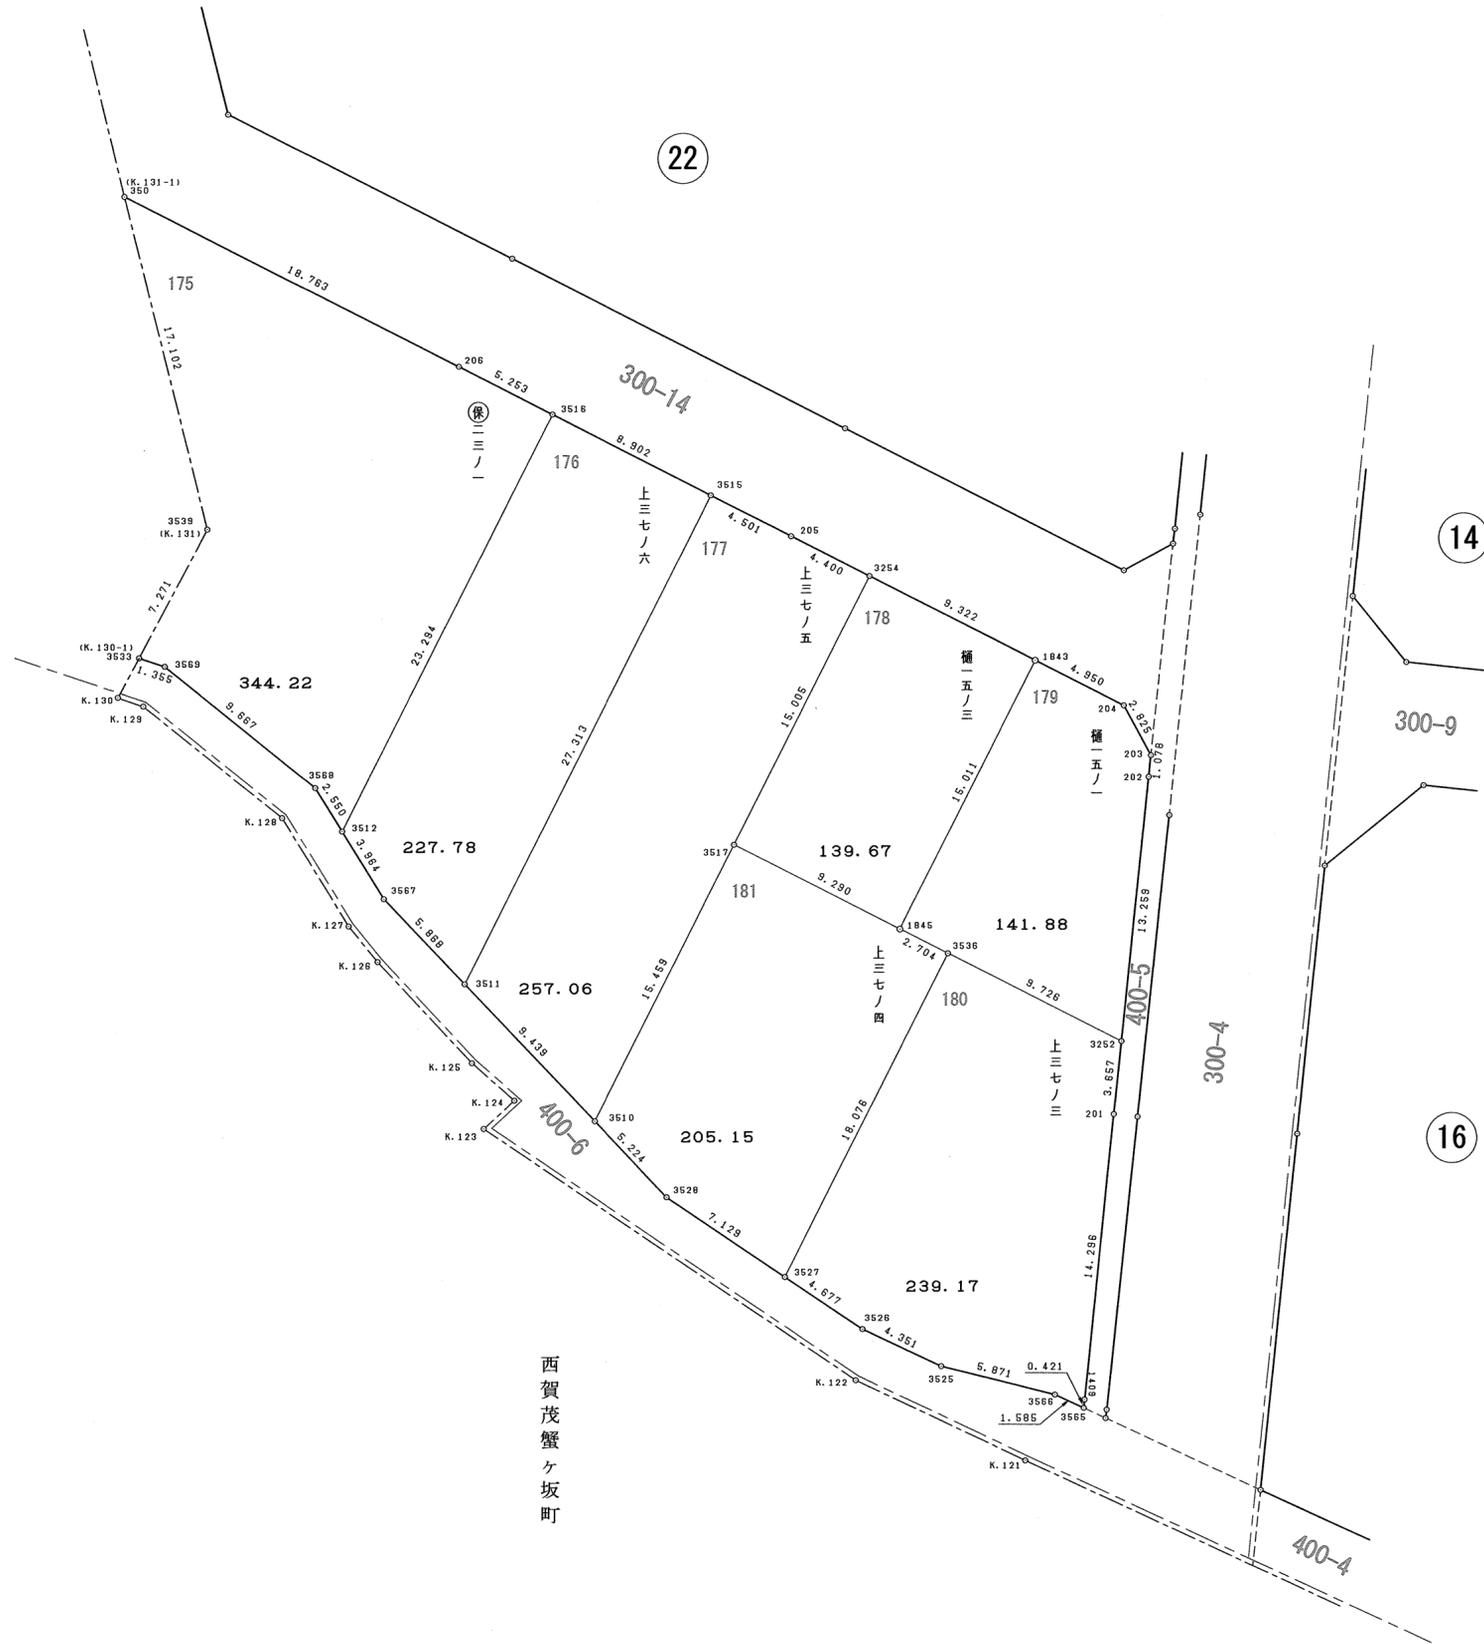

図面の種類	画地出来形確認測量図		
街区名	23	縮尺	1/250
町名	西賀茂上庄田町		
京都市西賀茂第三土地区画整理組合			

175

地番 保二三ノ一			
NO	X	Y	辺長
350	-102749.500	-23730.251	
3539	-102766.090	-23726.095	17.102
3533	-102772.503	-23729.522	7.271
3569	-102772.930	-23728.235	1.355
3568	-102778.986	-23720.700	9.667
3512	-102781.156	-23719.359	2.550
3516	-102760.374	-23708.836	23.294
206	-102757.894	-23713.520	5.253
350	-102749.500	-23730.251	18.763
面積	344.2229730		
地積	344.22 m ²		

176

地番 上三七ノ六			
NO	X	Y	辺長
3516	-102760.374	-23708.836	
3512	-102781.156	-23719.359	23.294
3567	-102784.528	-23717.275	3.964
3511	-102788.779	-23713.229	5.868
3515	-102764.407	-23700.899	27.313
3516	-102760.374	-23708.836	8.902
面積	227.7809855		
地積	227.78 m ²		

177

地番 上三七ノ五			
NO	X	Y	辺長
3515	-102764.407	-23700.899	
3511	-102788.779	-23713.229	27.313
3510	-102795.617	-23706.721	9.439
3517	-102781.824	-23699.738	15.459
3254	-102768.436	-23692.961	15.005
205	-102766.446	-23696.886	4.400
3515	-102764.407	-23700.899	4.501
面積	257.0616860		
地積	257.06 m ²		

178

地番 樋一五ノ三			
NO	X	Y	辺長
3254	-102768.436	-23692.961	
3517	-102781.824	-23699.738	15.005
1845	-102786.031	-23691.455	9.290
1843	-102772.652	-23684.646	15.011
3254	-102768.436	-23692.961	9.322
面積	139.6783860		
地積	139.67 m ²		

179

地番 樋一五ノ一			
NO	X	Y	辺長
1843	-102772.652	-23684.646	
1845	-102786.031	-23691.455	15.011
3536	-102787.250	-23689.041	2.704
3252	-102791.636	-23680.359	9.726
202	-102778.447	-23678.990	13.259
203	-102777.374	-23678.883	1.078
204	-102774.891	-23680.231	2.825
1843	-102772.652	-23684.646	4.950
面積	141.8884740		
地積	141.88 m ²		

180

地番 上三七ノ三			
NO	X	Y	辺長
3536	-102787.250	-23689.041	
3527	-102803.379	-23697.202	18.076
3526	-102805.988	-23693.320	4.677
3525	-102807.833	-23689.379	4.351
3566	-102809.249	-23683.681	5.871
3565	-102809.915	-23682.242	1.585
1409	-102809.495	-23682.202	0.421
201	-102795.274	-23680.737	14.296
3252	-102791.636	-23680.359	3.657
3536	-102787.250	-23689.041	9.726
面積	239.1724655		
地積	239.17 m ²		

181

地番 上三七ノ四			
NO	X	Y	辺長
3517	-102781.824	-23699.738	
3510	-102795.617	-23706.721	15.459
3528	-102799.401	-23703.119	5.224
3527	-102803.379	-23697.202	7.129
3536	-102787.250	-23689.041	18.076
1845	-102786.031	-23691.455	2.704
3517	-102781.824	-23699.738	9.290
面積	205.1567815		
地積	205.15 m ²		

図面の種類	画地出来形確認測量図	
街区名	23	求積表
町名	西賀茂上庄田町	
京都市西賀茂第三土地区画整理組合		