

京都市都市計画（京都国際文化観光都市建設計画）  
都市計画事業洛北第三地区土地区画整理事業

画地出来形確認測量図

1 / 2

1 街区～3 0 - 2 街区


平成25年10月25日現在

京都市洛北第三土地区画整理組合  
第一測量設計株式会社


洛北第三地区土地区画整理事業  
画地出来形確認測量図(1/2)

地番(岩倉幡枝町)	街区名
2000~2010	1
2011~2017	3-1, 3-2, 4
2018~2032	16
2033~2049	15
2050~2065	19
2066	1号公園
2067~2082	18
2083~2093	12
2094~2109	11
2110~2120	13
2121~2139	14
2140~2145	17
2146~2174	20
2175~2197	21
2198~2218	22
2219~2225	6
2226~2227	5
2228~2252	7
2253~2264	9
2265	2号公園
2266~2279	10
2280~2284	23
2285~2299	25-1, 25
2300~2350	24
2351~2370	26
2427~2449	27
2450	4号公園
2451~2458	29
2459~2476	30-1
2477~2510	30-2

# 新町界図

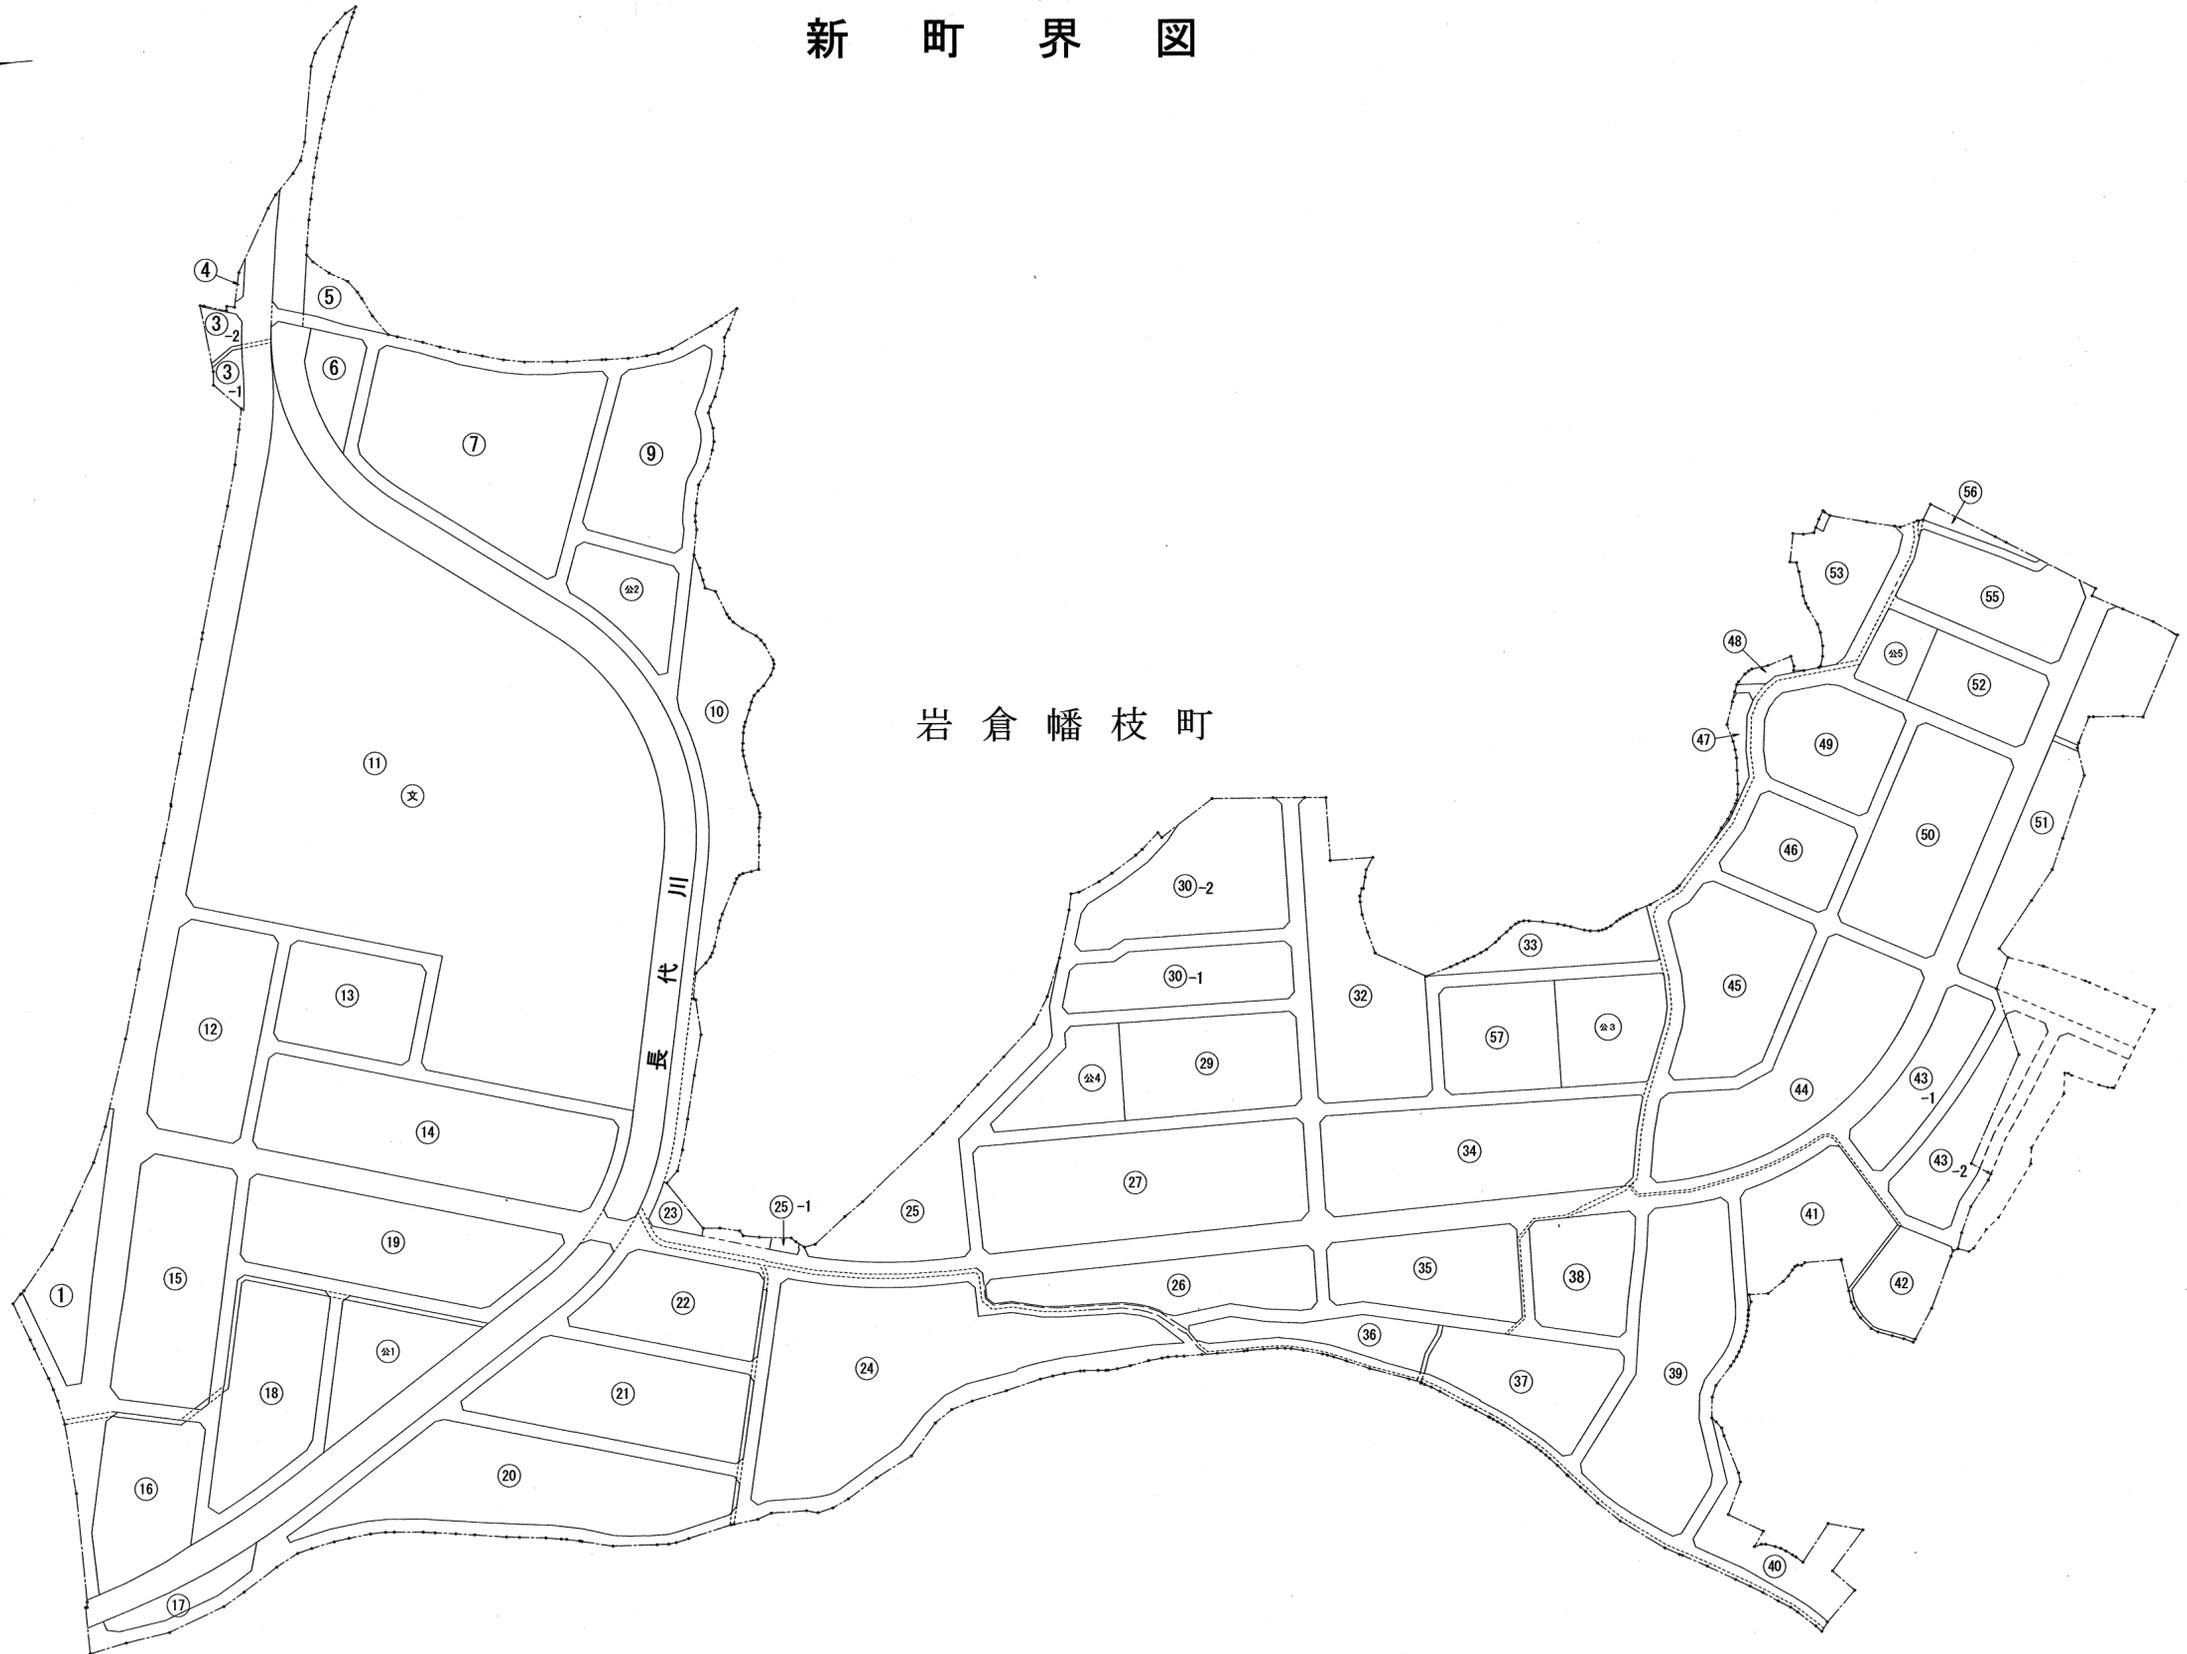

岩倉幡枝町

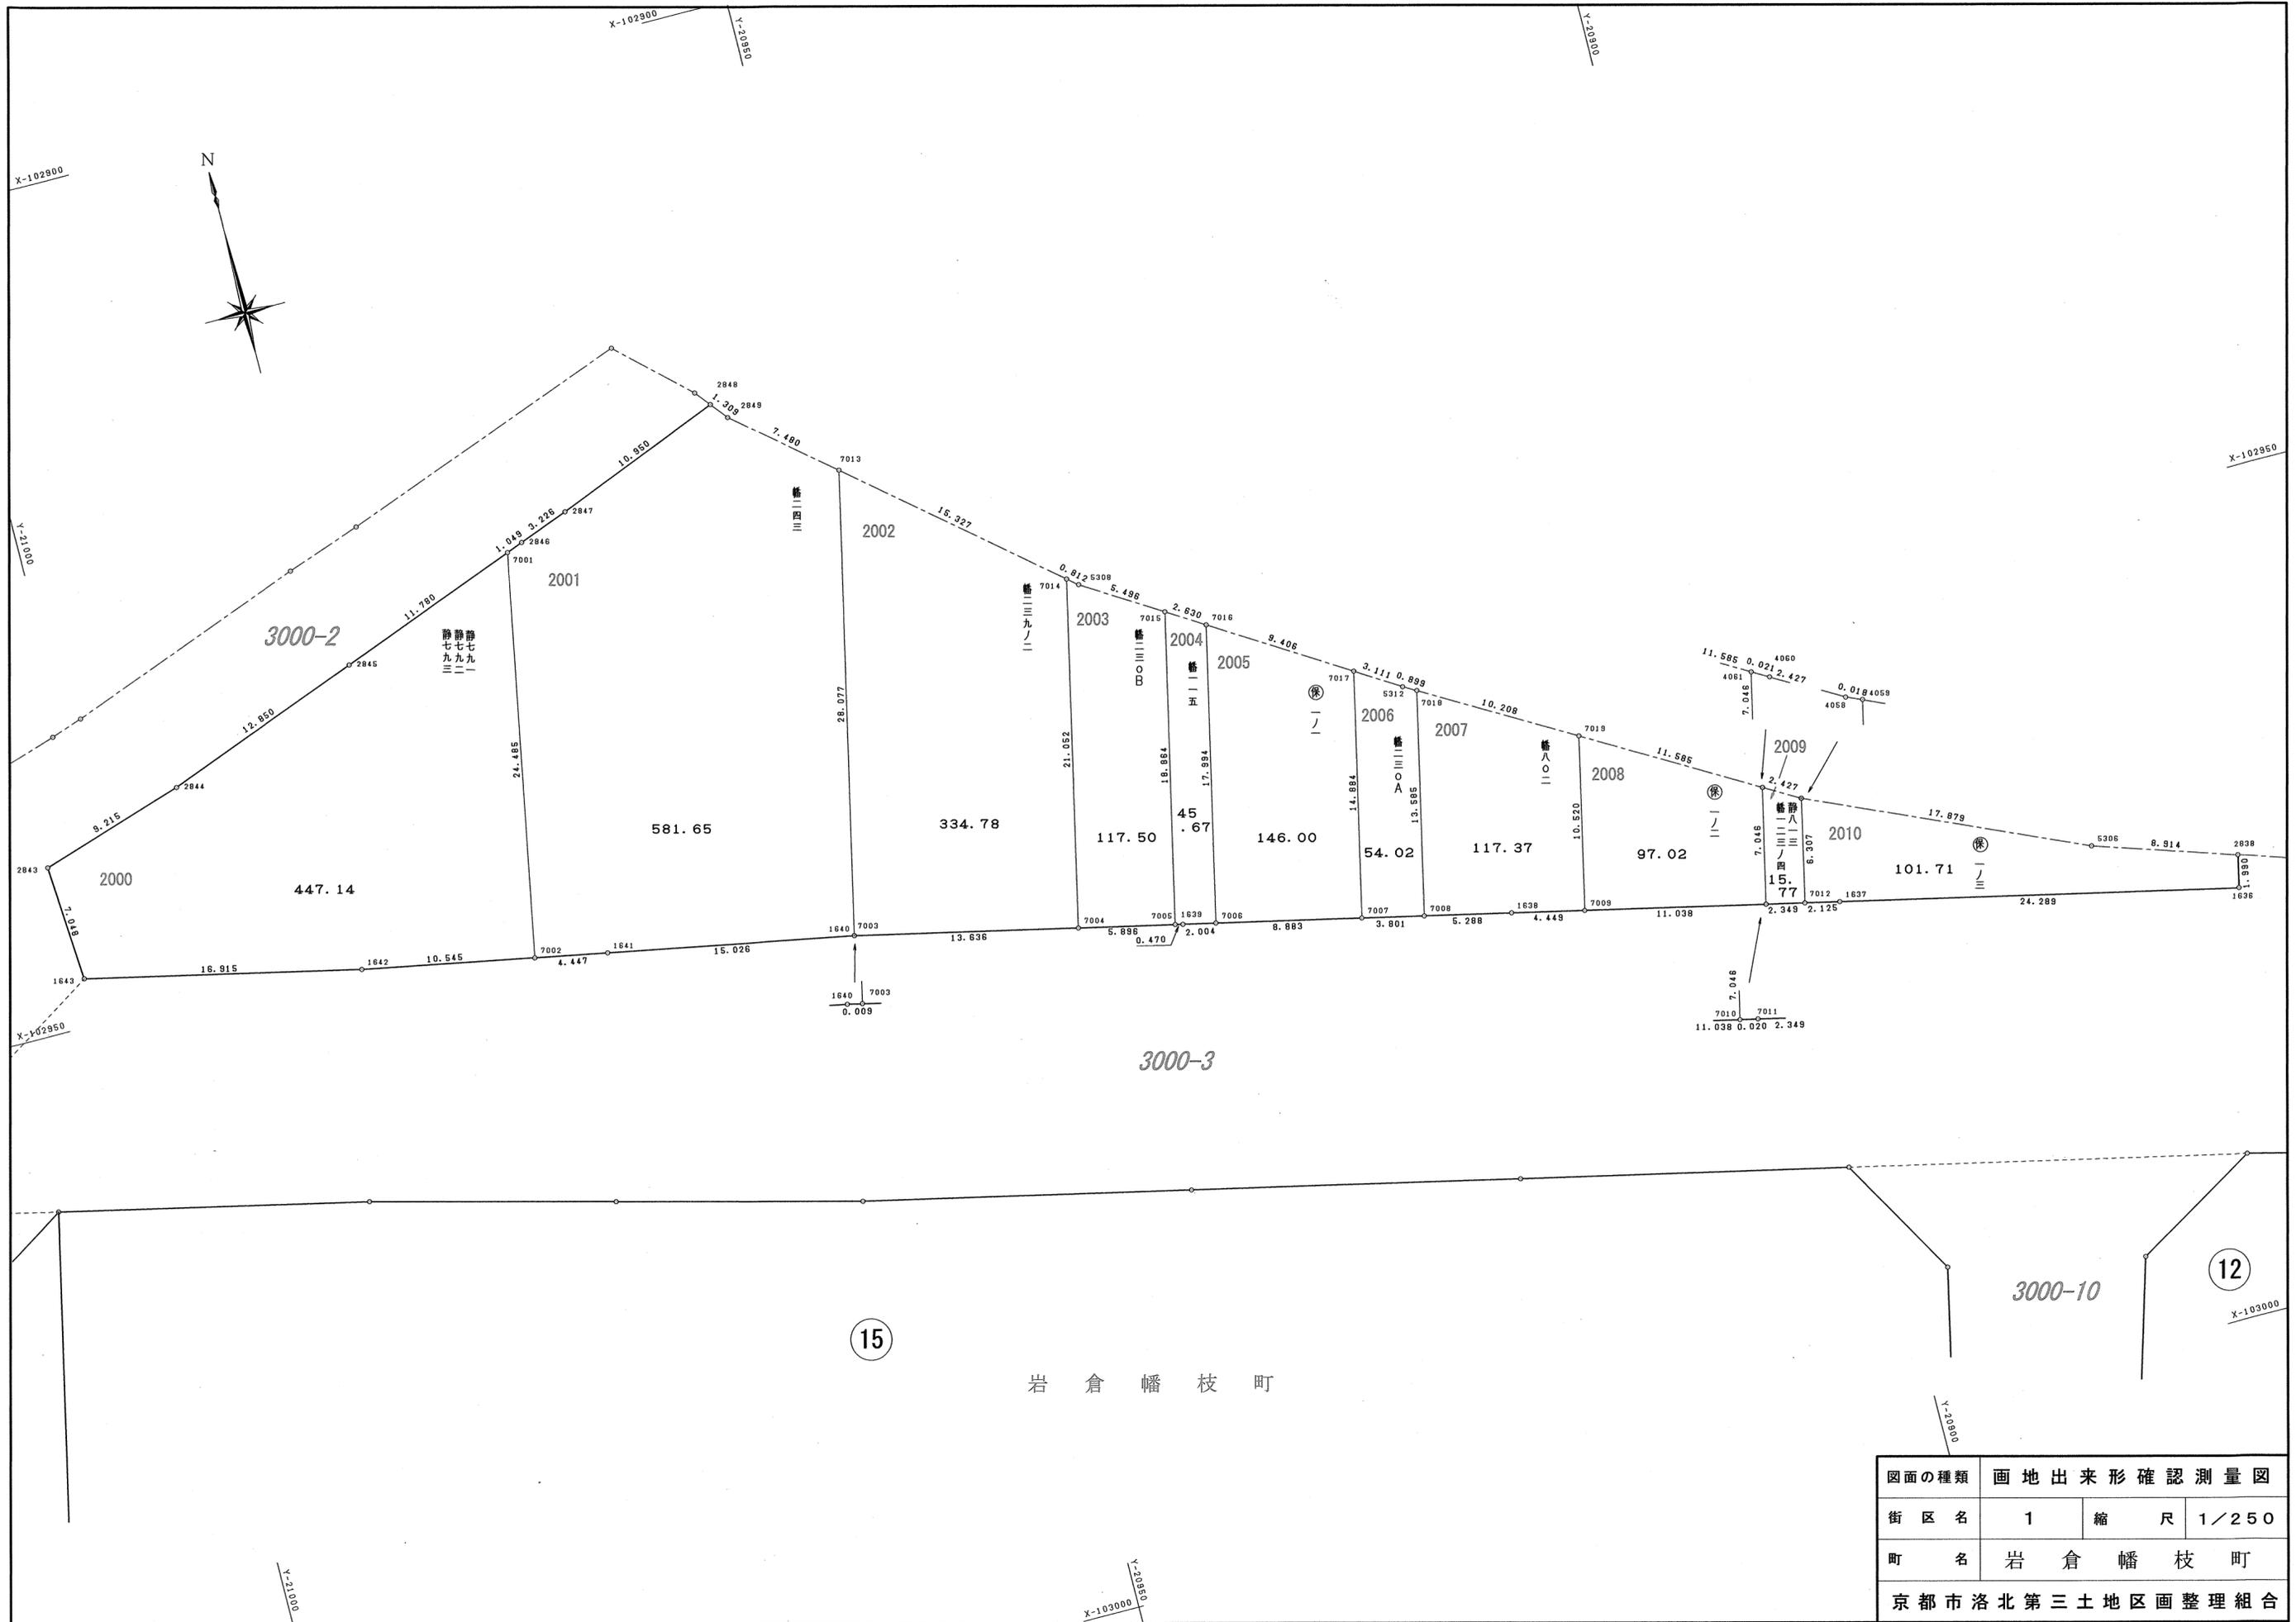

15

岩倉幡枝町

12

図面の種類	画地出来形確認測量図		
街区名	1	縮尺	1/250
町名	岩倉幡枝町		
京都市洛北第三土地区画整理組合			

## 2000

地番	静七九一 静七九二 静七九三		
N O	X	Y	辺長
2843	-102940.105	-21003.080	
1643	-102947.138	-21002.616	7.048
1642	-102950.819	-20986.106	16.915
7002	-102952.771	-20975.743	10.545
7001	-102928.706	-20971.222	24.485
2845	-102932.850	-20982.250	11.780
2844	-102937.368	-20994.280	12.850
2843	-102940.105	-21003.080	9.215
面積	447.1435005		
地積	447.14 m <sup>2</sup>		

## 2001

地番	幡二四三		
N O	X	Y	辺長
7001	-102928.706	-20971.222	
7002	-102952.771	-20975.743	24.485
1641	-102953.595	-20971.372	4.447
1640	-102956.374	-20956.605	15.026
7003	-102956.376	-20956.596	0.009
7013	-102928.975	-20950.472	28.077
2849	-102924.179	-20956.213	7.480
2848	-102923.164	-20957.041	1.309
2847	-102927.208	-20967.217	10.950
2846	-102928.337	-20970.239	3.226
7001	-102928.706	-20971.222	1.049
面積	581.6559585		
地積	581.65 m <sup>2</sup>		

## 2002

地番	幡二三九ノ二		
N O	X	Y	辺長
7013	-102928.975	-20950.472	
7003	-102956.376	-20956.596	28.077
7004	-102959.350	-20943.288	13.636
7014	-102938.802	-20938.709	21.052
7013	-102928.975	-20950.472	15.327
面積	334.7846205		
地積	334.78 m <sup>2</sup>		

## 2003

地番	幡二三〇B		
N O	X	Y	辺長
7014	-102938.802	-20938.709	
7004	-102959.350	-20943.288	21.052
7005	-102960.636	-20937.533	5.896
7015	-102942.226	-20933.418	18.864
5308	-102939.323	-20938.085	5.496
7014	-102938.802	-20938.709	0.812
面積	117.5096845		
地積	117.50 m <sup>2</sup>		

## 2004

地番	幡一一五		
N O	X	Y	辺長
7015	-102942.226	-20933.418	
7005	-102960.636	-20937.533	18.864
1639	-102960.739	-20937.074	0.470
7006	-102961.175	-20935.118	2.004
7016	-102943.616	-20931.185	17.994
7015	-102942.226	-20933.418	2.630
面積	45.6777980		
地積	45.67 m <sup>2</sup>		

## 2005

地番	保一ノ一		
N O	X	Y	辺長
7016	-102943.616	-20931.185	
7006	-102961.175	-20935.118	17.994
7007	-102963.109	-20926.448	8.883
7017	-102948.584	-20923.198	14.884
7016	-102943.616	-20931.185	9.406
面積	146.0000635		
地積	146.00 m <sup>2</sup>		

## 2006

地番	幡二三〇A		
N O	X	Y	辺長
7017	-102948.584	-20923.198	
7007	-102963.109	-20926.448	14.884
7008	-102963.937	-20922.738	3.801
7018	-102950.678	-20919.777	13.585
5312	-102950.228	-20920.556	0.899
7017	-102948.584	-20923.198	3.111
面積	54.0231735		
地積	54.02 m <sup>2</sup>		

## 2007

地番	幡八〇二		
N O	X	Y	辺長
7019	-102955.789	-20910.940	
7018	-102950.678	-20919.777	10.208
7008	-102963.937	-20922.738	13.585
1638	-102965.088	-20917.576	5.288
7009	-102966.057	-20913.233	4.449
7019	-102955.789	-20910.940	10.520
面積	117.3793845		
地積	117.37 m <sup>2</sup>		

## 2008

地番	保一ノ二		
N O	X	Y	辺長
7019	-102955.789	-20910.940	
7009	-102966.057	-20913.233	10.520
7010	-102968.463	-20902.460	11.038
4061	-102961.589	-20900.911	7.046
7019	-102955.789	-20910.940	11.585
面積	97.0288340		
地積	97.02 m <sup>2</sup>		

## 2009

地番	静八一三 幡一二三ノ四		
N O	X	Y	辺長
4061	-102961.589	-20900.911	
7010	-102968.463	-20902.460	7.046
7011	-102968.467	-20902.440	0.020
7012	-102968.979	-20900.147	2.349
4059	-102962.823	-20898.774	6.307
4058	-102962.815	-20898.791	0.018
4060	-102961.600	-20900.893	2.427
4061	-102961.589	-20900.911	0.021
面積	15.7711490		
地積	15.77 m <sup>2</sup>		

## 2010

地番	保一ノ三		
N O	X	Y	辺長
4059	-102962.823	-20898.774	
7012	-102968.979	-20900.147	6.307
1637	-102969.442	-20898.073	2.125
1636	-102974.725	-20874.365	24.289
2838	-102972.782	-20873.932	1.990
5306	-102970.019	-20882.407	8.914
4059	-102962.823	-20898.774	17.879
面積	101.7196430		
地積	101.71 m <sup>2</sup>		

図面の種類	画地出来形確認測量図	
街区名	1	求積表
町名	岩倉幡枝町	
京都市洛北第三土地区画整理組合		




X-103050

X-103050

Y-20550

Y-20500

Y-20450

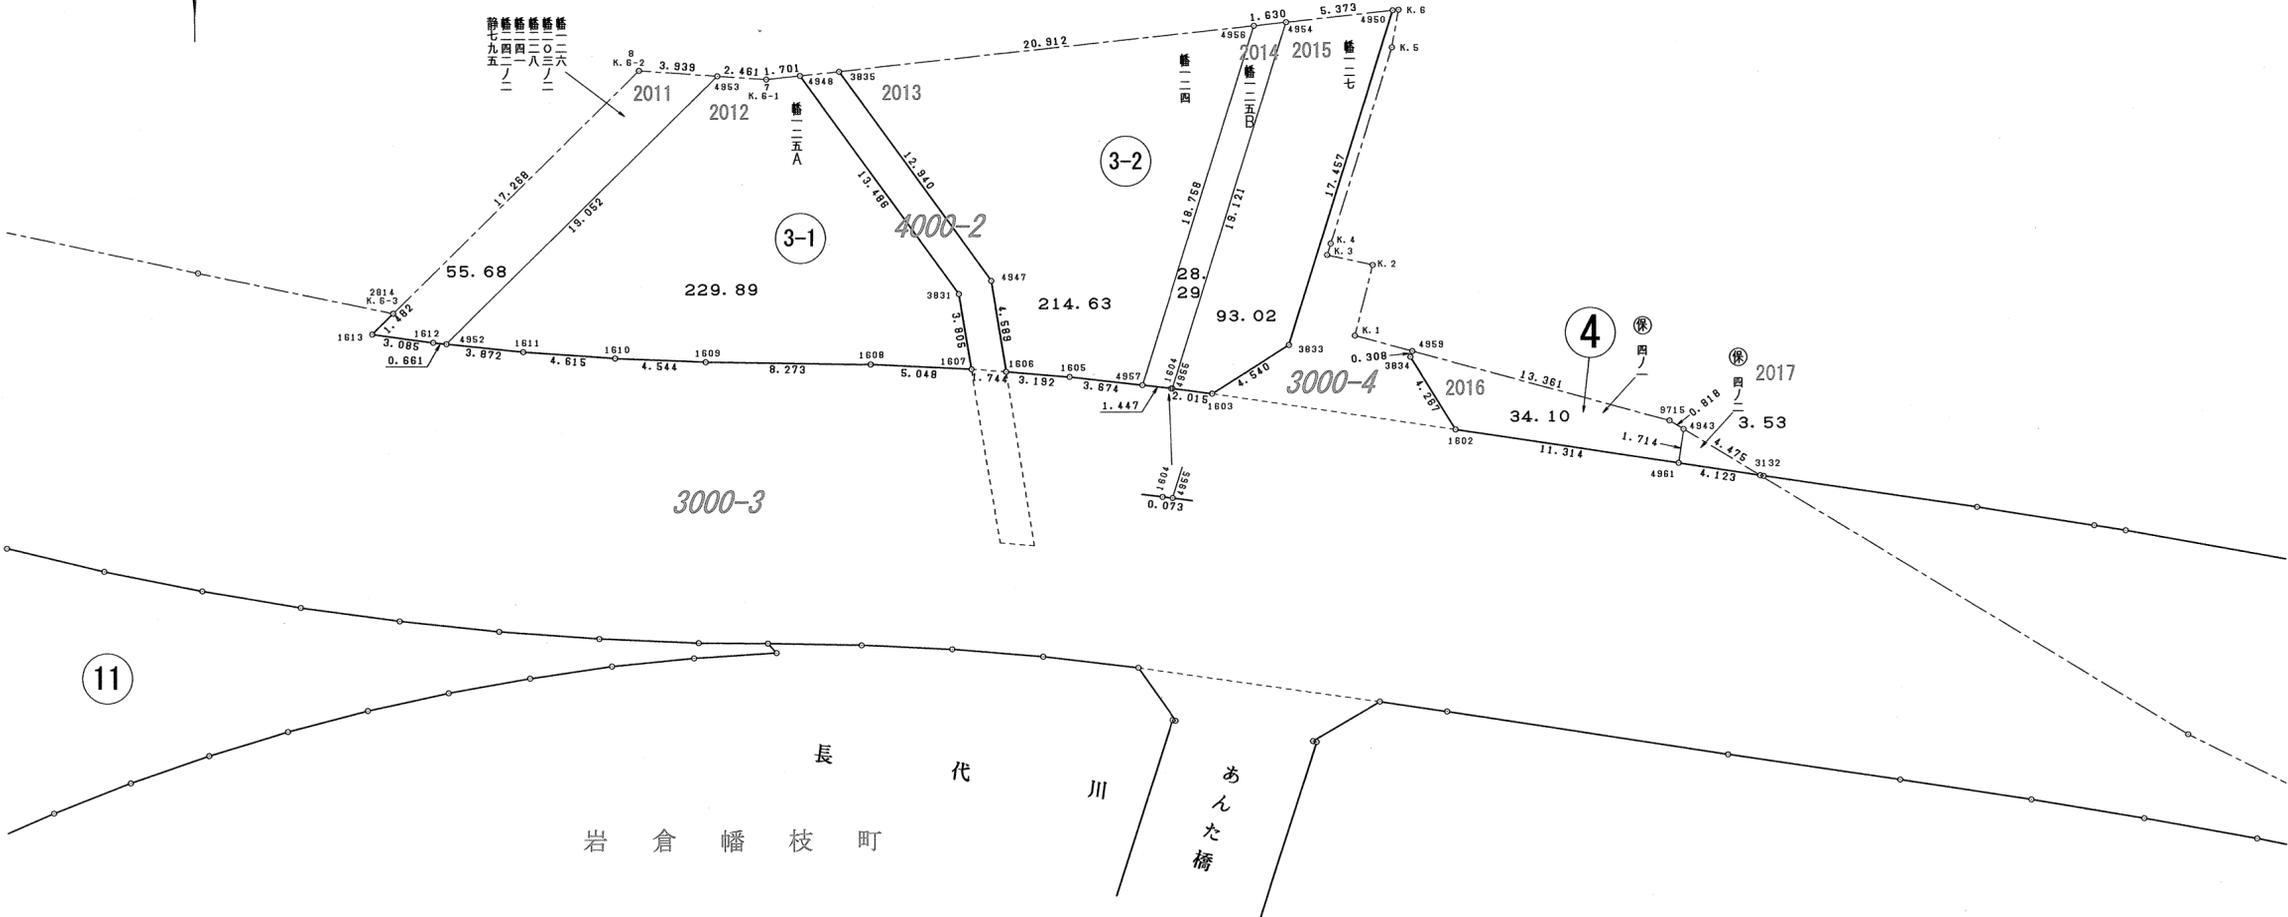

X-103100

X-103100

Y-20550

Y-20500

Y-20450

図面の種類	画地出来形確認測量図		
街区名	3-1,3-2,4	縮尺	1/250
町名	岩倉幡枝町		
京都市洛北第三土地区画整理組合			

3-1街区

2011

地番	幡一二六 幡二〇三ノ二 幡二二八 幡二四一 幡二四二ノ二 静七九五		
N O	X	Y	辺長
1613	-103067.321	-20550.311	
1612	-103067.736	-20547.254	3.085
4952	-103067.805	-20546.596	0.661
4953	-103054.476	-20532.982	19.052
8	-103054.203	-20536.912	3.939
2814	-103066.284	-20549.251	17.268
1613	-103067.321	-20550.311	1.482
面積	55.6849490		
地積	55.68 m <sup>2</sup>		

2012

地番	幡一二五A		
N O	X	Y	辺長
4952	-103067.805	-20546.596	
1611	-103068.210	-20542.745	3.872
1610	-103068.539	-20538.141	4.615
1609	-103068.727	-20533.600	4.544
1608	-103068.865	-20525.328	8.273
1607	-103069.131	-20520.287	5.048
3831	-103065.376	-20520.906	3.805
4948	-103054.466	-20528.834	13.486
7	-103054.646	-20530.526	1.701
4953	-103054.476	-20532.982	2.461
4952	-103067.805	-20546.596	19.052
面積	229.8940240		
地積	229.89 m <sup>2</sup>		

3-2街区

2013

地番	幡一二四		
N O	X	Y	辺長
4958	-103052.051	-20506.087	
3835	-103054.259	-20526.883	20.912
4947	-103064.727	-20519.276	12.940
1606	-103069.258	-20518.547	4.589
1605	-103069.528	-20515.366	3.192
4957	-103069.945	-20511.715	3.674
4956	-103052.051	-20506.087	18.758
面積	214.6332420		
地積	214.63 m <sup>2</sup>		

2014

地番	幡一二五B		
N O	X	Y	辺長
4955	-103070.119	-20510.204	
4954	-103051.879	-20504.466	19.121
4956	-103052.051	-20506.087	1.630
4957	-103069.945	-20511.715	18.758
1604	-103070.109	-20510.277	1.447
4955	-103070.119	-20510.204	0.073
面積	28.2974010		
地積	28.29 m <sup>2</sup>		

2015

地番	幡一二七		
N O	X	Y	辺長
4950	-103051.312	-20499.123	
4954	-103051.879	-20504.466	5.373
4955	-103070.119	-20510.204	19.121
1603	-103070.382	-20508.206	2.015
3833	-103067.965	-20504.362	4.540
4950	-103051.312	-20499.123	17.457
面積	93.0225160		
地積	93.02 m <sup>2</sup>		

4 街区

2016

地番	保四ノ一		
N O	X	Y	辺長
4959	-103068.289	-20498.182	
3834	-103068.584	-20498.273	0.308
1602	-103072.210	-20496.022	4.267
4961	-103073.917	-20484.837	11.314
4943	-103072.221	-20484.589	1.714
9715	-103071.797	-20485.289	0.818
4959	-103068.289	-20498.182	13.361
面積	34.1015860		
地積	34.10 m <sup>2</sup>		

2017

地番	保四ノ二		
N O	X	Y	辺長
4943	-103072.221	-20484.589	
4961	-103073.917	-20484.837	1.714
3132	-103074.539	-20480.761	4.123
4943	-103072.221	-20484.589	4.475
面積	3.5335760		
地積	3.53 m <sup>2</sup>		

図面の種類	画地出来形確認測量図	
街区名	3-1,3-2,4	求積表
町名	岩倉幡枝町	
京都市洛北第三土地区画整理組合		



3000-3

あんた橋

長代川

6

3000-19

452.51

橋七ノ一A

岩倉幡枝町

3000-23

7

228.44

2227

2226

図面の種類	画地出来形確認測量図		
街区名	5	縮尺	1/250
町名	岩倉幡枝町		
京都市洛北第三土地区画整理組合			

2226

地番	幡七七ノ一A		
N O	X	Y	辺長
3545	-103089.961	-20507.213	
3544	-103105.931	-20509.011	6.234
3543	-103118.734	-20514.187	13.809
6830	-103118.844	-20513.240	0.953
6829	-103120.105	-20504.173	9.154
6828	-103120.558	-20501.088	3.118
7778	-103121.737	-20493.453	7.725
6825	-103113.857	-20489.073	9.015
6826	-103106.693	-20483.112	9.319
6827	-103104.028	-20479.557	4.443
3545	-103089.961	-20507.213	27.953
面積	452.5192070		
地積	452.51 m <sup>2</sup>		

2227

地番	幡七九		
N O	X	Y	辺長
3543	-103118.734	-20514.187	
3542	-103139.276	-20520.792	21.577
6820	-103132.602	-20511.294	11.608
6821	-103128.294	-20502.552	9.745
6822	-103126.544	-20499.391	3.613
6823	-103122.372	-20493.806	6.971
7778	-103121.737	-20493.453	0.726
6828	-103120.558	-20501.088	7.725
6829	-103120.105	-20504.173	3.118
6830	-103118.844	-20513.240	9.154
3543	-103118.734	-20514.187	0.953
面積	228.4493260		
地積	228.44 m <sup>2</sup>		

図面の種類	画地出来形確認測量図	
街区名	5	求積表
町名	岩倉幡枝町	
京都市洛北第三土地区画整理組合		



X-103100

X-103100

X-103150

X-103150

Y-20600


Y-20650

Y-20600

Y-20600

Y-20650

Y-20600

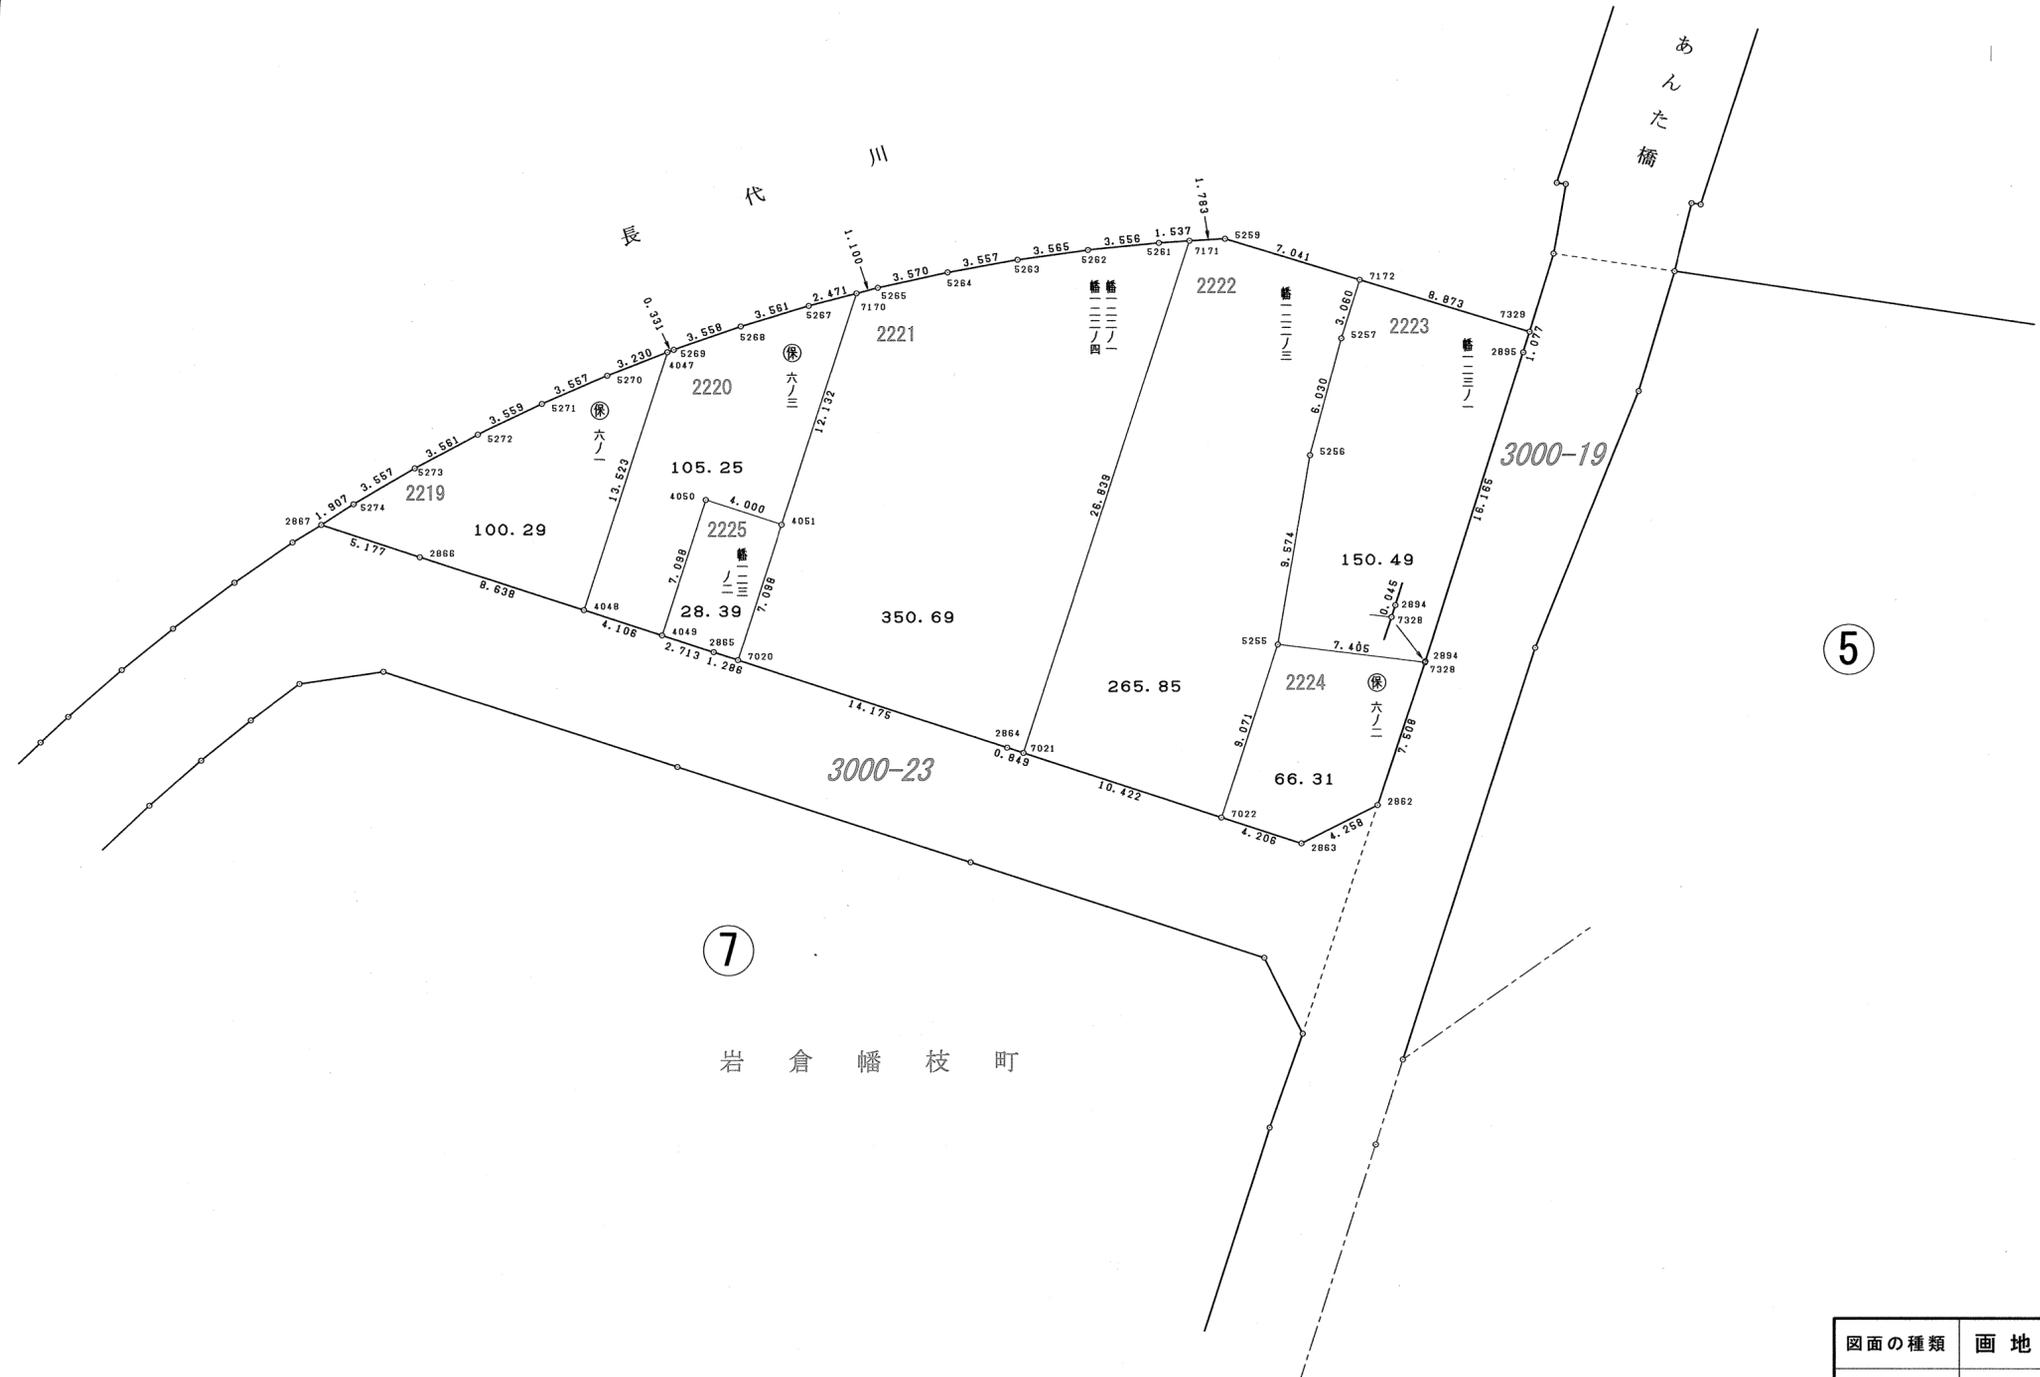

5

7

岩倉幡枝町

図面の種類	画地出来形確認測量図		
街区名	6	縮尺	1/250
町名	岩倉幡枝町		
京都市洛北第三土地区画整理組合			

2219

地番 保六ノ一			
NO	X	Y	辺長
4047	-103103.997	-20557.608	
5270	-103105.169	-20560.618	3.230
5271	-103106.575	-20563.886	3.557
5272	-103108.106	-20567.099	3.559
5273	-103109.774	-20570.246	3.561
5274	-103111.567	-20573.319	3.557
2867	-103112.602	-20574.921	1.907
2866	-103114.203	-20569.997	5.177
4048	-103116.862	-20561.778	8.638
4047	-103103.997	-20557.608	13.523
面積	100.2929945		
地積	100.29 m <sup>2</sup>		

2220

地番 保六ノ三			
NO	X	Y	辺長
7170	-103101.064	-20548.135	
5267	-103101.685	-20550.527	2.471
5268	-103102.715	-20553.936	3.561
5269	-103103.877	-20557.299	3.558
4047	-103103.997	-20557.608	0.331
4048	-103116.862	-20561.778	13.523
4049	-103118.126	-20557.871	4.106
4050	-103111.373	-20555.682	7.098
4051	-103112.605	-20551.876	4.000
7170	-103101.064	-20548.135	12.132
面積	105.2541120		
地積	105.25 m <sup>2</sup>		

2221

地番 幡一二二ノ一 幡一二二ノ四			
NO	X	Y	辺長
7170	-103101.064	-20548.135	
4051	-103112.605	-20551.876	12.132
7020	-103119.358	-20554.065	7.098
2864	-103123.728	-20540.580	14.175
7021	-103123.990	-20539.772	0.849
7171	-103098.465	-20531.475	26.839
5261	-103098.563	-20533.009	1.537
5262	-103098.914	-20536.548	3.556
5263	-103099.399	-20540.080	3.565
5264	-103100.031	-20543.581	3.557
5265	-103100.788	-20547.070	3.570
7170	-103101.064	-20548.135	1.100
面積	350.6946905		
地積	350.69 m <sup>2</sup>		

2222

地番 幡一二二ノ三			
NO	X	Y	辺長
7171	-103098.465	-20531.475	
7021	-103123.990	-20539.772	26.839
7022	-103127.207	-20529.858	10.422
5255	-103118.584	-20527.041	9.071
5256	-103109.145	-20525.434	9.574
5257	-103103.318	-20523.879	6.030
7172	-103100.399	-20522.958	3.060
5259	-103098.351	-20529.695	7.041
7171	-103098.465	-20531.475	1.783
面積	265.8518825		
地積	265.85 m <sup>2</sup>		

2223

地番 幡一二三ノ一			
NO	X	Y	辺長
7172	-103100.399	-20522.958	
5257	-103103.318	-20523.879	3.060
5256	-103109.145	-20525.434	6.030
5255	-103118.584	-20527.041	9.574
7328	-103119.462	-20519.688	7.405
2894	-103119.419	-20519.674	0.045
2895	-103104.010	-20514.786	16.165
7329	-103102.980	-20514.468	1.077
7172	-103100.399	-20522.958	8.873
面積	150.4944045		
地積	150.49 m <sup>2</sup>		

2224

地番 保六ノ二			
NO	X	Y	辺長
5255	-103118.584	-20527.041	
7022	-103127.207	-20529.858	9.071
2863	-103128.505	-20525.857	4.206
2862	-103126.588	-20522.054	4.259
7328	-103119.462	-20519.688	7.508
5255	-103118.584	-20527.041	7.405
面積	66.3156030		
地積	66.31 m <sup>2</sup>		

2225

地番 幡一二三ノ二			
NO	X	Y	辺長
4049	-103118.126	-20557.871	
2865	-103118.961	-20555.289	2.713
7020	-103119.358	-20554.065	1.286
4051	-103112.605	-20551.876	7.098
4050	-103111.373	-20555.682	4.000
4049	-103118.126	-20557.871	7.098
面積	28.3972590		
地積	28.39 m <sup>2</sup>		

図面の種類	画地出来形確認測量図	
街区名	6	求積表
町名	岩倉幡枝町	
京都市洛北第三土地区画整理組合		



岩倉幡枝町

代  
川

3000-23

3000-19

6

5



図面の種類	画地出来形確認測量図		
街区名	7 1/2	縮尺	1/250
町名	岩倉幡枝町		
京都市洛北第三土地区画整理組合			



2228

Table with 4 columns: NO, X, Y, 辺長. Data for parcel 2228, 幡八四ノ三.

2229

Table with 4 columns: NO, X, Y, 辺長. Data for parcel 2229, 幡八四ノ二.

2230

Table with 4 columns: NO, X, Y, 辺長. Data for parcel 2230, 幡八四ノ一 幡二一四ノ二.

2231

Table with 4 columns: NO, X, Y, 辺長. Data for parcel 2231, 保七ノ三.

2232

Table with 4 columns: NO, X, Y, 辺長. Data for parcel 2232, 保七ノ四.

2233

Table with 4 columns: NO, X, Y, 辺長. Data for parcel 2233, 保七ノ五.

2234

Table with 4 columns: NO, X, Y, 辺長. Data for parcel 2234, 幡八一ノ四.

2235

Table with 4 columns: NO, X, Y, 辺長. Data for parcel 2235, 幡八一ノ二 幡八一ノ三.

2236

Table with 4 columns: NO, X, Y, 辺長. Data for parcel 2236, 幡八一ノ五 幡八一ノ六.

2237

Table with 4 columns: NO, X, Y, 辺長. Data for parcel 2237, 幡八一ノ八.

2238

Table with 4 columns: NO, X, Y, 辺長. Data for parcel 2238, 幡八一ノ一〇.

2239

Table with 4 columns: NO, X, Y, 辺長. Data for parcel 2239, 幡八一ノ七.

2240

Table with 4 columns: NO, X, Y, 辺長. Data for parcel 2240, 幡八一ノ九.

2241

Table with 4 columns: NO, X, Y, 辺長. Data for parcel 2241, 幡八一ノ一.

2242

Table with 4 columns: NO, X, Y, 辺長. Data for parcel 2242, 幡八二.

2243

Table with 4 columns: NO, X, Y, 辺長. Data for parcel 2243, 保七ノ一.

2244

Table with 4 columns: NO, X, Y, 辺長. Data for parcel 2244, 保七ノ六.

2245

Table with 4 columns: NO, X, Y, 辺長. Data for parcel 2245, 幡八三A.

2246

Table with 4 columns: NO, X, Y, 辺長. Data for parcel 2246, 幡二二九.

2247

Table with 4 columns: NO, X, Y, 辺長. Data for parcel 2247, 保七ノ二.

2248

Table with 4 columns: NO, X, Y, 辺長. Data for parcel 2248, 幡一一七.

2249

Table with 4 columns: NO, X, Y, 辺長. Data for parcel 2249, 幡一一三ノ一.

2250

Table with 4 columns: NO, X, Y, 辺長. Data for parcel 2250, 幡一一九.

2251

Table with 4 columns: NO, X, Y, 辺長. Data for parcel 2251, 幡八三B.

2252

Table with 4 columns: NO, X, Y, 辺長. Data for parcel 2252, 幡八四ノ四.

Summary table with 2 columns: 図面の種類, 画地出来形確認測量図. Includes 街区名 (7) and 町名 (岩倉幡枝町).



岩倉幡枝町

代  
川

7

公2

9

10

3000-20

3000-23

3000-21

3000-22

二号公園

1. 898. 52

2265

18. 102

3117

3118

2995

2994

3052

2989

15. 793

3050

3077

15. 801

3051

3076

2991

15. 786

2993

2992

4. 516

15. 785

14. 382

14. 351

3084

2. 115

3085

4. 769

3083

4. 871

3089

4. 823

3070

4. 816

3071

4. 842

3072

4. 812

3073

4. 804

3074

4. 839

3075

4. 817

3076

4. 820

3077

4. 838

3078

4. 816

3051

4. 817

3052

4. 730

2989

15. 793

15. 801

15. 786

4. 516

2993

2992

15. 785

14. 382

14. 351

図面の種類	画地出来形確認測量図		
街区名	2号公園	縮尺	1/250
町名	岩倉幡枝町		
京都市洛北第三土地区画整理組合			


2265

地番	二号公園		
N O	X	Y	辺長
3084	-103214.148	-20650.862	
3085	-103216.123	-20652.359	2.478
3069	-103219.820	-20655.215	4.671
3070	-103223.382	-20658.162	4.623
3071	-103226.836	-20661.223	4.615
3072	-103230.177	-20664.446	4.642
3073	-103233.395	-20667.751	4.612
3074	-103236.497	-20671.154	4.604
3075	-103239.521	-20674.671	4.638
3076	-103242.387	-20678.292	4.617
3077	-103245.137	-20682.017	4.630
3050	-103247.753	-20685.787	4.588
3051	-103250.152	-20689.614	4.516
3052	-103252.583	-20693.773	4.817
2989	-103256.774	-20693.198	4.230
2990	-103260.045	-20677.747	15.793
2991	-103263.316	-20662.288	15.801
2992	-103266.583	-20646.844	15.785
2993	-103264.401	-20642.890	4.516
2994	-103249.877	-20637.518	15.485
2995	-103236.404	-20632.542	14.362
3118	-103222.946	-20627.556	14.351
3117	-103219.078	-20629.307	4.245
3083	-103212.804	-20646.287	18.102
3084	-103214.148	-20650.862	4.768
面積	1898.5206135		
地積	1898.52 m <sup>2</sup>		

図面の種類	画地出来形確認測量図	
街区名	2号公園	求積表
町名	岩倉幡枝町	
京都市洛北第三土地区画整理組合		

7

岩倉幡枝町

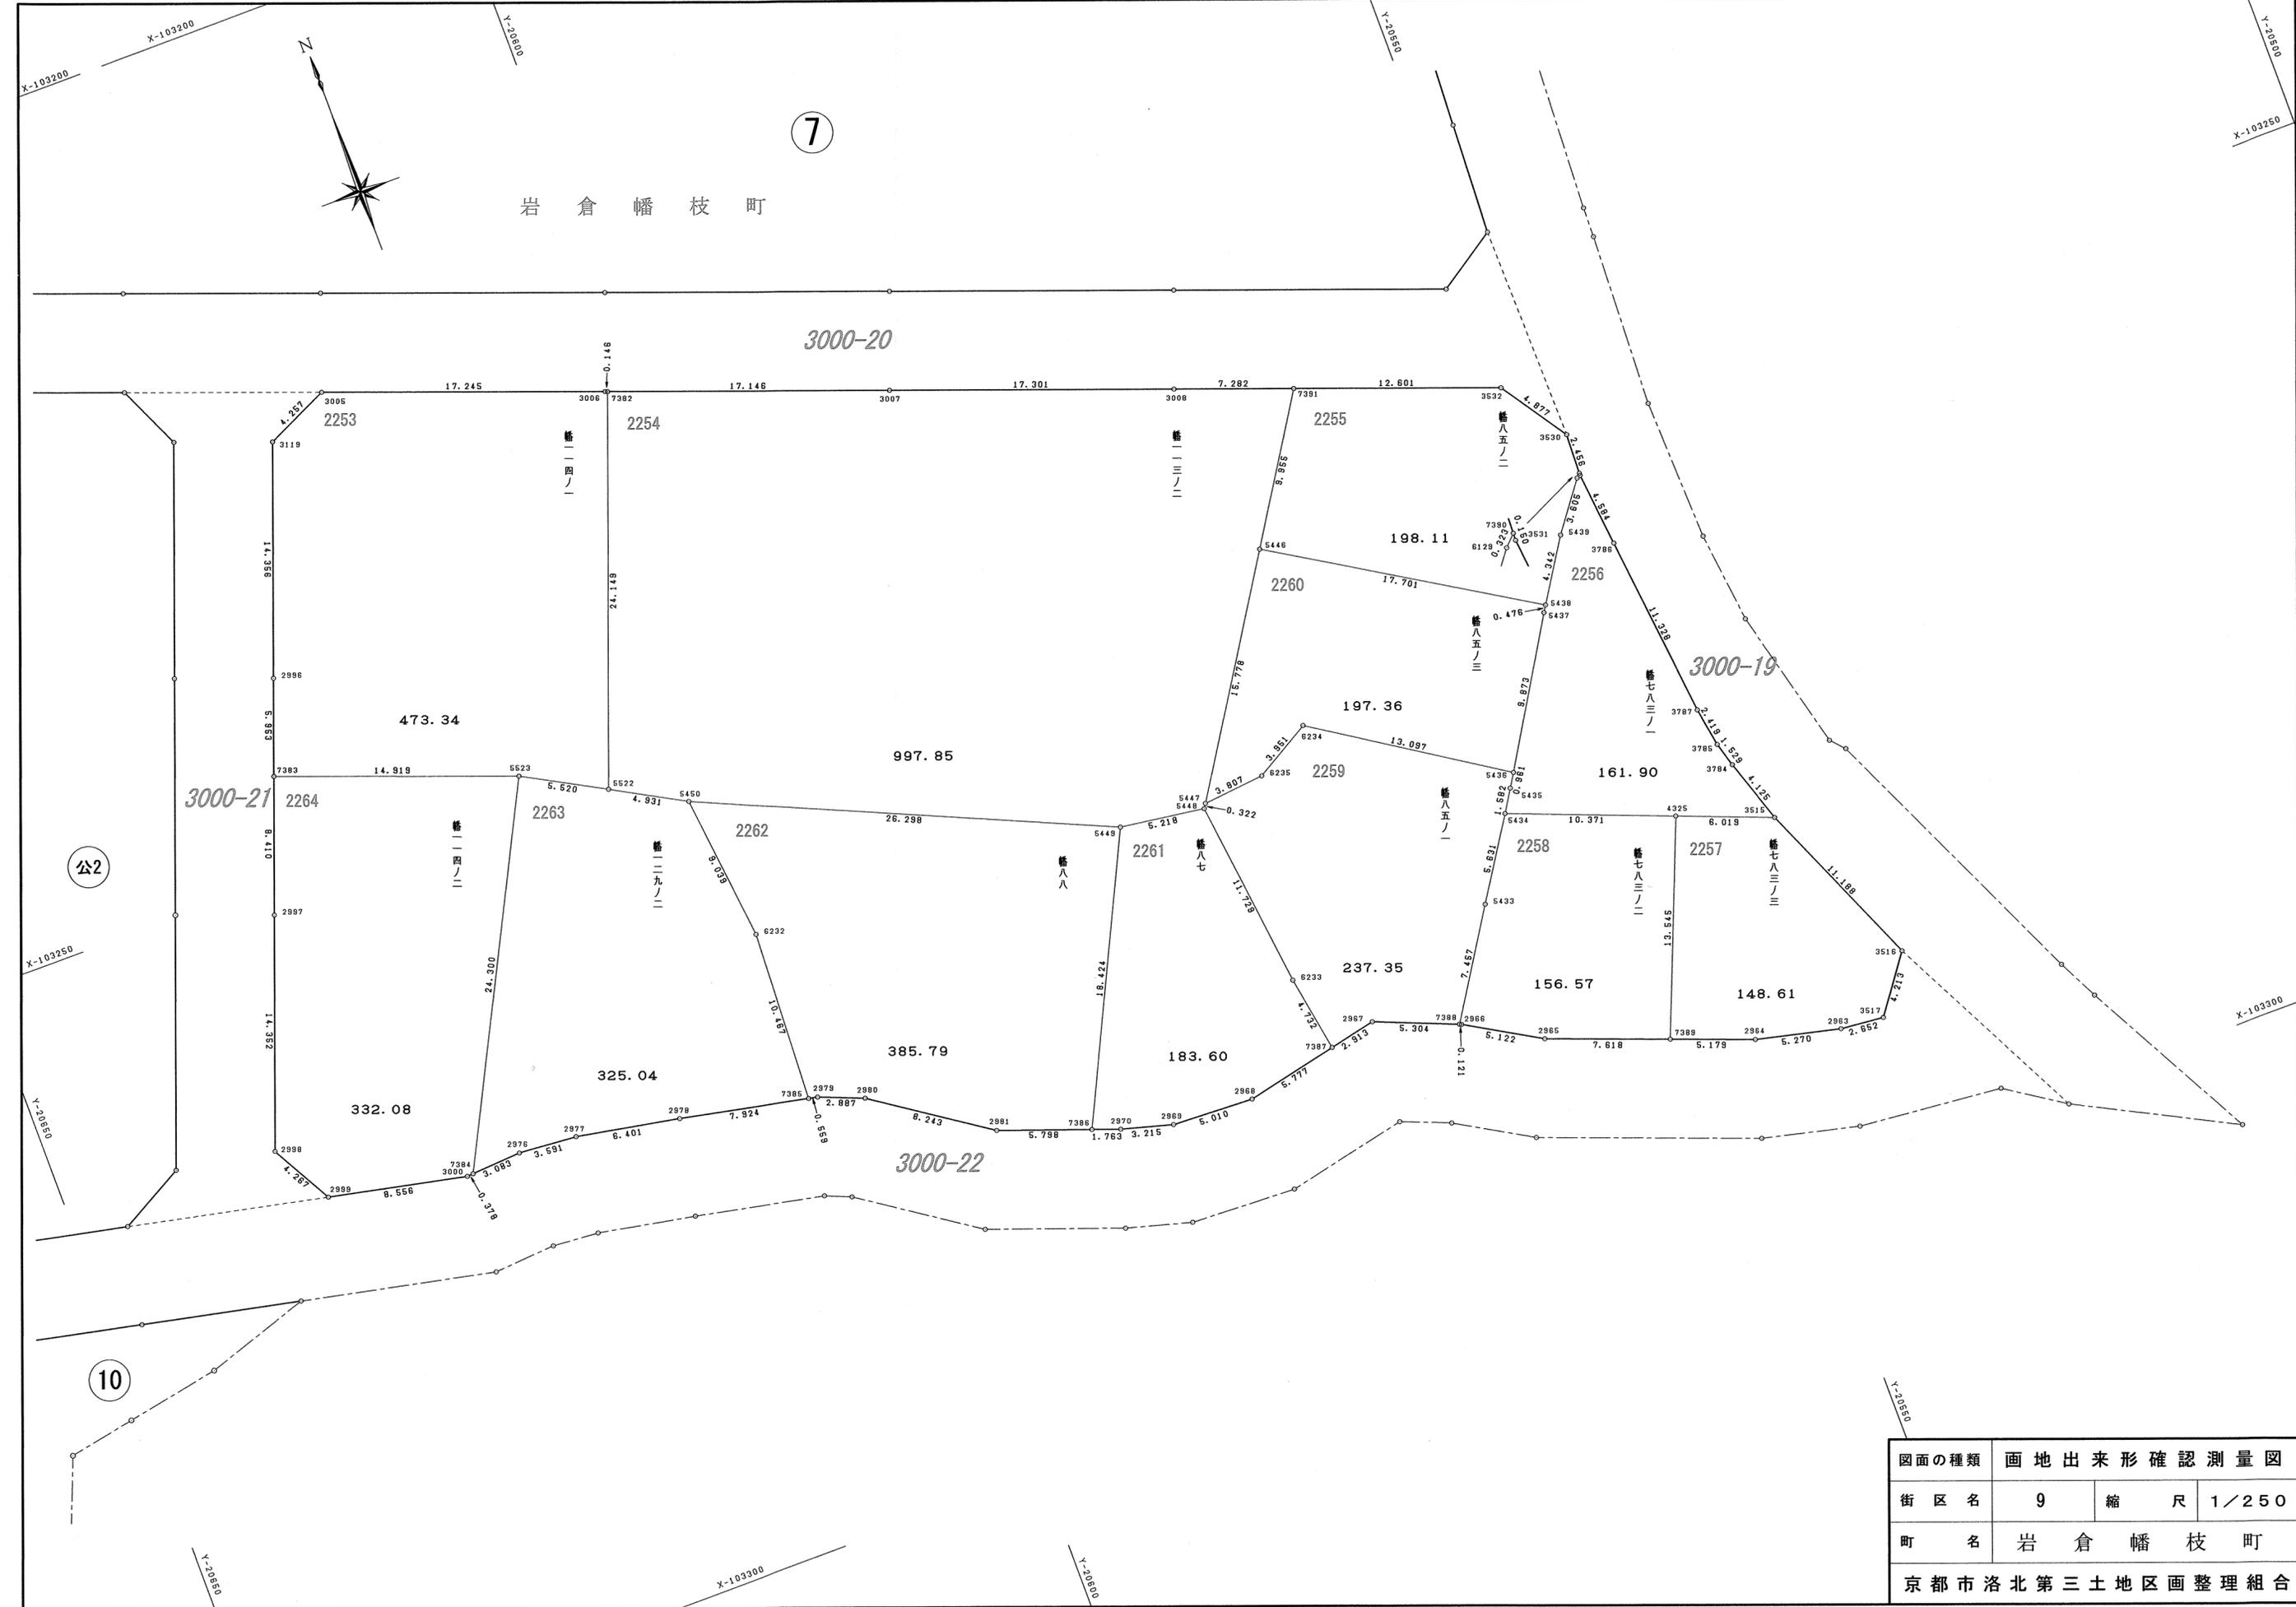

公2

10

図面の種類	画地出来形確認測量図		
街区名	9	縮尺	1/250
町名	岩倉幡枝町		
京都市洛北第三土地区画整理組合			

2253

地番 幡一四ノ一			
NO	X	Y	辺長
3005	-103223.241	-20618.056	
3119	-103225.019	-20621.925	4.257
2996	-103238.488	-20626.893	14.356
7383	-103244.073	-20628.956	5.953
5523	-103249.258	-20614.966	14.919
5522	-103251.922	-20610.131	5.520
7382	-103229.275	-20601.745	24.149
3006	-103229.224	-20601.882	0.146
3005	-103223.241	-20618.056	17.245
面積	473.3483500		
地積	473.34 m <sup>2</sup>		

2254

地番 幡一三ノ二			
NO	X	Y	辺長
7382	-103229.275	-20601.745	
5522	-103251.922	-20610.131	24.149
5450	-103254.313	-20605.818	4.931
5449	-103264.986	-20581.783	26.298
5448	-103265.722	-20576.617	5.218
5447	-103265.455	-20576.437	0.322
5446	-103252.148	-20567.958	15.778
7391	-103243.753	-20562.607	9.955
3008	-103241.226	-20569.437	7.282
3007	-103235.222	-20585.663	17.301
7382	-103229.275	-20601.745	17.146
面積	997.8519410		
地積	997.85 m <sup>2</sup>		

2255

地番 幡八五ノ二			
NO	X	Y	辺長
7391	-103243.753	-20562.607	
5446	-103252.148	-20567.958	9.955
5438	-103261.403	-20552.869	17.701
5439	-103257.741	-20550.536	4.342
6129	-103254.853	-20548.377	3.605
7390	-103254.621	-20548.151	0.323
3530	-103252.166	-20548.056	2.456
3532	-103248.126	-20550.789	4.877
7391	-103243.753	-20562.607	12.601
面積	198.1100085		
地積	198.11 m <sup>2</sup>		

2256

地番 幡七八三ノ一			
NO	X	Y	辺長
3515	-103278.359	-20544.315	
3784	-103274.448	-20545.627	4.125
3785	-103272.979	-20546.052	1.529
3787	-103270.593	-20546.454	2.419
3786	-103259.330	-20547.675	11.328
3531	-103254.771	-20548.157	4.584
7390	-103254.621	-20548.151	0.150
6129	-103254.853	-20548.377	0.323
5439	-103257.741	-20550.536	3.605
5438	-103261.403	-20552.869	4.342
5437	-103261.807	-20553.121	0.476
5436	-103270.245	-20558.248	9.873
5435	-103271.063	-20558.754	0.961
5434	-103272.408	-20559.588	1.582
4325	-103276.174	-20549.924	10.371
3515	-103278.359	-20544.315	6.019
面積	161.9049105		
地積	161.90 m <sup>2</sup>		

2257

地番 幡七八三ノ三			
NO	X	Y	辺長
7389	-103288.738	-20554.986	
2964	-103290.568	-20550.141	5.179
2963	-103291.787	-20545.013	5.270
3517	-103292.043	-20542.373	2.652
3516	-103288.637	-20539.893	4.213
3515	-103278.359	-20544.315	11.188
4325	-103276.174	-20549.924	6.019
7389	-103288.738	-20554.986	13.545
面積	148.6175785		
地積	148.61 m <sup>2</sup>		

2258

地番 幡七八三ノ二			
NO	X	Y	辺長
7389	-103288.738	-20554.986	
4325	-103276.174	-20549.924	13.545
5434	-103272.408	-20559.588	10.371
5433	-103277.139	-20562.643	5.631
7388	-103283.426	-20566.654	7.457
2966	-103283.472	-20566.542	0.121
2965	-103286.045	-20562.113	5.122
7389	-103288.738	-20554.986	7.618
面積	156.5788030		
地積	156.57 m <sup>2</sup>		

2259

地番 幡八五ノ一			
NO	X	Y	辺長
7388	-103283.426	-20566.654	
5433	-103277.139	-20562.643	7.457
5434	-103272.408	-20559.588	5.631
5435	-103271.063	-20558.754	1.582
5436	-103270.245	-20558.248	0.961
6234	-103263.104	-20569.228	13.097
6235	-103265.084	-20572.648	3.951
5447	-103265.455	-20576.437	3.807
5448	-103265.722	-20576.617	0.322
6233	-103277.367	-20575.211	11.729
7387	-103282.032	-20574.414	4.732
2967	-103281.421	-20571.565	2.913
7388	-103283.426	-20566.654	5.304
面積	237.3576010		
地積	237.35 m <sup>2</sup>		

2260

地番 幡八五ノ三			
NO	X	Y	辺長
5436	-103270.245	-20558.248	
5437	-103261.807	-20553.121	9.873
5438	-103261.403	-20552.869	0.476
5446	-103252.148	-20567.958	17.701
5447	-103265.455	-20576.437	15.778
6235	-103265.084	-20572.648	3.807
6234	-103263.104	-20569.228	3.951
5436	-103270.245	-20558.248	13.097
面積	197.3699495		
地積	197.36 m <sup>2</sup>		

2261

地番 幡八七			
NO	X	Y	辺長
7387	-103282.032	-20574.414	
6233	-103277.367	-20575.211	4.732
5448	-103265.722	-20576.617	11.729
5449	-103264.986	-20581.783	5.218
7386	-103281.564	-20589.823	18.424
2970	-103282.164	-20588.165	1.763
2969	-103283.031	-20585.069	3.215
2968	-103283.245	-20580.063	5.010
7387	-103282.032	-20574.414	5.777
面積	183.6042540		
地積	183.60 m <sup>2</sup>		

2262

地番 幡八八			
NO	X	Y	辺長
7386	-103281.564	-20589.823	
5449	-103264.986	-20581.783	18.424
5450	-103254.313	-20605.818	26.298
6232	-103263.297	-20604.818	9.039
7385	-103273.753	-20605.315	10.467
2979	-103273.867	-20604.767	0.559
2980	-103274.956	-20602.093	2.887
2981	-103279.591	-20595.276	8.243
7386	-103281.564	-20589.823	5.798
面積	385.7901305		
地積	385.79 m <sup>2</sup>		

2263

地番 幡一二九ノ二			
NO	X	Y	辺長
7385	-103273.753	-20605.315	
6232	-103263.297	-20604.818	10.467
5450	-103254.313	-20605.818	9.039
5522	-103251.922	-20610.131	4.931
5523	-103249.258	-20614.966	5.520
7384	-103270.896	-20626.026	24.300
2976	-103270.696	-20622.949	3.083
2977	-103270.979	-20619.369	3.591
2978	-103272.147	-20613.075	6.401
7385	-103273.753	-20605.315	7.924
面積	325.0489415		
地積	325.04 m <sup>2</sup>		

2264


地番 幡一一四ノ二			
NO	X	Y	辺長
7383	-103244.073	-20628.956	
2997	-103251.963	-20631.870	8.410
2998	-103265.425	-20636.847	14.352
2999	-103269.156	-20634.776	4.267
3000	-103270.921	-20626.404	8.556
7384	-103270.896	-20626.026	0.378
5523	-103249.258	-20614.966	24.300
7383	-103244.073	-20628.956	14.919
面積	332.0811455		
地積	332.08 m <sup>2</sup>		

図面の種類	画地出来形確認測量図	
街区名	9	求積表
町名	岩倉幡枝町	
京都市洛北第三土地区画整理組合		



岩倉幡枝町

長代川

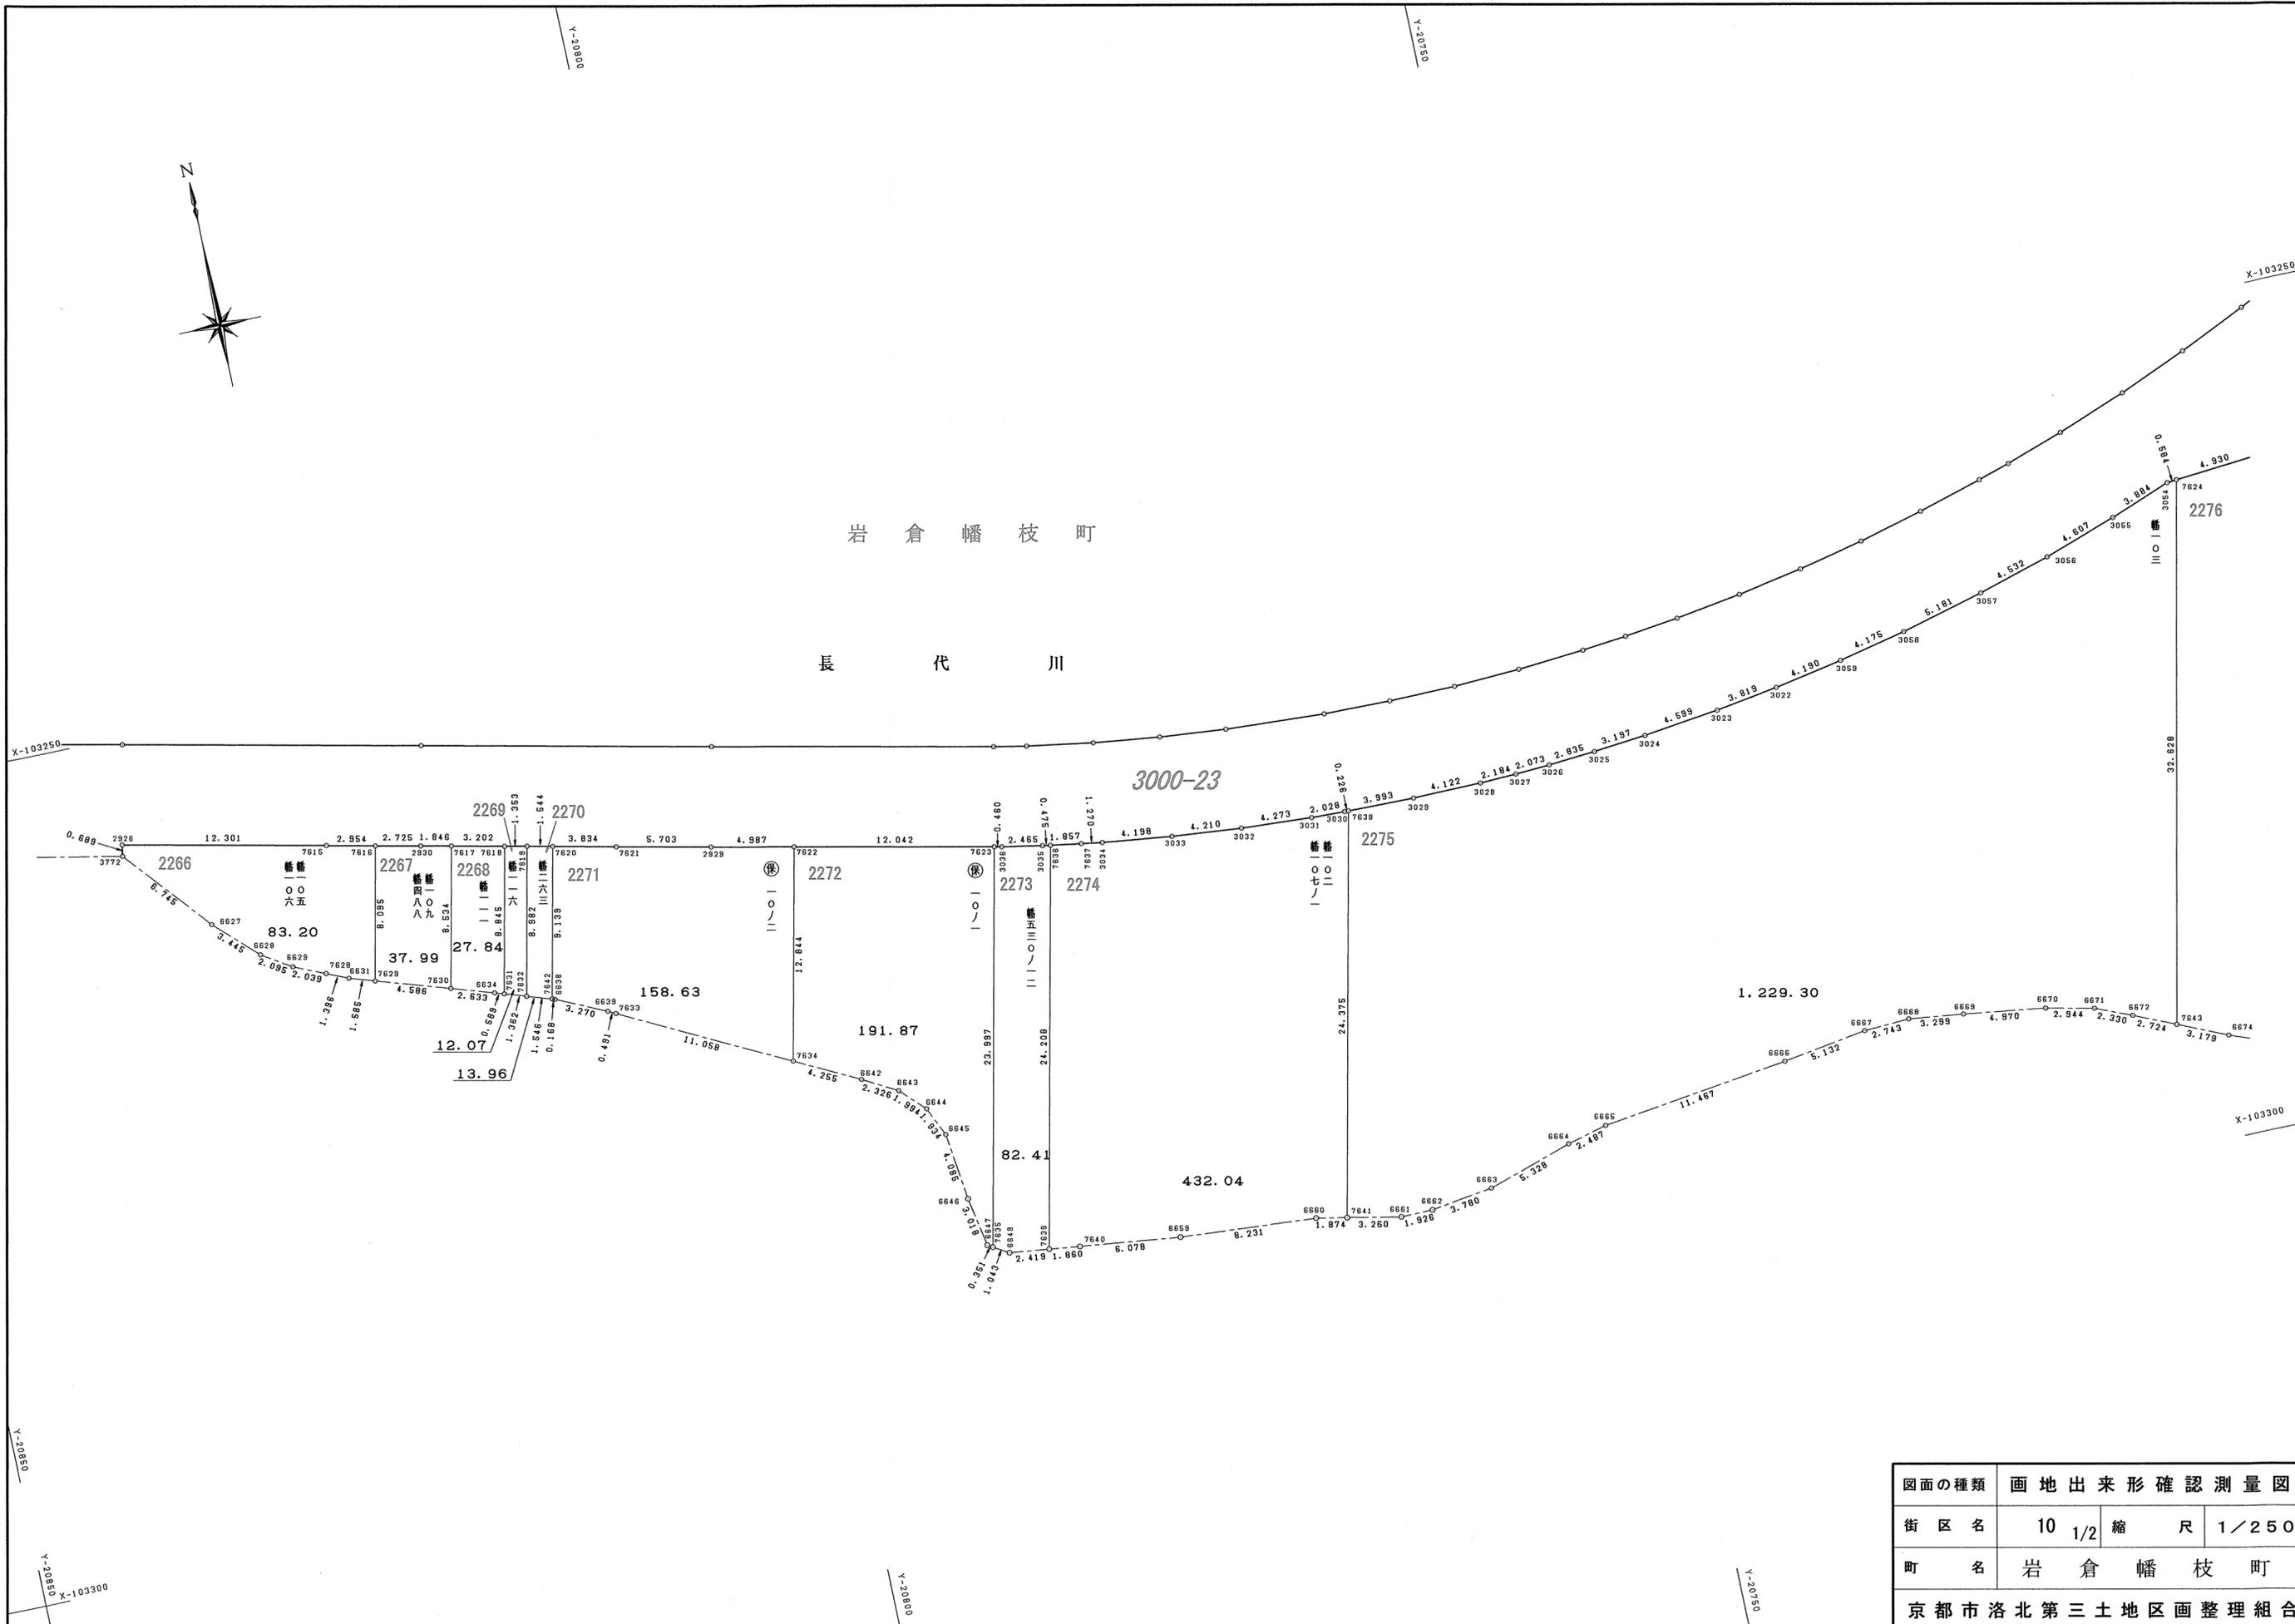

図面の種類	画地出来形確認測量図		
街区名	10 1/2	縮尺	1/250
町名	岩倉幡枝町		
京都市洛北第三土地区画整理組合			



岩倉幡枝町

長代川

公2

9

3000-21

3000-22

3000-23

X-103250

X-103250

Y-20750


X-103300

X-103300

Y-20750

Y-20700

Y-20550

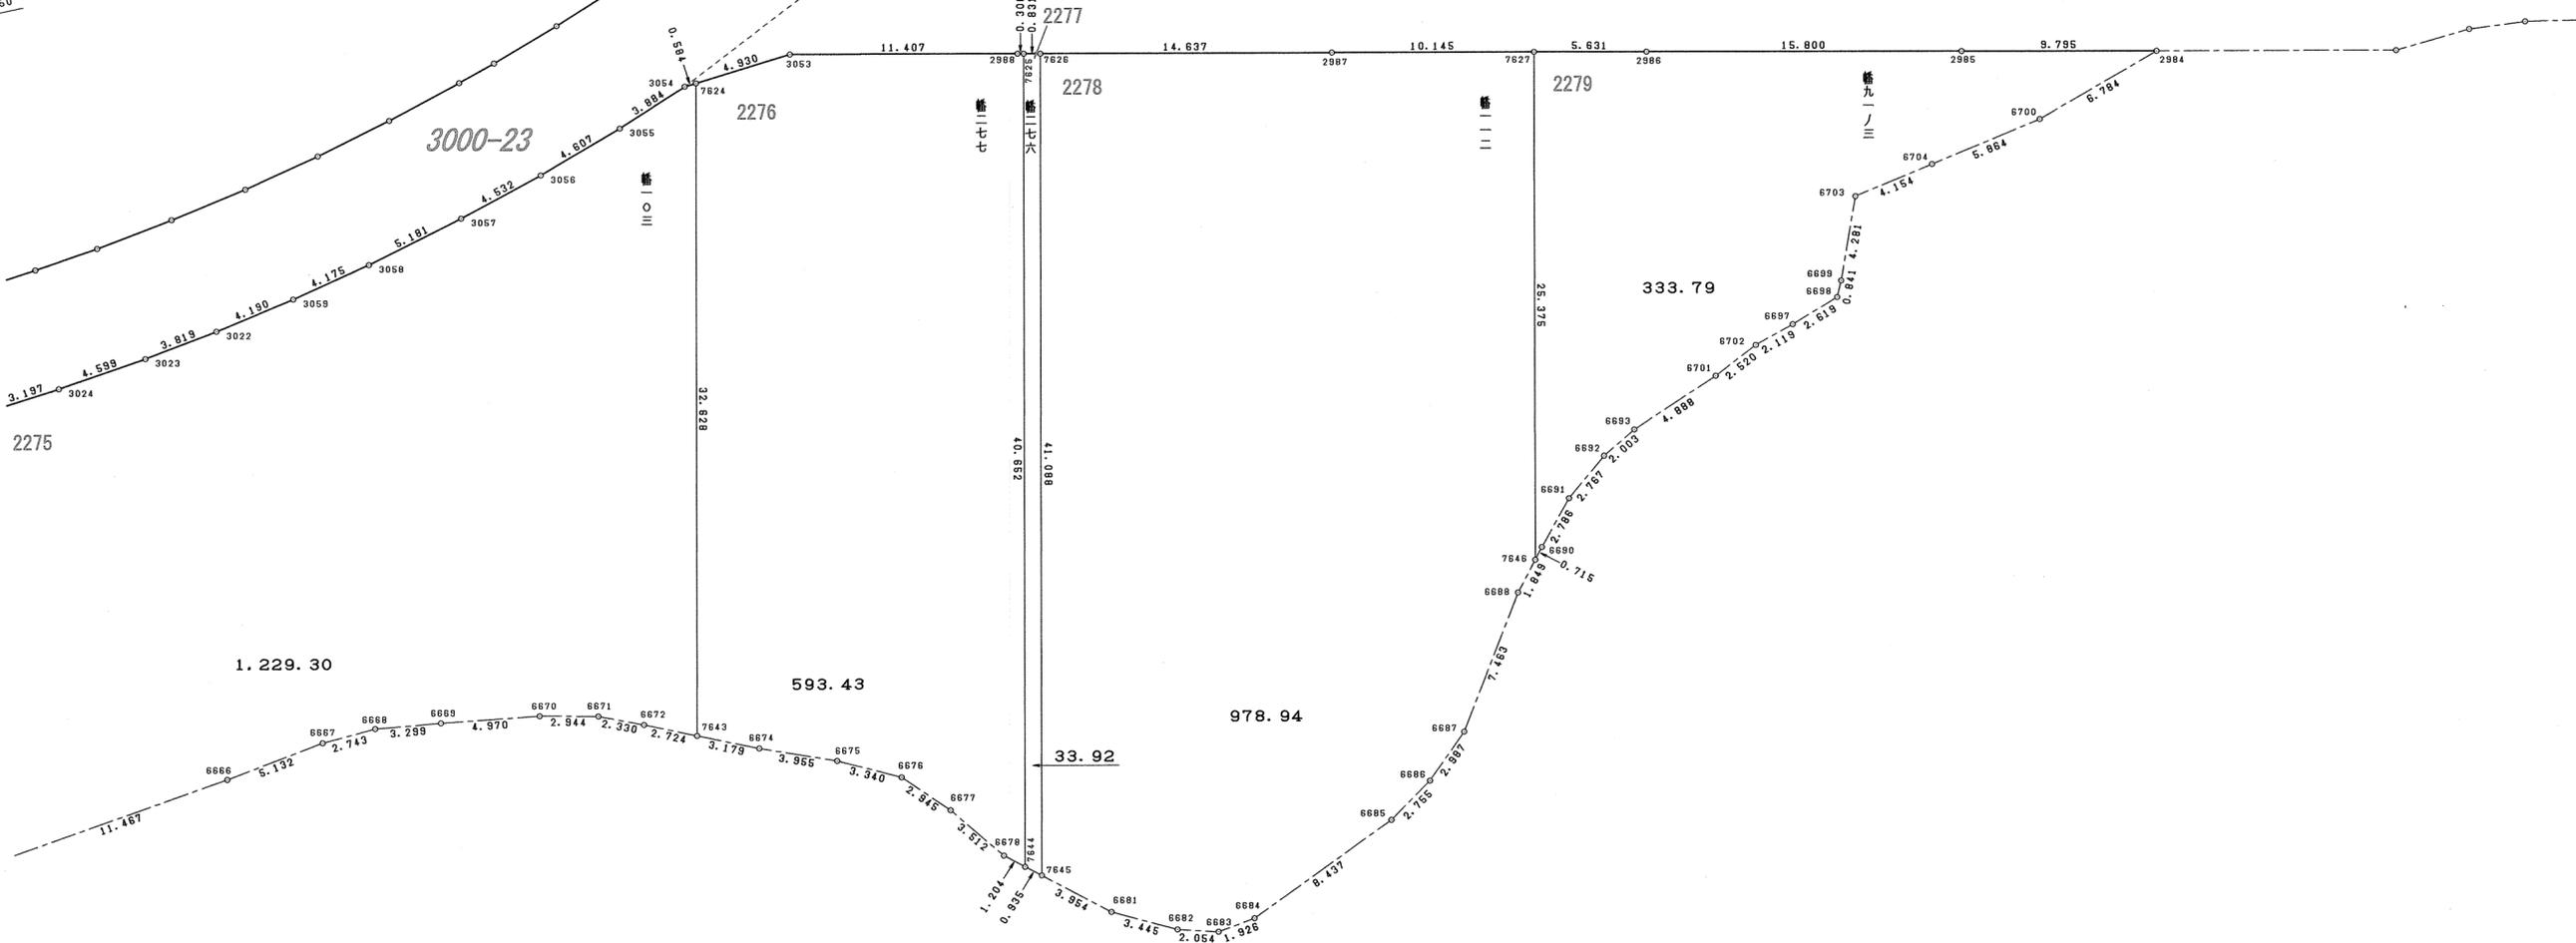

図面の種類	画地出来形確認測量図		
街区名	10 2/2	縮尺	1/250
町名	岩倉幡枝町		
京都市洛北第三土地区画整理組合			

2266

地番	幡一〇五 幡一〇六		
N O	X	Y	辺長
2926	-103256.315	-20836.008	
3772	-103256.994	-20836.127	0.689
6627	-103262.110	-20831.731	6.745
6628	-103264.494	-20829.244	3.445
6629	-103265.599	-20827.463	2.095
7628	-103266.412	-20825.593	2.039
6631	-103266.968	-20824.312	1.396
7629	-103267.450	-20822.802	1.585
7616	-103259.536	-20821.096	8.095
7615	-103258.913	-20823.984	2.954
2926	-103256.315	-20836.008	12.301
面積	83.2023280		
地積	83.20 m <sup>2</sup>		

2267

地番	幡一〇九 幡四八八		
N O	X	Y	辺長
7616	-103259.536	-20821.096	
7629	-103267.450	-20822.802	8.095
7630	-103268.844	-20818.432	4.586
7617	-103260.503	-20816.627	8.534
2930	-103260.112	-20818.432	1.846
7616	-103259.536	-20821.096	2.725
面積	37.9928260		
地積	37.99 m <sup>2</sup>		

2268

地番	幡一一一		
N O	X	Y	辺長
7617	-103260.503	-20816.627	
7630	-103268.844	-20818.432	8.534
6634	-103269.644	-20815.923	2.633
7631	-103269.827	-20815.363	0.589
7618	-103261.181	-20813.497	8.845
7617	-103260.503	-20816.627	3.202
面積	27.8444125		
地積	27.84 m <sup>2</sup>		

2269

地番	幡一一六		
N O	X	Y	辺長
7618	-103261.181	-20813.497	
7631	-103269.827	-20815.363	8.845
7632	-103270.249	-20814.068	1.362
7619	-103261.468	-20812.174	8.982
7618	-103261.181	-20813.497	1.353
面積	12.0724315		
地積	12.07 m <sup>2</sup>		

2270

地番	幡二六三		
N O	X	Y	辺長
7619	-103261.468	-20812.174	
7632	-103270.249	-20814.068	8.982
7642	-103270.728	-20812.598	1.546
7620	-103261.795	-20810.665	9.139
7619	-103261.468	-20812.174	1.544
面積	13.9636420		
地積	13.96 m <sup>2</sup>		

2271

地番	保一〇ノ二		
N O	X	Y	辺長
7620	-103261.795	-20810.665	
7642	-103270.728	-20812.598	9.139
6638	-103270.780	-20812.438	0.168
6639	-103272.151	-20809.469	3.270
7633	-103272.375	-20809.032	0.491
7634	-103277.410	-20799.186	11.058
7622	-103264.857	-20796.466	12.844
2929	-103263.815	-20801.343	4.987
7621	-103262.607	-20806.917	5.703
7620	-103261.795	-20810.665	3.834
面積	158.6377020		
地積	158.63 m <sup>2</sup>		

2272

地番	保一〇ノ一		
N O	X	Y	辺長
7622	-103264.857	-20796.466	
7634	-103277.410	-20799.186	12.844
6642	-103278.348	-20795.397	4.255
6643	-103280.465	-20793.356	2.326
6644	-103281.878	-20791.948	1.994
6645	-103283.629	-20791.126	1.934
6646	-103287.683	-20790.621	4.085
6647	-103290.649	-20790.063	3.018
7635	-103290.828	-20789.761	0.351
7623	-103267.373	-20784.689	23.997
7622	-103264.857	-20796.466	12.042
面積	191.8722425		
地積	191.87 m <sup>2</sup>		

2273

地番	幡五三〇ノ一二		
N O	X	Y	辺長
7635	-103290.828	-20789.761	
6649	-103291.360	-20788.863	1.043
7639	-103291.652	-20786.461	2.419
7636	-103267.990	-20781.344	24.208
3035	-103267.915	-20781.814	0.475
3036	-103267.469	-20784.239	2.465
7623	-103267.373	-20784.689	0.460
7635	-103290.828	-20789.761	23.997
面積	82.4159200		
地積	82.41 m <sup>2</sup>		

2274

地番	幡一〇二 幡一〇七ノ一		
N O	X	Y	辺長
7639	-103291.652	-20786.461	
7640	-103291.877	-20784.614	1.860
6659	-103292.611	-20778.580	6.078
6660	-103293.205	-20770.370	8.231
7641	-103293.568	-20768.531	1.874
7638	-103269.743	-20763.378	24.375
3030	-103269.740	-20763.604	0.226
3031	-103269.662	-20765.631	2.028
3032	-103269.392	-20769.896	4.273
3033	-103269.001	-20774.088	4.210
3034	-103268.485	-20778.255	4.198
7637	-103268.284	-20779.510	1.270
7636	-103267.990	-20781.344	1.857
7639	-103291.652	-20786.461	24.208
面積	432.0407400		
地積	432.04 m <sup>2</sup>		

2275

地番	幡一〇三		
N O	X	Y	辺長
7641	-103293.568	-20768.531	
6661	-103294.199	-20765.332	3.260
6662	-103294.180	-20763.406	1.926
6663	-103293.639	-20759.664	3.780
6664	-103292.005	-20754.592	5.328
6665	-103291.387	-20752.182	2.487
6666	-103289.877	-20740.814	11.467
6667	-103289.086	-20735.743	5.132
6668	-103288.941	-20733.003	2.743
6669	-103289.344	-20729.728	3.299
6670	-103290.022	-20724.804	4.970
6671	-103290.652	-20721.928	2.944
6672	-103291.545	-20719.775	2.330
7643	-103292.634	-20717.278	2.724
7624	-103260.713	-20710.518	32.628
3054	-103260.763	-20711.100	0.584
3055	-103262.126	-20714.738	3.884
3056	-103263.600	-20719.103	4.607
3057	-103264.881	-20723.451	4.532
3058	-103266.184	-20728.466	5.181
3059	-103267.079	-20732.544	4.175
3022	-103267.853	-20736.662	4.190
3023	-103268.442	-20740.436	3.819
3024	-103269.015	-20745.000	4.599
3025	-103269.324	-20748.183	3.197
3026	-103269.544	-20751.010	2.835
3027	-103269.660	-20753.080	2.073
3028	-103269.749	-20755.263	2.184
3029	-103269.799	-20759.385	4.122
7638	-103269.743	-20763.378	3.993
7641	-103293.568	-20768.531	24.375
面積	1229.3089525		
地積	1229.30 m <sup>2</sup>		

2276

地番	幡二七七		
N O	X	Y	辺長
7624	-103260.713	-20710.518	
7643	-103292.634	-20717.278	32.628
6674	-103293.904	-20714.363	3.179
6675	-103295.321	-20710.670	3.955
6676	-103296.816	-20707.683	3.340
6677	-103298.938	-20705.640	2.945
6678	-103301.718	-20703.493	3.512
7644	-103302.487	-20702.566	1.204
7625	-103262.716	-20694.146	40.652
2988	-103262.653	-20694.446	0.306
3053	-103260.290	-20705.606	11.407
7624	-103260.713	-20710.518	4.930
面積	593.4367635		
地積	593.43 m <sup>2</sup>		

2277

地番	幡二七六		
N O	X	Y	辺長
7625	-103262.716	-20694.146	
7644	-103302.487	-20702.566	40.652
7645	-103303.085	-20701.846	0.935
7626	-103262.888	-20693.332	41.088
7625	-103262.716	-20694.146	0.831
面積	33.9275230		
地積	33.92 m <sup>2</sup>		

2278


地番	幡一一二		
N O	X	Y	辺長
7626	-103262.888	-20693.332	
7645	-103303.085	-20701.846	41.088
6681	-103305.610	-20698.802	3.954
6682	-103307.166	-20695.728	3.445
6683	-103307.703	-20693.745	2.054
6684	-103307.427	-20691.838	1.926
6685	-103304.053	-20684.104	8.437
6686	-103302.534	-20681.805	2.755
6687	-103300.511	-20679.606	2.987
6688	-103294.270	-20675.512	7.463
7646	-103292.847	-20674.330	1.849
7627	-103268.019	-20669.086	25.375
2987	-103265.916	-20679.011	10.145
7626	-103262.888	-20693.332	14.637
面積	978.9454300		
地積	978.94 m <sup>2</sup>		

2279


地番	幡九一ノ三		
N O	X	Y	辺長
7627	-103268.019	-20669.086	
7646	-103292.847	-20674.330	25.375
6690	-103292.297	-20673.873	0.715
6691	-103290.205	-20672.032	2.786
6692	-103288.487	-20669.862	2.767
6693	-103287.518	-20668.108	2.003
6701	-103285.750	-20663.550	4.888
6702	-103284.655	-20661.280	2.520
6697	-103284.032	-20659.254	2.119
6698	-103283.161	-20656.784	2.619
6699	-103282.402	-20656.421	0.841
6703	-103278.424	-20654.839	4.281
6704	-103277.663	-20650.755	4.154
6700	-103276.589	-20644.990	5.864
2984	-103274.495	-20638.537	6.784
2985	-103272.454	-20648.118	9.795
2986	-103269.186	-20663.577	15.800
7627	-103268.019	-20669.086	5.631
面積	333.7956645		
地積	333.79 m <sup>2</sup>		

図面の種類	画地出来形確認測量図	
街区名	10	求積表
町名	岩倉幡枝町	
京都市洛北第三土地区画整理組合		



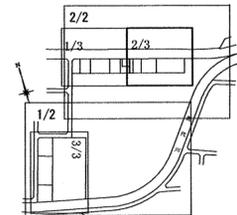


3000-3

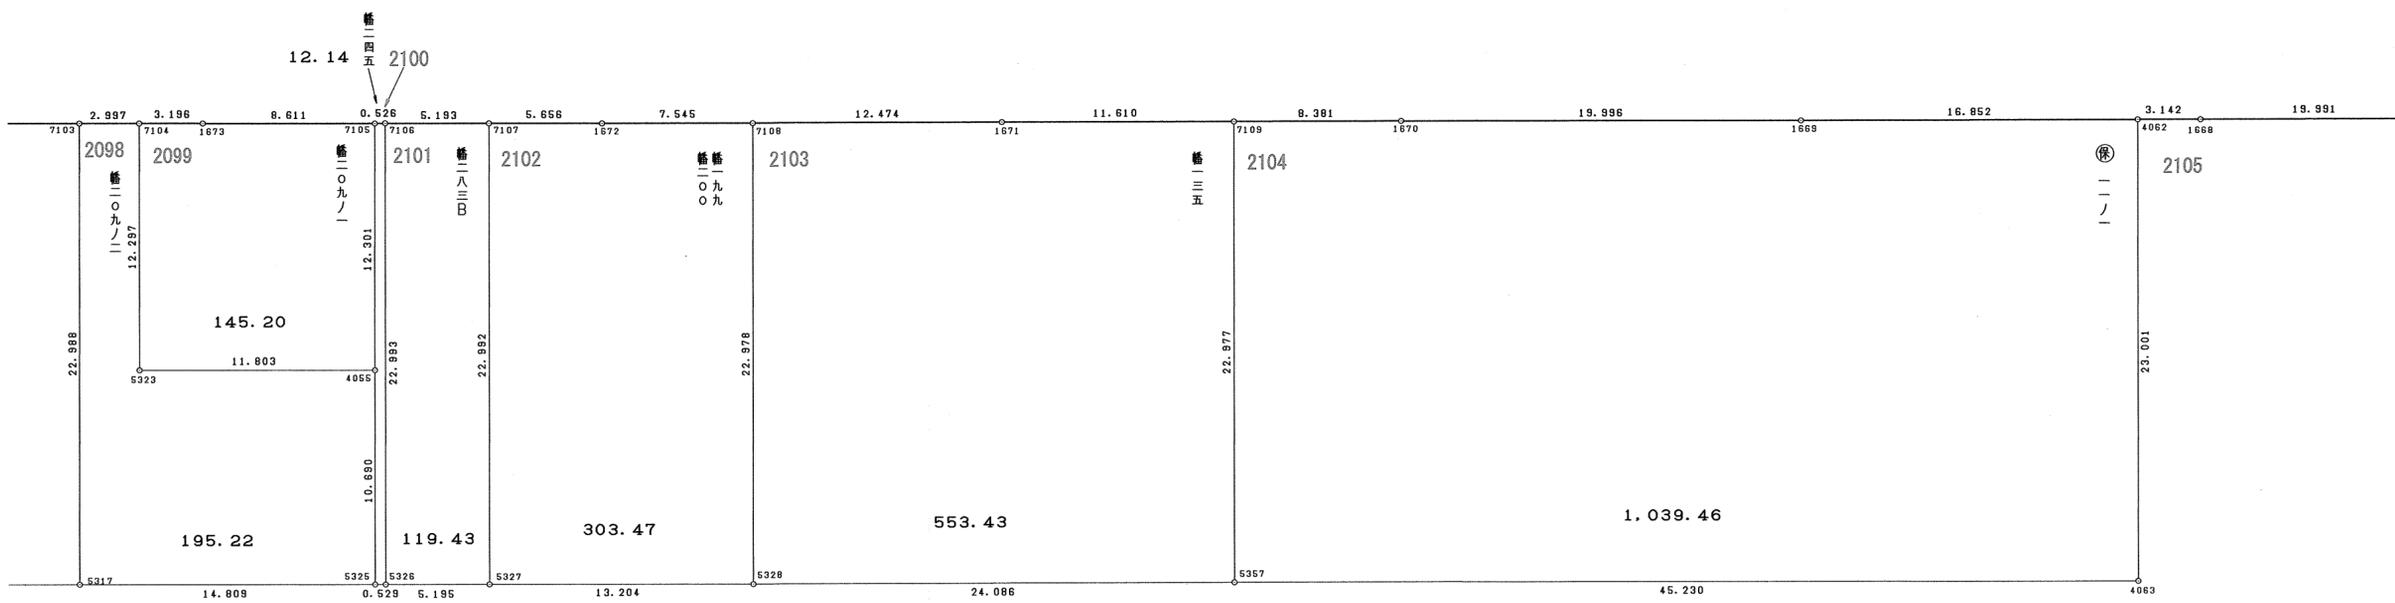

岩倉幡枝町

図面の種類	画地出来形確認測量図		
街区名	11 2/3	縮尺	1/250
町名	岩倉幡枝町		
京都市洛北第三土地区画整理組合			

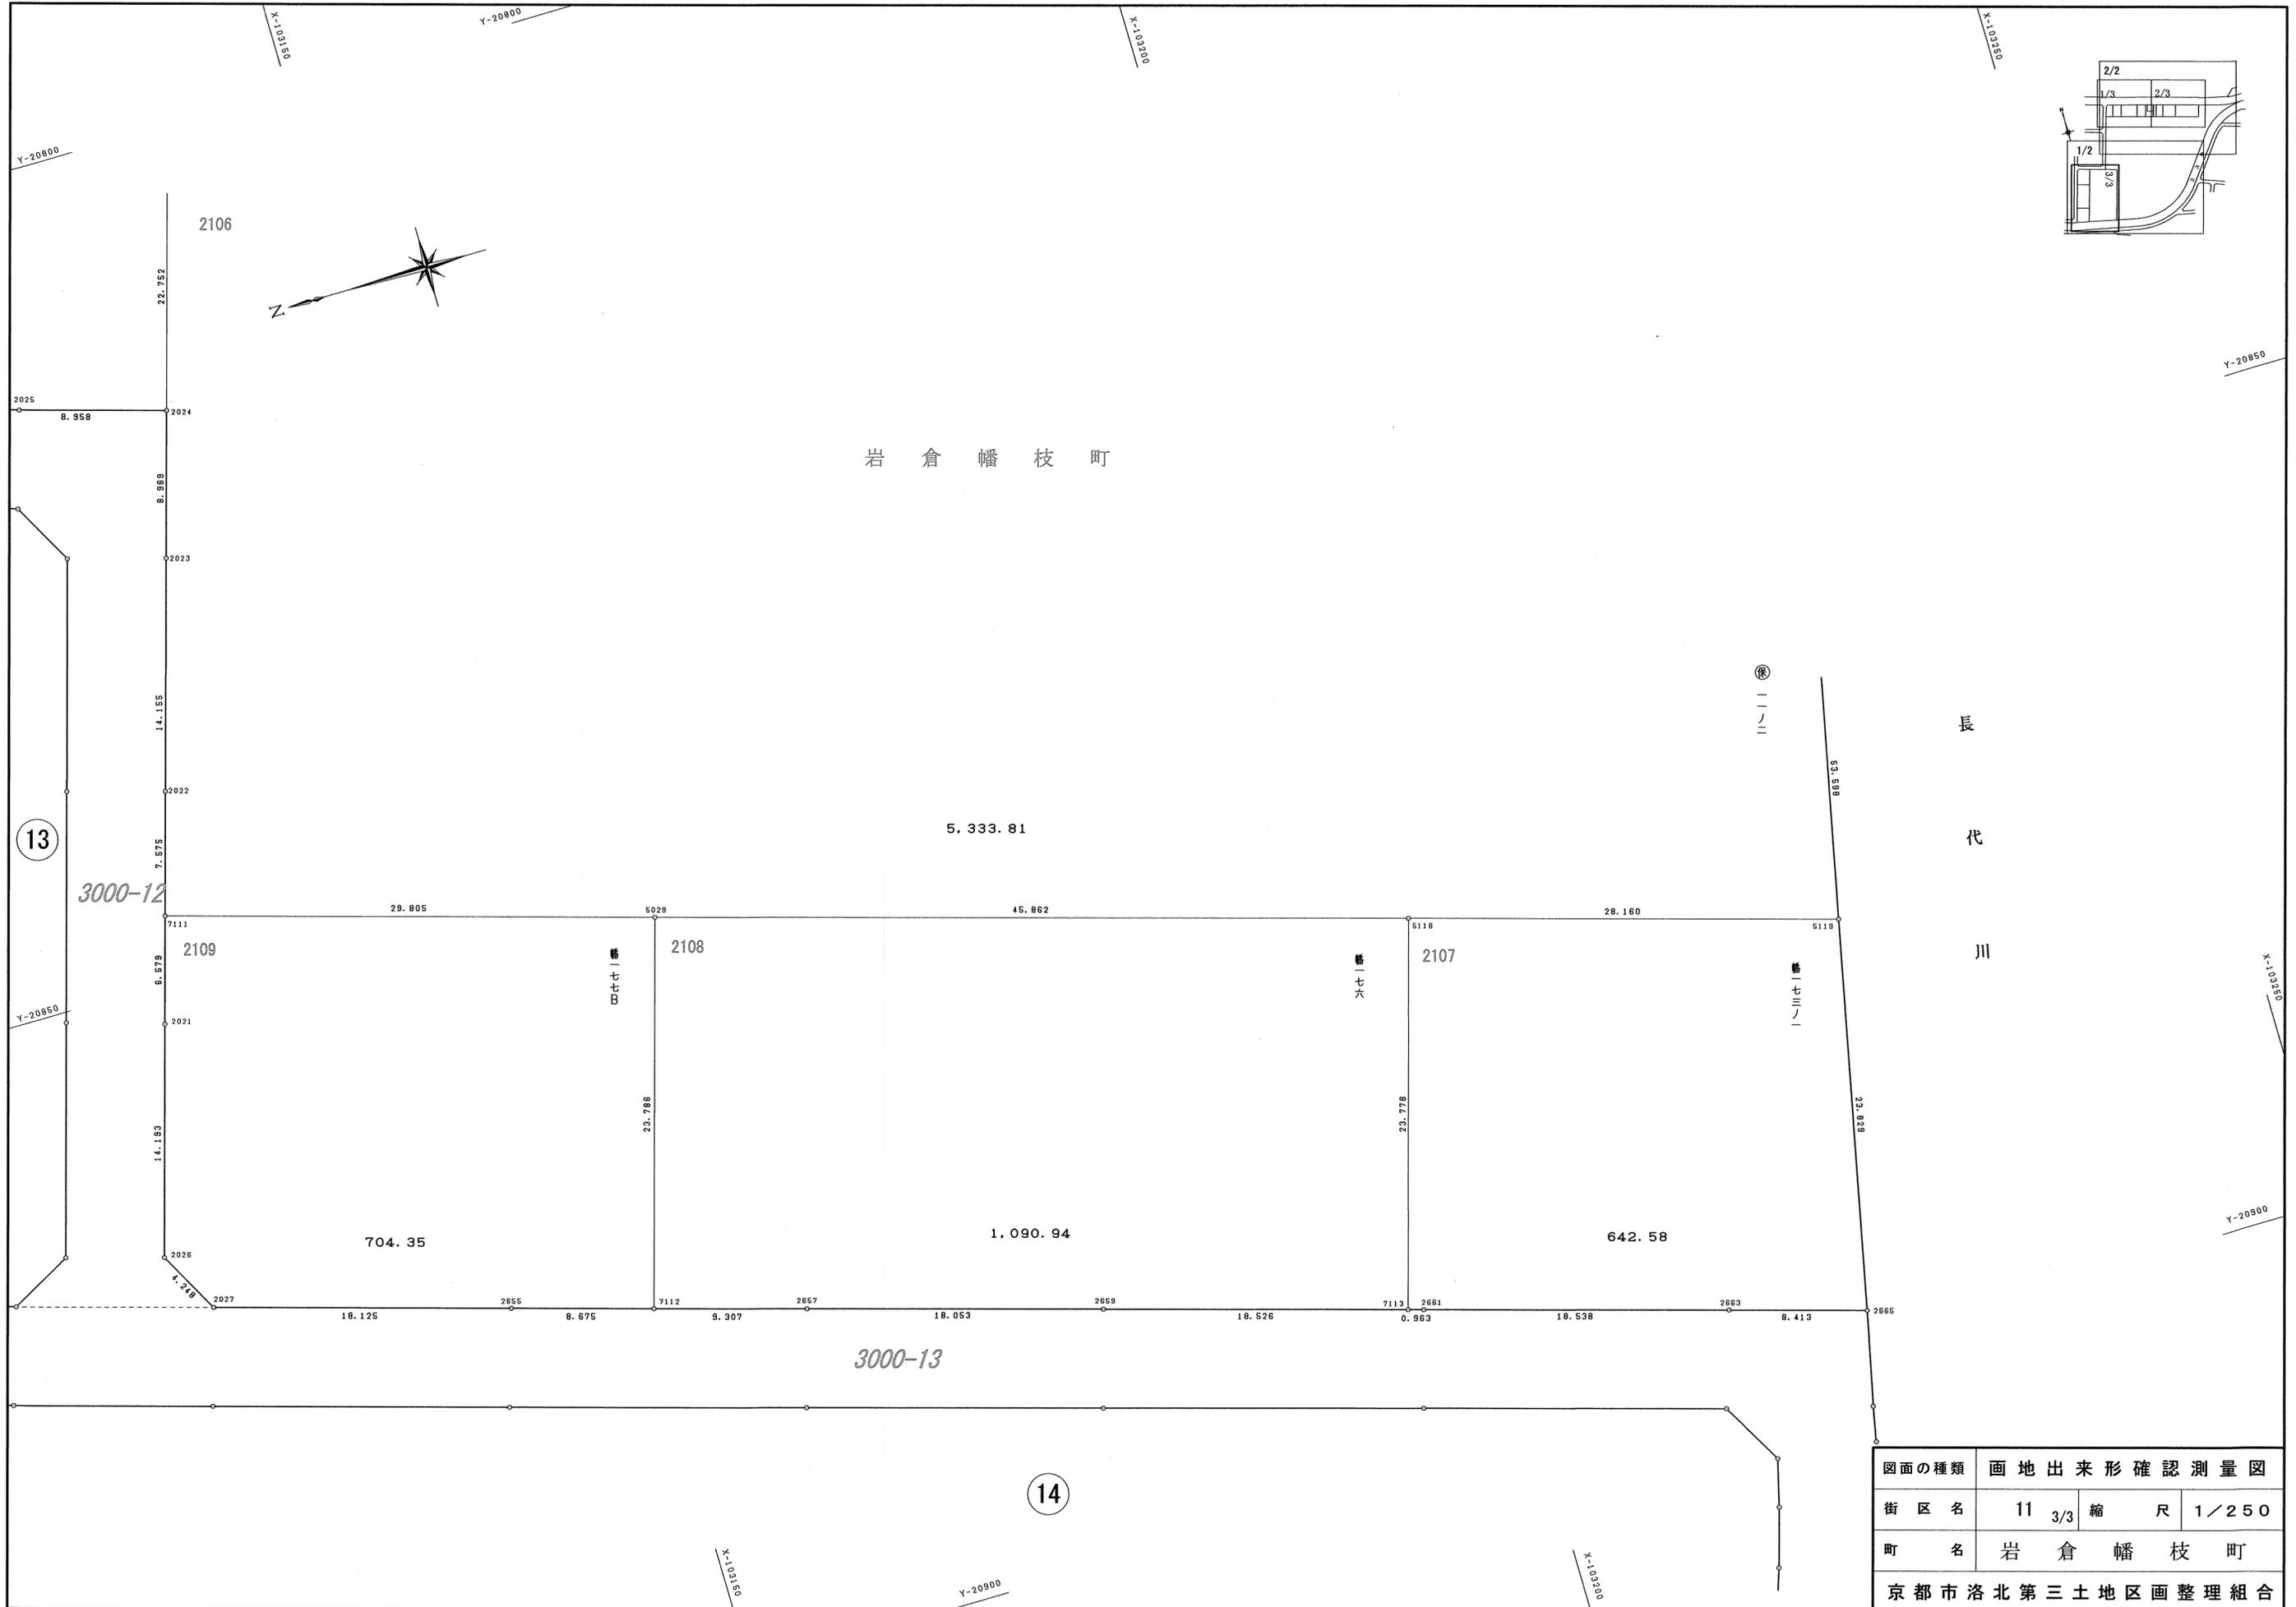

岩 倉 幡 枝 町

長  
代  
川

13

14

図面の種類	画地出来形確認測量図		
街区名	11 3/3	縮 尺	1/250
町 名	岩 倉 幡 枝 町		
京都市洛北第三土地区画整理組合			





## 2094

地番 幡二九ノ一			
N O	X	Y	辺長
1677	-103017.837	-20778.117	
2002	-103019.888	-20781.830	4.241
2003	-103033.211	-20785.778	13.895
7110	-103039.058	-20787.510	6.098
5076	-103042.637	-20775.115	12.901
7100	-103020.527	-20768.751	23.007
1677	-103017.837	-20778.117	9.744
面積	290.1951560		
地積	290.19 m <sup>2</sup>		

## 2095

地番 幡二〇一			
N O	X	Y	辺長
7100	-103020.527	-20768.751	
5076	-103042.637	-20775.115	23.007
5077	-103047.138	-20759.427	16.320
7101	-103025.035	-20753.071	22.998
1676	-103023.361	-20758.884	6.049
7100	-103020.527	-20768.751	10.265
面積	375.3886240		
地積	375.38 m <sup>2</sup>		

## 2096

地番 幡一九三			
N O	X	Y	辺長
7101	-103025.035	-20753.071	
5077	-103047.138	-20759.427	22.998
5318	-103055.665	-20729.778	30.850
7102	-103033.567	-20723.419	22.994
1675	-103028.895	-20739.666	16.905
7101	-103025.035	-20753.071	13.949
面積	709.4745415		
地積	709.47 m <sup>2</sup>		

## 2097

地番 幡一四七			
N O	X	Y	辺長
7102	-103033.567	-20723.419	
5318	-103055.665	-20729.778	22.994
5317	-103060.327	-20713.540	16.893
7103	-103038.236	-20707.179	22.988
1674	-103034.420	-20720.451	13.809
7102	-103033.567	-20723.419	3.088
面積	388.4676015		
地積	388.46 m <sup>2</sup>		

## 2098

地番 幡二〇九ノ二			
N O	X	Y	辺長
7103	-103038.236	-20707.179	
5317	-103060.327	-20713.540	22.988
5325	-103064.426	-20699.309	14.809
4055	-103054.152	-20696.353	10.690
5323	-103050.884	-20707.695	11.803
7104	-103039.065	-20704.298	12.297
7103	-103038.236	-20707.179	2.997
面積	195.2257640		
地積	195.22 m <sup>2</sup>		

## 2099

地番 幡二〇九ノ一			
N O	X	Y	辺長
7104	-103039.065	-20704.298	
5323	-103050.884	-20707.695	12.297
4055	-103054.152	-20696.353	11.803
7105	-103042.330	-20692.951	12.301
1673	-103039.948	-20701.226	8.611
7104	-103039.065	-20704.298	3.196
面積	145.2074685		
地積	145.20 m <sup>2</sup>		

## 2100

地番 幡二四五			
N O	X	Y	辺長
7105	-103042.330	-20692.951	
4055	-103054.152	-20696.353	12.301
5325	-103064.426	-20699.309	10.690
5326	-103064.573	-20698.800	0.529
7106	-103042.475	-20692.445	22.993
7105	-103042.330	-20692.951	0.526
面積	12.1454345		
地積	12.14 m <sup>2</sup>		

## 2101

地番 幡二八三B			
N O	X	Y	辺長
7106	-103042.475	-20692.445	
5326	-103064.573	-20698.800	22.993
5327	-103066.009	-20693.807	5.195
7107	-103043.912	-20687.454	22.992
7106	-103042.475	-20692.445	5.193
面積	119.4382410		
地積	119.43 m <sup>2</sup>		

## 2102

地番 幡一九九 幡二〇〇			
N O	X	Y	辺長
7107	-103043.912	-20687.454	
5327	-103066.009	-20693.807	22.992
5328	-103069.648	-20681.114	13.204
7108	-103047.563	-20674.767	22.978
1672	-103045.477	-20682.018	7.545
7107	-103043.912	-20687.454	5.656
面積	303.4763805		
地積	303.47 m <sup>2</sup>		

## 2103

地番 幡一三五			
N O	X	Y	辺長
7108	-103047.563	-20674.767	
5328	-103069.648	-20681.114	22.978
5357	-103076.303	-20657.965	24.086
7109	-103054.219	-20651.620	22.977
1671	-103051.011	-20662.779	11.610
7108	-103047.563	-20674.767	12.474
面積	553.4384450		
地積	553.43 m <sup>2</sup>		

## 2104


地番 保一一ノ一			
N O	X	Y	辺長
7109	-103054.219	-20651.620	
5357	-103076.303	-20657.965	22.977
4063	-103088.817	-20614.500	45.230
4062	-103066.710	-20608.149	23.001
1669	-103062.073	-20624.351	16.852
1670	-103056.535	-20643.565	19.996
7109	-103054.219	-20651.620	8.381
面積	1039.4654695		
地積	1039.46 m <sup>2</sup>		

## 2105

地番 幡八〇・幡一二ノ二・幡一三九・幡一四九・幡一五一・幡一五三・幡一五三ノ一・幡一五三ノ二・幡一五四・幡一五五・幡一五六・幡一五七・幡一五八・幡一五九ノ一・幡一五九ノ二・幡一六一・幡一六一ノ一・幡一六二・幡一六三・幡一六四・幡一六五・幡一六六・幡一六七・幡一六八ノ二・幡一六九ノ二・幡一七八・幡一八四・幡一八五・幡一八六・幡一八七・幡一八八・幡一九九・幡一九〇・幡一九一・幡一九二			
N O	X	Y	辺長
1657	-103082.772	-20530.512	
1658	-103082.741	-20533.976	3.464
1659	-103082.525	-20538.965	4.993
1660	-103082.157	-20543.979	5.027
1661	-103081.626	-20548.964	5.013
1662	-103080.949	-20553.922	5.004
1663	-103080.114	-20558.865	5.013
1664	-103079.134	-20563.766	4.998
1665	-103077.963	-20568.643	5.015
1666	-103076.658	-20573.461	4.991
1667	-103073.104	-20585.916	12.952
1668	-103067.575	-20605.128	19.991
4062	-103066.710	-20608.149	3.142
4063	-103088.817	-20614.500	23.001
5357	-103076.303	-20657.965	45.230
5328	-103069.648	-20681.114	24.086
5327	-103066.009	-20693.807	13.204
5326	-103064.573	-20698.800	5.195
5325	-103064.426	-20699.309	0.529
5317	-103060.327	-20713.540	14.809
5318	-103055.665	-20729.778	16.893
5077	-103047.138	-20759.427	30.850
5076	-103042.637	-20775.115	16.320
7110	-103039.058	-20787.510	12.901
2005	-103046.392	-20789.682	7.648
2007	-103060.036	-20793.732	14.232
2008	-103071.460	-20797.115	11.914
2011	-103090.614	-20802.790	19.977
2014	-103109.647	-20808.420	19.848
2025	-103128.837	-20814.125	20.020
2024	-103137.430	-20816.659	8.958
4079	-103143.899	-20794.845	22.752
4078	-103237.636	-20822.633	97.769
5457	-103246.155	-20783.173	40.369
5458	-103246.909	-20779.355	3.891
5459	-103247.537	-20775.516	3.890
5460	-103248.025	-20771.657	3.889
5461	-103248.377	-20767.780	3.892
5462	-103248.598	-20763.896	3.890
5463	-103248.694	-20760.006	3.891
5464	-103248.654	-20756.113	3.893
5465	-103248.450	-20752.229	3.889
5466	-103248.147	-20748.350	3.890
5467	-103247.695	-20744.484	3.892
5468	-103247.110	-20740.641	3.887
5469	-103246.397	-20736.815	3.891
5470	-103245.538	-20733.018	3.892

5471	-103244.574	-20729.253	3.886
5472	-103243.460	-20725.526	3.889
5473	-103242.218	-20721.836	3.893
5474	-103240.862	-20718.191	3.889
5475	-103239.370	-20714.597	3.891
5476	-103237.757	-20711.057	3.890
5477	-103236.023	-20707.574	3.890
5478	-103234.168	-20704.152	3.892
5479	-103232.203	-20700.793	3.891
5480	-103230.115	-20697.507	3.893
5481	-103227.924	-20694.295	3.888
5482	-103225.617	-20691.162	3.890
5483	-103223.193	-20688.112	3.895
5484	-103220.680	-20685.142	3.890
5485	-103218.055	-20682.269	3.891
5486	-103215.343	-20679.488	3.884
5487	-103212.537	-20676.792	3.891
5488	-103209.639	-20674.200	3.888
5489	-103206.642	-20671.717	3.891
5490	-103203.571	-20669.324	3.893
5491	-103203.544	-20669.302	0.034
5492	-103126.304	-20611.643	96.387
5493	-103123.033	-20609.105	4.140
5494	-103119.863	-20606.440	4.141
5495	-103116.794	-20603.643	4.152
5496	-103113.838	-20600.759	4.129
5497	-103110.982	-20597.719	4.171
5498	-103108.199	-20594.557	4.212
5499	-103105.697	-20591.434	4.001
5500	-103103.169	-20588.032	4.238
5501	-103100.816	-20584.633	4.133
5502	-103098.630	-20581.115	4.141
5503	-103096.558	-20577.533	4.138
5504	-103094.614	-20573.869	4.147
5505	-103092.831	-20570.129	4.143
5506	-103091.186	-20566.322	4.147
5507	-103089.681	-20562.466	4.139
5508	-103088.326	-20558.541	4.152
5509	-103087.134	-20554.577	4.139
5510	-103086.098	-20550.569	4.139
5511	-103085.216	-20546.521	4.142
5518	-103084.498	-20542.432	4.151
5519	-103083.904	-20538.332	4.142
5520	-103083.502	-20534.209	4.142
5521	-103083.242	-20530.072	4.145
1657	-103082.772	-20530.512	0.643
面積	31677.6369135		
地積	31677.63 m <sup>2</sup>		

## 2106&lt;/

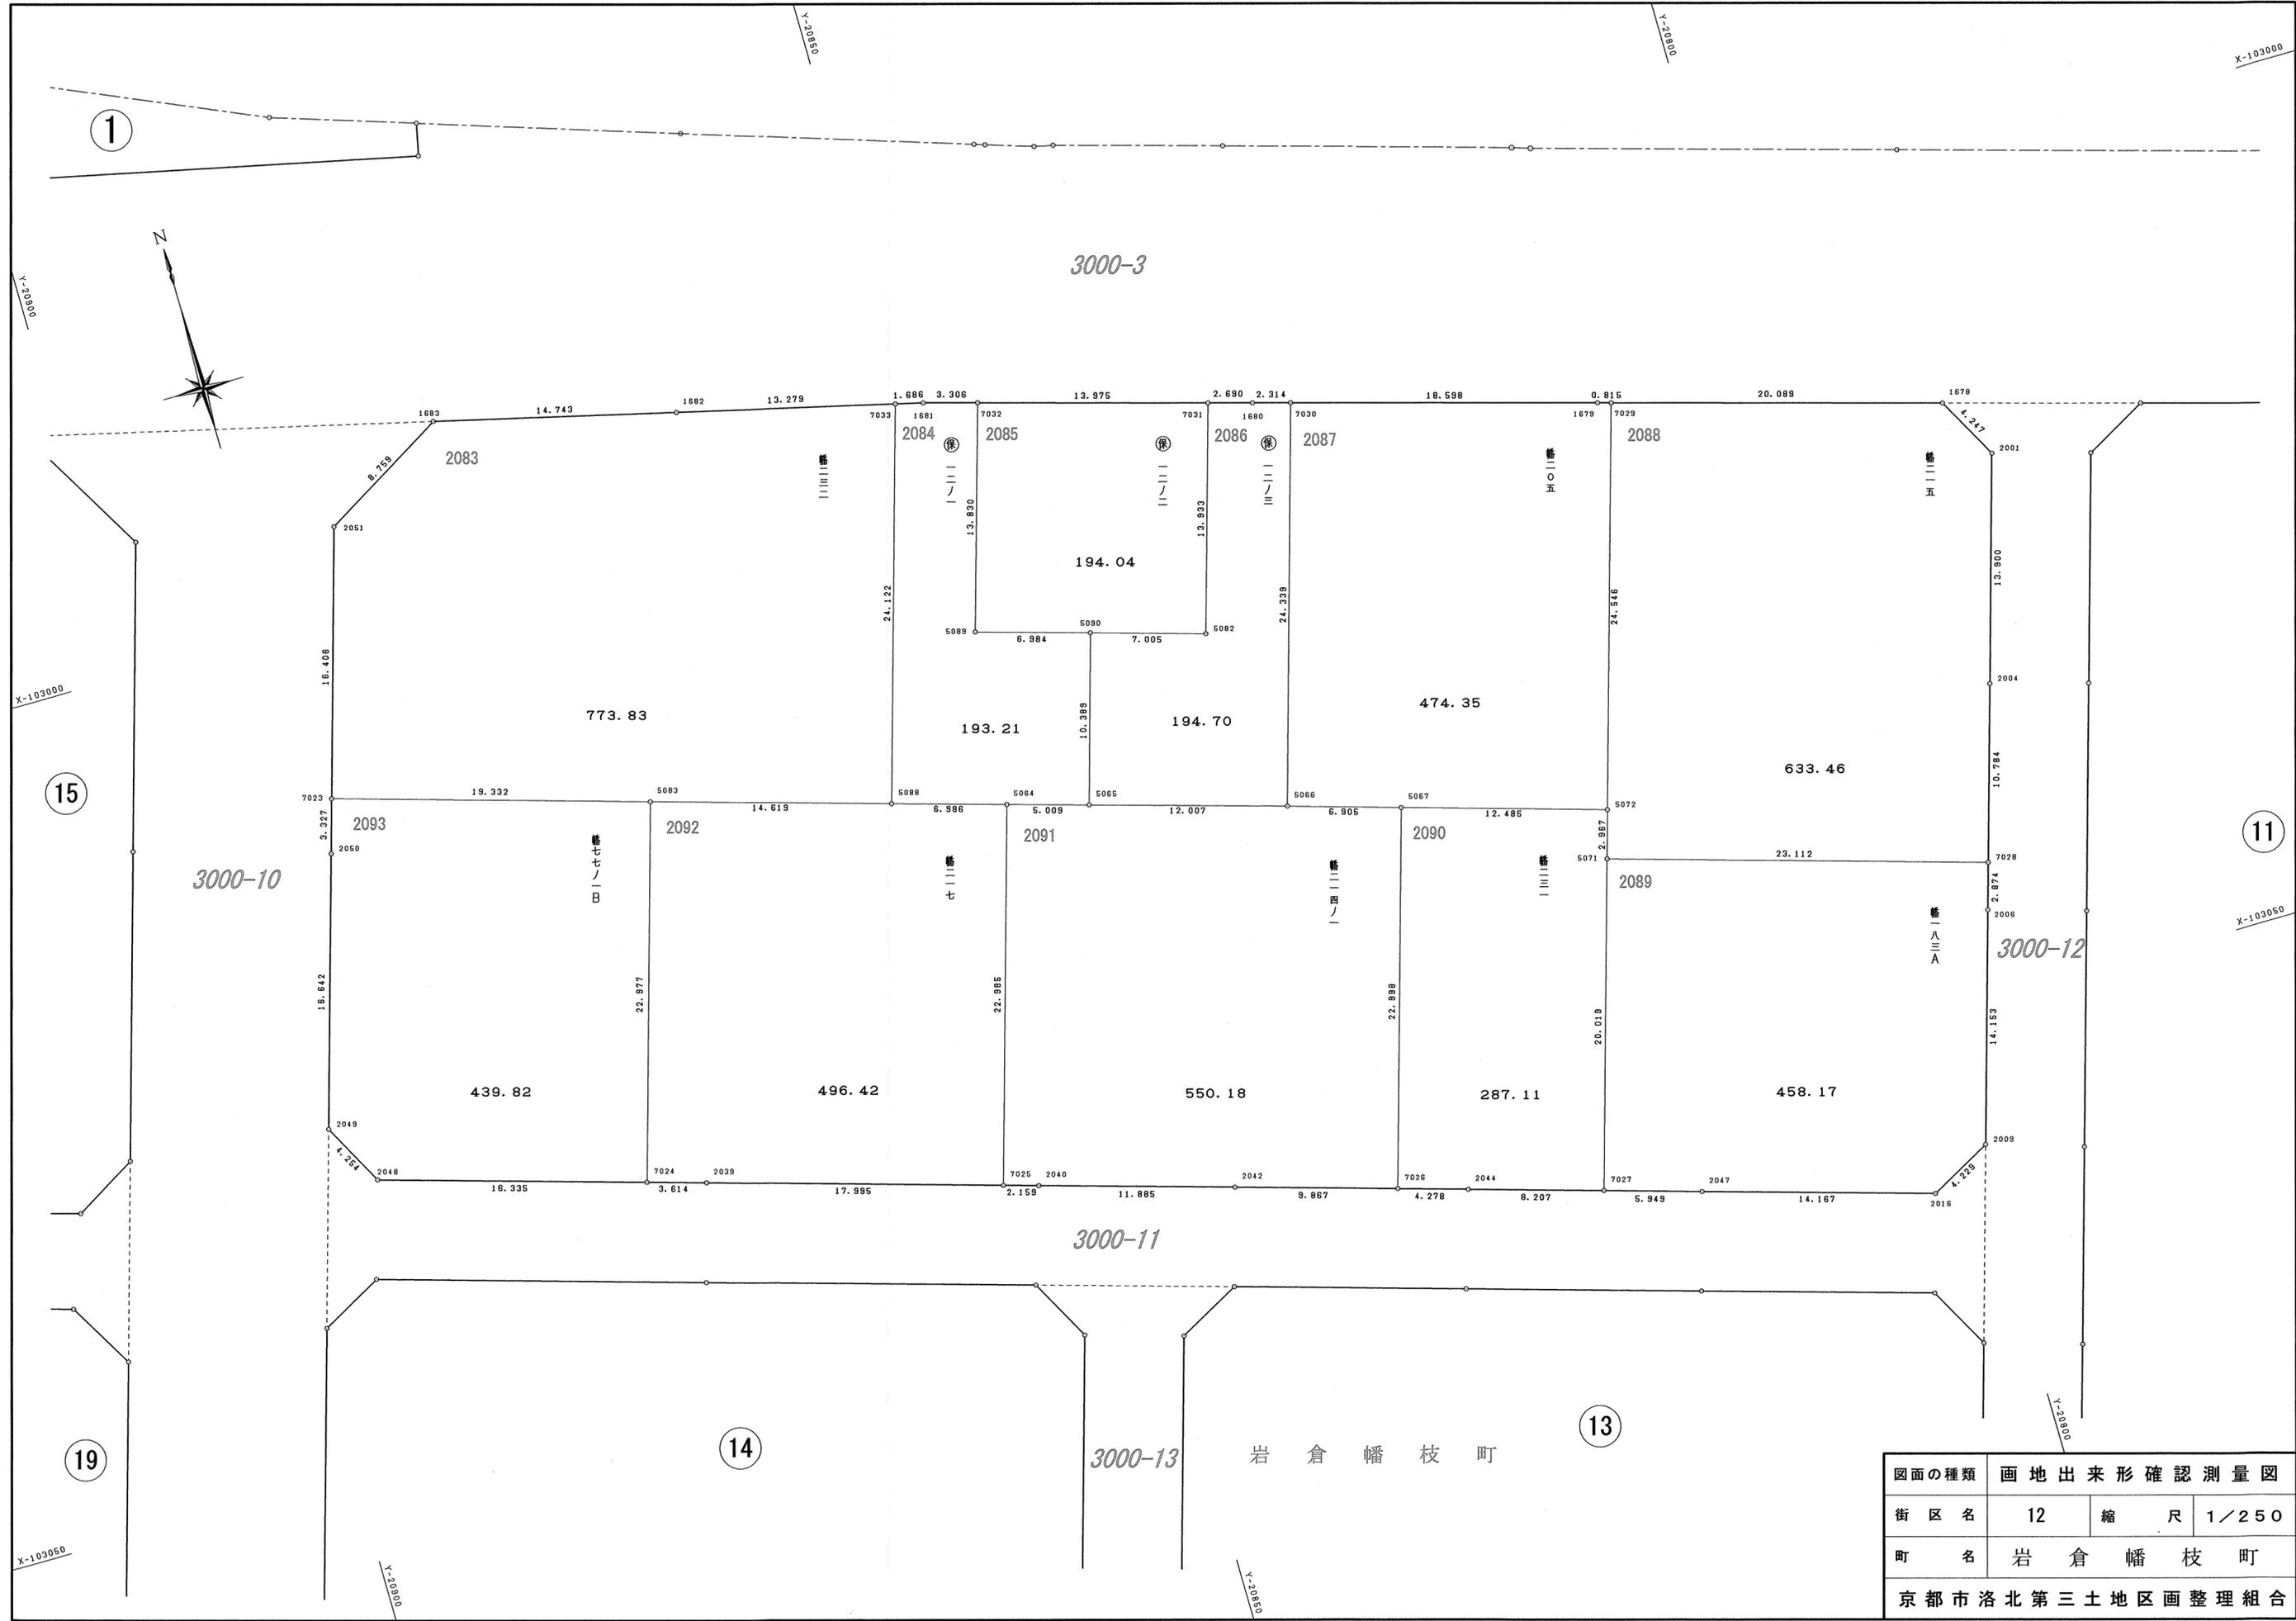

図面の種類	画地出来形確認測量図		
街区名	12	縮尺	1/250
町名	岩倉幡枝町		
京都市洛北第三土地区画整理組合			

## 2083

地番	幡二三二		
NO	X	Y	辺長
1683	-102990.364	-20877.897	
2051	-102994.813	-20885.443	8.759
7023	-103010.545	-20890.100	16.406
5083	-103016.030	-20871.562	19.332
5088	-103020.192	-20857.547	14.619
7033	-102997.066	-20850.687	24.122
1682	-102993.888	-20863.581	13.279
1683	-102990.364	-20877.897	14.743
面積	773.8391020		
地積	773.83 m <sup>2</sup>		

## 2084

地番	保一二ノ一		
NO	X	Y	辺長
7033	-102997.066	-20850.687	
5088	-103020.192	-20857.547	24.122
5064	-103022.167	-20850.845	6.986
5065	-103023.579	-20846.039	5.009
5090	-103013.608	-20843.120	10.389
5089	-103011.638	-20849.821	6.984
7032	-102998.383	-20845.872	13.830
1681	-102997.470	-20849.050	3.306
7033	-102997.066	-20850.687	1.686
面積	193.2137420		
地積	193.21 m <sup>2</sup>		

## 2085

地番	保一二ノ二		
NO	X	Y	辺長
7032	-102998.383	-20845.872	
5089	-103011.638	-20849.821	13.830
5090	-103013.608	-20843.120	6.984
5082	-103015.601	-20836.404	7.005
7031	-103002.243	-20832.440	13.933
7032	-102998.383	-20845.872	13.975
面積	194.0466725		
地積	194.04 m <sup>2</sup>		

## 2086

地番	保一二ノ三		
NO	X	Y	辺長
7031	-103002.243	-20832.440	
5082	-103015.601	-20836.404	13.933
5090	-103013.608	-20843.120	7.005
5065	-103023.579	-20846.039	10.389
5066	-103026.969	-20834.520	12.007
7030	-103003.625	-20827.629	24.339
1680	-103002.986	-20829.854	2.314
7031	-103002.243	-20832.440	2.690
面積	194.7019420		
地積	194.70 m <sup>2</sup>		

## 2087

地番	幡二〇五		
NO	X	Y	辺長
7030	-103003.625	-20827.629	
5066	-103026.969	-20834.520	24.339
5067	-103028.954	-20827.906	6.905
5072	-103032.516	-20815.939	12.485
7029	-103008.980	-20808.968	24.546
1679	-103008.755	-20809.752	0.815
7030	-103003.625	-20827.629	18.598
面積	474.3550370		
地積	474.35 m <sup>2</sup>		

## 2088

地番	幡二一五		
NO	X	Y	辺長
7029	-103008.980	-20808.968	
5072	-103032.516	-20815.939	24.546
5071	-103035.362	-20816.781	2.967
7028	-103041.928	-20794.621	23.112
2004	-103031.588	-20791.558	10.784
2001	-103018.256	-20787.625	13.900
1678	-103014.528	-20789.660	4.247
7029	-103008.980	-20808.968	20.089
面積	633.4662820		
地積	633.46 m <sup>2</sup>		

## 2089

地番	幡一八三A		
NO	X	Y	辺長
7028	-103041.928	-20794.621	
5071	-103035.362	-20816.781	23.112
7027	-103054.556	-20822.472	20.019
2047	-103056.247	-20816.768	5.949
2016	-103060.263	-20803.182	14.167
2009	-103058.253	-20799.461	4.229
2006	-103044.684	-20795.437	14.153
7028	-103041.928	-20794.621	2.874
面積	458.1736750		
地積	458.17 m <sup>2</sup>		

## 2090

地番	幡二三一		
NO	X	Y	辺長
5072	-103032.516	-20815.939	
5067	-103028.954	-20827.906	12.485
7026	-103051.004	-20834.442	22.998
2044	-103052.222	-20830.341	4.278
7027	-103054.556	-20822.472	8.207
5071	-103035.362	-20816.781	20.019
5072	-103032.516	-20815.939	2.967
面積	287.1127720		
地積	287.11 m <sup>2</sup>		

## 2091

地番	幡二一四ノ一		
NO	X	Y	辺長
5067	-103028.954	-20827.906	
5066	-103026.969	-20834.520	6.905
5065	-103023.579	-20846.039	12.007
5064	-103022.167	-20850.845	5.009
7025	-103044.207	-20857.368	22.985
2040	-103044.821	-20855.298	2.159
2042	-103048.195	-20843.901	11.885
7026	-103051.004	-20834.442	9.867
5067	-103028.954	-20827.906	22.998
面積	550.1850645		
地積	550.18 m <sup>2</sup>		

## 2092

地番	幡二一七		
NO	X	Y	辺長
5064	-103022.167	-20850.845	
5088	-103020.192	-20857.547	6.986
5083	-103016.030	-20871.562	14.619
7024	-103038.062	-20878.085	22.977
2039	-103038.086	-20874.619	3.614
7025	-103044.207	-20857.368	17.995
5064	-103022.167	-20850.845	22.985
面積	496.4283245		
地積	496.42 m <sup>2</sup>		

## 2093

地番	幡七七ノ一B		
NO	X	Y	辺長
5083	-103016.030	-20871.562	
7023	-103010.545	-20890.100	19.332
2050	-103013.736	-20891.045	3.327
2049	-103029.692	-20895.775	16.642
2048	-103033.434	-20893.751	4.254
7024	-103038.062	-20878.085	16.335
5083	-103016.030	-20871.562	22.977
面積	439.8290705		
地積	439.82 m <sup>2</sup>		

図面の種類	画地出来形確認測量図	
街区名	12	求積表
町名	岩倉幡枝町	
京都市洛北第三土地区画整理組合		




岩倉幡枝町

14

12

11

11

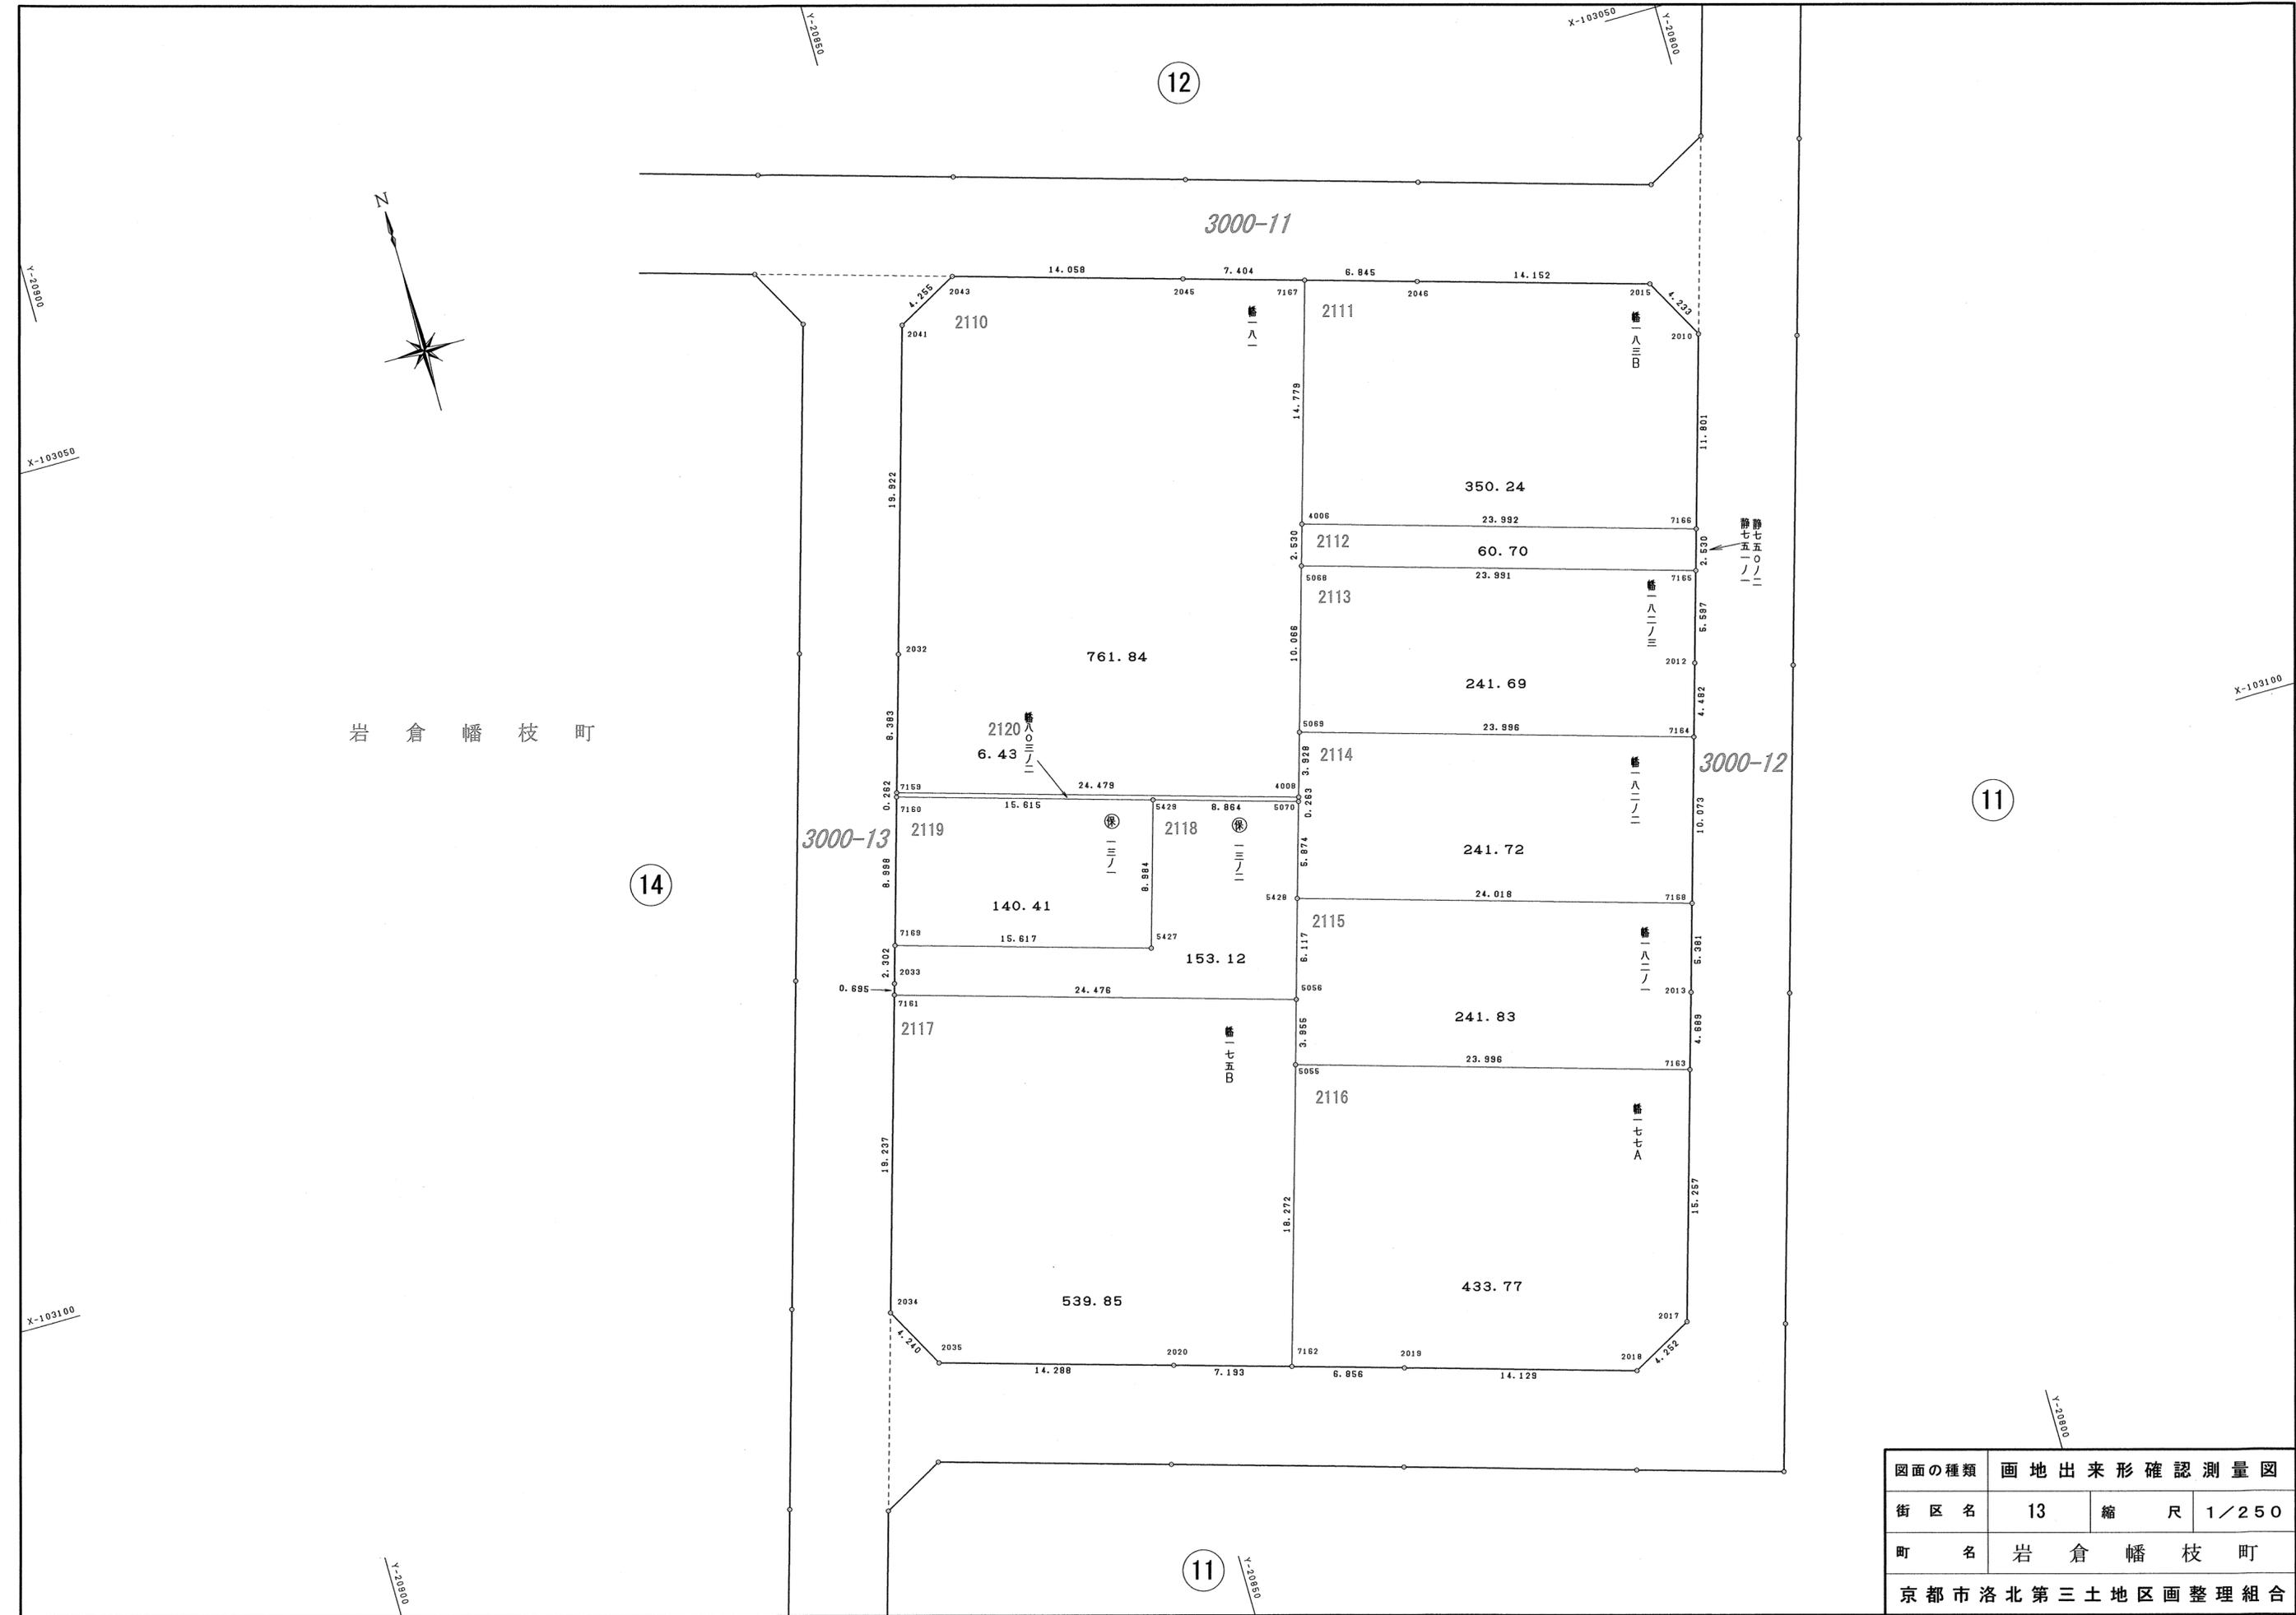

図面の種類	画地出来形確認測量図		
街区名	13	縮尺	1/250
町名	岩倉幡枝町		
京都市洛北第三土地区画整理組合			

2110

地番 幡一八一			
NO	X	Y	辺長
2043	-103053.958	-20845.597	
2041	-103055.971	-20849.346	4.255
2032	-103075.074	-20855.002	19.922
7159	-103083.111	-20857.386	8.383
4008	-103090.076	-20833.918	24.479
5069	-103086.310	-20832.800	3.928
5068	-103076.659	-20829.937	10.066
4006	-103074.233	-20829.219	2.530
7167	-103060.062	-20825.021	14.779
2045	-103057.958	-20832.120	7.404
2043	-103053.958	-20845.597	14.058
面積	761.8499420		
地積	761.84 m <sup>2</sup>		

2111

地番 幡一八三B			
NO	X	Y	辺長
7167	-103060.062	-20825.021	
4006	-103074.233	-20829.219	14.779
7166	-103081.051	-20806.216	23.992
2010	-103069.736	-20802.864	11.801
2015	-103066.017	-20804.886	4.233
2046	-103062.007	-20818.458	14.152
7167	-103060.062	-20825.021	6.845
面積	350.2461625		
地積	350.24 m <sup>2</sup>		

2112

地番 静七五〇ノ二 静七五一ノ一			
NO	X	Y	辺長
4006	-103074.233	-20829.219	
5068	-103076.659	-20829.937	2.530
7165	-103083.477	-20806.935	23.991
7166	-103081.051	-20806.216	2.530
4006	-103074.233	-20829.219	23.992
面積	60.7027980		
地積	60.70 m <sup>2</sup>		

2113

地番 幡一八二ノ三			
NO	X	Y	辺長
5068	-103076.659	-20829.937	
5069	-103086.310	-20832.800	10.066
7164	-103093.142	-20809.797	23.996
2012	-103088.844	-20808.525	4.482
7165	-103083.477	-20806.935	5.597
5068	-103076.659	-20829.937	23.991
面積	241.6912095		
地積	241.69 m <sup>2</sup>		

2114

地番 幡一八二ノ二			
NO	X	Y	辺長
7164	-103093.142	-20809.797	
5069	-103086.310	-20832.800	23.996
4008	-103090.076	-20833.918	3.928
5070	-103090.329	-20833.993	0.263
5428	-103095.957	-20835.676	5.874
7168	-103102.802	-20812.654	24.018
7164	-103093.142	-20809.797	10.073
面積	241.7290445		
地積	241.72 m <sup>2</sup>		

2115

地番 幡一八二ノ一			
NO	X	Y	辺長
7168	-103102.802	-20812.654	
5428	-103095.957	-20835.676	24.018
5056	-103101.824	-20837.407	6.117
5055	-103105.620	-20838.520	3.955
7163	-103112.457	-20815.518	23.996
2013	-103107.962	-20814.181	4.689
7168	-103102.802	-20812.654	5.381
面積	241.8351020		
地積	241.83 m <sup>2</sup>		

2116

地番 幡一七七A			
NO	X	Y	辺長
5055	-103105.620	-20838.520	
7162	-103123.134	-20843.729	18.272
2019	-103125.082	-20837.155	6.856
2018	-103129.102	-20823.609	14.129
2017	-103127.082	-20819.867	4.252
7163	-103112.457	-20815.518	15.257
5055	-103105.620	-20838.520	23.996
面積	433.7786735		
地積	433.77 m <sup>2</sup>		

2117

地番 幡一七五B			
NO	X	Y	辺長
7161	-103094.864	-20860.873	
2034	-103113.307	-20866.346	19.237
2035	-103117.036	-20864.327	4.240
2020	-103121.090	-20850.626	14.288
7162	-103123.134	-20843.729	7.193
5055	-103105.620	-20838.520	18.272
5056	-103101.824	-20837.407	3.955
7161	-103094.864	-20860.873	24.476
面積	539.8520190		
地積	539.85 m <sup>2</sup>		

2118

地番 保一三ノ二			
NO	X	Y	辺長
7161	-103094.864	-20860.873	
5056	-103101.824	-20837.407	24.476
5428	-103095.957	-20835.676	6.117
5070	-103090.329	-20833.993	5.874
5429	-103087.805	-20842.491	8.864
5427	-103096.419	-20845.044	8.984
7169	-103091.990	-20860.020	15.617
2033	-103094.197	-20860.675	2.302
7161	-103094.864	-20860.873	0.695
面積	153.1262530		
地積	153.12 m <sup>2</sup>		

2119

地番 保一三ノ一			
NO	X	Y	辺長
7160	-103083.363	-20857.461	
7169	-103091.990	-20860.020	8.998
5427	-103096.419	-20845.044	15.617
5429	-103087.805	-20842.491	8.984
7160	-103083.363	-20857.461	15.615
面積	140.4118845		
地積	140.41 m <sup>2</sup>		


2120

地番 幡八〇三ノ二			
NO	X	Y	辺長
7159	-103083.111	-20857.386	
7160	-103083.363	-20857.461	0.262
5429	-103087.805	-20842.491	15.615
5070	-103090.329	-20833.993	8.864
4008	-103090.076	-20833.918	0.263
7159	-103083.111	-20857.386	24.479
面積	6.4300005		
地積	6.43 m <sup>2</sup>		

図面の種類	画地出来形確認測量図	
街区名	13	求積表
町名	岩倉幡枝町	
京都市洛北第三土地区画整理組合		



岩倉幡枝町

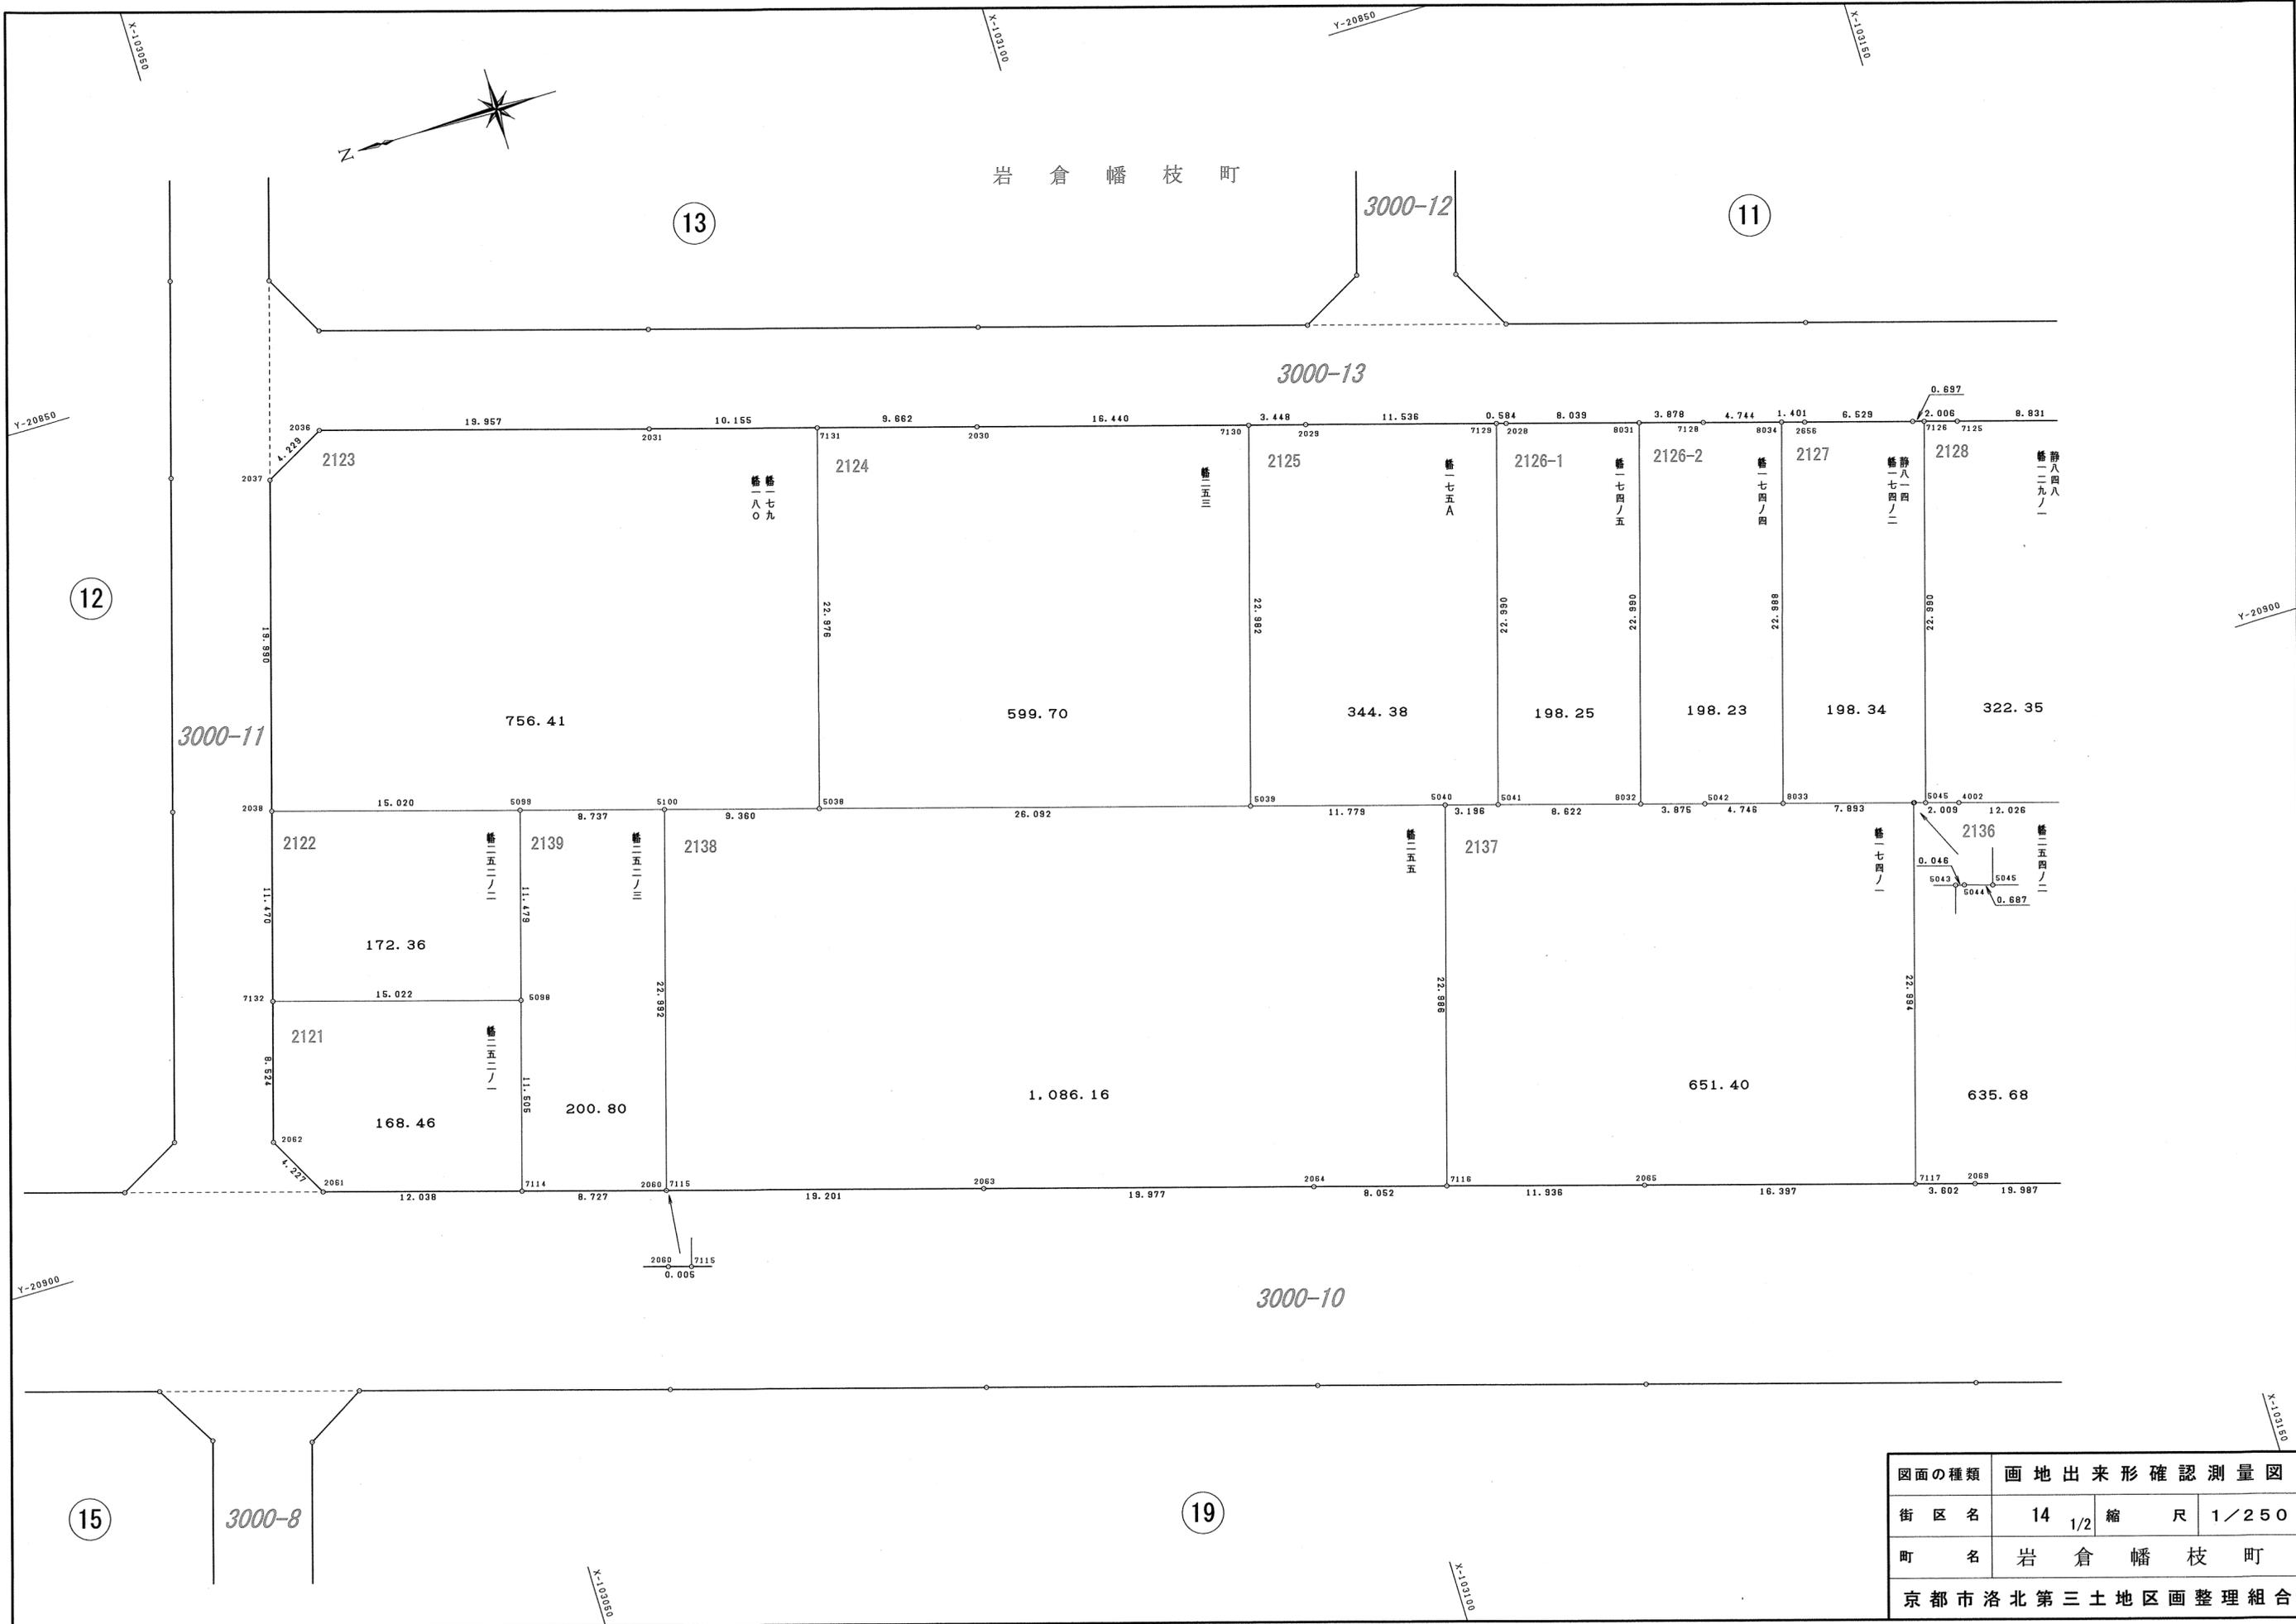


図面の種類	画地出来形確認測量図		
街区名	14	1/2 縮	尺 1/250
町名	岩倉幡枝町		
京都市洛北第三土地区画整理組合			



11

岩倉幡枝町

3000-13

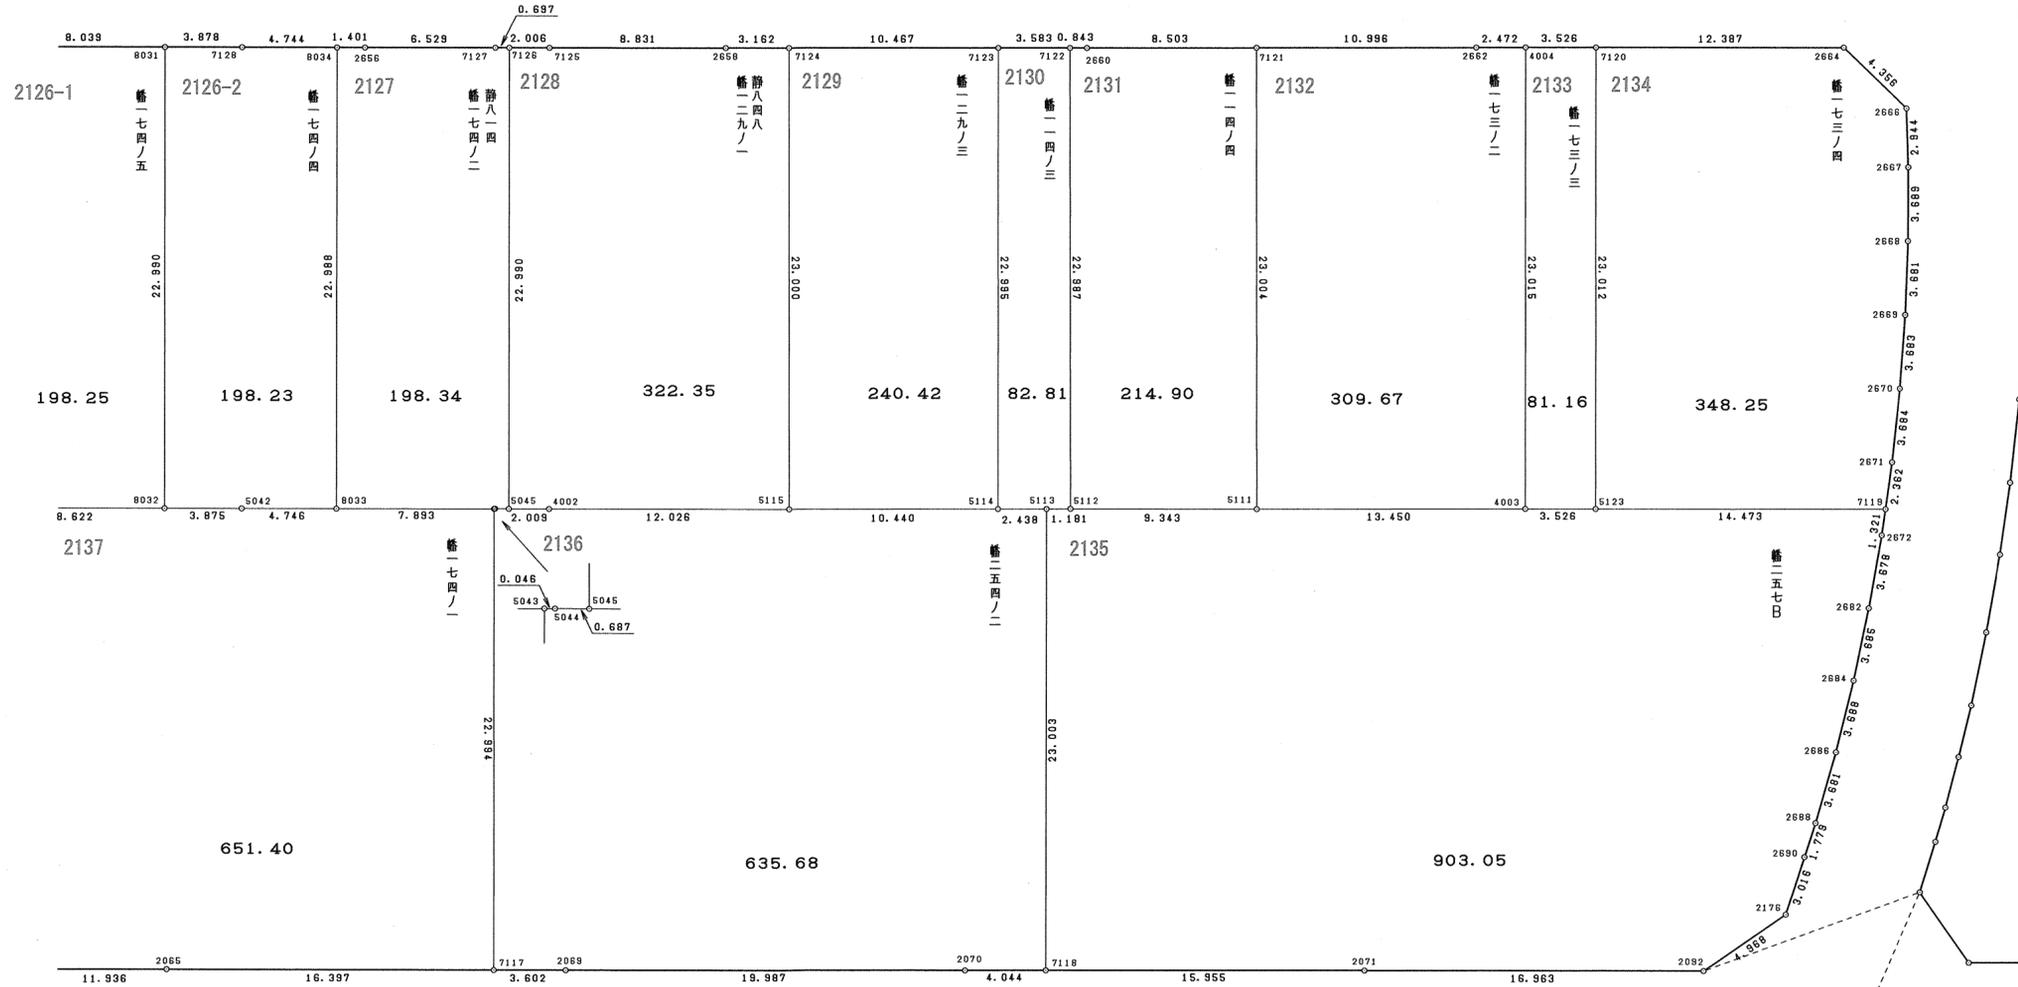

長代川

八幡橋

19

3000-9

図面の種類	画地出来形確認測量図		
街区名	14	縮尺	1/250
町名	岩倉幡枝町		
京都市洛北第三土地区画整理組合			

2121

地番 幡二五二ノ一			
NO	X	Y	辺長
2062	-103039.186	-20895.466	
2061	-103041.199	-20899.184	4.227
7114	-103052.742	-20902.603	12.038
5098	-103056.007	-20891.571	11.505
7132	-103041.607	-20887.293	15.022
2062	-103039.186	-20895.466	8.524
面積	168.4673810		
地積	168.46 m <sup>2</sup>		

2122

地番 幡二五二ノ二			
NO	X	Y	辺長
2038	-103044.864	-20876.295	
7132	-103041.607	-20887.293	11.470
5098	-103056.007	-20891.571	15.022
5099	-103059.265	-20880.564	11.479
2038	-103044.864	-20876.295	15.020
面積	172.3624275		
地積	172.36 m <sup>2</sup>		

2123

地番 幡一七九 幡一八〇			
NO	X	Y	辺長
2036	-103054.260	-20855.116	
2037	-103050.539	-20857.127	4.229
2038	-103044.864	-20876.295	19.990
5099	-103059.265	-20880.564	15.020
5100	-103067.645	-20883.038	8.737
5038	-103076.619	-20885.700	9.360
7131	-103083.134	-20863.666	22.976
2031	-103073.397	-20860.780	10.155
2036	-103054.260	-20855.116	19.957
面積	756.4135070		
地積	756.41 m <sup>2</sup>		

2124

地番 幡二五三			
NO	X	Y	辺長
7131	-103083.134	-20863.666	
5038	-103076.619	-20885.700	22.976
5039	-103101.635	-20893.117	26.092
7130	-103108.161	-20871.081	22.982
2030	-103092.398	-20866.411	16.440
7131	-103083.134	-20863.666	9.662
面積	599.7015030		
地積	599.70 m <sup>2</sup>		

2125

地番 幡一七五A			
NO	X	Y	辺長
7130	-103108.161	-20871.081	
5039	-103101.635	-20893.117	22.982
5040	-103112.928	-20896.469	11.779
5041	-103115.994	-20897.372	3.196
7129	-103122.531	-20875.330	22.990
2029	-103111.468	-20872.060	11.536
7130	-103108.161	-20871.081	3.448
面積	344.3825865		
地積	344.38 m <sup>2</sup>		

2126-1

地番 幡一七四ノ五			
NO	X	Y	辺長
7129	-103122.531	-20875.330	
5041	-103115.994	-20897.372	22.990
8032	-103124.261	-20899.823	8.622
8031	-103130.799	-20877.782	22.990
2028	-103123.091	-20875.496	8.039
7129	-103122.531	-20875.330	0.584
面積	198.2550985		
地積	198.25 m <sup>2</sup>		

2126-2

地番 幡一七四ノ四			
NO	X	Y	辺長
8031	-103130.799	-20877.782	
8032	-103124.261	-20899.823	22.990
5042	-103127.977	-20900.925	3.875
8033	-103132.528	-20902.273	4.746
8034	-103139.066	-20880.234	22.988
7128	-103134.517	-20878.885	4.744
8031	-103130.799	-20877.782	3.878
面積	198.2313525		
地積	198.23 m <sup>2</sup>		

2127

地番 静八一四 幡一七四ノ二			
NO	X	Y	辺長
8034	-103139.066	-20880.234	
8033	-103132.528	-20902.273	22.988
5043	-103140.096	-20904.517	7.893
5044	-103140.142	-20904.523	0.046
5045	-103140.799	-20904.724	0.687
7126	-103147.340	-20882.684	22.990
7127	-103146.671	-20882.486	0.697
2656	-103140.410	-20880.633	6.529
8034	-103139.066	-20880.234	1.401
面積	198.3453820		
地積	198.34 m <sup>2</sup>		

2128

地番 静八四八 幡一二九ノ一			
NO	X	Y	辺長
7126	-103147.340	-20882.684	
5045	-103140.799	-20904.724	22.990
4002	-103142.725	-20905.296	2.009
5115	-103154.255	-20908.717	12.026
7124	-103160.764	-20886.657	23.000
2658	-103157.732	-20885.759	3.162
7125	-103149.264	-20883.253	8.831
7126	-103147.340	-20882.684	2.006
面積	322.3501660		
地積	322.35 m <sup>2</sup>		

2129

地番 幡一二九ノ三			
NO	X	Y	辺長
7124	-103160.764	-20886.657	
5115	-103154.255	-20908.717	23.000
5114	-103164.266	-20911.680	10.440
7123	-103170.800	-20889.632	22.995
7124	-103160.764	-20886.657	10.467
面積	240.4206025		
地積	240.42 m <sup>2</sup>		

2130

地番 幡一一四ノ三			
NO	X	Y	辺長
7123	-103170.800	-20889.632	
5114	-103164.266	-20911.680	22.995
5113	-103166.604	-20912.372	2.438
5112	-103167.739	-20912.700	1.181
7122	-103174.236	-20890.650	22.987
7123	-103170.800	-20889.632	3.583
面積	82.8168430		
地積	82.81 m <sup>2</sup>		

2131

地番 幡一一四ノ四			
NO	X	Y	辺長
7122	-103174.236	-20890.650	
5112	-103167.739	-20912.700	22.987
5111	-103176.695	-20915.364	9.343
7121	-103183.200	-20893.298	23.004
2660	-103175.045	-20890.890	8.503
7122	-103174.236	-20890.650	0.843
面積	214.9017720		
地積	214.90 m <sup>2</sup>		

2132

地番 幡一七三ノ二			
NO	X	Y	辺長
7121	-103183.200	-20893.298	
5111	-103176.695	-20915.364	23.004
4003	-103189.593	-20919.179	13.450
4004	-103196.118	-20897.108	23.015
2662	-103193.746	-20896.412	2.472
7121	-103183.200	-20893.298	10.996
面積	309.6754395		
地積	309.67 m <sup>2</sup>		

2133

地番 幡一七三ノ三			
NO	X	Y	辺長
4004	-103196.118	-20897.108	
4003	-103189.593	-20919.179	23.015
5123	-103192.975	-20920.179	3.526
7120	-103199.499	-20898.111	23.012
4004	-103196.118	-20897.108	3.526
面積	81.1623010		
地積	81.16 m <sup>2</sup>		

2134

地番 幡一七三ノ四			
NO	X	Y	辺長
7120	-103199.499	-20898.111	
5123	-103192.975	-20920.179	23.012
7119	-103206.855	-20924.282	14.473
2671	-103207.832	-20922.131	2.362
2670	-103209.248	-20918.730	3.684
2669	-103210.548	-20915.284	3.683
2668	-103211.724	-20911.795	3.681
2667	-103212.778	-20908.259	3.689
2666	-103213.525	-20905.411	2.944
2664	-103211.379	-20901.620	4.356
7120	-103199.499	-20898.111	12.387
面積	348.2590505		
地積	348.25 m <sup>2</sup>		

2135

地番 幡二五七B			
NO	X	Y	辺長
7118	-103160.058	-20934.424	
2071	-103175.356	-20938.956	15.955
2092	-103191.616	-20943.790	16.963
2176	-103196.339	-20942.248	4.968
2690	-103198.062	-20939.772	3.016
2688	-103199.072	-20938.307	1.779
2686	-103201.046	-20935.200	3.681
2684	-103202.914	-20932.019	3.688
2682	-103204.659	-20928.773	3.685
2672	-103206.309	-20925.485	3.678
7119	-103206.855	-20924.282	1.321
5123	-103192.975	-20920.179	14.473
4003	-103189.593	-20919.179	3.526
5111	-103176.695	-20915.364	13.450
5112	-103167.739	-20912.700	9.343
5113	-103166.604	-20912.372	1.181
7118	-103160.058	-20934.424	23.003
面積	903.0578930		
地積	903.05 m <sup>2</sup>		

2136

地番 幡二五四ノ二			
NO	X	Y	辺長
7117	-103133.564	-20926.564	
2069	-103137.018	-20927.589	3.602
2070	-103156.180	-20933.275	19.987
7118	-103160.058	-20934.424	4.044
5113	-103166.604	-20912.372	23.003
5114	-103164.266	-20911.680	2.438
5115	-103154.255	-20908.717	10.440
4002	-103142.725	-20905.296	12.026
5045	-103140.799	-20904.724	2.009
5044	-103140.142	-20904.523	0.687
5043	-103140.096	-20904.517	0.046
7117	-103133.564	-20926.564	22.994
面積	635.6876020		
地積	635.68 m <sup>2</sup>		

2137

地番 幡一七四ノ一			
NO	X	Y	辺長
7116	-103106.399	-20918.509	
2065	-103117.845	-20921.897	11.936
7117	-103133.564	-20926.564	16.397
5043	-103140.096	-20904.517	22.994
5042	-103127.977	-20900.925	12.640
5041	-103115.994	-20897.372	12.498
5040	-103112.928	-20896.469	3.196
7116	-103106.399	-20918.509	22.986
面積	651.4071050		
地積	651.40 m <sup>2</sup>		

2138

地番 幡二五五			
NO	X	Y	辺長
7115	-103061.115	-20905.084	
2063	-103079.522	-20910.552	19.201
2064	-103098.677	-20916.	



2033

地番 幡二四六			
NO	X	Y	辺長
1690	-102960.364	-21007.650	
2148	-102962.659	-21011.225	4.248
2149	-102981.250	-21015.376	19.048
7085	-102983.623	-21015.905	2.431
5186	-102987.112	-21000.275	16.014
5194	-102990.908	-20983.271	17.422
5195	-102991.056	-20982.571	0.715
7099	-102967.545	-20977.331	24.087
1689	-102964.485	-20989.174	12.231
1690	-102960.364	-21007.650	18.930
面積	829.6757275		
地積	829.67 m <sup>2</sup>		

2034

地番 静八三五A			
NO	X	Y	辺長
7099	-102967.545	-20977.331	
5195	-102991.056	-20982.571	24.087
5212	-102994.181	-20968.586	14.329
7098	-102971.133	-20963.452	23.612
1688	-102968.239	-20974.643	11.559
7099	-102967.545	-20977.331	2.776
面積	341.7464185		
地積	341.74 m <sup>2</sup>		

2035

地番 幡二三八			
NO	X	Y	辺長
7098	-102971.133	-20963.452	
5212	-102994.181	-20968.586	23.613
5020	-102995.016	-20964.883	3.795
5019	-102996.200	-20959.514	5.498
7097	-102973.271	-20954.412	23.489
1687	-102971.997	-20960.108	5.836
7098	-102971.133	-20963.452	3.453
面積	218.5404565		
地積	218.54 m <sup>2</sup>		

2036

地番 幡二四八ノ二			
NO	X	Y	辺長
7097	-102973.271	-20954.412	
5019	-102996.200	-20959.514	23.489
4014	-102997.023	-20955.843	3.762
7096	-102974.093	-20950.741	23.490
7097	-102973.271	-20954.412	3.761
面積	88.3705895		
地積	88.37 m <sup>2</sup>		

2037

地番 幡二三五 幡二三七			
NO	X	Y	辺長
7096	-102974.093	-20950.741	
4014	-102997.023	-20955.843	23.490
5018	-102997.406	-20954.132	1.753
5017	-102999.814	-20943.364	11.033
5097	-103000.676	-20939.473	3.985
7095	-102977.755	-20934.375	23.481
1686	-102976.365	-20940.585	6.363
7096	-102974.093	-20950.741	10.407
面積	393.8551635		
地積	393.95 m <sup>2</sup>		

2038

地番 幡二三六			
NO	X	Y	辺長
7095	-102977.755	-20934.375	
5097	-103000.676	-20939.473	23.481
5096	-103003.848	-20925.226	14.596
7094	-102980.943	-20920.125	23.466
1685	-102980.734	-20921.065	0.962
7095	-102977.755	-20934.375	13.639
面積	342.6830555		
地積	342.68 m <sup>2</sup>		

2039

地番 幡二八四 幡二八五 幡二八八			
NO	X	Y	辺長
7094	-102980.943	-20920.125	
5096	-103003.848	-20925.226	23.466
4033	-103004.289	-20923.252	2.022
5095	-103005.390	-20918.329	5.044
5094	-103005.690	-20916.976	1.385
7092	-102982.783	-20911.864	23.470
7093	-102982.481	-20913.220	1.389
7094	-102980.943	-20920.125	7.074
面積	198.5088880		
地積	198.50 m <sup>2</sup>		

2040

地番 幡二三四			
NO	X	Y	辺長
7092	-102982.783	-20911.864	
5094	-103005.690	-20916.976	23.470
7091	-103009.004	-20902.176	15.166
2052	-102992.412	-20897.258	17.305
1684	-102985.079	-20901.554	8.498
7092	-102982.783	-20911.864	10.562
面積	355.7012780		
地積	355.70 m <sup>2</sup>		

2041

地番 幡二五〇ノ一			
NO	X	Y	辺長
4033	-103004.289	-20923.252	
7090	-103026.741	-20928.252	23.002
2055	-103030.458	-20911.636	17.026
2054	-103028.238	-20907.873	4.369
2053	-103010.315	-20902.565	18.692
7091	-103009.004	-20902.176	1.367
5094	-103005.690	-20916.976	15.166
5095	-103005.390	-20918.329	1.385
4033	-103004.289	-20923.252	5.044
面積	474.0919450		
地積	474.09 m <sup>2</sup>		

2042

地番 幡二五〇ノ二			
NO	X	Y	辺長
5017	-102999.814	-20943.364	
5015	-103022.253	-20948.367	22.989
2165	-103022.503	-20947.244	1.150
2166	-103026.421	-20929.682	17.993
7090	-103026.741	-20928.252	1.465
4033	-103004.289	-20923.252	23.002
5096	-103003.848	-20925.226	2.022
5097	-103000.676	-20939.473	14.595
5017	-102999.814	-20943.364	3.985
面積	473.9061395		
地積	473.90 m <sup>2</sup>		

2043

地番 保一五ノ二			
NO	X	Y	辺長
5026	-103019.854	-20959.135	
5015	-103022.253	-20948.367	11.032
5017	-102999.814	-20943.364	22.989
5018	-102997.406	-20954.132	11.033
5026	-103019.854	-20959.135	22.998
面積	253.6963185		
地積	253.69 m <sup>2</sup>		

2044

地番 保一五ノ一			
NO	X	Y	辺長
5025	-103019.199	-20962.063	
2164	-103019.845	-20959.174	2.960
5026	-103019.854	-20959.135	0.040
5018	-102997.406	-20954.132	22.998
5014	-102997.023	-20955.843	1.753
5019	-102996.200	-20959.514	3.762
5020	-102995.016	-20964.883	5.498
5021	-103003.785	-20966.855	8.988
5022	-103005.532	-20959.017	8.030
5025	-103019.199	-20962.063	14.002
面積	141.1651245		
地積	141.16 m <sup>2</sup>		

2045

地番 保一五ノ四			
NO	X	Y	辺長
5024	-103017.442	-20969.917	
5025	-103019.199	-20962.063	8.048
5022	-103005.532	-20959.017	14.002
5021	-103003.785	-20966.855	8.030
5024	-103017.442	-20969.917	13.996
面積	112.5426600		
地積	112.54 m <sup>2</sup>		

2046

地番 幡二四七ノ一			
NO	X	Y	辺長
5194	-102990.908	-20983.271	
7089	-103013.342	-20988.286	22.987
2173	-103015.701	-20977.704	10.841
5024	-103017.442	-20969.917	7.979
5021	-103003.785	-20966.855	13.996
5020	-102995.016	-20964.883	8.988
5212	-102994.181	-20968.586	3.795
5195	-102991.056	-20982.571	14.329
5194	-102990.908	-20983.271	0.715
面積	432.9128635		
地積	432.91 m <sup>2</sup>		

2047

地番 幡二三三			
NO	X	Y	辺長
5186	-102987.112	-21000.275	
5426	-102995.517	-21002.158	8.613
5187	-102997.178	-21002.529	1.701
7088	-103009.555	-21005.287	12.680
2156	-103011.570	-20996.237	8.271
7089	-103013.342	-20988.286	8.146
5194	-102990.908	-20983.271	22.987
5186	-102987.112	-21000.275	17.422
面積	400.5841830		
地積	400.58 m <sup>2</sup>		


2048

地番 幡二六九ノ一 幡二六九ノ三			
NO	X	Y	辺長
7087	-102993.687	-21018.151	
2150	-102999.845	-21019.525	6.309
2151	-103002.402	-21017.904	3.027
2154	-103004.911	-21016.313	2.970
2155	-103007.462	-21014.683	3.027
7088	-103009.555	-21005.287	9.626
5187	-102997.178	-21002.529	12.680
5426	-102995.517	-21002.158	1.701
7086	-102992.030	-21017.781	16.007
7087	-102993.687	-21018.151	1.697
面積	209.9607560		
地積	209.96 m <sup>2</sup>		

2049

地番 幡二六九ノ二			
NO	X	Y	辺長
7085	-102983.623	-21015.905	
7086	-102992.030	-21017.781	8.613
5426	-102995.517	-21002.158	16.007
5186	-102987.112	-21000.275	8.613
7085	-102983.623	-21015.905	16.014
面積	137.9120550		
地積	137.91 m <sup>2</sup>		

図面の種類	画地出来形確認測量図		
街区名	15	求積表	
町名	岩倉幡枝町		
京都市洛北第三土地区画整理組合			

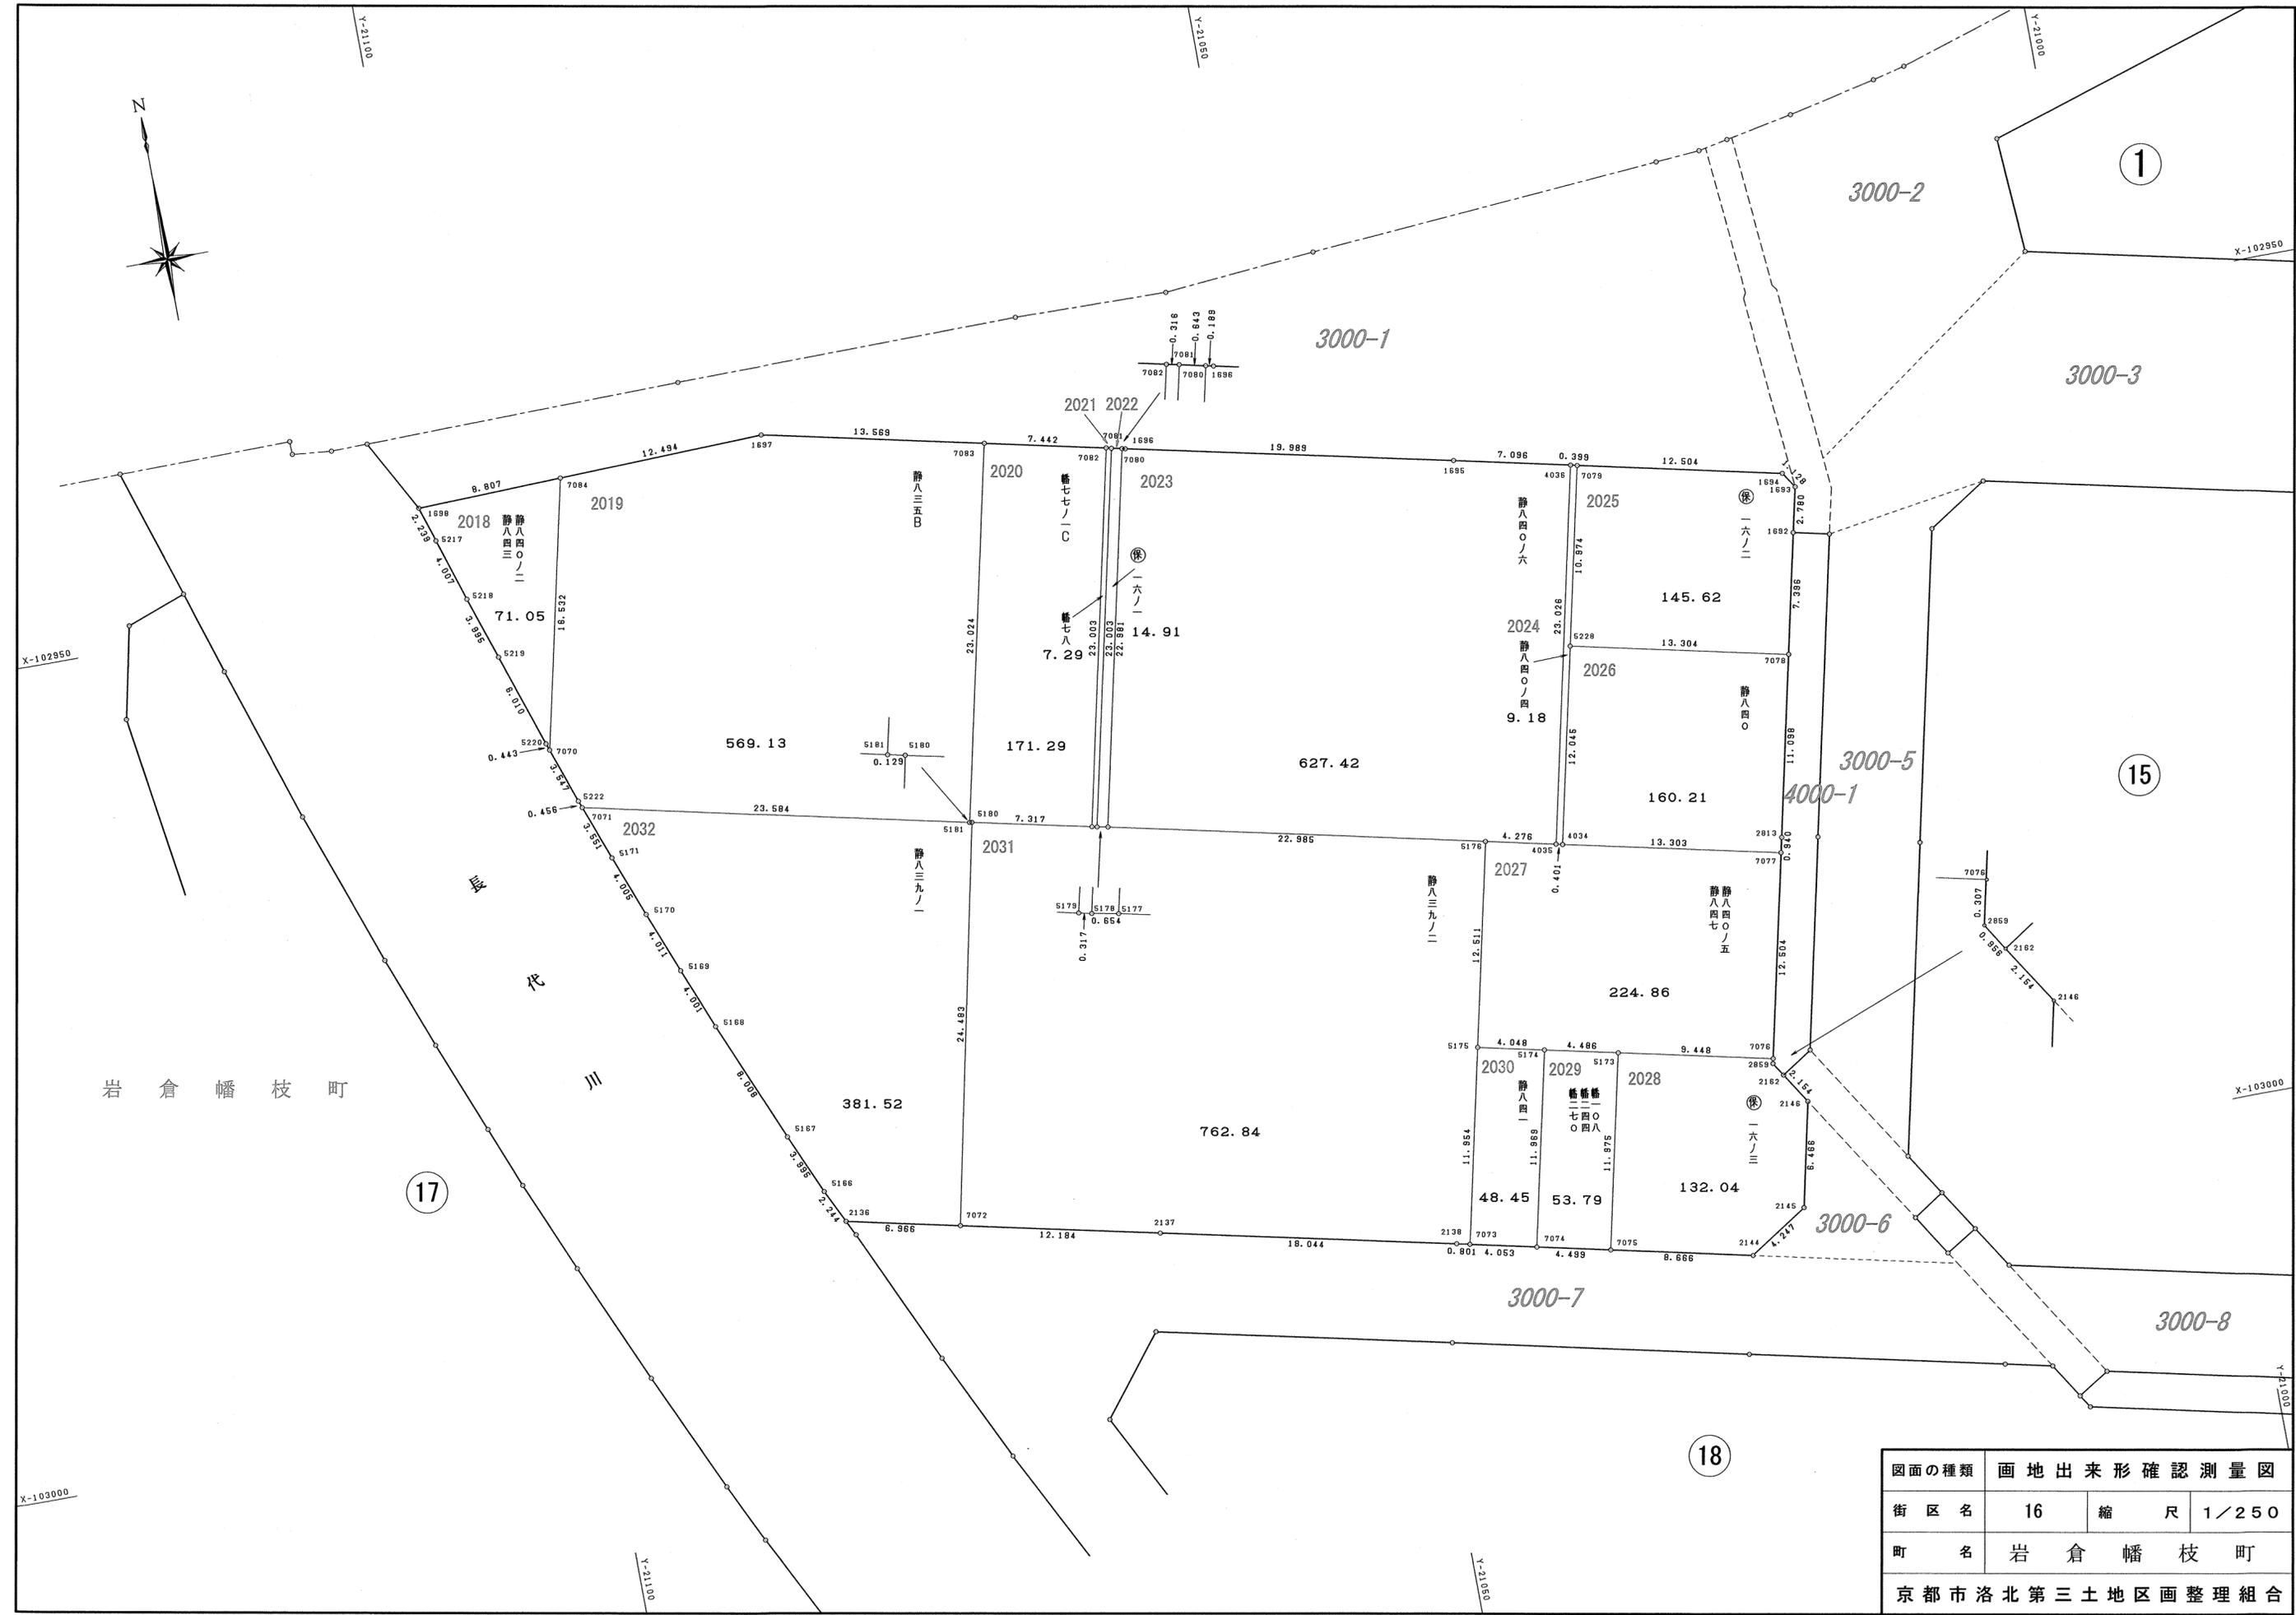

図面の種類	画地出来形確認測量図		
街区名	16	縮尺	1/250
町名	岩倉幡枝町		
京都市洛北第三土地区画整理組合			

2018

地番 静八四〇ノ二 静八四三			
N O	X	Y	辺長
1698	-102944.791	-21101.522	
5217	-102946.925	-21100.842	2.239
5218	-102950.746	-21099.634	4.007
5219	-102954.542	-21098.386	3.995
5220	-102960.244	-21096.484	6.010
7070	-102960.663	-21096.339	0.443
7084	-102944.532	-21092.718	16.532
1698	-102944.791	-21101.522	8.807
面積	71.0593810		
地積	71.05 m <sup>2</sup>		

2019

地番 静八三五B			
N O	X	Y	辺長
7084	-102944.532	-21092.718	
7070	-102960.663	-21096.339	16.532
5222	-102964.016	-21095.179	3.547
7071	-102964.444	-21095.021	0.456
5181	-102969.602	-21072.007	23.584
7083	-102947.131	-21066.988	23.024
1697	-102944.164	-21080.229	13.569
7084	-102944.532	-21092.718	12.494
面積	569.1346785		
地積	569.13 m <sup>2</sup>		

2020

地番 幡七七ノ-C			
N O	X	Y	辺長
7083	-102947.131	-21066.988	
5181	-102969.602	-21072.007	23.024
5180	-102969.622	-21071.879	0.129
5179	-102971.210	-21064.736	7.317
7082	-102948.759	-21059.726	23.003
7083	-102947.131	-21066.988	7.442
面積	171.2961155		
地積	171.29 m <sup>2</sup>		

2021

地番 幡七八			
N O	X	Y	辺長
7082	-102948.759	-21059.726	
5179	-102971.210	-21064.736	23.003
5178	-102971.280	-21064.426	0.317
7081	-102948.828	-21059.417	23.003
7082	-102948.759	-21059.726	0.316
面積	7.2968995		
地積	7.29 m <sup>2</sup>		

2022

地番 保一六ノ一			
N O	X	Y	辺長
7081	-102948.828	-21059.417	
5178	-102971.280	-21064.426	23.003
5177	-102971.400	-21063.783	0.654
7080	-102948.968	-21058.789	22.981
7081	-102948.828	-21059.417	0.643
面積	14.9120860		
地積	14.91 m <sup>2</sup>		

2023

地番 静八四〇ノ六			
N O	X	Y	辺長
7080	-102948.968	-21058.789	
5177	-102971.400	-21063.783	22.981
5176	-102976.425	-21041.353	22.985
4035	-102977.355	-21037.179	4.276
4036	-102954.882	-21032.162	23.026
1695	-102953.337	-21039.088	7.096
1696	-102949.010	-21058.604	19.989
7080	-102948.968	-21058.789	0.189
面積	627.4264655		
地積	627.42 m <sup>2</sup>		

2024

地番 静八四〇ノ四			
N O	X	Y	辺長
4036	-102954.882	-21032.162	
4035	-102977.355	-21037.179	23.026
4034	-102977.443	-21036.787	0.401
5228	-102965.686	-21034.167	12.045
7079	-102954.976	-21031.774	10.974
4036	-102954.882	-21032.162	0.399
面積	9.1825145		
地積	9.18 m <sup>2</sup>		

2025

地番 保一六ノ二			
N O	X	Y	辺長
7079	-102954.976	-21031.774	
5228	-102965.686	-21034.167	10.974
7078	-102968.586	-21021.182	13.304
1692	-102961.367	-21019.573	7.396
1693	-102958.656	-21018.956	2.780
1694	-102957.710	-21019.572	1.128
7079	-102954.976	-21031.774	12.504
面積	145.6251470		
地積	145.62 m <sup>2</sup>		

2026

地番 静八四〇			
N O	X	Y	辺長
5228	-102965.686	-21034.167	
4034	-102977.443	-21036.787	12.045
7077	-102980.337	-21023.802	13.303
2813	-102979.419	-21023.597	0.940
7078	-102968.586	-21021.182	11.098
5228	-102965.686	-21034.167	13.304
面積	160.2177275		
地積	160.21 m <sup>2</sup>		

2027

地番 静八四〇ノ五 静八四七			
N O	X	Y	辺長
5176	-102976.425	-21041.353	
5175	-102988.635	-21044.081	12.511
5174	-102989.507	-21040.128	4.049
5173	-102990.485	-21035.749	4.486
7076	-102992.541	-21026.527	9.448
7077	-102980.337	-21023.802	12.504
4034	-102977.443	-21036.787	13.303
4035	-102977.355	-21037.179	0.401
5176	-102976.425	-21041.353	4.276
面積	224.8615500		
地積	224.86 m <sup>2</sup>		

2028

地番 保一六ノ三			
N O	X	Y	辺長
5173	-102990.485	-21035.749	
7075	-103002.174	-21038.351	11.975
2144	-103004.072	-21029.895	8.666
2145	-103001.781	-21026.318	4.247
2146	-102995.466	-21024.925	6.466
2162	-102993.649	-21026.082	2.154
2859	-102992.841	-21026.594	0.956
7076	-102992.541	-21026.527	0.307
5173	-102990.485	-21035.749	9.448
面積	132.0422985		
地積	132.04 m <sup>2</sup>		

2029

地番 幡一〇八 幡二四四 幡二七〇			
N O	X	Y	辺長
5174	-102989.507	-21040.128	
7074	-103001.188	-21042.741	11.969
7075	-103002.174	-21038.351	4.499
5173	-102990.485	-21035.749	11.975
5174	-102989.507	-21040.128	4.486
面積	53.7934475		
地積	53.79 m <sup>2</sup>		

2030

地番 静八四一			
N O	X	Y	辺長
5175	-102988.635	-21044.081	
7073	-103000.300	-21046.696	11.954
7074	-103001.188	-21042.741	4.053
5174	-102989.507	-21040.128	11.969
5175	-102988.635	-21044.081	4.048
面積	48.4553620		
地積	48.45 m <sup>2</sup>		


2031

地番 静八三九ノ二			
N O	X	Y	辺長
5180	-102969.622	-21071.879	
7072	-102993.567	-21076.987	24.483
2137	-102996.214	-21065.094	12.184
2138	-103000.125	-21047.478	18.044
7073	-103000.300	-21046.696	0.801
5175	-102988.635	-21044.081	11.954
5176	-102976.425	-21041.353	12.511
5177	-102971.400	-21063.783	22.985
5178	-102971.280	-21064.426	0.654
5179	-102971.210	-21064.736	0.317
5180	-102969.622	-21071.879	7.317
面積	762.8460170		
地積	762.84 m <sup>2</sup>		

2032

地番 静八三九ノ一			
N O	X	Y	辺長
7071	-102964.444	-21095.021	
5171	-102967.775	-21093.780	3.551
5170	-102971.520	-21092.369	4.005
5169	-102975.257	-21090.911	4.011
5168	-102978.976	-21089.435	4.001
5167	-102986.365	-21086.347	8.008
5166	-102990.030	-21084.757	3.995
2136	-102992.054	-21083.787	2.244
7072	-102993.567	-21076.987	6.966
5180	-102969.622	-21071.879	24.483
5181	-102969.602	-21072.007	0.129
7071	-102964.444	-21095.021	23.584
面積	381.5239960		
地積	381.52 m <sup>2</sup>		

図面の種類	画地出来形確認測量図	
街区名	16	求積表
町名	岩倉幡枝町	
京都市洛北第三土地区画整理組合		

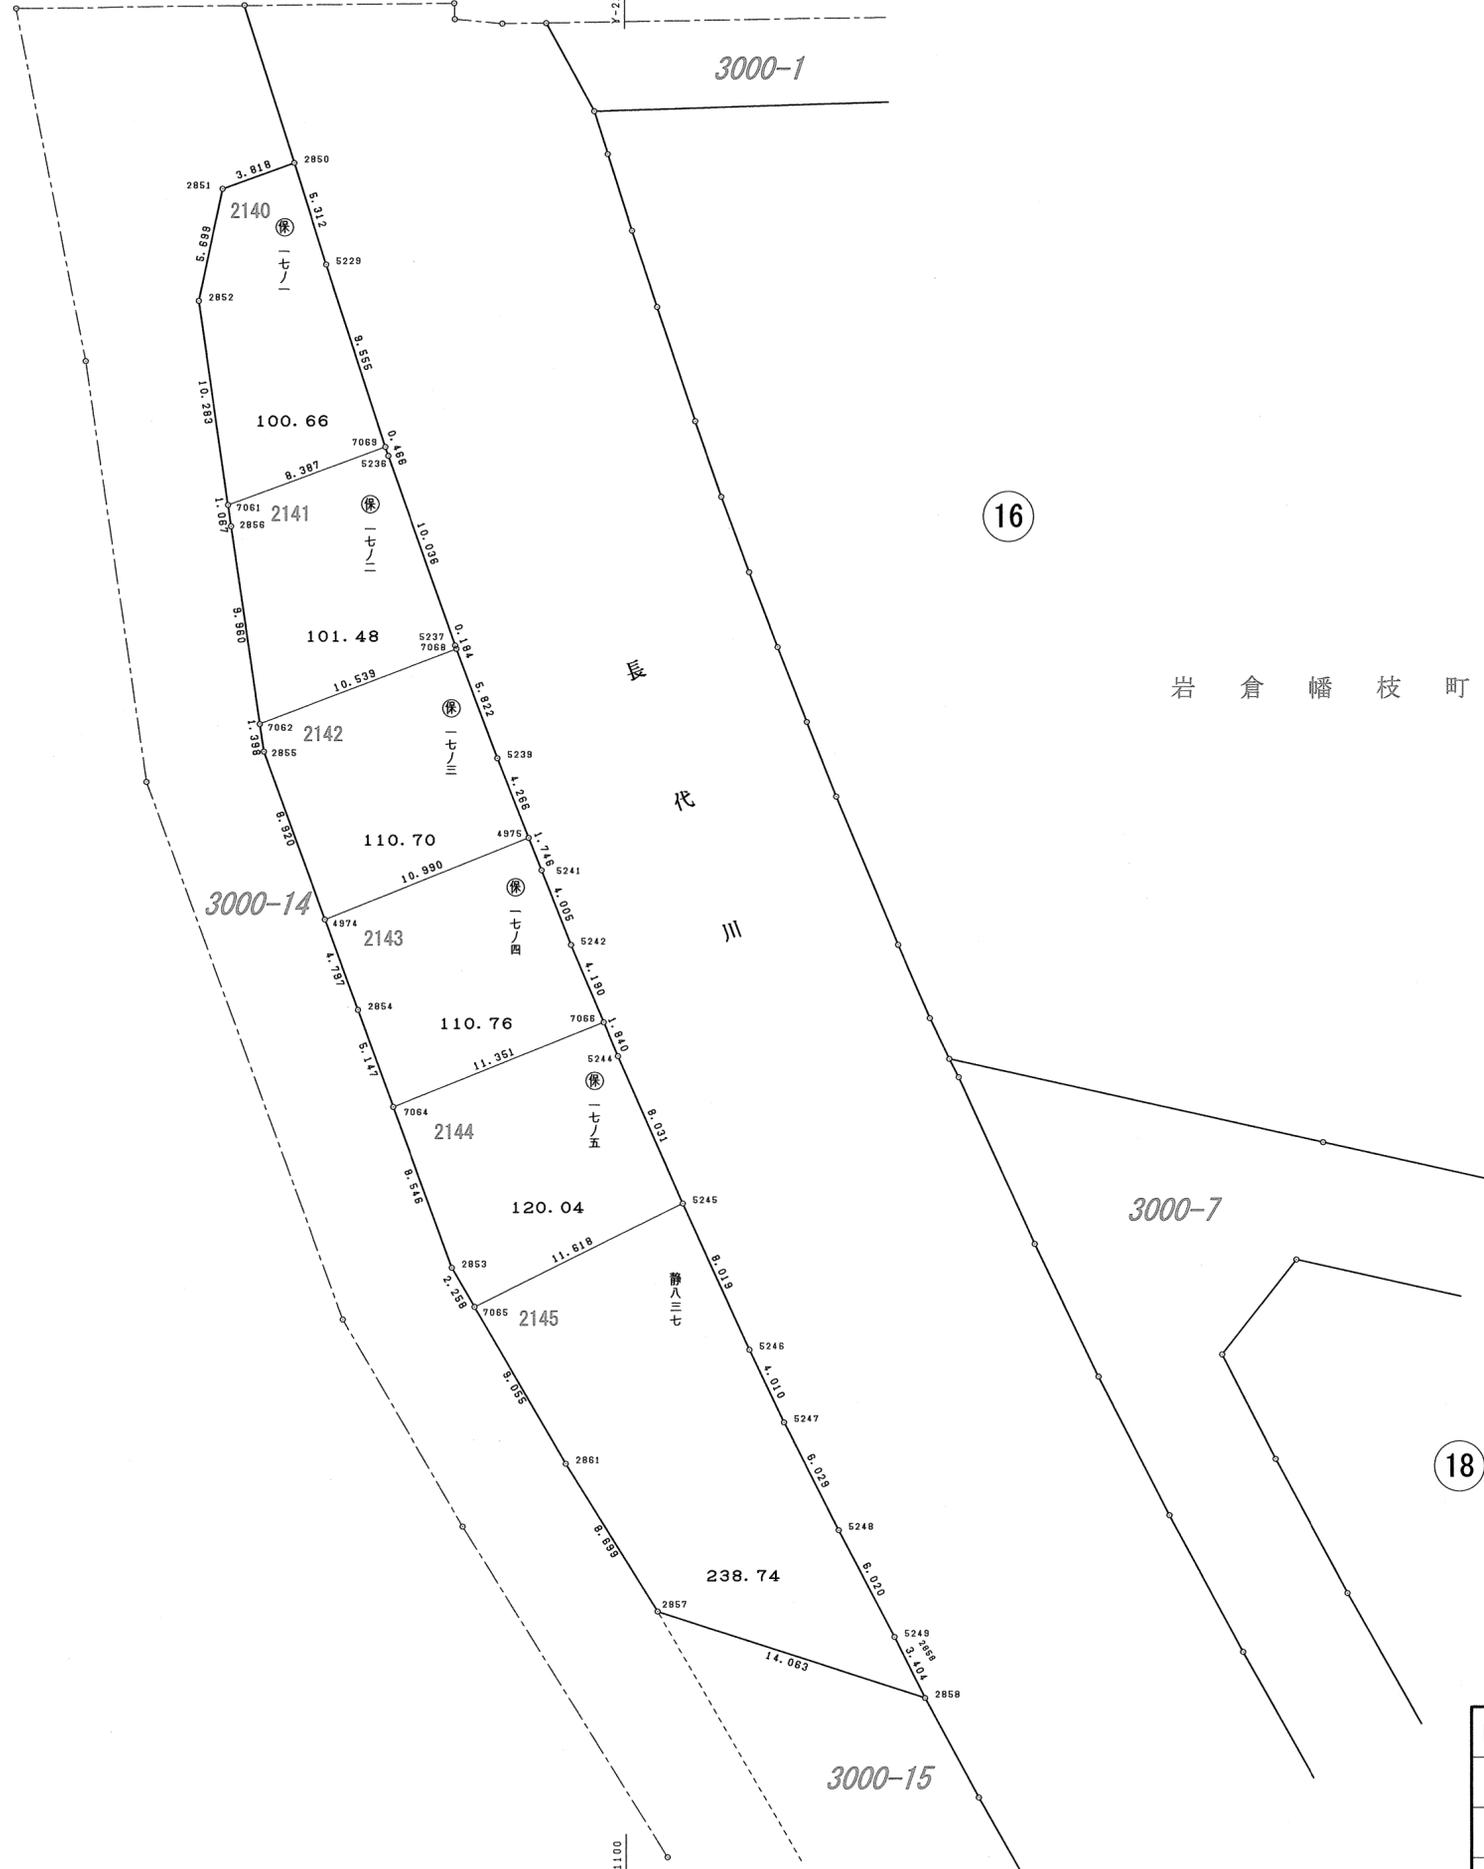

16

18

図面の種類	画地出来形確認測量図		
街区名	17	縮尺	1/250
町名	岩倉幡枝町		
京都市洛北第三土地区画整理組合			

2140

地番 保一七ノ一			
NO	X	Y	辺長
2850	-102947.343	-21116.548	
2851	-102948.638	-21120.140	3.818
2852	-102954.210	-21121.337	5.699
7061	-102964.389	-21119.878	10.283
7069	-102961.500	-21112.004	8.387
5229	-102952.412	-21114.957	9.555
2850	-102947.343	-21116.548	5.312
面積	100.6603890		
地積	100.66 m <sup>2</sup>		

2141

地番 保一七ノ二			
NO	X	Y	辺長
7061	-102964.389	-21119.878	
2856	-102965.446	-21119.726	1.067
7062	-102975.304	-21118.299	9.960
7068	-102971.576	-21108.441	10.539
5237	-102971.403	-21108.506	0.184
5236	-102961.944	-21111.860	10.036
7069	-102961.500	-21112.004	0.466
7061	-102964.389	-21119.878	8.387
面積	101.4814075		
地積	101.48 m <sup>2</sup>		

2142

地番 保一七ノ三			
NO	X	Y	辺長
7062	-102975.304	-21118.299	
2855	-102976.688	-21118.099	1.398
4974	-102985.069	-21115.044	8.920
4975	-102980.999	-21104.835	10.990
5239	-102977.029	-21106.399	4.266
7068	-102971.576	-21108.441	5.822
7062	-102975.304	-21118.299	10.539
面積	110.7020025		
地積	110.70 m <sup>2</sup>		

2143

地番 保一七ノ四			
NO	X	Y	辺長
4974	-102985.069	-21115.044	
2854	-102989.576	-21113.400	4.797
7064	-102994.411	-21111.635	5.147
7066	-102990.209	-21101.090	11.351
5242	-102986.349	-21102.721	4.190
5241	-102982.624	-21104.194	4.005
4975	-102980.999	-21104.835	1.746
4974	-102985.069	-21115.044	10.990
面積	110.7687265		
地積	110.76 m <sup>2</sup>		


2144

地番 保一七ノ五			
NO	X	Y	辺長
7064	-102994.411	-21111.635	
2853	-103002.439	-21108.704	8.546
7065	-103004.390	-21107.567	2.258
5245	-102999.257	-21097.144	11.618
5244	-102991.904	-21100.374	8.031
7066	-102990.209	-21101.090	1.840
7064	-102994.411	-21111.635	11.351
面積	120.0418830		
地積	120.04 m <sup>2</sup>		

2145

地番 静八三七			
NO	X	Y	辺長
7065	-103004.390	-21107.567	
2861	-103012.214	-21103.007	9.055
2857	-103019.598	-21098.408	8.699
2858	-103023.917	-21085.024	14.063
5249	-103020.877	-21086.556	3.404
5248	-103015.544	-21089.349	6.020
5247	-103010.170	-21092.083	6.029
5246	-103006.552	-21093.813	4.010
5245	-102999.257	-21097.144	8.019
7065	-103004.390	-21107.567	11.618
面積	238.7402655		
地積	238.74 m <sup>2</sup>		

図面の種類	画地出来形確認測量図		
街区名	17	求積表	
町名	岩倉幡枝町		
京都市洛北第三土地区画整理組合			

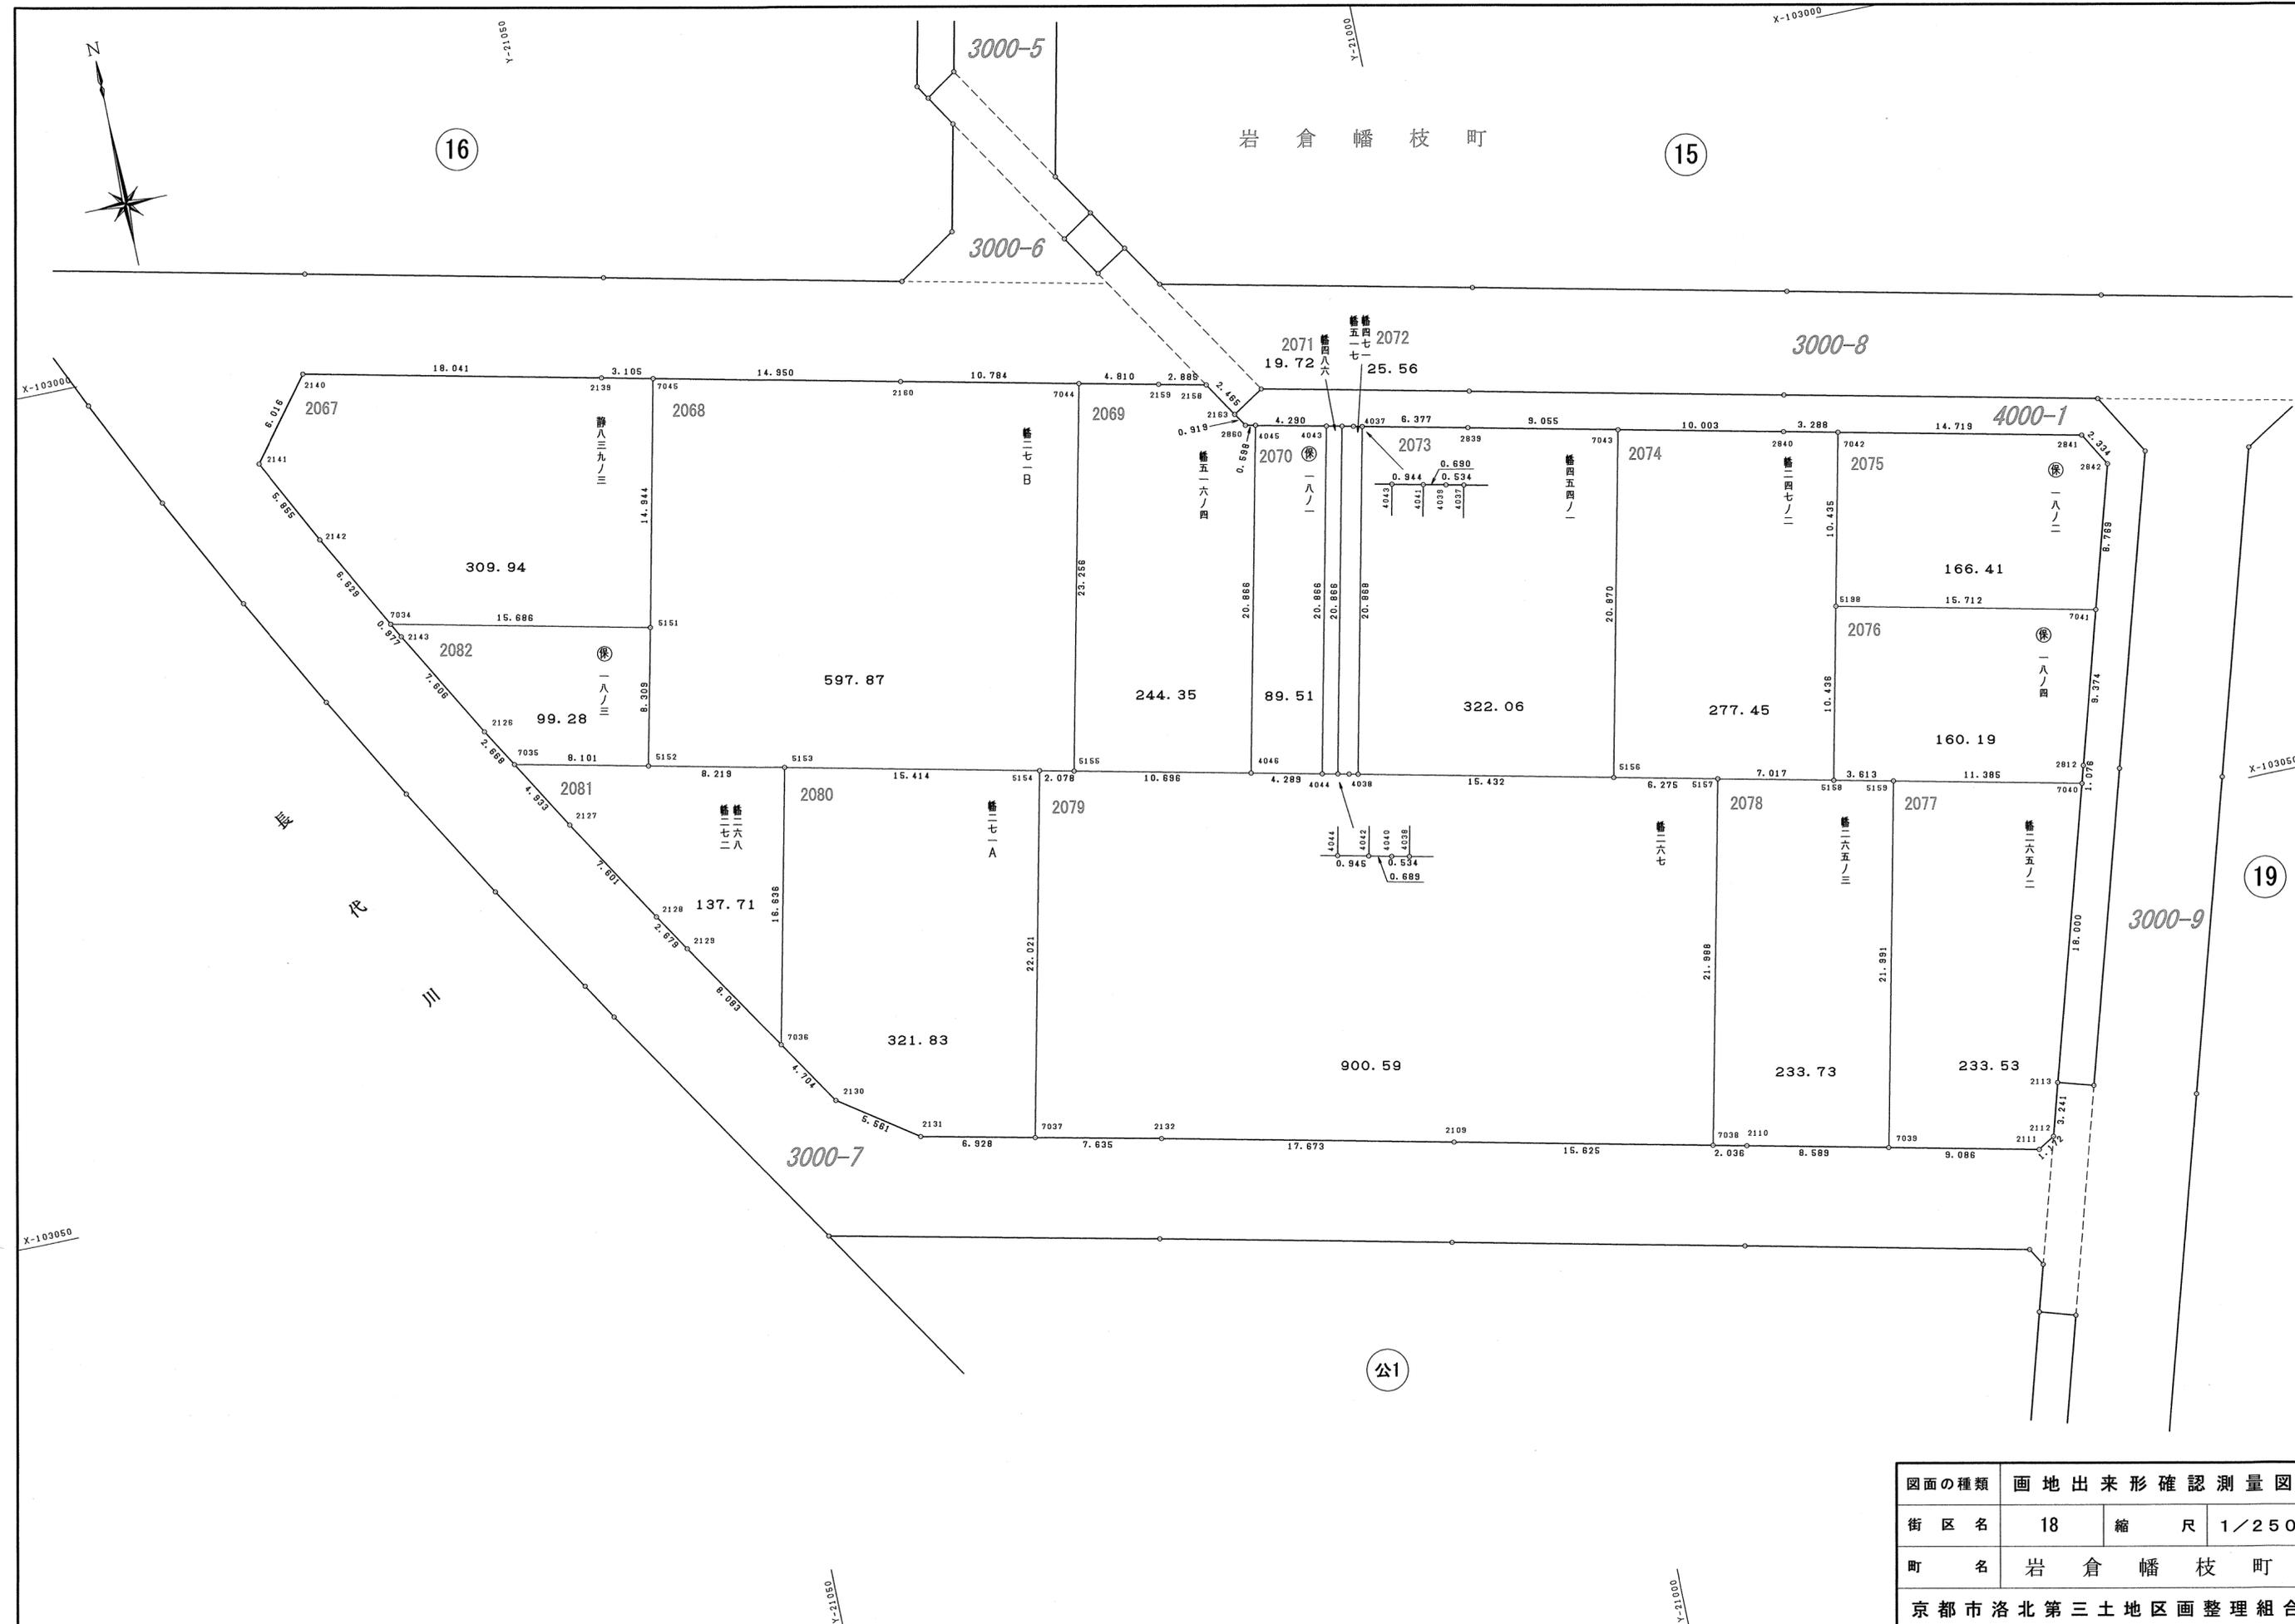

図面の種類	画地出来形確認測量図		
街区名	18	縮尺	1/250
町名	岩倉幡枝町		
京都市洛北第三土地区画整理組合			

2067

地番 静八三九ノ三			
NO	X	Y	辺長
2140	-103002.064	-21066.442	
2141	-103006.795	-21070.159	6.016
2142	-103012.006	-21067.488	5.855
7034	-103017.841	-21064.342	6.629
5151	-103021.253	-21049.031	15.686
7045	-103006.662	-21045.801	14.944
2139	-103005.983	-21048.831	3.105
2140	-103002.064	-21066.442	18.041
面積	309.9454235		
地積	309.94 m <sup>2</sup>		

2068

地番 幡二七一B			
NO	X	Y	辺長
7045	-103006.662	-21045.801	
5151	-103021.253	-21049.031	14.944
5152	-103029.360	-21050.853	8.309
5153	-103031.151	-21042.831	8.219
5154	-103034.519	-21027.789	15.414
5155	-103034.974	-21025.761	2.078
7044	-103012.278	-21020.686	23.256
2160	-103009.930	-21031.212	10.784
7045	-103006.662	-21045.801	14.950
面積	597.8793270		
地積	597.87 m <sup>2</sup>		

2069

地番 幡五一六ノ四			
NO	X	Y	辺長
4045	-103016.941	-21010.777	
2860	-103016.811	-21011.361	0.598
2163	-103016.039	-21011.860	0.919
2158	-103013.954	-21013.175	2.465
2159	-103013.326	-21015.991	2.885
7044	-103012.278	-21020.686	4.810
5155	-103034.974	-21025.761	23.256
4046	-103037.307	-21015.322	10.696
4045	-103016.941	-21010.777	20.866
面積	244.3596230		
地積	244.35 m <sup>2</sup>		

2070

地番 保一八ノ一			
NO	X	Y	辺長
4043	-103017.877	-21006.590	
4045	-103016.941	-21010.777	4.290
4046	-103037.307	-21015.322	20.866
4044	-103038.242	-21011.136	4.289
4043	-103017.877	-21006.590	20.866
面積	89.5124810		
地積	89.51 m <sup>2</sup>		

2071

地番 幡四八六			
NO	X	Y	辺長
4042	-103038.448	-21010.213	
4041	-103018.083	-21005.668	20.866
4043	-103017.877	-21006.590	0.944
4044	-103038.242	-21011.136	20.866
4042	-103038.448	-21010.213	0.945
面積	19.7230855		
地積	19.72 m <sup>2</sup>		

2072

地番 幡四七一 幡五一七			
NO	X	Y	辺長
4041	-103018.083	-21005.668	
4042	-103038.448	-21010.213	20.866
4040	-103038.599	-21009.540	0.689
4038	-103038.716	-21009.018	0.534
4037	-103018.349	-21004.472	20.868
4039	-103018.233	-21004.994	0.534
4041	-103018.083	-21005.668	0.690
面積	25.5611840		
地積	25.56 m <sup>2</sup>		

2073

地番 幡四五四ノ一			
NO	X	Y	辺長
7043	-103021.713	-20989.411	
2839	-103019.738	-20998.248	9.055
4037	-103018.349	-21004.472	6.377
4038	-103038.716	-21009.018	20.868
5156	-103042.082	-20993.957	15.432
7043	-103021.713	-20989.411	20.870
面積	322.0686415		
地積	322.06 m <sup>2</sup>		

2074

地番 幡二四七ノ二			
NO	X	Y	辺長
7043	-103021.713	-20989.411	
5156	-103042.082	-20993.957	20.870
5157	-103043.454	-20987.833	6.275
5158	-103044.981	-20980.984	7.017
5198	-103034.795	-20978.710	10.436
7042	-103024.610	-20976.438	10.435
2840	-103023.895	-20979.648	3.288
7043	-103021.713	-20989.411	10.003
面積	277.4542695		
地積	277.45 m <sup>2</sup>		

2075

地番 保一八ノ二			
NO	X	Y	辺長
7042	-103024.610	-20976.438	
5198	-103034.795	-20978.710	10.435
7041	-103038.229	-20963.377	15.712
2842	-103029.820	-20960.887	8.769
2841	-103027.808	-20962.070	2.334
7042	-103024.610	-20976.438	14.719
面積	166.4175470		
地積	166.41 m <sup>2</sup>		

2076

地番 保一八ノ四			
NO	X	Y	辺長
5198	-103034.795	-20978.710	
5158	-103044.981	-20980.984	10.436
5159	-103045.769	-20977.457	3.613
7040	-103048.250	-20966.345	11.385
2812	-103047.218	-20966.039	1.076
7041	-103038.229	-20963.377	9.374
5198	-103034.795	-20978.710	15.712
面積	160.1999420		
地積	160.19 m <sup>2</sup>		

2077

地番 幡二六五ノ二			
NO	X	Y	辺長
5159	-103045.769	-20977.457	
7039	-103067.231	-20982.256	21.991
2111	-103069.214	-20973.389	9.086
2112	-103068.616	-20972.381	1.172
2113	-103065.507	-20971.464	3.241
7040	-103048.250	-20966.345	18.000
5159	-103045.769	-20977.457	11.385
面積	233.5386005		
地積	233.53 m <sup>2</sup>		

2078

地番 幡二六五ノ三			
NO	X	Y	辺長
5157	-103043.454	-20987.833	
7038	-103064.914	-20992.627	21.988
2110	-103065.357	-20990.639	2.036
7039	-103067.231	-20982.256	8.589
5159	-103045.769	-20977.457	21.991
5158	-103044.981	-20980.984	3.613
5157	-103043.454	-20987.833	7.017
面積	233.7340975		
地積	233.73 m <sup>2</sup>		

2079

地番 幡二六七			
NO	X	Y	辺長
5154	-103034.519	-21027.789	
7037	-103056.013	-21032.582	22.021
2132	-103057.653	-21025.125	7.635
2109	-103061.514	-21007.878	17.673
7038	-103064.914	-20992.627	15.625
5157	-103043.454	-20987.833	21.988
5156	-103042.082	-20993.957	6.275
4038	-103038.716	-21009.018	15.432
4040	-103038.599	-21009.540	0.534
4042	-103038.448	-21010.213	0.689
4044	-103038.242	-21011.136	0.945
4046	-103037.307	-21015.322	4.289
5155	-103034.974	-21025.761	10.696
5154	-103034.519	-21027.789	2.078
面積	900.5960025		
地積	900.59 m <sup>2</sup>		

2080

地番 幡二七一A			
NO	X	Y	辺長
5153	-103031.151	-21042.831	
7036	-103047.388	-21046.453	16.636
2130	-103051.349	-21043.914	4.704
2131	-103054.525	-21039.349	5.561
7037	-103056.013	-21032.582	6.928
5154	-103034.519	-21027.789	22.021
5153	-103031.151	-21042.831	15.414
面積	321.8310885		
地積	321.83 m <sup>2</sup>		

2081

地番 幡二六八 幡二七二			
NO	X	Y	辺長
7035	-103027.612	-21058.764	
2127	-103031.853	-21056.244	4.933
2128	-103038.321	-21052.251	7.601
2129	-103040.583	-21050.815	2.679
7036	-103047.388	-21046.453	8.083
5153	-103031.151	-21042.831	16.636
5152	-103029.360	-21050.853	8.219
7035	-103027.612	-21058.764	8.101
面積	137.7178760		
地積	137.71 m <sup>2</sup>		

2082

地番 保一八ノ三			
NO	X	Y	辺長
7034	-103017.841	-21064.342	
2143	-103018.701	-21063.878	0.977
2126	-103025.318	-21060.127	7.606
7035	-103027.612	-21058.764	2.668
5152	-103029.360	-21050.853	8.101
5151	-103021.253	-21049.031	8.309
7034	-103017.841	-21064.342	15.686
面積	99.2842455		
地積	99.28 m <sup>2</sup>		

図面の種類	画地出来形確認測量図	
街区名	18	求積表
町名	岩倉幡枝町	
京都市洛北第三土地区画整理組合		