


X-103050

X-103050

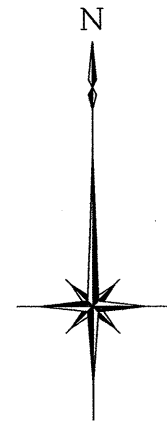

Y-21050

Y-21000

Y-20950

18

岩 倉 幡 枝 町

2119

20.000

2066

2118

3000-7

17.667

2108

17.667

2107

17.214

2106

1.213

2105

2.862

2104

一号公園

15.484

2177

4000-1

15.728

3000-9

2176

15.311

2178

18.393

2180

公1

2.500.86

35.735

19

X-103100

X-103100

Y-21050

Y-21000


Y-20950

図面の種類	画 地 出 来 形 確 認 測 量 図		
街 区 名	1号公園	縮 尺	1／250
町 名	岩 倉 幡 枝 町		
京 都 市 洛 北 第 三 土 地 区 画 整 理 組 合			


2066

地番	一号公園		
N O	X	Y	辺 長
2119	-103059.209	-21046.008	
2180	-103140.587	-20993.706	96.736
2179	-103122.954	-20988.473	18.393
2178	-103108.269	-20984.137	15.311
2177	-103093.572	-20979.782	15.328
2104	-103078.756	-20975.384	15.454
2105	-103076.010	-20974.574	2.862
2106	-103074.965	-20975.190	1.213
2107	-103071.206	-20991.989	17.214
2108	-103067.366	-21009.234	17.667
2118	-103063.517	-21026.477	17.667
2119	-103059.209	-21046.008	20.000
面積	2500.8607440		
地積	2500.86 m²		

図面の種類	画 地 出 来 形 確 認 測 量 図		
街 区 名	1号公園	求 積 表	
町 名	岩 倉 幡 枝 町		
京都市洛北第三土地地区画整理組合			

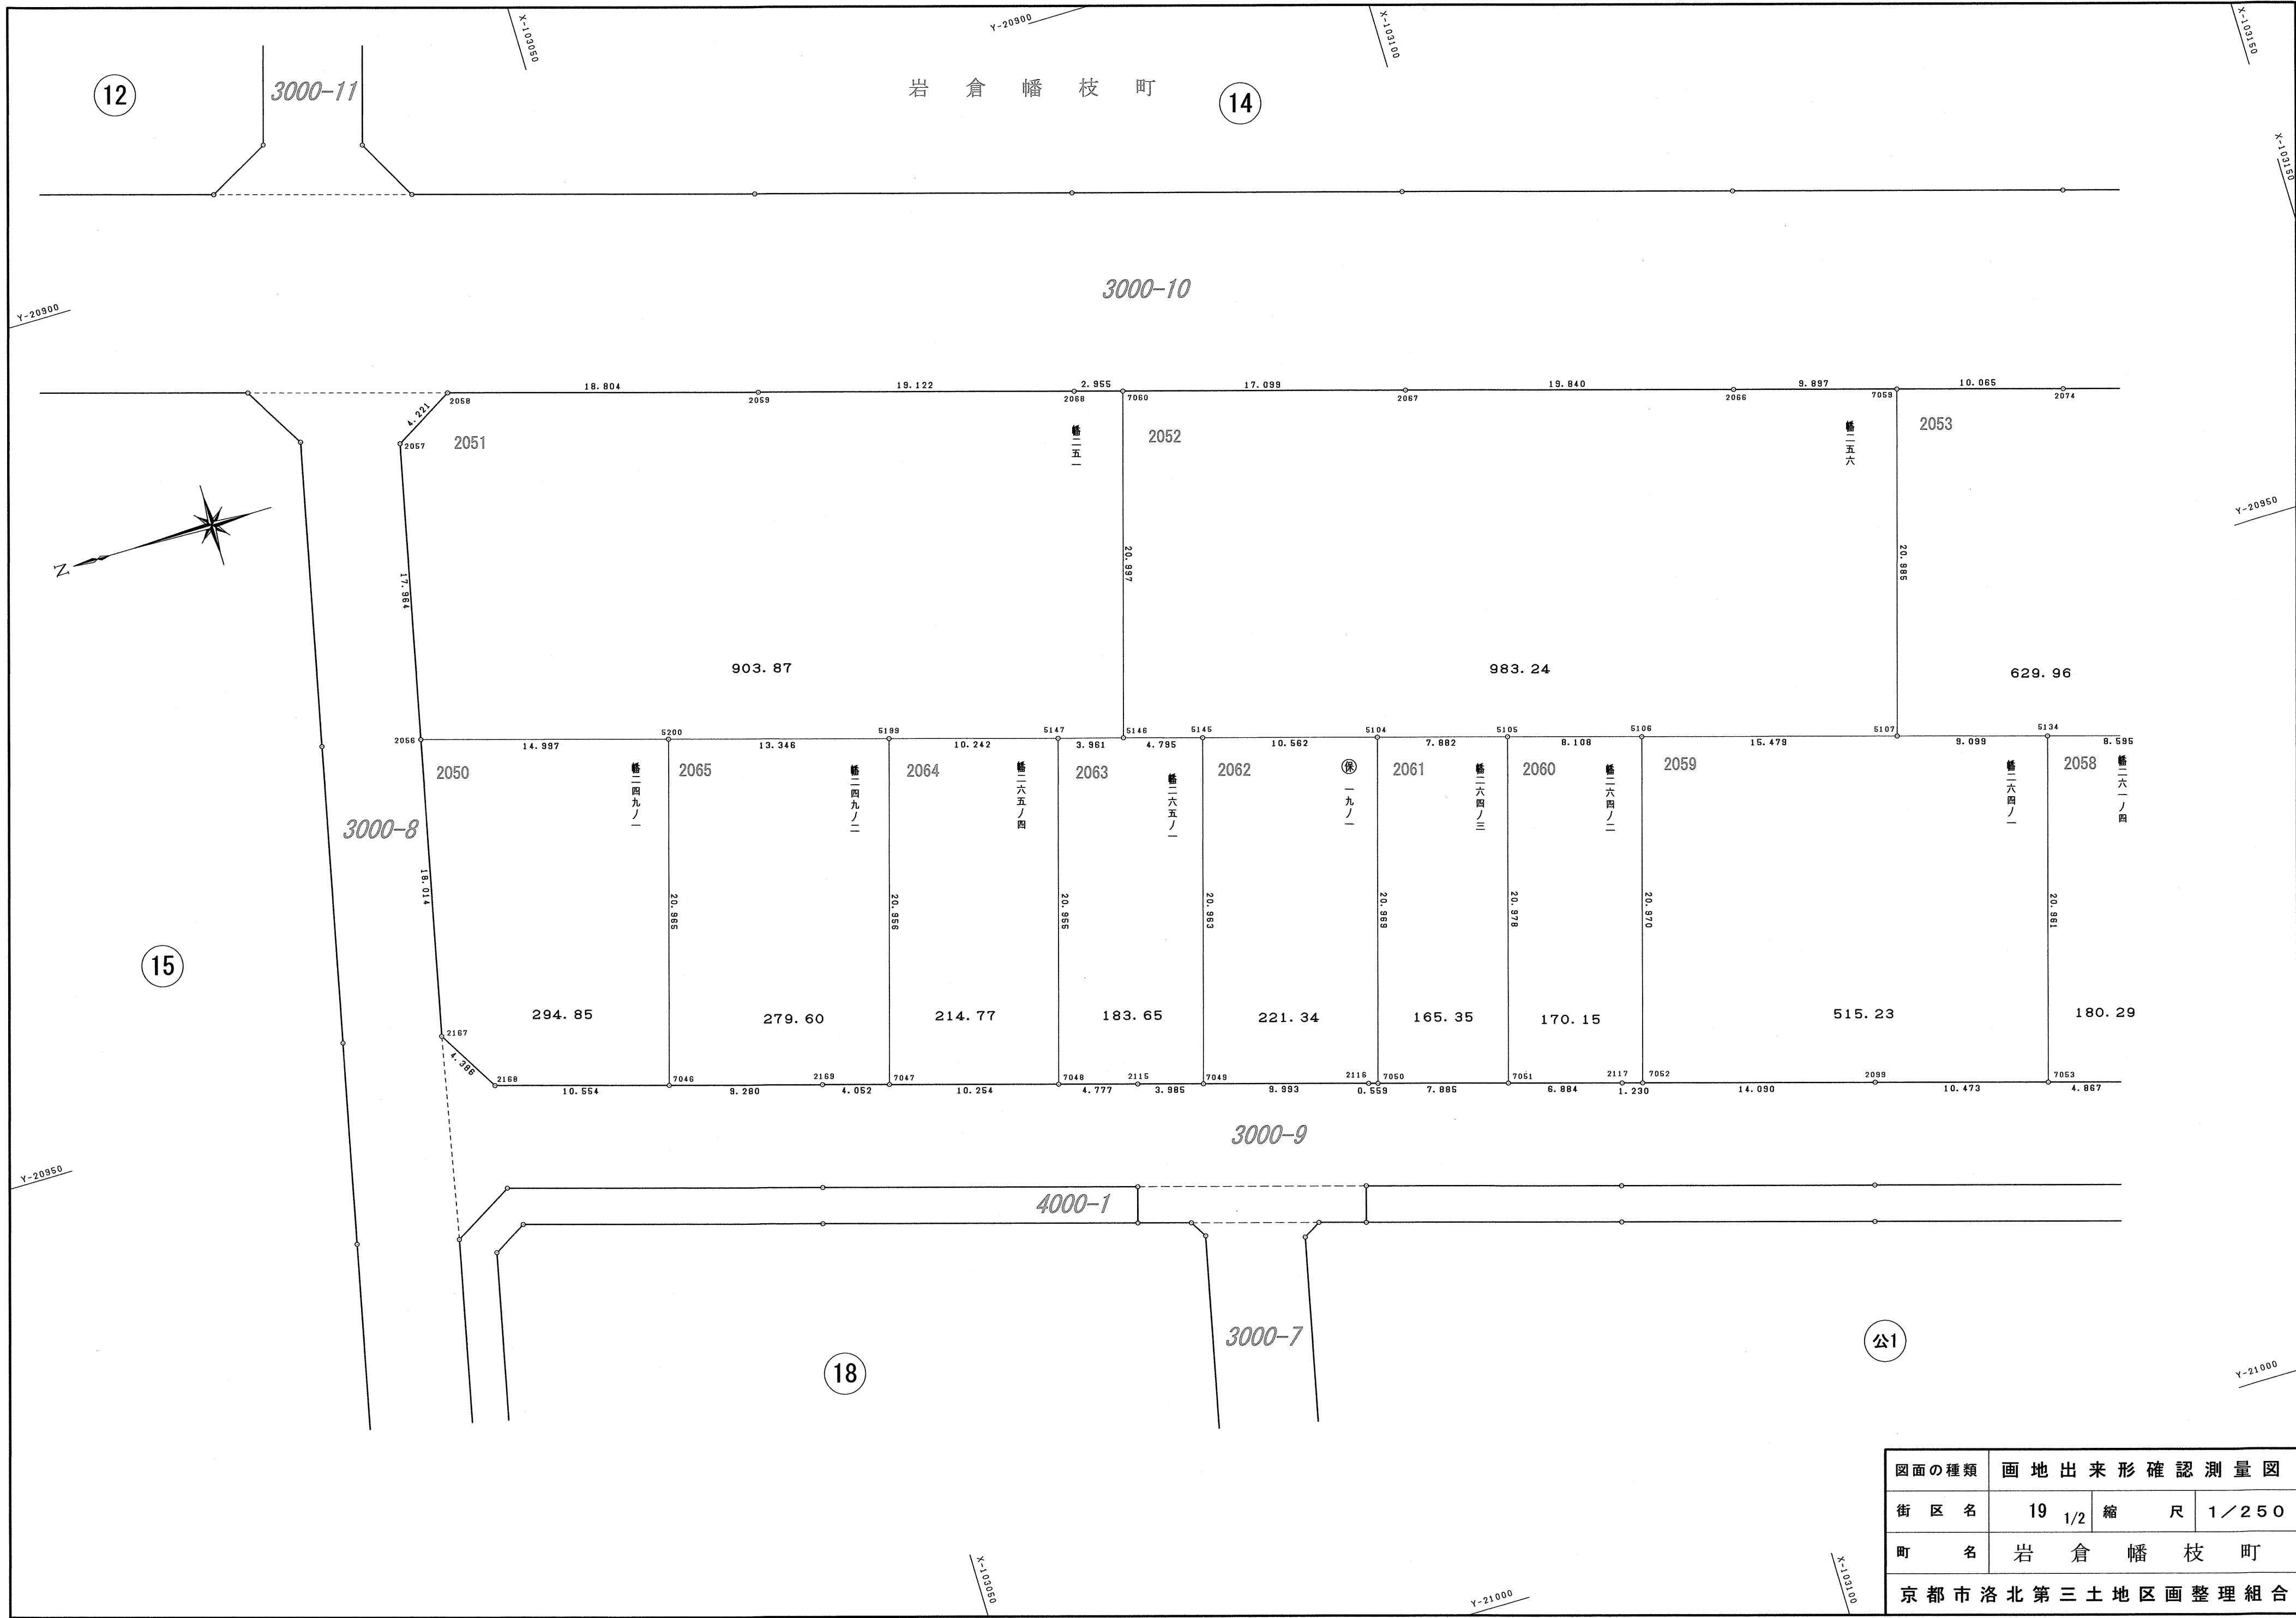

図面の種類	画地出来形確認測量図		
街 区 名	19 1/2	縮 尺	1／250
町 名	岩 倉 幡 枝 町		
京都市洛北第三土地区画整理組合			

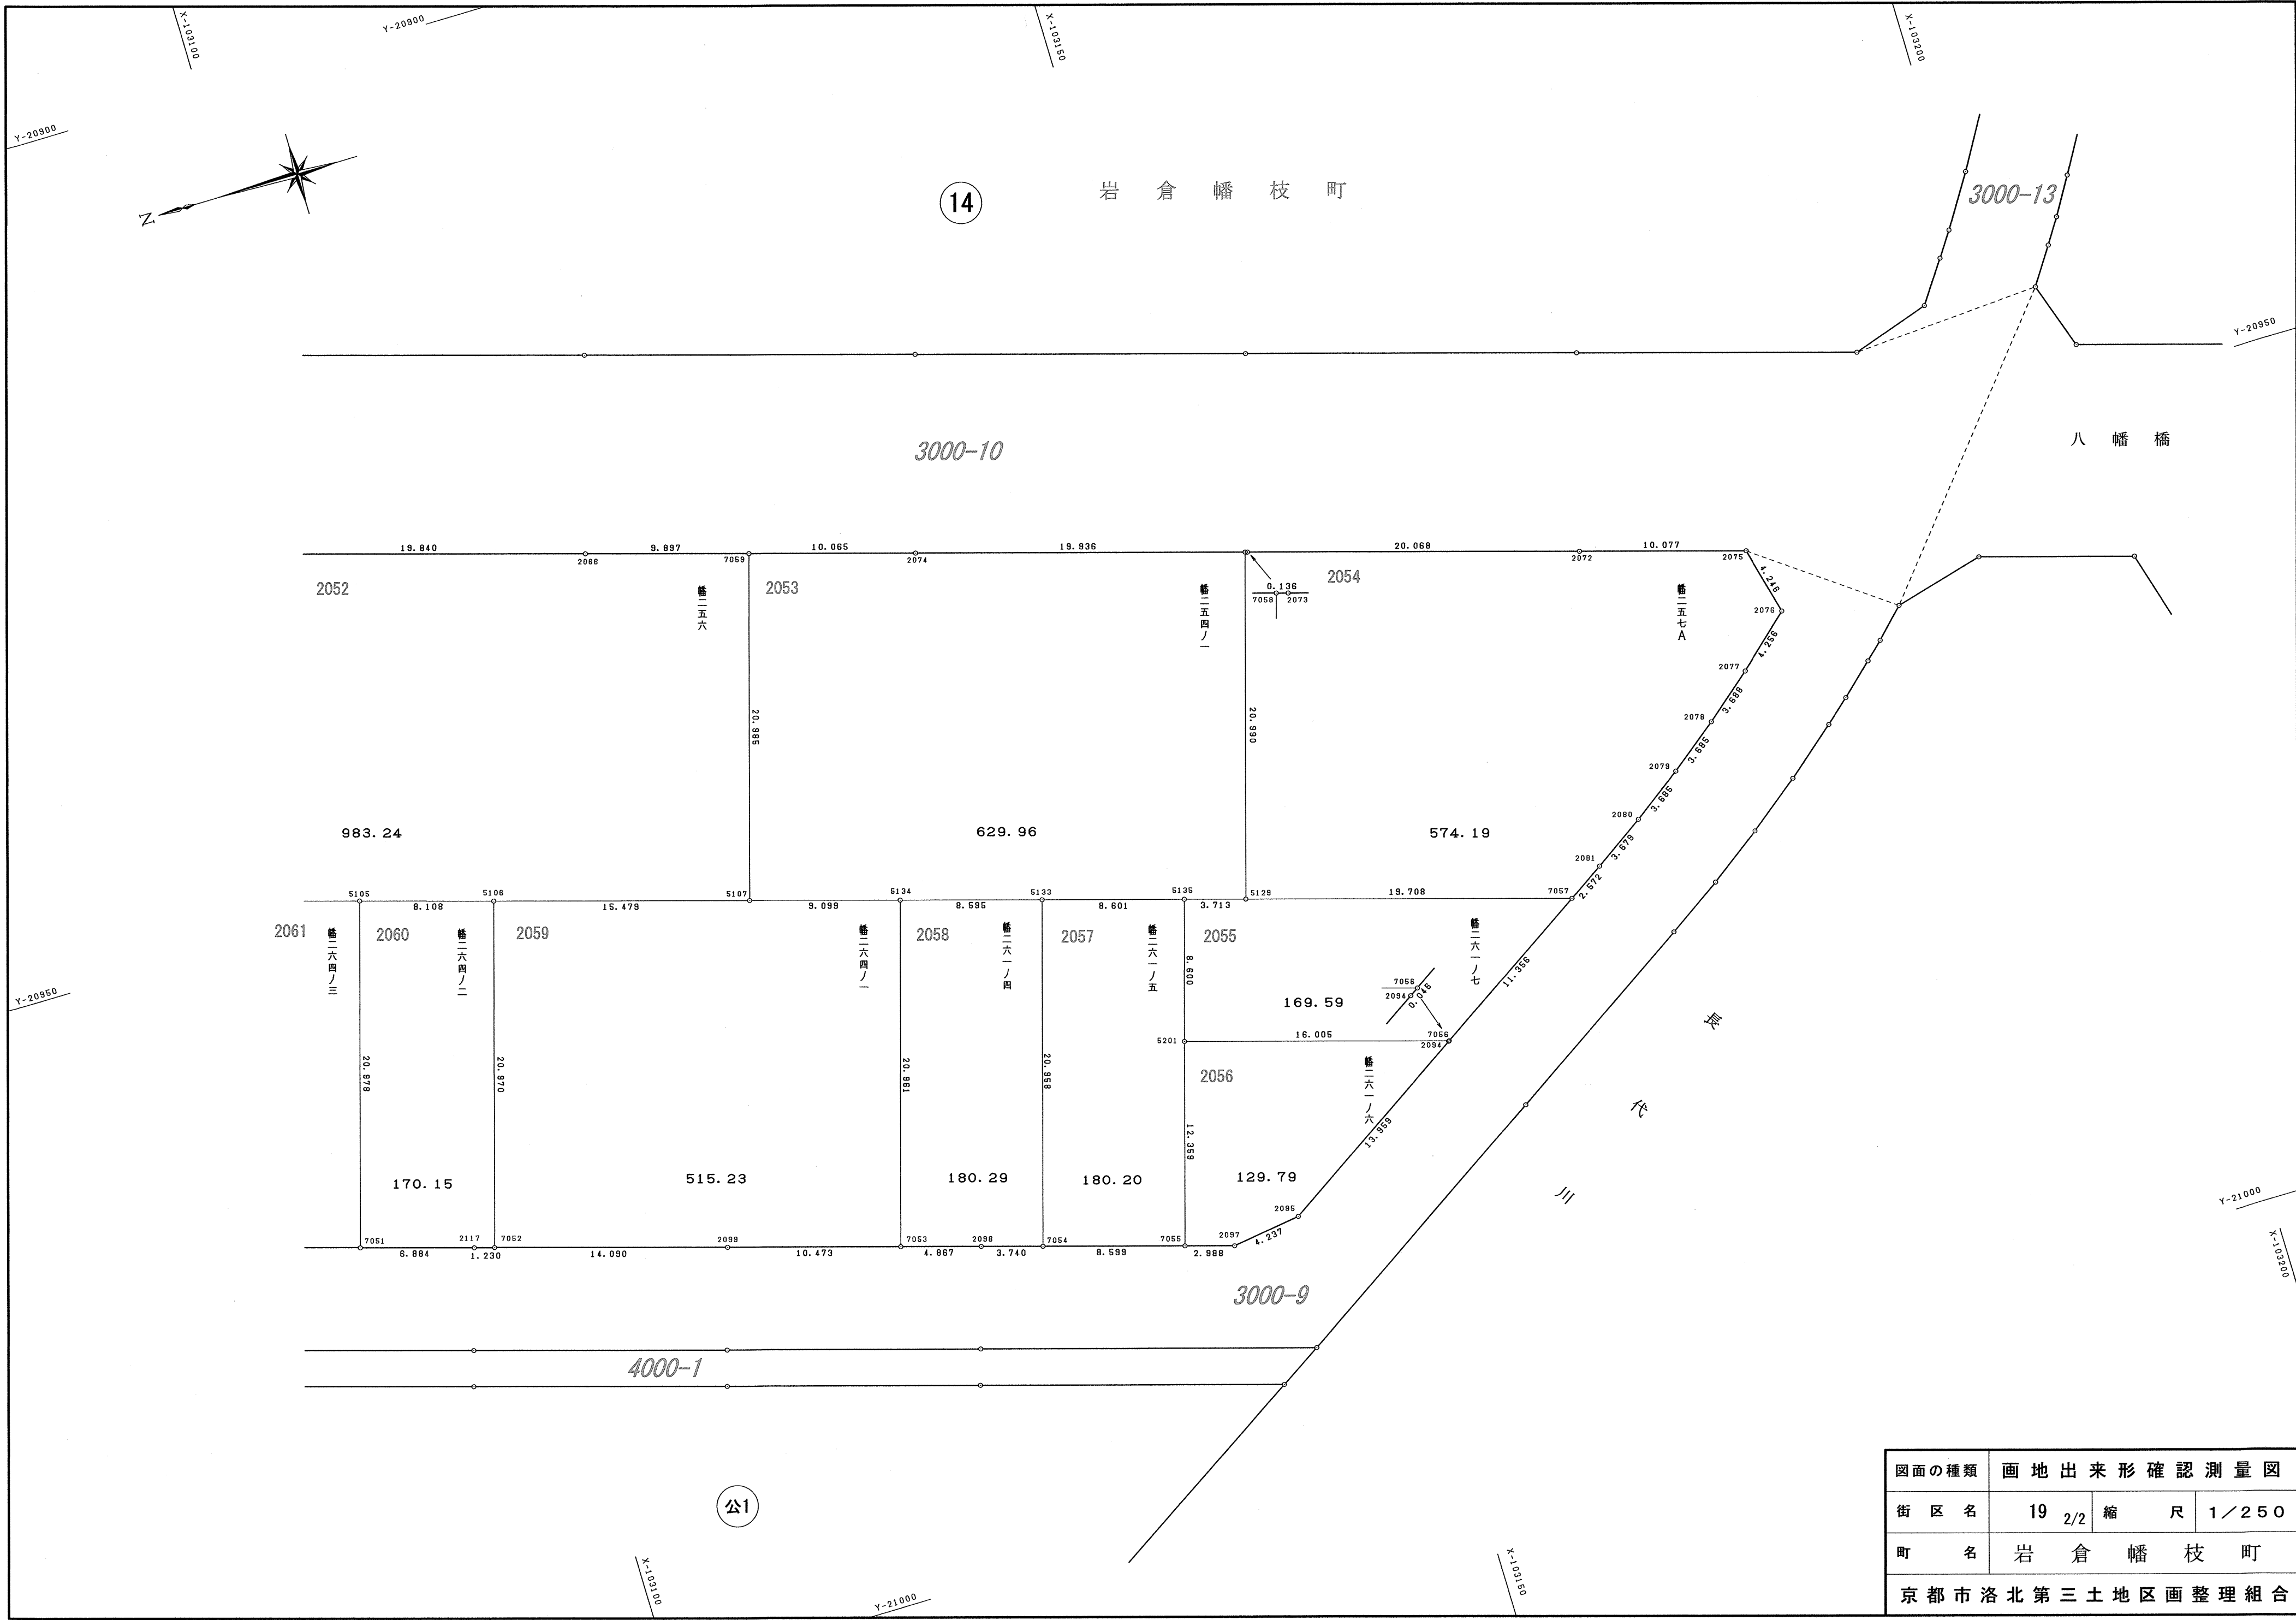

図面の種類	画 地 出 来 形 確 認 測 量 図		
街 区 名	19 2/2	縮 尺	1／250
町 名	岩 倉 幡 枝 町		
京 都 市 洛 北 第 三 土 地 区 画 整 理 組 合			

2050

地 番	幡二四九ノ一		
N O	X	Y	辺 長
2056	-103032.281	-20930.976	
2167	-103028.360	-20948.559	18.014
2168	-103030.591	-20952.336	4.386
7046	-103040.711	-20955.333	10.554
5200	-103046.663	-20935.230	20.965
2056	-103032.281	-20930.976	14.997
面積	294.8532870		
地積	294.85㎡		

2051

地 番	幡二五一		
N O	X	Y	辺 長
2056	-103032.281	-20930.976	
5200	-103046.663	-20935.230	14.997
5199	-103059.457	-20939.030	13.346
5147	-103069.276	-20941.946	10.242
5146	-103073.078	-20943.059	3.961
7060	-103079.043	-20922.927	20.997
2068	-103076.209	-20922.087	2.955
2059	-103057.875	-20916.653	19.122
2058	-103039.845	-20911.312	18.804
2057	-103036.202	-20913.445	4.221
2056	-103032.281	-20930.976	17.964
面積	903.8768490		
地積	903.87㎡		

2052

地 番	幡二五六		
N O	X	Y	辺 長
7060	-103079.043	-20922.927	
2067	-103095.437	-20927.789	17.099
2066	-103114.459	-20933.428	19.840
7059	-103123.948	-20936.242	9.897
5107	-103117.978	-20956.360	20.985
5106	-103103.134	-20951.970	15.479
5105	-103095.362	-20949.658	8.108
5104	-103087.802	-20947.426	7.882
5145	-103077.674	-20944.429	10.562
5146	-103073.078	-20943.059	4.795
7060	-103079.043	-20922.927	20.997
面積	983.2408030		
地積	983.24㎡		

2053

地 番	幡二五四ノ一		
N O	X	Y	辺 長
7059	-103123.948	-20936.242	
2074	-103133.598	-20939.103	10.065
7058	-103152.712	-20944.772	19.936
5129	-103146.748	-20964.897	20.990
5135	-103143.186	-20963.847	3.713
5133	-103134.939	-20961.403	8.601
5134	-103126.699	-20958.957	8.595
5107	-103117.978	-20956.360	9.099
7059	-103123.948	-20936.242	20.985
面積	629.9674055		
地積	629.96㎡		

2054

地 番	幡二五七A		
N O	X	Y	辺 長
7058	-103152.712	-20944.772	
2073	-103152.843	-20944.811	0.136
2072	-103172.084	-20950.516	20.068
2075	-103181.748	-20953.372	10.077
2076	-103182.795	-20957.487	4.246
2077	-103179.619	-20960.321	4.256
2078	-103176.780	-20962.676	3.688
2079	-103173.863	-20964.928	3.685
2080	-103170.868	-20967.076	3.685
2081	-103167.806	-20969.117	3.679
7057	-103165.641	-20970.507	2.572
5129	-103146.748	-20964.897	19.708
7058	-103152.712	-20944.772	20.990
面積	574.1925680		
地積	574.19㎡		

2055

地 番	幡二六一ノ七		
N O	X	Y	辺 長
7056	-103156.084	-20976.641	
7057	-103165.641	-20970.507	11.356
5129	-103146.748	-20964.897	19.708
5135	-103143.186	-20963.847	3.713
5201	-103140.739	-20972.092	8.600
7056	-103156.084	-20976.641	16.005
面積	169.5923440		
地積	169.59㎡		

2056

地 番	幡二六一ノ六		
N O	X	Y	辺 長
5201	-103140.739	-20972.092	
7055	-103137.236	-20983.945	12.359
2097	-103140.101	-20984.794	2.988
2095	-103144.298	-20984.208	4.237
2094	-103156.045	-20976.666	13.959
7056	-103156.084	-20976.641	0.046
5201	-103140.739	-20972.092	16.005
面積	129.7994920		
地積	129.79㎡		

2057

地 番	幡二六一ノ五		
N O	X	Y	辺 長
7054	-103128.991	-20981.500	
7055	-103137.236	-20983.945	8.599
5201	-103140.739	-20972.092	12.359
5135	-103143.186	-20963.847	8.600
5133	-103134.939	-20961.403	8.601
7054	-103128.991	-20981.500	20.958
面積	180.2052875		
地積	180.20㎡		

2058

地 番	幡二六一ノ四		
N O	X	Y	辺 長
7053	-103120.738	-20979.053	
2098	-103125.405	-20980.437	4.867
7054	-103128.991	-20981.500	3.740
5133	-103134.939	-20961.403	20.958
5134	-103126.699	-20958.957	8.595
7053	-103120.738	-20979.053	20.961
面積	180.2944730		
地積	180.29㎡		

2059

地 番	幡二六四ノ一		
N O	X	Y	辺 長
7052	-103097.185	-20972.079	
2099	-103110.697	-20976.075	14.090
7053	-103120.738	-20979.053	10.473
5134	-103126.699	-20958.957	20.961
5107	-103117.978	-20956.360	9.099
5106	-103103.134	-20951.970	15.479
7052	-103097.185	-20972.079	20.970
面積	515.2385640		
地積	515.23㎡		

2060

地 番	幡二六四ノ二		
N O	X	Y	辺 長
7051	-103089.404	-20969.773	
2117	-103096.005	-20971.730	6.884
7052	-103097.185	-20972.079	1.230
5106	-103103.134	-20951.970	20.970
5105	-103095.362	-20949.658	8.108
7051	-103089.404	-20969.773	20.978
面積	170.1503550		
地積	170.15㎡		

2061

地 番	幡二六四ノ三		
N O	X	Y	辺 長
7050	-103081.844	-20967.531	
7051	-103089.404	-20969.773	7.885
5105	-103095.362	-20949.658	20.978
5104	-103087.802	-20947.426	7.882
7050	-103081.844	-20967.531	20.969
面積	165.3596460		
地積	165.35㎡		

2062

地 番	保一九ノ一		
N O	X	Y	辺 長
7049	-103071.727	-20964.531	
2116	-103081.308	-20967.372	9.993
7050	-103081.844	-20967.531	0.559
5104	-103087.802	-20947.426	20.969
5145	-103077.674	-20944.429	10.562
7049	-103071.727	-20964.531	20.963
面積	221.3459485		
地積	221.34㎡		

2063

地 番	幡二六五ノ一		
N O	X	Y	辺 長
7048	-103063.326	-20962.039	
2115	-103067.906	-20963.398	4.777
7049	-103071.727	-20964.531	3.985
5145	-103077.674	-20944.429	20.963
5146	-103073.078	-20943.059	4.795
5147	-103069.276	-20941.946	3.961
7048	-103063.326	-20962.039	20.955
面積	183.6543405		
地積	183.65㎡		

2064

地 番	幡二六五ノ四		
N O	X	Y	辺 長
7047	-103053.495	-20959.121	
7048	-103063.326	-20962.039	10.254
5147	-103069.276	-20941.946	20.955
5199	-103059.457	-20939.030	10.242
7047	-103053.495	-20959.121	20.956
面積	214.7775520		
地積	214.77㎡		

2065

地 番	幡二四九ノ二		
N O	X	Y	辺 長
7046	-103040.711	-20955.333	
2169	-103049.610	-20957.968	9.280
7047	-103053.495	-20959.121	4.052
5199	-103059.457	-20939.030	20.956
5200	-103046.663	-20935.230	13.346
7046	-103040.711	-20955.333	20.965
面積	279.6096050		
地積	279.60㎡		



図面の種類	画 地 出 来 形 確 認 測 量 図		
街 区 名	19	求 積 表	
町 名	岩 倉 幡 枝 町		
京 都 市 洛 北 第 三 土 地 区 画 整 理 組 合			

岩倉幡枝町

川

代

最

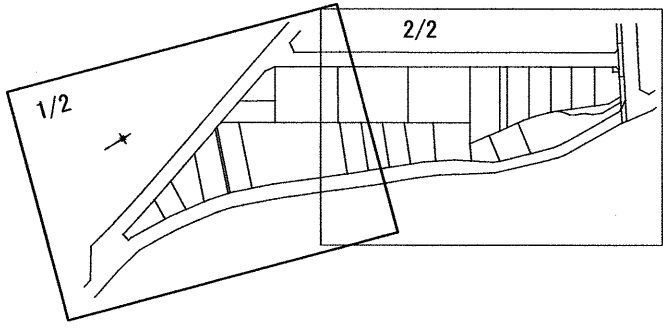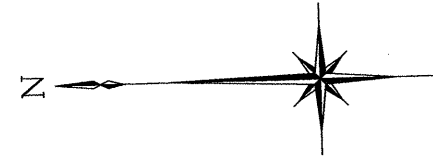

3000-15

3000-16

3000-14


Y-21050

Y-21050

Y-21100


Y-21100

図面の種類	画地出来形確認測量図		
街 区 名	20 1/2	縮 尺	1／250
町 名	岩 倉 幡 枝 町		
京 都 市 洛 北 第 三 土 地 区 画 整 理 組 合			

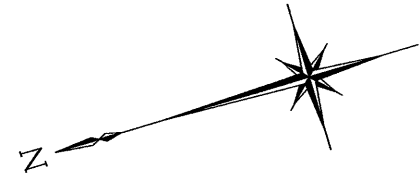


21

岩 倉 幡 枝 町

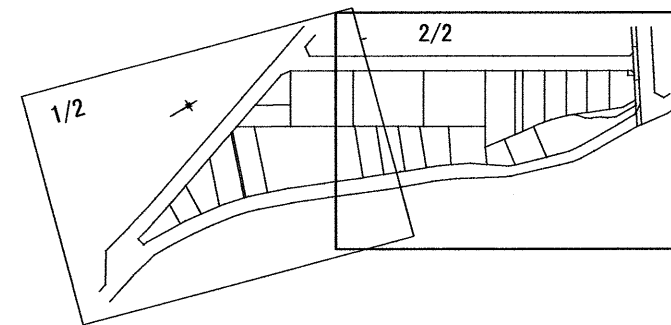

24

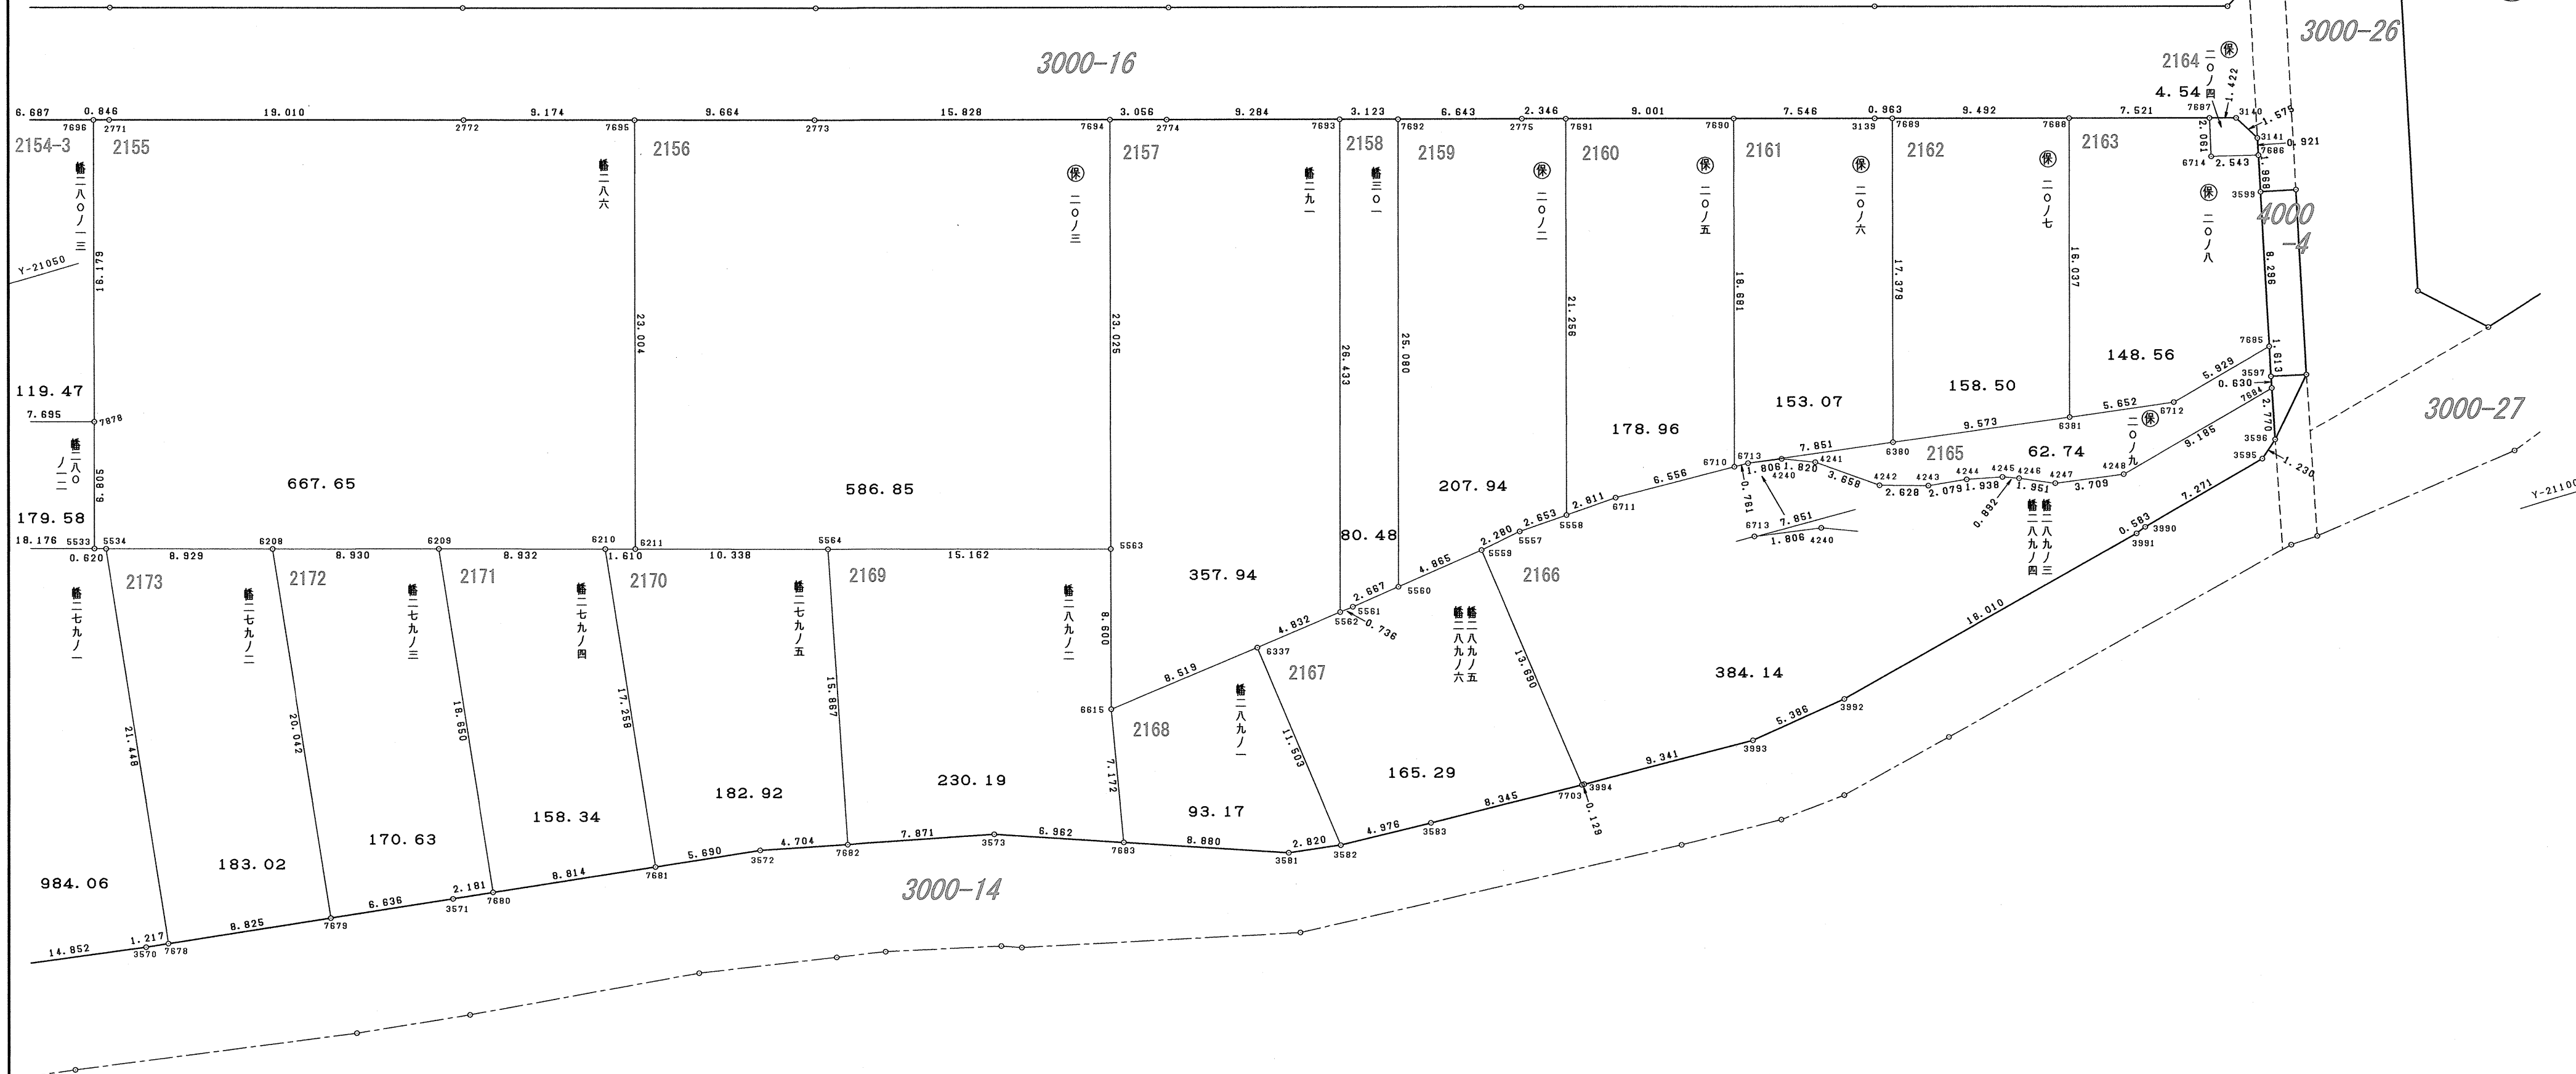

図面の種類	画地出来形確認測量図		
街 区 名	20	2/2	縮 尺 1／250
町 名	岩 倉 幡 枝 町		
京都市洛北第三土地区画整理組合			

2146

地番	保二〇ノ一		
N O	X	Y	辺 長
2761	-103039.362	-21087.003	
2760	-103040.962	-21086.270	1.759
7672	-103056.291	-21082.946	15.685
7702	-103054.392	-21074.134	9.014
2750	-103052.774	-21075.167	1.919
2763	-103045.871	-21079.422	8.109
2762	-103038.023	-21084.082	9.127
2761	-103039.362	-21087.003	3.213
面積	105.0302410		
地積	105.03㎡		

2147

地番	保二〇ノ一〇		
N O	X	Y	辺 長
7672	-103056.291	-21082.946	
3565	-103058.729	-21082.417	2.494
7673	-103065.791	-21081.579	7.111
7701	-103063.019	-21068.601	13.270
2764	-103055.394	-21073.495	9.060
7702	-103054.392	-21074.134	1.188
7672	-103056.291	-21082.946	9.014
面積	105.9422240		
地積	105.94㎡		

2148

地番	保二〇ノ一一		
N O	X	Y	辺 長
7673	-103065.791	-21081.579	
7674	-103073.874	-21080.619	8.139
7700	-103075.712	-21060.445	20.257
2751	-103069.874	-21064.201	6.941
7701	-103063.019	-21068.601	8.145
7673	-103065.791	-21081.579	13.270
面積	174.2899840		
地積	174.28㎡		

2149

地番	幡一〇一		
N O	X	Y	辺 長
7674	-103073.874	-21080.619	
3566	-103076.024	-21080.364	2.165
7675	-103084.609	-21080.250	8.585
7699	-103087.048	-21053.153	27.206
2752	-103084.456	-21054.818	3.080
7700	-103075.712	-21060.445	10.398
7674	-103073.874	-21080.619	20.257
面積	251.6792105		
地積	251.67㎡		

2150

地番	幡一〇〇 幡一一〇		
N O	X	Y	辺 長
7675	-103084.609	-21080.250	
7676	-103085.368	-21080.240	0.759
3567	-103086.697	-21080.222	1.329
7677	-103094.512	-21080.929	7.846
5532	-103097.019	-21053.306	27.736
7697	-103090.024	-21051.241	7.293
7698	-103087.862	-21052.630	2.569
7699	-103087.048	-21053.153	0.967
7675	-103084.609	-21080.250	27.206
面積	281.8177360		
地積	281.81㎡		

2151

地番	幡二八〇ノ八		
N O	X	Y	辺 長
7697	-103090.024	-21051.241	
5532	-103097.019	-21053.306	7.293
6707	-103111.396	-21057.548	14.989
6708	-103113.910	-21049.033	8.878
7734	-103099.906	-21044.892	14.603
2740	-103099.053	-21045.440	1.013
7697	-103090.024	-21051.241	10.731
面積	163.8436060		
地積	163.84㎡		

2152

地番	幡二八〇ノ九		
N O	X	Y	辺 長
7734	-103099.906	-21044.892	
6708	-103113.910	-21049.033	14.603
2745	-103117.918	-21035.500	14.114
2741	-103113.657	-21036.060	4.297
7734	-103099.906	-21044.892	16.343
面積	118.0229260		
地積	118.02㎡		

2153

地番	幡二八〇ノ一〇		
N O	X	Y	辺 長
2745	-103117.918	-21035.500	
6708	-103113.910	-21049.033	14.114
6707	-103111.396	-21057.548	8.878
6847	-103118.782	-21059.726	7.700
7873	-103120.963	-21052.350	7.691
2742	-103125.299	-21037.684	15.293
2745	-103117.918	-21035.500	7.697
面積	177.0434710		
地積	177.04㎡		

2154-1

地番	幡二八〇ノ一一		
N O	X	Y	辺 長
2742	-103125.299	-21037.684	
7873	-103120.963	-21052.350	15.293
7874	-103129.000	-21054.728	8.381
7875	-103131.921	-21044.861	10.290
7876	-103130.101	-21044.320	1.898
7877	-103131.519	-21039.530	4.995
2742	-103125.299	-21037.684	6.488
面積	118.7083655		
地積	118.70㎡		

2154-2

地番	幡二八〇ノ一二		
N O	X	Y	辺 長
7877	-103131.519	-21039.530	
7876	-103130.101	-21044.320	4.995
7875	-103131.921	-21044.861	1.898
7874	-103129.000	-21054.728	10.290
7873	-103120.963	-21052.350	8.381
6847	-103118.782	-21059.726	7.691
5533	-103136.208	-21064.896	18.176
7878	-103138.137	-21058.370	6.805
7879	-103130.758	-21056.187	7.695
7880	-103133.934	-21045.458	11.189
7881	-103134.893	-21045.744	1.000
7882	-103136.312	-21040.951	4.998
7877	-103131.519	-21039.530	4.999
面積	179.5880010		
地積	179.58㎡		

2154-3

地番	幡二八〇ノ一三		
N O	X	Y	辺 長
7882	-103136.312	-21040.951	
7881	-103134.893	-21045.744	4.998
7880	-103133.934	-21045.458	1.000
7879	-103130.758	-21056.187	11.189
7878	-103138.137	-21058.370	7.695
7696	-103142.723	-21042.854	16.179
7882	-103136.312	-21040.951	6.687
面積	119.4740345		
地積	119.47㎡		

2155

地番	幡二八六		
N O	X	Y	辺 長
7696	-103142.723	-21042.854	
7878	-103138.137	-21058.370	16.179
5533	-103136.208	-21064.896	6.805
5534	-103136.800	-21065.081	0.620
6208	-103145.358	-21067.630	8.929
6209	-103153.920	-21070.168	8.930
6210	-103162.483	-21072.711	8.932
6211	-103164.026	-21073.171	1.610
7695	-103170.555	-21051.112	23.004
2772	-103161.760	-21048.501	9.174
2771	-103143.534	-21043.095	19.010
7696	-103142.723	-21042.854	0.846
面積	667.6515300		
地積	667.65㎡		

2156

地番	保二〇ノ三		
N O	X	Y	辺 長
7695	-103170.555	-21051.112	
6211	-103164.026	-21073.171	23.004
5564	-103173.933	-21076.125	10.338
5563	-103188.465	-21080.451	15.162
7694	-103194.993	-21058.370	23.025
2773	-103179.820	-21053.863	15.828
7695	-103170.555	-21051.112	9.664
面積	586.8565005		
地積	586.85㎡		

2157

地番	幡二九一		
N O	X	Y	辺 長
7694	-103194.993	-21058.370	
5563	-103188.465	-21080.451	23.025
6615	-103186.039	-21088.702	8.600
6337	-103194.507	-21087.771	8.519
5562	-103199.308	-21087.220	4.832
7693	-103206.825	-21061.878	26.433
2774	-103197.923	-21059.240	9.284
7694	-103194.993	-21058.370	3.056
面積	357.9482095		
地積	357.94㎡		

2158

地番	幡三〇一		
N O	X	Y	辺 長
7693	-103206.825	-21061.878	
5562	-103199.308	-21087.220	26.433
5561	-103200.041	-21087.148	0.736
5560	-103202.687	-21086.811	2.667
7692	-103209.820	-21062.766	25.080
7693	-103206.825	-21061.878	3.123
面積	80.4807765		
地積	80.48㎡		

2159

地番	保二〇ノ二		
N O	X	Y	辺 長
7692	-103209.820	-21062.766	
5560	-103202.687	-21086.811	25.080
5559	-103207.515	-21086.206	4.865
5557	-103209.765	-21085.834	2.280
5558	-103212.415	-21085.706	2.653
7691	-103218.440	-21065.321	21.256
2775	-103216.190	-21064.654	2.346
7692	-103209.820	-21062.766	6.643
面積	207.9464300		
地積	207.94㎡		

2160

地番	保二〇ノ五		
N O	X	Y	辺 長
7691	-103218.440	-21065.321	
5558	-103212.415	-21085.706	21.256
6711	-103215.223	-21085.564	2.811
6710	-103221.776	-21085.792	6.556
7690	-103227.071	-21067.877	18.681
7691	-103218.440	-21065.321	9.001
面積	178.9648850		
地積	178.96㎡		

2161

地番	保二〇ノ六		
N O	X	Y	辺 長
7690	-103227.071	-21067.877	
6710	-103221.776	-21085.792	18.681
6713	-103222.537	-21085.811	0.761
6380	-103230.304	-21086.961	7.851
7689	-103235.231	-21070.294	17.379
3139	-103234.307	-21070.020	0.963
7690	-103227.071	-21067.877	7.546
面積	153.0776045		
地積	153.07㎡		

2162

地番	保二〇ノ七		
N O	X	Y	辺 長
7689	-103235.231	-21070.294	
6380	-103230.304	-21086.961	17.379
6381	-103239.773	-21088.372	9.573
7688	-103244.331	-21072.996	16.037
7689	-103235.231	-21070.294	9.492
面積	158.5045680		
地積	158.50㎡		

2163

地番	保二〇ノ八		
N O	X	Y	辺 長
7688	-103244.331	-21072.996	
6381	-103239.773	-21088.372	16.037
6712	-103245.365	-21089.196	5.652
7685	-103251.125	-21087.790	5.929
3599	-103253.035	-21079.716	8.296
7686	-103253.487	-21077.800	1.968
6714	-103251.032	-21077.133	2.543
7687	-103251.542	-21075.136	2.061
7688	-103244.331	-21072.996	7.521
面積	148.5673935		
地積	148.56 m ²		

2166

地番	幅二八九ノ三	幅二八九ノ四	
N O	X	Y	辺 長
7684	-103250.614	-21089.975	
4248	-103241.686	-21092.134	9.185
4247	-103238.023	-21091.551	3.709
4246	-103236.248	-21090.740	1.951
4245	-103235.416	-21090.418	0.892
4244	-103233.525	-21088.892	1.938
4243	-103231.462	-21088.731	2.079
4242	-103228.949	-21088.961	2.628
4241	-103226.007	-21086.787	3.658
4240	-103224.320	-21086.102	1.820
6713	-103222.537	-21085.811	1.806
6710	-103221.776	-21085.792	0.761
6711	-103215.223	-21085.564	6.556
5558	-103212.415	-21085.706	2.811
5557	-103208.765	-21085.834	2.653
5559	-103207.515	-21086.206	2.280
7703	-103209.080	-21089.807	13.690
3984	-103209.209	-21089.813	0.129
3993	-103218.545	-21100.128	8.341
3992	-103223.882	-21089.397	5.386
3991	-103241.436	-21085.369	18.010
3990	-103241.965	-21095.170	0.583
3595	-103248.053	-21093.462	7.271
3596	-103250.001	-21092.677	1.230
7684	-103250.614	-21089.975	2.770
面積	384.1439165		
地積	384.14		m ²

2167

地番	幅二八九ノ五	幅二八九ノ六	
N O	X	Y	辺 長
7703	-103209.080	-21089.807	
5559	-103207.515	-21086.206	13.690
5560	-103202.687	-21086.811	4.865
5561	-103200.041	-21087.148	2.667
5562	-103199.308	-21087.220	0.736
6337	-103194.507	-21087.771	4.832
3582	-103195.772	-21099.205	11.503
3583	-103200.742	-21099.451	4.976
7703	-103209.080	-21089.807	8.345
面積	165.2913470		
地積	165.29		m ²

2168

地番	幅二八九ノ一		
N O	X	Y	辺長
3582	-103195.772	-21099.205	
6337	-103194.507	-21087.771	11.503
6615	-103186.039	-21088.702	8.519
7683	-103184.646	-21095.738	7.172
3581	-103182.980	-21088.805	8.880
3582	-103195.772	-21099.205	2.820
面積	93.1711790		
地積	93.17 ㎡		

2169

地 番	幅二八九ノ二		
N O	X	Y	辺 長
7683	-103184.646	-21095.738	
6615	-103186.039	-21088.702	7.1722
5563	-103188.465	-21080.451	8.6000
5564	-103173.933	-21076.125	15.1620
7682	-103170.433	-21091.602	15.8675
3573	-103178.112	-21093.333	7.8710
7683	-103184.646	-21095.738	6.9620
面積	230.1944725		
地積	230.19 ㎡		

2170

地番	幅二七九ノ五		
N O	X	Y	辺 長
7682	-103170.433	-21091.602	
5564	-103173.933	-21076.125	15.867
6211	-103164.026	-21073.171	10.336
6210	-103162.483	-21072.711	1.610
7681	-103160.203	-21089.811	17.258
3572	-103165.844	-21090.568	5.690
7682	-103170.433	-21091.602	4.704
面積	182.9212690		
地積	182.92 ㎡		

2171

地番	幅二七九ノ四		
N O	X	Y	辺 長
7681	-103160.203	-21089.818	
6210	-103162.483	-21072.711	17.258
6209	-103153.920	-21070.168	8.932
7680	-103151.465	-21088.656	18.650
7681	-103160.203	-21089.818	8.814
面積	158.3430675		
地積	158.34 m ²		

2172

地番	幅二七九ノ三		
N O	X	Y	辺 長
7680	-103151.465	-21088.656	
6209	-103153.920	-21070.168	18.656
6208	-103145.358	-21067.630	8.930
7679	-103142.723	-21087.499	20.042
3571	-103149.302	-21088.369	6.636
7680	-103151.465	-21088.656	2.181
面積	170.6310880		
地積	170.63 m ²		

2173



地番	幅二七九ノ二		
N O	X	Y	辺 長
7679	-103142.723	-21087.499	
6208	-103145.358	-21067.630	20.04
5534	-103136.800	-21065.081	8.92
7678	-103133.974	-21086.343	21.44
7679	-103142.723	-21087.499	8.82
面積	183.0218055		
地積	183.02 ㎡		

2174

地 番	幅二七九ノ一		
N O	X	Y	辺 長
7678	-103133.974	-21086.343	
5534	-103136.800	-21065.081	21.44
5533	-103136.208	-21064.896	0.62
6847	-103118.782	-21059.726	18.17
6707	-103111.396	-21057.548	7.70
5532	-103097.019	-21053.306	14.98
7677	-103094.512	-21080.929	27.73
3568	-103103.397	-21081.733	8.92
3569	-103118.082	-21083.961	14.85
3570	-103132.767	-21086.183	14.85
7678	-103133.974	-21086.343	1.21
面積	984.0628915		
地積	984.06 ㎡		

幅丁 幅二七九ノ一
 2174
 幅二七九ノ一
 幅二七九ノ一

図面の種類	圖地出来形確認測量圖	
街 区 名	20 2/2	求 積 表
町 名	岩 倉 幡 枝 町	
京都市洛北第三土地区画整理組合		

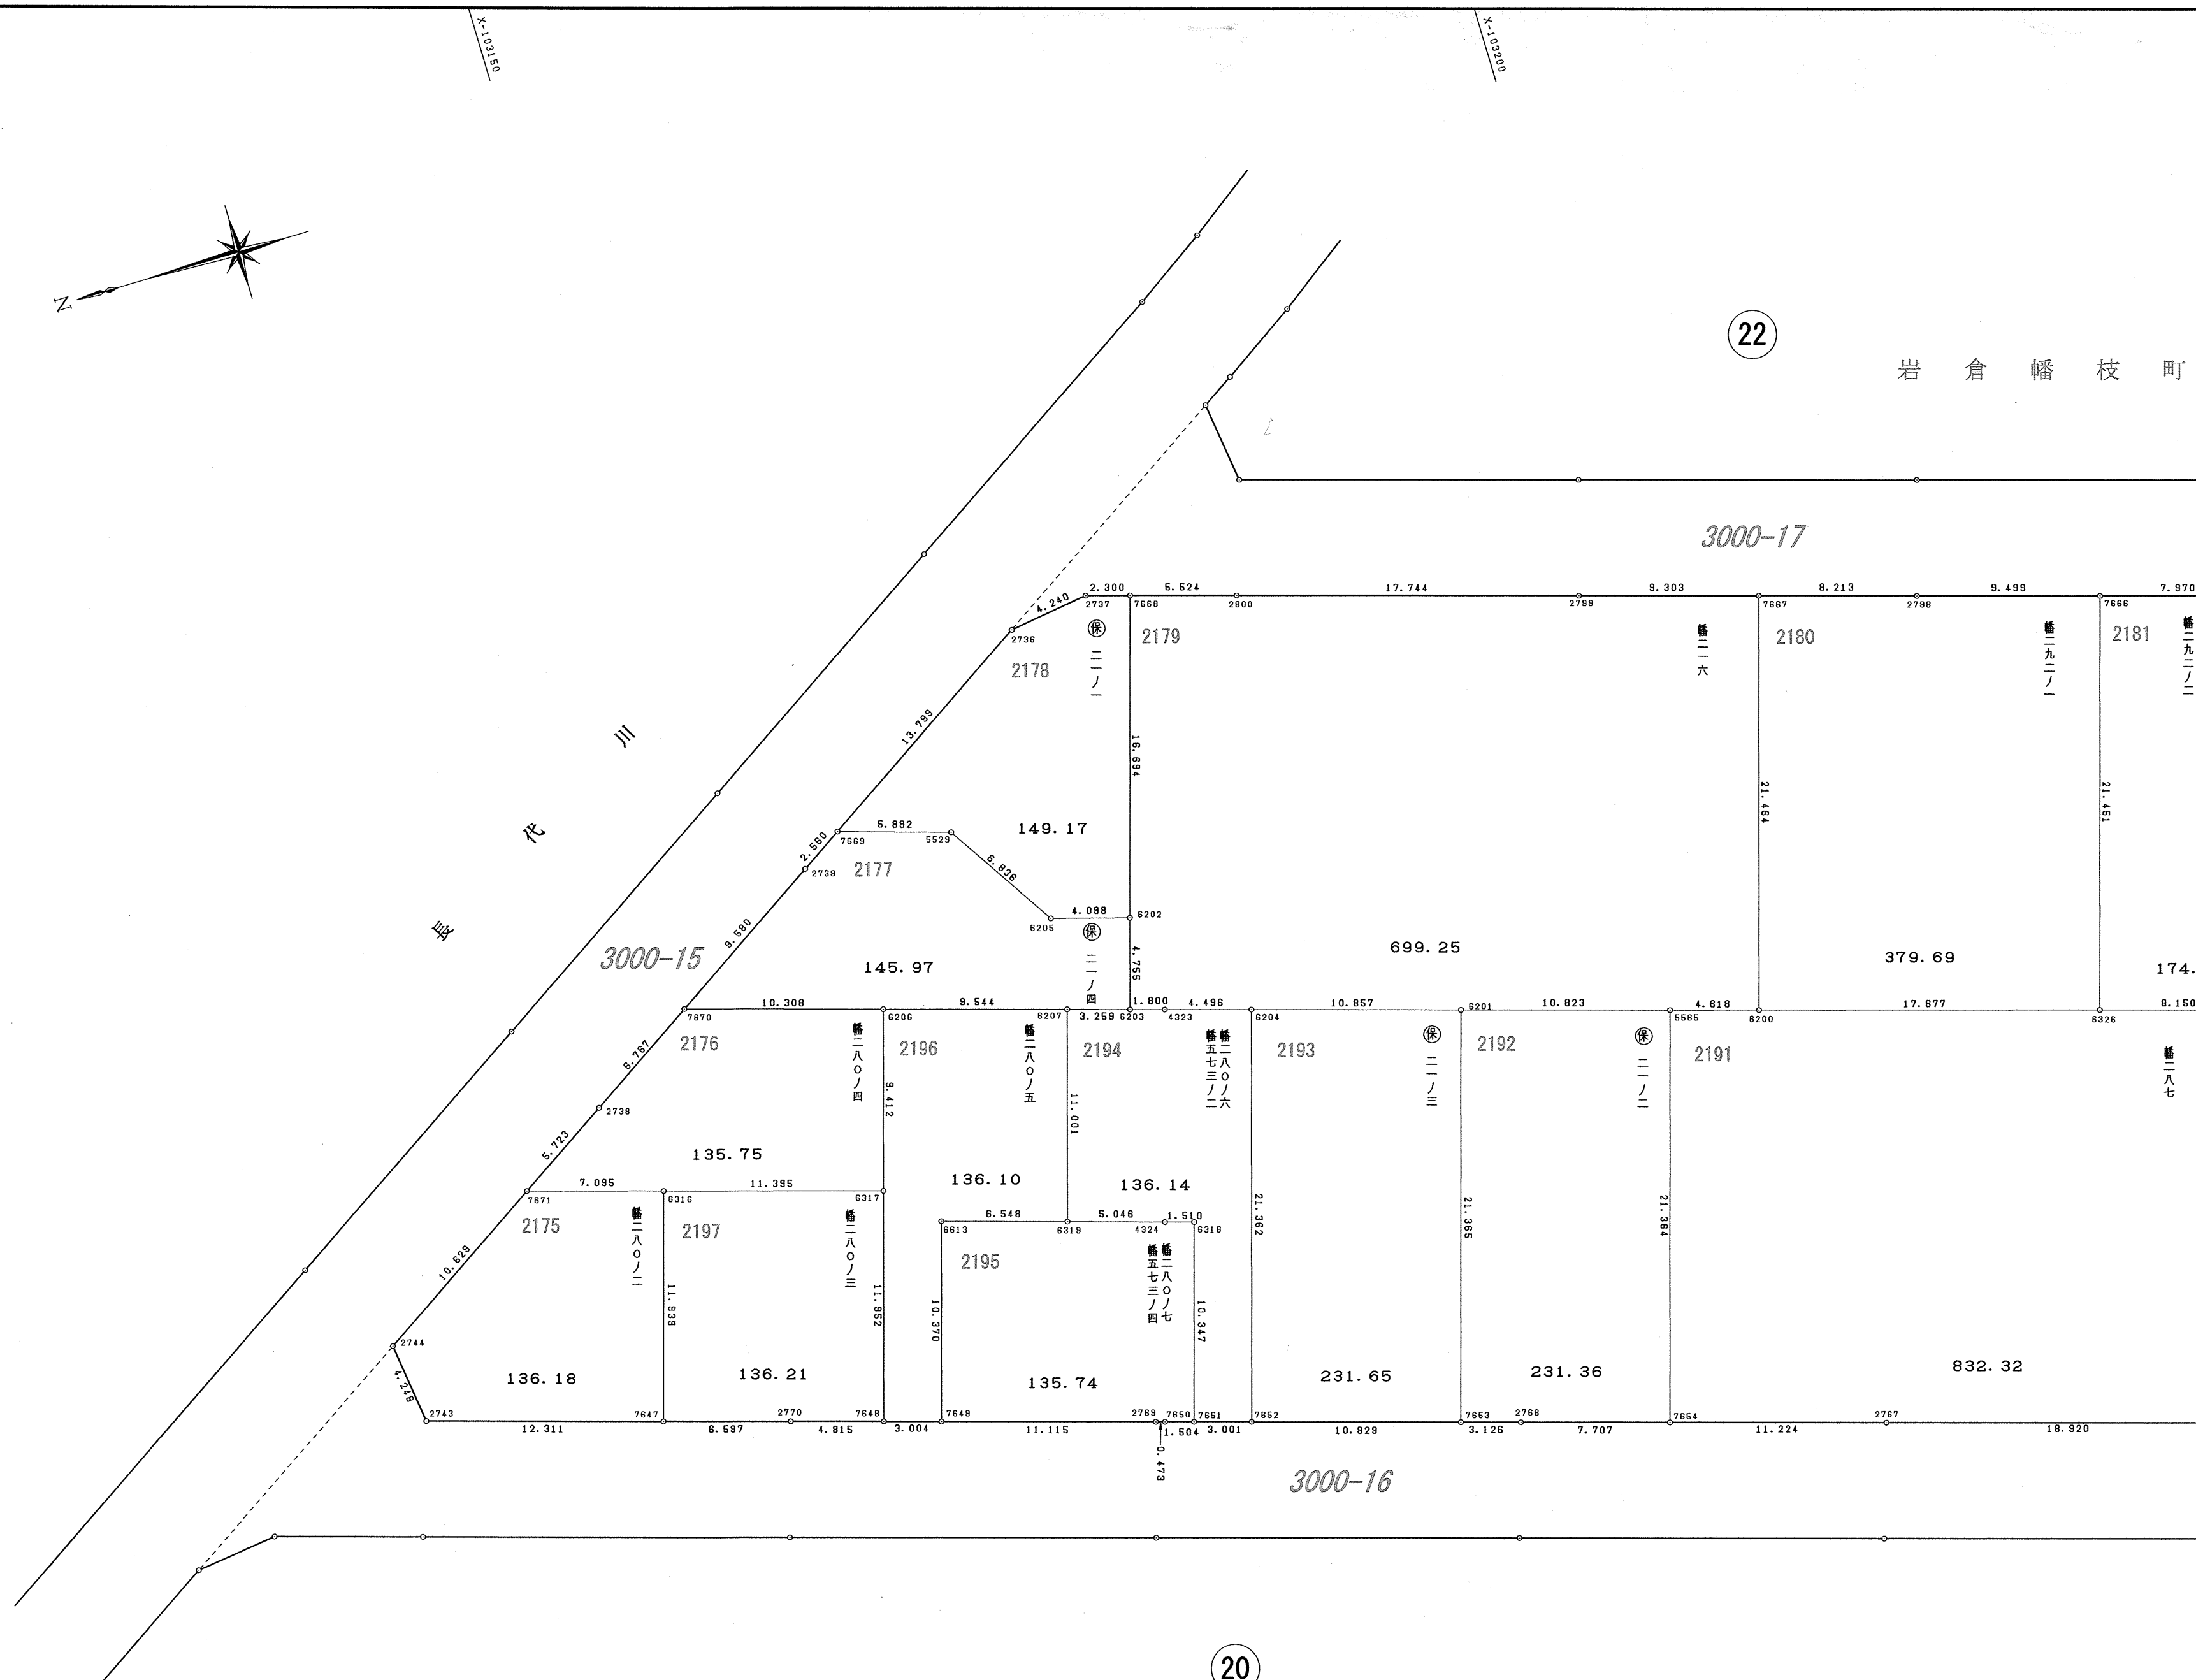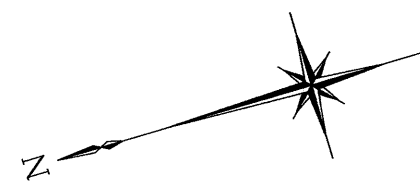

Y-21000

Y-21000

Y-21050

Y-21050

X-103150

X-103200


X-103150

20

22

岩倉幡枝町

図面の種類	画 地 出 来 形 確 認 測 量 図		
街 区 名	21 1/2	縮 尺	1 / 2 5 0
町 名	岩 倉 幡 枝 町		
京 都 市 洛 北 第 三 土 地 区 画 整 理 組 合			

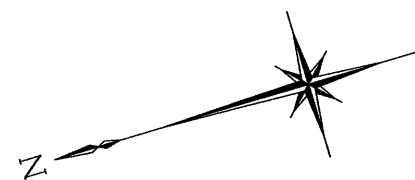

22

岩 倉 幡 枝 町

3000-17

3000-26

24

20

3000-16

図面の種類	画 地 出 来 形 確 認 測 量 図		
街 区 名	21	2/2	縮 尺 1／250
町 名	岩 倉 幡 枝 町		
京 都 市 洛 北 第 三 土 地 区 画 整 理 組 合			

2175			
地番	幡二八〇ノ二		
N O	X	Y	辺 長
2744	-103126.597	-21027.764	
2743	-103127.150	-21031.976	4.248
7647	-103138.956	-21035.466	12.311
6316	-103142.349	-21024.019	11.939
7671	-103135.541	-21022.021	7.095
2744	-103126.597	-21027.764	10.629
面積	136.1858585		
地積	136.18㎡		

2176			
地番	幡二八〇ノ四		
N O	X	Y	辺 長
7671	-103135.541	-21022.021	
6316	-103142.349	-21024.019	7.095
6317	-103153.279	-21027.244	11.395
6206	-103155.932	-21018.213	9.412
7670	-103146.052	-21015.273	10.308
2738	-103140.357	-21018.929	6.767
7671	-103135.541	-21022.021	5.723
面積	135.7525305		
地積	135.75㎡		

2177			
地番	保二一ノ四		
N O	X	Y	辺 長
7670	-103146.052	-21015.273	
6206	-103155.932	-21018.213	10.308
6207	-103165.081	-21020.931	9.544
6203	-103168.203	-21021.868	3.259
6202	-103169.549	-21017.307	4.755
6205	-103165.611	-21016.173	4.098
5529	-103161.905	-21010.428	6.836
7669	-103156.268	-21008.713	5.892
2739	-103154.114	-21010.097	2.560
7670	-103146.052	-21015.273	9.580
面積	145.9715605		
地積	145.97㎡		

2178			
地番	保二一ノ一		
N O	X	Y	辺 長
7669	-103156.268	-21008.713	
5529	-103161.905	-21010.428	5.892
6205	-103165.611	-21016.173	6.836
6202	-103169.549	-21017.307	4.098
7668	-103174.281	-21001.297	16.694
2737	-103172.075	-21000.644	2.300
2736	-103167.879	-21001.256	4.240
7669	-103156.268	-21008.713	13.799
面積	149.1775930		
地積	149.17㎡		

2179			
地番	幡二一六		
N O	X	Y	辺 長
7668	-103174.281	-21001.297	
6202	-103169.549	-21017.307	16.694
6203	-103168.203	-21021.868	4.755
4323	-103169.929	-21022.380	1.800
6204	-103174.240	-21023.659	4.496
6201	-103184.648	-21026.749	10.857
5565	-103195.024	-21029.829	10.823
6200	-103199.453	-21031.140	4.618
7667	-103205.513	-21010.549	21.464
2799	-103196.592	-21007.907	9.303
2800	-103179.579	-21002.864	17.744
7668	-103174.281	-21001.297	5.524
面積	699.2556775		
地積	699.25㎡		

2180			
地番	幡二九二ノ一		
N O	X	Y	辺 長
7667	-103205.513	-21010.549	
6200	-103199.453	-21031.140	21.464
6326	-103216.406	-21036.149	17.677
7666	-103222.496	-21015.580	21.451
2798	-103213.388	-21012.882	9.499
7667	-103205.513	-21010.549	8.213
面積	379.6968330		
地積	379.69㎡		

2181			
地番	幡二九二ノ二		
N O	X	Y	辺 長
7666	-103222.496	-21015.580	
6326	-103216.406	-21036.149	21.451
6329	-103224.220	-21038.466	8.150
7665	-103230.316	-21017.897	21.453
2797	-103230.138	-21017.844	0.185
7666	-103222.496	-21015.580	7.970
面積	174.9063710		
地積	174.90㎡		

2182			
地番	幡二九三ノ一		
N O	X	Y	辺 長
7665	-103230.316	-21017.897	
6329	-103224.220	-21038.466	21.453
6199	-103232.404	-21040.845	8.522
6198	-103233.126	-21041.072	0.756
6197	-103235.317	-21033.689	7.701
7664	-103239.202	-21020.534	13.716
7665	-103230.316	-21017.897	9.269
面積	198.7981450		
地積	198.79㎡		

2183			
地番	幡二九三ノ二		
N O	X	Y	辺 長
7664	-103239.202	-21020.534	
6197	-103235.317	-21033.689	13.716
6196	-103244.976	-21036.588	10.084
7663	-103248.881	-21023.406	13.748
2788	-103246.986	-21022.845	1.976
7664	-103239.202	-21020.534	8.119
面積	138.5589885		
地積	138.55㎡		

2184			
地番	幡二九三ノ三		
N O	X	Y	辺 長
7663	-103248.881	-21023.406	
6196	-103244.976	-21036.588	13.748
6197	-103235.317	-21033.689	10.084
6198	-103233.126	-21041.072	7.701
6195	-103244.943	-21044.615	12.336
6194	-103245.651	-21044.838	0.742
7662	-103251.754	-21024.257	21.466
7663	-103248.881	-21023.406	2.996
面積	141.8817625		
地積	141.88㎡		

2185			
地番	幡二九三ノ四		
N O	X	Y	辺 長
7662	-103251.754	-21024.257	
6194	-103245.651	-21044.838	21.466
3142	-103260.285	-21049.205	15.271
7660	-103262.066	-21041.709	7.704
5581	-103250.716	-21038.331	11.842
7661	-103254.635	-21025.110	13.789
7662	-103251.754	-21024.257	3.004
面積	157.2006315		
地積	157.20㎡		

2186			
地番	幡二九三ノ五		
N O	X	Y	辺 長
7661	-103254.635	-21025.110	
5581	-103250.716	-21038.331	13.789
7660	-103262.066	-21041.709	11.842
2785	-103264.341	-21032.136	9.839
2786	-103265.006	-21029.327	2.886
2787	-103264.211	-21027.945	1.594
7661	-103254.635	-21025.110	9.986
面積	157.6565355		
地積	157.65㎡		

2187			
地番	幡二九〇ノ四		
N O	X	Y	辺 長
3142	-103260.285	-21049.205	
6194	-103245.651	-21044.838	15.271
6195	-103244.943	-21044.615	0.742
7657	-103238.830	-21065.103	21.380
7658	-103241.710	-21065.959	3.004
6321	-103245.608	-21052.833	13.692
7659	-103258.503	-21056.715	13.466
3142	-103260.285	-21049.205	7.718
面積	165.8082780		
地積	165.80㎡		

2188			
地番	幡二九〇ノ五		
N O	X	Y	辺 長
7659	-103258.503	-21056.715	
6321	-103245.608	-21052.833	13.466
7658	-103241.710	-21065.959	13.692
3137	-103254.174	-21069.664	13.003
3136	-103255.611	-21068.858	1.647
3135	-103256.228	-21066.298	2.633
7659	-103258.503	-21056.715	9.849
面積	188.5171685		
地積	188.51㎡		

2189			
地番	幡二九〇ノ三		
N O	X	Y	辺 長
7657	-103238.830	-21065.103	
6195	-103244.943	-21044.615	21.380
6198	-103233.126	-21041.072	12.336
6199	-103232.404	-21040.845	0.756
6320	-103230.181	-21048.225	7.707
6330	-103239.866	-21051.117	10.107
7656	-103235.959	-21064.250	13.701
3138	-103236.020	-21064.268	0.063
7657	-103238.830	-21065.103	2.931
面積	141.8783400		
地積	141.87㎡		


2190			
地番	幡二九〇ノ二		
N O	X	Y	辺 長
7656	-103235.959	-21064.250	
6330	-103239.866	-21051.117	13.701
6320	-103230.181	-21048.225	10.107
7655	-103226.269	-21061.377	13.721
7656	-103235.959	-21064.250	10.106
面積	138.5871025		
地積	138.58㎡		

2191			
地番	幡二八七		
N O	X	Y	辺 長
7655	-103226.269	-21061.377	
6320	-103230.181	-21048.225	13.721
6199	-103232.404	-21040.845	7.707
6329	-103224.220	-21038.466	8.522
6326	-103216.406	-21036.149	8.150
6200	-103199.453	-21031.140	17.677
5565	-103195.024	-21029.829	4.618
7654	-103188.975	-21050.319	21.364
2767	-103199.736	-21053.510	11.224
2766	-103217.876	-21058.889	18.920
7655	-103226.269	-21061.377	8.754
面積	832.3298485		
地積	832.32㎡		

2192			
地番	保二一ノ二		
N O	X	Y	辺 長
7654	-103188.975	-21050.319	
5565	-103195.024	-21029.829	21.364
6201	-103184.648	-21026.749	10.823
7653	-103178.588	-21047.237	21.365
2768	-103181.585	-21048.128	3.126
7654	-103188.975	-21050.319	7.707
面積	231.3694995		
地積	231.36㎡		

2193			
地番	保二一ノ三		
N O	X	Y	辺 長
7653	-103178.588	-21047.237	
6201	-103184.648	-21026.749	21.365
6204	-103174.240	-21023.659	10.857
7652	-103168.207	-21044.152	21.362
7653	-103178.588	-21047.237	10.829
面積	231.6570710		
地積	231.65㎡		

2194			
地番	幡二八〇ノ六 幡五七三ノ二		
N O	X	Y	辺 長
7652	-103168.207	-21044.152	
6204	-103174.240	-21023.659	21.362
4323	-103169.929	-21022.380	4.496
6203	-103168.203	-21021.868	1.800
6207	-103165.081	-21020.931	3.259
6319	-103161.983	-21031.487	11.001
4324	-103166.816	-21032.939	5.046
6318	-103168.262	-21033.374	1.510
7651	-103165.330	-21043.297	10.347
7652	-103168.207	-21044.152	3.001
面積	136.1495005		
地積	136.14 ㎡		

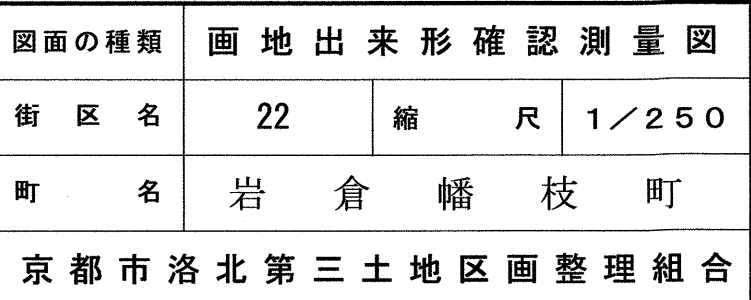

2198

地 番	保二二ノ一		
N O	X	Y	辺 長
2728	-103181.413	-20997.150	
2727	-103198.274	-21002.145	17.585
7392	-103199.804	-21002.598	1.595
6191	-103202.522	-20993.452	9.541
7416	-103186.977	-20988.864	16.207
2731	-103186.293	-20989.356	0.842
2730	-103182.452	-20991.913	4.614
2729	-103180.820	-20992.951	1.934
2728	-103181.413	-20997.150	4.240
面積	182.6033005		
地積	182.60 ㎡		

2199

地番	幡五七五ノ二		
N O	X	Y	辺 長
7416	-103186.977	-20988.864	
6191	-103202.522	-20993.452	16.207
6184	-103205.813	-20982.387	11.544
7415	-103198.124	-20980.119	8.016
2899	-103197.256	-20980.887	1.158
2898	-103193.703	-20983.838	4.618
2897	-103190.043	-20986.661	4.622
7416	-103186.977	-20988.864	3.775
面積	138.0363060		
地積	138.03㎡		

2200			
地番	幡四三〇ノ四		
N O	X	Y	辺 長
7415	-103198.124	-20980.119	
6184	-103205.813	-20982.387	8.016
5596	-103214.802	-20985.034	9.370
5595	-103219.476	-20986.428	4.877
6189	-103222.075	-20977.712	9.095
7414	-103205.764	-20972.893	17.007
2901	-103204.065	-20974.628	2.428
2900	-103200.572	-20977.952	4.821
7415	-103198.124	-20980.119	3.269
面積	177.6965845		
地積	177.69 ㎡		

2201

地番	保二二ノ二		
N O	X	Y	辺 長
7414	-103205.764	-20972.893	
6189	-103222.075	-20977.712	17.007
7413	-103225.439	-20966.316	11.882
2201	-103217.370	-20963.928	8.414
2699	-103212.583	-20965.392	5.005
2903	-103210.403	-20967.911	3.331
2902	-103207.299	-20971.326	4.614
7414	-103205.764	-20972.893	2.193
面積	163.4331590		
地積	163.43㎡		

2202

地 番	保二二ノ七		
N O	X	Y	辺 長
7413	-103225.439	-20966.316	
6189	-103222.075	-20977.712	11.882
5595	-103219.476	-20986.428	9.095
5594	-103222.113	-20987.213	2.751
5593	-103226.876	-20988.619	4.966
5592	-103229.406	-20989.379	2.641
6190	-103230.493	-20989.690	1.130
7412	-103236.461	-20969.578	20.978
2202	-103235.803	-20969.383	0.686
7413	-103225.439	-20966.316	10.808
面積	240.9713370		
地積	240.97 ㎡		

2203			
地 番	幡二五九		
N O	X	Y	辺 長
7412	-103236.461	-20969.578	
6190	-103230.493	-20989.690	20.978
5591	-103231.019	-20989.862	0.553
6331	-103233.425	-20990.590	2.513
6188	-103238.792	-20992.153	5.589
7411	-103244.748	-20972.032	20.984
7412	-103236.461	-20969.578	8.642
面積	181.6229555		
地積	181.62 ㎡		

2204

地番	幡二五九ノ三		
N O	X	Y	辺 長
7411	-103244.748	-20972.032	
6188	-103238.792	-20992.153	20.984
6187	-103239.906	-20992.496	1.165
6186	-103247.063	-20994.618	7.464
7410	-103253.037	-20974.486	20.999
7411	-103244.748	-20972.032	8.644
面積	181.3638090		
地積	181.36 ㎡		

2205			
地 番	幡二五九ノ四		
N O	X	Y	辺 長
7410	-103253.037	-20974.486	
6186	-103247.063	-20994.618	20.999
6185	-103248.805	-20995.129	1.815
6336	-103255.368	-20997.078	6.846
4328	-103256.586	-20992.965	4.289
7409	-103261.329	-20976.944	16.708
2203	-103254.266	-20974.850	7.366
7410	-103253.037	-20974.486	1.281
面積	181.7311570		
地積	181.73 m ²		

2206			
地 番	幡五六四ノ二		
N O	X	Y	辺 長
7409	-103261. 329	-20976. 944	
4328	-103256. 586	-20992. 965	16. 708
4331	-103257. 878	-20993. 293	1. 332
7408	-103262. 606	-20977. 323	16. 655
7409	-103261. 329	-20976. 944	1. 332
面積	22. 2202190		
地積	22. 22 ㎡		

2207			
地番	幡二六〇ノ三 幡一一六八ノ二		
N O	X	Y	辺 長
7408	-103262.606	-20977.323	
4331	-103257.878	-20993.293	16.655
4329	-103263.957	-20994.836	6.271
4332	-103265.461	-20995.193	1.545
4330	-103269.998	-20996.269	4.662
2776	-103275.505	-20985.181	12.380
2204	-103272.698	-20980.315	5.617
7407	-103270.100	-20979.545	2.709
7408	-103262.606	-20977.323	7.816
面積	217.6216295		
地積	217.62 ㎡		

2208				
地番	保二二ノ三			
N O	X	Y	辺 長	
2776	-103275.505	-20985.181		
4330	-103269.998	-20996.269	12.380	
7406	-103272.711	-20996.913	2.788	
2777	-103274.972	-20987.391	9.786	
2776	-103275.505	-20985.181	2.273	
面積	16.7749180			
地積	16.77 ㎡			

2209			
地番	保二ノ四		
N O	X	Y	辺 長
6336	-103255.368	-20997.078	
6334	-103260.682	-20998.339	5.461
7405	-103271.749	-21000.963	11.373
7406	-103272.711	-20996.913	4.162
4330	-103269.998	-20996.269	2.788
4332	-103265.461	-20995.193	4.662
4329	-103263.957	-20994.836	1.545
4331	-103257.878	-20993.293	6.271
4328	-103256.586	-20992.965	1.332
6336	-103255.368	-20997.078	4.289
面積	70.0772535		
地積	70.07 m ²		

2210			
地番	幡二九四ノ四		
N O	X	Y	辺 長
7405	-103271.749	-21000.963	
6334	-103260.682	-20998.339	11.373
7402	-103254.611	-21018.843	21.383
7403	-103257.389	-21019.665	2.897
6332	-103261.291	-21006.456	13.773
7404	-103269.961	-21008.501	8.907
2780	-103271.246	-21003.084	5.567
7405	-103271.749	-21000.963	2.179
面積	129.4558830		
地積	129.45 ㎡		

2211

地番	幡二九四ノ五		
N O	X	Y	辺 長
7404	-103269.961	-21008.501	
6332	-103261.291	-21006.456	8.907
7403	-103257.389	-21019.665	13.773
2790	-103265.504	-21022.066	8.462
2791	-103266.928	-21021.262	1.635
2792	-103267.534	-21018.730	2.603
7404	-103269.961	-21008.501	10.512
面積	129.5347970		
地積	129.53 ㎡		

2212			
地番	幡二九四ノ三		
N O	X	Y	辺 長
7402	-103254.611	-21018.843	
6334	-103260.682	-20998.339	21.383
6336	-103255.368	-20997.078	5.461
6185	-103248.805	-20995.129	6.846
6335	-103246.621	-21002.520	7.706
6333	-103255.636	-21005.197	9.404
7401	-103251.828	-21018.020	13.376
7402	-103254.611	-21018.843	2.902
面積	134.3470875		
地積	134.34 ㎡		

2213

地番	幡二九四ノ一		
N O	X	Y	辺 長
7401	-103251.828	-21018.020	
6333	-103255.636	-21005.197	13.376
6335	-103246.621	-21002.520	9.404
7400	-103242.823	-21015.350	13.380
2789	-103248.695	-21017.093	6.125
7401	-103251.828	-21018.020	3.267
面積	125.7428230		
地積	125.74 m ²		

2214

地番	幡二五九ノ五		
N O	X	Y	辺 長
7400	-103242.823	-21015.350	
6335	-103246.621	-21002.520	13.380
6185	-103248.805	-20995.129	7.706
6186	-103247.063	-20994.618	1.815
6187	-103239.906	-20992.496	7.464
7399	-103233.938	-21012.712	21.078
7400	-103242.823	-21015.350	9.268
面積	195.5355150		
地積	195.53 m ²		

2215

地番	幡二五九ノ二 幡二六一ノ八		
N O	X	Y	辺 長
7399	-103233.938	-21012.712	
6187	-103239.906	-20992.496	21.078
6188	-103238.792	-20992.153	1.165
6331	-103233.425	-20990.590	5.589
5591	-103231.019	-20989.862	2.513
7397	-103225.043	-21010.074	21.076
7398	-103227.451	-21010.788	2.511
2796	-103231.894	-21012.105	4.634
7399	-103233.938	-21012.712	2.132
面積	195.4454360		
地積	195.44㎡		

2216			
地 番	幡二六〇ノ六 幡二六一ノ三 幡二六二ノ一 幡一一六八ノ三 幡一一七三ノ一		
	X	Y	辺 長
	N O		
7397	-103225.043	-21010.074	
5591	-103231.019	-20989.862	21.076
6190	-103230.493	-20989.690	0.553
5592	-103229.406	-20989.379	1.130
5593	-103226.876	-20988.619	2.641
5594	-103222.113	-20987.213	4.966
7394	-103216.134	-21007.434	21.086
7395	-103220.896	-21008.845	4.966
7396	-103223.430	-21009.596	2.642
7397	-103225.043	-21010.074	1.682
面積	195.9429070		
地積	195.94 ㎡		

2217

地 番	幡二八三A		
N O	X	Y	辺 長
7393	-103208.827	-21005.270	
2726	-103215.090	-21007.124	6.531
7394	-103216.134	-21007.434	1.089
5594	-103222.113	-20987.213	21.086
5595	-103219.476	-20986.428	2.751
5596	-103214.802	-20985.034	4.877
7393	-103208.827	-21005.270	21.099
面積	160.8227410		
地積	160.82 m ²		

2280

地番	幡五七二ノ二		
N O	X	Y	辺 長
2697	-103223.845	-20949.818	
2698	-103225.322	-20953.766	4.215
7438	-103234.375	-20956.458	9.444
7453	-103238.819	-20941.477	15.626
3764	-103233.893	-20934.065	8.899
3763	-103232.471	-20933.433	1.556
2911	-103230.753	-20937.182	4.123
2910	-103228.688	-20941.332	4.635
2909	-103226.484	-20945.372	4.602
2697	-103223.845	-20949.818	5.170
面積	196.1112630		
地積	196.11㎡		

2281

地番	保二三ノ二		
N O	X	Y	辺 長
7452	-103240.249	-20943.627	
7453	-103238.819	-20941.477	2.582
7438	-103234.375	-20956.458	15.626
7439	-103236.274	-20957.023	1.981
7452	-103240.249	-20943.627	13.973
面積	29.3311545		
地積	29.33㎡		

2282

地番	保二三ノ三		
N O	X	Y	辺 長
7439	-103236.274	-20957.023	
7440	-103237.973	-20957.529	1.772
7451	-103241.529	-20945.553	12.492
7452	-103240.249	-20943.627	2.312
7439	-103236.274	-20957.023	13.973
面積	23.4746450		
地積	23.47㎡		


2283

地番	幡二六〇ノ四 幡四六四 幡五一九 幡一一六六ノ一 幡一一七四		
N O	X	Y	辺 長
7451	-103241.529	-20945.553	
7440	-103237.973	-20957.529	12.492
2700	-103239.233	-20957.903	1.314
7441	-103239.743	-20958.054	0.531
7442	-103241.608	-20958.604	1.944
7443	-103243.688	-20959.218	2.168
7444	-103244.249	-20959.384	0.585
7445	-103244.464	-20959.448	0.224
7446	-103246.394	-20952.874	6.851
7447	-103246.247	-20952.652	0.266
7448	-103245.825	-20952.017	0.762
7449	-103244.260	-20949.664	2.825
7450	-103242.859	-20947.555	2.531
7451	-103241.529	-20945.553	2.403
面積	65.3374630		
地積	65.33㎡		

2284

地番	保二三ノ一		
N O	X	Y	辺 長
2702	-103249.145	-20957.013	
7446	-103246.394	-20952.874	4.969
7445	-103244.464	-20959.448	6.851
2701	-103248.113	-20960.525	3.804
2702	-103249.145	-20957.013	3.660
面積	20.0000480		
地積	20.00㎡		

図面の種類	画地出来形確認測量図		
街 区 名	23	求 積 表	
町 名	岩 倉 幡 枝 町		
京都市洛北第三土地区画整理組合			

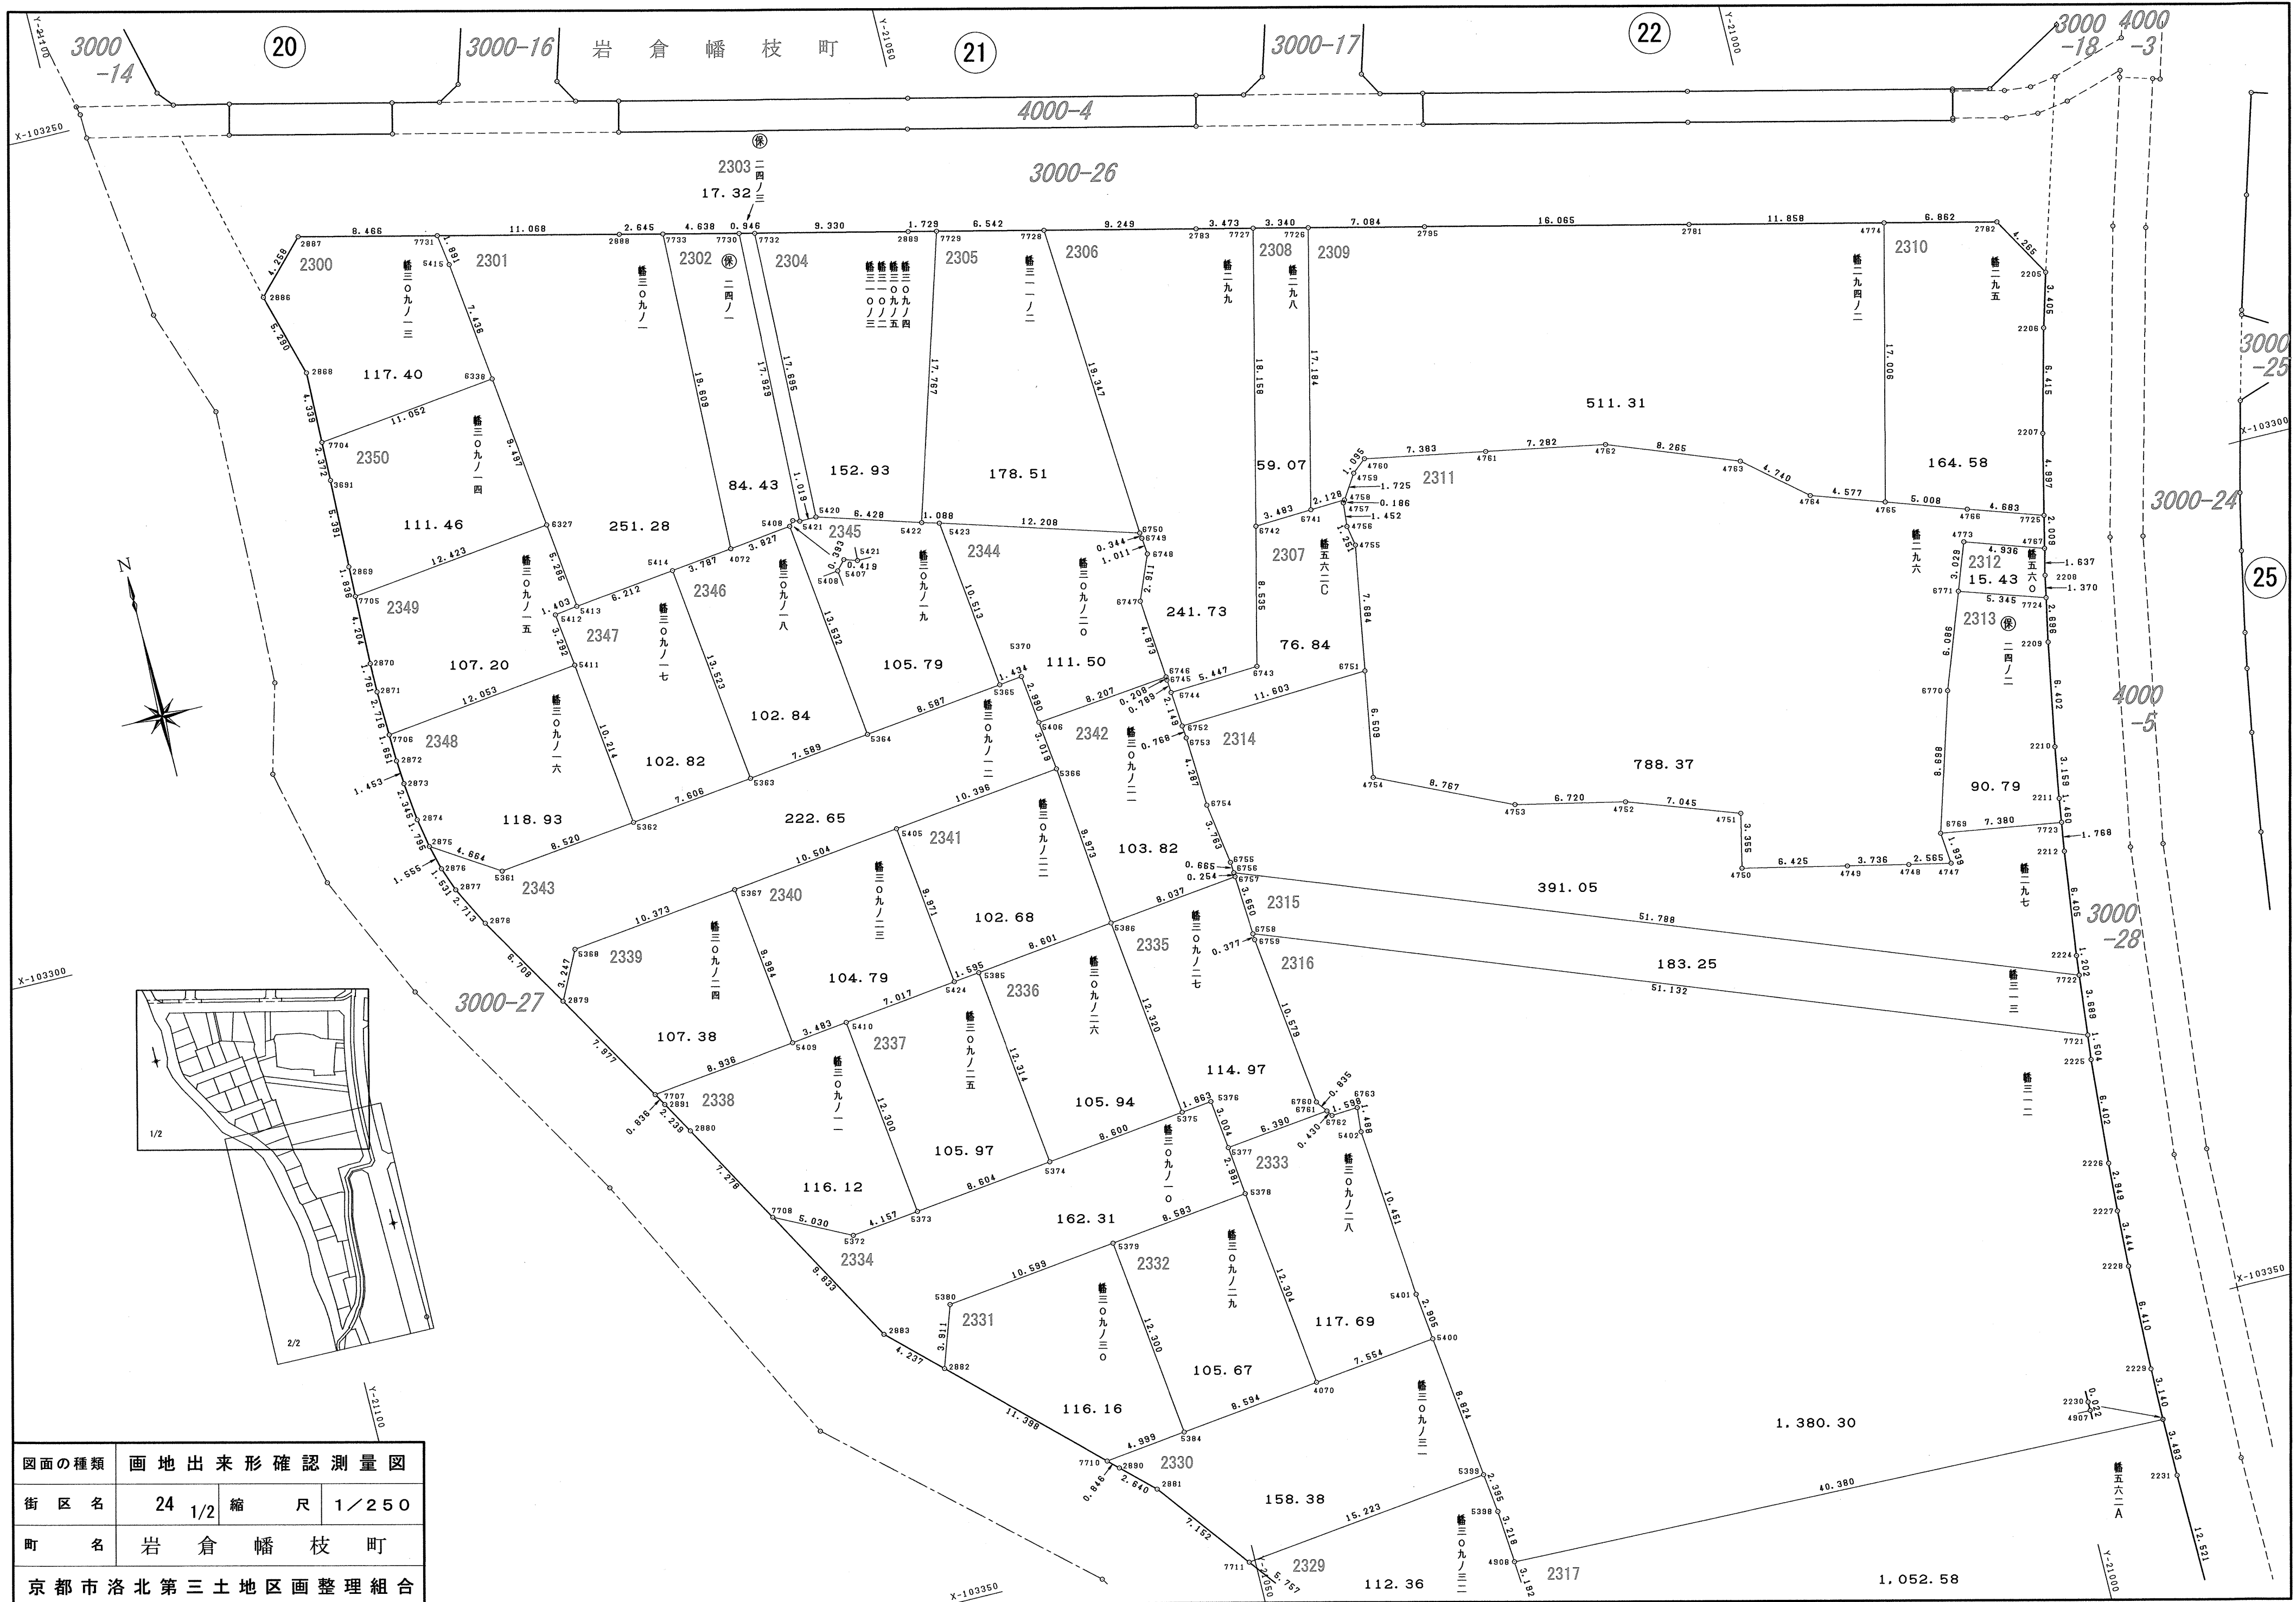

図面の種類	画地出来形確認測量図		
街 区 名	24 1/2	縮 尺	1／250
町 名	岩 倉 幡 枝 町		
京 都 市 洛 北 第 三 土 地 区 画 整 理 組 合			

2300			
地番	幡三〇九ノ一三		
N O	X	Y	辺 長
2886	-103262.680	-21090.159	
2868	-103267.768	-21088.709	5.290
7704	-103272.106	-21088.804	4.339
6338	-103270.817	-21077.827	11.052
5415	-103263.431	-21078.693	7.436
7731	-103261.561	-21078.978	1.891
2887	-103259.603	-21087.215	8.466
2886	-103262.680	-21090.159	4.258
面積	117.4084165		
地積	117.40 ㎡		

2301			
地番	幡三〇九ノ一		
N O	X	Y	辺 長
7731	-103261.561	-21078.978	
5415	-103263.431	-21078.693	1.891
6338	-103270.817	-21077.827	7.436
6327	-103280.251	-21076.729	9.497
5413	-103285.503	-21076.134	5.285
5414	-103284.777	-21069.964	6.212
4072	-103284.332	-21066.203	3.787
7733	-103264.731	-21065.635	19.609
2888	-103264.120	-21068.209	2.645
7731	-103261.561	-21078.978	11.068
面積	251.2854760		
地積	251.28 ㎡		

2302			
地番	保二四ノ一		
N O	X	Y	辺 長
7733	-103264.731	-21065.635	
4072	-103284.332	-21066.203	19.609
5408	-103283.883	-21062.402	3.827
5407	-103283.592	-21062.137	0.393
5421	-103283.723	-21061.738	0.419
7730	-103265.804	-21061.122	17.929
7733	-103264.731	-21065.635	4.638
面積	84.4305840		
地積	84.43 ㎡		

2303			
地番	保二四ノ三		
N O	X	Y	辺 長
7730	-103265.804	-21061.122	
5421	-103283.723	-21061.738	17.929
5420	-103283.710	-21060.719	1.019
7732	-103266.022	-21060.201	17.695
7730	-103265.804	-21061.122	0.946
面積	17.3275125		
地積	17.32 ㎡		

2304			
地番	幡三〇九ノ四 幡三一〇ノ二		幡三〇九ノ五 幡三一〇ノ三
	N O	X	Y
辺長			
7732	-103266.022	-21060.201	
5420	-103283.710	-21060.719	17.695
5422	-103285.588	-21054.571	6.428
7729	-103268.578	-21049.440	17.767
2889	-103268.179	-21051.123	1.729
7732	-103266.022	-21060.201	9.330
面積			152.9349825
地積			152.93 ㎡

2305

地番	幡三一ノ二		
N O	X	Y	辺 長
7729	-103268.578	-21049.440	
5422	-103285.588	-21054.571	17.767
5423	-103285.882	-21053.523	1.088
6750	-103289.395	-21041.831	12.208
7728	-103270.087	-21043.074	19.347
7729	-103268.578	-21049.440	6.542
面積	178.5179910		
地積	178.51 m ²		

2306			
地番	幡二九九		
N O	X	Y	辺 長
7728	-103270.087	-21043.074	
6750	-103289.395	-21041.831	19.347
6749	-103289.736	-21041.785	0.344
6748	-103290.743	-21041.688	1.011
6747	-103293.437	-21042.791	2.911
6746	-103298.293	-21042.376	4.873
6745	-103298.501	-21042.362	0.208
6744	-103299.288	-21042.294	0.789
6743	-103298.997	-21036.854	5.447
6742	-103290.694	-21034.875	8.535
7727	-103273.023	-21030.695	18.158
2783	-103272.220	-21034.074	3.473
7728	-103270.087	-21043.074	9.249
面積	241.7358225		
地積	241.73 ㎡		

2307			
地番	幡五六二C		
N O	X	Y	辺 長
6752	-103301.431	-21042.130	
6751	-103300.844	-21030.541	11.603
4755	-103293.264	-21029.280	7.684
4756	-103292.033	-21029.508	1.251
4757	-103290.587	-21029.372	1.452
4758	-103290.431	-21029.269	0.186
6741	-103290.519	-21031.396	2.128
6742	-103290.694	-21034.875	3.483
6743	-103298.997	-21036.854	8.535
6744	-103299.288	-21042.294	5.447
6752	-103301.431	-21042.130	2.149
面積	76.8484855		
地積	76.84 ㎡		

2308			
地番	幡二九八		
N O	X	Y	辺 長
7727	-103273.023	-21030.695	
6742	-103290.694	-21034.875	18.158
6741	-103290.519	-21031.396	3.483
7726	-103273.795	-21027.445	17.184
7727	-103273.023	-21030.695	3.340
面積	59.0745405		
地積	59.07 ㎡		

2309			
地番	幡二九四ノ二		
N O	X	Y	辺 長
7726	-103273.795	-21027.445	
6741	-103290.519	-21031.396	17.184
4758	-103290.431	-21029.269	2.128
4759	-103288.983	-21028.331	1.725
4760	-103288.287	-21027.485	1.095
4761	-103289.618	-21020.222	7.383
4762	-103290.942	-21013.061	7.282
4763	-103293.893	-21005.340	8.265
4764	-103296.940	-21001.709	4.740
4765	-103298.418	-20997.377	4.577
4774	-103281.887	-20993.384	17.006
2781	-103279.146	-21004.921	11.858
2795	-103275.433	-21020.552	16.065
7726	-103273.795	-21027.445	7.084
面積	511.3173340		
地積	511.31㎡		

2310			
地番	幡二九五		
N O	X	Y	辺長
4774	-103281.887	-20993.384	
4765	-103298.418	-20997.377	17.006
4766	-103300.035	-20992.637	5.008
7725	-103301.517	-20988.194	4.683
2207	-103296.645	-20987.079	4.997
2206	-103290.430	-20985.489	6.415
2205	-103287.155	-20984.554	3.405
2782	-103283.473	-20986.707	4.265
4774	-103281.887	-20993.384	6.862
面積	164.5879710		
地積	164.58 ㎡		

2311

地 番	幡二九六		
N O	X	Y	辺 長
7725	-103301.517	-20988.194	
4766	-103300.035	-20992.637	4.683
4765	-103298.418	-20997.377	5.008
4764	-103296.940	-21001.709	4.577
4763	-103293.893	-21005.340	4.740
4762	-103290.942	-21013.061	8.265
4761	-103289.618	-21020.222	7.282
4760	-103288.287	-21027.485	7.383
4759	-103288.983	-21028.331	1.095
4758	-103290.431	-21029.269	1.725
4757	-103290.587	-21029.372	0.186
4756	-103292.033	-21029.508	1.452
4755	-103293.264	-21029.280	1.251
6751	-103300.844	-21030.541	7.684

2312

地番	幡五六〇		
N O	X	Y	辺 長
7724	-103306.416	-20989.273	
2208	-103305.072	-20989.007	1.370
4767	-103303.476	-20988.642	1.637
4773	-103301.914	-20993.325	4.936
6771	-103304.763	-20994.356	3.029
7724	-103306.416	-20989.273	5.345
面積	15.4366640		
地積	15.43 ㎡		

2313

地番	保二四ノ二		
N O	X	Y	辺 長
7724	-103306.416	-20989.273	
6771	-103304.763	-20994.356	5.345
6770	-103310.485	-20996.431	6.086
6769	-103318.818	-20998.926	8.698
7723	-103319.929	-20991.630	7.380
2211	-103318.483	-20991.423	1.460
2210	-103315.363	-20990.925	3.159
2209	-103309.061	-20989.797	6.402
7724	-103306.416	-20989.273	2.696
面積	90.7957410		
地積	90.79 ㎡		

2314			
地番	幡二九七		
N O	X	Y	辺 長
7723	-103319.929	-20991.630	
6769	-103318.818	-20998.926	7.380
4747	-103320.749	-20998.744	1.939
4748	-103320.212	-21001.253	2.565
4749	-103319.401	-21004.900	3.736
4750	-103318.005	-21011.172	6.425
4751	-103314.730	-21010.443	3.355
4752	-103312.374	-21017.083	7.045
4753	-103310.941	-21023.649	6.720
4754	-103307.265	-21031.609	8.767
6751	-103300.844	-21030.541	6.509
6752	-103301.431	-21042.130	11.603
6753	-103302.197	-21042.064	0.768
6754	-103306.478	-21041.835	4.287
6755	-103310.199	-21041.268	3.763
6756	-103310.863	-21041.227	0.665
7722	-103329.231	-20992.805	51.788
2224	-103328.035	-20992.683	1.202
2212	-103321.680	-20991.881	6.405
7723	-103319.929	-20991.630	1.768
面積	391.0571825		
地積	391.05 ㎡		

2315			
地番	幡三一三		
N O	X	Y	辺 長
7722	-103329.231	-20992.805	
6756	-103310.863	-21041.227	51.788
6757	-103311.117	-21041.213	0.254
6758	-103314.760	-21040.984	3.650
7721	-103332.902	-20993.178	51.132
7722	-103329.231	-20992.805	3.689
面積	183.2535330		
地積	183.25 m ²		

2321			
地番	幡三二一		
N O	X	Y	辺 長
4781	-103459.665	-21032.318	
3816	-103466.881	-21032.501	7.218
3815	-103469.922	-21032.647	3.044
3813	-103472.043	-21032.407	2.134
3814	-103471.925	-21032.214	0.226
3172	-103466.532	-21028.620	6.480
3635	-103464.334	-21026.618	2.973
3173	-103462.219	-21024.616	2.912
7717	-103461.977	-21024.382	0.336
4782	-103459.306	-21024.398	2.671
4781	-103459.665	-21032.318	7.928
面積	58.2822900		
地積	58.28 ㎡		

2322			
地番	幡三二〇		
N O	X	Y	辺 長
4779	-103439.153	-21033.111	
3819	-103444.380	-21032.833	5.234
3821	-103449.034	-21032.597	4.659
3818	-103454.521	-21032.346	5.492
3817	-103457.441	-21032.262	2.921
4781	-103459.665	-21032.318	2.224
4782	-103459.306	-21024.398	7.928
6782	-103443.278	-21024.493	16.028
4768	-103442.854	-21024.327	0.455
4769	-103442.536	-21023.515	0.872
4770	-103442.412	-21022.656	0.867
4771	-103442.533	-21020.438	2.221
4780	-103438.570	-21020.260	3.966
4779	-103439.153	-21033.111	12.864
面積	183.6214450		
地積	183.62 ㎡		

2323

地番	幡三一九		
N O	X	Y	辺 長
6780	-103415.603	-21022.265	
7716	-103416.136	-21034.005	11.752
3812	-103416.160	-21034.002	0.024
3820	-103421.069	-21034.074	4.909
4779	-103439.153	-21033.111	18.109
4780	-103438.570	-21020.260	12.864
4778	-103419.907	-21019.424	18.681
6779	-103419.752	-21022.090	2.670
6780	-103415.603	-21022.265	4.152
面積	309.2906760		
地積	309.29 ㎡		

2324

地番	幡三一六		
N O	X	Y	辺 長
7716	-103416.136	-21034.005	
6780	-103415.603	-21022.265	11.752
4776	-103409.147	-21023.196	6.522
4777	-103409.672	-21034.738	11.553
7716	-103416.136	-21034.005	6.505
面積	75.6409880		
地積	75.64 ㎡		

2325			
地 番	幡三一五		
N O	X	Y	辺 長
4776	-103409.147	-21023.196	
4775	-103391.145	-21025.793	18.188
6776	-103391.173	-21026.656	0.863
6777	-103391.327	-21027.856	1.209
7715	-103392.448	-21037.447	9.656
3823	-103392.482	-21037.417	0.045
3824	-103396.893	-21036.518	4.501
3826	-103403.808	-21035.403	7.004
4777	-103409.672	-21034.738	5.901
4776	-103409.147	-21023.196	11.553
面積	204.0329775		
地積	204.03 ㎡		

2326			
地番	幡三〇九ノ三三		
N O	X	Y	辺 長
7714	-103381.387	-21040.125	
2893	-103381.806	-21040.057	0.424
2892	-103388.301	-21039.085	6.567
3825	-103390.839	-21038.647	2.575
3822	-103391.297	-21038.481	0.487
7715	-103392.448	-21037.447	1.547
6777	-103391.327	-21027.856	9.656
5388	-103390.647	-21028.057	0.709
5389	-103390.072	-21028.262	0.610
5390	-103384.875	-21030.163	5.533
5391	-103380.321	-21030.922	4.616
7714	-103381.387	-21040.125	9.264
面積	108.9682375		
地積	108.96 ㎡		

2327			
地番	幡三〇九ノ八		
N O	X	Y	辺 長
7713	-103370.214	-21041.930	
7714	-103381.387	-21040.125	11.317
5391	-103380.321	-21030.922	9.264
5392	-103375.572	-21031.701	4.812
5393	-103369.071	-21032.171	6.517
7713	-103370.214	-21041.930	9.825
面積	106.5666785		
地積	106.56 ㎡		

2328			
地 番	幡三〇九ノ九		
N O	X	Y	辺 長
7712	-103360.139	-21045.332	
2885	-103367.224	-21042.413	7.662
7713	-103370.214	-21041.930	3.028
5393	-103369.071	-21032.171	9.825
5394	-103368.137	-21032.238	0.936
5395	-103360.463	-21034.374	7.965
5396	-103358.885	-21034.477	1.581
7712	-103360.139	-21045.332	10.927
面積	104.6282830		
地積	104.62 ㎡		

2329			
地番	幡三〇九ノ三二		
N O	X	Y	辺長
7711	-103351.877	-21050.368	
2884	-103356.439	-21046.856	5.757
7712	-103360.139	-21045.332	4.001
5396	-103358.885	-21034.477	10.927
4908	-103355.701	-21034.706	3.192
5398	-103352.492	-21034.952	3.218
5399	-103350.115	-21035.247	2.395
7711	-103351.877	-21050.368	15.223
面積	112.3652075		
地積	112.36㎡		

2330			
地 番	幡三〇九ノ三一		
N O	X	Y	辺 長
7710	-103343.819	-21057.270	
2890	-103344.402	-21056.656	0.846
2881	-103346.209	-21054.731	2.640
7711	-103351.877	-21050.368	7.152
5399	-103350.115	-21035.247	15.223
5400	-103341.350	-21036.266	8.824
4070	-103342.230	-21043.769	7.554
5384	-103343.231	-21052.305	8.594
7710	-103343.819	-21057.270	4.999
面積	158.3810990		
地積	158.38 ㎡		

2331			
地番	幡三〇九ノ三〇		
N O	X	Y	辺長
2882	-103335.971	-21065.536	
7710	-103343.819	-21057.270	11.398
5384	-103343.231	-21052.305	4.999
5379	-103331.016	-21053.754	12.300
5380	-103332.267	-21064.279	10.599
2882	-103335.971	-21065.536	3.911
面積	116.1673730		
地積	116.16 ㎡		

2332			
地番	幡三〇九ノ二九		
N O	X	Y	辺 長
5379	-103331.016	-21053.754	
5384	-103343.231	-21052.305	12.300
4070	-103342.230	-21043.769	8.594
5378	-103330.012	-21045.229	12.304
5379	-103331.016	-21053.754	8.583
面積	105.6709895		
地積	105.67 ㎡		

2333			
地番	幡三〇九ノ二八		
N O	X	Y	辺 長
5377	-103327.049	-21045.562	
5378	-103330.012	-21045.229	2.981
4070	-103342.230	-21043.769	12.304
5400	-103341.350	-21036.266	7.554
5401	-103338.464	-21036.604	2.905
5402	-103328.050	-21037.485	10.451
6763	-103326.566	-21037.366	1.488
6762	-103326.669	-21038.961	1.598
6761	-103326.320	-21039.213	0.430
5377	-103327.049	-21045.562	6.390
面積	117.6979385		
地積	117.69 m ²		

2334			
地番	幡三〇九ノ一〇		
N O	X	Y	辺長
7708	-103324.513	-21073.476	
2883	-103333.063	-21068.618	9.833
2882	-103335.971	-21065.536	4.237
5380	-103332.267	-21064.279	3.911
5379	-103331.016	-21053.754	10.599
5378	-103330.012	-21045.229	8.583
5377	-103327.049	-21045.562	2.981
5376	-103324.064	-21045.908	3.004
5375	-103324.282	-21047.759	1.863
5374	-103325.279	-21056.302	8.600
5373	-103326.281	-21064.848	8.604
5372	-103326.764	-21068.977	4.157
7708	-103324.513	-21073.476	5.030
面積	162.3175845		
地積	162.31 m ²		

2345

地番	幡三〇九ノ一九		
N O	X	Y	辺 長
5364	-103297.326	-21060.849	
5365	-103296.326	-21052.320	8.587
5423	-103285.882	-21053.523	10.513
5422	-103285.588	-21054.571	1.088
5420	-103283.710	-21060.719	6.428
5421	-103283.723	-21061.738	1.019
5407	-103283.592	-21062.137	0.419
5408	-103283.883	-21062.402	0.393
5364	-103297.326	-21060.849	13.532
面積	105.7904050		
地積	105.79㎡		

2346

地番	幡三〇九ノ一八		
N O	X	Y	辺 長
5363	-103298.208	-21068.387	
5364	-103297.326	-21060.849	7.589
5408	-103283.883	-21062.402	13.532
4072	-103284.332	-21066.203	3.827
5414	-103284.777	-21069.964	3.787
5363	-103298.208	-21068.387	13.523
面積	102.8404480		
地積	102.84㎡		

2347

地番	幡三〇九ノ一七		
N O	X	Y	辺 長
5362	-103299.110	-21075.940	
5363	-103298.208	-21068.387	7.606
5414	-103284.777	-21069.964	13.523
5413	-103285.503	-21076.134	6.212
5412	-103285.697	-21077.524	1.403
5411	-103288.964	-21077.118	3.292
5362	-103299.110	-21075.940	10.214
面積	102.8217235		
地積	102.82㎡		

2348

地番	幡三〇九ノ一六		
N O	X	Y	辺 長
7706	-103290.382	-21089.088	
2872	-103292.033	-21089.035	1.651
2873	-103293.483	-21088.928	1.453
2874	-103295.814	-21088.668	2.345
2875	-103297.578	-21088.335	1.795
5361	-103300.089	-21084.404	4.664
5362	-103299.110	-21075.940	8.520
5411	-103288.964	-21077.118	10.214
7706	-103290.382	-21089.088	12.053
面積	118.9307420		
地積	118.93㎡		


2349


地番	幡三〇九ノ一五		
N O	X	Y	辺 長
7706	-103290.382	-21089.088	
5411	-103288.964	-21077.118	12.053
5412	-103285.697	-21077.524	3.292
5413	-103285.503	-21076.134	1.403
6327	-103280.251	-21076.729	5.285
7705	-103281.703	-21089.067	12.423
2870	-103285.906	-21089.174	4.204
2871	-103287.667	-21089.176	1.761
7706	-103290.382	-21089.088	2.716
面積	107.2010875		
地積	107.20㎡		

2350

地番	幡三〇九ノ一四		
N O	X	Y	辺 長
7705	-103281.703	-21089.067	
6327	-103280.251	-21076.729	12.423
6338	-103270.817	-21077.827	9.497
7704	-103272.106	-21088.804	11.052
3691	-103274.478	-21088.856	2.372
2869	-103279.867	-21089.020	5.391
7705	-103281.703	-21089.067	1.836
面積	111.4606395		
地積	111.46㎡		

図面の種類	画地出来形確認測量図		
街 区 名	24 3/3	求 積 表	
町 名	岩 倉 幡 枝 町		
京都市洛北第三土地区画整理組合			

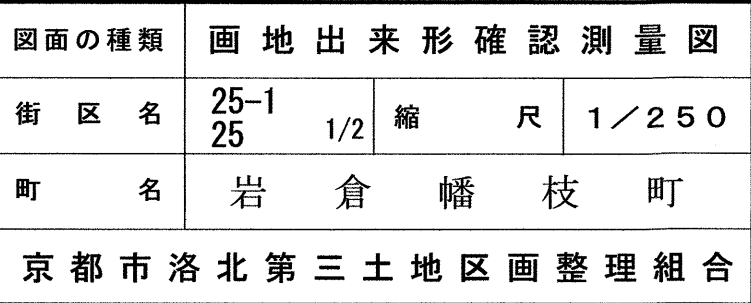

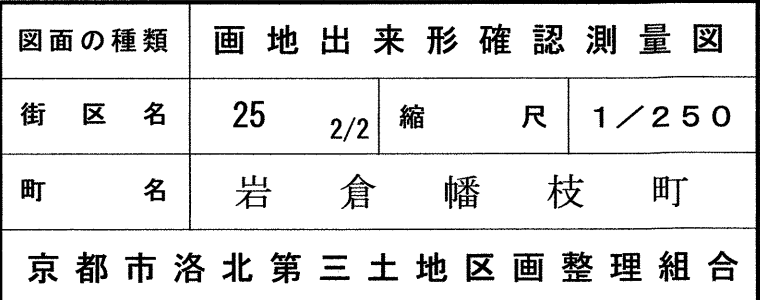

25-1 街区

2285			
地番	幡五九二B		
N O	X	Y	辺 長
2707	-103279.556	-20969.822	
2708	-103285.549	-20971.590	6.248
2709	-103292.283	-20973.546	7.012
2710	-103292.556	-20973.616	0.281
2714	-103293.744	-20971.631	2.313
2715	-103293.503	-20970.365	1.288
2725	-103294.105	-20968.827	1.651
9730	-103292.539	-20967.500	2.052
9731	-103290.405	-20965.543	2.895
2720	-103281.158	-20964.409	9.316
2707	-103279.556	-20969.822	5.645
面積	86.5115500		
地積	86.51㎡		

25街区

2286			
地番	幡五五三B		
N O	X	Y	辺 長
2711	-103297.612	-20974.938	
4372	-103299.016	-20975.290	1.447
4371	-103297.358	-20970.338	5.222
2718	-103296.123	-20970.536	1.250
2711	-103297.612	-20974.938	4.647
面積	6.0501420		
地積	6.05㎡		

2287			
地番	幡五九二A		
N O	X	Y	辺 長
4372	-103299.016	-20975.290	
2712	-103303.053	-20976.302	4.161
2713	-103306.504	-20977.061	3.533
7150	-103306.872	-20977.134	0.375
5302	-103335.906	-20958.391	34.558
5286	-103345.944	-20951.168	12.366
5285	-103345.946	-20951.116	0.052
5282	-103354.242	-20943.903	10.993
4068	-103358.754	-20939.959	5.992
4069	-103374.513	-20939.775	15.760
4373	-103374.474	-20936.704	3.071
4374	-103362.477	-20922.528	18.571
6520	-103362.306	-20922.679	0.228
6513	-103325.982	-20951.541	46.394
6512	-103301.330	-20969.702	30.619
4371	-103297.358	-20970.338	4.022
4372	-103299.016	-20975.290	5.222
面積	967.5006785		
地積	967.50㎡		

2288			
地番	幡五九一		
N O	X	Y	辺 長
4373	-103374.474	-20936.704	
2506	-103374.438	-20933.807	2.897
2507	-103374.350	-20926.308	7.499
2508	-103386.328	-20916.169	15.693
2509	-103398.823	-20905.591	16.371
2510	-103411.374	-20894.950	16.454
2520	-103420.898	-20886.875	12.486
2521	-103423.210	-20881.952	5.438
2522	-103423.238	-20867.688	14.264
2527	-103428.599	-20850.086	18.400
2528	-103430.096	-20845.135	5.172
6514	-103422.656	-20862.957	19.312
6515	-103415.034	-20875.402	14.593
6516	-103399.342	-20889.411	21.035
6517	-103385.898	-20901.392	18.007
6518	-103375.692	-20910.667	13.790
6519	-103367.841	-20917.793	10.602
4374	-103362.477	-20922.528	7.154
4373	-103374.474	-20936.704	18.571
面積	956.3133580		
地積	956.31㎡		

2289			
地番	保二五ノ三		
N O	X	Y	辺 長
7158	-103374.565	-20943.638	
4069	-103374.513	-20939.775	3.863
4068	-103358.754	-20939.959	15.760
5282	-103354.242	-20943.903	5.992
7158	-103374.565	-20943.638	20.324
面積	69.9224085		
地積	69.92㎡		

2290			
地番	保二五ノ五		
N O	X	Y	辺 長
5283	-103345.978	-20951.825	
7157	-103374.660	-20951.441	28.684
2241	-103374.569	-20943.942	7.499
7158	-103374.565	-20943.638	0.304
5282	-103354.242	-20943.903	20.324
5285	-103345.946	-20951.116	10.993
5286	-103345.944	-20951.168	0.052
5283	-103345.978	-20951.825	0.657
面積	194.3845330		
地積	194.38㎡		

2291			
地番	保二五ノ四		
N O	X	Y	辺 長
5288	-103346.133	-20963.993	
5287	-103355.735	-20963.864	9.602
5284	-103355.612	-20954.956	8.908
7156	-103374.699	-20954.687	19.088
7157	-103374.660	-20951.441	3.246
5283	-103345.978	-20951.825	28.684
4053	-103346.118	-20962.805	10.980
5288	-103346.133	-20963.993	1.188
面積	178.8798805		
地積	178.87㎡		

2292			
地番	保二五ノ一		
N O	X	Y	辺 長
5287	-103355.735	-20963.864	
6183	-103360.956	-20963.786	5.221
7155	-103374.807	-20963.606	13.852
2240	-103374.782	-20961.528	2.078
7156	-103374.699	-20954.687	6.841
5284	-103355.612	-20954.956	19.088
5287	-103355.735	-20963.864	8.908
面積	170.0259830		
地積	170.02㎡		

2293			
地番	幡五五九ノ一一		
N O	X	Y	辺 長
7327	-103374.921	-20972.973	
7155	-103374.807	-20963.606	9.367
6183	-103360.956	-20963.786	13.852
6182	-103361.066	-20973.162	9.376
7327	-103374.921	-20972.973	13.856
面積	129.8440535		
地積	129.84㎡		

2294			
地番	幡五五九ノ一〇		
N O	X	Y	辺 長
7326	-103361.172	-20982.284	
2223	-103372.032	-20982.133	10.861
2239	-103374.996	-20979.104	4.237
7327	-103374.921	-20972.973	6.131
6182	-103361.066	-20973.162	13.856
7326	-103361.172	-20982.284	9.122
面積	121.9230820		
地積	121.92㎡		

2295			
地番	幡五五九ノ一二		
N O	X	Y	辺 長
7154	-103356.165	-20982.299	
2222	-103360.049	-20982.300	3.884
7326	-103361.172	-20982.284	1.123
6182	-103361.066	-20973.162	9.122
6183	-103360.956	-20963.786	9.376
5287	-103355.735	-20963.864	5.221
5288	-103346.133	-20963.993	9.602
5298	-103346.211	-20971.389	7.396
5297	-103358.536	-20971.233	12.325
5296	-103358.601	-20977.319	6.086
5290	-103356.101	-20977.357	2.500
7154	-103356.165	-20982.299	4.942
面積	150.0025190		
地積	150.00㎡		


2296			
地番	幡五五九ノ一		
N O	X	Y	辺 長
7153	-103346.321	-20982.068	
2220	-103347.711	-20982.137	1.391
2221	-103353.804	-20982.299	6.095
7154	-103356.165	-20982.299	2.361
5290	-103356.101	-20977.357	4.942
5296	-103358.601	-20977.319	2.500
5297	-103358.536	-20971.233	6.086
5298	-103346.211	-20971.389	12.325
4052	-103346.231	-20973.321	1.932
7153	-103346.321	-20982.068	8.747
面積	122.3242860		
地積	122.32㎡		

2297			
地番	保二五ノ二		
N O	X	Y	辺 長
7152	-103325.900	-20980.311	
2217	-103329.468	-20980.761	3.596
2218	-103335.542	-20981.370	6.104
2219	-103341.621	-20981.836	6.096
7153	-103346.321	-20982.068	4.705
4052	-103346.231	-20973.321	8.747
7152	-103325.900	-20980.311	21.499
面積	92.2447310		
地積	92.24㎡		


2298			
地番	幡五五八ノ二		
N O	X	Y	辺 長
7151	-103322.284	-20979.826	
2216	-103323.424	-20979.998	1.152
7152	-103325.900	-20980.311	2.495
4052	-103346.231	-20973.321	21.499
5298	-103346.211	-20971.389	1.932
5288	-103346.133	-20963.993	7.396
4053	-103346.118	-20962.805	1.188
4054	-103323.596	-20971.469	24.131
7151	-103322.284	-20979.826	8.459
面積	232.3213010		
地積	232.32㎡		

2299			
地番	幡五六三ノ一		
N O	X	Y	辺 長
7150	-103306.872	-20977.134	
2213	-103311.398	-20978.035	4.614
2214	-103313.558	-20978.441	2.197
2215	-103317.401	-20979.091	3.897
7151	-103322.284	-20979.826	4.938
4054	-103323.596	-20971.469	8.459
4053	-103346.118	-20962.805	24.131
5283	-103345.978	-20951.825	10.980
5286	-103345.944	-20951.168	0.657
5302	-103335.906	-20958.391	12.366
7150	-103306.872	-20977.134	34.558
面積	295.0761275		
地積	295.07㎡		

図面の種類	画地出来形確認測量図		
街 区 名	25-1 25	求 積 表	
町 名	岩 倉 幡 枝 町		
京都市洛北第三土地区画整理組合			

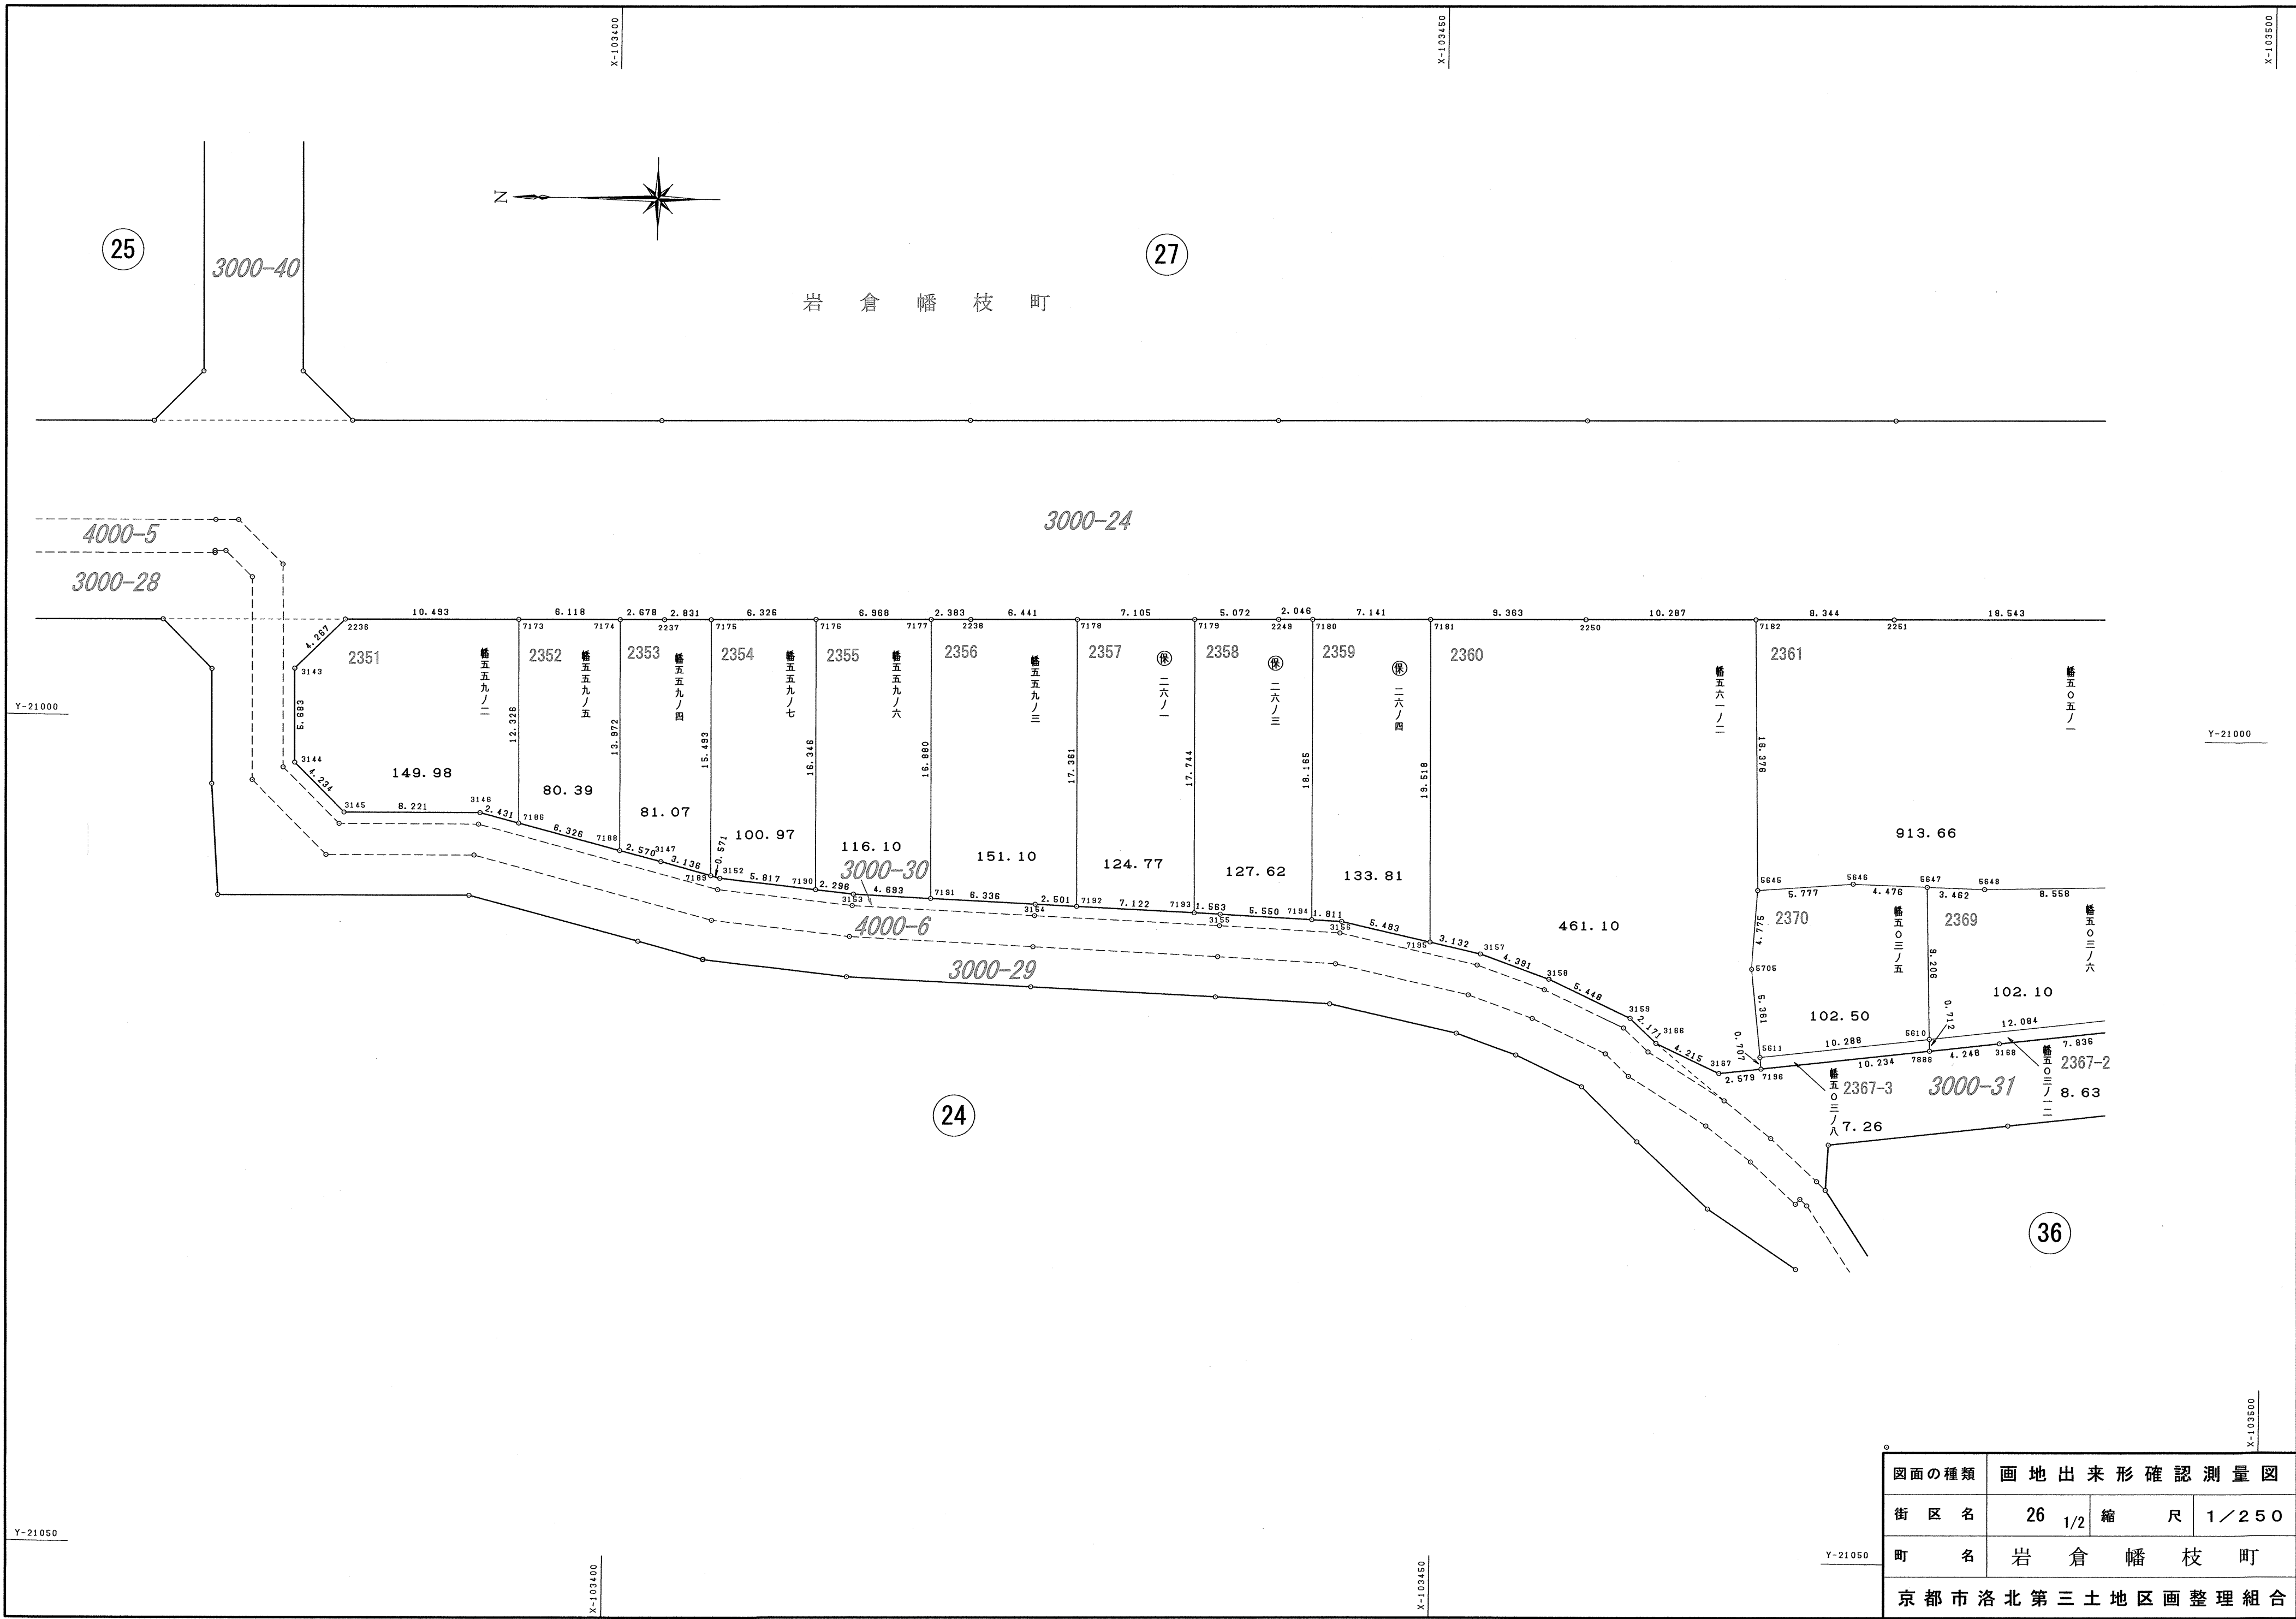

図面の種類	画地出来形確認測量図		
街区名	26 1/2	縮尺	1／250
町名	岩倉幡枝町		
京都市洛北第三土地区画整理組合			

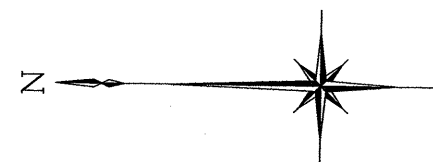


27

岩 倉 幡 枝 町

34

3000-45

3000-24

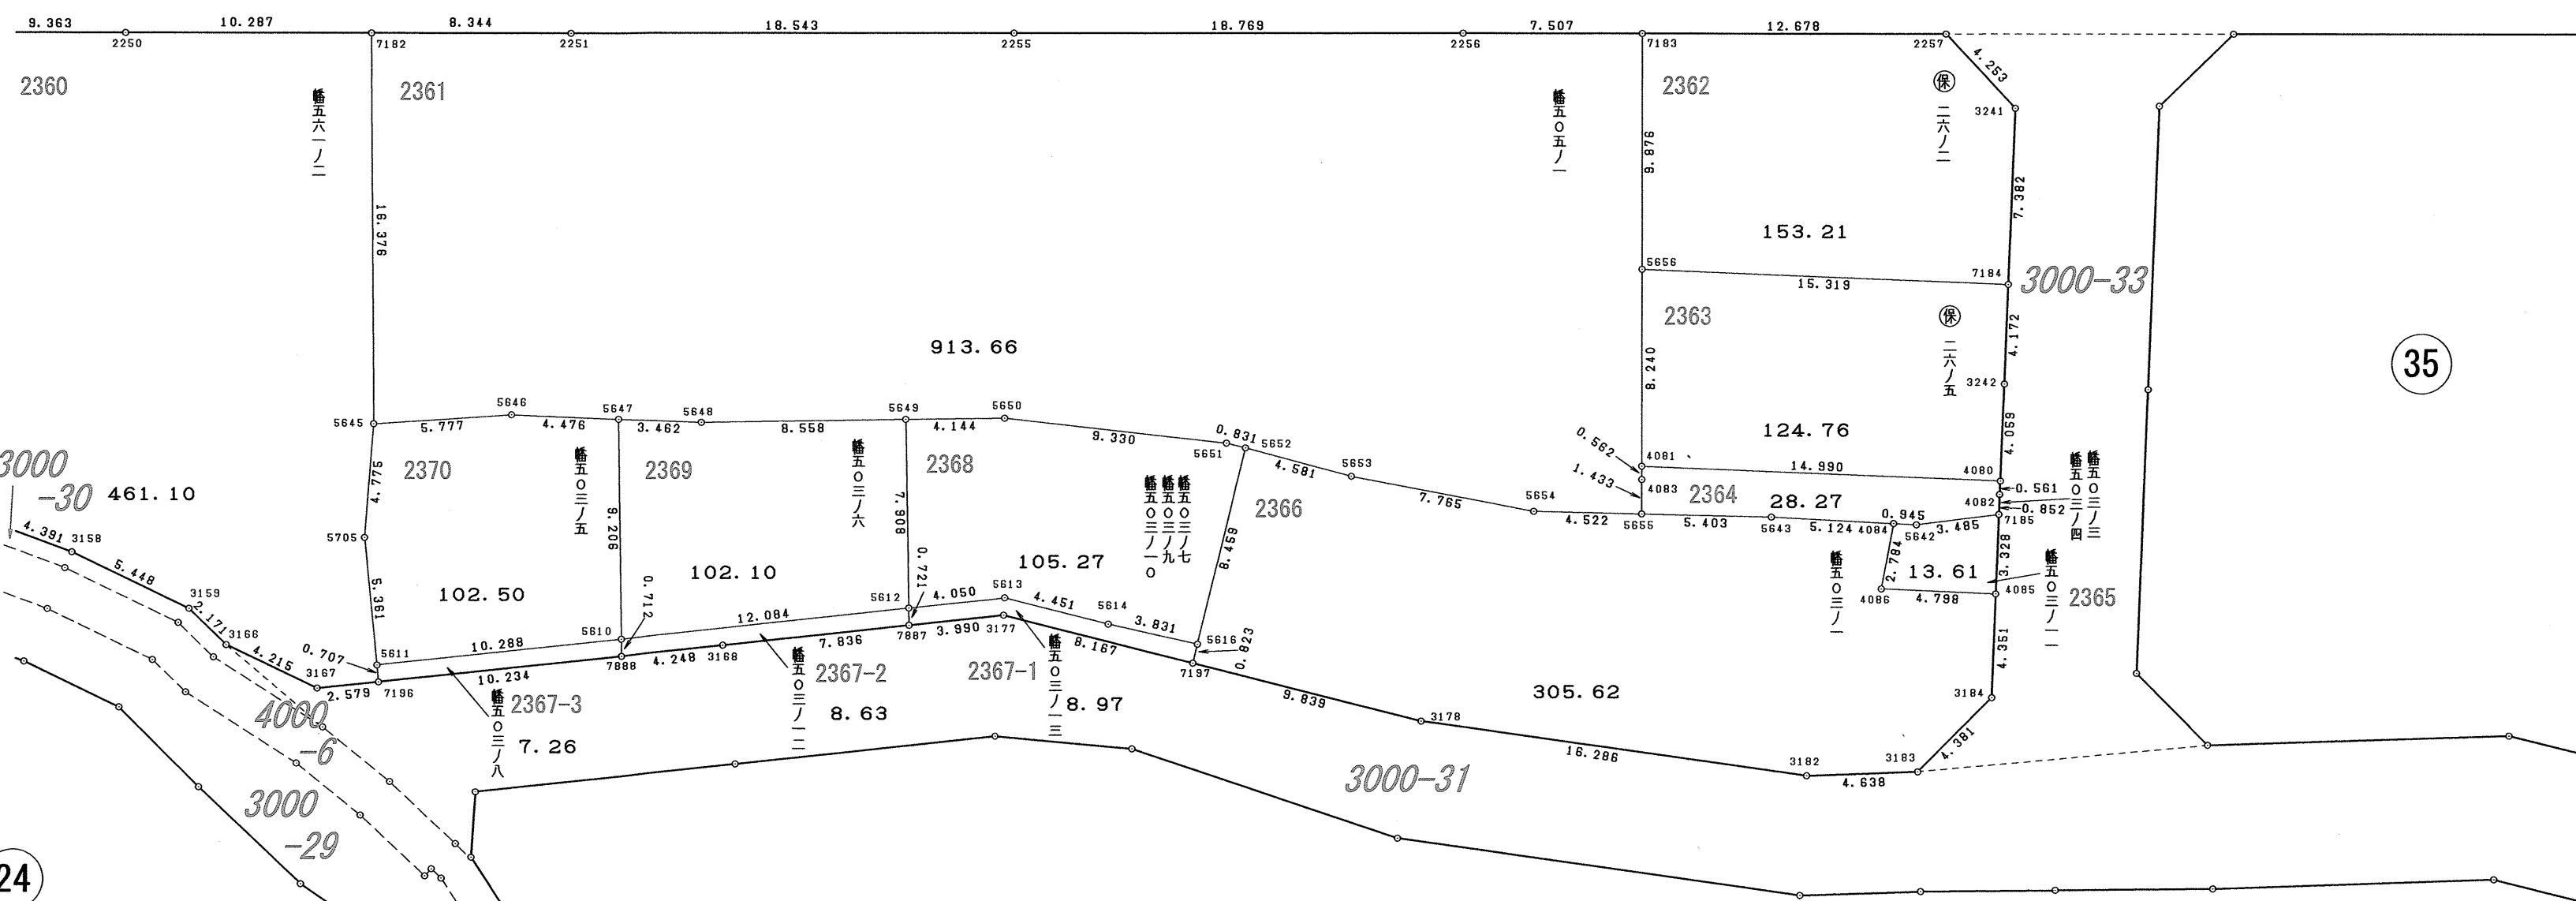

24

36

X-103550

Y-21050

図面の種類	画 地 出 来 形 確 認 測 量 図		
街 区 名	26	2/2	縮 尺 1／250
町 名	岩 倉 幡 枝 町		
京 都 市 洛 北 第 三 土 地 区 画 整 理 組 合			

Y-21000

Y-21000

Y-21050

X-103450

X-103500

2351

地番	幡五五九ノ二		
N O	X	Y	辺 長
2236	-103383.760	-20994.000	
3143	-103380.739	-20997.014	4.267
3144	-103380.814	-21002.697	5.683
3145	-103383.829	-21005.670	4.234
3146	-103392.050	-21005.593	8.221
7186	-103394.405	-21006.197	2.431
7173	-103394.253	-20993.871	12.326
2236	-103383.760	-20994.000	10.493
面積	149.9846850		
地積	149.98㎡		

2352

地番	幡五五九ノ五		
N O	X	Y	辺 長
7173	-103394.253	-20993.871	
7186	-103394.405	-21006.197	12.326
7188	-103400.533	-21007.768	6.326
7174	-103400.371	-20993.796	13.972
7173	-103394.253	-20993.871	6.118
面積	80.3938910		
地積	80.39㎡		

2353

地番	幡五五九ノ四		
N O	X	Y	辺 長
7174	-103400.371	-20993.796	
7188	-103400.533	-21007.768	13.972
3147	-103403.023	-21008.406	2.570
7189	-103406.052	-21009.220	3.136
7175	-103405.880	-20993.727	15.493
2237	-103403.049	-20993.763	2.831
7174	-103400.371	-20993.796	2.678
面積	81.0708530		
地積	81.07㎡		

2354

地番	幡五五九ノ七		
N O	X	Y	辺 長
7175	-103405.880	-20993.727	
7189	-103406.052	-21009.220	15.493
3152	-103406.604	-21009.368	0.571
7190	-103412.388	-21009.991	5.817
7176	-103412.206	-20993.646	16.346
7175	-103405.880	-20993.727	6.326
面積	100.9781920		
地積	100.97㎡		

2355

地番	幡五五九ノ六		
N O	X	Y	辺 長
7176	-103412.206	-20993.646	
7190	-103412.388	-21009.991	16.346
3153	-103414.671	-21010.237	2.296
7191	-103418.360	-21010.436	4.693
7177	-103419.174	-20993.557	16.880
7176	-103412.206	-20993.646	6.968
面積	116.1024765		
地積	116.10㎡		

2356

地番	幡五五九ノ三		
N O	X	Y	辺 長
7177	-103419.174	-20993.557	
7191	-103419.360	-21010.436	16.880
3154	-103425.691	-21010.705	6.336
7192	-103428.190	-21010.809	2.501
7178	-103427.998	-20993.449	17.361
2238	-103421.557	-20993.526	6.441
7177	-103419.174	-20993.557	2.383
面積	151.1037775		
地積	151.10㎡		

2357

地番	保二六ノ一		
N O	X	Y	辺 長
7178	-103427.998	-20993.449	
7192	-103428.190	-21010.809	17.361
7193	-103435.306	-21011.106	7.122
7179	-103435.103	-20993.363	17.744
7178	-103427.998	-20993.449	7.105
面積	124.7791045		
地積	124.77㎡		

2358

地番	保二六ノ三		
N O	X	Y	辺 長
7179	-103435.103	-20993.363	
7193	-103435.306	-21011.106	17.744
3155	-103436.868	-21011.171	1.563
7194	-103442.412	-21011.440	5.550
7180	-103442.221	-20993.276	18.165
2249	-103440.175	-20993.302	2.046
7179	-103435.103	-20993.363	5.072
面積	127.6275205		
地積	127.62㎡		

2359

地番	保二六ノ四		
N O	X	Y	辺 長
7180	-103442.221	-20993.276	
7194	-103442.412	-21011.440	18.165
3156	-103444.221	-21011.528	1.811
7195	-103449.577	-21012.703	5.483
7181	-103449.362	-20993.186	19.518
7180	-103442.221	-20993.276	7.141
面積	133.8199135		
地積	133.81㎡		

2360

地番	幡五六ノ二		
N O	X	Y	辺 長
7181	-103449.362	-20993.186	
7195	-103449.577	-21012.703	19.518
3157	-103452.637	-21013.375	3.132
3158	-103456.775	-21014.846	4.391
3159	-103461.712	-21017.151	5.448
3166	-103463.287	-21018.646	2.171
3167	-103467.112	-21020.418	4.215
7196	-103469.673	-21020.112	2.579
5611	-103469.600	-21019.408	0.707
5705	-103469.011	-21014.079	5.361
5645	-103469.332	-21009.314	4.775
7182	-103469.012	-20992.941	16.376
2250	-103458.725	-20993.068	10.287
7181	-103449.362	-20993.186	9.363
面積	461.1089360		
地積	461.10㎡		

2361

地番	幡五〇五ノ一		
N O	X	Y	辺 長
7182	-103469.012	-20992.941	
5645	-103469.332	-21009.314	16.376
5646	-103475.091	-21008.856	5.777
5647	-103479.566	-21008.984	4.476
5648	-103483.027	-21009.075	3.462
5649	-103491.582	-21008.840	8.558
5650	-103495.725	-21008.736	4.144
5651	-103505.010	-21009.659	9.330
5652	-103505.819	-21009.849	0.831
5653	-103510.258	-21010.984	4.581
5654	-103517.903	-21012.344	7.765
5655	-103522.425	-21012.389	4.522
4083	-103522.406	-21010.956	1.433
4081	-103522.398	-21010.394	0.562
5656	-103522.287	-21002.154	8.240
7183	-103522.173	-20992.278	9.876
2256	-103514.666	-20992.372	7.507
2255	-103495.898	-20992.607	18.769
2251	-103477.356	-20992.838	18.543
7182	-103469.012	-20992.941	8.344
面積	913.6672115		
地積	913.66㎡		

2362

地番	保二六ノ二		
N O	X	Y	辺 長
7183	-103522.173	-20992.278	
5656	-103522.287	-21002.154	9.876
7184	-103537.601	-21002.566	15.319
3241	-103537.798	-20995.186	7.382
2257	-103534.851	-20992.119	4.253
7183	-103522.173	-20992.278	12.678
面積	153.2157355		
地積	153.21㎡		

2363

地番	保二六ノ五		
N O	X	Y	辺 長
5656	-103522.287	-21002.154	
4081	-103522.398	-21010.394	8.240
4080	-103537.389	-21010.795	14.990
3242	-103537.489	-21006.737	4.059
7184	-103537.601	-21002.566	4.172
5656	-103522.287	-21002.154	15.319
面積	124.7641205		
地積	124.76㎡		

2364

地番	幡五〇三ノ三 幡五〇三ノ四		
N O	X	Y	辺 長
5655	-103522.425	-21012.389	
5643	-103527.828	-21012.449	5.403
4084	-103532.949	-21012.648	5.124
5642	-103533.894	-21012.685	0.945
7185	-103537.347	-21012.208	3.485
4082	-103537.368	-21011.356	0.852
4080	-103537.383	-21010.795	0.561
4081	-103522.398	-21010.394	14.990
4083	-103522.406	-21010.956	0.562
5655	-103522.425	-21012.389	1.433
面積	28.2704820		
地積	28.27㎡		

2365

地番	幡五〇三ノ一		
N O	X	Y	辺 長
7185	-103537.347	-21012.208	
5642	-103533.894	-21012.685	3.485
4084	-103532.949	-21012.648	0.945
4086	-103532.464	-21015.390	2.784
4085	-103537.260	-21015.535	4.798
7185	-103537.347	-21012.208	3.328
面積	13.6181485		
地積	13.61㎡		

2366

地番	幡五〇三ノ一		
N O	X	Y	辺 長
7197	-103503.739	-21018.896	
3178	-103513.307	-21021.190	9.839
3182	-103529.461	-21023.260	16.286
3183	-103534.094	-21023.028	4.638
3184	-103537.147	-21019.885	4.381
4085	-103537.260	-21015.535	4.351
4086	-103532.464	-21015.390	4.798
4084	-103532.949	-21012.648	2.784
5643	-103527.828	-21012.449	5.124
5655	-103522.425	-21012.389	5.403
5654	-103517.903	-21012.344	4.522
5653	-103510.258	-21010.984	7.765
5652	-103505.819	-21009.849	4.581
5616	-103503.914	-21018.091	8.459
7197	-103503.739	-21018.896	0.823
面積	305.6278410		
地積	305.62㎡		

2367-1


地番	幡五〇三ノ一三		
N O	X	Y	辺 長
7887	-103491.835	-21017.466	
3177	-103495.797	-21016.992	3.990
7197	-103503.739	-21018.896	8.167
5616	-103503.914	-21018.091	0.823
5614	-103500.164	-21017.305	3.831
5613	-103495.836	-21016.264	4.451
5612	-103491.814	-21016.745	4.050
7887	-103491.835	-21017.466	0.721
面積	8.9762090		
地積	8.97㎡		

2367-2

地番	幡五〇三ノ一		
N O	X	Y	辺 長
7888	-103479.835	-21018.899	
3168	-103484.054	-21018.396	4.248
7887	-103491.835	-21017.466	7.836
5612	-103491.814	-21016.745	0.721
5610	-103479.816	-21018.187	12.084
7888	-103479.835	-21018.899	0.712
面積	8.6309470		
地積	8.63㎡		

2367-3

地番	幡五〇三ノ八		
N O	X	Y	辺 長
7196	-103469.673	-21020.112	
7888	-103479.835	-21018.899	10.234
5610	-103479.816	-21018.187	0.712
5611	-103469.600	-21019.408	10.288

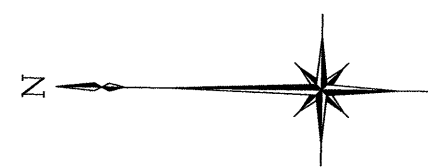

岩 倉 幡 枝 町

公4

29

3000-41

25

3000-40

3000-24

4000-5

3000-28


3000-29

3000-30

24

26

図面の種類	画 地 出 来 形 確 認 測 量 図		
街 区 名	27 1/2	縮 尺	1 / 2 5 0
町 名	岩 倉 幡 枝 町		
京 都 市 洛 北 第 三 土 地 区 画 整 理 組 合			

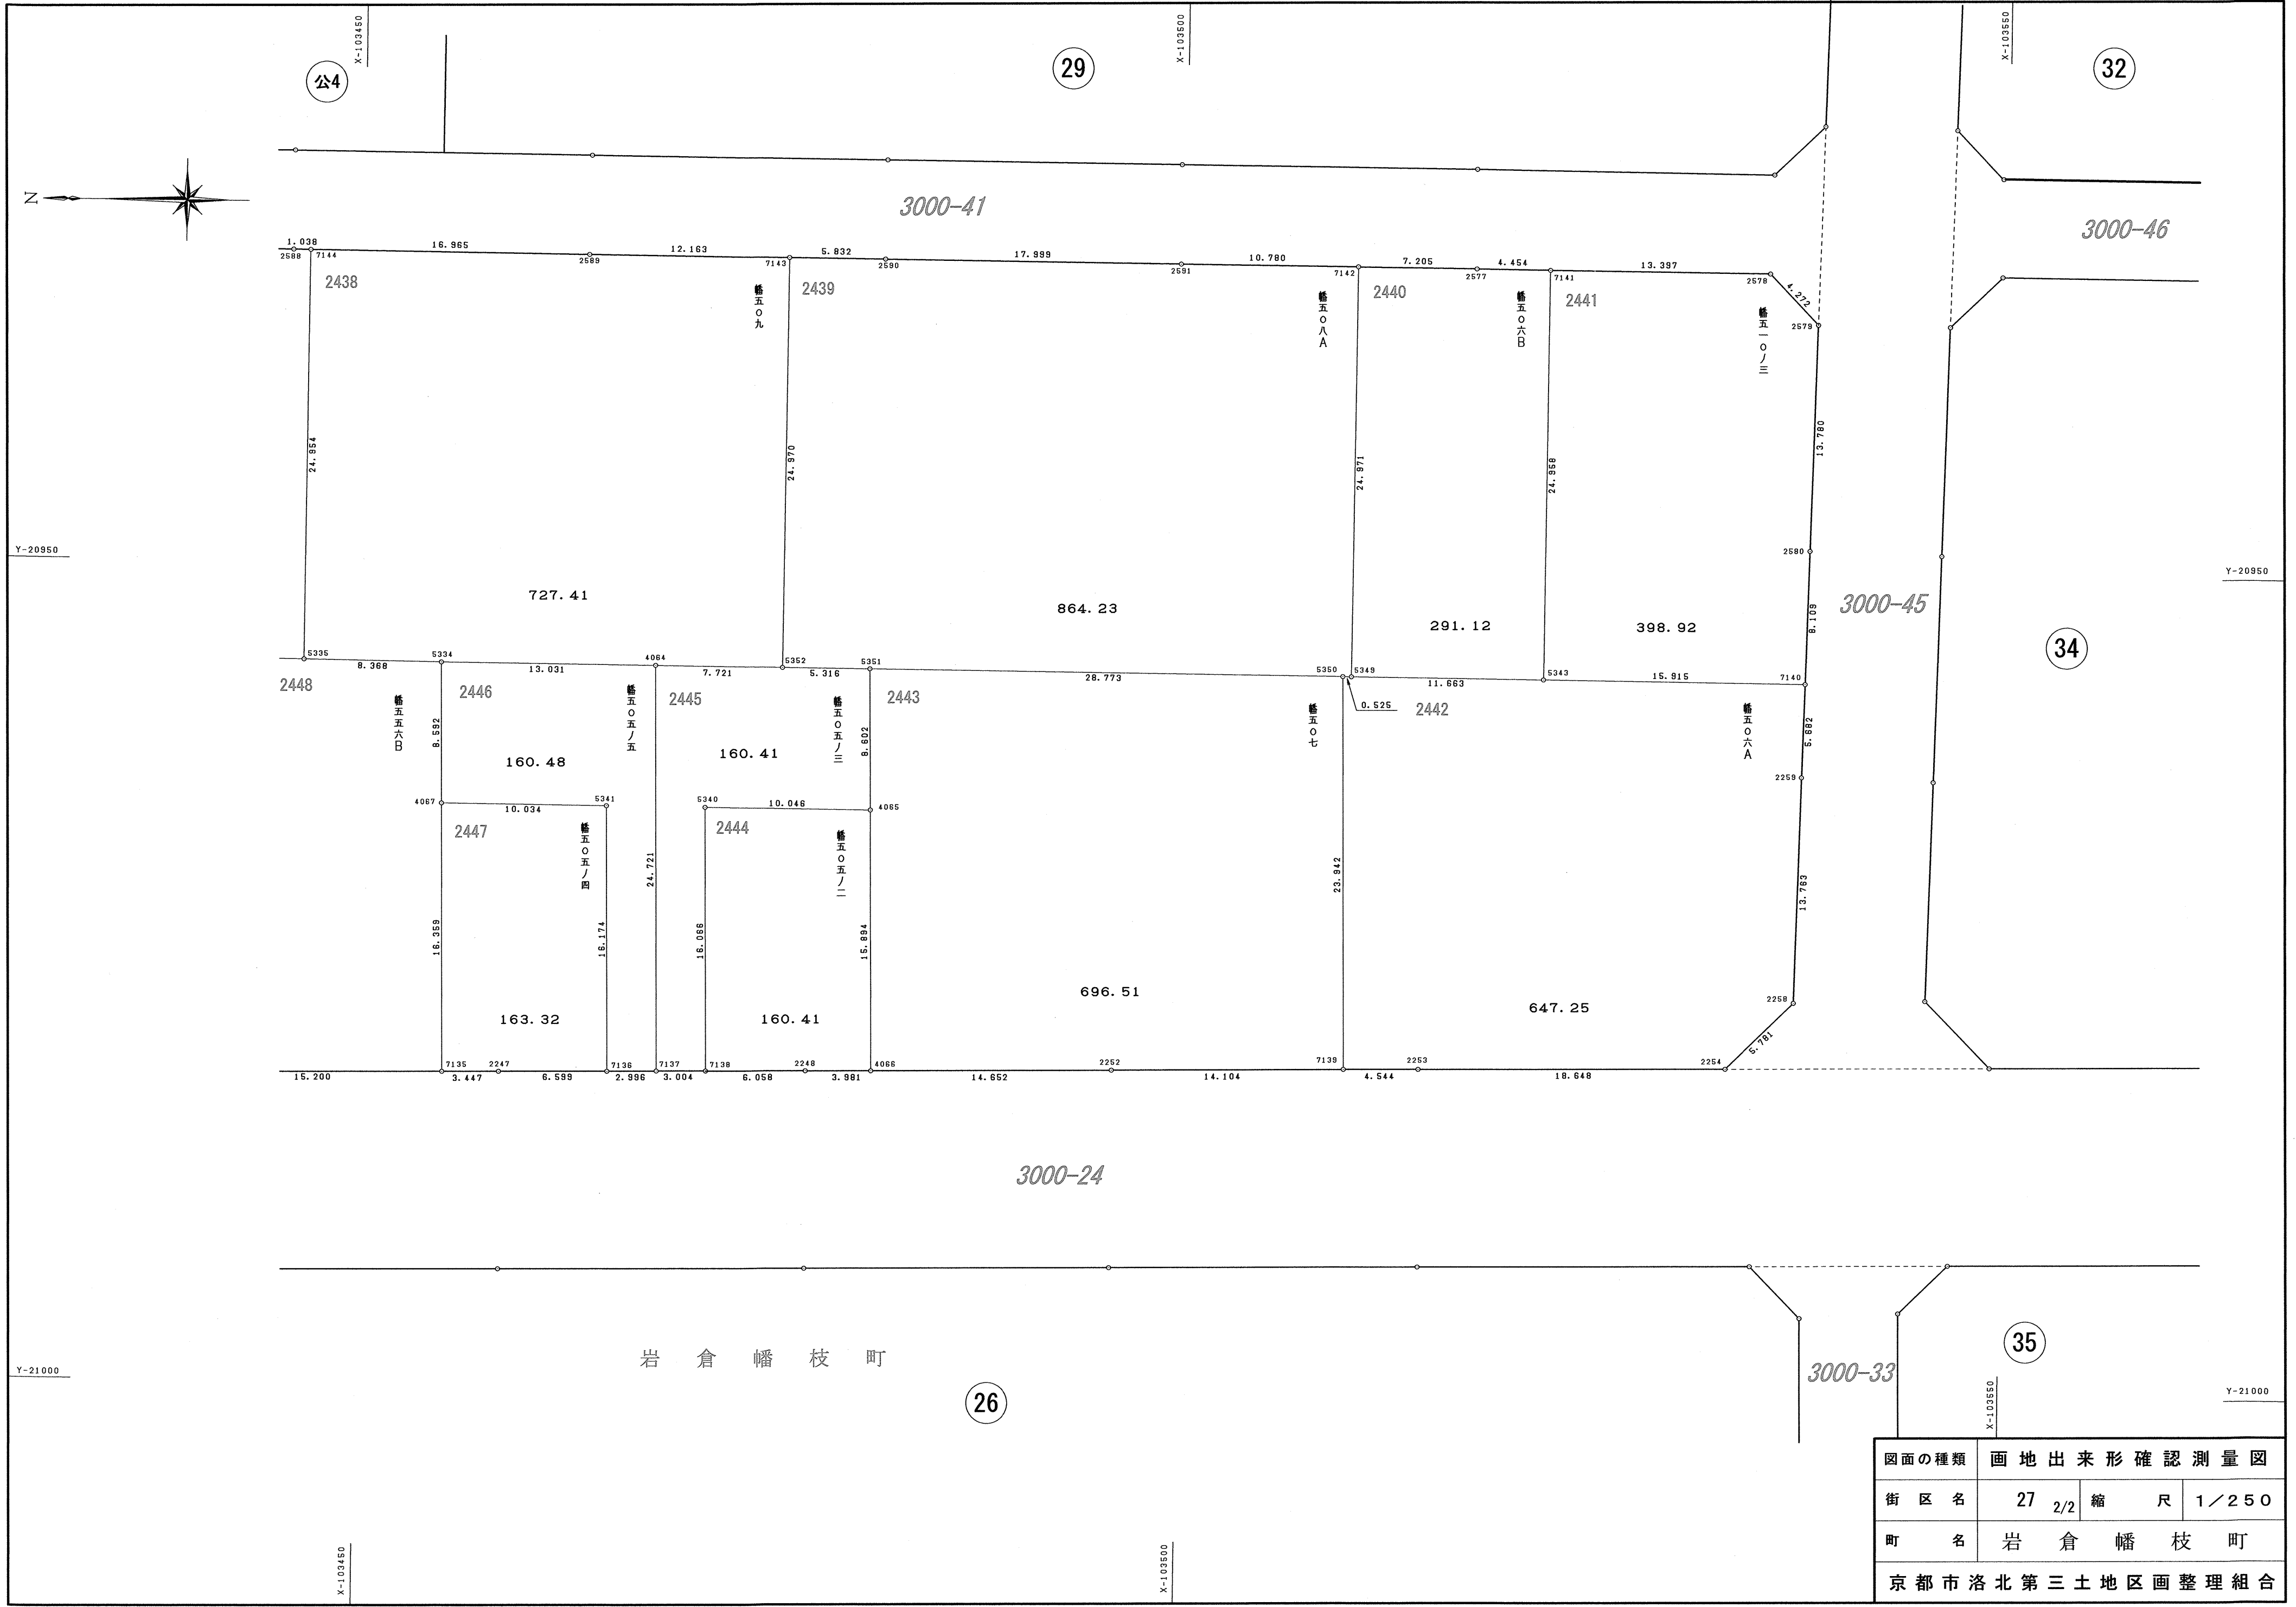

図面の種類	画地出来形確認測量図			
街 区 名	27	2/2	縮 尺	1／250
町 名	岩 倉 幡 枝 町			
京都市洛北第三土地区画整理組合				

2427

地番	保二七ノ一		
N O	X	Y	辺 長
2245	-103381.004	-20979.015	
2233	-103384.040	-20981.966	4.233
7133	-103391.572	-20981.870	7.532
5289	-103391.401	-20968.363	13.508
7149	-103380.883	-20968.503	10.518
2245	-103381.004	-20979.015	10.512
面積	137.6771575		
地積	137.67㎡		

2428

地番	幡五七一ノ二		
N O	X	Y	辺 長
7149	-103380.883	-20968.503	
5289	-103391.401	-20968.363	10.518
5355	-103401.580	-20968.231	10.179
5354	-103401.466	-20958.843	9.388
7148	-103380.772	-20959.113	20.695
2244	-103380.801	-20961.390	2.277
7149	-103380.883	-20968.503	7.113
面積	194.3124135		
地積	194.31㎡		

2429

地番	幡五〇五		
N O	X	Y	辺 長
7148	-103380.772	-20959.113	
5354	-103401.466	-20958.843	20.695
5009	-103401.422	-20955.769	3.074
5010	-103401.362	-20949.932	5.837
7147	-103380.657	-20950.216	20.706
7148	-103380.772	-20959.113	8.897
面積	184.3024855		
地積	184.30㎡		

2430

地番	幡五五七		
N O	X	Y	辺 長
7147	-103380.657	-20950.216	
5010	-103401.362	-20949.932	20.706
5011	-103401.304	-20945.812	4.120
5012	-103401.245	-20941.662	4.150
7146	-103380.552	-20941.943	20.694
2243	-103380.574	-20943.742	1.799
7147	-103380.657	-20950.216	6.474
面積	171.2477705		
地積	171.24㎡		

2431

地番	幡五五八ノ一		
N O	X	Y	辺 長
7146	-103380.552	-20941.943	
5012	-103401.245	-20941.662	20.694
5001	-103401.107	-20930.816	10.846
2519	-103391.570	-20930.759	9.537
2518	-103383.440	-20930.711	8.130
2242	-103380.454	-20933.710	4.232
7146	-103380.552	-20941.943	8.233
面積	224.0486570		
地積	224.04㎡		

2432

地番	保二七ノ四		
N O	X	Y	辺 長
5001	-103401.107	-20930.816	
5012	-103401.245	-20941.662	10.846
5011	-103401.304	-20945.812	4.150
5013	-103411.679	-20945.883	10.375
5002	-103411.768	-20930.880	15.003
2517	-103409.652	-20930.867	2.116
5001	-103401.107	-20930.816	8.545
面積	157.7962875		
地積	157.79㎡		

2433

地番	保二七ノ三		
N O	X	Y	辺 長
5002	-103411.768	-20930.880	
5013	-103411.679	-20945.883	15.003
5011	-103401.304	-20945.812	10.375
5010	-103401.362	-20949.932	4.120
5009	-103401.422	-20955.769	5.837
5008	-103414.620	-20955.857	13.198
5003	-103414.768	-20930.899	24.958
5002	-103411.768	-20930.880	3.000
面積	177.2352580		
地積	177.23㎡		

2434

地番	保二七ノ六		
N O	X	Y	辺 長
5003	-103414.768	-20930.899	
5008	-103414.620	-20955.857	24.958
5007	-103428.288	-20955.949	13.668
5006	-103428.341	-20945.982	9.967
5014	-103417.679	-20945.920	10.662
5004	-103417.768	-20930.917	15.003
5003	-103414.768	-20930.899	3.000
面積	181.1291160		
地積	181.12㎡		

2435

地番	保二七ノ五		
N O	X	Y	辺 長
5004	-103417.768	-20930.917	
5014	-103417.679	-20945.920	15.003
5006	-103428.341	-20945.982	10.662
5005	-103428.422	-20930.983	14.999
2595	-103427.645	-20930.978	0.777
5004	-103417.768	-20930.917	9.877
面積	159.8870920		
地積	159.88㎡		

2436

地番	幡五一〇ノ一		
N O	X	Y	辺 長
5005	-103428.422	-20930.983	
5006	-103428.341	-20945.982	14.999
5007	-103428.288	-20955.949	9.967
5336	-103436.911	-20955.988	8.623
7145	-103437.059	-20931.033	24.955
5005	-103428.422	-20930.983	8.637
面積	215.4215795		
地積	215.42㎡		

2437

地番	幡五一〇ノ二		
N O	X	Y	辺 長
7145	-103437.059	-20931.033	
5336	-103436.911	-20955.988	24.955
5335	-103446.528	-20956.043	9.617
7144	-103446.674	-20931.089	24.954
2588	-103445.636	-20931.083	1.038
7145	-103437.059	-20931.033	8.577
面積	239.9704115		
地積	239.97㎡		

2438

地番	幡五〇九		
N O	X	Y	辺 長
7144	-103446.674	-20931.089	
5335	-103446.528	-20956.043	24.954
5334	-103454.896	-20956.128	8.368
4064	-103467.927	-20956.196	13.031
5352	-103475.648	-20956.240	7.721
7143	-103475.802	-20931.270	24.970
2589	-103463.639	-20931.194	12.163
7144	-103446.674	-20931.089	16.965
面積	727.4169345		
地積	727.41㎡		

2439

地番	幡五〇八A		
N O	X	Y	辺 長
7143	-103475.802	-20931.270	
5352	-103475.648	-20956.240	24.970
5351	-103480.964	-20956.273	5.316
5350	-103509.737	-20956.452	28.773
5349	-103510.262	-20956.458	0.525
7142	-103510.413	-20931.487	24.971
2591	-103499.633	-20931.423	10.780
2590	-103481.634	-20931.306	17.999
7143	-103475.802	-20931.270	5.832
面積	864.2320675		
地積	864.23㎡		

2440

地番	幡五〇六B		
N O	X	Y	辺 長
7142	-103510.413	-20931.487	
5349	-103510.262	-20956.458	24.971
5343	-103521.925	-20956.513	11.663
7141	-103522.072	-20931.555	24.958
2577	-103517.618	-20931.529	4.454
7142	-103510.413	-20931.487	7.205
面積	291.1203290		
地積	291.12㎡		

2441

地番	幡五一〇ノ三		
N O	X	Y	辺 長
7141	-103522.072	-20931.555	
5343	-103521.925	-20956.513	24.958
7140	-103537.840	-20956.612	15.915
2580	-103538.050	-20948.505	8.109
2579	-103538.415	-20934.729	13.780
2578	-103535.469	-20931.634	4.272
7141	-103522.072	-20931.555	13.397
面積	398.9224640		
地積	398.92㎡		

2442

地番	幡五〇六A		
N O	X	Y	辺 長
7140	-103537.840	-20956.612	
2259	-103537.692	-20962.293	5.682
2258	-103537.350	-20976.052	13.763
2254	-103533.231	-20980.109	5.781
2253	-103514.584	-20980.335	18.648
7139	-103510.040	-20980.393	4.544
5350	-103509.737	-20956.452	23.942
5349	-103510.262	-20956.458	0.525
5343	-103521.925	-20956.513	11.663
7140	-103537.840	-20956.612	15.915
面積	647.2537630		
地積	647.25㎡		

2443

地番	幡五〇七		
N O	X	Y	辺 長
7139	-103510.040	-20980.393	
5350	-103509.737	-20956.452	23.942
5351	-103480.964	-20956.273	28.773
4065	-103481.079	-20964.875	8.602
4066	-103481.286	-20980.768	15.894
2252	-103495.937	-20980.571	14.652
7139	-103510.040	-20980.393	14.104
面積	696.5163210		
地積	696.51㎡		

2444

地番	幡五〇五ノ二		
N O	X	Y	辺 長
4066	-103481.286	-20980.768	
4065	-103481.079	-20964.875	15.894
5340	-103471.033	-20964.812	10.046
7138	-103471.247	-20980.877	16.066
2248	-103477.305	-20980.800	6.058
4066	-103481.286	-20980.768	3.981
面積	160.4176085		
地積	160.41㎡		

2445


地番	幡五〇五ノ三		
N O	X	Y	辺 長
7138	-103471.247	-20980.877	
5340	-103471.033	-20964.812	16.066
4065	-103481.079	-20964.875	10.046
5351	-103480.964	-20956.273	8.602
5352	-103475.648	-20956.240	5.316
4064	-103467.927	-20956.196	7.721
7137	-103468.243	-20980.915	24.721
7138	-103471.247	-20980.877	3.004
面積	160.4194580		
地積	160.41㎡		

2446

地番	幡五〇五ノ五		
N O	X	Y	辺 長
7137	-103468.243	-20980.915	
4064	-103467.927	-20956.196	24.721
5334	-103454.896	-20956.128	13.031
4067	-103454.999	-20964.720	8.592
5341	-103465.033	-20964.780	10.034
7136	-103465.247	-20980.953	16.174
7137	-103468.243	-20980.915	2.996
面積	160.4863070		
地積	160.48㎡		

2447

地 番	幡五〇五ノ四		
N O	X	Y	辺 長
7136	-103465.247	-20980.953	
5341	-103465.033	-20964.780	16.174
4067	-103454.999	-20964.720	10.034
7135	-103455.201	-20981.078	16.359
2247	-103458.648	-20981.037	3.447
7136	-103465.247	-20980.953	6.599
面積	163.3218745		
地積	163.32 m ²		

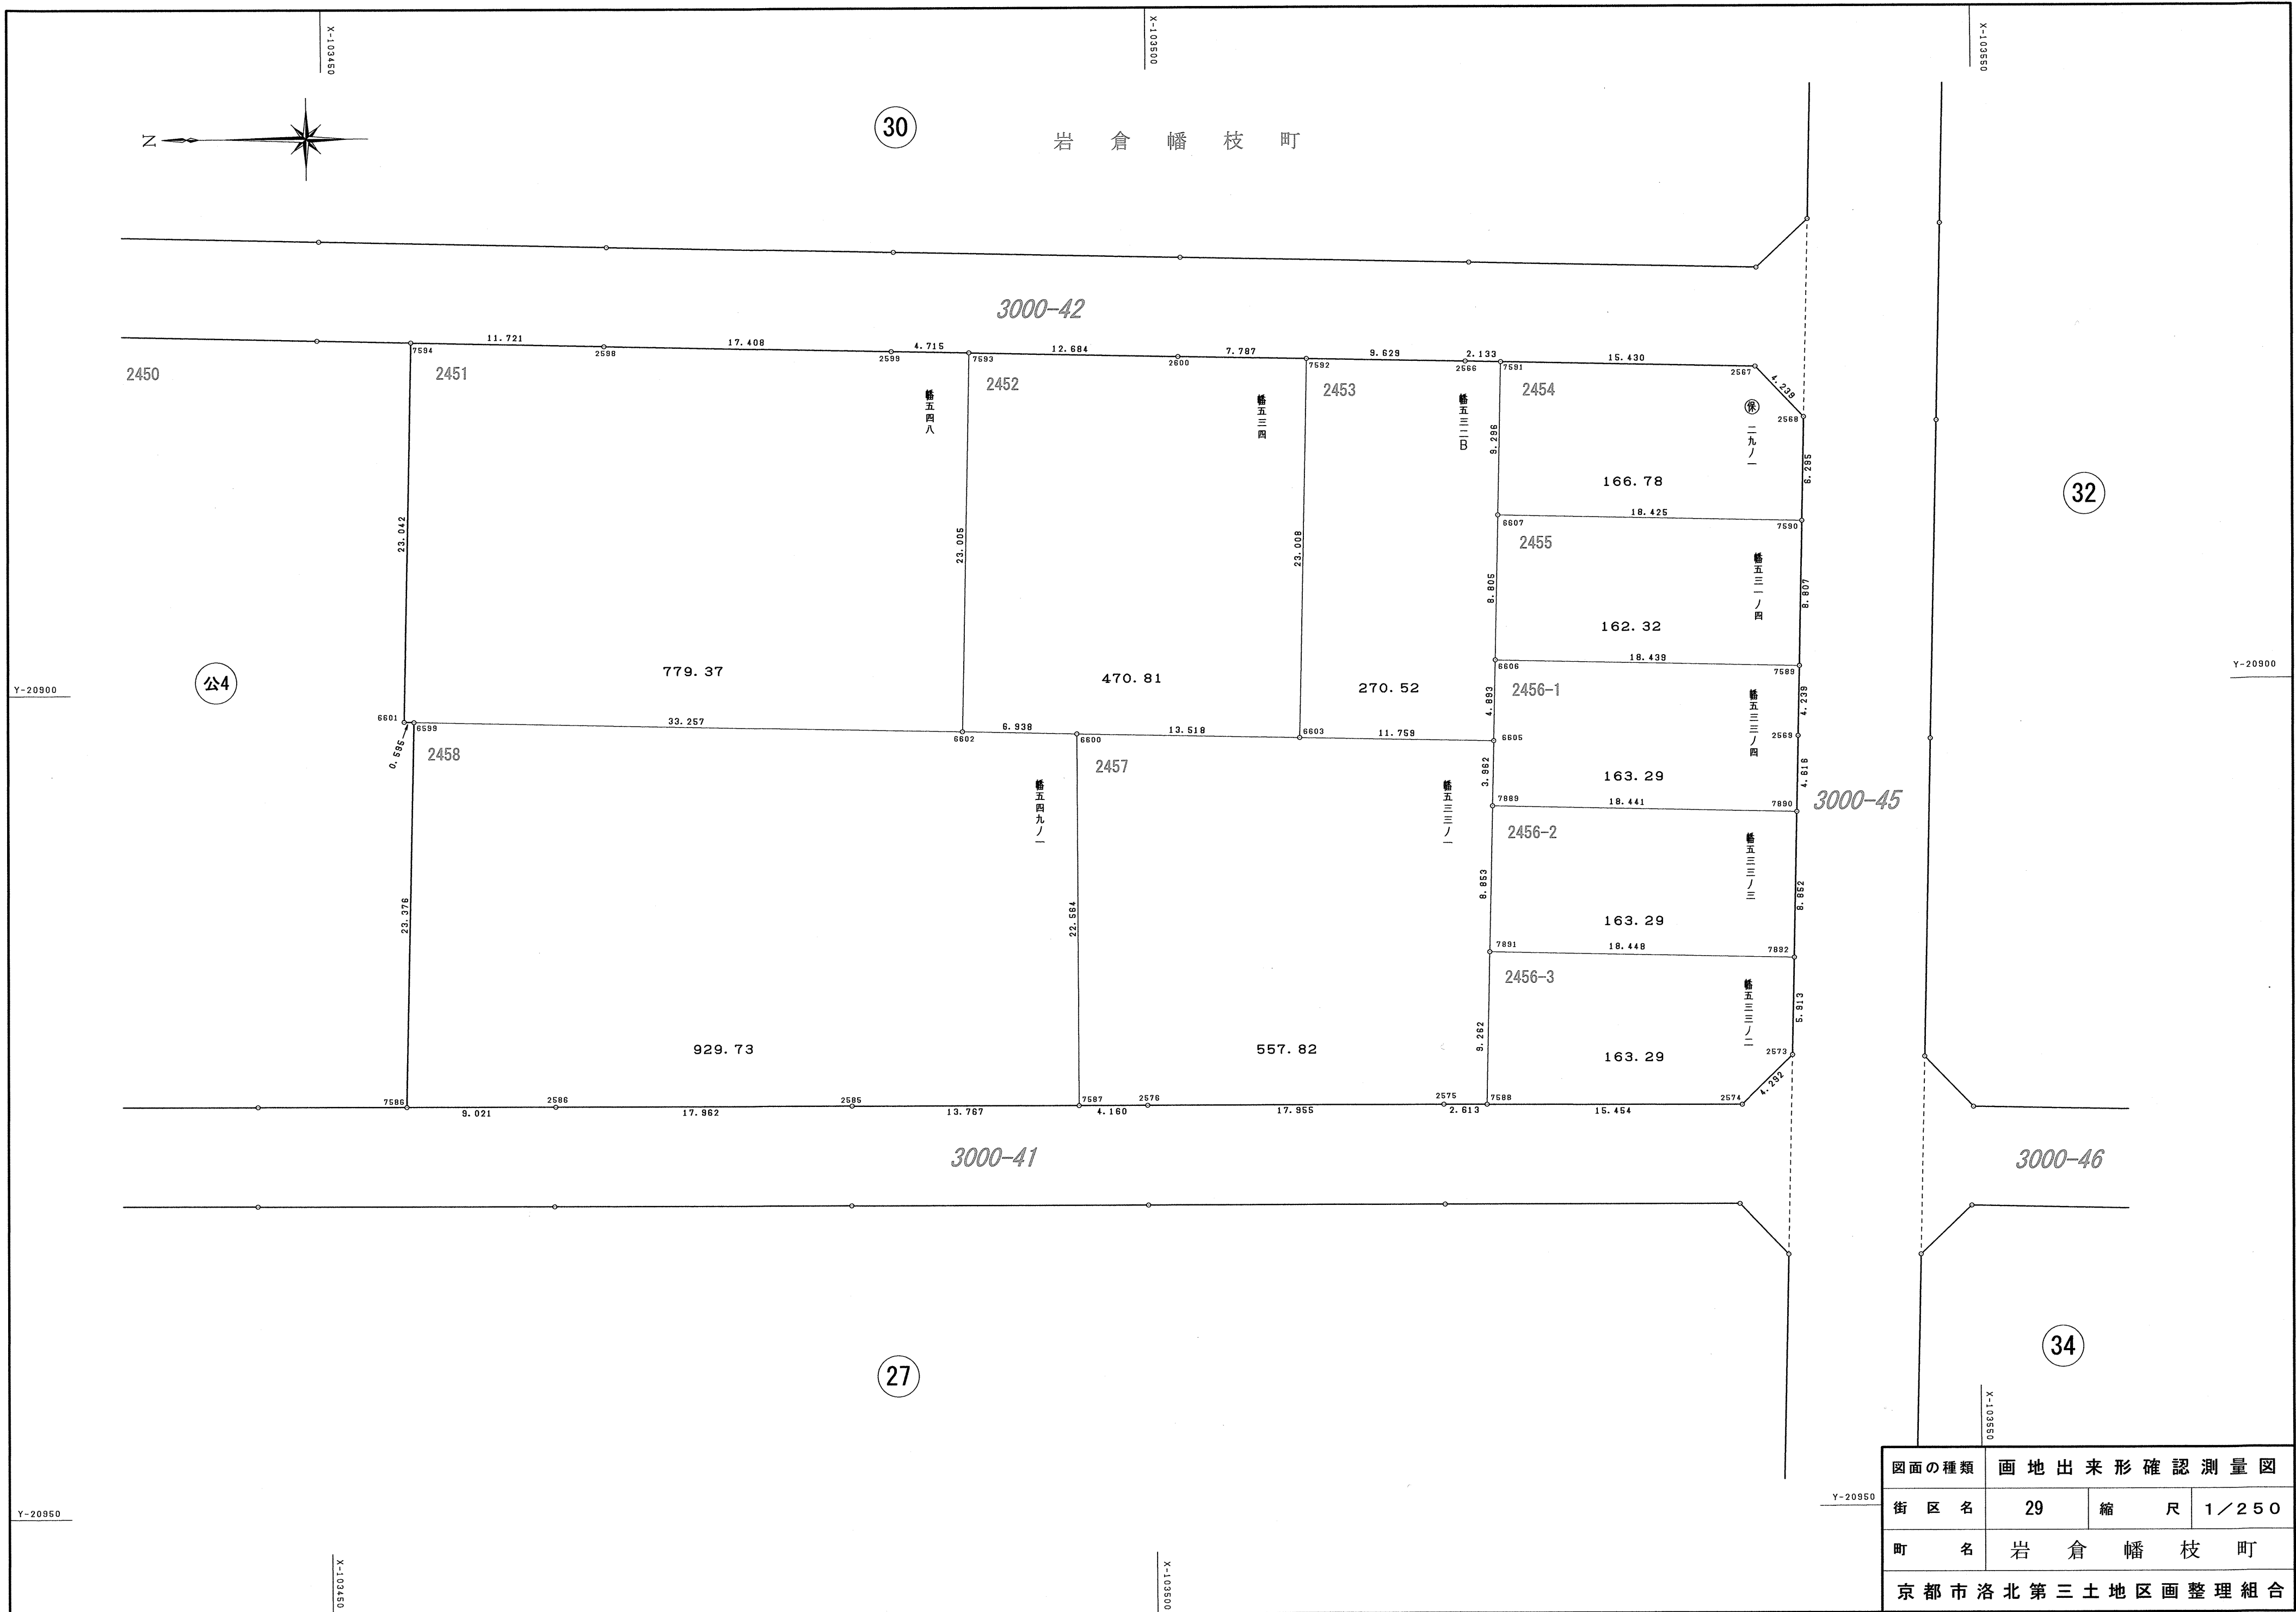

図面の種類	画地出来形確認測量図		
街区名	29	縮尺	1／250
町名	岩倉幡枝町		
京都市洛北第三土地区画整理組合			

2451

地番	幡五四八		
N O	X	Y	辺 長
7594	-103455.331	-20878.676	
6601	-103454.741	-20901.711	23.042
6599	-103455.336	-20901.729	0.595
6602	-103488.582	-20902.585	33.257
7593	-103489.164	-20879.587	23.005
2599	-103484.450	-20879.457	4.715
2598	-103467.048	-20878.994	17.408
7594	-103455.331	-20878.676	11.721
面積	779.3743550		
地積	779.37㎡		

2452

地番	幡五三四		
N O	X	Y	辺 長
7593	-103489.164	-20879.587	
6602	-103488.582	-20902.585	23.005
6600	-103495.518	-20902.780	6.938
6603	-103509.032	-20903.134	13.518
7592	-103509.629	-20880.133	23.008
2600	-103501.844	-20879.936	7.787
7593	-103489.164	-20879.587	12.684
面積	470.8154630		
地積	470.81㎡		

2453

地番	幡五三二B		
N O	X	Y	辺 長
7592	-103509.629	-20880.133	
6603	-103509.032	-20903.134	23.008
6605	-103520.788	-20903.420	11.759
6606	-103520.911	-20898.528	4.893
6607	-103521.148	-20889.726	8.805
7591	-103521.388	-20880.433	9.296
2566	-103519.255	-20880.377	2.133
7592	-103509.629	-20880.133	9.629
面積	270.5276985		
地積	270.52㎡		

2454

地番	保二九ノ一		
N O	X	Y	辺 長
7591	-103521.388	-20880.433	
6607	-103521.148	-20889.726	9.296
7590	-103539.567	-20890.211	18.425
2568	-103539.726	-20883.918	6.295
2567	-103536.813	-20880.838	4.239
7591	-103521.388	-20880.433	15.430
面積	166.7842755		
地積	166.78㎡		

2455

地番	幡五三一ノ四		
N O	X	Y	辺 長
7590	-103539.567	-20890.211	
6607	-103521.148	-20889.726	18.425
6606	-103520.911	-20898.528	8.805
7589	-103539.344	-20899.016	18.439
7590	-103539.567	-20890.211	8.807
面積	162.3251860		
地積	162.32㎡		

2456-1

地番	幡五三三ノ四		
N O	X	Y	辺 長
7889	-103520.682	-20907.381	
7890	-103539.117	-20907.869	18.441
2569	-103539.237	-20903.254	4.616
7589	-103539.344	-20899.016	4.239
6606	-103520.911	-20898.528	18.439
6605	-103520.788	-20903.420	4.893
7889	-103520.682	-20907.381	3.962
面積	163.2991690		
地積	163.29㎡		

2456-2

地番	幡五三三ノ二		
N O	X	Y	辺 長
7891	-103520.446	-20916.231	
7892	-103538.888	-20916.719	18.448
7890	-103539.117	-20907.869	8.852
7889	-103520.682	-20907.381	18.441
7891	-103520.446	-20916.231	8.853
面積	163.2941850		
地積	163.29㎡		

2456-3

地番	幡五三三ノ二		
N O	X	Y	辺 長
7588	-103520.199	-20925.490	
2574	-103535.653	-20925.618	15.454
2573	-103538.736	-20922.631	4.292
7892	-103538.888	-20916.719	5.913
7891	-103520.446	-20916.231	18.448
7588	-103520.199	-20925.490	9.262
面積	163.2934560		
地積	163.29㎡		


2457

地番	幡五三三ノ一		
N O	X	Y	辺 長
7588	-103520.199	-20925.490	
6605	-103520.788	-20903.420	22.077
6603	-103509.032	-20903.134	11.759
6600	-103495.518	-20902.780	13.518
7587	-103495.471	-20925.344	22.564
2576	-103499.631	-20925.370	4.160
2575	-103517.586	-20925.468	17.955
7588	-103520.199	-20925.490	2.613
面積	557.8276630		
地積	557.82㎡		

2458

地番	幡五四九ノ一		
N O	X	Y	辺 長
7587	-103495.471	-20925.344	
6600	-103495.518	-20902.780	22.564
6602	-103488.582	-20902.585	6.938
6599	-103455.336	-20901.729	33.257
7586	-103454.721	-20925.097	23.376
2586	-103463.742	-20925.150	9.021
2585	-103481.704	-20925.256	17.962
7587	-103495.471	-20925.344	13.767
面積	929.7349565		
地積	929.73㎡		

図面の種類	画 地 出 来 形 確 認 測 量 図		
街 区 名	29	求 積 表	
町 名	岩 倉 幡 枝 町		
京 都 市 洛 北 第 三 土 地 区 画 整 理 組 合			

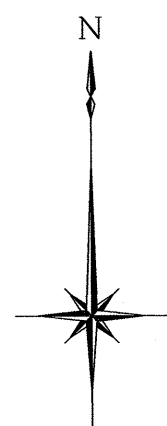

X-103400

X-103400

27

岩倉幡枝町

X-103450

X-103450

25

3000-40

公4

2,000.54

29

30


3000-42

図面の種類	画地出来形確認測量図		
街 区 名	4号公園	縮 尺	1／250
町 名	岩 倉 幡 枝 町		
京 都 市 洛 北 第 三 土 地 区 画 整 理 組 合			



2450

地 番	四号公園		
N O	X	Y	辺 長
2514	-103390.165	-20920.792	
2515	-103391.601	-20924.762	4.221
2516	-103409.804	-20924.852	18.203
2596	-103427.690	-20924.949	17.886
2587	-103445.682	-20925.043	17.992
7586	-103454.721	-20925.097	9.039
6599	-103455.336	-20901.729	23.376
6601	-103454.741	-20901.711	0.595
7594	-103455.331	-20878.676	23.042
2597	-103449.644	-20878.522	5.689
2525	-103432.244	-20878.058	17.406
2526	-103429.196	-20881.053	4.273
2511	-103429.188	-20887.764	6.711
2512	-103415.251	-20899.664	18.326
2513	-103402.602	-20910.301	16.527
2514	-103390.165	-20920.792	16.270
面積	2000.5490320		
地積	2000.54 m ²		

図面の種類	画 地 出 来 形 確 認 測 量 図	
街 区 名	4号公園	求 積 表
町 名	岩 倉 幡 枝 町	
京 都 市 洛 北 第 三 土 地 区 画 整 理 組 合		

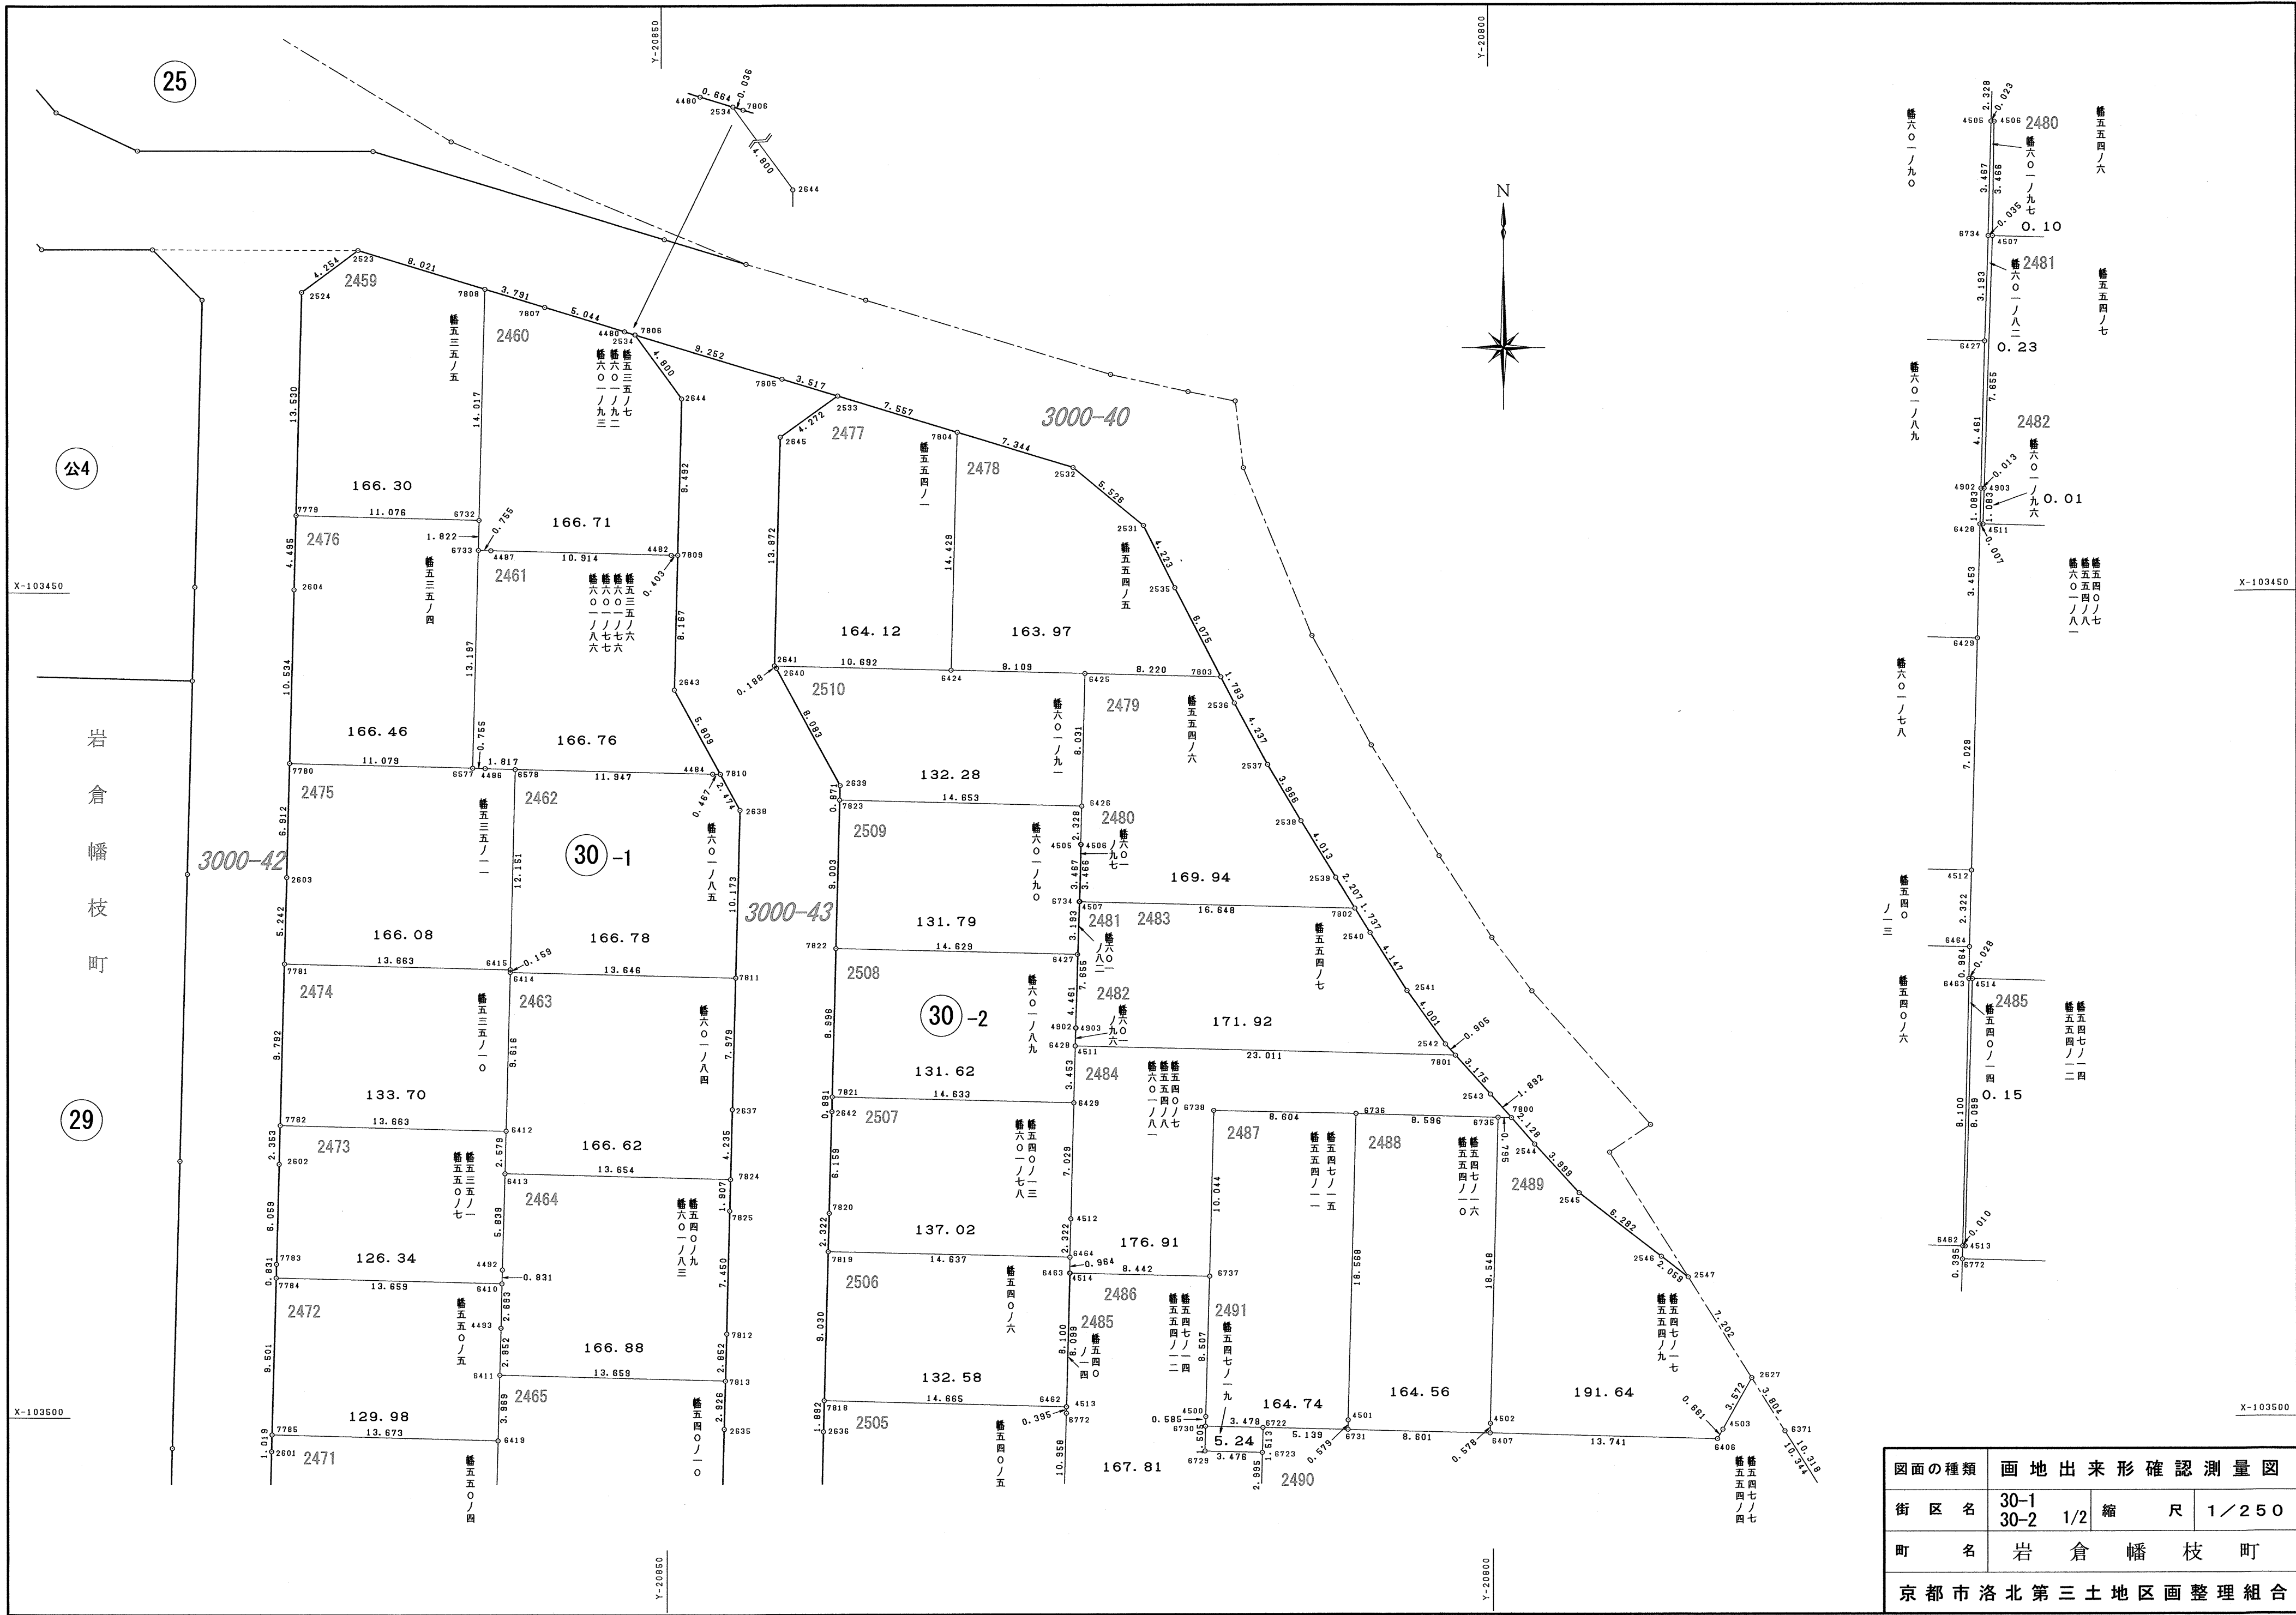

図面の種類	画地出来形確認測量図			
街 区 名	30-1 30-2	1/2	縮 尺	1／250
町 名	岩 倉 幡 枝 町			
京都市洛北第三土地区画整理組合				

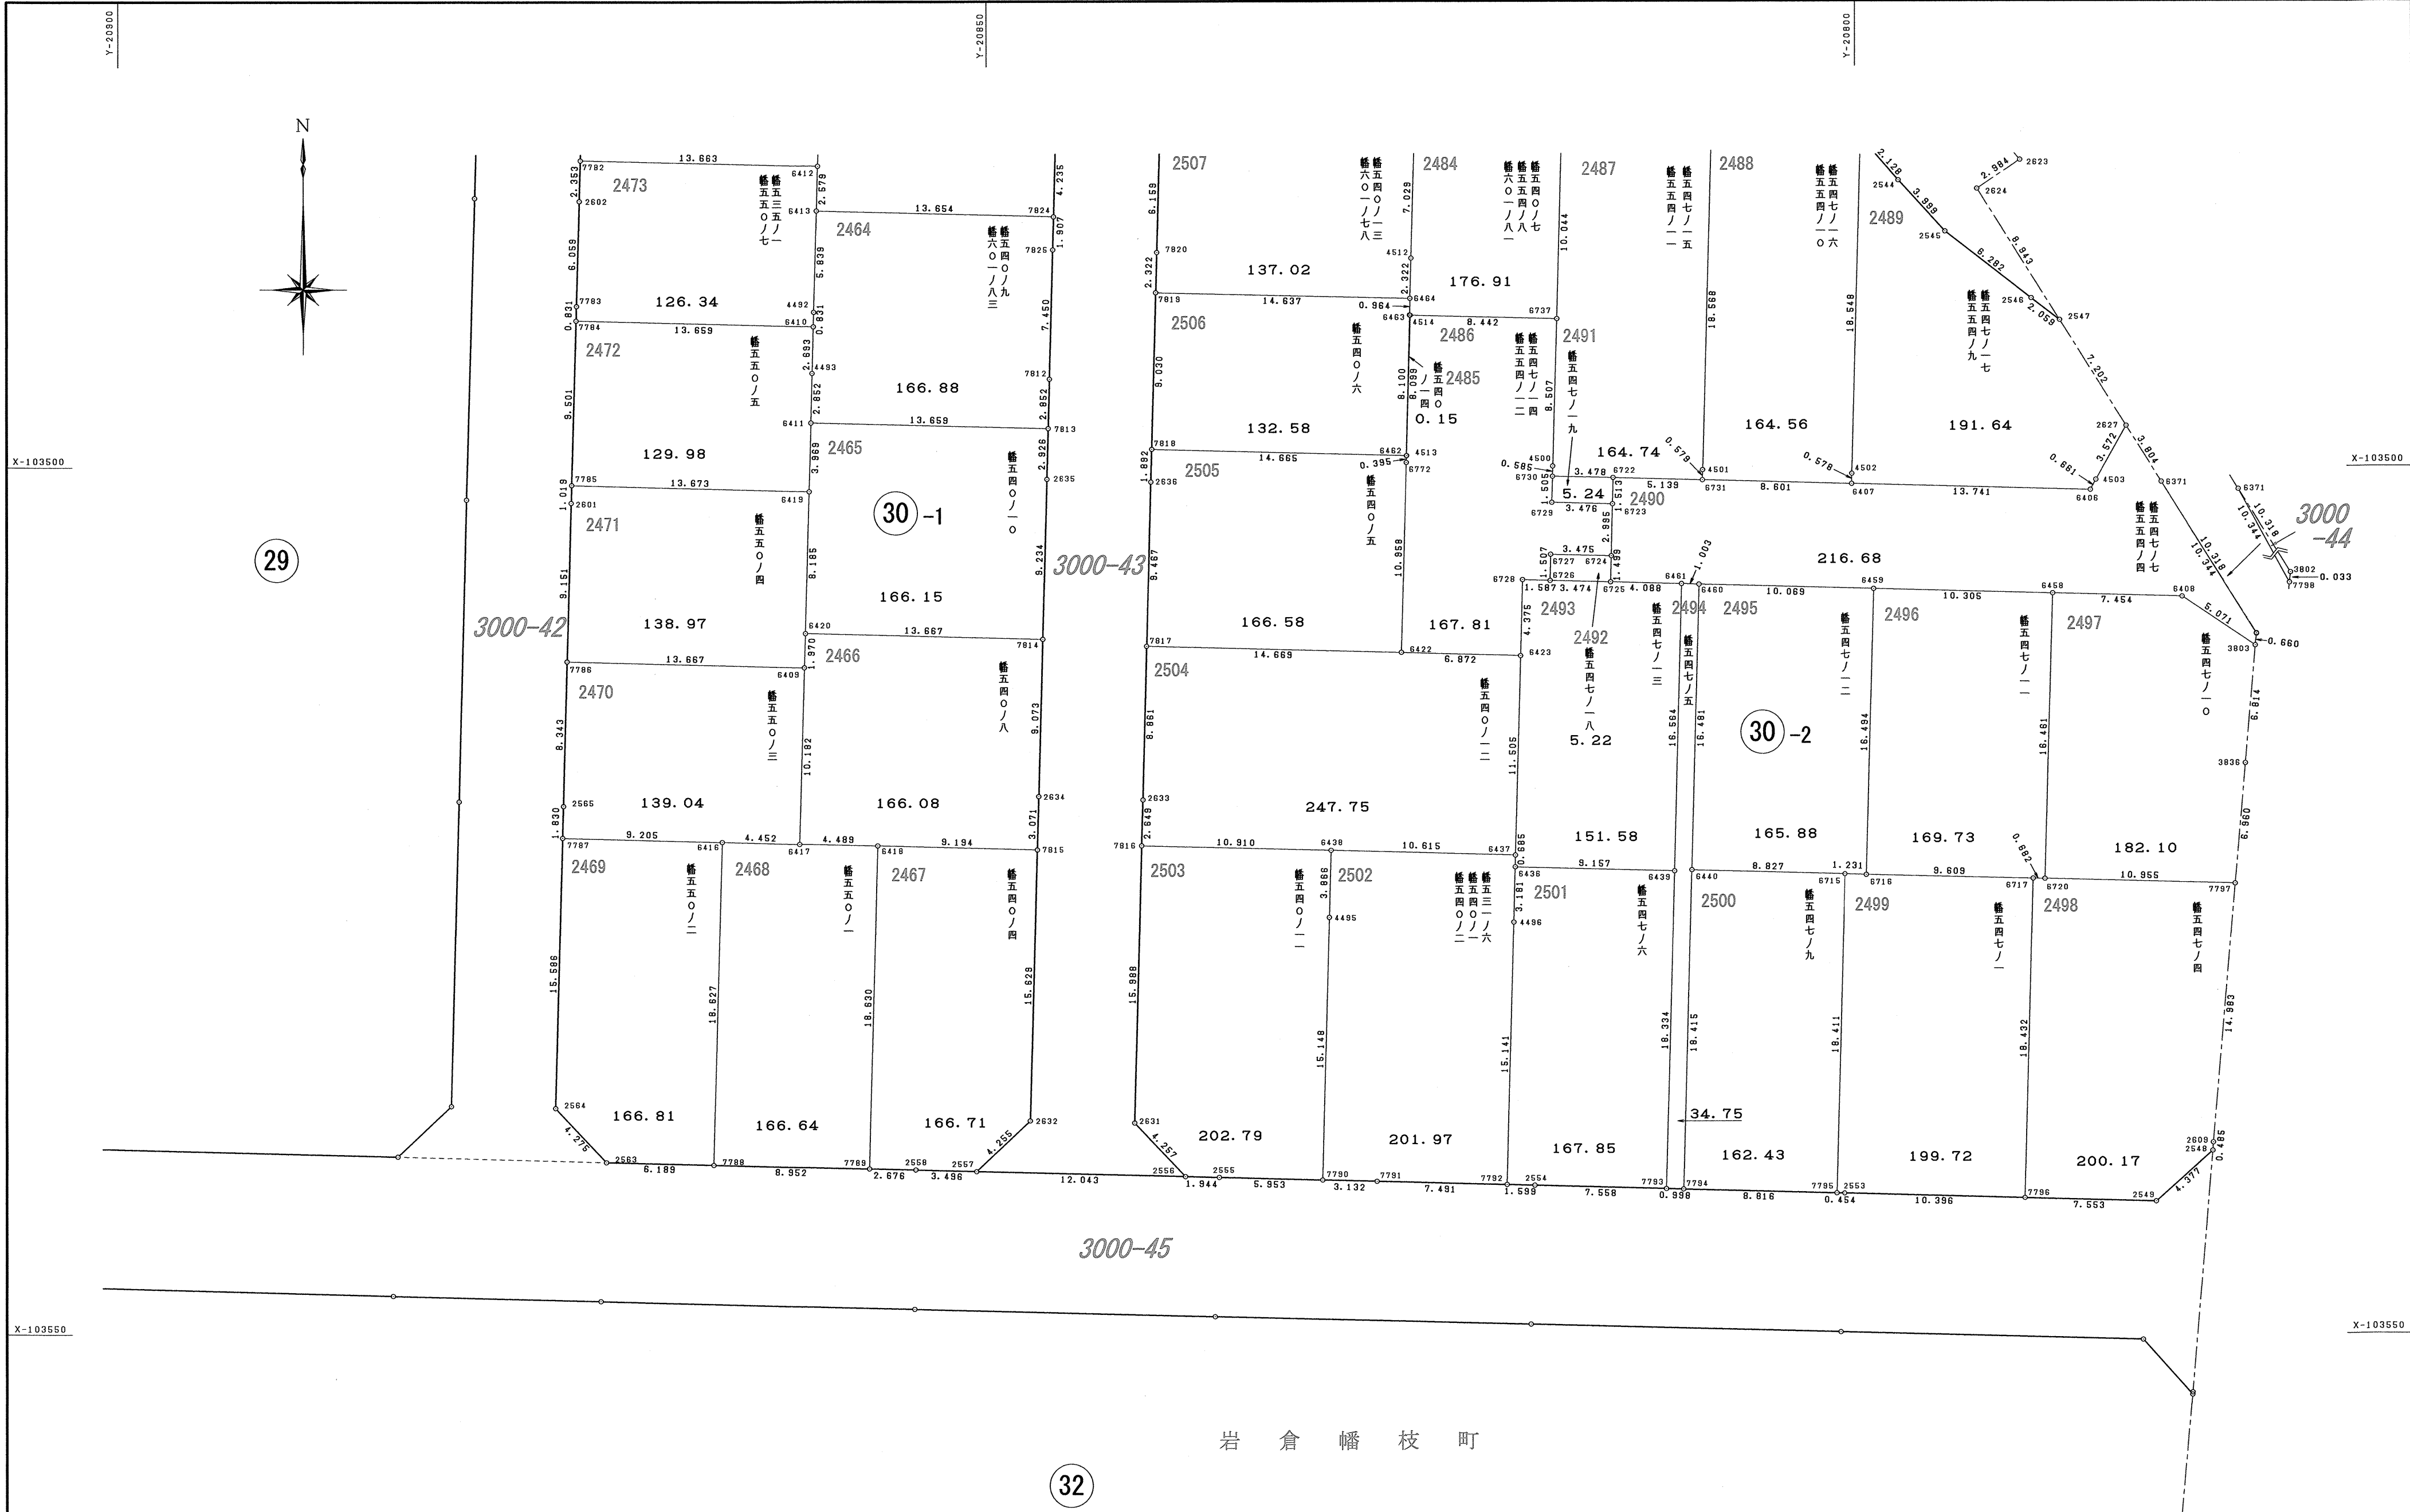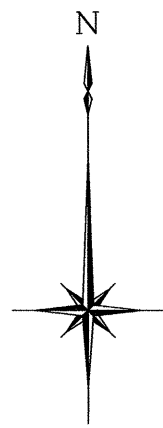

岩 倉 幡 枝 町

32

図面の種類	画地出来形確認測量図		
街区名	30-1 30-2	2/2	縮尺 1/250
町名	岩倉幡枝町		
京都市洛北第三土地区画整理組合			

2459

地番	幡五三五ノ五		
N O	X	Y	辺 長
2523	-103429.242	-20868.615	
2524	-103431.782	-20872.028	4.254
7779	-103445.308	-20872.384	13.530
6732	-103445.599	-20861.311	11.076
7808	-103431.586	-20860.944	14.017
2523	-103429.242	-20868.615	8.021
面積	166.3047830		
地積	166.30㎡		

2460

地番	幡五三五ノ七 幡六〇一ノ九二 幡六〇一ノ九三		
N O	X	Y	辺 長
7808	-103431.586	-20860.944	
6732	-103445.599	-20861.311	14.017
6733	-103447.421	-20861.356	1.822
4487	-103447.441	-20860.601	0.755
4482	-103447.723	-20849.690	10.914
7809	-103447.733	-20849.287	0.403
2644	-103438.244	-20849.032	9.492
2534	-103434.363	-20851.858	4.800
4480	-103434.169	-20852.494	0.664
7807	-103432.694	-20857.318	5.044
7808	-103431.586	-20860.944	3.791
面積	166.7175980		
地積	166.71㎡		

2461

地番	幡五三五ノ六 幡六〇一ノ七六 幡六〇一ノ七七 幡六〇一ノ八六		
N O	X	Y	辺 長
6733	-103447.421	-20861.356	
6577	-103460.614	-20861.710	13.197
4486	-103460.637	-20860.955	0.755
6578	-103460.694	-20859.138	1.817
4484	-103460.989	-20847.194	11.947
7810	-103461.000	-20846.727	0.467
2643	-103455.898	-20849.506	5.809
7809	-103447.733	-20849.287	8.167
4482	-103447.723	-20849.690	0.403
4487	-103447.441	-20860.601	10.914
6733	-103447.421	-20861.356	0.755
面積	166.7604110		
地積	166.76㎡		

2462

地番	幡六〇一ノ八五		
N O	X	Y	辺 長
7811	-103473.343	-20845.812	
2638	-103463.173	-20845.543	10.173
7810	-103461.000	-20846.727	2.474
4484	-103460.989	-20847.194	0.467
6578	-103460.694	-20859.138	11.947
6415	-103472.841	-20859.454	12.151
6414	-103473.000	-20859.454	0.159
7811	-103473.343	-20845.812	13.646
面積	166.7827515		
地積	166.78㎡		

2463

地番	幡六〇一ノ八四		
N O	X	Y	辺 長
6413	-103485.192	-20859.783	
7824	-103485.554	-20846.133	13.654
2637	-103481.320	-20846.023	4.235
7811	-103473.343	-20845.812	7.979
6414	-103473.000	-20859.454	13.646
6412	-103482.613	-20859.716	9.616
6413	-103485.192	-20859.783	2.579
面積	166.6240930		
地積	166.62㎡		

2464

地番	幡五四〇ノ九 幡六〇一ノ八三		
N O	X	Y	辺 長
6411	-103497.405	-20860.106	
7813	-103497.761	-20846.451	13.659
7812	-103494.909	-20846.377	2.852
7825	-103487.461	-20846.183	7.450
7824	-103485.554	-20846.133	1.907
6413	-103485.192	-20859.783	13.654
4492	-103491.029	-20859.948	5.839
6410	-103491.860	-20859.971	0.831
4493	-103494.553	-20860.037	2.693
6411	-103497.405	-20860.106	2.852
面積	166.8828340		
地積	166.88㎡		

2465

地番	幡五四〇ノ一〇		
N O	X	Y	辺 長
7814	-103509.918	-20846.771	
2635	-103500.687	-20846.527	9.234
7813	-103497.761	-20846.451	2.926
6411	-103497.405	-20860.106	13.659
6419	-103501.373	-20860.216	3.969
6420	-103509.556	-20860.434	8.185
7814	-103509.918	-20846.771	13.667
面積	166.1515490		
地積	166.15㎡		

2466

地番	幡五四〇ノ八		
N O	X	Y	辺 長
7815	-103522.058	-20847.092	
2634	-103518.988	-20847.010	3.071
7814	-103509.918	-20846.771	9.073
6420	-103509.556	-20860.434	13.667
6409	-103511.526	-20860.492	1.970
6417	-103521.705	-20860.771	10.182
6418	-103521.809	-20856.283	4.489
7815	-103522.058	-20847.092	9.194
面積	166.0896340		
地積	166.08㎡		

2467

地番	幡五四〇ノ四		
N O	X	Y	辺 長
2557	-103540.601	-20850.605	
2632	-103537.682	-20847.509	4.255
7815	-103522.058	-20847.092	15.629
6418	-103521.809	-20856.283	9.194
7789	-103540.433	-20856.776	18.630
2558	-103540.501	-20854.100	2.676
2557	-103540.601	-20850.605	3.496
面積	166.7198595		
地積	166.71㎡		

2468

地番	幡五五〇ノ一		
N O	X	Y	辺 長
7789	-103540.433	-20856.776	
6418	-103521.809	-20856.283	18.630
6417	-103521.705	-20860.771	4.489
6416	-103521.586	-20865.222	4.452
7788	-103540.207	-20865.726	18.627
7789	-103540.433	-20856.776	8.952
面積	166.6452805		
地積	166.64㎡		

2469

地番	幡五五〇ノ二		
N O	X	Y	辺 長
7788	-103540.207	-20865.726	
6416	-103521.586	-20865.222	18.627
7787	-103521.350	-20874.424	9.205
2564	-103536.931	-20874.837	15.586
2563	-103540.051	-20871.914	4.275
7788	-103540.207	-20865.726	6.189
面積	166.8157185		
地積	166.81㎡		

2470

地番	幡五五〇ノ三		
N O	X	Y	辺 長
7787	-103521.350	-20874.424	
6416	-103521.586	-20865.222	9.205
6417	-103521.705	-20860.771	4.452
6409	-103511.526	-20860.492	10.182
7786	-103511.179	-20874.155	13.667
2565	-103519.520	-20874.375	8.343
7787	-103521.350	-20874.424	1.830
面積	139.0409685		
地積	139.04㎡		

2471

地番	幡五五〇ノ四		
N O	X	Y	辺 長
7786	-103511.179	-20874.155	
6409	-103511.526	-20860.492	13.667
6420	-103509.556	-20860.434	1.970
6419	-103501.373	-20860.216	8.185
7785	-103501.012	-20873.885	13.673
2601	-103502.031	-20873.913	1.019
7786	-103511.179	-20874.155	9.151
面積	138.9705520		
地積	138.97㎡		

2472

地番	幡五五〇ノ五		
N O	X	Y	辺 長
7785	-103501.012	-20873.885	
6419	-103501.373	-20860.216	13.673
6411	-103497.405	-20860.106	3.969
4493	-103494.553	-20860.037	2.852
6410	-103491.860	-20859.971	2.693
7784	-103491.514	-20873.626	13.659
7785	-103501.012	-20873.885	9.501
面積	129.9891505		
地積	129.98㎡		

2473

地番	幡五三五ノ一 幡五五〇ノ七		
N O	X	Y	辺 長
7784	-103491.514	-20873.626	
6410	-103491.860	-20859.971	13.659
4492	-103491.029	-20859.948	0.831
6413	-103485.192	-20859.783	5.839
6412	-103482.613	-20859.716	2.579
7782	-103482.273	-20873.375	13.663
2602	-103484.626	-20873.438	2.353
7783	-103490.683	-20873.603	6.059
7784	-103491.514	-20873.626	0.831
面積	126.3443950		
地積	126.34㎡		

2474

地番	幡五三五ノ一〇		
N O	X	Y	辺 長
7782	-103482.273	-20873.375	
6412	-103482.613	-20859.716	13.663
6414	-103473.000	-20859.454	9.616
6415	-103472.841	-20859.454	0.159
7781	-103472.484	-20873.113	13.663
7782	-103482.273	-20873.375	9.792
面積	133.7039855		
地積	133.70㎡		

2475

地番	幡五三五ノ一一		
N O	X	Y	辺 長
7781	-103472.484	-20873.113	
6415	-103472.841	-20859.454	13.663
6578	-103460.694	-20859.138	12.151
4486	-103460.637	-20860.955	1.817
6577	-103460.614	-20861.710	0.755
7780	-103460.333	-20872.786	11.079
2603	-103467.243	-20872.973	6.912
7781	-103472.484	-20873.113	5.242
面積	166.0804195		
地積	166.08㎡		

2476

地番	幡五三五ノ四		
N O	X	Y	辺 長
7780	-103460.333	-20872.786	
6577	-103460.614	-20861.710	11.079
6733	-103447.421	-20861.356	13.197
6732	-103445.599	-20861.311	1.822
7779	-103445.308	-20872.384	11.076
2604	-103449.802	-20872.502	4.495
7780	-103460.333	-20872.786	10.534
面積	166.4623655		
地積	166.46㎡		

図面の種類	画地出来形確認測量図		
街 区 名	30-1	求 積 表	
町 名	岩 倉 幡 枝 町		
京都市洛北第三土地区画整理組合			

2477

地番	幡五五四ノ一		
N O	X	Y	辺 長
2533	-103438.099	-20839.608	
2645	-103440.582	-20843.085	4.272
2641	-103454.450	-20843.454	13.872
6424	-103454.732	-20832.765	10.692
7804	-103440.308	-20832.381	14.429
2533	-103438.099	-20839.608	7.557
面積	164.1268620		
地積	164.12㎡		

2478

地番	幡五五四ノ五		
N O	X	Y	辺 長
7804	-103440.308	-20832.381	
6424	-103454.732	-20832.765	14.429
6425	-103454.941	-20824.658	8.109
7803	-103455.166	-20816.441	8.220
2535	-103449.762	-20819.217	6.075
2531	-103445.985	-20821.106	4.223
2532	-103442.454	-20825.357	5.526
7804	-103440.308	-20832.381	7.344
面積	163.9760910		
地積	163.97㎡		

2479

地番	幡五五四ノ六		
N O	X	Y	辺 長
7803	-103455.166	-20816.441	
6425	-103454.941	-20824.658	8.220
6426	-103462.970	-20824.867	8.031
4505	-103465.298	-20824.928	2.328
4506	-103465.299	-20824.905	0.023
4507	-103468.765	-20824.983	3.466
7802	-103469.197	-20808.340	16.648
2539	-103467.321	-20809.504	2.207
2538	-103463.898	-20811.599	4.013
2537	-103460.483	-20813.617	3.966
2536	-103456.752	-20815.626	4.237
7803	-103455.166	-20816.441	1.783
面積	169.9407195		
地積	169.94㎡		

2480

地番	幡六〇一ノ九七		
N O	X	Y	辺 長
4505	-103465.298	-20824.928	
6734	-103468.764	-20825.018	3.467
4507	-103468.765	-20824.983	0.035
4506	-103465.299	-20824.905	3.466
4505	-103465.298	-20824.928	0.023
面積	0.1005980		
地積	0.10㎡		

2481

地番	幡六〇一ノ八二		
N O	X	Y	辺 長
6734	-103468.764	-20825.018	
6427	-103471.956	-20825.127	3.193
4902	-103476.416	-20825.248	4.461
4903	-103476.416	-20825.235	0.013
4507	-103468.765	-20824.983	7.655
6734	-103468.764	-20825.018	0.035
面積	0.2337105		
地積	0.23㎡		

2482

地番	幡六〇一ノ九六		
N O	X	Y	辺 長
4902	-103476.416	-20825.248	
6428	-103477.499	-20825.277	1.083
4511	-103477.499	-20825.270	0.007
4903	-103476.416	-20825.235	1.083
4902	-103476.416	-20825.248	0.013
面積	0.0108300		
地積	0.01㎡		

2483

地番	幡五五四ノ七		
N O	X	Y	辺 長
7802	-103469.197	-20808.340	
4507	-103468.765	-20824.983	16.648
4903	-103476.416	-20825.235	7.655
4511	-103477.499	-20825.270	1.083
7801	-103478.101	-20802.266	23.011
2542	-103477.426	-20802.870	0.905
2541	-103474.178	-20805.207	4.001
2540	-103470.673	-20807.424	4.147
7802	-103469.197	-20808.340	1.737
面積	171.9278770		
地積	171.92㎡		

2484

地番	幡五四〇ノ七 幡六〇一ノ八一		
N O	X	Y	辺 長
7801	-103478.101	-20802.266	
4511	-103477.499	-20825.270	23.011
6428	-103477.499	-20825.277	0.007
6429	-103480.952	-20825.360	3.453
4512	-103487.979	-20825.546	7.029
6464	-103490.301	-20825.606	2.322
6463	-103491.265	-20825.622	0.964
4514	-103491.266	-20825.594	0.028
6737	-103491.471	-20817.154	8.442
6738	-103481.430	-20816.891	10.044
6736	-103481.635	-20808.289	8.604
6735	-103481.876	-20799.696	8.596
7800	-103481.891	-20798.901	0.795
2543	-103480.467	-20800.148	1.892
7801	-103478.101	-20802.266	3.175
面積	176.9123690		
地積	176.91㎡		

2485

地番	幡五四〇ノ一四		
N O	X	Y	辺 長
6463	-103491.265	-20825.622	
6462	-103499.363	-20825.820	8.100
4513	-103499.363	-20825.810	0.010
4514	-103491.266	-20825.594	8.099
6463	-103491.265	-20825.622	0.028
面積	0.1539560		
地積	0.15㎡		

2486

地番	幡五四七ノ一四 幡五五四ノ一二		
N O	X	Y	辺 長
6724	-103505.150	-20814.046	
6723	-103502.155	-20813.970	2.995
6729	-103502.065	-20817.445	3.476
6730	-103500.560	-20817.408	1.505
4500	-103499.975	-20817.392	0.585
6737	-103491.471	-20817.154	8.507
4514	-103491.266	-20825.594	8.442
4513	-103499.363	-20825.810	8.099
6462	-103499.363	-20825.820	0.010
6772	-103499.758	-20825.830	0.395
6422	-103510.713	-20826.113	10.958
6423	-103510.897	-20819.243	6.872
6728	-103506.523	-20819.142	4.375
6726	-103506.571	-20817.555	1.587
6727	-103505.064	-20817.520	1.507
6724	-103505.150	-20814.046	3.475
面積	167.8167825		
地積	167.81㎡		

2487

地番	幡五四七ノ一五 幡五五四ノ一一		
N O	X	Y	辺 長
6731	-103500.776	-20808.792	
4501	-103500.197	-20808.777	0.579
6736	-103481.635	-20808.289	18.568
6738	-103481.430	-20816.891	8.604
6737	-103491.471	-20817.154	10.044
4500	-103499.975	-20817.392	8.507
6730	-103500.560	-20817.408	0.585
6722	-103500.642	-20813.930	3.478
6731	-103500.776	-20808.792	5.139
面積	164.7420250		
地積	164.74㎡		

2488

地番	幡五四七ノ一六 幡五五四ノ一〇		
N O	X	Y	辺 長
6407	-103500.996	-20800.193	
4502	-103500.418	-20800.178	0.578
6735	-103481.876	-20799.696	18.548
6736	-103481.635	-20808.289	8.596
4501	-103500.197	-20808.777	18.568
6731	-103500.776	-20808.792	0.579
6407	-103500.996	-20800.193	8.601
面積	164.5628560		
地積	164.56㎡		

2489

地番	幡五四七ノ一七 幡五五四ノ九		
N O	X	Y	辺 長
6406	-103501.357	-20786.456	
4503	-103500.780	-20786.133	0.661
2627	-103497.663	-20784.388	3.572
2547	-103491.559	-20788.212	7.202
2546	-103490.302	-20789.843	2.059
2545	-103486.448	-20794.805	6.282
2544	-103483.492	-20797.499	3.999
7800	-103481.891	-20798.901	2.128
6735	-103481.876	-20799.696	0.795
4502	-103500.418	-20800.178	18.548
6407	-103500.996	-20800.193	0.578
6406	-103501.357	-20786.456	13.741
面積	191.6478595		
地積	191.64㎡		

2490

地番	幡五四七ノ七 幡五五四ノ四		
N O	X	Y	辺 長
6371	-103500.887	-20782.369	
2627	-103497.663	-20784.388	3.804
4503	-103500.780	-20786.133	3.572
6406	-103501.357	-20786.456	0.661
6407	-103500.996	-20800.193	13.741
6731	-103500.776	-20808.792	8.601
6722	-103500.642	-20813.930	5.139
6723	-103502.155	-20813.970	1.513
6724	-103505.150	-20814.046	2.995
6725	-103506.649	-20814.081	1.499
6461	-103506.751	-20809.994	4.088
6460	-103506.779	-20808.991	1.003
6459	-103507.045	-20798.925	10.069
6458	-103507.311	-20788.623	10.305
6408	-103507.500	-20781.171	7.454
3803	-103510.323	-20776.958	5.071
7798	-103509.665	-20776.896	0.660
6371	-103500.887	-20782.369	10.344
面積	216.6801415		
地積	216.68㎡		

2491

地番	幡五四七ノ一九		
N O	X	Y	辺 長
6730	-103500.560	-20817.408	
6729	-103502.065	-20817.445	1.505
6723	-103502.155	-20813.970	3.476
6722	-103500.642	-20813.930	1.513
6730	-103500.560	-20817.408	3.478
面積	5.2493495		
地積	5.24㎡		

2492

地番	幡五四七ノ一八		
N O	X	Y	辺 長
6727	-103505.064	-20817.520	
6726	-103506.571	-20817.555	1.507
6725	-103506.649	-20814.081	3.474
6724	-103505.150	-20814.046	1.499
6727	-103505.064	-20817.520	3.475
面積	5.2242920		
地積	5.22㎡		

2493

地番	幡五四七ノ一三		
N O	X	Y	辺 長
6461	-103506.751	-20809.994	
6725	-103506.649	-20814.081	4.088
6726	-103506.571	-20817.555	3.474
6728	-103506.523	-20819.142	1.587
6423	-103510.897	-20819.243	4.375
6437	-103522.398	-20819.558	11.505
6436	-103523.083	-20819.567	0.685
6439	-103523.310	-20810.412	9.157
6461	-103506.751	-20809.994	16.564
面積	151.5822405		
地積	151.58㎡		

2494

地 番	幡五四七ノ五		
N O	X	Y	辺 長
7794	-103541.664	-20809.897	
6440	-103523.255	-20809.419	18.415
6460	-103506.779	-20808.991	16.481
6461	-103506.751	-20809.994	1.003
6439	-103523.310	-20810.412	16.564
7793	-103541.638	-20810.895	18.334
7794	-103541.664	-20809.897	0.998
面積	34.7576290		
地積	34.75 m ²		

2499

地番	幡五四七ノ一		
N O	X	Y	辺 長
7796	-103542.183	-20790.237	
6717	-103523.757	-20789.757	18.432
6716	-103523.534	-20799.364	9.609
6715	-103523.489	-20800.595	1.231
7795	-103541.894	-20801.084	18.411
2553	-103541.906	-20800.630	0.454
7796	-103542.183	-20790.237	10.396
面積	199.7255700		
地積	199.72㎡		

2500

地番	幡五四七ノ九		
N O	X	Y	辺 長
7795	-103541.894	-20801.084	
6715	-103523.489	-20800.595	18.411
6440	-103523.255	-20809.419	8.827
7794	-103541.664	-20809.897	18.415
7795	-103541.894	-20801.084	8.816
面積	162.4343015		
地積	162.43㎡		

2501

地番	幡五四七ノ六		
N O	X	Y	辺 長
7793	-103541.638	-20810.895	
6439	-103523.310	-20810.412	18.334
6436	-103523.083	-20819.567	9.157
4496	-103526.263	-20819.651	3.181
7792	-103541.399	-20820.050	15.141
2554	-103541.441	-20818.451	1.599
7793	-103541.638	-20810.895	7.558
面積	167.8529255		
地積	167.85㎡		

2502

地番	幡五三ノ六 幡五四〇ノ二	幡五四〇ノ一	
N O	X	Y	辺 長
7792	-103541.399	-20820.050	
4496	-103526.263	-20819.651	15.141
6436	-103523.083	-20819.567	3.181
6437	-103522.398	-20819.558	0.685
6438	-103522.112	-20830.170	10.615
4495	-103525.977	-20830.272	3.866
7790	-103541.120	-20830.670	15.148
7791	-103541.202	-20827.539	3.132
7792	-103541.399	-20820.050	7.491
面積	201.9753990		
地積	201.97㎡		

2503

地番	幡五四〇ノ一		
N O	X	Y	辺 長
7790	-103541.120	-20830.670	
4495	-103525.977	-20830.272	15.148
6438	-103522.112	-20830.170	3.866
7816	-103521.832	-20841.077	10.910
2631	-103537.815	-20841.490	15.988
2556	-103540.908	-20838.565	4.257
2555	-103540.964	-20836.621	1.944
7790	-103541.120	-20830.670	5.953
面積	202.7920460		
地積	202.79㎡		

2504

地番	幡五四〇ノ一二		
N O	X	Y	辺 長
7817	-103510.325	-20840.777	
2633	-103519.183	-20841.008	8.861
7816	-103521.832	-20841.077	2.649
6438	-103522.112	-20830.170	10.910
6437	-103522.398	-20819.558	10.615
6423	-103510.897	-20819.243	11.505
6422	-103510.713	-20826.113	6.872
7817	-103510.325	-20840.777	14.669
面積	247.7584690		
地積	247.75㎡		

2505

地番	幡五四〇ノ五		
N O	X	Y	辺 長
7818	-103498.969	-20840.480	
2636	-103500.861	-20840.531	1.892
7817	-103510.325	-20840.777	9.467
6422	-103510.713	-20826.113	14.669
6772	-103499.758	-20825.830	10.958
6462	-103499.363	-20825.820	0.395
7818	-103498.969	-20840.480	14.665
面積	166.5827645		
地積	166.58㎡		

2506

地番	幡五四〇ノ六		
N O	X	Y	辺 長
7819	-103489.942	-20840.239	
7818	-103498.969	-20840.480	9.030
6462	-103499.363	-20825.820	14.665
6463	-103491.265	-20825.622	8.100
6464	-103490.301	-20825.606	0.964
7819	-103489.942	-20840.239	14.637
面積	132.5865750		
地積	132.58㎡		

2507

地番	幡五四〇ノ一三 幡六〇一ノ七八		
N O	X	Y	辺 長
7819	-103489.942	-20840.239	
6464	-103490.301	-20825.606	14.637
4512	-103487.979	-20825.546	2.322
6429	-103480.952	-20825.360	7.029
7821	-103480.572	-20839.989	14.633
2642	-103481.463	-20840.012	0.891
7820	-103487.620	-20840.177	6.159
7819	-103489.942	-20840.239	2.322
面積	137.0224225		
地積	137.02㎡		

2508

地番	幡六〇一ノ八九		
N O	X	Y	辺 長
7821	-103480.572	-20839.989	
6429	-103480.952	-20825.360	14.633
6428	-103477.499	-20825.277	3.453
4902	-103476.416	-20825.248	1.083
6427	-103471.956	-20825.127	4.461
7822	-103471.579	-20839.752	14.629
7821	-103480.572	-20839.989	8.996
面積	131.6217070		
地積	131.62㎡		

2509

地番	幡六〇一ノ九〇		
N O	X	Y	辺 長
7823	-103462.579	-20839.515	
7822	-103471.579	-20839.752	9.003
6427	-103471.956	-20825.127	14.629
6734	-103468.764	-20825.018	3.193
4505	-103465.298	-20824.928	3.467
6426	-103462.970	-20824.867	2.328
7823	-103462.579	-20839.515	14.653
面積	131.7952925		
地積	131.79㎡		

2510

地番	幡六〇一ノ九一		
N O	X	Y	辺 長
2641	-103454.450	-20843.454	
2640	-103454.595	-20843.333	0.188
2639	-103461.708	-20839.492	8.083
7823	-103462.579	-20839.515	0.871
6426	-103462.970	-20824.867	14.653
6425	-103454.941	-20824.658	8.031
6424	-103454.732	-20832.765	8.109
2641	-103454.450	-20843.454	10.692
面積	132.2877045		
地積	132.28㎡		

図面の種類	画地出来形確認測量図		
街 区 名	30-2	2/2	求 積 表
町 名	岩 倉 幡 枝 町		
京都市洛北第三土地区画整理組合			