

京都市都市計画（京都国際文化観光都市建設計画）  
都市計画事業洛北第三地区土地区画整理事業

画地出来形確認測量図

2 / 2

32街区～57街区


平成25年10月25日現在

京都市洛北第三土地区画整理組合  
第一測量設計株式会社


洛北第三地区土地区画整理事業 画地出来形確認測量図(2/2)	
地番(岩倉幡枝町)	街区名
2371~2379	36
2380~2393	35
2394~2410	37
2411~2426	38
2511~2530	32
2531-1~2555	34
2556~2573	57,3号公園
2574~2600	33
2601~2630	39
2631~2644	40
2645~2651	41
2652~2653	42
2654~2681	44
2682~2705	45
2706~2719	43-1
2720~2739	43-2
2740~2745	46
2746~2767	47,48,49
2768~2785	50
2786~2788	53
2789~2798	52,5号公園
2799~2821	55,56
2822~2840	51

京都都市計画（京都国際文化観光都市建設計画）  
都市計画事業洛北第三地区土地区画整理事業

新町界図

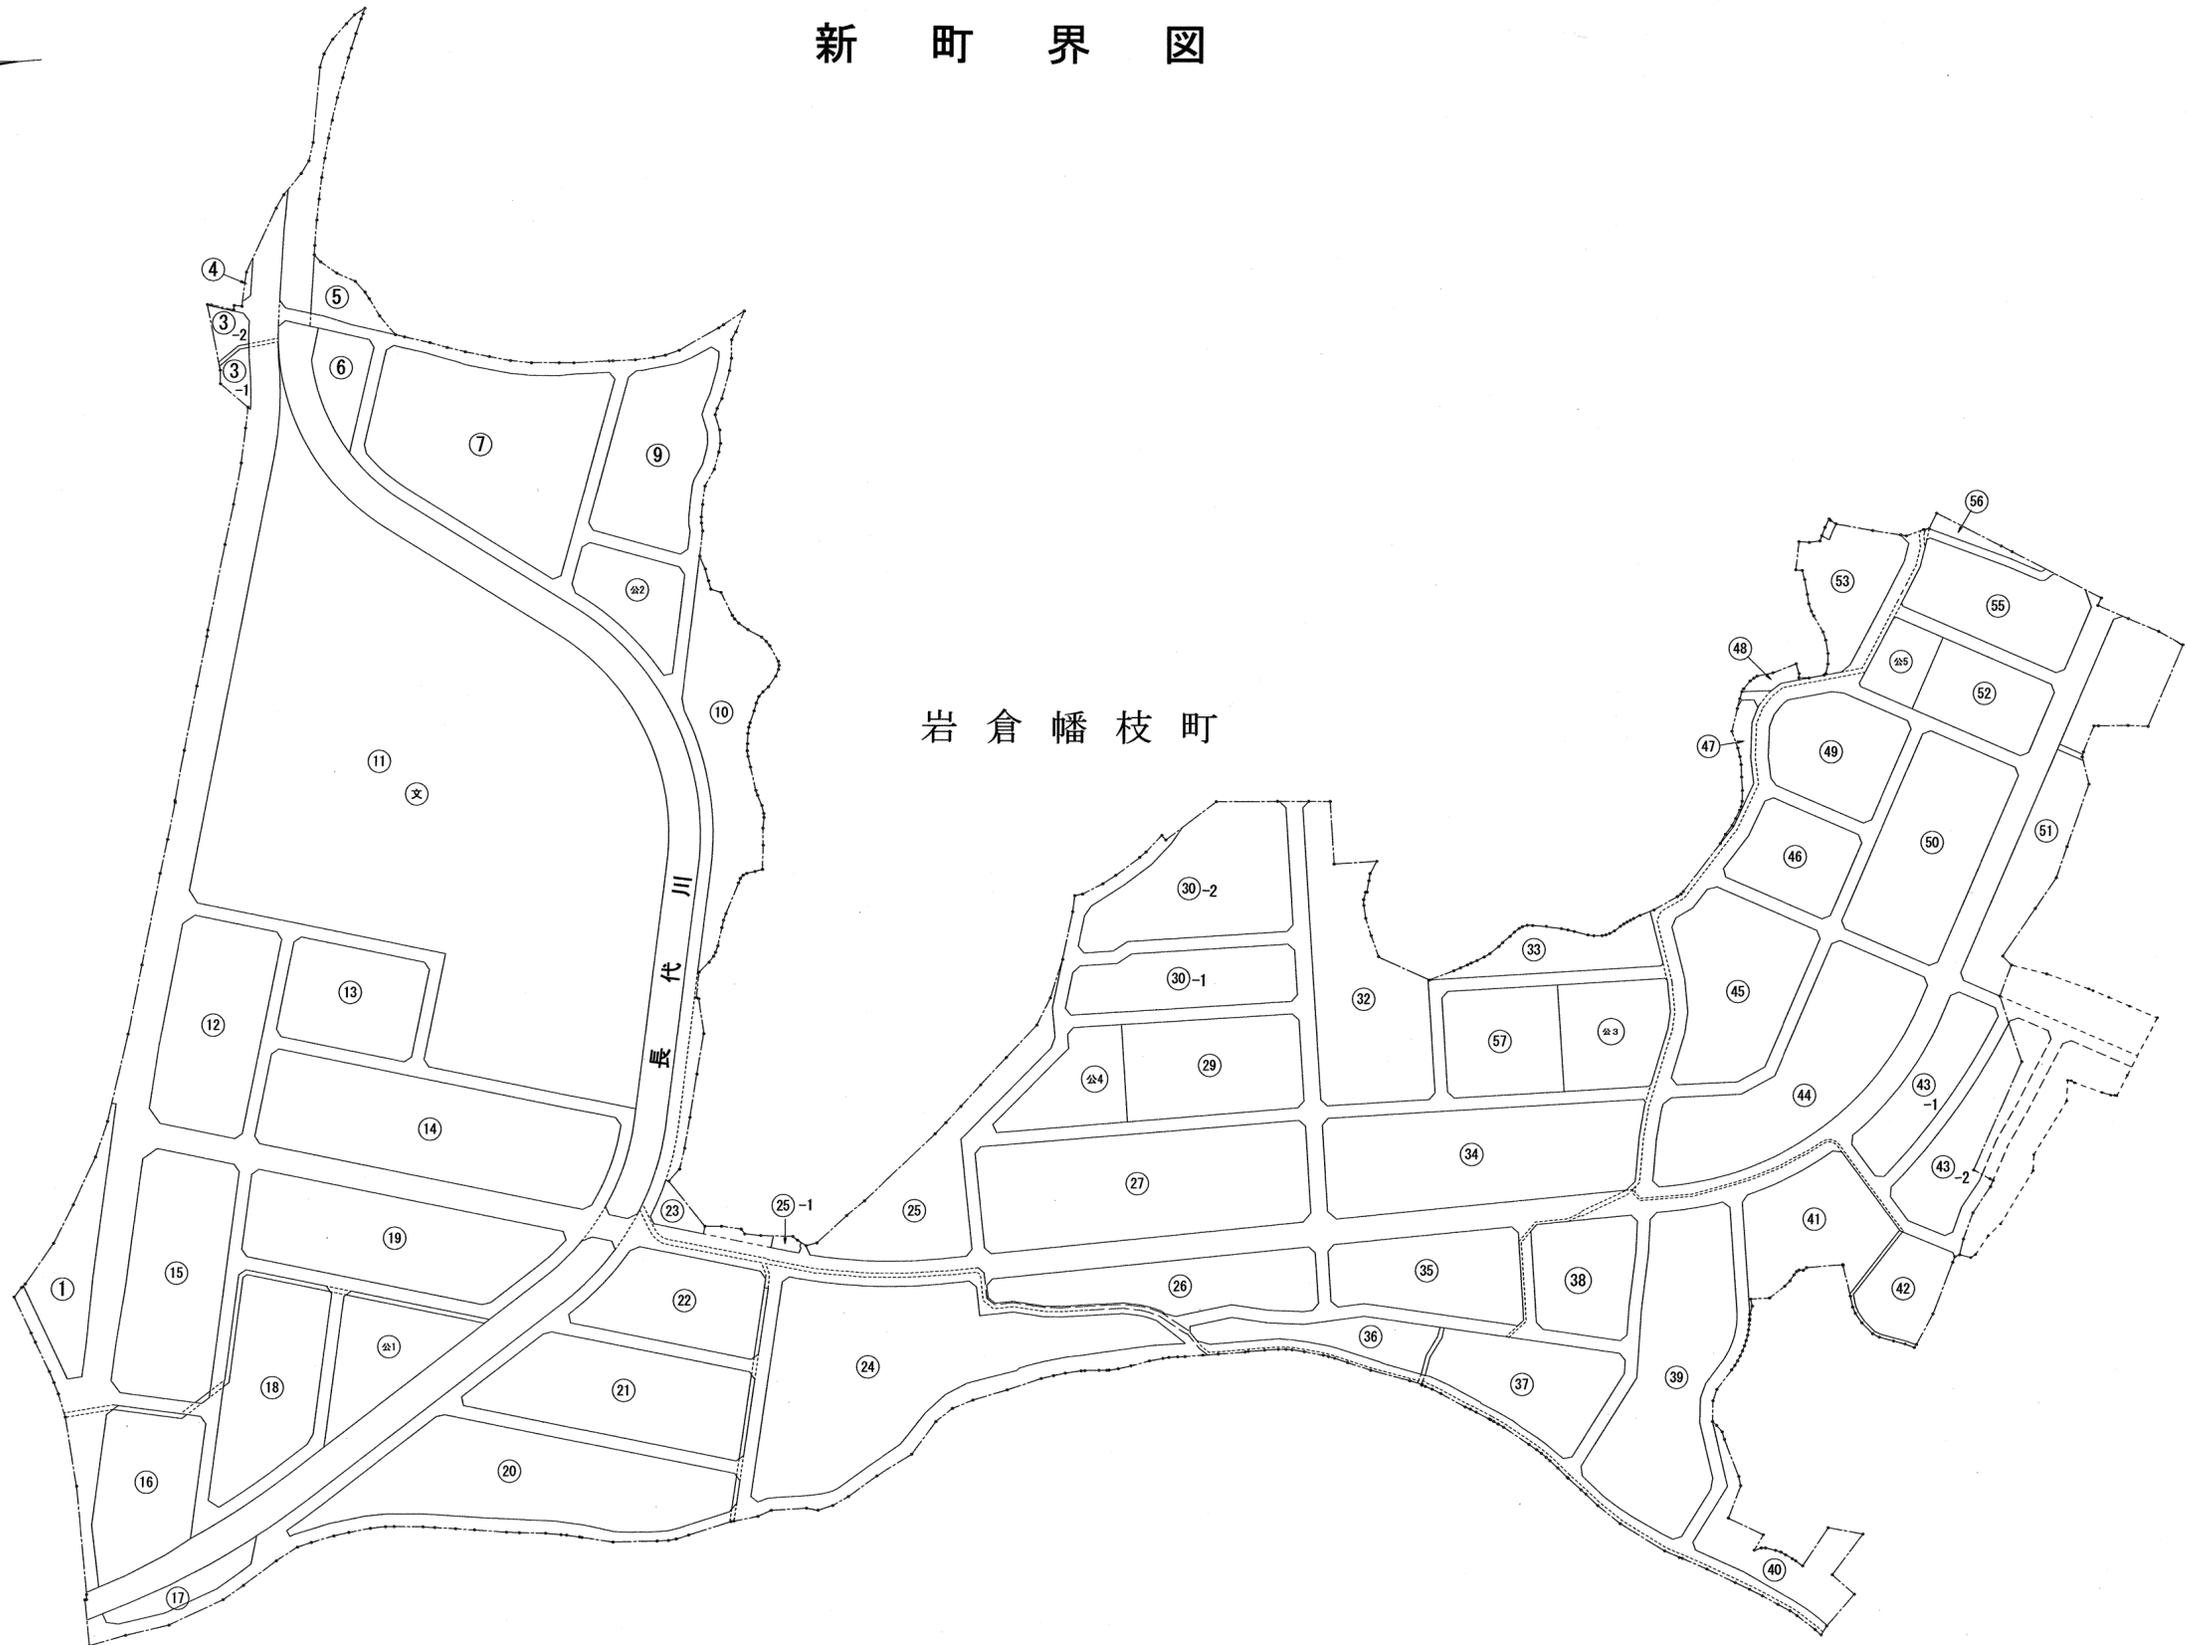

岩倉幡枝町

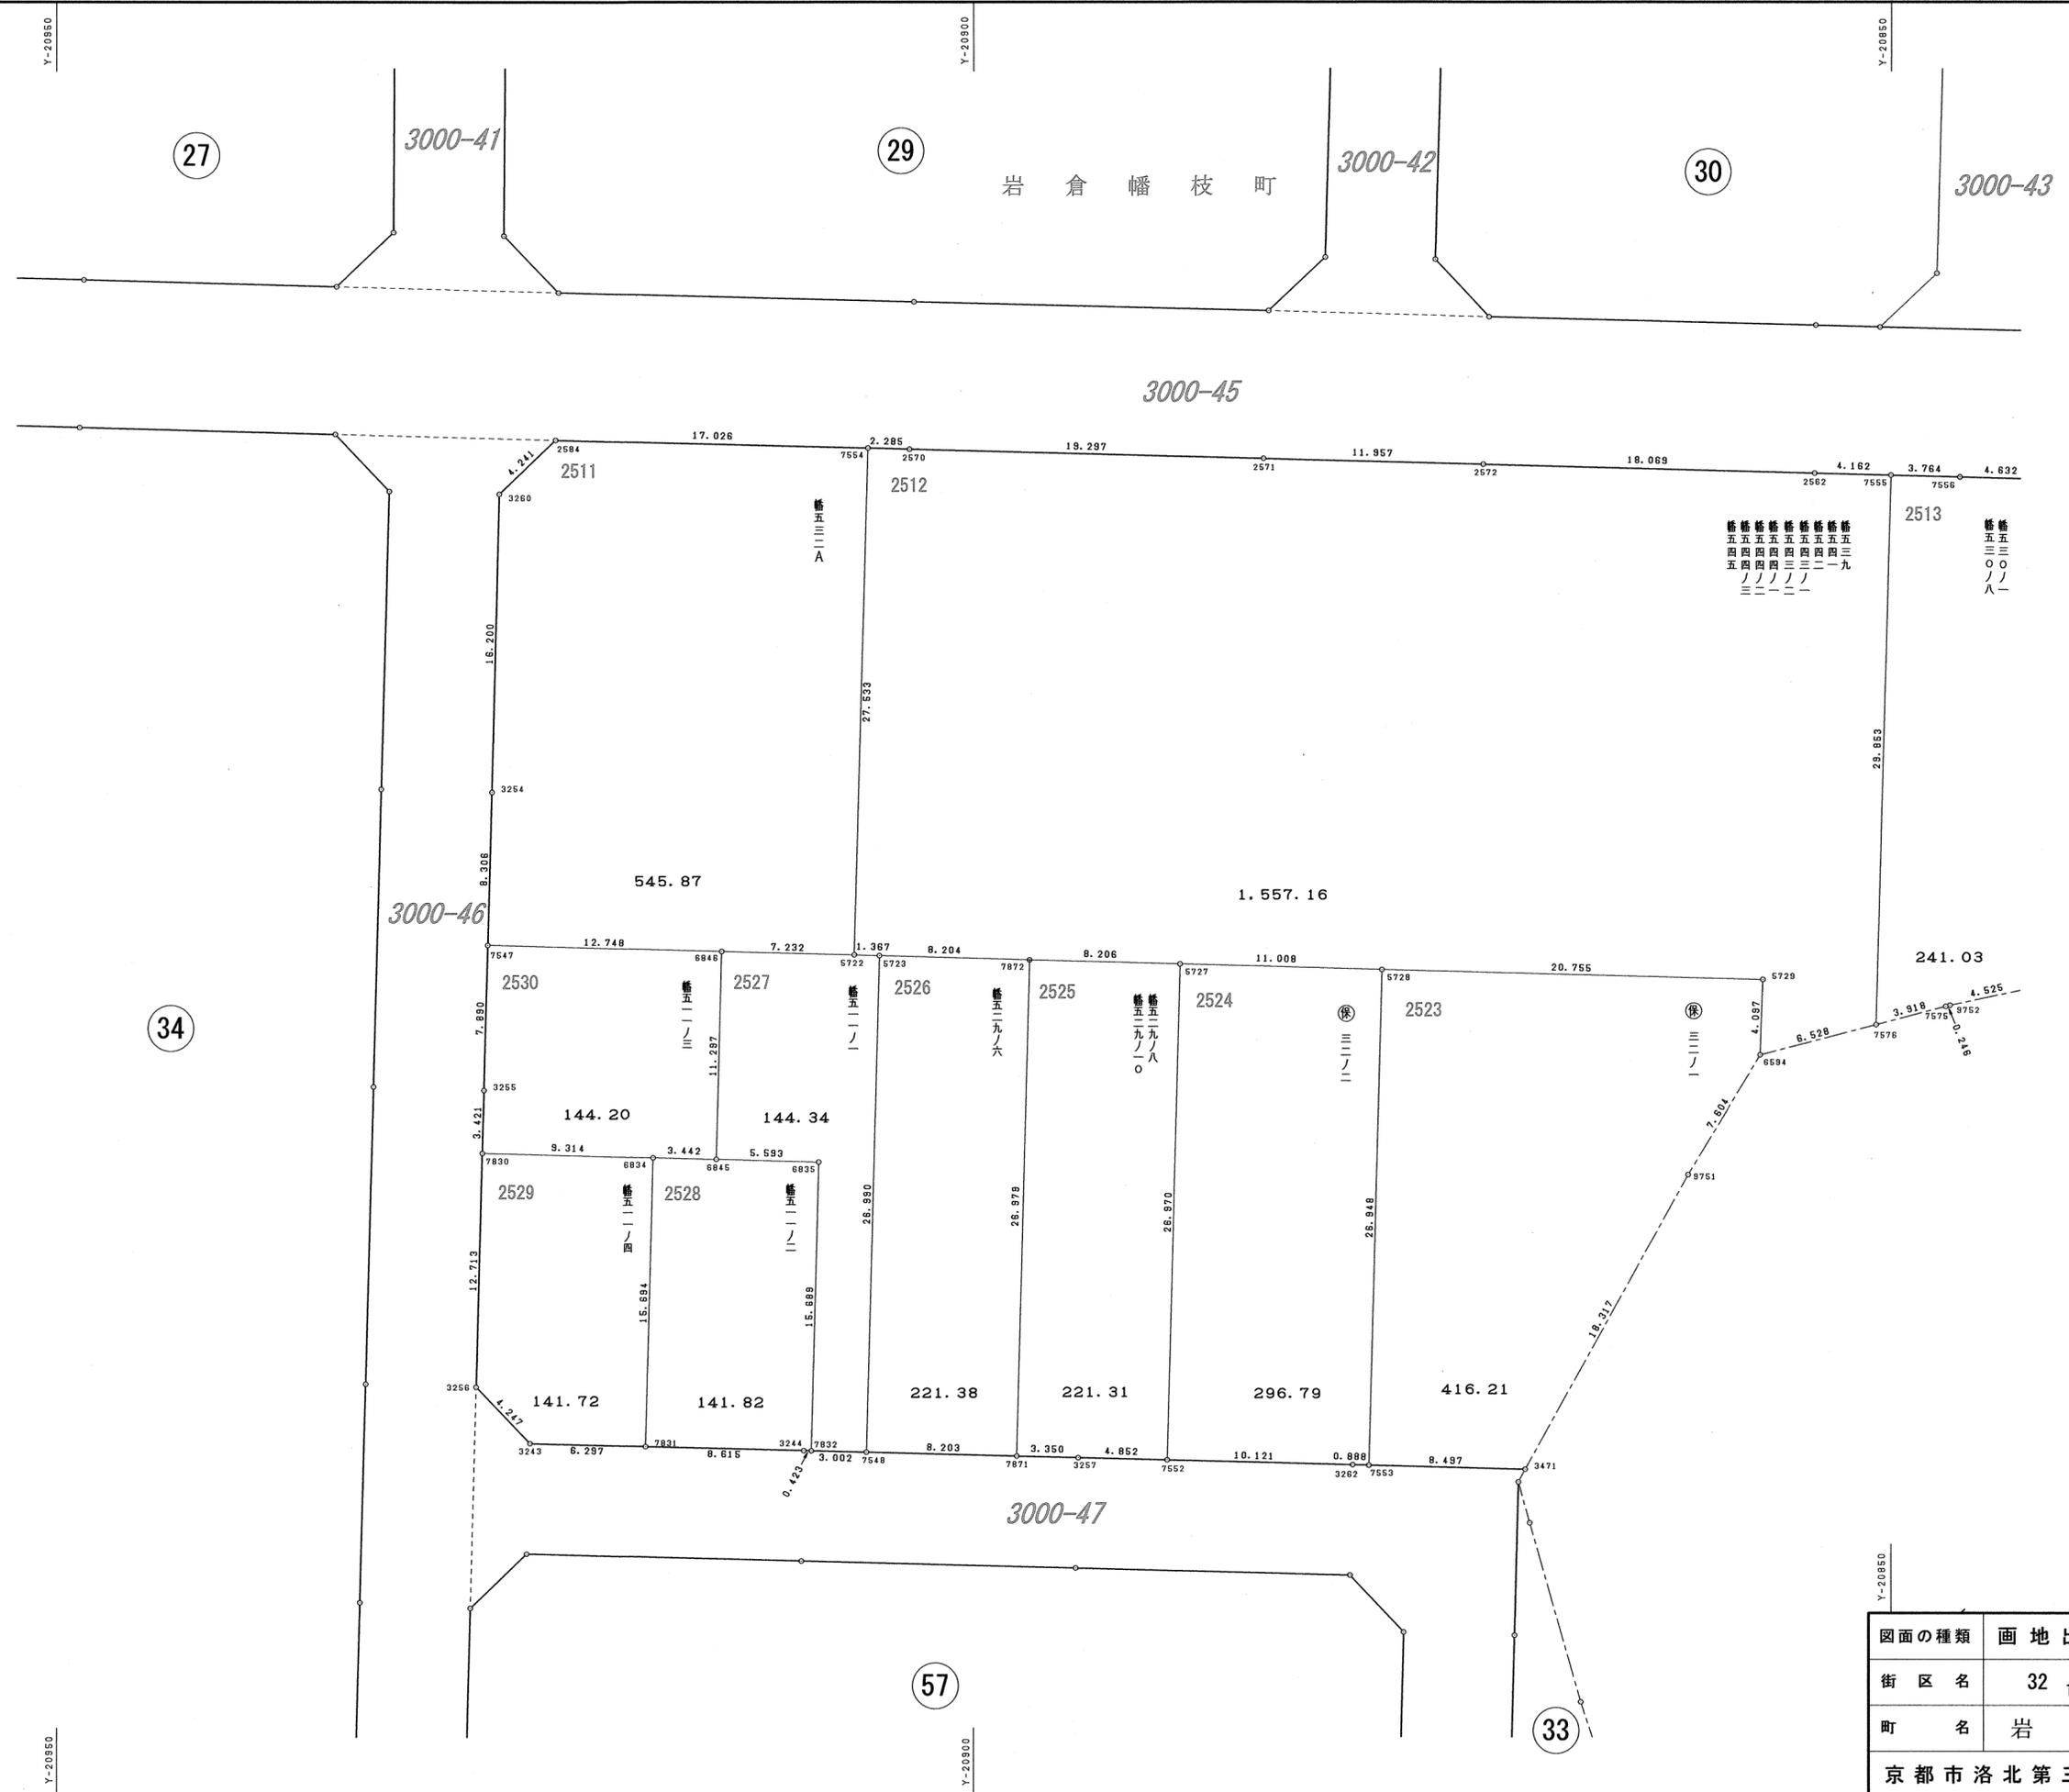

橋五三〇〇ノ八  
 橋五三〇〇ノ九  
 橋五三〇〇ノ一〇  
 橋五三〇〇ノ一一  
 橋五三〇〇ノ一二  
 橋五三〇〇ノ一三  
 橋五三〇〇ノ一四  
 橋五三〇〇ノ一五  
 橋五三〇〇ノ一六  
 橋五三〇〇ノ一七  
 橋五三〇〇ノ一八  
 橋五三〇〇ノ一九  
 橋五三〇〇ノ二〇  
 橋五三〇〇ノ二一  
 橋五三〇〇ノ二二  
 橋五三〇〇ノ二三  
 橋五三〇〇ノ二四  
 橋五三〇〇ノ二五  
 橋五三〇〇ノ二六  
 橋五三〇〇ノ二七  
 橋五三〇〇ノ二八  
 橋五三〇〇ノ二九  
 橋五三〇〇ノ三〇

図面の種類	画地出来形確認測量図		
街区名	32 1/2	縮尺	1/250
町名	岩倉幡枝町		
京都市洛北第三土地区画整理組合			

岩倉幡枝町

30

29

3000-42


3000-43

3000-45

3000-47

57

33

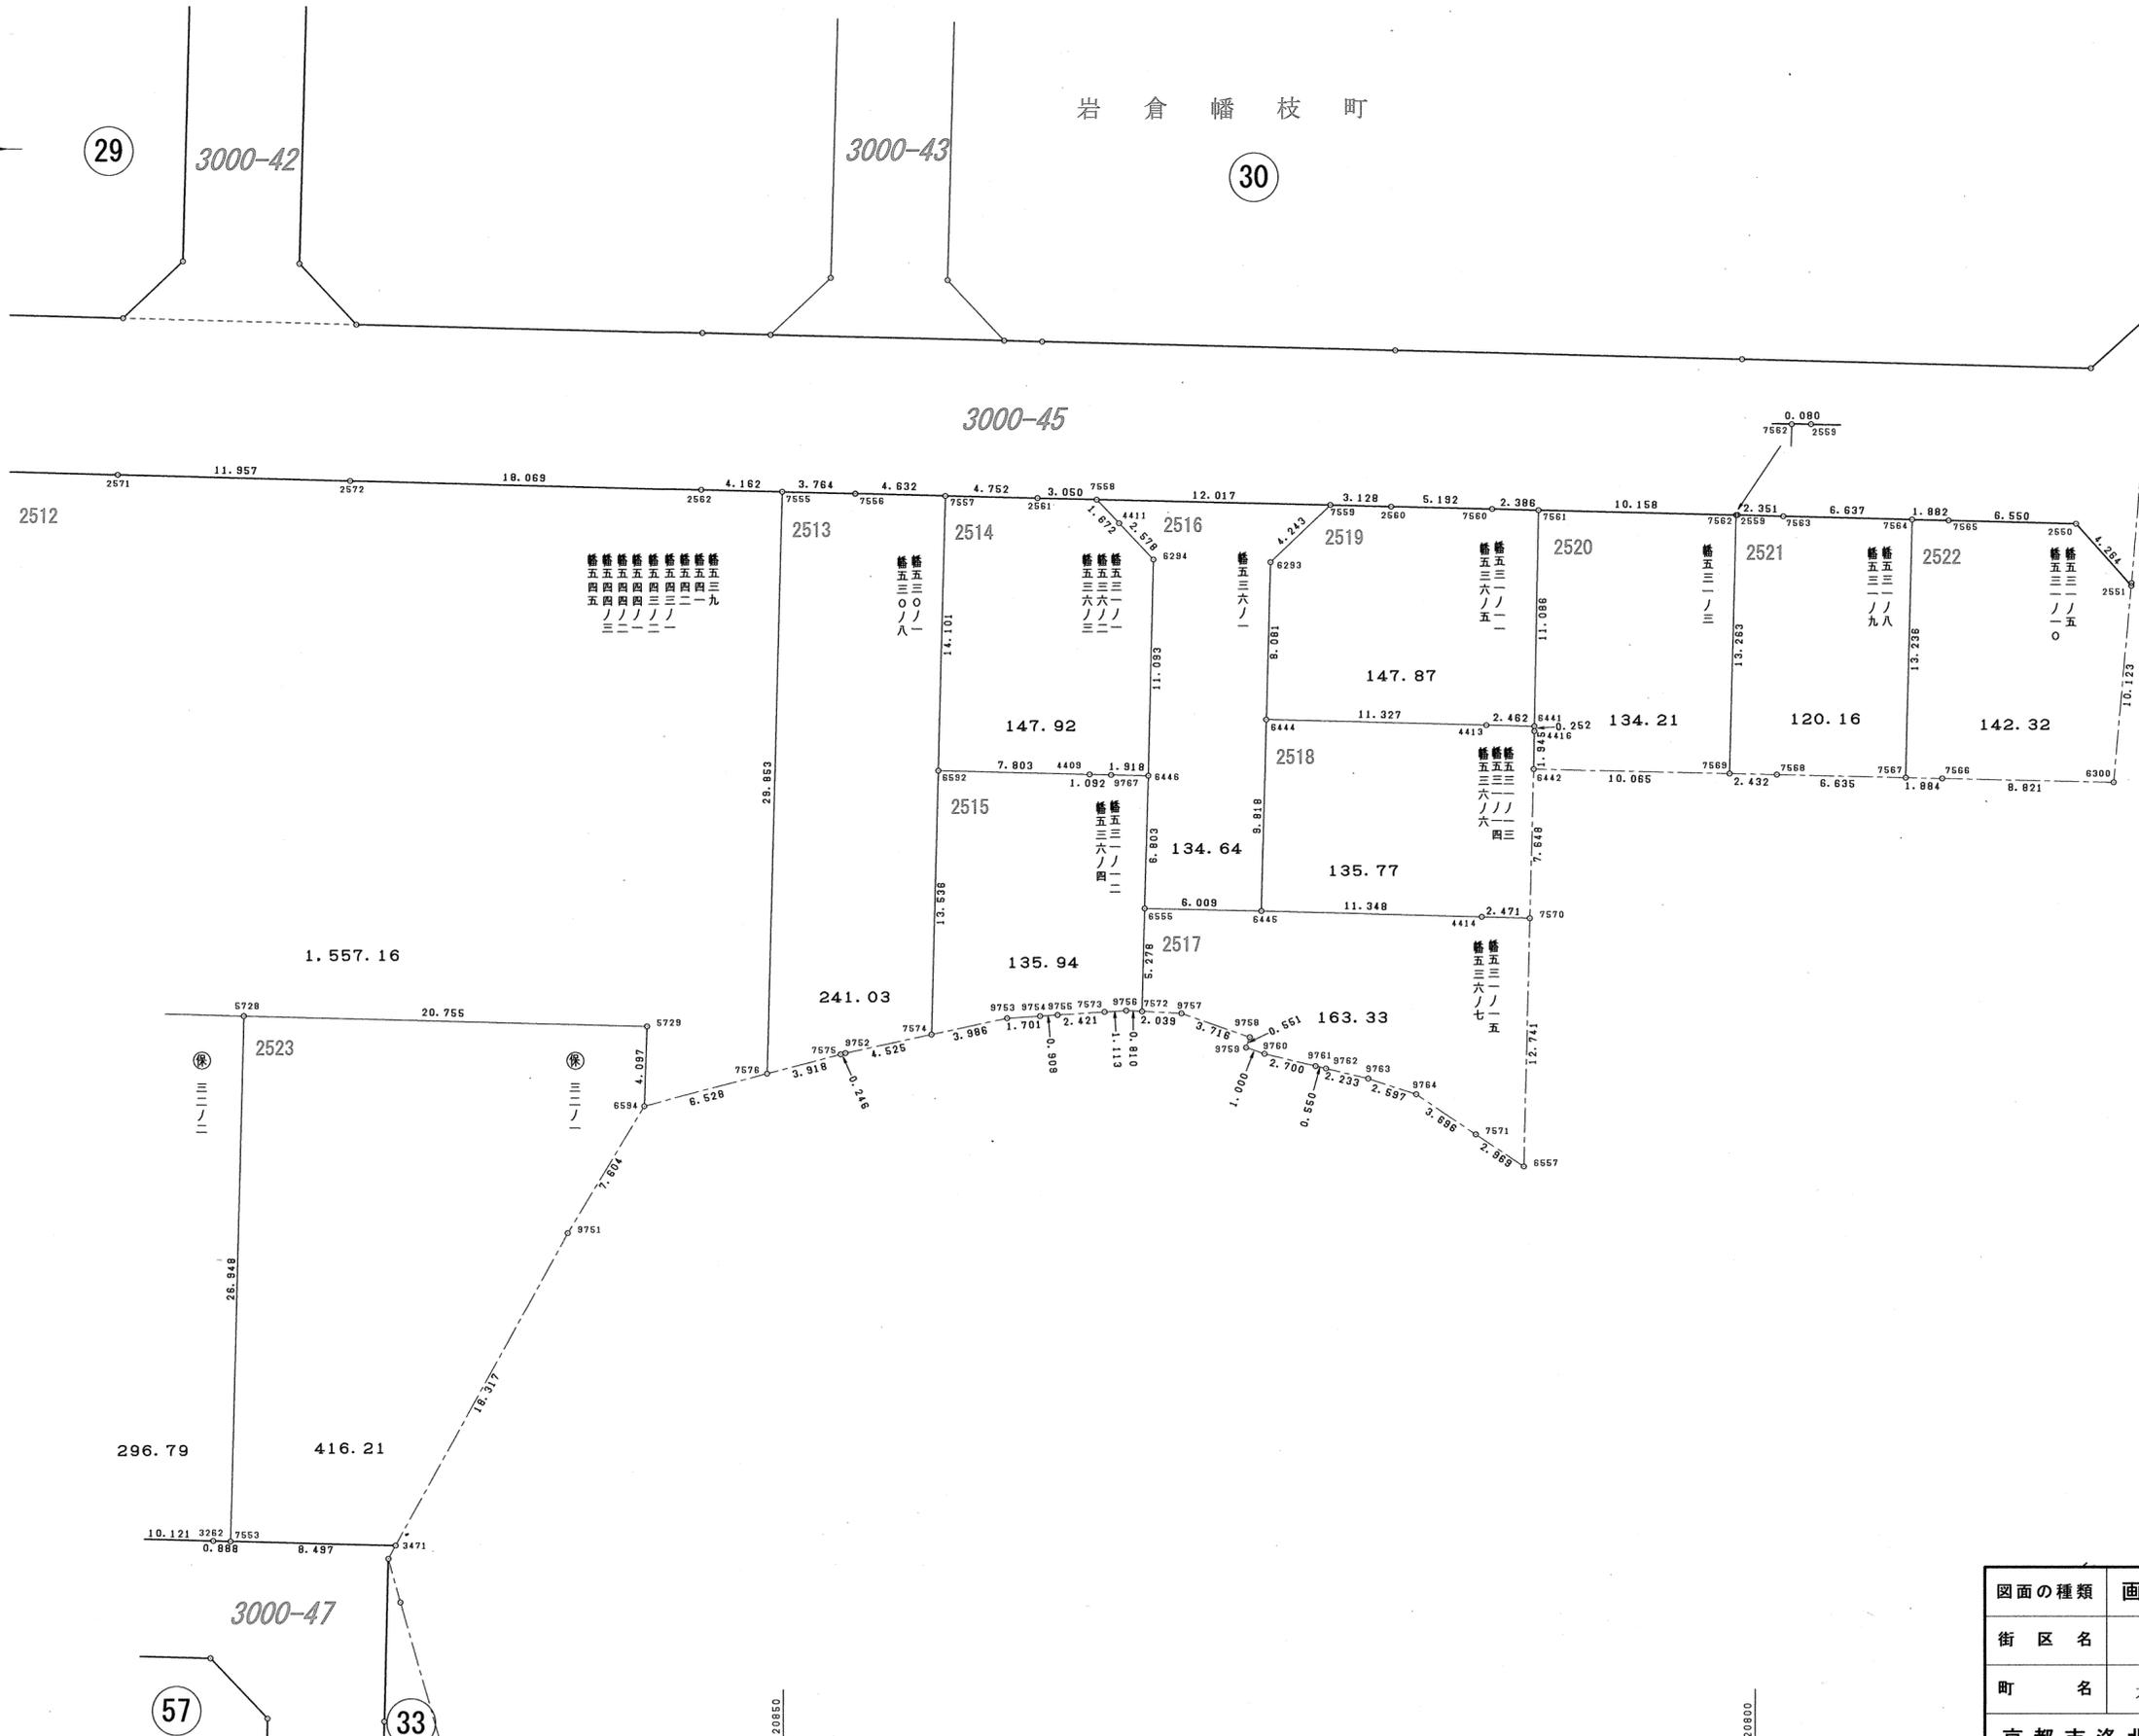

図面の種類	画地出来形確認測量図		
街区名	32 2/2	縮尺	1/250
町名	岩倉幡枝町		
京都市洛北第三土地区画整理組合			

## 2511

地番 幡五三二A			
N O	X	Y	辺長
2584	-103546.753	-20922.785	
3260	-103549.678	-20925.856	4.241
3254	-103565.874	-20926.249	16.200
7547	-103574.177	-20926.474	8.306
6846	-103574.525	-20913.730	12.748
5722	-103574.710	-20906.500	7.232
7554	-103547.186	-20905.764	27.533
2584	-103546.753	-20922.785	17.026
面積	545.8720315		
地積	545.87 m <sup>2</sup>		

## 2512

地番 幡五三九 幡五四一 幡五四二 幡五四三ノ一 幡五四三ノ二 幡五四四ノ一 幡五四四ノ二 幡五四四ノ三 幡五四五			
N O	X	Y	辺長
7554	-103547.186	-20905.764	
5722	-103574.710	-20906.500	27.533
5723	-103574.751	-20905.133	1.367
5724	-103574.833	-20902.107	3.027
5725	-103574.916	-20899.077	3.031
5726	-103575.000	-20896.045	3.033
5727	-103575.188	-20888.729	7.318
5728	-103575.507	-20877.725	11.008
5729	-103576.044	-20856.976	20.755
6594	-103580.139	-20857.119	4.097
7576	-103578.493	-20850.801	6.528
7555	-103548.650	-20850.010	29.853
2562	-103548.542	-20854.171	4.162
2572	-103548.066	-20872.234	18.069
2571	-103547.759	-20884.188	11.957
2570	-103547.244	-20903.479	19.297
7554	-103547.186	-20905.764	2.285
面積	1557.1605075		
地積	1557.16 m <sup>2</sup>		

## 2513

地番 幡五三〇ノ一 幡五三〇ノ八			
N O	X	Y	辺長
7555	-103548.650	-20850.010	
7576	-103578.493	-20850.801	29.853
7575	-103577.504	-20847.009	3.918
9752	-103577.442	-20846.770	0.246
7574	-103576.497	-20842.344	4.525
6592	-103562.965	-20841.986	13.536
7557	-103548.868	-20841.616	14.101
7556	-103548.748	-20846.247	4.632
7555	-103548.650	-20850.010	3.764
面積	241.0369275		
地積	241.03 m <sup>2</sup>		

## 2514

地番 幡五三ノ一 幡五三六ノ二 幡五三六ノ三			
N O	X	Y	辺長
7557	-103548.868	-20841.616	
6592	-103562.965	-20841.986	14.101
4409	-103563.167	-20834.185	7.803
9767	-103563.195	-20833.093	1.092
6446	-103563.245	-20831.175	1.918
6294	-103552.155	-20830.892	11.093
4411	-103550.283	-20832.665	2.578
7558	-103549.068	-20833.815	1.672
2561	-103548.991	-20836.865	3.050
7557	-103548.868	-20841.616	4.752
面積	147.9253315		
地積	147.92 m <sup>2</sup>		

## 2515

地番 幡五三ノ一ノ二 幡五三六ノ四			
N O	X	Y	辺長
7572	-103575.323	-20831.502	
6555	-103570.046	-20831.363	5.278
6446	-103563.245	-20831.175	6.803
9767	-103563.195	-20833.093	1.918
4409	-103563.167	-20834.185	1.092
6592	-103562.965	-20841.986	7.803
7574	-103576.497	-20842.344	13.536
9753	-103575.664	-20838.445	3.986
9754	-103575.558	-20836.747	1.701
9755	-103575.501	-20835.839	0.909
7573	-103575.350	-20833.422	2.421
9756	-103575.281	-20832.311	1.113
7572	-103575.323	-20831.502	0.810
面積	135.9457290		
地積	135.94 m <sup>2</sup>		

## 2516

地番 幡五三六ノ一			
N O	X	Y	辺長
7558	-103549.068	-20833.815	
4411	-103550.283	-20832.665	1.672
6294	-103552.155	-20830.892	2.578
6446	-103563.245	-20831.175	11.093
6555	-103570.046	-20831.363	6.803
6445	-103570.189	-20825.355	6.009
6444	-103560.374	-20825.094	9.818
6293	-103552.295	-20824.877	8.081
7559	-103549.372	-20821.801	4.243
7558	-103549.068	-20833.815	12.017
面積	134.6434220		
地積	134.64 m <sup>2</sup>		

## 2517

地番 幡五三ノ一ノ五 幡五三六ノ七			
N O	X	Y	辺長
7570	-103570.569	-20811.540	
4414	-103570.501	-20814.011	2.471
6445	-103570.189	-20825.355	11.348
6555	-103570.046	-20831.363	6.009
7572	-103575.323	-20831.502	5.278
9757	-103575.427	-20829.465	2.039
9758	-103576.660	-20825.959	3.716
9759	-103577.181	-20826.141	0.551
9760	-103577.513	-20825.197	1.000
9761	-103578.145	-20822.571	2.700
9762	-103578.274	-20822.036	0.550
9763	-103578.797	-20819.865	2.233
9764	-103579.600	-20817.395	2.597
7571	-103581.656	-20814.323	3.696
6557	-103583.307	-20811.855	2.969
7570	-103570.569	-20811.540	12.741
面積	163.3396025		
地積	163.33 m <sup>2</sup>		

## 2518

地番 幡五三ノ一ノ三 幡五三ノ一ノ四 幡五三六ノ六			
N O	X	Y	辺長
6441	-103560.726	-20811.308	
4413	-103560.663	-20813.770	2.462
6444	-103560.374	-20825.094	11.327
6445	-103570.189	-20825.355	9.818
4414	-103570.501	-20814.011	11.348
7570	-103570.569	-20811.540	2.471
6442	-103562.923	-20811.351	7.648
4416	-103560.978	-20811.313	1.945
6441	-103560.726	-20811.308	0.252
面積	135.7792135		
地積	135.77 m <sup>2</sup>		

## 2519

地番 幡五三ノ一ノ一 幡五三六ノ五			
N O	X	Y	辺長
7559	-103549.372	-20821.801	
6293	-103552.295	-20824.877	4.243
6444	-103560.374	-20825.094	8.081
4413	-103560.663	-20813.770	11.327
6441	-103560.726	-20811.308	2.462
7561	-103549.642	-20811.096	11.086
7560	-103549.582	-20813.482	2.386
2560	-103549.451	-20818.673	5.192
7559	-103549.372	-20821.801	3.128
面積	147.8783730		
地積	147.87 m <sup>2</sup>		

## 2520

地番 幡五三ノ一ノ三			
N O	X	Y	辺長
7561	-103549.642	-20811.096	
6441	-103560.726	-20811.308	11.086
4416	-103560.978	-20811.313	0.252
6442	-103562.923	-20811.351	1.945
7569	-103563.156	-20801.288	10.065
7562	-103549.897	-20800.941	13.263
7561	-103549.642	-20811.096	10.158
面積	134.2145245		
地積	134.21 m <sup>2</sup>		

## 2521

地番 幡五三ノ一ノ八 幡五三ノ一ノ九			
N O	X	Y	辺長
7562	-103549.897	-20800.941	
7569	-103563.156	-20801.288	13.263
7568	-103563.212	-20798.856	2.432
7567	-103563.366	-20792.222	6.635
7564	-103550.134	-20791.875	13.236
7563	-103549.960	-20798.510	6.637
2559	-103549.899	-20800.861	2.351
7562	-103549.897	-20800.941	0.080
面積	120.1623290		
地積	120.16 m <sup>2</sup>		

## 2522

地番 幡五三ノ一ノ五 幡五三ノ一ノ〇			
N O	X	Y	辺長
7564	-103550.134	-20791.875	
7567	-103563.366	-20792.222	13.236
7566	-103563.410	-20790.338	1.884
6300	-103563.614	-20781.519	8.821
2551	-103553.532	-20780.602	10.123
2550	-103550.354	-20783.445	4.264
7565	-103550.183	-20789.993	6.550
7564	-103550.134	-20791.875	1.882
面積	142.3241270		
地積	142.32 m <sup>2</sup>		

## 2523

地番 保三二ノ一			
N O	X	Y	辺長
7553	-103602.446	-20878.430	
3471	-103602.667	-20869.935	8.497
9751	-103586.648	-20861.052	18.317
6594	-103580.139	-20857.119	7.604
5729	-103576.044	-20856.976	4.097
5728	-103575.507	-20877.725	20.755
7553	-103602.446	-20878.430	26.948
面積	416.2194780		
地積	416.21 m <sup>2</sup>		

## 2524

地番 保三二ノ二			
N O	X	Y	辺長
7552	-103602.159	-20889.436	
3262	-103602.423	-20879.318	10.121
7553	-103602.446	-20878.430	0.888
5728	-103575.507	-20877.725	26.948
5727	-103575.198	-20888.729	11.008
7552	-103602.159	-20889.436	26.970
面積	296.7959970		
地積	296.79 m <sup>2</sup>		

## 2525

地番 幡五二九ノ八 幡五二九ノ一〇			
N O	X	Y	辺長
7871	-103601.946	-20897.636	
3257	-103602.033	-20894.287	3.350
7552	-103602.159	-20889.436	4.852
5727	-103575.198	-20888.729	26.970
7872	-103574.976	-20896.932	8.206
7871	-103601.946	-20897.636	26.979
面積	221.3110260		
地積	221.31 m <sup>2</sup>		

## 2526


地番 幡五二九ノ六			
N O	X	Y	辺長
7548	-103601.732	-20905.837	
7871	-103601.946	-20897.636	8.203
7872	-103574.976	-20896.932	26.979
5723	-103574.751	-20905.133	8.204
7548	-103601.732	-20905.837	26.990
面積	221.3806035		
地積	221.38 m <sup>2</sup>		

## 2527

地番 幡五一一ノ一			
N O	X	Y	辺長
7548	-103601.732	-20905.837	
5723	-103574.751	-20905.133	26.990
5722	-103574.710	-20906.500	1.367
6846	-103574.525	-20913.730	7.232
6845	-103585.819	-20914.025	11.297
6835	-103585.970	-20908.434	5.593
7832	-103601.654	-20908.838	15.689
7548	-103601.732	-20905.837	3.002
面積	144.3469520		
地積	144.34 m <sup>2</sup>		

## 2528

地番 幡五一一ノ二			
N O	X	Y	辺長
7832	-103601.654	-20908.838	
6835	-103585.970	-20908.434	15.689
6845	-103585.819	-20914.025	5.593
6834	-103585.732	-20917.466	3.442
7831	-103601.421	-20917.874	15.694
3244			

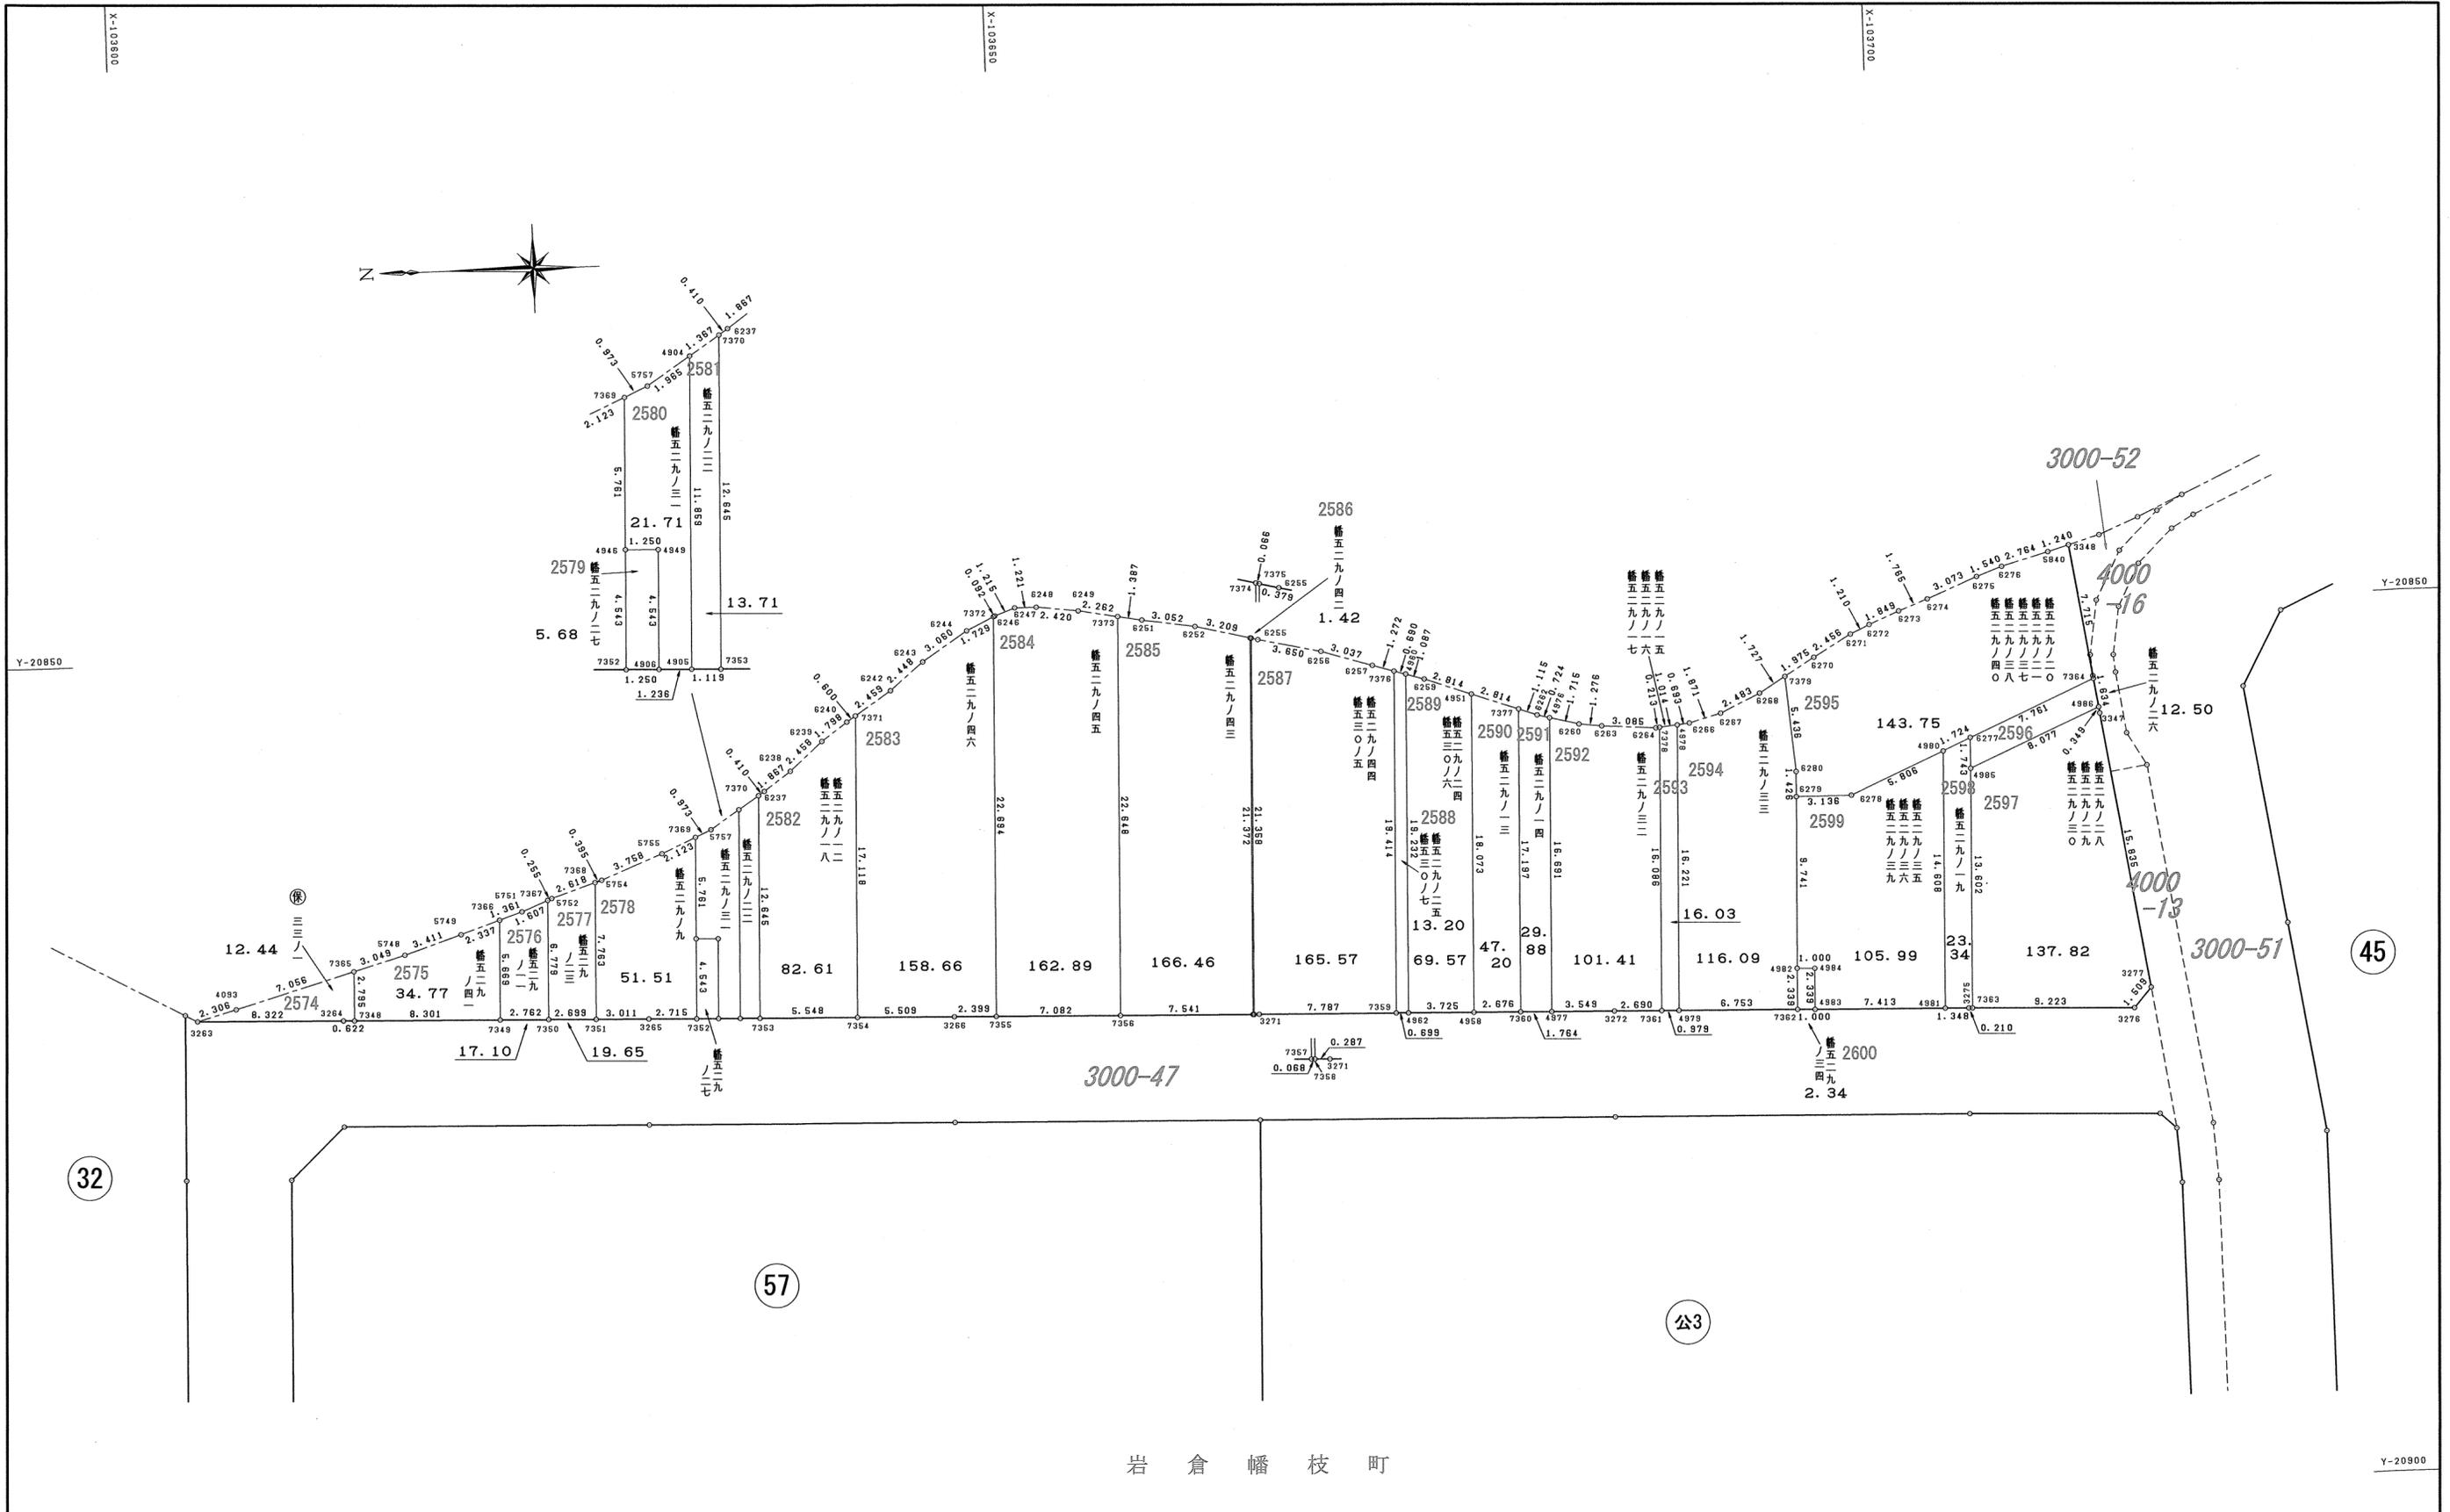

岩倉幡枝町

32

57

公3

45

図面の種類	画地出来形確認測量図		
街区名	33	縮尺	1/250
町名	岩倉幡枝町		
京都市洛北第三土地区画整理組合			

2574			
地番	保三三ノ一		
N O	X	Y	辺長
3263	-103603.350	-20870.308	
3264	-103611.670	-20870.524	8.322
7348	-103612.292	-20870.541	0.622
7365	-103612.356	-20867.746	2.795
4093	-103605.572	-20869.688	7.056
3263	-103603.350	-20870.308	2.306
面積	12.4458350		
地積	12.44 m <sup>2</sup>		

2575			
地番	幡五二九ノ四一		
N O	X	Y	辺長
7348	-103612.292	-20870.541	
7349	-103620.591	-20870.761	8.301
7366	-103620.743	-20865.094	5.669
5749	-103618.528	-20865.840	2.337
5748	-103615.288	-20866.907	3.411
7365	-103612.356	-20867.746	3.049
7348	-103612.292	-20870.541	2.795
面積	34.7716020		
地積	34.77 m <sup>2</sup>		

2576			
地番	幡五二九ノ一一		
N O	X	Y	辺長
7349	-103620.591	-20870.761	
7350	-103623.353	-20870.834	2.762
7367	-103623.524	-20864.057	6.779
5751	-103622.033	-20864.659	1.607
7366	-103620.743	-20865.094	1.361
7349	-103620.591	-20870.761	5.669
面積	17.1024325		
地積	17.10 m <sup>2</sup>		

2577			
地番	幡五二九ノ二三		
N O	X	Y	辺長
7350	-103623.353	-20870.834	
7351	-103626.052	-20870.906	2.699
7368	-103626.249	-20863.145	7.763
5752	-103623.761	-20863.961	2.618
7367	-103623.524	-20864.057	0.255
7350	-103623.353	-20870.834	6.779
面積	19.6589760		
地積	19.65 m <sup>2</sup>		

2578			
地番	幡五二九ノ九		
N O	X	Y	辺長
7351	-103626.052	-20870.906	
3265	-103629.062	-20870.986	3.011
7352	-103631.776	-20871.060	2.715
7369	-103632.053	-20860.759	10.304
5755	-103630.117	-20861.631	2.123
5754	-103626.625	-20863.022	3.758
7368	-103626.249	-20863.145	0.395
7351	-103626.052	-20870.906	7.763
面積	51.5197360		
地積	51.51 m <sup>2</sup>		

2579			
地番	幡五二九ノ二七		
N O	X	Y	辺長
7352	-103631.776	-20871.060	
4906	-103633.026	-20871.094	1.250
4949	-103633.148	-20866.552	4.543
4946	-103631.898	-20866.518	1.250
7352	-103631.776	-20871.060	4.543
面積	5.6816480		
地積	5.68 m <sup>2</sup>		

2580			
地番	幡五二九ノ三一		
N O	X	Y	辺長
4904	-103634.579	-20859.273	
5757	-103632.941	-20860.359	1.965
7369	-103632.053	-20860.759	0.973
4946	-103631.898	-20866.518	5.761
4949	-103633.148	-20866.552	1.250
4906	-103633.026	-20871.094	4.543
4905	-103634.262	-20871.128	1.236
4904	-103634.579	-20859.273	11.859
面積	21.7151310		
地積	21.71 m <sup>2</sup>		

2581			
地番	幡五二九ノ二二		
N O	X	Y	辺長
7370	-103635.719	-20858.517	
4904	-103634.579	-20859.273	1.367
4905	-103634.262	-20871.128	11.859
7353	-103635.381	-20871.158	1.119
7370	-103635.719	-20858.517	12.645
面積	13.7152335		
地積	13.71 m <sup>2</sup>		

2582			
地番	幡五二九ノ一八 幡五二九ノ一八		
N O	X	Y	辺長
7353	-103635.381	-20871.158	
7354	-103640.927	-20871.308	5.548
7371	-103641.387	-20854.196	17.118
6240	-103640.888	-20854.530	0.600
6239	-103639.428	-20855.581	1.798
6238	-103637.575	-20857.197	2.458
6237	-103636.061	-20858.290	1.867
7370	-103635.719	-20858.517	0.410
7353	-103635.381	-20871.158	12.645
面積	82.6144230		
地積	82.61 m <sup>2</sup>		

2583			
地番	幡五二九ノ四六		
N O	X	Y	辺長
7354	-103640.927	-20871.308	
3266	-103646.434	-20871.458	5.509
7355	-103648.833	-20871.522	2.399
7372	-103649.432	-20848.835	22.694
6244	-103647.870	-20849.578	1.729
6243	-103645.316	-20851.265	3.060
6242	-103643.431	-20852.828	2.448
7371	-103641.387	-20854.196	2.459
7354	-103640.927	-20871.308	17.118
面積	158.6684480		
地積	158.66 m <sup>2</sup>		

2584			
地番	幡五二九ノ四五		
N O	X	Y	辺長
7355	-103648.833	-20871.522	
7356	-103655.913	-20871.712	7.082
7373	-103656.509	-20849.071	22.648
6249	-103654.282	-20848.671	2.262
6248	-103651.879	-20848.380	2.420
6247	-103650.658	-20848.381	1.221
6246	-103649.515	-20848.795	1.215
7372	-103649.432	-20848.835	0.092
7355	-103648.833	-20871.522	22.694
面積	162.8919595		
地積	162.89 m <sup>2</sup>		

2585			
地番	幡五二九ノ四三		
N O	X	Y	辺長
7356	-103655.913	-20871.712	
7357	-103663.452	-20871.913	7.541
7374	-103664.009	-20850.548	21.372
6252	-103660.893	-20849.777	3.209
6251	-103657.875	-20849.317	3.052
7373	-103656.509	-20849.071	1.387
7356	-103655.913	-20871.712	22.648
面積	166.4682920		
地積	166.46 m <sup>2</sup>		

2586			
地番	幡五二九ノ四二		
N O	X	Y	辺長
7357	-103663.452	-20871.913	
7358	-103663.520	-20871.915	0.068
7375	-103664.074	-20850.564	21.358
7374	-103664.009	-20850.548	0.066
7357	-103663.452	-20871.913	21.372
面積	1.4253065		
地積	1.42 m <sup>2</sup>		

2587			
地番	幡五二九ノ四四 幡五三〇ノ五		
N O	X	Y	辺長
7358	-103663.520	-20871.915	
3271	-103663.807	-20871.923	0.287
7359	-103671.592	-20872.116	7.787
7376	-103672.126	-20852.709	19.414
6257	-103670.907	-20852.345	1.272
6256	-103668.006	-20851.443	3.037
6255	-103664.442	-20850.655	3.650
7375	-103664.074	-20850.564	0.379
7358	-103663.520	-20871.915	21.358
面積	165.5763135		
地積	165.57 m <sup>2</sup>		

2588			
地番	幡五二九ノ二五 幡五三〇ノ七		
N O	X	Y	辺長
4960	-103672.788	-20852.907	
7376	-103672.126	-20852.709	0.690
7359	-103671.592	-20872.116	19.414
4962	-103672.291	-20872.133	0.699
4960	-103672.788	-20852.907	19.232
面積	13.2002945		
地積	13.20 m <sup>2</sup>		

2589			
地番	幡五二九ノ二四 幡五三〇ノ六		
N O	X	Y	辺長
4951	-103676.483	-20854.159	
6259	-103673.830	-20853.218	2.814
4960	-103672.788	-20852.907	1.087
4962	-103672.291	-20872.133	19.232
4958	-103676.015	-20872.226	3.725
4951	-103676.483	-20854.159	18.073
面積	69.5713925		
地積	69.57 m <sup>2</sup>		

2590			
地番	幡五二九ノ一三		
N O	X	Y	辺長
7377	-103679.136	-20855.100	
4951	-103676.483	-20854.159	2.814
4958	-103676.015	-20872.226	18.073
7360	-103678.691	-20872.292	2.676
7377	-103679.136	-20855.100	17.197
面積	47.2036505		
地積	47.20 m <sup>2</sup>		

2591			
地番	幡五二九ノ一四		
N O	X	Y	辺長
4976	-103680.890	-20855.650	
6262	-103680.187	-20855.473	0.724
7377	-103679.136	-20855.100	1.115
7360	-103678.691	-20872.292	17.197
4977	-103680.455	-20872.336	1.764
4976	-103680.890	-20855.650	16.691
面積	29.8882850		
地積	29.88 m <sup>2</sup>		

2592			
地番	幡五二九ノ三二		
N O	X	Y	辺長
7378	-103687.112	-20856.409	
6264	-103686.900	-20856.432	0.213
6263	-103683.822	-20856.218	3.085
6260	-103682.554	-20856.069	1.276
4976	-103680.890	-20855.650	1.715
4977	-103680.455	-20872.336	16.691
3272	-103684.003	-20872.424	3.549
7361	-103686.693	-20872.490	2.690
7378	-103687.112	-20856.409	16.086
面積	101.4112935		
地積	101.41 m <sup>2</sup>		

2593			
地番	幡五二九ノ一五 幡五二九ノ一六 幡五二九ノ一七		
N O	X	Y	辺長
4978	-103688.121	-20856.299	
7378	-103687.112	-20856.409	1.014
7361	-103686.693	-20872.490	16.086
4979	-103687.672	-20872.514	0.979
4978	-103688.121	-20856.299	16.221
面積	16.0324500		
地積	16.03 m <sup>2</sup>		

2594			
地番	幡五二九ノ三三		
N O	X	Y	辺長
6280	-103694.799	-20859.177	
7379	-103694.333	-20853.761	5.436
6268	-103692.860	-20854.663	1.727
6267	-103690.613	-20855.720	2.483
6266	-103688.810	-20856.223	1.871
4978	-103688.121	-20856.299	0.693
4979	-103687.672	-20872.514	16.221
7362	-103694.423	-20872.680	6.753
4982	-103694.488	-20870.341	2.339
6279	-103694.757	-20860.603	9.741
6280	-103694.799	-20859.177	1.426
面積	116.0947850		
地積	116.09 m <sup>2</sup>		

2595			
地番	幡五二九ノ二〇 幡五二九ノ二一 幡五二九ノ三七 幡五二九ノ三八 幡五二九ノ四〇		
N O	X	Y	辺長
6279	-103694.757	-20860.603	
6278	-103697.893	-20860.628	3.136
4980	-103703.205	-20858.282	5.806
6277	-103704.782	-20857.585	1.724
7364	-103711.891	-20854.469	7.761
3348	-103710.732	-20846.841	7.715
5840	-103709.543	-20847.193	1.240
6276	-103706.881	-20847.938	2.764
6275	-103705.434	-20848.466	1.540
6274	-103702.593	-20849.639	3.073
6273	-103700.944	-20850.270	1.765
6272	-103699.236	-20850.980	1.849
6271	-103698.136	-20851.486	1.210
6270	-103696.017	-20852.729	2.456
7379	-103694.333	-20853.761	1.975
6280	-103694.799	-20859.177	5.436
6279	-103694.757	-20860.603	1.4

2597

地番	幡五二九ノ二八 幡五二九ノ二九 幡五二九ノ三〇		
N O	X	Y	辺長
4985	-103704.738	-20859.328	
7363	-103704.392	-20872.926	13.602
3276	-103713.611	-20873.219	9.223
3277	-103714.602	-20872.081	1.509
3347	-103712.189	-20856.430	15.835
4986	-103712.136	-20856.085	0.349
4985	-103704.738	-20859.328	8.077
面積	137.8287295		
地積	137.82 m <sup>2</sup>		

2598

地番	幡五二九ノ一九		
N O	X	Y	辺長
7363	-103704.392	-20872.926	
4985	-103704.738	-20859.328	13.602
6277	-103704.782	-20857.585	1.743
4980	-103703.205	-20858.282	1.724
4981	-103702.834	-20872.886	14.608
3275	-103704.182	-20872.919	1.348
7363	-103704.392	-20872.926	0.210
面積	23.3455295		
地積	23.34 m <sup>2</sup>		


2599

地番	幡五二九ノ三五 幡五二九ノ三六 幡五二九ノ三九		
N O	X	Y	辺長
4980	-103703.205	-20858.282	
6278	-103697.893	-20860.628	5.806
6279	-103694.757	-20860.603	3.136
4982	-103694.488	-20870.341	9.741
4984	-103695.488	-20870.365	1.000
4983	-103695.423	-20872.704	2.339
4981	-103702.834	-20872.886	7.413
4980	-103703.205	-20858.282	14.608
面積	105.9915305		
地積	105.99 m <sup>2</sup>		

2600

地番	幡五二九ノ三四		
N O	X	Y	辺長
7362	-103694.423	-20872.680	
4983	-103695.423	-20872.704	1.000
4984	-103695.488	-20870.365	2.339
4982	-103694.488	-20870.341	1.000
7362	-103694.423	-20872.680	2.339
面積	2.3405600		
地積	2.34 m <sup>2</sup>		

図面の種類	画地出来形確認測量図		
街区名	33	2/2	求積表
町名	岩倉幡枝町		
京都市洛北第三土地区画整理組合			

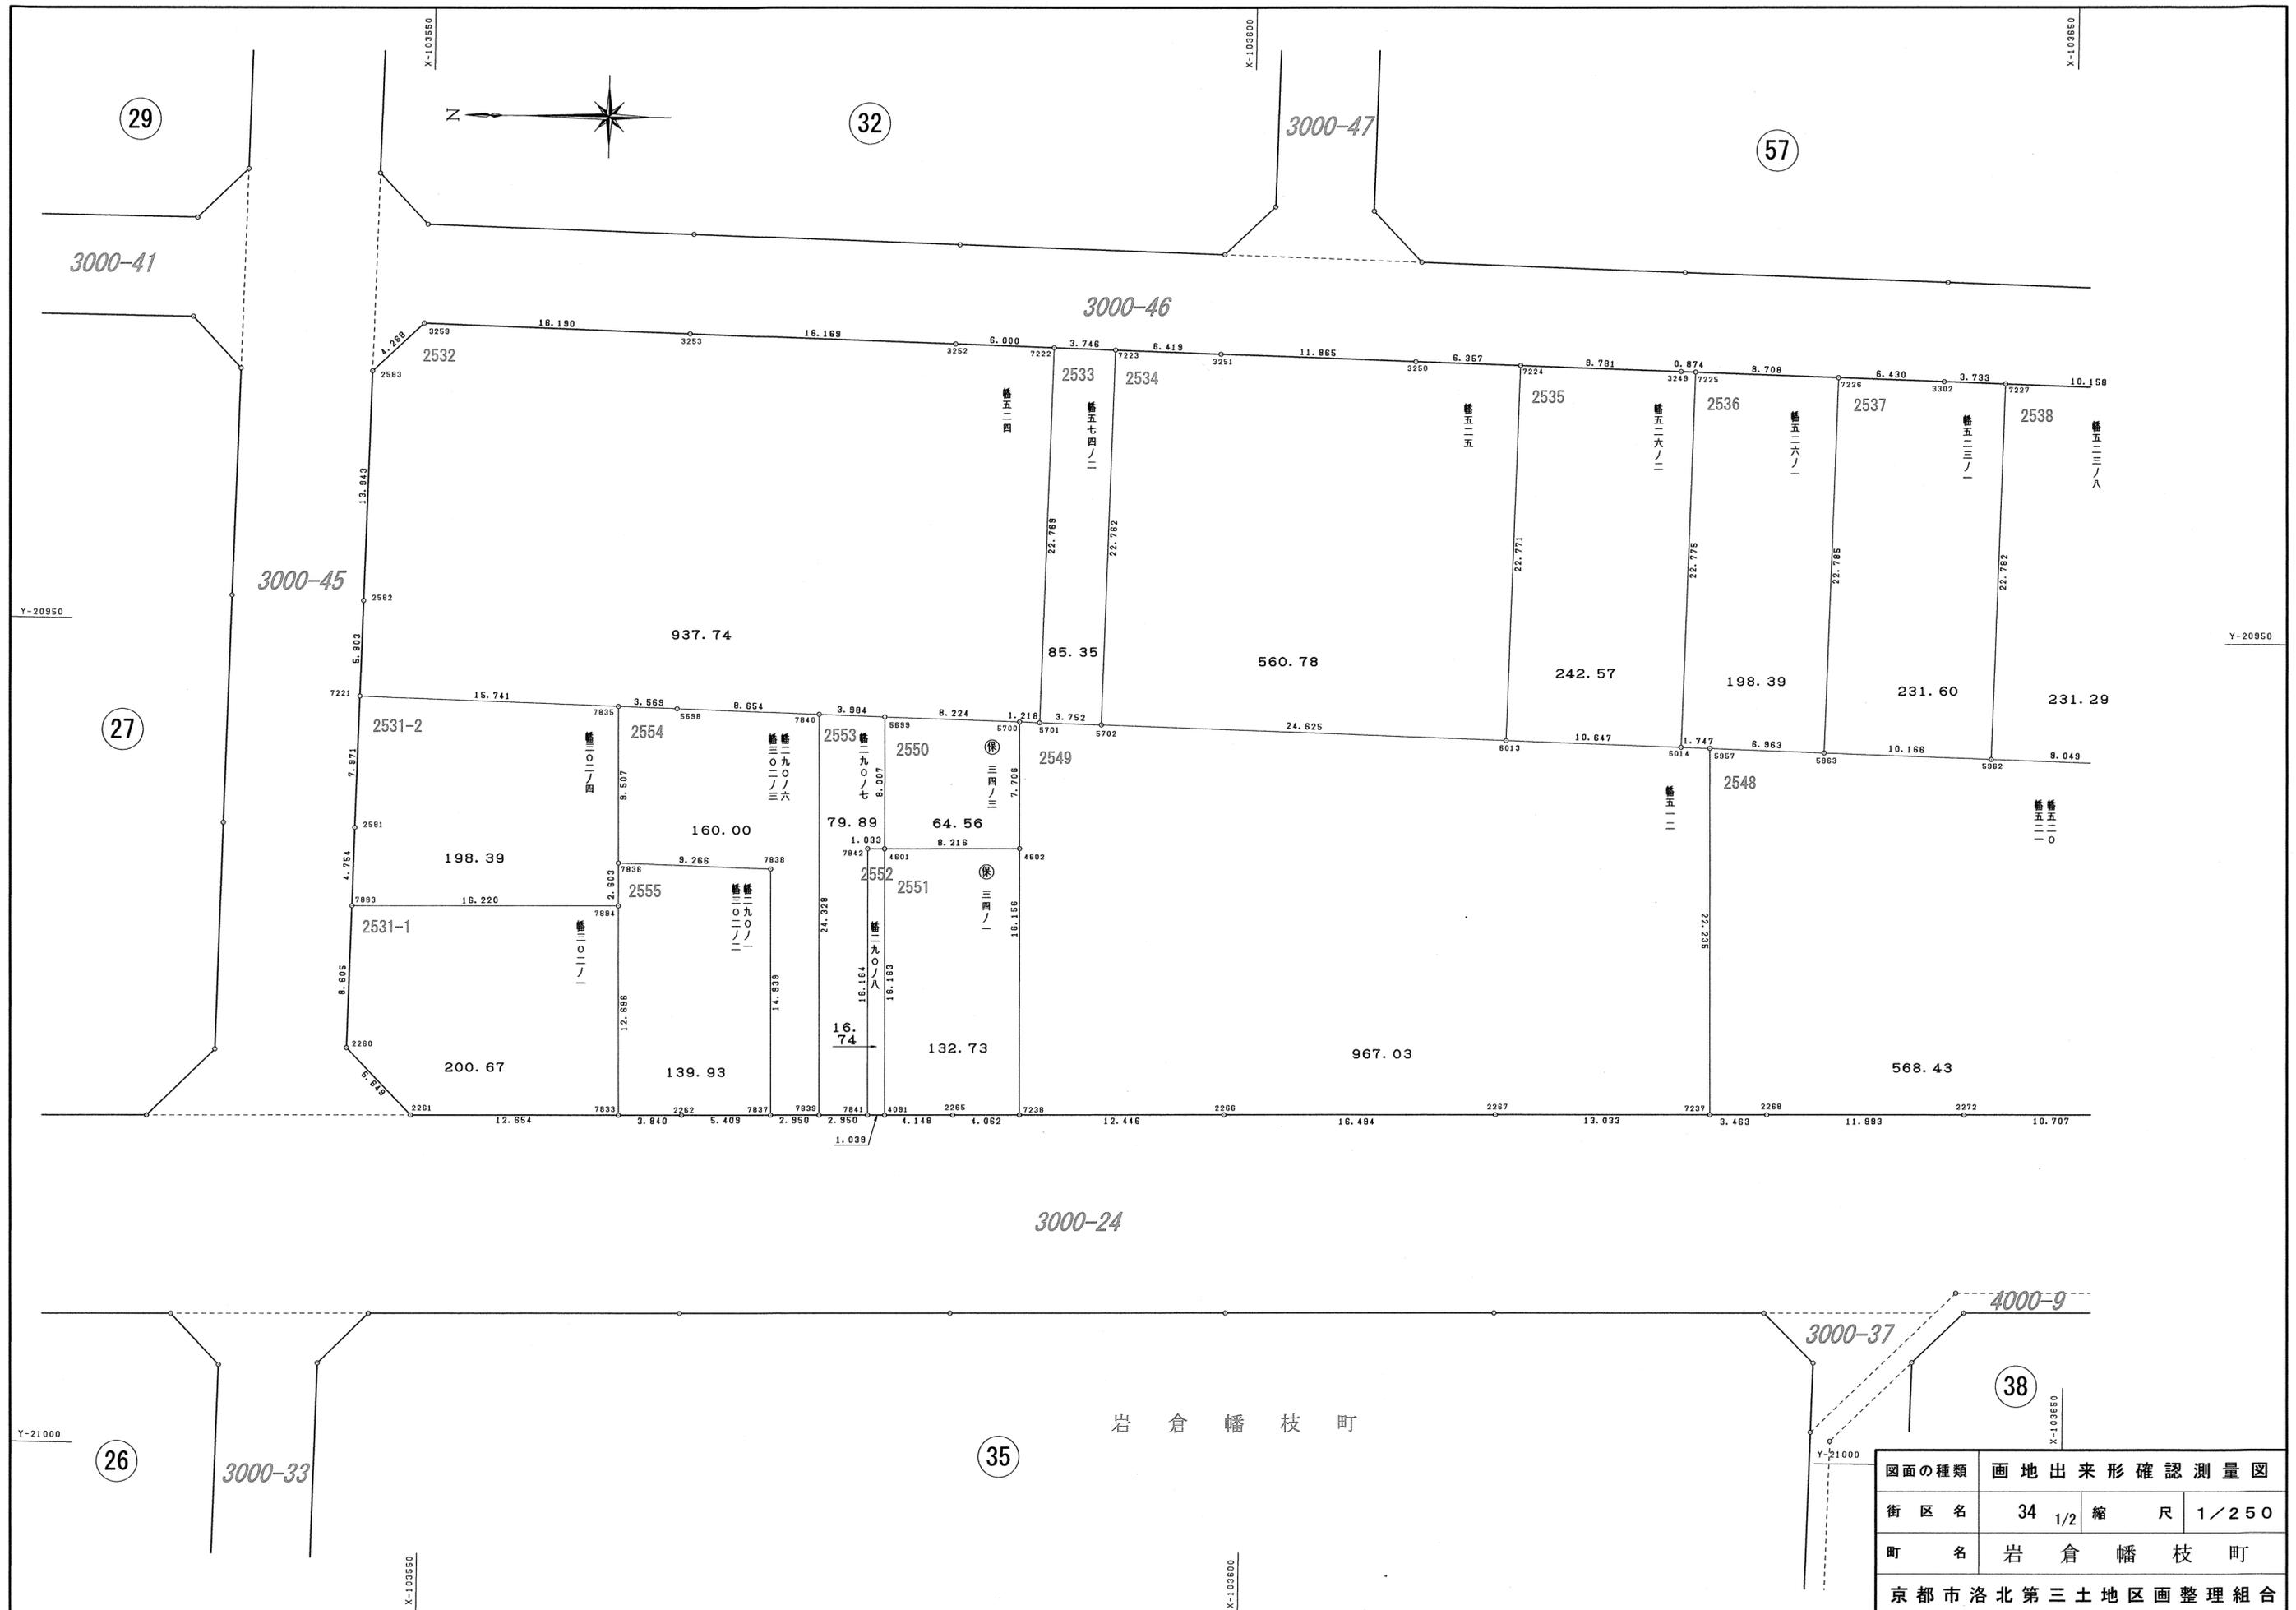

図面の種類	画地出来形確認測量図		
街区名	34	1/2	縮尺 1/250
町名	岩倉幡枝町		
京都市洛北第三土地区画整理組合			



X-103600

X-103650

X-103700

Y-20950

Y-20950

Y-21000

X-103600

X-103650

X-103700

57


岩倉幡枝町

公3

45

3000-46

3000-53

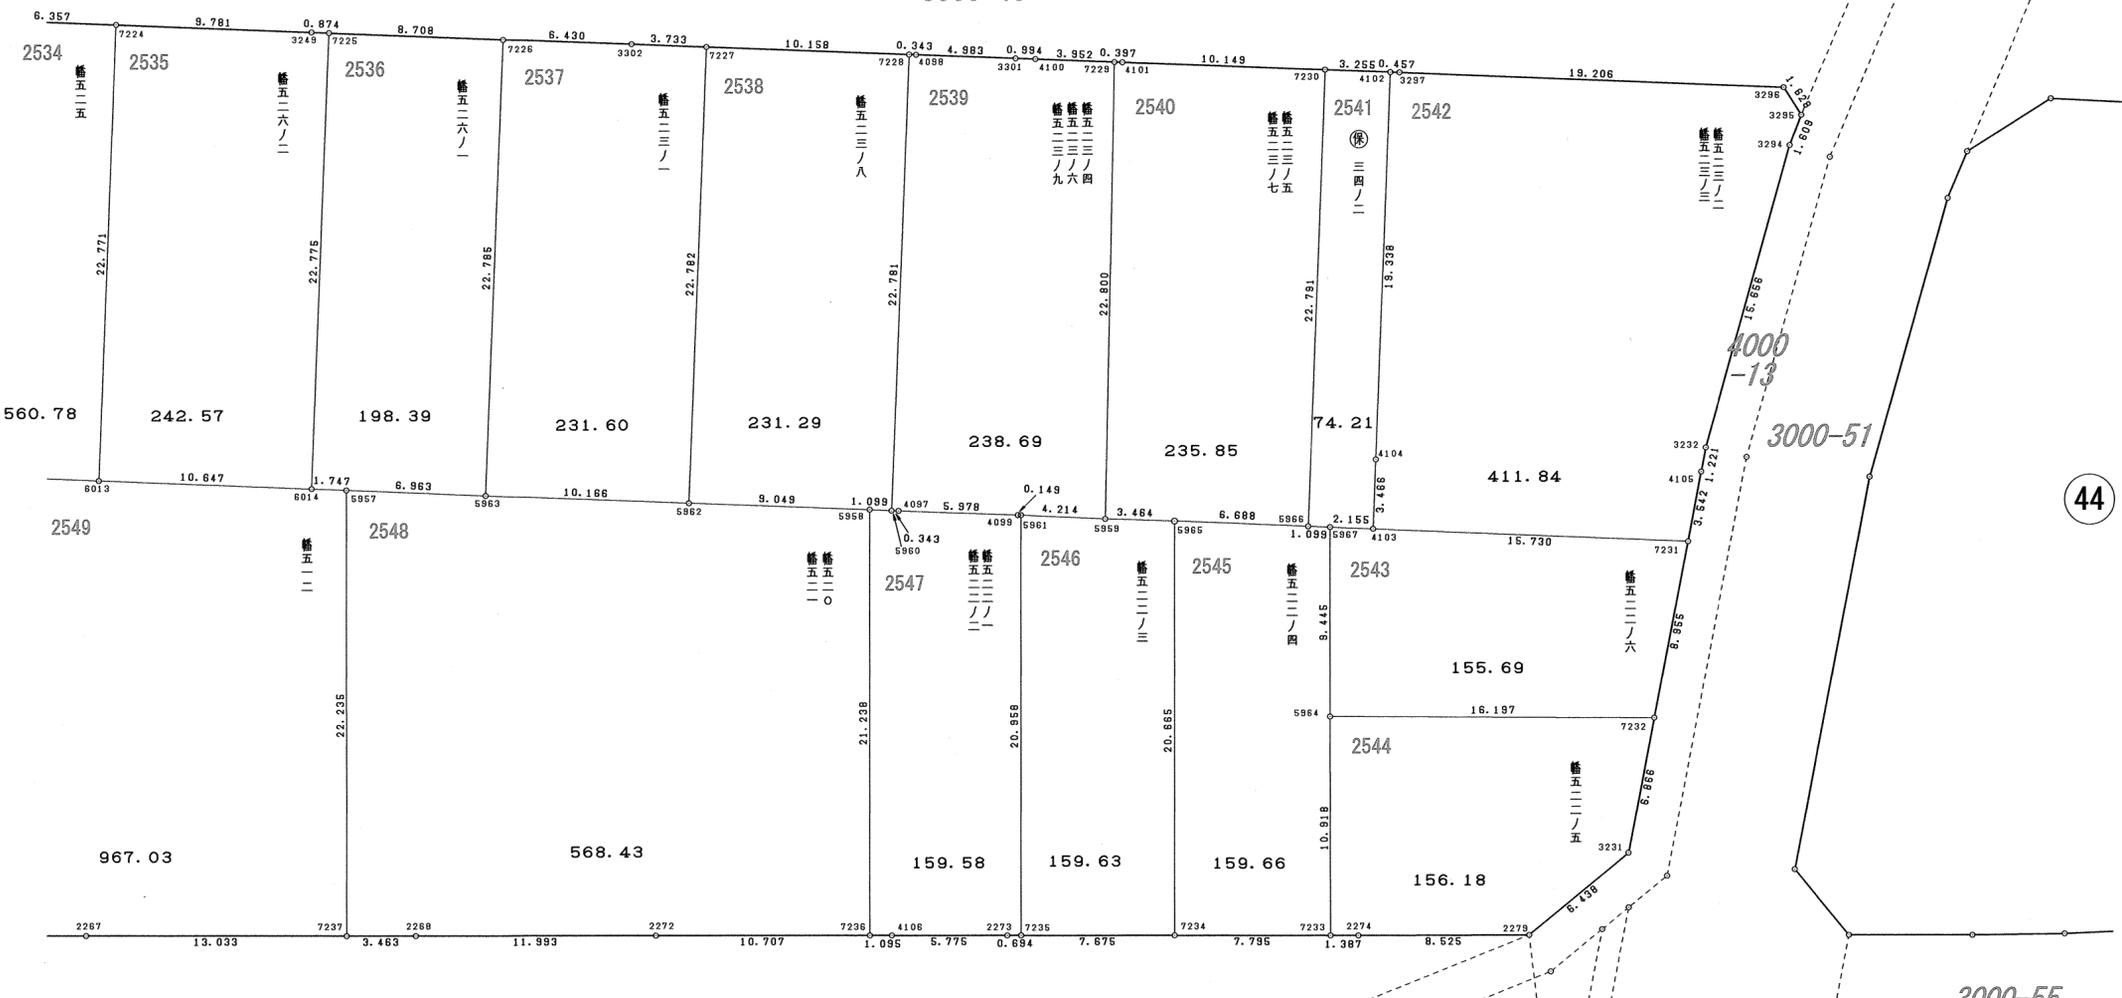

3000-24

3000-39

3000-55

3000-48

3000-50

3000-37

3000-36

3000-38

35

38

39

Y-21000

図面の種類	画地出来形確認測量図		
街区名	34	2/2	縮尺 1/250
町名	岩倉幡枝町		
京都市洛北第三土地区画整理組合			

2531-1

Table with columns: 地番, 幅三〇二ノ一, NO, X, Y, 辺長, 面積, 地積. Includes data for lots 2261, 7833, 7894, 7893, 2260, 2261 and totals.

2531-2

Table with columns: 地番, 幅三〇二ノ四, NO, X, Y, 辺長, 面積, 地積. Includes data for lots 7893, 7894, 7836, 7835, 7221, 2581, 7893 and totals.

2532

Table with columns: 地番, 幅五二四, NO, X, Y, 辺長, 面積, 地積. Includes data for lots 7221, 5698, 5699, 5700, 5701, 7222, 3252, 3253, 3259, 2583, 2582, 7221 and totals.

2533

Table with columns: 地番, 幅五七四ノ二, NO, X, Y, 辺長, 面積, 地積. Includes data for lots 7222, 5701, 5702, 7223, 7222 and totals.

2534

Table with columns: 地番, 幅五二五, NO, X, Y, 辺長, 面積, 地積. Includes data for lots 7223, 5702, 6013, 7224, 3250, 3251, 7223 and totals.

2535

Table with columns: 地番, 幅五二六ノ二, NO, X, Y, 辺長, 面積, 地積. Includes data for lots 7224, 6013, 6014, 7225, 3249, 7224 and totals.

2536

Table with columns: 地番, 幅五二六ノ一, NO, X, Y, 辺長, 面積, 地積. Includes data for lots 7225, 6014, 5957, 5963, 7226, 7225 and totals.

2537

Table with columns: 地番, 幅五二三ノ一, NO, X, Y, 辺長, 面積, 地積. Includes data for lots 7226, 5963, 5962, 7227, 3302, 7226 and totals.

2538

Table with columns: 地番, 幅五二三ノ八, NO, X, Y, 辺長, 面積, 地積. Includes data for lots 7227, 5962, 5958, 5960, 7228, 7227 and totals.

2539

Table with columns: 地番, 幅五二三ノ四, 幅五二三ノ六, 幅五二三ノ九, NO, X, Y, 辺長, 面積, 地積. Includes data for lots 7228, 5960, 4097, 4099, 5961, 5959, 7229, 4100, 3301, 4098, 7228 and totals.

2540

Table with columns: 地番, 幅五二三ノ五, 幅五二三ノ七, NO, X, Y, 辺長, 面積, 地積. Includes data for lots 7229, 5959, 5965, 5966, 7230, 4101, 7229 and totals.

2541

Table with columns: 地番, 保三四ノ二, NO, X, Y, 辺長, 面積, 地積. Includes data for lots 7230, 5966, 5967, 4103, 4104, 4102, 7230 and totals.

2542

Table with columns: 地番, 幅五二三ノ二, 幅五二三ノ三, NO, X, Y, 辺長, 面積, 地積. Includes data for lots 4102, 4104, 4103, 7231, 4105, 3232, 3294, 3295, 3296, 3297, 4102 and totals.

2543

Table with columns: 地番, 幅五二二ノ六, NO, X, Y, 辺長, 面積, 地積. Includes data for lots 7231, 4103, 5967, 5964, 7232, 7231 and totals.

2544

Table with columns: 地番, 幅五二二ノ五, NO, X, Y, 辺長, 面積, 地積. Includes data for lots 7232, 5964, 7233, 2274, 2279, 3231, 7232 and totals.

2545

Table with columns: 地番, 幅五二二ノ四, NO, X, Y, 辺長, 面積, 地積. Includes data for lots 7233, 5964, 5967, 5966, 5965, 7234, 7233 and totals.

2546

Table with columns: 地番, 幅五二二ノ三, NO, X, Y, 辺長, 面積, 地積. Includes data for lots 7234, 5965, 5959, 5961, 7235, 7234 and totals.

2547

Table with columns: 地番, 幅五二二ノ一, 幅五二二ノ二, NO, X, Y, 辺長, 面積, 地積. Includes data for lots 7235, 5961, 4099, 4097, 5960, 5958, 7236, 4106, 2273, 7235 and totals.

2548

Table with columns: 地番, 幅五二〇, 幅五二一, NO, X, Y, 辺長, 面積, 地積. Includes data for lots 7236, 5958, 5962, 5963, 5957, 7237, 2268, 2272, 7236 and totals.

2549

Table with columns: 地番, 幅五一二, NO, X, Y, 辺長, 面積, 地積. Includes data for lots 7237, 5957, 6014, 6013, 5702, 5701, 5700, 4602, 7238, 2266, 2267, 7237 and totals.

2550

Table with columns: 地番, 保三四ノ三, NO, X, Y, 辺長, 面積, 地積. Includes data for lots 4601, 4602, 5700, 5699, 4601 and totals.

2551

Table with columns: 地番, 保三四ノ一, NO, X, Y, 辺長, 面積, 地積. Includes data for lots 4091, 2265, 7238, 4602, 4601, 4091 and totals.

2552

Table with columns: 地番, 幅二九〇ノ八, NO, X, Y, 辺長, 面積, 地積. Includes data for lots 7841, 4091, 4601, 7842, 7841 and totals.

2553

Table with columns: 地番, 幅二九〇ノ七, NO, X, Y, 辺長, 面積, 地積. Includes data for lots 7839, 7841, 7842, 4601, 5699, 7840, 7839 and totals.

2554

Table with columns: 地番, 幅二九〇ノ六, 幅三〇二ノ三, NO, X, Y, 辺長, 面積, 地積. Includes data for lots 7837, 7839, 7840, 5698, 7835, 7836, 7838, 7837 and totals.

2555

Table with columns: 地番, 幅二九〇ノ一, 幅三〇二ノ二, NO, X, Y, 辺長, 面積, 地積. Includes data for lots 7837, 7838, 7836, 7894, 7833, 2262, 7837 and totals.

Summary table with columns: 図面の種類, 街区名, 町名, 画地出来形確認測量図, 34, 求積表, 岩倉幡枝町, 京都市洛北第三土地区画整理組合.

27

3000-45



岩倉幡枝町

34

Y-21000

Y-21000

26

3000-33

3000-24

3000-37

Y-21050

Y-21050

36

3000-31

38

3000-36

4000-19

3000-35

37

X-103550

X-103550

X-103550

図面の種類	画地出来形確認測量図		
街区名	35	縮尺	1/250
町名	岩倉幡枝町		
京都市洛北第三土地区画整理組合			

2380

地番 幡五〇三ノ二			
NO	X	Y	辺長
3187	-103546.227	-21021.753	
3188	-103558.816	-21021.185	12.601
7199	-103558.917	-21021.209	0.103
5694	-103558.803	-21011.789	9.420
7198	-103543.381	-21011.991	15.423
3186	-103543.202	-21018.781	6.792
3187	-103546.227	-21021.753	4.240
面積	145.7192530		
地積	145.71 m <sup>2</sup>		

2381

地番 幡五一三			
NO	X	Y	辺長
7198	-103543.381	-21011.991	
5694	-103558.803	-21011.789	15.423
4088	-103559.081	-21011.786	0.278
4089	-103564.779	-21011.719	5.698
5695	-103571.514	-21011.640	6.735
5696	-103582.210	-21011.500	10.696
5697	-103582.888	-21011.482	0.678
7211	-103582.631	-20991.518	19.965
2269	-103582.283	-20991.522	0.348
2264	-103565.826	-20991.728	16.458
2263	-103546.892	-20991.963	18.935
3240	-103543.826	-20995.015	4.326
3185	-103543.516	-21006.897	11.886
7198	-103543.381	-21011.991	5.095
面積	776.9969445		
地積	776.99 m <sup>2</sup>		

2382

地番 幡五〇八B			
NO	X	Y	辺長
7211	-103582.631	-20991.518	
5697	-103582.888	-21011.482	19.965
5956	-103590.939	-21011.389	8.051
7210	-103590.677	-20991.418	19.972
7211	-103582.631	-20991.518	8.046
面積	160.7334655		
地積	160.73 m <sup>2</sup>		

2383

地番 静七五ノ二			
NO	X	Y	辺長
7210	-103590.677	-20991.418	
5956	-103590.939	-21011.389	19.972
4096	-103591.276	-21011.387	0.337
4095	-103591.052	-20991.411	19.977
7210	-103590.677	-20991.418	0.375
面積	7.1116595		
地積	7.11 m <sup>2</sup>		

2384

地番 保三五ノ一			
NO	X	Y	辺長
4095	-103591.052	-20991.411	
4096	-103591.276	-21011.387	19.977
5955	-103591.284	-21011.387	0.008
5954	-103599.998	-21011.271	8.714
7209	-103599.772	-20991.306	19.966
2270	-103599.031	-20991.315	0.741
4095	-103591.052	-20991.411	7.979
面積	174.1877195		
地積	174.18 m <sup>2</sup>		

2385

地番 幡五一六ノ一三			
NO	X	Y	辺長
7209	-103599.772	-20991.306	
5954	-103599.998	-21011.271	19.966
5953	-103610.624	-21011.138	10.626
7208	-103610.382	-20991.173	19.966
7209	-103599.772	-20991.306	10.610
面積	212.0194920		
地積	212.01 m <sup>2</sup>		

2386

地番 幡五一六ノ一四 幡五一六ノ一五			
NO	X	Y	辺長
7208	-103610.382	-20991.173	
5953	-103610.624	-21011.138	19.966
5952	-103611.625	-21011.124	1.001
5951	-103621.881	-21010.995	10.256
7206	-103621.631	-20991.037	19.959
2271	-103615.374	-20991.110	6.257
7207	-103611.382	-20991.160	3.992
7208	-103610.382	-20991.173	1.000
面積	224.6696845		
地積	224.66 m <sup>2</sup>		

2387

地番 幡五一六ノ三 幡五一六ノ一六			
NO	X	Y	辺長
7206	-103621.631	-20991.037	
5951	-103621.881	-21010.995	19.959
5950	-103622.888	-21010.987	1.007
7204	-103634.362	-21010.850	11.474
3203	-103634.443	-21007.724	3.127
3237	-103634.801	-20993.909	13.819
2275	-103631.778	-20990.919	4.251
7205	-103622.631	-20991.026	9.147
7206	-103621.631	-20991.037	1.000
面積	252.1208805		
地積	252.12 m <sup>2</sup>		

2388

地番 幡五二八			
NO	X	Y	辺長
7203	-103591.513	-21028.860	
3196	-103610.909	-21033.410	19.922
3200	-103630.364	-21037.989	19.986
3201	-103633.725	-21035.393	4.246
3202	-103634.083	-21021.628	13.769
7204	-103634.362	-21010.850	10.781
5950	-103622.888	-21010.987	11.474
5951	-103621.881	-21010.995	1.007
5952	-103611.625	-21011.124	10.256
5953	-103610.624	-21011.138	1.001
5954	-103599.998	-21011.271	10.626
5955	-103591.284	-21011.387	8.714
7203	-103591.513	-21028.860	17.474
面積	962.3973130		
地積	962.39 m <sup>2</sup>		

2389

地番 保三五ノ三			
NO	X	Y	辺長
7202	-103582.402	-21026.719	
3195	-103591.448	-21028.845	9.292
7203	-103591.513	-21028.860	0.066
5955	-103591.284	-21011.387	17.474
4096	-103591.276	-21011.387	0.008
5956	-103590.939	-21011.389	0.337
5697	-103582.888	-21011.482	8.051
5696	-103582.210	-21011.500	0.678
7202	-103582.402	-21026.719	15.220
面積	148.4651665		
地積	148.46 m <sup>2</sup>		

2390

地番 保三五ノ二			
NO	X	Y	辺長
7201	-103571.690	-21024.202	
3194	-103571.977	-21024.269	0.294
7202	-103582.402	-21026.719	10.709
5696	-103582.210	-21011.500	15.220
5695	-103571.514	-21011.640	10.696
7201	-103571.690	-21024.202	12.563
面積	148.4628905		
地積	148.46 m <sup>2</sup>		

2391

地番 幡三一八			
NO	X	Y	辺長
7200	-103564.909	-21022.613	
7201	-103571.690	-21024.202	6.964
5695	-103571.514	-21011.640	12.563
4089	-103564.779	-21011.719	6.735
7200	-103564.909	-21022.613	10.894
面積	79.1423090		
地積	79.14 m <sup>2</sup>		

2392

地番 幡五〇四			
NO	X	Y	辺長
4087	-103559.192	-21021.271	
7200	-103564.909	-21022.613	5.872
4089	-103564.779	-21011.719	10.894
4088	-103559.081	-21011.786	5.698
4087	-103559.192	-21021.271	9.485
面積	58.0797525		
地積	58.07 m <sup>2</sup>		


2393

地番 幡五八五ノ二			
NO	X	Y	辺長
7199	-103558.917	-21021.209	
4087	-103559.192	-21021.271	0.281
4088	-103559.081	-21011.786	9.485
5694	-103558.803	-21011.789	0.278
7199	-103558.917	-21021.209	9.420
面積	2.6102975		
地積	2.61 m <sup>2</sup>		

図面の種類	画地出来形確認測量図	
街区名	35	求積表
町名	岩倉幡枝町	
京都市洛北第三土地区画整理組合		



岩倉幡枝町

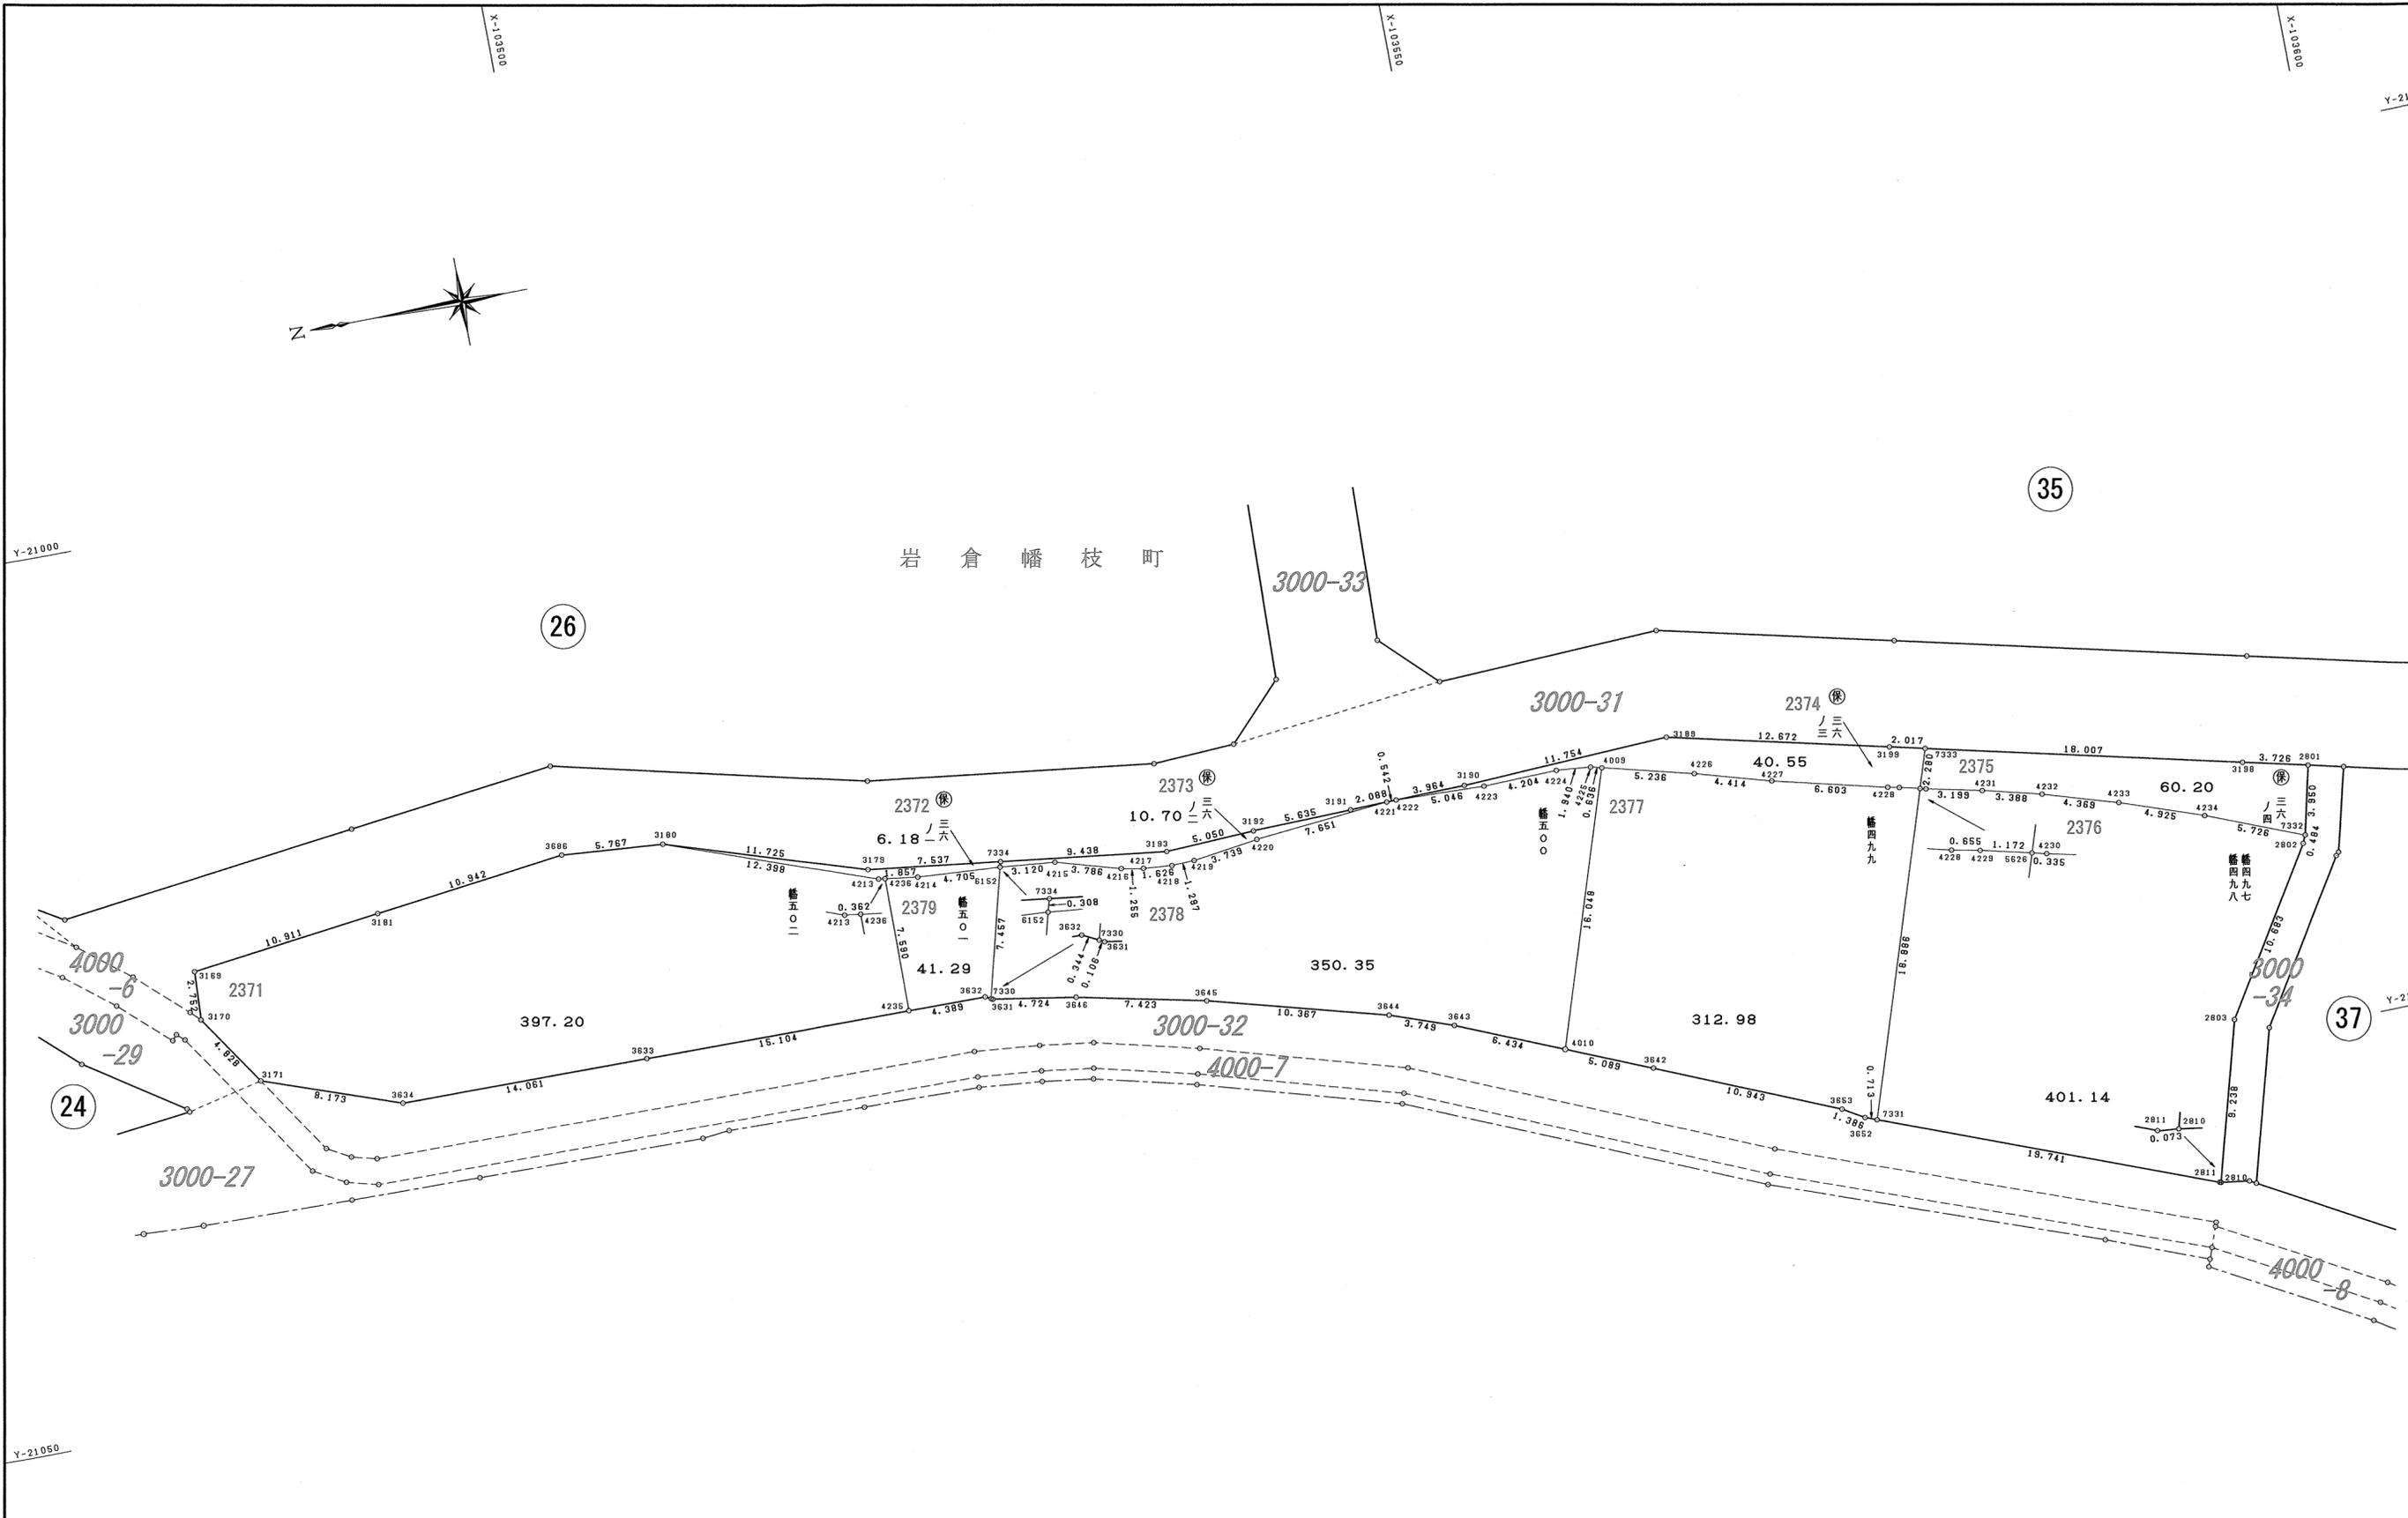

35

26

24

37

図面の種類	画地出来形確認測量図		
街区名	36	縮尺	1/250
町名	岩倉幡枝町		
京都市洛北第三土地区画整理組合			

2371

地番 幡五〇二			
NO	X	Y	辺長
3171	-103476.328	-21031.428	
3634	-103484.030	-21034.164	8.173
3633	-103498.091	-21034.256	14.061
4235	-103513.195	-21034.388	15.104
4236	-103513.258	-21026.798	7.590
4213	-103512.899	-21026.748	0.362
3180	-103501.246	-21022.514	12.398
3686	-103495.497	-21022.057	5.767
3181	-103484.633	-21023.365	10.942
3169	-103473.798	-21024.658	10.911
3170	-103473.654	-21027.407	2.752
3171	-103476.328	-21031.428	4.828
面積	397.2093680		
地積	397.20 m <sup>2</sup>		

2372

地番 保三六ノ一			
NO	X	Y	辺長
3180	-103501.246	-21022.514	
4213	-103512.899	-21026.748	12.398
4236	-103513.258	-21026.798	0.362
4214	-103515.098	-21027.053	1.857
6152	-103519.793	-21027.372	4.705
7334	-103519.881	-21027.076	0.308
3179	-103512.405	-21026.115	7.537
3180	-103501.246	-21022.514	11.725
面積	6.1844060		
地積	6.18 m <sup>2</sup>		

2373

地番 保三六ノ二			
NO	X	Y	辺長
6152	-103519.793	-21027.372	
4215	-103522.898	-21027.682	3.120
4216	-103526.532	-21028.745	3.786
4217	-103527.767	-21028.969	1.255
4218	-103529.387	-21029.109	1.626
4219	-103530.684	-21029.067	1.297
4220	-103534.390	-21028.565	3.739
4221	-103542.010	-21027.871	7.651
3191	-103539.922	-21027.917	2.088
3192	-103534.288	-21028.052	5.635
3193	-103529.243	-21028.279	5.050
7334	-103519.881	-21027.076	9.438
6152	-103519.793	-21027.372	0.308
面積	10.7064015		
地積	10.70 m <sup>2</sup>		

2374

地番 保三六ノ三			
NO	X	Y	辺長
4222	-103542.552	-21027.859	
4223	-103547.596	-21028.021	5.046
4224	-103551.799	-21027.908	4.204
4225	-103553.732	-21028.081	1.940
4226	-103559.422	-21029.538	5.873
4227	-103563.661	-21030.771	4.414
4228	-103570.074	-21032.344	6.603
4229	-103570.716	-21032.476	0.655
5626	-103571.857	-21032.748	1.172
7333	-103572.558	-21030.578	2.280
3199	-103570.594	-21030.117	2.017
3189	-103558.257	-21027.219	12.672
3190	-103546.516	-21027.772	11.754
4222	-103542.552	-21027.859	3.964
面積	40.5551115		
地積	40.55 m <sup>2</sup>		

2375

地番 保三六ノ四			
NO	X	Y	辺長
5626	-103571.857	-21032.748	
4230	-103572.183	-21032.829	0.335
4231	-103575.306	-21033.526	3.199
4232	-103578.590	-21034.360	3.988
4233	-103582.768	-21035.638	4.369
4234	-103587.420	-21037.256	4.925
7332	-103592.738	-21039.379	5.726
2801	-103593.715	-21035.551	3.950
3198	-103590.088	-21034.696	3.726
7333	-103572.558	-21030.578	18.007
5626	-103571.857	-21032.748	2.280
面積	60.2089240		
地積	60.20 m <sup>2</sup>		

2376

地番 幡四九七 幡四九八			
NO	X	Y	辺長
7331	-103565.984	-21050.698	
2811	-103584.409	-21057.786	19.741
2810	-103584.480	-21057.804	0.073
2803	-103586.944	-21048.900	9.238
2802	-103592.618	-21039.848	10.683
7332	-103592.738	-21039.379	0.484
4234	-103587.420	-21037.256	5.726
4233	-103582.768	-21035.638	4.925
4232	-103578.590	-21034.360	4.369
4231	-103575.306	-21033.526	3.988
4230	-103572.183	-21032.829	3.199
5626	-103571.857	-21032.748	0.335
7331	-103565.984	-21050.698	18.886
面積	401.1432195		
地積	401.14 m <sup>2</sup>		

2377

地番 幡四九九			
NO	X	Y	辺長
7331	-103565.984	-21050.698	
5626	-103571.857	-21032.748	18.886
4229	-103570.716	-21032.476	1.172
4228	-103570.074	-21032.344	0.655
4227	-103563.661	-21030.771	6.603
4226	-103559.422	-21029.538	4.414
4009	-103554.349	-21028.239	5.236
4010	-103549.358	-21043.492	16.048
3642	-103554.048	-21045.469	5.089
3653	-103564.126	-21049.734	10.943
3652	-103565.318	-21050.442	1.386
7331	-103565.984	-21050.698	0.713
面積	312.9884010		
地積	312.98 m <sup>2</sup>		

2378

地番 幡五〇〇			
NO	X	Y	辺長
4010	-103549.358	-21043.492	
4009	-103554.349	-21028.239	16.048
4225	-103553.732	-21028.081	0.636
4224	-103551.799	-21027.908	1.940
4223	-103547.596	-21028.021	4.204
4222	-103542.552	-21027.859	5.046
4221	-103542.010	-21027.871	0.542
4220	-103534.390	-21028.565	7.651
4219	-103530.684	-21029.067	3.739
4218	-103529.387	-21029.109	1.297
4217	-103527.767	-21028.969	1.626
4216	-103526.532	-21028.745	1.255
4215	-103522.898	-21027.682	3.786
6152	-103519.793	-21027.372	3.120
7330	-103517.891	-21034.583	7.457
3631	-103517.986	-21034.631	0.106
3646	-103522.647	-21035.405	4.724
3645	-103529.899	-21036.990	7.423
3644	-103539.898	-21039.731	10.367
3643	-103543.429	-21040.992	3.749
4010	-103549.358	-21043.492	6.434
面積	350.3560195		
地積	350.35 m <sup>2</sup>		

2379

地番 幡五〇一			
NO	X	Y	辺長
4235	-103513.195	-21034.388	
3632	-103517.584	-21034.426	4.389
7330	-103517.891	-21034.583	0.344
6152	-103519.793	-21027.372	7.457
4214	-103515.098	-21027.053	4.705
4236	-103513.258	-21026.798	1.857
4235	-103513.195	-21034.388	7.590
面積	41.2914430		
地積	41.29 m <sup>2</sup>		

図面の種類	画地出来形確認測量図		
街区名	36	求積表	
町名	岩倉幡枝町		
京都市洛北第三土地区画整理組合			



## 2394

地番	幡四九三		
N O	X	Y	辺長
2808	-103586.425	-21058.222	
3651	-103595.657	-21063.367	10.568
3650	-103609.838	-21072.718	16.986
7347	-103610.145	-21073.480	0.821
4294	-103613.264	-21065.624	8.452
4287	-103616.684	-21057.013	9.265
4288	-103612.502	-21055.352	4.499
4285	-103617.739	-21042.165	14.188
4284	-103607.118	-21040.884	10.697
4283	-103605.264	-21039.905	2.096
4282	-103599.648	-21040.690	5.670
4281	-103597.823	-21040.916	1.838
4280	-103596.533	-21040.962	1.290
4279	-103595.158	-21040.857	1.379
2805	-103594.345	-21040.875	0.813
2804	-103588.793	-21049.717	10.440
2808	-103586.425	-21058.222	8.828
面積	657.3734660		
地積	657.37 m <sup>2</sup>		

## 2395

地番	保三七ノ三		
N O	X	Y	辺長
2805	-103594.345	-21040.875	
4279	-103595.158	-21040.857	0.813
4280	-103596.533	-21040.962	1.379
4281	-103597.823	-21040.916	1.290
4282	-103599.648	-21040.690	1.838
4283	-103605.264	-21039.905	5.670
4284	-103607.118	-21040.884	2.096
4285	-103617.739	-21042.165	10.697
4286	-103622.360	-21042.722	4.654
7340	-103622.521	-21042.315	0.437
3197	-103609.542	-21039.267	13.332
2807	-103595.681	-21036.010	14.238
2806	-103594.500	-21040.696	4.832
2805	-103594.345	-21040.875	0.236
面積	59.2118920		
地積	59.21 m <sup>2</sup>		

## 2396

地番	幡四九六		
N O	X	Y	辺長
4286	-103622.360	-21042.722	
4285	-103617.739	-21042.165	4.654
4288	-103612.502	-21055.352	14.188
4287	-103616.684	-21057.013	4.499
4286	-103622.360	-21042.722	15.376
面積	66.5234670		
地積	66.52 m <sup>2</sup>		

## 2397

地番	幡四九五		
N O	X	Y	辺長
7341	-103636.125	-21045.513	
3210	-103629.007	-21043.838	7.312
7340	-103622.521	-21042.315	6.662
4286	-103622.360	-21042.722	0.437
4287	-103616.684	-21057.013	15.376
4294	-103613.264	-21065.624	9.265
4293	-103625.033	-21070.379	12.693
6223	-103625.650	-21069.214	1.318
6224	-103626.634	-21067.986	1.573
4299	-103627.730	-21065.403	2.805
6225	-103633.029	-21052.916	13.564
7341	-103636.125	-21045.513	8.024
面積	352.8308820		
地積	352.83 m <sup>2</sup>		

## 2398

地番	幡四九〇		
N O	X	Y	辺長
7341	-103636.125	-21045.513	
6225	-103633.029	-21052.916	8.024
4299	-103627.730	-21065.403	13.564
4298	-103641.565	-21074.438	16.523
6219	-103643.769	-21072.729	2.788
6220	-103644.803	-21072.096	1.212
6221	-103648.409	-21067.020	6.226
6222	-103651.481	-21062.635	5.354
4297	-103652.737	-21060.809	2.216
4296	-103647.417	-21059.560	5.464
4295	-103649.953	-21048.762	11.091
3209	-103641.142	-21046.693	9.050
7341	-103636.125	-21045.513	5.153
面積	431.3924565		
地積	431.39 m <sup>2</sup>		

## 2399

地番	幡五五六A		
N O	X	Y	辺長
4295	-103649.953	-21048.762	
4296	-103647.417	-21059.560	11.091
4297	-103652.737	-21060.809	5.464
6216	-103658.747	-21052.072	10.604
7342	-103659.519	-21051.008	1.314
3208	-103659.209	-21050.935	0.318
4295	-103649.953	-21048.762	9.507
面積	84.6266480		
地積	84.62 m <sup>2</sup>		

## 2400

地番	幡五一六ノ一		
N O	X	Y	辺長
7342	-103659.519	-21051.008	
6216	-103658.747	-21052.072	1.314
6215	-103658.897	-21052.180	0.184
7343	-103659.714	-21051.054	1.391
7342	-103659.519	-21051.008	0.200
面積	0.2500640		
地積	0.25 m <sup>2</sup>		

## 2401

地番	幡五一六ノ五		
N O	X	Y	辺長
7343	-103659.714	-21051.054	
6215	-103658.897	-21052.180	1.391
6214	-103660.171	-21053.062	1.549
7344	-103661.335	-21051.435	2.000
7343	-103659.714	-21051.054	1.665
面積	2.6179845		
地積	2.61 m <sup>2</sup>		

## 2402

地番	保三七ノ一		
N O	X	Y	辺長
3213	-103679.411	-21064.366	
3212	-103680.268	-21058.947	5.486
3211	-103677.821	-21055.307	4.386
7344	-103661.335	-21051.435	16.934
6214	-103660.171	-21053.062	2.000
4300	-103666.707	-21057.625	7.971
4301	-103668.019	-21057.083	1.419
4302	-103670.563	-21057.867	2.662
4303	-103672.210	-21059.010	2.004
4304	-103674.453	-21061.111	3.073
4305	-103678.107	-21063.934	4.617
3213	-103679.411	-21064.366	1.373
面積	98.6209815		
地積	98.62 m <sup>2</sup>		

## 2403

地番	幡五一四ノ二		
N O	X	Y	辺長
3213	-103679.411	-21064.366	
4305	-103678.107	-21063.934	1.373
4304	-103674.453	-21061.111	4.617
4303	-103672.210	-21059.010	3.073
4302	-103670.563	-21057.867	2.004
4301	-103668.019	-21057.083	2.662
4300	-103666.707	-21057.625	1.419
6625	-103670.903	-21060.554	5.117
3214	-103678.332	-21067.477	10.154
3213	-103679.411	-21064.366	3.292
面積	30.1024160		
地積	30.10 m <sup>2</sup>		

## 2404

地番	幡四八九		
N O	X	Y	辺長
6216	-103658.747	-21052.072	
4297	-103652.737	-21060.809	10.604
6222	-103651.481	-21062.635	2.216
6221	-103648.409	-21067.020	5.354
6220	-103644.803	-21072.096	6.226
6219	-103643.769	-21072.729	1.212
6227	-103652.292	-21079.314	10.770
6226	-103652.441	-21079.422	0.184
6228	-103657.159	-21073.941	7.231
6625	-103670.903	-21060.554	19.186
4300	-103666.707	-21057.625	5.117
6214	-103660.171	-21053.062	7.971
6215	-103658.897	-21052.180	1.549
6216	-103658.747	-21052.072	0.184
面積	319.6863315		
地積	319.68 m <sup>2</sup>		

## 2405

地番	幡四八七		
N O	X	Y	辺長
3214	-103678.332	-21067.477	
6625	-103670.903	-21060.554	10.154
6228	-103657.159	-21073.941	19.186
6226	-103652.441	-21079.422	7.231
3680	-103662.585	-21087.381	12.893
3681	-103668.238	-21080.462	8.934
3682	-103669.957	-21078.362	2.713
3683	-103674.925	-21072.180	7.930
3215	-103677.037	-21069.455	3.447
3214	-103678.332	-21067.477	2.364
面積	307.5145350		
地積	307.51 m <sup>2</sup>		

## 2406

地番	幡四八五ノ一		
N O	X	Y	辺長
3680	-103662.585	-21087.381	
6226	-103652.441	-21079.422	12.893
6227	-103652.292	-21079.314	0.184
6228	-103648.372	-21084.063	6.157
7345	-103638.995	-21095.290	14.627
3677	-103646.495	-21102.789	10.605
3678	-103650.737	-21102.533	4.249
3679	-103660.357	-21090.165	15.668
3680	-103662.585	-21087.381	3.565
面積	283.9817275		
地積	283.98 m <sup>2</sup>		

## 2407

地番	幡四八五ノ二		
N O	X	Y	辺長
7345	-103638.995	-21095.290	
6229	-103648.372	-21084.063	14.627
6227	-103652.292	-21079.314	6.157
6219	-103643.769	-21072.729	10.770
4298	-103641.565	-21074.438	2.788
6218	-103636.190	-21078.603	6.799
6217	-103632.193	-21082.218	5.389
7346	-103628.301	-21086.598	5.859
3660	-103634.482	-21091.469	7.869
3661	-103638.771	-21095.066	5.597
7345	-103638.995	-21095.290	0.316
面積	261.4520330		
地積	261.45 m <sup>2</sup>		

## 2408

地番	幡四九一		
N O	X	Y	辺長
7346	-103628.301	-21086.598	
6217	-103632.193	-21082.218	5.859
6218	-103636.190	-21078.603	5.389
4298	-103641.565	-21074.438	6.799
4299	-103627.730	-21065.403	16.523
6224	-103626.634	-21067.986	2.805
6223	-103625.650	-21069.214	1.573
4293	-103625.033	-21070.379	1.318
4290	-103623.963	-21072.401	2.287
3656	-103619.987	-21079.910	8.496
3657	-103624.462	-21083.112	5.502
3658	-103624.971	-21083.498	0.638
3659	-103628.220	-21086.534	4.446
7346	-103628.301	-21086.598	0.103
面積	221.4114940		
地積	221.41 m <sup>2</sup>		

## 2409

地番	幡四九二		
N O	X	Y	辺長
3655	-103617.342	-21078.085	
3656	-103619.987	-21079.910	3.213
4290	-103623.963	-21072.401	8.496
4291	-103618.650	-21069.588	6.011
4292	-103614.955	-21076.565	7.895
3655	-103617.342	-21078.085	2.829
面積	49.1059845		
地積	49.10 m <sup>2</sup>		

## 2410

地番	幡四九四		
N O	X	Y	辺長
4292	-103614.955	-21076.565	
4291	-103618.650	-21069.588	7.895
4290	-103623.963	-21072.401	6.011
4293			



2411

地番 幡五一四ノ一B			
NO	X	Y	辺長
3206	-103642.525	-21040.854	
7248	-103659.184	-21044.765	17.111
4090	-103663.958	-21024.463	20.855
7239	-103640.028	-21023.837	23.938
3205	-103639.687	-21037.169	13.336
3206	-103642.525	-21040.854	4.651
面積	400.8143105		
地積	400.81 m <sup>2</sup>		

2412

地番 幡五一五			
NO	X	Y	辺長
7239	-103640.028	-21023.837	
4090	-103663.958	-21024.463	23.938
5689	-103664.202	-21023.425	1.066
7240	-103640.055	-21022.802	24.155
7239	-103640.028	-21023.837	1.035
面積	25.0005250		
地積	25.00 m <sup>2</sup>		

2413

地番 幡五六二B			
NO	X	Y	辺長
7240	-103640.055	-21022.802	
5689	-103664.202	-21023.425	24.155
4120	-103666.117	-21012.471	11.120
5980	-103666.276	-21011.558	0.926
5688	-103656.022	-21009.561	10.446
4116	-103655.517	-21009.463	0.514
4117	-103656.027	-20990.601	18.868
2276	-103643.923	-20990.755	12.104
3239	-103640.804	-20993.804	4.361
3238	-103640.443	-21007.809	14.009
3204	-103640.082	-21021.748	13.943
7240	-103640.055	-21022.802	1.054
面積	612.0241745		
地積	612.02 m <sup>2</sup>		

2414

地番 保三八ノ一			
NO	X	Y	辺長
4117	-103656.027	-20990.601	
4116	-103655.517	-21009.463	18.868
5688	-103656.022	-21009.561	0.514
5687	-103657.620	-20999.709	9.980
7241	-103657.175	-20990.586	9.133
4117	-103656.027	-20990.601	1.148
面積	25.1519945		
地積	25.15 m <sup>2</sup>		

2415

地番 保三八ノ三			
NO	X	Y	辺長
7241	-103657.175	-20990.586	
5687	-103657.620	-20999.709	9.133
4118	-103659.105	-20990.562	9.266
7241	-103657.175	-20990.586	1.930
面積	8.8090350		
地積	8.80 m <sup>2</sup>		

2416

地番 幡五一六ノ八			
NO	X	Y	辺長
4118	-103659.105	-20990.562	
5687	-103657.620	-20999.709	9.266
5688	-103656.022	-21009.561	9.980
5980	-103666.276	-21011.558	10.446
5983	-103668.506	-21012.004	2.274
5982	-103668.906	-21010.030	2.014
5981	-103669.300	-21008.067	2.002
5979	-103666.347	-21007.498	3.007
4112	-103669.489	-20991.329	16.471
4115	-103663.976	-20990.850	5.533
4113	-103662.151	-20990.523	1.854
2277	-103661.506	-20990.531	0.645
4118	-103659.105	-20990.562	2.401
面積	212.4418615		
地積	212.44 m <sup>2</sup>		

2417

地番 保三八ノ四			
NO	X	Y	辺長
4113	-103662.151	-20990.523	
4115	-103663.976	-20990.850	1.854
4112	-103669.489	-20991.329	5.533
7242	-103669.664	-20990.427	0.918
4113	-103662.151	-20990.523	7.513
面積	3.8442510		
地積	3.84 m <sup>2</sup>		

2418

地番 保三八ノ五			
NO	X	Y	辺長
7242	-103669.664	-20990.427	
4112	-103669.489	-20991.329	0.918
4114	-103676.460	-20991.513	6.973
4111	-103679.528	-20990.757	3.159
7243	-103679.617	-20990.300	0.465
2278	-103679.004	-20990.308	0.613
7242	-103669.664	-20990.427	9.340
面積	9.6625555		
地積	9.66 m <sup>2</sup>		

2419

地番 幡五一六ノ七			
NO	X	Y	辺長
4112	-103669.489	-20991.329	
5979	-103666.347	-21007.498	16.471
5981	-103669.300	-21008.067	3.007
5984	-103675.906	-21009.353	6.730
4109	-103675.920	-21009.280	0.074
4111	-103679.528	-20990.757	18.871
4114	-103676.460	-20991.513	3.159
4112	-103669.489	-20991.329	6.973
面積	169.5619735		
地積	169.56 m <sup>2</sup>		

2420

地番 幡五一六ノ六			
NO	X	Y	辺長
7243	-103679.617	-20990.300	
4111	-103679.528	-20990.757	0.465
4109	-103675.920	-21009.280	18.871
4110	-103688.983	-21011.838	13.311
3225	-103689.813	-21008.005	3.921
3230	-103691.827	-20993.357	14.785
2285	-103689.003	-20990.179	4.251
7243	-103679.617	-20990.300	9.386
面積	263.1740325		
地積	263.17 m <sup>2</sup>		

2421

地番 幡五一六ノ一			
NO	X	Y	辺長
7244	-103688.968	-21011.911	
4110	-103688.983	-21011.838	0.074
4109	-103675.920	-21009.280	13.311
5984	-103675.906	-21009.353	0.074
7244	-103688.968	-21011.911	13.310
面積	0.9906535		
地積	0.99 m <sup>2</sup>		

2422

地番 幡五一六ノ九			
NO	X	Y	辺長
7244	-103688.968	-21011.911	
5984	-103675.906	-21009.353	13.310
5981	-103669.300	-21008.067	6.730
5982	-103668.906	-21010.030	2.002
7245	-103688.544	-21013.870	20.009
7244	-103688.968	-21011.911	2.004
面積	40.1611190		
地積	40.16 m <sup>2</sup>		

2423

地番 幡五一六ノ一〇			
NO	X	Y	辺長
7245	-103688.544	-21013.870	
5982	-103668.906	-21010.030	20.009
5983	-103668.506	-21012.004	2.014
7246	-103688.120	-21015.831	19.983
7245	-103688.544	-21013.870	2.006
面積	40.1935570		
地積	40.19 m <sup>2</sup>		

2424

地番 保三八ノ二			
NO	X	Y	辺長
7246	-103688.120	-21015.831	
5983	-103668.506	-21012.004	19.983
5980	-103666.276	-21011.558	2.274
4120	-103666.117	-21012.471	0.926
4119	-103687.830	-21017.173	22.216
7246	-103688.120	-21015.831	1.372
面積	25.4558855		
地積	25.45 m <sup>2</sup>		

2425

地番 幡三八三			
NO	X	Y	辺長
4119	-103687.830	-21017.173	
4120	-103666.117	-21012.471	22.216
5689	-103664.202	-21023.425	11.120
7247	-103685.479	-21028.033	21.770
3226	-103685.638	-21027.299	0.751
4119	-103687.830	-21017.173	10.360
面積	244.3756330		
地積	244.37 m <sup>2</sup>		

2426

地番 幡五一四ノ一A			
NO	X	Y	辺長
7248	-103659.184	-21044.765	
3207	-103660.594	-21045.096	1.448
3229	-103678.648	-21049.335	18.544
3228	-103682.165	-21046.978	4.233
3227	-103684.364	-21033.174	13.978
7247	-103685.479	-21028.033	5.260
5689	-103664.202	-21023.425	21.770
4090	-103663.958	-21024.463	1.066
7248	-103659.184	-21044.765	20.855
面積	488.8715740		
地積	488.87 m <sup>2</sup>		

図面の種類	画地出来形確認測量図	
街区名	38	求積表
町名	岩倉幡枝町	
京都市洛北第三土地区画整理組合		



37

38

岩倉幡枝町

3000-35

3000-38

4000-10


3000-32

3000-49

40



図面の種類	画地出来形確認測量図		
街区名	39	縮尺	1/250
町名	岩倉幡枝町		
京都市洛北第三土地区画整理組合			

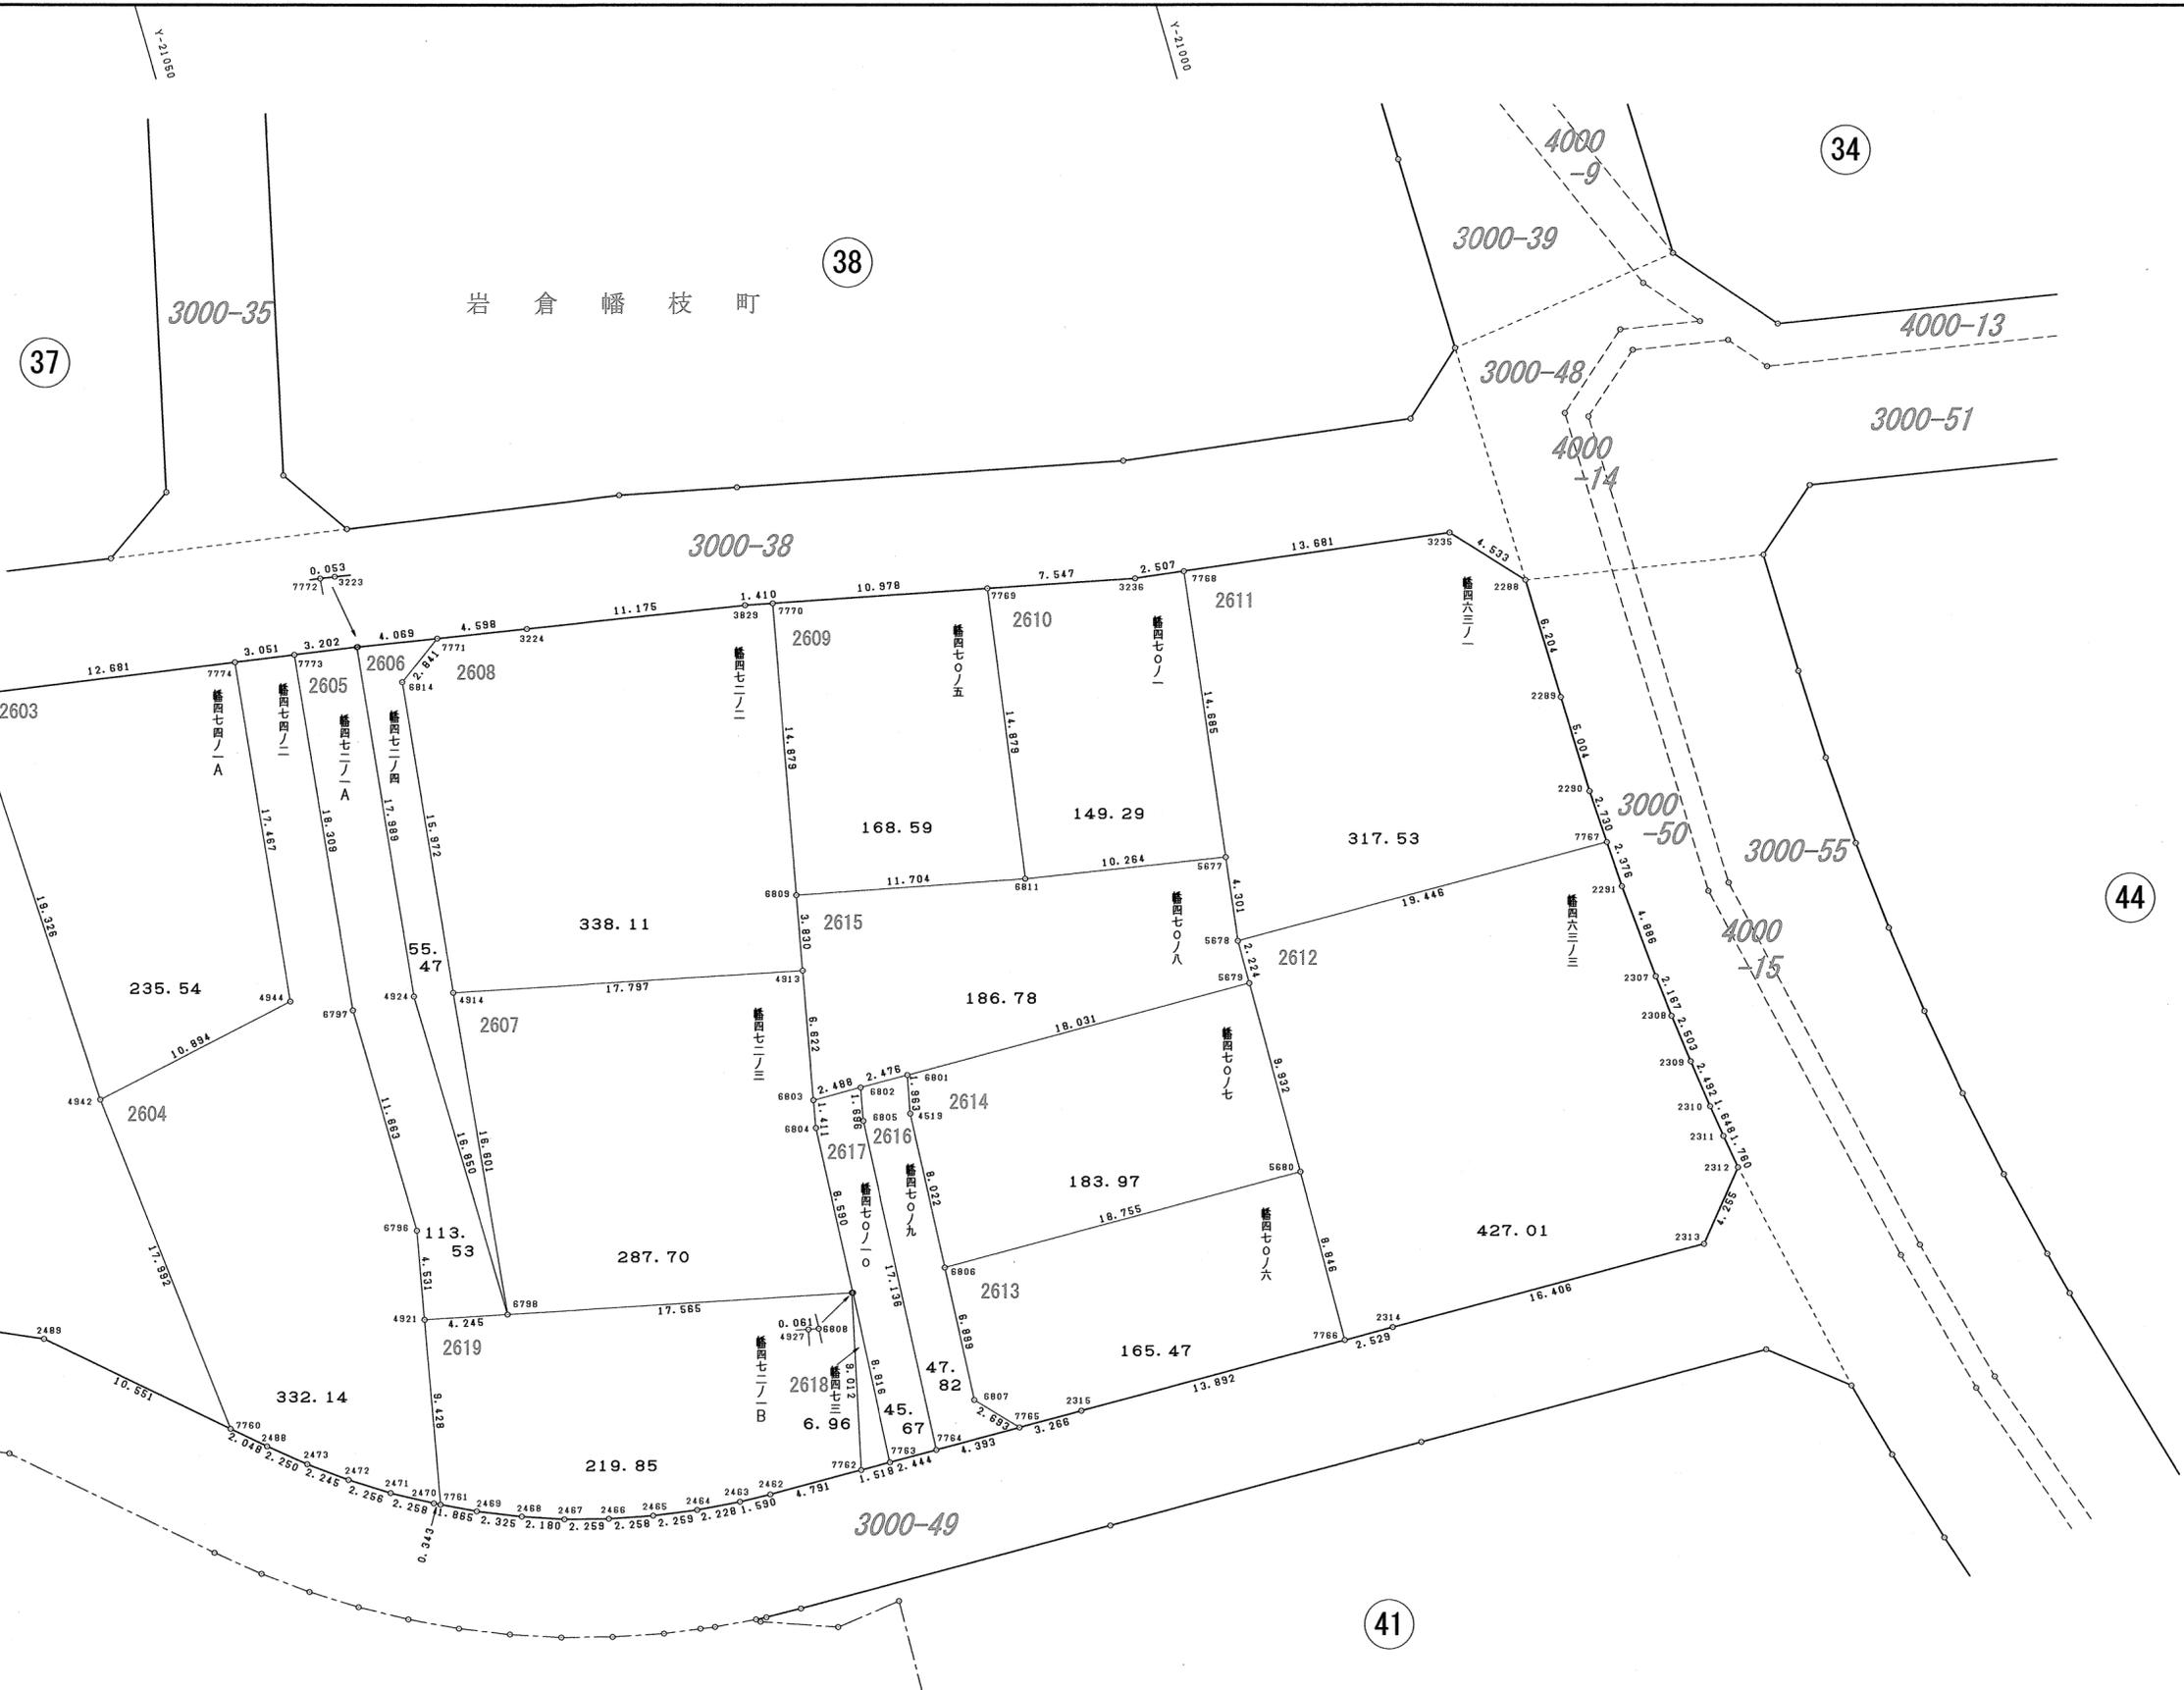

岩倉幡枝町

図面の種類	画地出来形確認測量図		
街区名	39 2/2	縮尺	1/250
町名	岩倉幡枝町		
京都市洛北第三土地区画整理組合			

## 2601

地番 幡四八〇ノ一 幡四八一			
NO	X	Y	辺長
3753	-103653.672	-21110.467	
3752	-103656.371	-21113.607	4.140
3751	-103662.065	-21119.975	8.542
7751	-103662.971	-21120.959	1.337
4917	-103681.478	-21099.871	28.057
6469	-103679.988	-21099.016	1.717
6466	-103674.370	-21099.884	5.684
4918	-103666.637	-21095.183	9.049
7776	-103663.622	-21093.351	3.527
3684	-103663.514	-21093.480	0.168
7777	-103663.082	-21094.214	0.851
3685	-103662.669	-21094.916	0.814
3754	-103653.646	-21105.852	14.177
3753	-103653.672	-21110.467	4.615
面積	382.0280405		
地積	382.02 m <sup>2</sup>		

## 2602

地番 幡四七五			
NO	X	Y	辺長
7776	-103663.622	-21093.351	
4918	-103666.637	-21095.183	3.527
6466	-103674.370	-21099.884	9.049
6469	-103679.988	-21099.016	5.684
4917	-103681.478	-21099.871	1.717
6470	-103682.250	-21100.313	0.889
6481	-103683.589	-21102.058	2.199
6480	-103685.328	-21106.618	4.880
6479	-103686.953	-21112.027	5.647
4923	-103691.240	-21106.172	7.256
4919	-103703.164	-21089.883	20.186
6790	-103690.918	-21089.887	12.246
6791	-103690.104	-21080.502	9.420
6800	-103687.232	-21067.814	13.008
7775	-103684.724	-21067.264	2.567
3828	-103684.055	-21067.963	0.867
3221	-103682.715	-21069.839	2.305
3220	-103681.213	-21071.711	2.400
3219	-103679.108	-21074.399	3.414
3218	-103676.679	-21077.518	3.953
3217	-103673.311	-21081.703	5.371
3216	-103672.809	-21082.361	0.827
7776	-103663.622	-21093.351	14.324
面積	702.7234810		
地積	702.72 m <sup>2</sup>		

## 2603

地番 幡四七四ノ一A			
NO	X	Y	辺長
7775	-103684.724	-21067.264	
6800	-103687.232	-21067.814	2.567
4942	-103706.545	-21067.086	19.326
4944	-103704.429	-21056.399	10.894
7774	-103687.084	-21054.338	17.467
3222	-103685.106	-21066.864	12.681
7775	-103684.724	-21067.264	0.553
面積	235.5486735		
地積	235.54 m <sup>2</sup>		

## 2604

地番 幡四七四ノ二			
NO	X	Y	辺長
7774	-103687.084	-21054.338	
4944	-103704.429	-21056.399	17.467
4942	-103706.545	-21067.086	10.894
7760	-103724.452	-21065.330	17.992
2488	-103725.815	-21063.801	2.048
2473	-103727.265	-21062.080	2.250
2472	-103728.607	-21060.280	2.245
2471	-103729.852	-21058.398	2.256
2470	-103730.951	-21056.425	2.258
7761	-103731.105	-21056.118	0.343
4921	-103721.853	-21054.300	9.428
6796	-103717.407	-21053.426	4.531
6797	-103705.744	-21053.463	11.663
7773	-103687.560	-21051.324	18.309
7774	-103687.084	-21054.338	3.051
面積	332.1458550		
地積	332.14 m <sup>2</sup>		

## 2605

地番 幡四七二ノ一A			
NO	X	Y	辺長
7773	-103687.560	-21051.324	
6797	-103705.744	-21053.463	18.309
6796	-103717.407	-21053.426	11.663
4921	-103721.853	-21054.300	4.531
6798	-103722.776	-21050.156	4.245
4924	-103705.926	-21050.267	16.850
7772	-103688.060	-21048.161	17.989
7773	-103687.560	-21051.324	3.202
面積	113.5356005		
地積	113.53 m <sup>2</sup>		

## 2606

地番 幡四七二ノ四			
NO	X	Y	辺長
7772	-103688.060	-21048.161	
4924	-103705.926	-21050.267	17.989
6798	-103722.776	-21050.156	16.850
4914	-103706.284	-21048.252	16.601
6814	-103690.417	-21046.419	15.972
7771	-103688.775	-21044.100	2.841
3223	-103688.068	-21048.108	4.069
7772	-103688.060	-21048.161	0.053
面積	55.4796495		
地積	55.47 m <sup>2</sup>		

## 2607

地番 幡四七二ノ三			
NO	X	Y	辺長
4927	-103726.595	-21033.011	
6808	-103726.608	-21032.951	0.061
6804	-103718.032	-21032.447	8.590
6803	-103716.646	-21032.178	1.411
4913	-103710.152	-21030.880	6.622
4914	-103706.284	-21048.252	17.797
6798	-103722.776	-21050.156	16.601
4927	-103726.595	-21033.011	17.565
面積	287.7061445		
地積	287.70 m <sup>2</sup>		

## 2608

地番 幡四七二ノ二			
NO	X	Y	辺長
4914	-103706.284	-21048.252	
4913	-103710.152	-21030.880	17.797
6809	-103706.396	-21030.128	3.830
7770	-103691.810	-21027.186	14.879
3829	-103691.512	-21028.565	1.410
3224	-103689.573	-21039.571	11.175
7771	-103688.775	-21044.100	4.598
6814	-103690.417	-21046.419	2.841
4914	-103706.284	-21048.252	15.972
面積	338.1162595		
地積	338.11 m <sup>2</sup>		

## 2609

地番 幡四七〇ノ五			
NO	X	Y	辺長
7770	-103691.810	-21027.186	
6809	-103706.396	-21030.128	14.879
6811	-103708.837	-21018.681	11.704
7769	-103694.125	-21016.454	14.879
7770	-103691.810	-21027.186	10.978
面積	168.5960265		
地積	168.59 m <sup>2</sup>		

## 2610

地番 幡四七〇ノ一			
NO	X	Y	辺長
7769	-103694.125	-21016.454	
6811	-103708.837	-21018.681	14.879
5677	-103710.613	-21008.571	10.264
7768	-103696.061	-21006.593	14.685
3236	-103695.718	-21009.077	2.507
7769	-103694.125	-21016.454	7.547
面積	149.2967255		
地積	149.29 m <sup>2</sup>		

## 2611

地番 幡四六三ノ一			
NO	X	Y	辺長
7768	-103696.061	-21006.593	
5677	-103710.613	-21008.571	14.685
5678	-103714.875	-21009.152	4.301
7767	-103715.243	-20989.709	19.446
2290	-103712.516	-20989.843	2.730
2289	-103707.512	-20989.930	5.004
2288	-103701.308	-20990.011	6.204
3235	-103697.935	-20993.040	4.533
7768	-103696.061	-21006.593	13.681
面積	317.5315885		
地積	317.53 m <sup>2</sup>		

## 2612

地番 幡四六三ノ三			
NO	X	Y	辺長
2314	-103735.923	-21006.999	
2313	-103736.233	-20990.595	16.406
2312	-103732.973	-20987.860	4.255
2311	-103731.234	-20988.133	1.760
2310	-103729.602	-20988.363	1.648
2309	-103727.131	-20988.689	2.492
2308	-103724.644	-20988.980	2.503
2307	-103722.488	-20989.206	2.167
2291	-103717.617	-20989.592	4.886
7767	-103715.243	-20989.709	2.376
5678	-103714.875	-21009.152	19.446
5679	-103717.099	-21009.186	2.224
5680	-103727.030	-21009.334	8.846
7766	-103735.874	-21009.528	8.846
2314	-103735.923	-21006.999	2.529
面積	427.0174665		
地積	427.01 m <sup>2</sup>		

## 2613

地番 幡四七〇ノ六			
NO	X	Y	辺長
7766	-103735.874	-21009.528	
5680	-103727.030	-21009.334	8.846
6806	-103726.678	-21028.086	18.755
6807	-103733.564	-21028.513	6.899
7765	-103735.541	-21026.684	2.693
2315	-103735.605	-21023.418	3.266
7766	-103735.874	-21009.528	13.892
面積	165.4734085		
地積	165.47 m <sup>2</sup>		

## 2614

地番 幡四七〇ノ七			
NO	X	Y	辺長
6806	-103726.678	-21028.086	
5680	-103727.030	-21009.334	18.755
5679	-103717.099	-21009.186	9.932
6801	-103716.748	-21027.214	18.031
4519	-103718.669	-21027.620	1.963
6806	-103726.678	-21028.086	8.022
面積	183.9793940		
地積	183.97 m <sup>2</sup>		

## 2615

地番 幡四七〇ノ八			
NO	X	Y	辺長
6803	-103716.646	-21032.178	
6802	-103716.688	-21029.690	2.488
6801	-103716.748	-21027.214	2.476
5679	-103717.099	-21009.186	18.031
5678	-103714.875	-21009.152	2.224
5677	-103710.613	-21008.571	4.301
6811	-103708.837	-21018.681	10.264
6809	-103706.396	-21030.128	11.704
4913	-103710.152	-21030.880	3.830
6803	-103716.646	-21032.178	6.622
面積	186.7861685		
地積	186.78 m <sup>2</sup>		

## 2616

地番 幡四七〇ノ九			
NO	X	Y	辺長
7764	-103735.454	-21031.077	
7765	-103735.541	-21026.684	4.393
6807	-103733.564	-21028.513	2.693
6806	-103726.678	-21028.086	6.899
4519	-103718.669	-21027.620	8.022
6801	-103716.748	-21027.214	1.963
6802	-103716.688	-21029.690	2.476
6805	-103718.350	-21030.028	1.696
7764	-103735.454	-21031.077	17.136
面積	47.8257760		
地積	47.82 m <sup>2</sup>		

## 2617

地番 幡四七〇ノ一〇			
NO	X	Y	辺長
7763	-103735.406	-21033.521	
7764	-103735.454	-21031.077	2.444
6805	-103718.350	-21030.028	17.136
6802	-103716.688	-21029.690	1.696
6803	-103716.646	-21032.178	2.488
6804	-103718.032	-21032.447	1.411
6808	-103726.608	-21032.951	8.590
7763	-103735.406	-21033.521	8.816
面積	45.6775830		

2620

地番 幡四七四ノ一B			
NO	X	Y	辺長
6800	-103687.232	-21067.814	
6791	-103690.104	-21080.502	13.008
6790	-103690.918	-21089.887	9.420
4919	-103703.164	-21089.883	12.246
7759	-103713.249	-21089.880	10.085
2490	-103714.310	-21080.133	9.804
2489	-103717.430	-21073.206	7.597
7760	-103724.452	-21065.330	10.651
4942	-103706.545	-21067.086	17.992
6800	-103687.232	-21067.814	19.326
面積	617.0688630		
地積	617.06 m <sup>2</sup>		

2621

地番 幡四七七ノ一			
NO	X	Y	辺長
4923	-103691.240	-21106.172	
7758	-103714.726	-21103.370	23.652
2491	-103713.053	-21091.677	11.812
7759	-103713.249	-21089.880	1.807
4919	-103703.164	-21089.883	10.085
4923	-103691.240	-21106.172	20.186
面積	239.9526390		
地積	239.95 m <sup>2</sup>		

2622

地番 幡四七七ノ四			
NO	X	Y	辺長
6479	-103686.953	-21112.027	
6478	-103686.297	-21113.516	1.627
6477	-103702.397	-21125.601	20.131
4931	-103698.544	-21131.424	6.982
6476	-103697.951	-21132.319	1.073
7757	-103705.059	-21137.657	8.889
2501	-103707.565	-21134.305	4.185
2500	-103715.486	-21123.748	13.198
2499	-103716.877	-21118.374	5.551
2492	-103714.962	-21105.016	13.494
7758	-103714.726	-21103.370	1.662
4923	-103691.240	-21106.172	23.652
6479	-103686.953	-21112.027	7.256
面積	601.3863960		
地積	601.38 m <sup>2</sup>		

2623

地番 保三九ノ一			
NO	X	Y	辺長
6476	-103697.951	-21132.319	
4932	-103696.323	-21134.782	2.952
4937	-103695.487	-21136.049	1.517
7756	-103702.385	-21141.232	8.628
7757	-103705.059	-21137.657	4.464
6476	-103697.951	-21132.319	8.889
面積	39.0944860		
地積	39.09 m <sup>2</sup>		

2624

地番 幡五八四ノ二			
NO	X	Y	辺長
4937	-103695.487	-21136.049	
4939	-103693.034	-21139.764	4.451
7755	-103699.726	-21144.789	8.368
7756	-103702.385	-21141.232	4.441
4937	-103695.487	-21136.049	8.628
面積	37.7524440		
地積	37.75 m <sup>2</sup>		

2625

地番 幡四七七ノ二B			
NO	X	Y	辺長
4939	-103693.034	-21139.764	
7754	-103690.890	-21143.009	3.889
3744	-103690.907	-21143.021	0.020
3777	-103694.173	-21145.071	3.856
2617	-103695.293	-21145.735	1.302
2502	-103699.672	-21144.861	4.465
7755	-103699.726	-21144.789	0.090
4939	-103693.034	-21139.764	8.368
面積	24.5703490		
地積	24.57 m <sup>2</sup>		

2626

地番 幡三八八ノ三 幡四七八			
NO	X	Y	辺長
7754	-103690.890	-21143.009	
4939	-103693.034	-21139.764	3.889
4937	-103695.487	-21136.049	4.451
4932	-103696.323	-21134.782	1.517
4933	-103693.900	-21132.477	3.344
4930	-103696.135	-21129.134	4.021
4929	-103693.214	-21124.479	5.495
6482	-103684.206	-21119.249	10.416
4941	-103682.241	-21118.518	2.096
7753	-103674.373	-21131.279	14.991
3746	-103677.193	-21133.489	3.582
3745	-103687.223	-21140.402	12.181
7754	-103690.890	-21143.009	4.499
面積	305.2508120		
地積	305.25 m <sup>2</sup>		

2627

地番 保三九ノ二			
NO	X	Y	辺長
4931	-103698.544	-21131.424	
4930	-103696.135	-21129.134	3.323
4933	-103693.900	-21132.477	4.021
4932	-103696.323	-21134.782	3.344
6476	-103697.951	-21132.319	2.952
4931	-103698.544	-21131.424	1.073
面積	13.2118885		
地積	13.21 m <sup>2</sup>		

2628

地番 幡四七七ノ二A			
NO	X	Y	辺長
6477	-103702.397	-21125.601	
6478	-103686.297	-21113.516	20.131
6482	-103684.206	-21119.249	6.102
4929	-103693.214	-21124.479	10.416
4930	-103696.135	-21129.134	5.495
4931	-103698.544	-21131.424	3.323
6477	-103702.397	-21125.601	6.982
面積	108.9058145		
地積	108.90 m <sup>2</sup>		


2629

地番 幡四七九			
NO	X	Y	辺長
7752	-103664.893	-21123.031	
3749	-103668.829	-21126.666	5.357
3748	-103671.899	-21129.255	4.015
3747	-103673.986	-21130.975	2.704
7753	-103674.373	-21131.279	0.492
4941	-103682.241	-21118.518	14.991
6474	-103679.914	-21117.653	2.482
6473	-103678.184	-21116.725	1.963
6472	-103675.009	-21114.629	3.804
6471	-103674.277	-21114.153	0.873
6468	-103672.787	-21114.029	1.495
7752	-103664.893	-21123.031	11.972
面積	155.0379575		
地積	155.03 m <sup>2</sup>		

2630

地番 幡四八〇ノ二			
NO	X	Y	辺長
7751	-103662.971	-21120.959	
3750	-103664.782	-21122.928	2.675
7752	-103664.893	-21123.031	0.151
6468	-103672.787	-21114.029	11.972
6471	-103674.277	-21114.153	1.495
6472	-103675.009	-21114.629	0.873
6473	-103678.184	-21116.725	3.804
6474	-103679.914	-21117.653	1.963
4941	-103682.241	-21118.518	2.482
6482	-103684.206	-21119.249	2.096
6478	-103686.297	-21113.516	6.102
6479	-103686.953	-21112.027	1.627
6480	-103685.328	-21106.618	5.647
6481	-103683.589	-21102.058	4.880
6470	-103682.250	-21100.313	2.199
4917	-103681.478	-21099.871	0.889
7751	-103662.971	-21120.959	28.057
面積	204.3307595		
地積	204.33 m <sup>2</sup>		

図面の種類	画地出来形確認測量図		
街区名	39	2/2	求積表
町名	岩倉幡枝町		
京都市洛北第三土地区画整理組合			

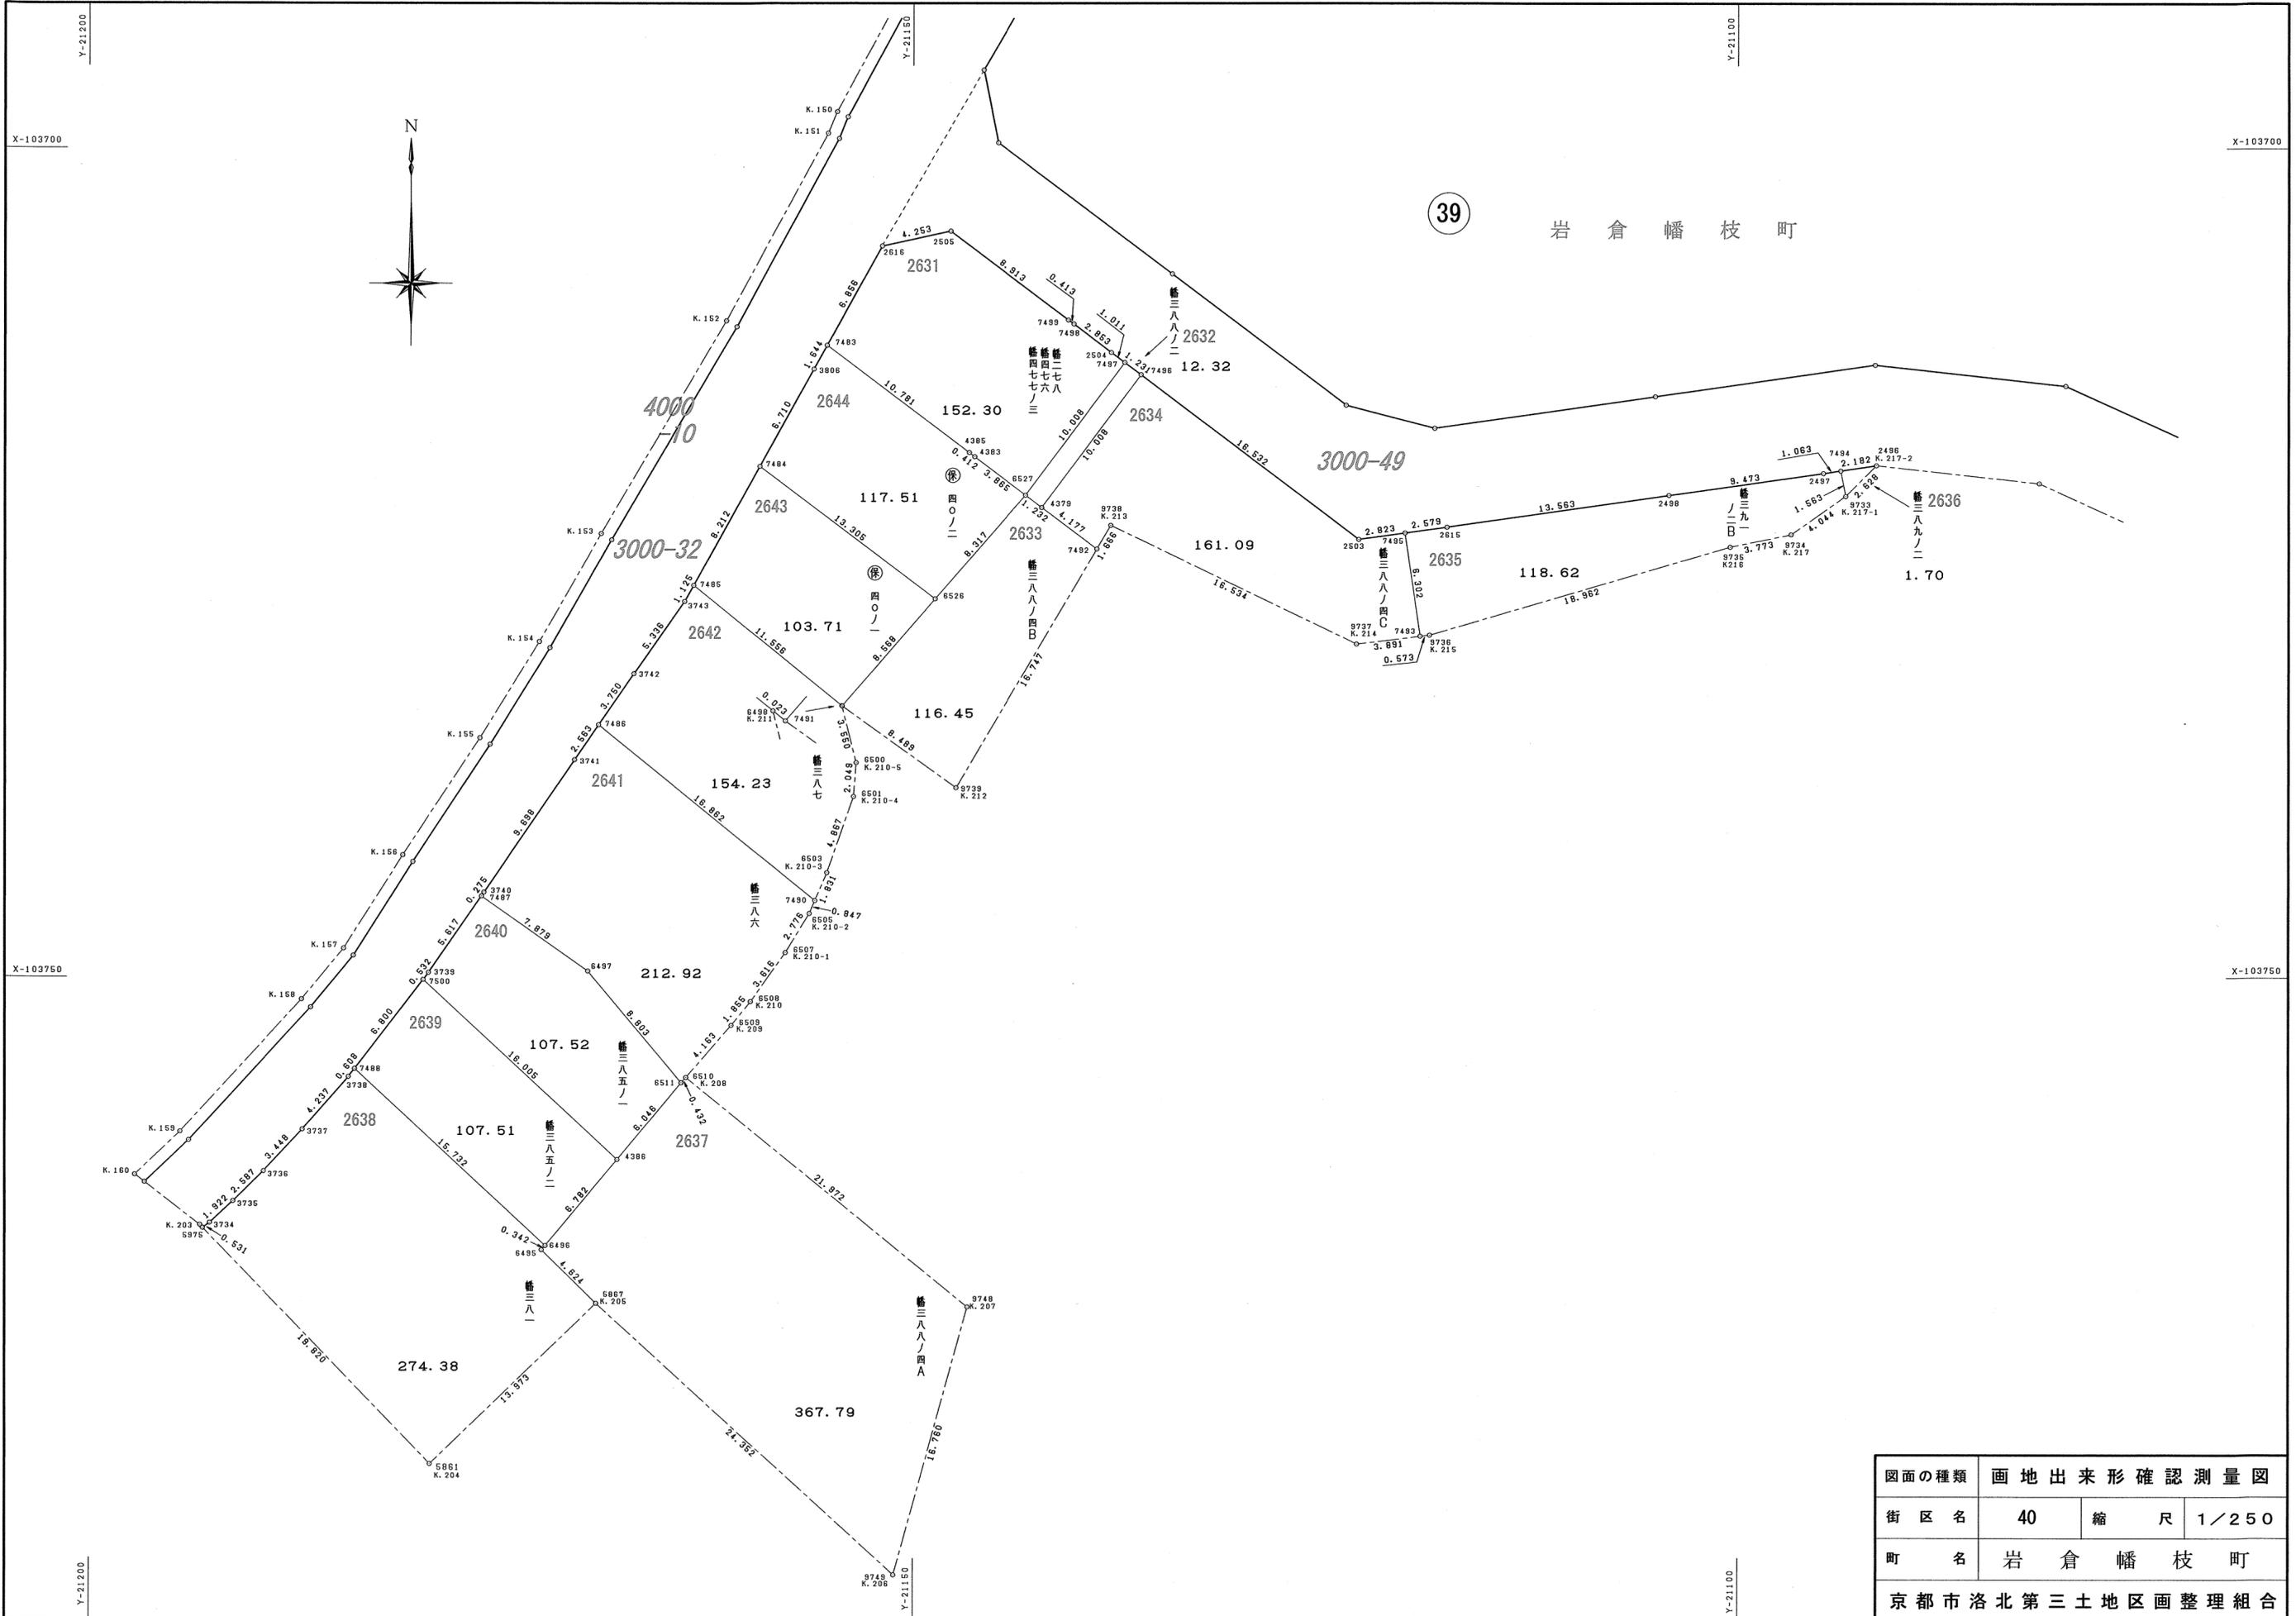

39

岩倉幡枝町

図面の種類	画地出来形確認測量図		
街区名	40	縮尺	1/250
町名	岩倉幡枝町		
京都市洛北第三土地区画整理組合			

2631

地番 幡二七八 幡四七六 幡四七七ノ三			
N O	X	Y	辺長
7497	-103712.912	-21137.181	
2504	-103712.305	-21137.990	1.011
7498	-103710.595	-21140.274	2.853
7499	-103710.347	-21140.605	0.413
2505	-103705.005	-21147.740	8.913
2616	-103705.895	-21151.899	4.253
7483	-103711.883	-21155.240	6.856
4385	-103718.350	-21146.613	10.781
4383	-103718.598	-21146.283	0.412
6527	-103720.916	-21143.190	3.865
7497	-103712.912	-21137.181	10.008
面積	152.3001560		
地積	152.30 m <sup>2</sup>		

2632

地番 幡三八八ノ二			
N O	X	Y	辺長
7497	-103712.912	-21137.181	
6527	-103720.916	-21143.190	10.008
4379	-103721.655	-21142.204	1.232
7496	-103713.651	-21136.196	10.008
7497	-103712.912	-21137.181	1.231
面積	12.3282235		
地積	12.32 m <sup>2</sup>		

2633

地番 幡三八八ノ四B			
N O	X	Y	辺長
6527	-103720.916	-21143.190	
6526	-103727.172	-21148.671	8.317
7491	-103733.630	-21154.302	8.568
9739	-103738.570	-21147.398	8.489
7492	-103724.161	-21138.862	16.747
4379	-103721.655	-21142.204	4.177
6527	-103720.916	-21143.190	1.232
面積	116.4510740		
地積	116.45 m <sup>2</sup>		

2634

地番 幡三八八ノ四C			
N O	X	Y	辺長
7496	-103713.651	-21136.196	
4379	-103721.655	-21142.204	10.008
7492	-103724.161	-21138.862	4.177
9738	-103722.727	-21138.012	1.666
9737	-103728.890	-21123.110	16.534
7493	-103728.421	-21119.247	3.891
7495	-103723.187	-21120.176	6.302
2503	-103723.574	-21122.973	2.823
7496	-103713.651	-21136.196	16.532
面積	161.0904135		
地積	161.09 m <sup>2</sup>		

2635

地番 幡三九一ノ二B			
N O	X	Y	辺長
7495	-103723.187	-21120.176	
7493	-103728.421	-21119.247	6.302
9736	-103728.352	-21118.678	0.573
9735	-103724.025	-21100.479	18.962
9734	-103723.281	-21096.780	3.773
9733	-103720.968	-21093.462	4.044
7494	-103719.433	-21093.761	1.563
2497	-103719.591	-21094.813	1.063
2498	-103720.922	-21104.193	9.473
2615	-103722.833	-21117.621	13.563
7495	-103723.187	-21120.176	2.579
面積	118.6287205		
地積	118.62 m <sup>2</sup>		

2636

地番 幡三八九ノ二			
N O	X	Y	辺長
7494	-103719.433	-21093.761	
9733	-103720.968	-21093.462	1.563
2496	-103719.110	-21091.603	2.628
7494	-103719.433	-21093.761	2.182
面積	1.7045535		
地積	1.70 m <sup>2</sup>		

2637

地番 幡三八八ノ四A			
N O	X	Y	辺長
6510	-103756.036	-21163.759	
6511	-103756.357	-21164.049	0.432
4386	-103760.990	-21167.935	6.046
6496	-103766.186	-21172.295	6.782
6495	-103766.441	-21172.524	0.342
5867	-103769.671	-21169.215	4.624
9749	-103786.032	-21151.177	24.352
9748	-103769.881	-21146.697	16.760
6510	-103756.036	-21163.759	21.972
面積	367.7981765		
地積	367.79 m <sup>2</sup>		

2638

地番 幡三八一			
N O	X	Y	辺長
7488	-103755.524	-21183.864	
3738	-103756.005	-21184.236	0.608
3737	-103759.185	-21187.037	4.237
3736	-103761.700	-21189.396	3.448
3735	-103763.512	-21191.243	2.587
3734	-103764.808	-21192.663	1.922
5975	-103765.121	-21193.093	0.531
5861	-103779.349	-21179.294	19.820
5867	-103769.671	-21169.215	13.973
6495	-103766.441	-21172.524	4.624
6496	-103766.186	-21172.295	0.342
7488	-103755.524	-21183.864	15.732
面積	274.3869840		
地積	274.38 m <sup>2</sup>		

2639

地番 幡三八五ノ二			
N O	X	Y	辺長
7488	-103755.524	-21183.864	
6496	-103766.186	-21172.295	15.732
4386	-103760.990	-21167.935	6.782
7500	-103750.144	-21179.705	16.005
7488	-103755.524	-21183.864	6.800
面積	107.5149790		
地積	107.51 m <sup>2</sup>		

2640

地番 幡三八五ノ一			
N O	X	Y	辺長
7500	-103750.144	-21179.705	
4386	-103760.990	-21167.935	16.005
6511	-103756.357	-21164.049	6.046
6497	-103749.628	-21169.726	8.803
7487	-103745.106	-21176.179	7.879
3739	-103749.723	-21179.378	5.617
7500	-103750.144	-21179.705	0.532
面積	107.5264165		
地積	107.52 m <sup>2</sup>		

2641

地番 幡三八六			
N O	X	Y	辺長
7487	-103745.106	-21176.179	
6497	-103749.628	-21169.726	7.879
6511	-103756.357	-21164.049	8.803
6510	-103756.036	-21163.759	0.432
6509	-103752.895	-21161.026	4.163
6508	-103751.458	-21159.852	1.855
6507	-103748.521	-21157.742	3.616
6505	-103746.154	-21156.291	2.776
7490	-103745.376	-21155.955	0.847
7486	-103734.778	-21169.071	16.862
3741	-103736.886	-21170.530	2.563
3740	-103744.880	-21176.022	9.698
7487	-103745.106	-21176.179	0.275
面積	212.9235215		
地積	212.92 m <sup>2</sup>		

2642

地番 幡三八七			
N O	X	Y	辺長
6498	-103733.617	-21154.321	
7485	-103726.353	-21163.309	11.556
3743	-103727.336	-21163.857	1.125
3742	-103731.695	-21166.936	5.336
7486	-103734.778	-21169.071	3.750
7490	-103745.376	-21155.955	16.862
6503	-103743.694	-21155.230	1.831
6501	-103739.103	-21153.614	4.867
6500	-103737.060	-21153.454	2.049
6498	-103733.617	-21154.321	3.550
面積	154.2382255		
地積	154.23 m <sup>2</sup>		


2643

地番 保四〇ノ一			
N O	X	Y	辺長
7485	-103726.353	-21163.309	
6498	-103733.617	-21154.321	11.556
7491	-103733.630	-21154.302	0.023
6526	-103727.172	-21148.671	8.568
7484	-103719.180	-21159.309	13.305
7485	-103726.353	-21163.309	8.212
面積	103.7197695		
地積	103.71 m <sup>2</sup>		

2644

地番 保四〇ノ二			
N O	X	Y	辺長
7484	-103719.180	-21159.309	
6526	-103727.172	-21148.671	13.305
6527	-103720.916	-21143.190	8.317
4383	-103718.598	-21146.283	3.865
4385	-103718.350	-21146.613	0.412
7483	-103711.883	-21155.240	10.781
3806	-103713.319	-21156.041	1.644
7484	-103719.180	-21159.309	6.710
面積	117.5198185		
地積	117.51 m <sup>2</sup>		

図面の種類	画地出来形確認測量図		
街区名	40	求積表	
町名	岩倉幡枝町		
京都市洛北第三土地区画整理組合			

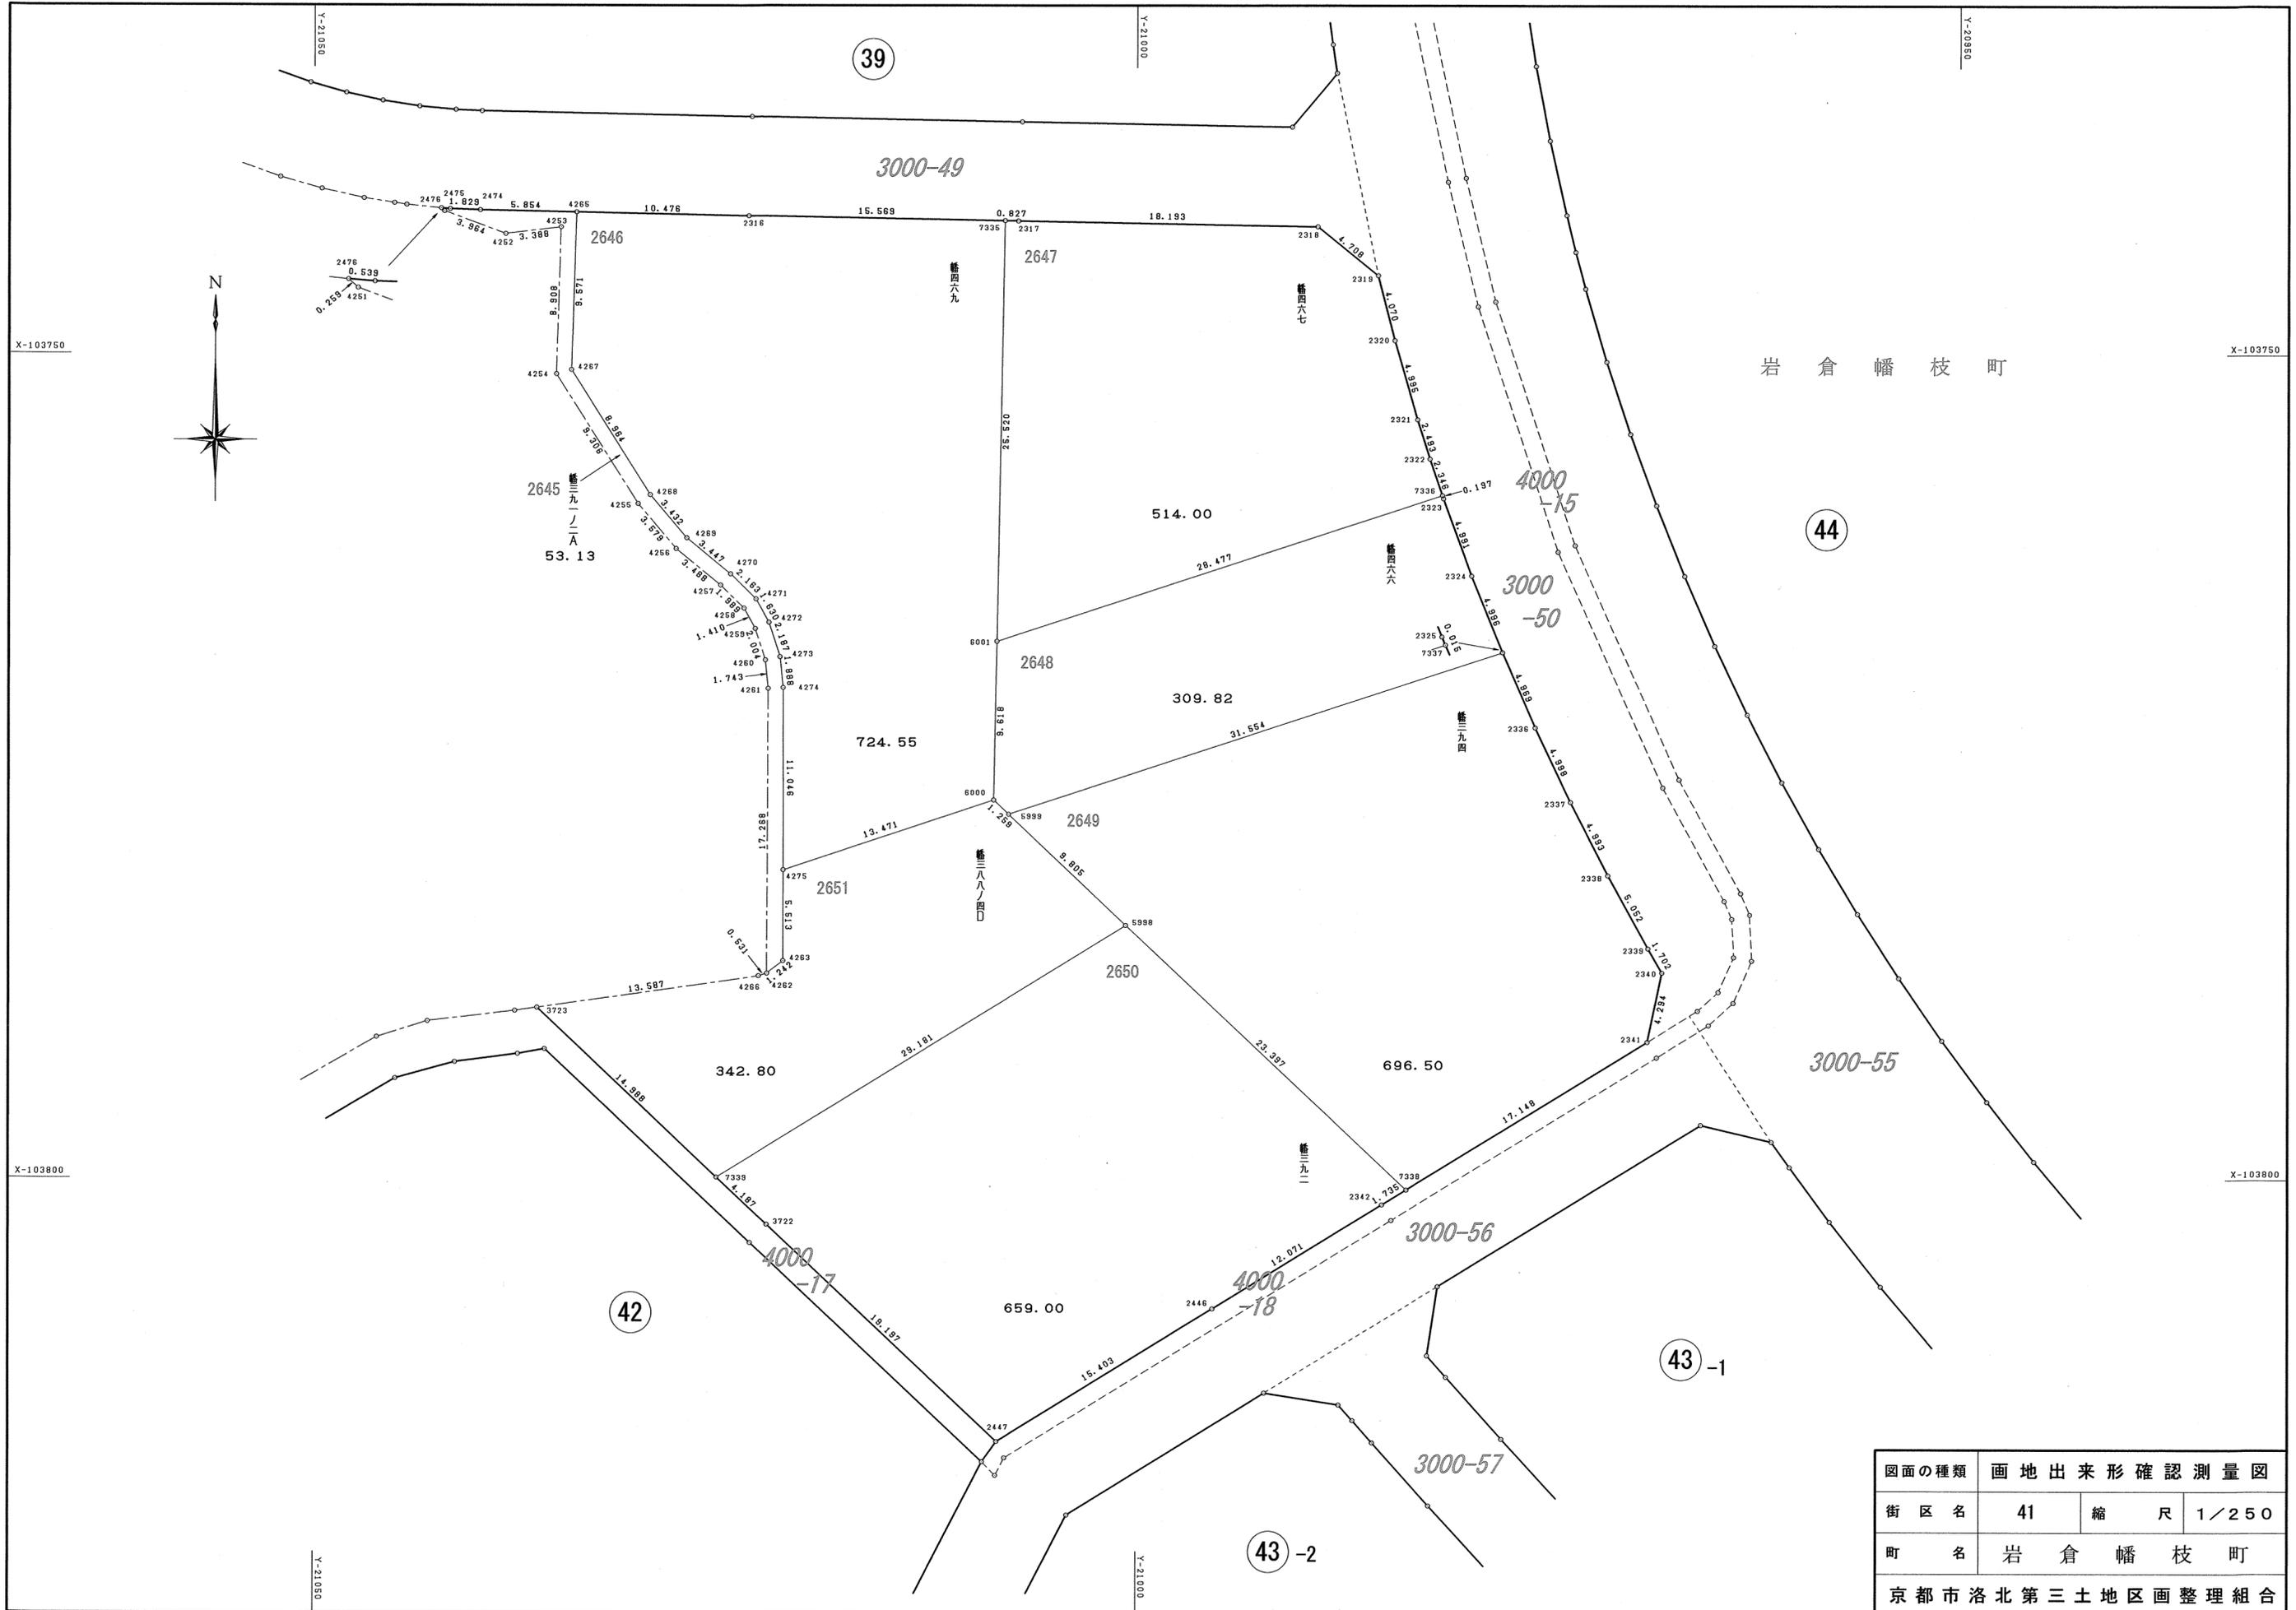

岩倉幡枝町

図面の種類	画地出来形確認測量図		
街区名	41	縮尺	1/250
町名	岩倉幡枝町		
京都市洛北第三土地区画整理組合			

2645

地番 幡三九一ノ二A			
NO	X	Y	辺長
2476	-103741.183	-21042.302	
4251	-103741.353	-21042.106	0.259
4252	-103742.721	-21038.385	3.964
4253	-103742.316	-21035.021	3.388
4254	-103751.221	-21035.287	8.908
4255	-103759.084	-21030.308	9.306
4256	-103761.811	-21027.989	3.579
4257	-103764.018	-21025.287	3.488
4258	-103765.411	-21023.867	1.989
4259	-103766.645	-21023.183	1.410
4260	-103768.552	-21022.564	2.004
4261	-103770.286	-21022.381	1.743
4262	-103787.554	-21022.450	17.268
4263	-103786.799	-21021.463	1.242
4275	-103781.286	-21021.466	5.513
4274	-103770.240	-21021.472	11.046
4273	-103768.362	-21021.670	1.888
4272	-103766.281	-21022.345	2.187
4271	-103764.855	-21023.136	1.630
4270	-103763.340	-21024.680	2.163
4269	-103761.159	-21027.350	3.447
4268	-103758.544	-21029.574	3.432
4267	-103750.970	-21034.370	8.964
4265	-103741.403	-21034.083	9.571
2474	-103741.285	-21039.936	5.854
2475	-103741.222	-21041.764	1.829
2476	-103741.183	-21042.302	0.539
面積	53.1387965		
地積	53.13 m <sup>2</sup>		

2646

地番 幡四六九			
NO	X	Y	辺長
4265	-103741.403	-21034.083	
4267	-103750.970	-21034.370	9.571
4268	-103758.544	-21029.574	8.964
4269	-103761.159	-21027.350	3.432
4270	-103763.340	-21024.680	3.447
4271	-103764.855	-21023.136	2.163
4272	-103766.281	-21022.345	1.630
4273	-103768.362	-21021.670	2.187
4274	-103770.240	-21021.472	1.888
4275	-103781.286	-21021.466	11.046
6000	-103777.045	-21008.679	13.471
6001	-103767.428	-21008.496	9.618
7335	-103741.912	-21008.042	25.520
2316	-103741.615	-21023.609	15.569
4265	-103741.403	-21034.083	10.476
面積	724.5550015		
地積	724.55 m <sup>2</sup>		

2647

地番 幡四六七			
NO	X	Y	辺長
7335	-103741.912	-21008.042	
6001	-103767.428	-21008.496	25.520
7336	-103758.558	-20981.435	28.477
2322	-103756.337	-20982.191	2.346
2321	-103753.961	-20982.947	2.493
2320	-103749.163	-20984.338	4.995
2319	-103745.223	-20985.360	4.070
2318	-103742.267	-20989.025	4.708
2317	-103741.928	-21007.215	18.193
7335	-103741.912	-21008.042	0.827
面積	514.0096610		
地積	514.00 m <sup>2</sup>		

2648

地番 幡四六六			
NO	X	Y	辺長
7336	-103758.558	-20981.435	
6001	-103767.428	-21008.496	28.477
6000	-103777.045	-21008.679	9.618
5999	-103777.910	-21007.763	1.259
7337	-103768.079	-20977.779	31.554
2325	-103768.065	-20977.785	0.015
2324	-103763.432	-20979.655	4.996
2323	-103758.745	-20981.371	4.991
7336	-103758.558	-20981.435	0.197
面積	309.8239365		
地積	309.82 m <sup>2</sup>		

2649

地番 幡三九四			
NO	X	Y	辺長
7337	-103768.079	-20977.779	
5999	-103777.910	-21007.763	31.554
5998	-103784.643	-21000.634	9.805
7338	-103800.664	-20983.582	23.397
2341	-103791.691	-20968.968	17.148
2340	-103787.490	-20968.076	4.294
2339	-103786.013	-20968.922	1.702
2338	-103781.589	-20971.362	5.052
2337	-103777.148	-20973.646	4.993
2336	-103772.631	-20975.786	4.998
7337	-103768.079	-20977.779	4.969
面積	696.5083655		
地積	696.50 m <sup>2</sup>		

2650

地番 幡三九二			
NO	X	Y	辺長
7338	-103800.664	-20983.582	
5998	-103784.643	-21000.634	23.397
7339	-103799.918	-21025.498	29.181
3722	-103802.789	-21022.450	4.187
2447	-103815.950	-21008.474	19.197
2446	-103807.886	-20995.350	15.403
2342	-103801.572	-20985.061	12.071
7338	-103800.664	-20983.582	1.735
面積	659.0058010		
地積	659.00 m <sup>2</sup>		


2651

地番 幡三八八ノ四D			
NO	X	Y	辺長
4275	-103781.286	-21021.466	
4263	-103786.799	-21021.463	5.513
4262	-103787.554	-21022.450	1.242
4266	-103787.713	-21022.957	0.531
3723	-103789.640	-21036.407	13.587
7339	-103799.918	-21025.498	14.988
5998	-103784.643	-21000.634	29.181
5999	-103777.910	-21007.763	9.805
6000	-103777.045	-21008.679	1.259
4275	-103781.286	-21021.466	13.471
面積	342.8074685		
地積	342.80 m <sup>2</sup>		

図面の種類	画地出来形確認測量図	
街区名	41	求積表
町名	岩倉幡枝町	
京都市洛北第三土地区画整理組合		



岩倉幡枝町

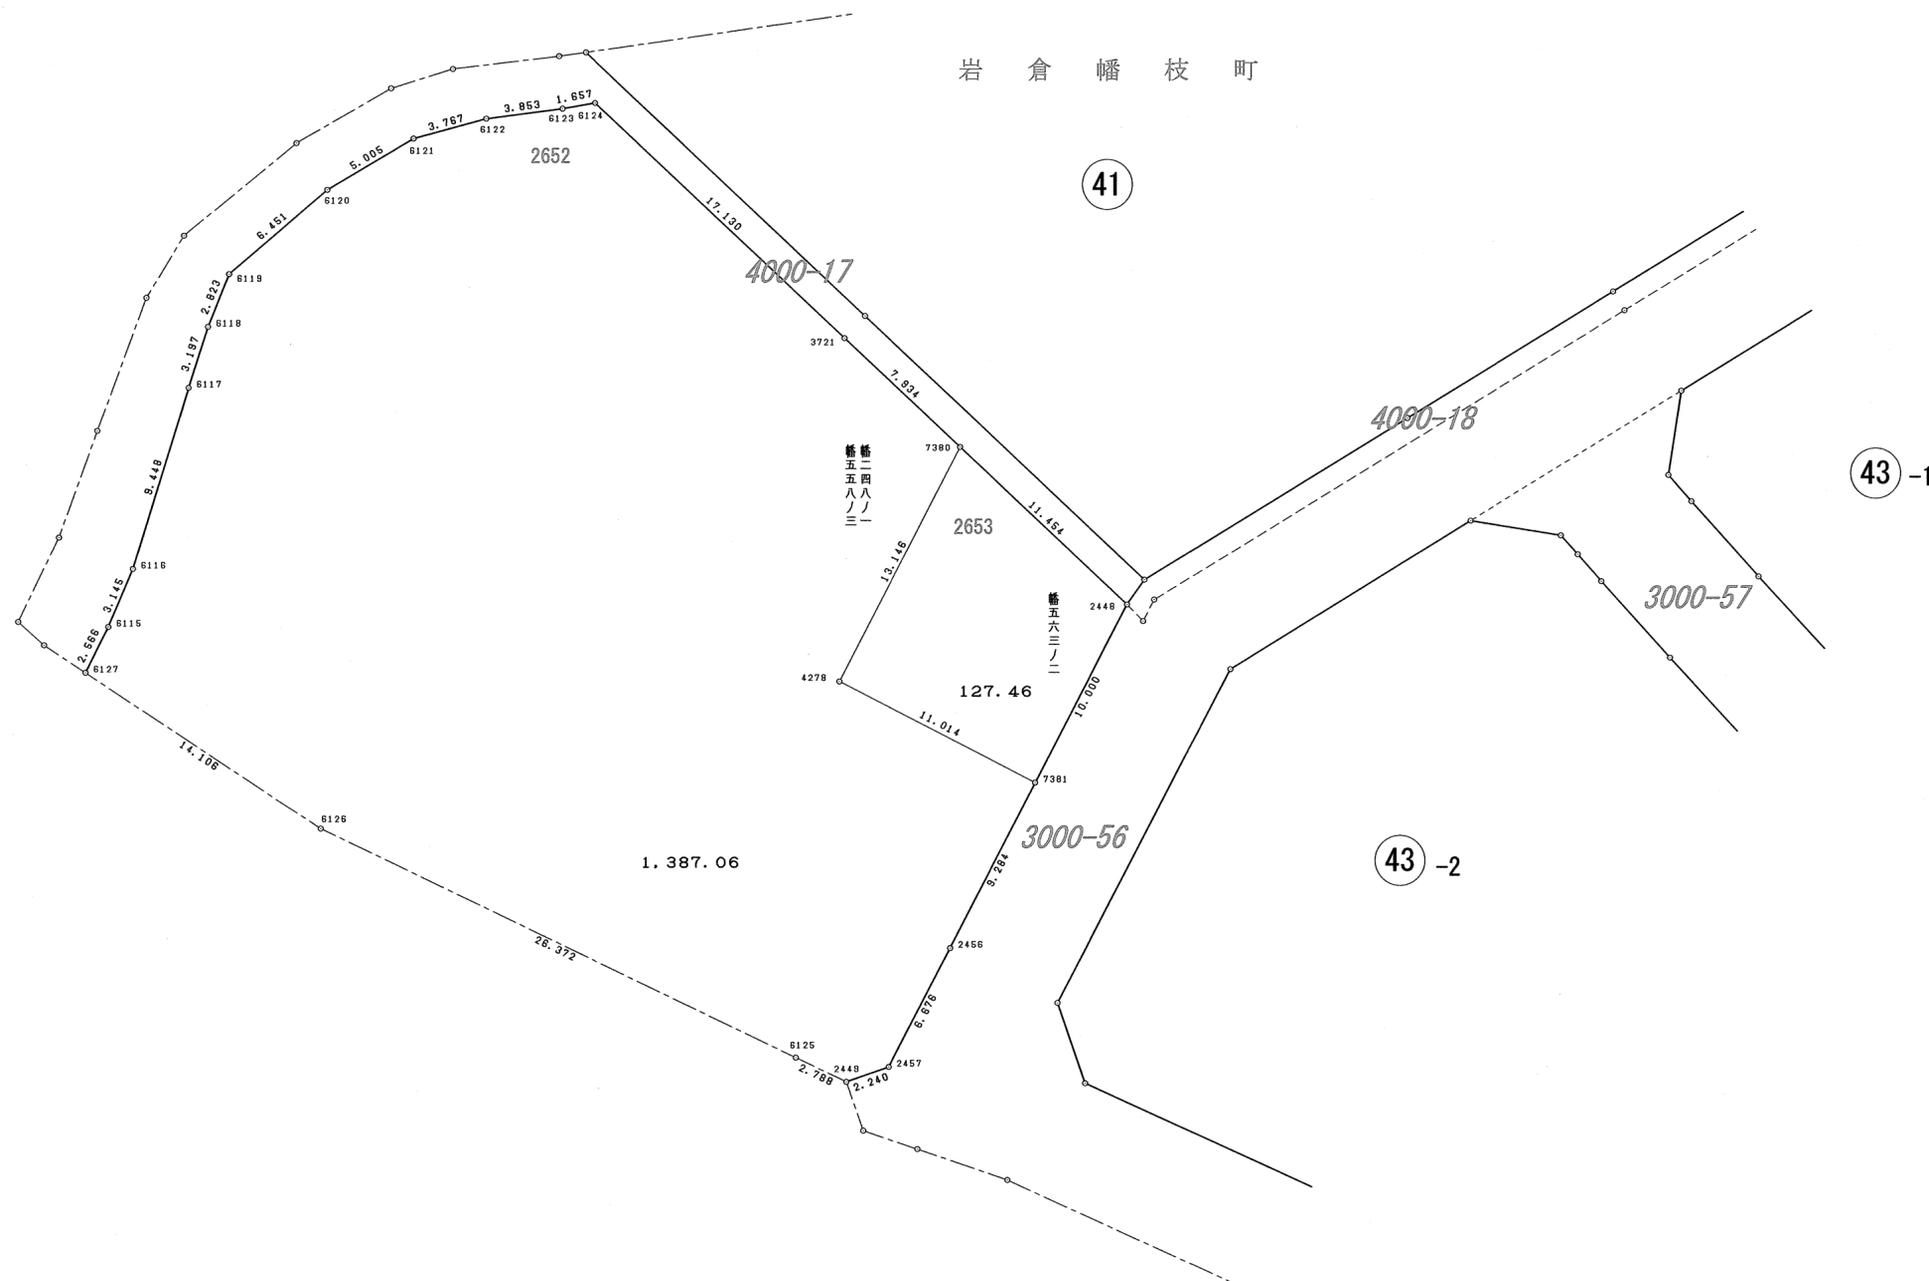

41

43-1

43-2

図面の種類	画地出来形確認測量図		
街区名	42	縮尺	1/250
町名	岩倉幡枝町		
京都市洛北第三土地区画整理組合			

2652

地番	幡二四八ノ一 幡五五八ノ三		
N O	X	Y	辺長
7380	-103809.328	-21017.692	
3721	-103803.890	-21023.470	7.934
6124	-103792.153	-21035.948	17.130
6123	-103792.446	-21037.579	1.657
6122	-103792.942	-21041.400	3.853
6121	-103793.938	-21045.033	3.767
6120	-103796.488	-21049.340	5.005
6119	-103800.674	-21054.249	6.451
6118	-103803.299	-21055.289	2.823
6117	-103806.344	-21056.266	3.197
6116	-103815.373	-21059.051	9.448
6115	-103818.268	-21060.280	3.145
6127	-103820.562	-21061.430	2.566
6126	-103828.337	-21049.659	14.106
6125	-103839.775	-21025.896	26.372
2449	-103840.976	-21023.379	2.788
2457	-103840.245	-21021.261	2.240
2456	-103834.314	-21018.196	6.676
7381	-103826.064	-21013.937	9.284
4278	-103821.010	-21023.723	11.014
7380	-103809.328	-21017.692	13.146
面積	1387.0692305		
地積	1387.06 m <sup>2</sup>		

2653

地番	幡五六三ノ二		
N O	X	Y	辺長
2448	-103817.178	-21009.350	
7380	-103809.328	-21017.692	11.454
4278	-103821.010	-21023.723	13.146
7381	-103826.064	-21013.937	11.014
2448	-103817.178	-21009.350	10.000
面積	127.4678440		
地積	127.46 m <sup>2</sup>		

図面の種類	画地出来形確認測量図	
街区名	42	求積表
町名	岩倉幡枝町	
京都市洛北第三土地区画整理組合		