



2706

| 地番   | 幅三九五ノ一<br>幅五五二 | 幅三九六ノ一七    |        |
|------|----------------|------------|--------|
| N O  | X              | Y          | 辺 長    |
| 7420 | -103818.661    | -20975.120 |        |
| 4345 | -103811.263    | -20967.046 | 10.950 |
| 6351 | -103810.319    | -20966.016 | 1.397  |
| 6352 | -103802.618    | -20972.958 | 10.368 |
| 7417 | -103801.680    | -20973.778 | 1.245  |
| 7418 | -103802.415    | -20974.975 | 1.404  |
| 2343 | -103806.517    | -20981.652 | 7.836  |
| 7419 | -103808.303    | -20981.927 | 1.807  |
| 2437 | -103810.719    | -20982.299 | 2.444  |
| 2436 | -103812.020    | -20981.145 | 1.739  |
| 2435 | -103815.767    | -20977.785 | 5.032  |
| 7420 | -103818.661    | -20975.120 | 3.934  |
| 面積   | 153.0831025    |            |        |
| 地積   | 153.08         |            | ㎡      |

2707

| 地番   | 幅三九六ノ二      |            |        |
|------|-------------|------------|--------|
| N O  | X           | Y          | 辺 長    |
| 2344 | -103796.718 | -20965.700 |        |
| 7417 | -103801.680 | -20973.778 | 9.480  |
| 6352 | -103802.618 | -20972.958 | 1.245  |
| 6351 | -103810.319 | -20966.016 | 10.368 |
| 6350 | -103810.407 | -20965.934 | 0.120  |
| 6349 | -103811.020 | -20965.370 | 0.832  |
| 6348 | -103812.504 | -20963.968 | 2.041  |
| 6353 | -103812.609 | -20963.858 | 0.152  |
| 7437 | -103805.999 | -20955.147 | 10.934 |
| 2347 | -103802.568 | -20957.860 | 4.374  |
| 2346 | -103799.262 | -20960.298 | 4.107  |
| 2345 | -103797.729 | -20961.397 | 1.886  |
| 2344 | -103796.718 | -20965.700 | 4.420  |
| 面積   | 158.6966875 |            |        |
| 地積   | 158.69      |            | ㎡      |

2708

| 地番   | 幅三九六ノ三      |            |        |
|------|-------------|------------|--------|
| N O  | X           | Y          | 辺 長    |
| 7437 | -103805.999 | -20955.147 |        |
| 6353 | -103812.609 | -20963.858 | 10.934 |
| 6354 | -103812.931 | -20963.561 | 0.438  |
| 6355 | -103814.506 | -20962.014 | 2.207  |
| 6356 | -103817.968 | -20958.649 | 4.827  |
| 6357 | -103818.996 | -20957.597 | 1.470  |
| 6358 | -103819.197 | -20957.403 | 0.279  |
| 6359 | -103821.360 | -20955.205 | 3.083  |
| 6360 | -103823.153 | -20953.325 | 2.597  |
| 6361 | -103823.240 | -20953.247 | 0.116  |
| 7436 | -103816.560 | -20945.757 | 10.036 |
| 2350 | -103814.031 | -20948.190 | 3.509  |
| 2349 | -103810.307 | -20951.523 | 4.997  |
| 2348 | -103806.493 | -20954.756 | 4.999  |
| 7437 | -103805.999 | -20955.147 | 0.630  |
| 面積   | 151.6554310 |            |        |
| 地積   | 151.65      |            | ㎡      |

2709

| 地番   | 幅三九六ノ四      |            |        |
|------|-------------|------------|--------|
| N O  | X           | Y          | 辺 長    |
| 7436 | -103816.560 | -20945.757 |        |
| 6361 | -103823.240 | -20953.247 | 10.036 |
| 6430 | -103824.114 | -20952.321 | 1.273  |
| 6431 | -103824.693 | -20951.709 | 0.842  |
| 6432 | -103827.321 | -20948.861 | 3.875  |
| 6433 | -103827.680 | -20948.476 | 0.526  |
| 6434 | -103827.969 | -20948.150 | 0.435  |
| 6435 | -103831.206 | -20944.556 | 4.836  |
| 6382 | -103834.273 | -20941.056 | 4.653  |
| 7435 | -103826.886 | -20934.713 | 9.736  |
| 2353 | -103824.509 | -20937.488 | 3.653  |
| 2352 | -103821.138 | -20941.177 | 4.997  |
| 2351 | -103817.630 | -20944.728 | 4.991  |
| 7436 | -103816.560 | -20945.757 | 1.484  |
| 面積   | 154.4968600 |            |        |
| 地積   | 154.49      |            | ㎡      |

2710

| 地番   | 保四三ノ一ノ一     |            |        |
|------|-------------|------------|--------|
| N O  | X           | Y          | 辺 長    |
| 7435 | -103826.886 | -20934.713 |        |
| 6382 | -103834.273 | -20941.056 | 9.736  |
| 6370 | -103835.332 | -20941.945 | 1.382  |
| 6363 | -103835.438 | -20941.810 | 0.171  |
| 6364 | -103835.724 | -20941.462 | 0.450  |
| 6365 | -103836.517 | -20940.525 | 1.227  |
| 6366 | -103838.557 | -20938.089 | 3.177  |
| 6367 | -103841.630 | -20934.331 | 4.854  |
| 6368 | -103843.394 | -20932.103 | 2.841  |
| 6369 | -103843.684 | -20931.733 | 0.470  |
| 7434 | -103834.339 | -20925.161 | 11.424 |
| 2594 | -103833.878 | -20925.808 | 0.794  |
| 2363 | -103830.887 | -20929.804 | 4.991  |
| 2362 | -103827.752 | -20933.702 | 5.002  |
| 7435 | -103826.886 | -20934.713 | 1.331  |
| 面積   | 142.0445400 |            |        |
| 地積   | 142.04      |            | ㎡      |

2711

| 地番   | 保四三ノ一ノ二     |            |        |
|------|-------------|------------|--------|
| N O  | X           | Y          | 辺 長    |
| 7434 | -103834.339 | -20925.161 |        |
| 6369 | -103843.684 | -20931.733 | 11.424 |
| 6373 | -103844.624 | -20930.514 | 1.539  |
| 6374 | -103845.777 | -20929.010 | 1.895  |
| 6375 | -103847.573 | -20926.660 | 2.957  |
| 6376 | -103848.191 | -20925.830 | 1.034  |
| 6377 | -103850.461 | -20922.755 | 3.822  |
| 6378 | -103851.188 | -20921.752 | 1.238  |
| 7433 | -103840.826 | -20915.404 | 12.151 |
| 2365 | -103839.516 | -20917.553 | 2.516  |
| 2364 | -103836.784 | -20921.734 | 4.994  |
| 7434 | -103834.339 | -20925.161 | 4.209  |
| 面積   | 141.8549800 |            |        |
| 地積   | 141.85      |            | ㎡      |

2712

| 地番   | 保四三ノ一ノ三     |            |        |
|------|-------------|------------|--------|
| N O  | X           | Y          | 辺 長    |
| 7433 | -103840.826 | -20915.404 |        |
| 6378 | -103851.188 | -20921.752 | 12.151 |
| 6379 | -103853.294 | -20918.824 | 3.606  |
| 6179 | -103854.982 | -20916.347 | 2.997  |
| 6178 | -103856.031 | -20914.825 | 1.848  |
| 6177 | -103857.801 | -20912.187 | 3.176  |
| 7432 | -103846.217 | -20905.931 | 13.165 |
| 2368 | -103845.009 | -20908.161 | 2.536  |
| 2367 | -103844.583 | -20908.948 | 0.894  |
| 2366 | -103842.115 | -20913.290 | 4.994  |
| 7433 | -103840.826 | -20915.404 | 2.475  |
| 面積   | 142.1412060 |            |        |
| 地積   | 142.14      |            | ㎡      |

2713

| 地番   | 保四三ノ一ノ四     |            |        |
|------|-------------|------------|--------|
| N O  | X           | Y          | 辺 長    |
| 7432 | -103846.217 | -20905.931 |        |
| 6177 | -103857.801 | -20912.187 | 13.165 |
| 6175 | -103858.731 | -20910.777 | 1.689  |
| 6176 | -103861.371 | -20906.706 | 4.852  |
| 7431 | -103863.632 | -20903.085 | 4.268  |
| 2376 | -103853.976 | -20897.855 | 10.981 |
| 2375 | -103849.876 | -20899.173 | 4.306  |
| 7432 | -103846.217 | -20905.931 | 7.684  |
| 面積   | 141.9805135 |            |        |
| 地積   | 141.98      |            | ㎡      |

2714

| 地番   | 幅四〇〇ノ六      |            |        |
|------|-------------|------------|--------|
| N O  | X           | Y          | 辺 長    |
| 2399 | -103870.588 | -20906.853 |        |
| 7431 | -103863.632 | -20903.085 | 7.910  |
| 6176 | -103861.371 | -20906.706 | 4.268  |
| 6175 | -103858.731 | -20910.777 | 4.852  |
| 6177 | -103857.801 | -20912.187 | 1.689  |
| 6178 | -103856.031 | -20914.825 | 3.176  |
| 6179 | -103854.982 | -20916.347 | 1.848  |
| 7430 | -103863.840 | -20922.827 | 10.975 |
| 2402 | -103865.104 | -20920.991 | 2.229  |
| 2401 | -103867.906 | -20916.812 | 5.031  |
| 2409 | -103870.634 | -20912.594 | 5.023  |
| 2400 | -103871.680 | -20910.963 | 1.937  |
| 2399 | -103870.588 | -20906.853 | 4.252  |
| 面積   | 177.2149405 |            |        |
| 地積   | 177.21      |            | ㎡      |

2715

| 地番   | 幅三九六ノ六 幅四〇〇ノ二 |            |        |
|------|---------------|------------|--------|
| N O  | X             | Y          | 辺 長    |
| 7429 | -103857.013   | -20932.346 |        |
| 2411 | -103859.336   | -20929.218 | 3.896  |
| 2403 | -103862.252   | -20925.133 | 5.018  |
| 7430 | -103863.840   | -20922.827 | 2.799  |
| 6179 | -103854.982   | -20916.347 | 10.975 |
| 6379 | -103853.294   | -20918.824 | 2.997  |
| 6378 | -103851.188   | -20921.752 | 3.606  |
| 6377 | -103850.461   | -20922.755 | 1.238  |
| 6376 | -103848.191   | -20925.830 | 3.822  |
| 6375 | -103847.573   | -20926.660 | 1.034  |
| 6374 | -103845.777   | -20929.010 | 2.957  |
| 7428 | -103854.291   | -20935.946 | 10.981 |
| 2412 | -103856.340   | -20933.252 | 3.384  |
| 7429 | -103857.013   | -20932.346 | 1.128  |
| 面積   | 174.8695165   |            |        |
| 地積   | 174.86        |            | ㎡      |

2716

| 地番   | 幅三九五ノ四 幅三九六ノ五 |            |        |
|------|---------------|------------|--------|
| N O  | X             | Y          | 辺 長    |
| 7427 | -103851.999   | -20938.898 |        |
| 2413 | -103853.293   | -20937.258 | 2.089  |
| 7428 | -103854.291   | -20935.946 | 1.648  |
| 6374 | -103845.777   | -20929.010 | 10.981 |
| 6373 | -103844.624   | -20930.514 | 1.895  |
| 6369 | -103843.684   | -20931.733 | 1.539  |
| 6368 | -103843.394   | -20932.103 | 0.470  |
| 6367 | -103841.630   | -20934.331 | 2.841  |
| 6366 | -103838.557   | -20938.089 | 4.854  |
| 6365 | -103836.517   | -20940.525 | 3.177  |
| 7426 | -103844.680   | -20947.853 | 10.969 |
| 2415 | -103846.995   | -20945.100 | 3.596  |
| 2414 | -103850.180   | -20941.203 | 5.032  |
| 7427 | -103851.999   | -20938.898 | 2.936  |
| 面積   | 164.9990335   |            |        |
| 地積   | 164.99        |            | ㎡      |

2717


| 地番   | 幅三九五ノ三 幅三九五ノ五<br>幅三九六ノ一六 |            |        |
|------|--------------------------|------------|--------|
| N O  | X                        | Y          | 辺 長    |
| 7424 | -103836.535              | -20957.110 |        |
| 2418 | -103837.109              | -20956.489 | 0.845  |
| 2417 | -103840.466              | -20952.746 | 5.027  |
| 2416 | -103843.759              | -20948.947 | 5.027  |
| 7425 | -103843.898              | -20948.782 | 0.215  |
| 7426 | -103844.680              | -20947.853 | 1.214  |
| 6365 | -103836.517              | -20940.525 | 10.969 |
| 6364 | -103835.724              | -20941.462 | 1.227  |
| 6363 | -103835.438              | -20941.810 | 0.450  |
| 6370 | -103835.332              | -20941.945 | 0.171  |
| 6382 | -103834.273              | -20941.056 | 1.382  |
| 6435 | -103831.206              | -20944.556 | 4.653  |
| 6434 | -103827.969              | -20948.150 | 4.836  |
| 6433 | -103827.680              | -20948.476 | 0.435  |
| 6432 | -103827.321              | -20948.861 | 0.526  |
| 4353 | -103828.369              | -20949.799 | 1.406  |
| 7424 | -103836.535              | -20957.110 | 10.960 |
| 面積   | 149.8914180              |            |        |
| 地積   | 149.89                   |            | ㎡      |

2718

| 地番   | 幅三九五ノ六 幅三九五ノ七<br>幅三九六ノ一四 幅三九六ノ一五 |            |        |
|------|----------------------------------|------------|--------|
| N O  | X                                | Y          | 辺 長    |
| 7424 | -103836.535                      | -20957.110 |        |
| 4353 | -103828.369                      | -20949.799 | 10.960 |
| 6432 | -103827.321                      | -20948.861 | 1.406  |
| 6431 | -103824.693                      | -20951.709 | 3.875  |
| 6430 | -103824.114                      | -20952.321 | 0.842  |
| 6361 | -103823.240                      | -20953.247 | 1.273  |
| 6360 | -103823.153                      | -20953.325 | 0.116  |
| 6359 | -103821.360                      | -20955.205 | 2.597  |
| 6358 | -103819.197                      | -20957.403 | 3.083  |
| 6357 | -103818.996                      | -20957.597 | 0.279  |
| 4349 | -103819.991                      | -20958.581 | 1.399  |
| 7422 | -103827.788                      | -20966.297 | 10.969 |
| 2420 | -103830.230                      | -20963.824 | 3.475  |
| 7423 | -103832.866                      | -20961.057 | 3.821  |
| 2419 | -103833.697                      | -20960.185 | 1.204  |
| 7424 | -103836.535                      | -20957.110 | 4.184  |
| 面積   | 153.0417460                      |            |        |
| 地積   | 153.04                           |            | ㎡      |

2719

| 地番   | 幅三九五ノ二 幅三九五ノ八<br>幅三九六ノ一三 幅三九六ノ一八 |            |        |
|------|----------------------------------|------------|--------|
| N O  | X                                | Y          | 辺 長    |
| 7422 | -103827.788                      | -20966.297 |        |
| 4348 | -103819.991                      | -20958.581 | 10.969 |
| 6357 | -103818.996                      | -20957.597 | 1.399  |
| 6356 | -103817.968                      | -20958.649 | 1.470  |
| 6355 | -103814.506                      | -20962.014 | 4.827  |
| 6354 | -103812.931                      | -20963.561 | 2.207  |

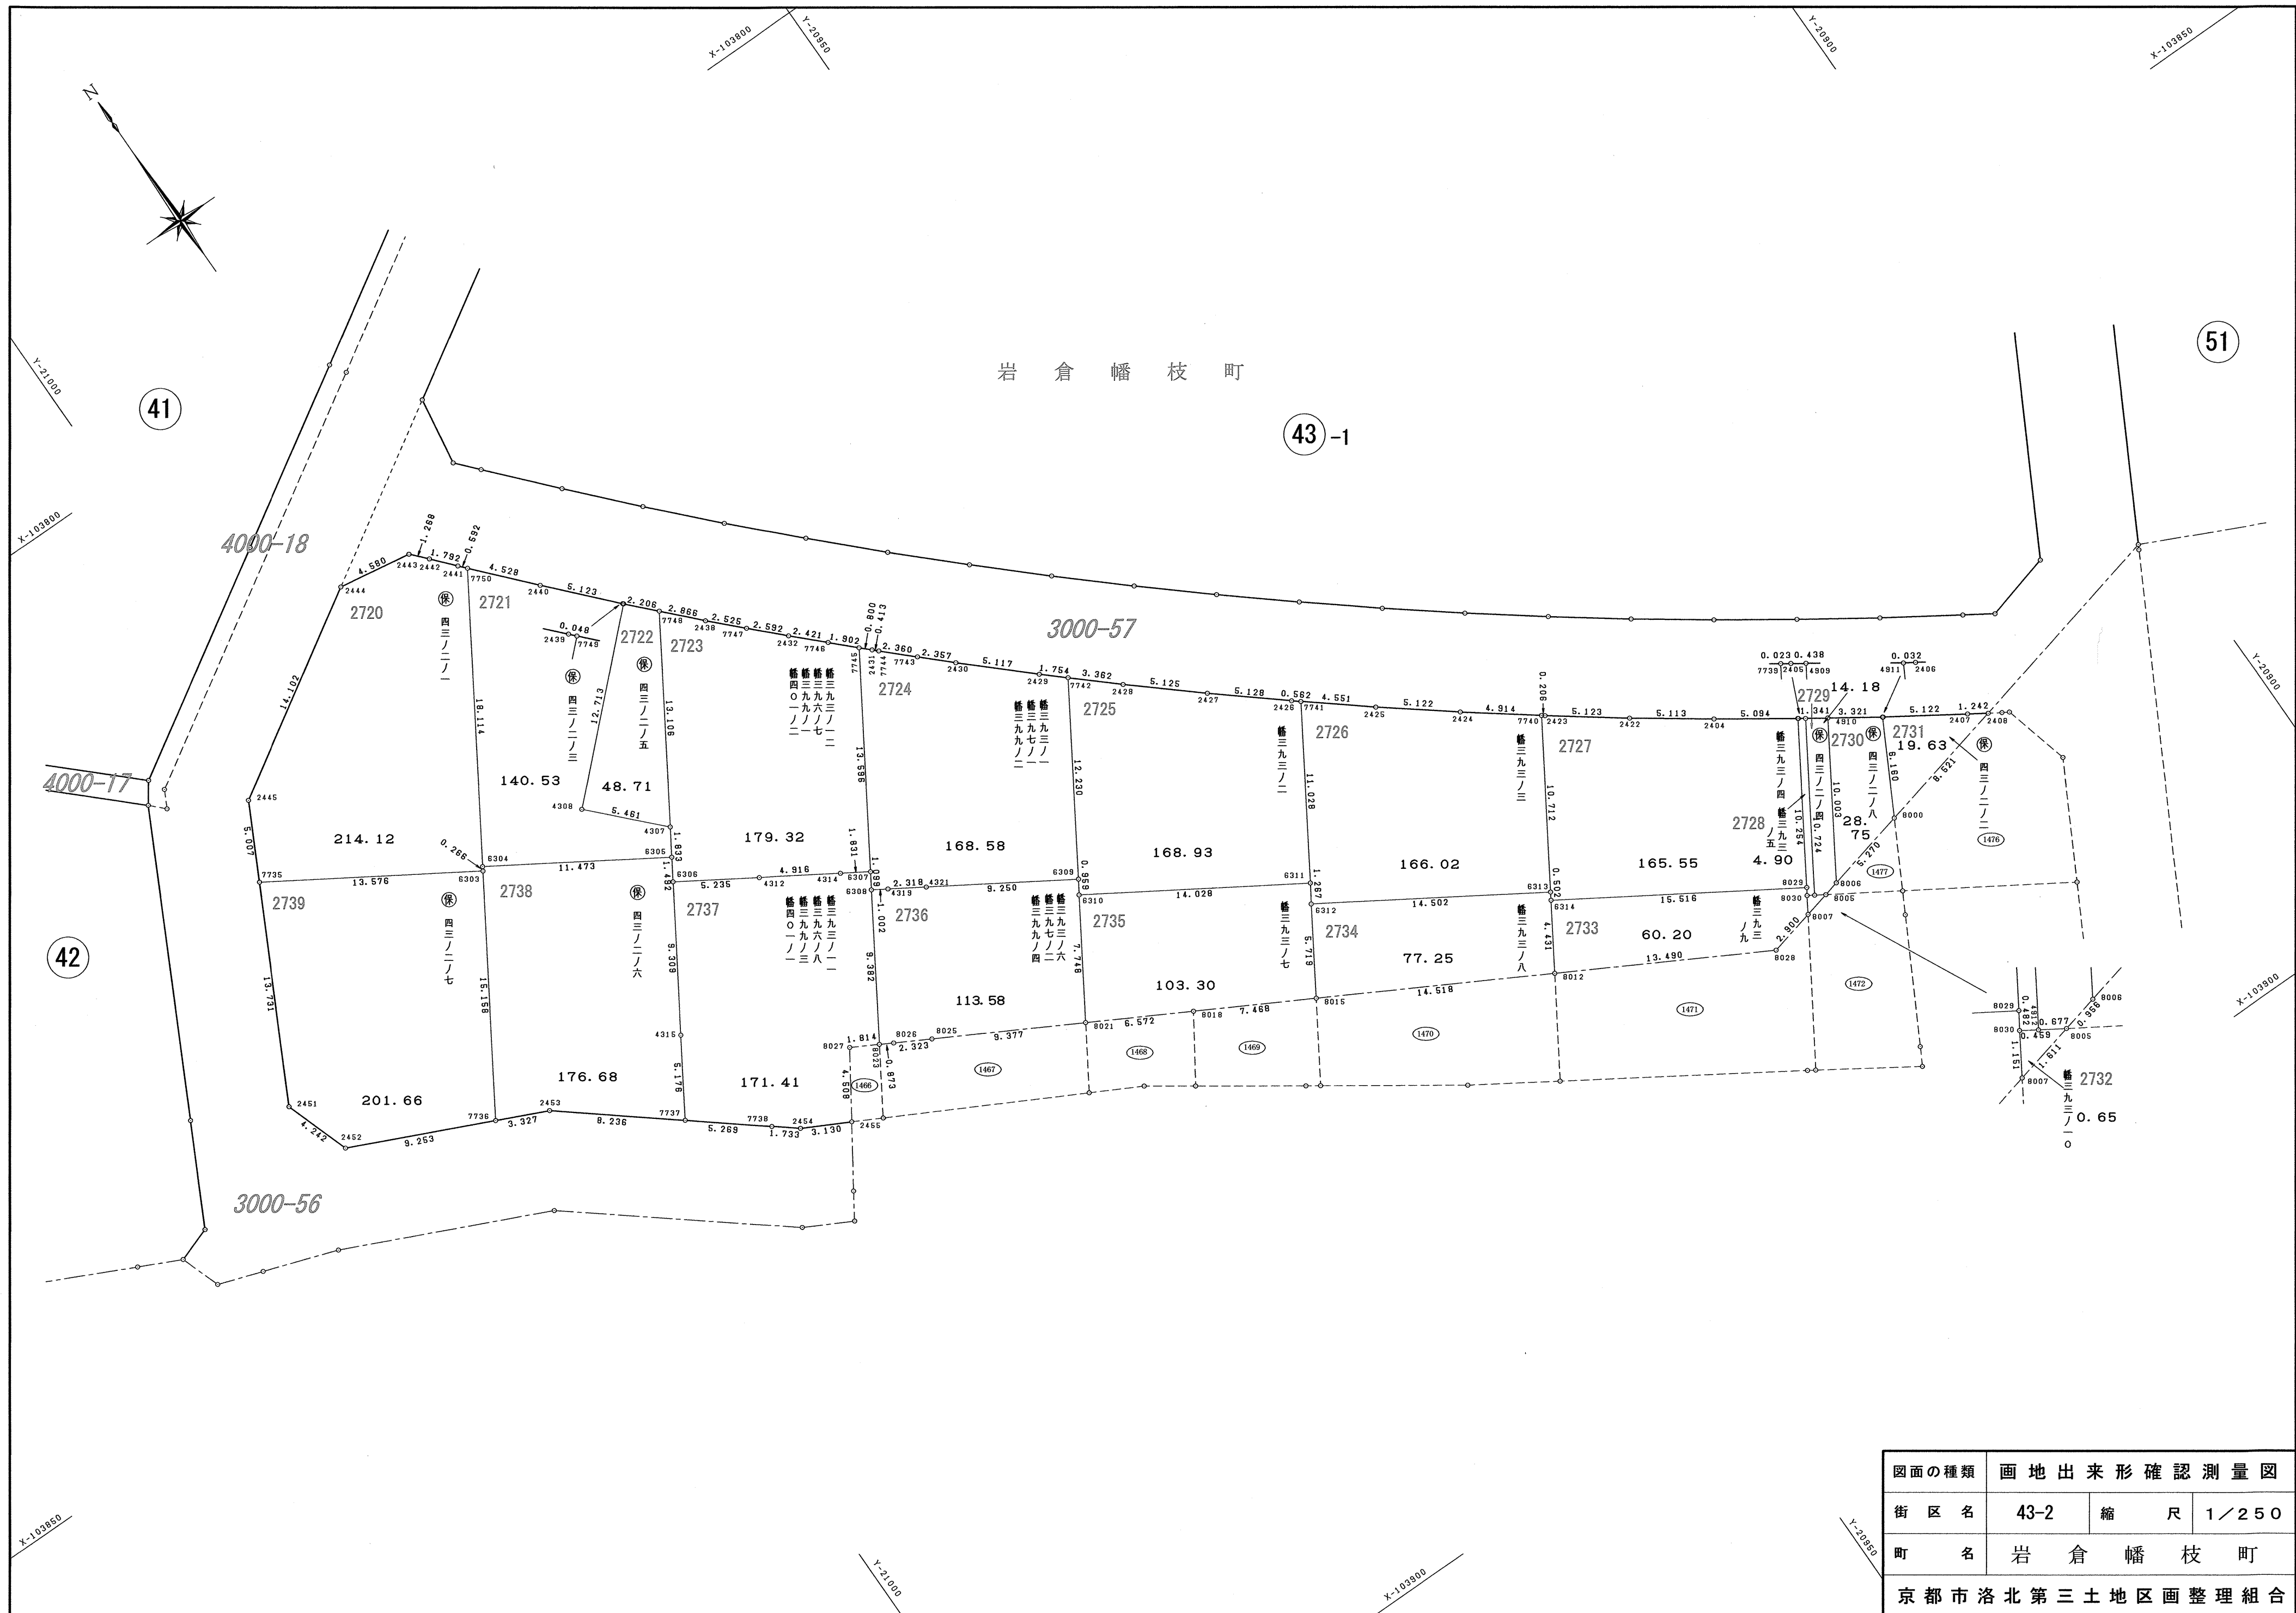

|                 |            |     |       |
|-----------------|------------|-----|-------|
| 図面の種類           | 画地出来形確認測量図 |     |       |
| 街 区 名           | 43-2       | 縮 尺 | 1／250 |
| 町 名             | 岩 倉 幡 枝 町  |     |       |
| 京都市洛北第三土地区画整理組合 |            |     |       |

|      |             |            |        |
|------|-------------|------------|--------|
| 2720 |             |            |        |
| 地番   | 保四三ノ二ノ一     |            |        |
| N O  | X           | Y          | 辺 長    |
| 2443 | -103813.720 | -20987.672 |        |
| 2444 | -103812.994 | -20992.195 | 4.580  |
| 2445 | -103820.401 | -21004.196 | 14.102 |
| 7735 | -103824.848 | -21006.498 | 5.007  |
| 6303 | -103832.037 | -20994.981 | 13.576 |
| 6304 | -103831.810 | -20994.841 | 0.266  |
| 7750 | -103816.448 | -20985.242 | 18.114 |
| 2441 | -103816.007 | -20985.638 | 0.592  |
| 2442 | -103814.662 | -20986.823 | 1.792  |
| 2443 | -103813.720 | -20987.672 | 1.268  |
| 面積   | 214.1281945 |            |        |
| 地積   | 214.12㎡     |            |        |

|      |             |            |        |
|------|-------------|------------|--------|
| 2721 |             |            |        |
| 地番   | 保四三ノ二ノ三     |            |        |
| N O  | X           | Y          | 辺 長    |
| 7750 | -103816.448 | -20985.242 |        |
| 6304 | -103831.810 | -20994.841 | 18.114 |
| 6305 | -103837.896 | -20985.115 | 11.473 |
| 4307 | -103836.341 | -20984.143 | 1.833  |
| 4308 | -103832.396 | -20987.920 | 5.461  |
| 7749 | -103823.626 | -20978.716 | 12.713 |
| 2439 | -103823.591 | -20978.750 | 0.048  |
| 2440 | -103819.818 | -20982.218 | 5.123  |
| 7750 | -103816.448 | -20985.242 | 4.528  |
| 面積   | 140.5372755 |            |        |
| 地積   | 140.53㎡     |            |        |

|      |             |            |        |
|------|-------------|------------|--------|
| 2722 |             |            |        |
| 地番   | 保四三ノ二ノ五     |            |        |
| N O  | X           | Y          | 辺 長    |
| 7749 | -103823.626 | -20978.716 |        |
| 4308 | -103832.396 | -20987.920 | 12.713 |
| 4307 | -103836.341 | -20984.143 | 5.461  |
| 7748 | -103825.226 | -20977.197 | 13.106 |
| 7749 | -103823.626 | -20978.716 | 2.206  |
| 面積   | 48.7156775  |            |        |
| 地積   | 48.71㎡      |            |        |

|      |                                 |            |        |
|------|---------------------------------|------------|--------|
| 2723 |                                 |            |        |
| 地番   | 幡三九三ノ一ニ 幡三九六ノ七<br>幡三九九ノ一 幡四〇一ノ二 |            |        |
| N O  | X                               | Y          | 辺 長    |
| 7748 | -103825.226                     | -20977.197 |        |
| 4307 | -103836.341                     | -20984.143 | 13.106 |
| 6305 | -103837.896                     | -20985.115 | 1.833  |
| 6306 | -103839.159                     | -20985.910 | 1.492  |
| 4312 | -103841.938                     | -20981.473 | 5.235  |
| 4314 | -103844.548                     | -20977.306 | 4.916  |
| 6307 | -103845.520                     | -20975.754 | 1.831  |
| 7745 | -103833.987                     | -20968.553 | 13.596 |
| 7746 | -103832.651                     | -20969.908 | 1.902  |
| 2432 | -103830.950                     | -20971.632 | 2.421  |
| 7747 | -103829.103                     | -20973.451 | 2.592  |
| 2438 | -103827.304                     | -20975.223 | 2.525  |
| 7748 | -103825.226                     | -20977.197 | 2.866  |
| 面積   | 179.3210390                     |            |        |
| 地積   | 179.32㎡                         |            |        |

|      |                         |            |        |
|------|-------------------------|------------|--------|
| 地番   | 幡三九三ノ一 幡三九七ノ一<br>幡三九九ノ二 |            |        |
| N O  | X                       | Y          | 辺 長    |
| 7745 | -103833.987             | -20968.553 |        |
| 6307 | -103845.520             | -20975.754 | 13.596 |
| 6308 | -103846.449             | -20976.343 | 1.099  |
| 4319 | -103846.980             | -20975.493 | 1.002  |
| 4321 | -103848.208             | -20973.527 | 2.318  |
| 6309 | -103853.109             | -20965.681 | 9.250  |
| 7742 | -103842.734             | -20959.205 | 12.230 |
| 2429 | -103841.562             | -20960.511 | 1.754  |
| 2430 | -103838.092             | -20964.272 | 5.117  |
| 7743 | -103836.464             | -20965.977 | 2.357  |
| 7744 | -103834.834             | -20967.684 | 2.360  |
| 2431 | -103834.549             | -20967.983 | 0.413  |
| 7745 | -103833.987             | -20968.553 | 0.800  |
| 面積   | 168.5815435             |            |        |
| 地積   | 168.58㎡                 |            |        |

|      |             |            |        |
|------|-------------|------------|--------|
| 2725 |             |            |        |
| 地番   | 幡三九三ノ二      |            |        |
| N O  | X           | Y          | 辺 長    |
| 7742 | -103842.734 | -20959.205 |        |
| 6309 | -103853.109 | -20965.681 | 12.230 |
| 6310 | -103853.915 | -20966.201 | 0.959  |
| 6311 | -103861.354 | -20954.307 | 14.028 |
| 7741 | -103851.996 | -20948.471 | 11.028 |
| 2426 | -103851.641 | -20948.907 | 0.562  |
| 2427 | -103848.340 | -20952.832 | 5.128  |
| 2428 | -103844.981 | -20956.703 | 5.125  |
| 7742 | -103842.734 | -20959.205 | 3.362  |
| 面積   | 168.9343300 |            |        |
| 地積   | 168.93㎡     |            |        |

|      |             |            |        |
|------|-------------|------------|--------|
| 2726 |             |            |        |
| 地番   | 幡三九三ノ三      |            |        |
| N O  | X           | Y          | 辺 長    |
| 7741 | -103851.996 | -20948.471 |        |
| 6311 | -103861.354 | -20954.307 | 11.028 |
| 6312 | -103862.423 | -20954.988 | 1.267  |
| 6313 | -103870.112 | -20942.691 | 14.502 |
| 7740 | -103861.027 | -20937.015 | 10.712 |
| 2424 | -103858.044 | -20940.921 | 4.914  |
| 2425 | -103854.873 | -20944.944 | 5.122  |
| 7741 | -103851.996 | -20948.471 | 4.551  |
| 面積   | 166.0208710 |            |        |
| 地積   | 166.02㎡     |            |        |

|      |             |            |        |
|------|-------------|------------|--------|
| 2727 |             |            |        |
| 地番   | 幡三九三ノ四      |            |        |
| N O  | X           | Y          | 辺 長    |
| 7740 | -103861.027 | -20937.015 |        |
| 6313 | -103870.112 | -20942.691 | 10.712 |
| 6314 | -103870.540 | -20942.955 | 0.502  |
| 8029 | -103878.771 | -20929.802 | 15.516 |
| 7739 | -103870.067 | -20924.380 | 10.254 |
| 2404 | -103867.175 | -20928.574 | 5.094  |
| 2422 | -103864.207 | -20932.738 | 5.113  |
| 2423 | -103861.152 | -20936.851 | 5.123  |
| 7740 | -103861.027 | -20937.015 | 0.206  |
| 面積   | 165.5518040 |            |        |
| 地積   | 165.55㎡     |            |        |

|      |             |            |        |
|------|-------------|------------|--------|
| 地番   | 幡三九三ノ五      |            |        |
| N O  | X           | Y          | 辺 長    |
| 7739 | -103870.067 | -20924.380 |        |
| 8029 | -103878.771 | -20929.802 | 10.254 |
| 8030 | -103879.177 | -20930.063 | 0.482  |
| 4912 | -103879.423 | -20929.675 | 0.459  |
| 4909 | -103870.325 | -20923.997 | 10.724 |
| 2405 | -103870.080 | -20924.361 | 0.438  |
| 7739 | -103870.067 | -20924.380 | 0.023  |
| 面積   | 4.9058335   |            |        |
| 地積   | 4.90㎡       |            |        |

|      |             |            |        |
|------|-------------|------------|--------|
| 2729 |             |            |        |
| 地番   | 保四三ノ二ノ四     |            |        |
| N O  | X           | Y          | 辺 長    |
| 4909 | -103870.325 | -20923.997 |        |
| 4912 | -103879.423 | -20929.675 | 10.724 |
| 8005 | -103879.785 | -20929.102 | 0.677  |
| 8006 | -103879.565 | -20928.171 | 0.956  |
| 4910 | -103871.073 | -20922.883 | 10.003 |
| 4909 | -103870.325 | -20923.997 | 1.341  |
| 面積   | 14.1841310  |            |        |
| 地積   | 14.18㎡      |            |        |

|      |             |            |        |
|------|-------------|------------|--------|
| 2730 |             |            |        |
| 地番   | 保四三ノ二ノ八     |            |        |
| N O  | X           | Y          | 辺 長    |
| 4910 | -103871.073 | -20922.883 |        |
| 8006 | -103879.565 | -20928.171 | 10.003 |
| 8000 | -103878.352 | -20923.042 | 5.270  |
| 4911 | -103872.925 | -20920.126 | 6.160  |
| 4910 | -103871.073 | -20922.883 | 3.321  |
| 面積   | 28.7518975  |            |        |
| 地積   | 28.75㎡      |            |        |

|      |             |            |       |
|------|-------------|------------|-------|
| 2731 |             |            |       |
| 地番   | 保四三ノ二ノ二     |            |       |
| N O  | X           | Y          | 辺 長   |
| 4911 | -103872.925 | -20920.126 |       |
| 8000 | -103878.352 | -20923.042 | 6.160 |
| 2408 | -103876.390 | -20914.749 | 8.521 |
| 2407 | -103875.720 | -20915.795 | 1.242 |
| 2406 | -103872.943 | -20920.099 | 5.122 |
| 4911 | -103872.925 | -20920.126 | 0.032 |
| 面積   | 19.6303130  |            |       |
| 地積   | 19.63㎡      |            |       |

|      |             |            |       |
|------|-------------|------------|-------|
| 2732 |             |            |       |
| 地番   | 幡三九三ノ一〇     |            |       |
| N O  | X           | Y          | 辺 長   |
| 8030 | -103879.177 | -20930.063 |       |
| 8007 | -103880.156 | -20930.670 | 1.151 |
| 8005 | -103879.785 | -20929.102 | 1.611 |
| 4912 | -103879.423 | -20929.675 | 0.677 |
| 8030 | -103879.177 | -20930.063 | 0.459 |
| 面積   | 0.6546865   |            |       |
| 地積   | 0.65㎡       |            |       |

|      |             |            |        |
|------|-------------|------------|--------|
| 地番   | 幡三九三ノ九      |            |        |
| N O  | X           | Y          | 辺 長    |
| 8012 | -103874.300 | -20945.301 |        |
| 8028 | -103880.824 | -20933.493 | 13.490 |
| 8007 | -103880.156 | -20930.670 | 2.900  |
| 8030 | -103879.177 | -20930.063 | 1.151  |
| 8029 | -103878.771 | -20929.802 | 0.482  |
| 6314 | -103870.540 | -20942.955 | 15.516 |
| 8012 | -103874.300 | -20945.301 | 4.431  |
| 面積   | 60.2040340  |            |        |
| 地積   | 60.20㎡      |            |        |


|      |             |            |        |
|------|-------------|------------|--------|
| 2734 |             |            |        |
| 地番   | 幡三九三ノ八      |            |        |
| N O  | X           | Y          | 辺 長    |
| 6312 | -103862.423 | -20954.988 |        |
| 8015 | -103867.280 | -20958.009 | 5.719  |
| 8012 | -103874.300 | -20945.301 | 14.518 |
| 6314 | -103870.540 | -20942.955 | 4.431  |
| 6313 | -103870.112 | -20942.691 | 0.502  |
| 6312 | -103862.423 | -20954.988 | 14.502 |
| 面積   | 77.2548750  |            |        |
| 地積   | 77.25㎡      |            |        |

|      |             |            |        |
|------|-------------|------------|--------|
| 2735 |             |            |        |
| 地番   | 幡三九三ノ七      |            |        |
| N O  | X           | Y          | 辺 長    |
| 6310 | -103853.915 | -20966.201 |        |
| 8021 | -103860.491 | -20970.299 | 7.748  |
| 8018 | -103863.670 | -20964.547 | 6.572  |
| 8015 | -103867.280 | -20958.009 | 7.468  |
| 6312 | -103862.423 | -20954.988 | 5.719  |
| 6311 | -103861.354 | -20954.307 | 1.267  |
| 6310 | -103853.915 | -20966.201 | 14.028 |
| 面積   | 103.3023990 |            |        |
| 地積   | 103.30㎡     |            |        |


|      |                         |            |       |
|------|-------------------------|------------|-------|
| 2736 |                         |            |       |
| 地番   | 幡三九三ノ六 幡三九七ノ二<br>幡三九九ノ四 |            |       |
| N O  | X                       | Y          | 辺 長   |
| 6308 | -103846.449             | -20976.343 |       |
| 8023 | -103854.411             | -20981.306 | 9.382 |
| 8026 | -103854.834             | -20980.542 | 0.873 |
| 8025 | -103855.957             | -20978.508 | 2.323 |
| 8021 | -103860.491             | -20970.299 | 9.377 |
| 6310 | -103853.915             | -20966.201 | 7.748 |
| 6309 | -103853.109             | -20965.681 | 0.959 |
| 4321 | -103848.208             | -20973.527 | 9.250 |
| 4319 | -103846.980             | -20975.493 | 2.318 |
| 6308 | -103846.449             | -20976.343 | 1.002 |
| 面積   | 113.5831770             |            |       |
| 地積   | 113.58㎡                 |            |       |

|      |                                 |            |       |
|------|---------------------------------|------------|-------|
| 地番   | 幡三九三ノ一ニ 幡三九六ノ八<br>幡三九九ノ三 幡四〇一ノ一 |            |       |
| N O  | X                               | Y          | 辺 長   |
| 7737 | -103851.446                     | -20993.584 |       |
| 7738 | -103854.759                     | -20989.486 | 5.269 |
| 2454 | -103855.849                     | -20988.138 | 1.733 |
| 2455 | -103857.304                     | -20985.366 | 3.130 |
| 8027 | -103853.534                     | -20982.894 | 4.508 |
| 8023 | -103854.411                     | -20981.306 | 1.814 |
| 6308 | -103846.449                     | -20976.343 | 9.382 |
| 6307 | -103845.520                     | -20975.754 | 1.099 |
| 4314 | -103844.548                     | -20977.306 | 1.831 |
| 4312 | -103841.938                     | -20981.473 | 4.916 |
| 6306 | -103839.159                     | -20985.910 | 5.235 |
| 4315 | -103847.055                     | -20990.842 | 9.309 |
| 7737 | -103851.446                     | -20993.584 | 5.176 |
| 面積   | 171.4183150                     |            |       |
| 地積   | 171.41㎡                         |            |       |

|      |             |            |        |
|------|-------------|------------|--------|
| 2738 |             |            |        |
| 地 番  | 保四三ノ二ノ六     |            |        |
| N O  | X           | Y          | 辺 長    |
| 6304 | -103831.810 | -20994.841 |        |
| 6303 | -103832.037 | -20994.981 | 0.266  |
| 7736 | -103844.889 | -21003.018 | 15.158 |
| 2453 | -103846.267 | -20999.989 | 3.327  |
| 7737 | -103851.446 | -20993.584 | 8.236  |
| 4315 | -103847.055 | -20990.842 | 5.176  |
| 6306 | -103839.159 | -20985.910 | 9.309  |
| 6305 | -103837.896 | -20985.115 | 1.492  |
| 6304 | -103831.810 | -20994.841 | 11.473 |
| 面積   | 176.6829030 |            |        |
| 地積   | 176.68 ㎡    |            |        |

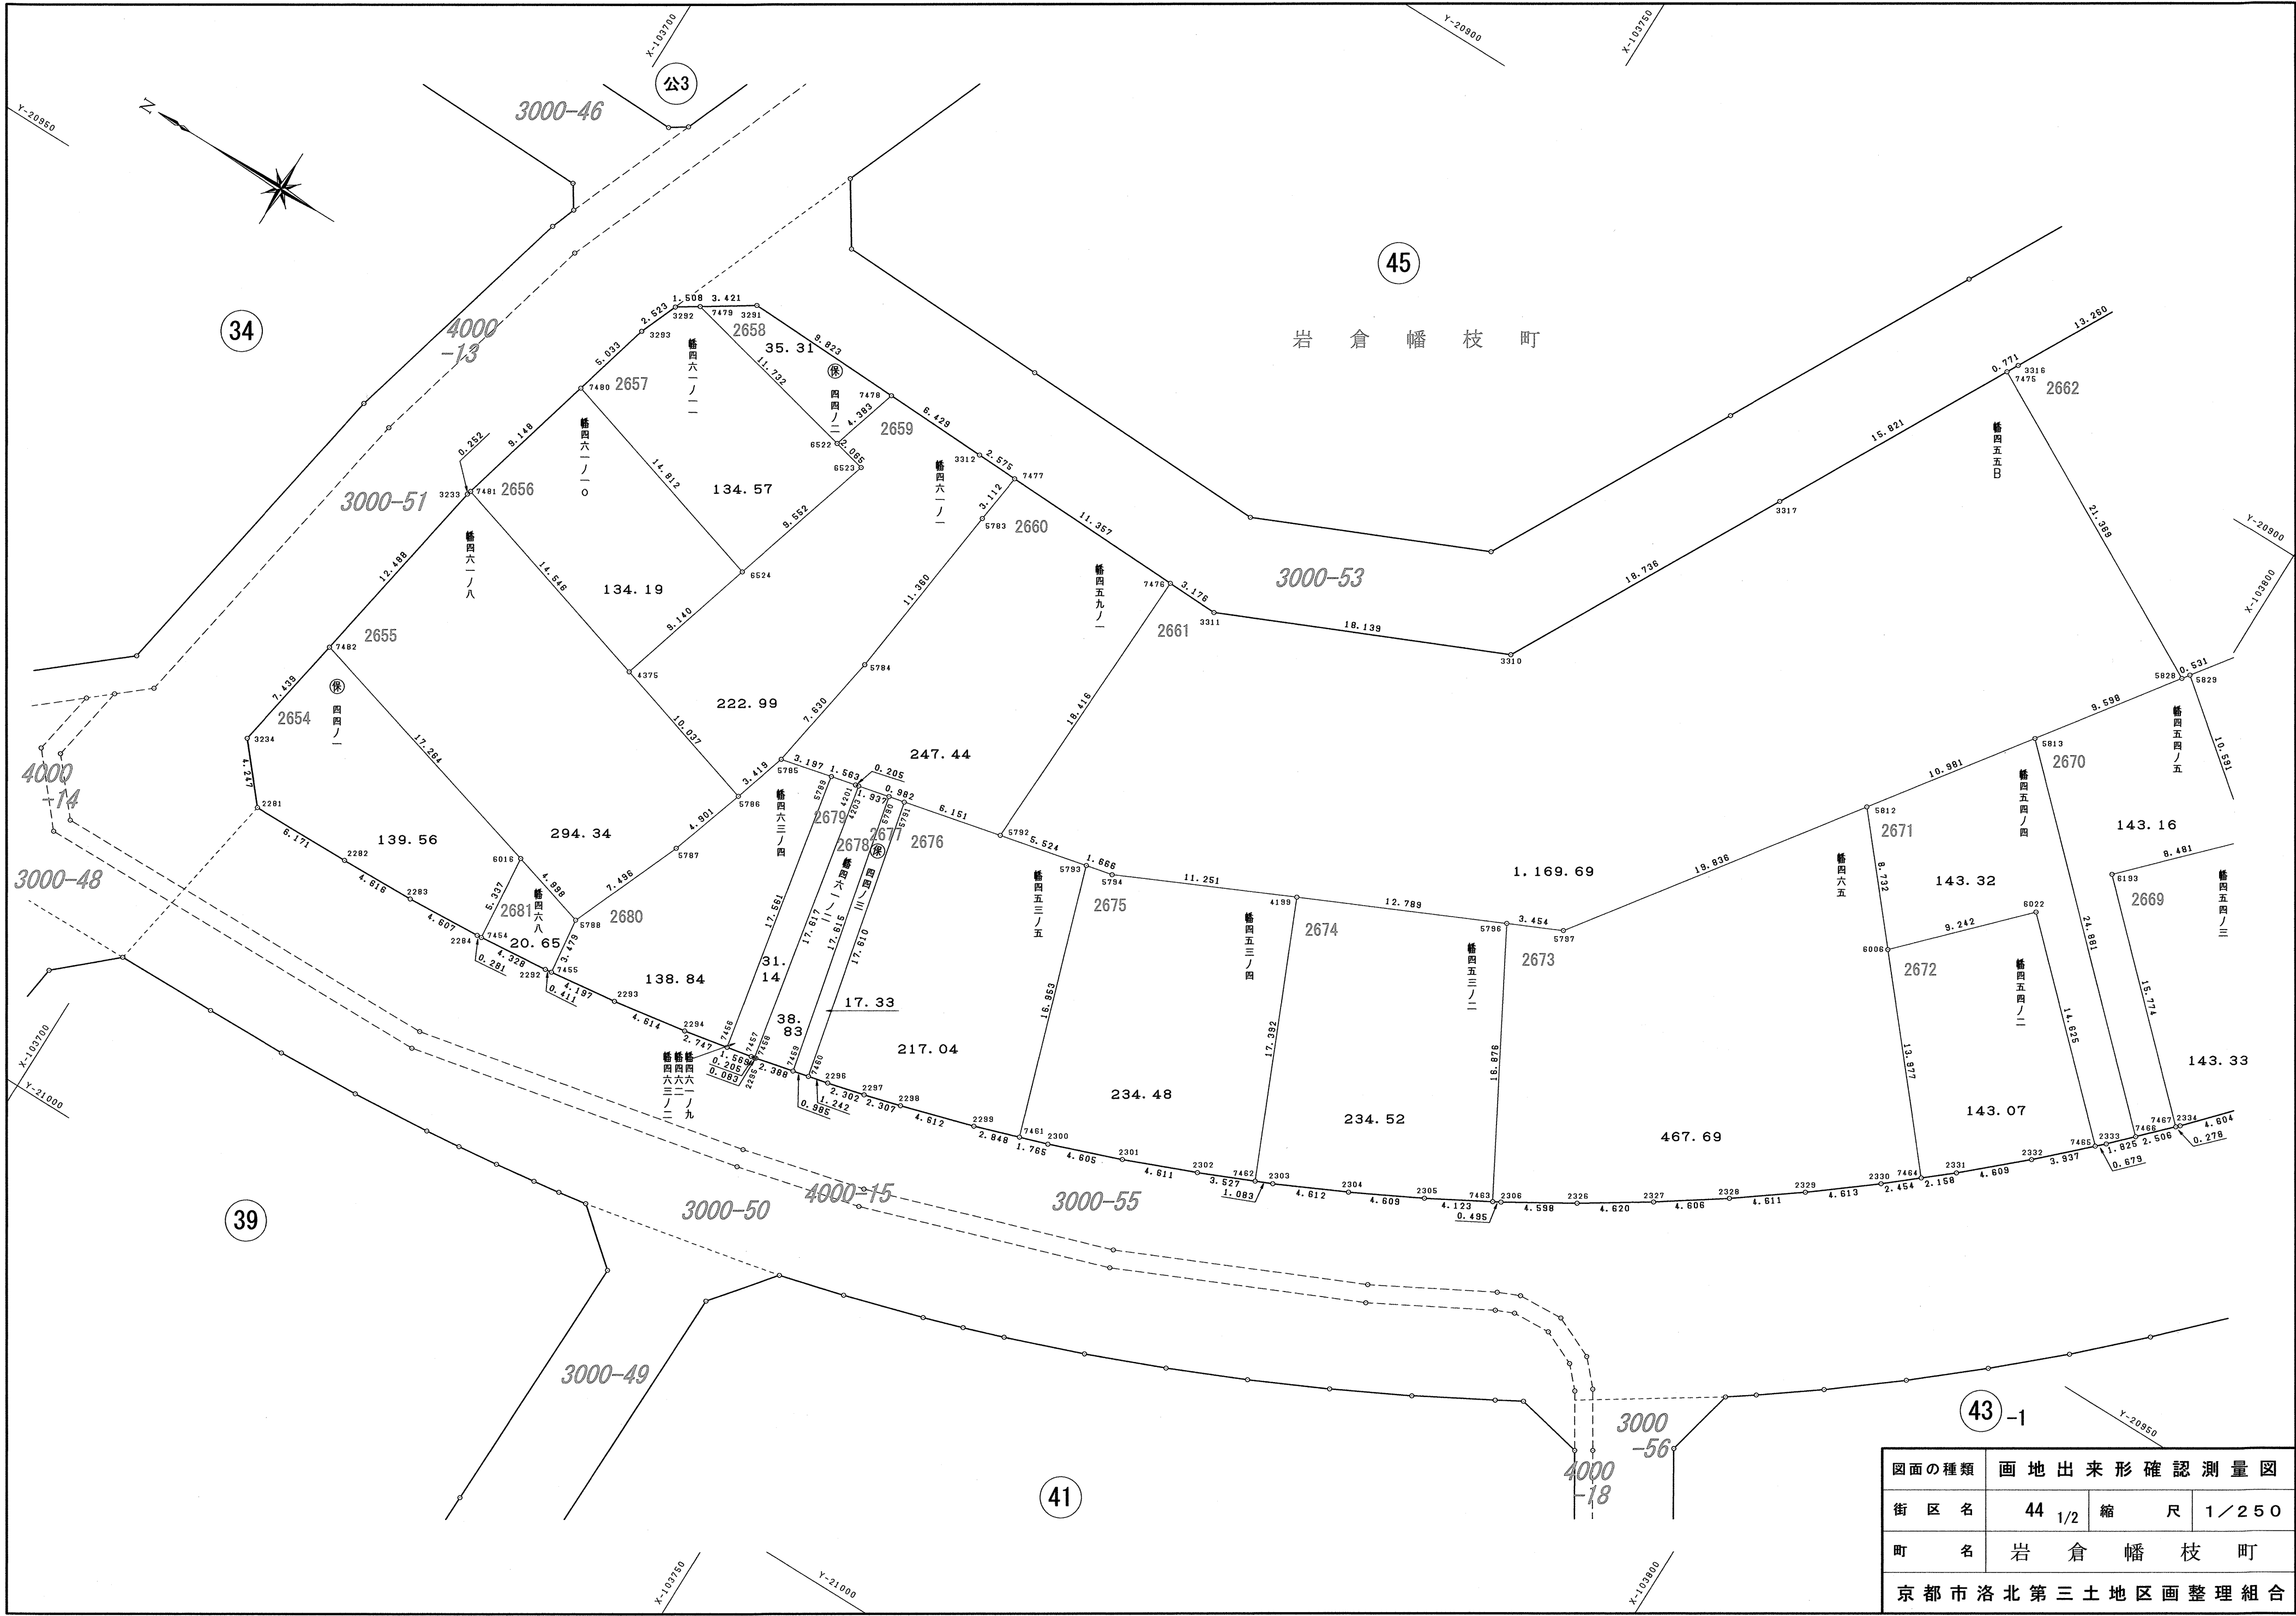

|                 |            |     |       |
|-----------------|------------|-----|-------|
| 図面の種類           | 画地出来形確認測量図 |     |       |
| 街 区 名           | 44 1/2     | 縮 尺 | 1／250 |
| 町 名             | 岩 倉 幡 枝 町  |     |       |
| 京都市洛北第三土地区画整理組合 |            |     |       |

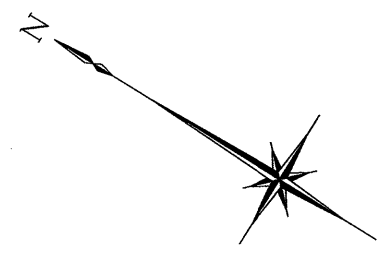

岩倉幡枝町


45

50

51

43 -1

|                 |            |    |       |
|-----------------|------------|----|-------|
| 図面の種類           | 画地出来形確認測量図 |    |       |
| 街区名             | 44<br>2/2  | 縮尺 | 1／250 |
| 町名              | 岩倉幡枝町      |    |       |
| 京都市洛北第三土地区画整理組合 |            |    |       |

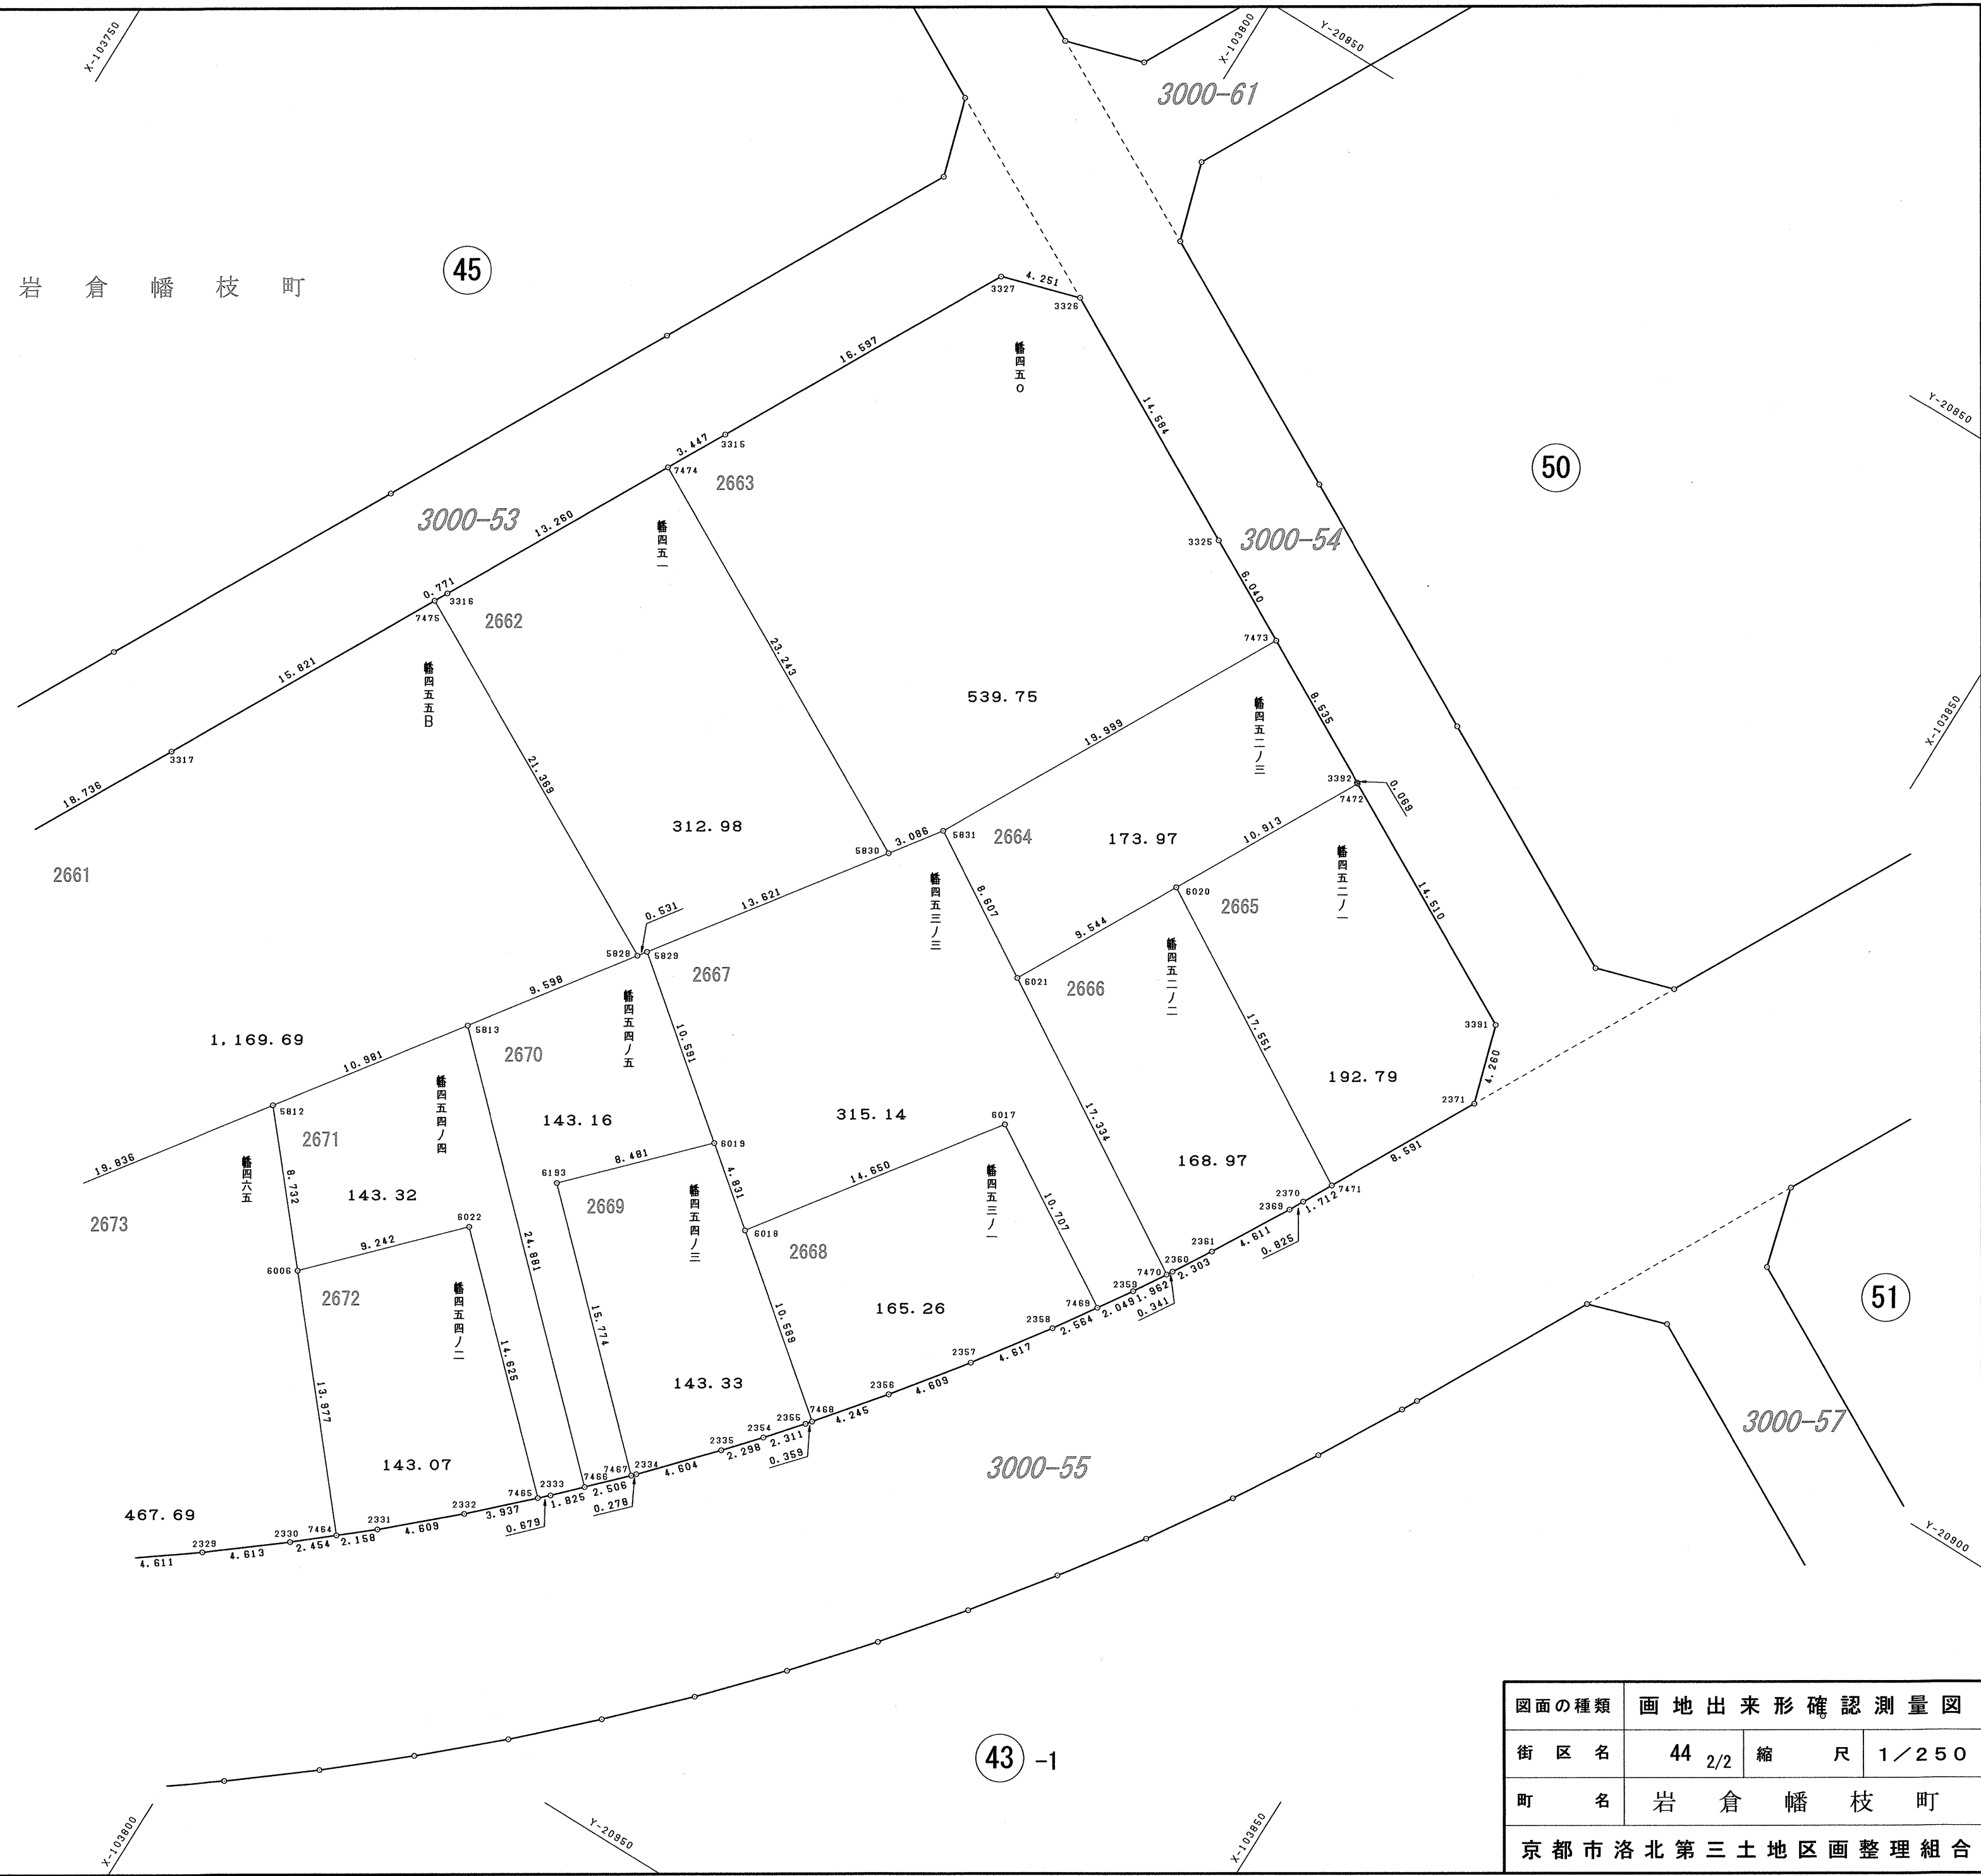

| 2654 |             |            |        |
|------|-------------|------------|--------|
| 地番   | 保四四ノ一       |            |        |
| N O  | X           | Y          | 辺 長    |
| 3234 | -103700.684 | -20974.753 |        |
| 2281 | -103703.424 | -20977.998 | 4.247  |
| 2282 | -103709.595 | -20977.922 | 6.171  |
| 2283 | -103714.210 | -20977.800 | 4.616  |
| 2284 | -103718.809 | -20977.525 | 4.607  |
| 7454 | -103719.089 | -20977.499 | 0.281  |
| 6016 | -103718.589 | -20972.185 | 5.337  |
| 7482 | -103701.992 | -20967.429 | 17.264 |
| 3234 | -103700.684 | -20974.753 | 7.439  |
| 面積   | 139.5669355 |            |        |
| 地積   | 139.56㎡     |            |        |

| 2655 |             |            |        |
|------|-------------|------------|--------|
| 地番   | 幡四六一ノ八      |            |        |
| N O  | X           | Y          | 辺 長    |
| 7482 | -103701.992 | -20967.429 |        |
| 6016 | -103718.589 | -20972.185 | 17.264 |
| 5788 | -103723.384 | -20973.596 | 4.998  |
| 5787 | -103726.255 | -20966.671 | 7.496  |
| 5786 | -103727.782 | -20962.013 | 4.901  |
| 4375 | -103718.178 | -20959.096 | 10.037 |
| 7481 | -103704.253 | -20954.891 | 14.546 |
| 3233 | -103704.188 | -20955.135 | 0.252  |
| 7482 | -103701.992 | -20967.429 | 12.488 |
| 面積   | 294.3492165 |            |        |
| 地積   | 294.34㎡     |            |        |

| 2656 |             |            |        |
|------|-------------|------------|--------|
| 地番   | 幡四六一ノ一〇     |            |        |
| N O  | X           | Y          | 辺 長    |
| 7481 | -103704.253 | -20954.891 |        |
| 4375 | -103718.178 | -20959.096 | 14.546 |
| 6524 | -103720.794 | -20950.338 | 9.140  |
| 7480 | -103706.615 | -20946.053 | 14.812 |
| 7481 | -103704.253 | -20954.891 | 9.148  |
| 面積   | 134.1953010 |            |        |
| 地積   | 134.19㎡     |            |        |

| 2657 |             |            |        |
|------|-------------|------------|--------|
| 地番   | 幡四六一ノ一一     |            |        |
| N O  | X           | Y          | 辺 長    |
| 7480 | -103706.615 | -20946.053 |        |
| 6524 | -103720.794 | -20950.338 | 14.812 |
| 6523 | -103723.563 | -20941.196 | 9.552  |
| 6522 | -103721.552 | -20940.725 | 2.065  |
| 7479 | -103710.133 | -20938.033 | 11.732 |
| 3292 | -103708.868 | -20938.854 | 1.508  |
| 3293 | -103707.914 | -20941.190 | 2.523  |
| 7480 | -103706.615 | -20946.053 | 5.033  |
| 面積   | 134.5761070 |            |        |
| 地積   | 134.57㎡     |            |        |

| 2658 |             |            |        |
|------|-------------|------------|--------|
| 地番   | 保四四ノ二       |            |        |
| N O  | X           | Y          | 辺 長    |
| 7479 | -103710.133 | -20938.033 |        |
| 6522 | -103721.552 | -20940.725 | 11.732 |
| 7478 | -103722.821 | -20936.529 | 4.383  |
| 3291 | -103713.004 | -20936.171 | 9.823  |
| 7479 | -103710.133 | -20938.033 | 3.421  |
| 面積   | 35.3186720  |            |        |
| 地積   | 35.31㎡      |            |        |

| 2659 |             |            |        |
|------|-------------|------------|--------|
| 地番   | 幡四六一ノ一      |            |        |
| N O  | X           | Y          | 辺 長    |
| 7478 | -103722.821 | -20936.529 |        |
| 6522 | -103721.552 | -20940.725 | 4.383  |
| 6523 | -103723.563 | -20941.196 | 2.065  |
| 6524 | -103720.794 | -20950.338 | 9.552  |
| 4375 | -103718.178 | -20959.096 | 9.140  |
| 5786 | -103727.782 | -20962.013 | 10.037 |
| 5785 | -103728.797 | -20958.748 | 3.419  |
| 5784 | -103730.060 | -20951.223 | 7.630  |
| 5783 | -103731.428 | -20939.945 | 11.360 |
| 7477 | -103731.820 | -20936.857 | 3.112  |
| 3312 | -103729.246 | -20936.763 | 2.575  |
| 7478 | -103722.821 | -20936.529 | 6.429  |
| 面積   | 222.9963335 |            |        |
| 地積   | 222.99㎡     |            |        |

| 2660 |             |            |        |
|------|-------------|------------|--------|
| 地番   | 幡四五九ノ一      |            |        |
| N O  | X           | Y          | 辺 長    |
| 7477 | -103731.820 | -20936.857 |        |
| 5783 | -103731.428 | -20939.945 | 3.112  |
| 5784 | -103730.060 | -20951.223 | 11.360 |
| 5785 | -103728.797 | -20958.748 | 7.630  |
| 5789 | -103731.915 | -20958.041 | 3.197  |
| 4201 | -103733.440 | -20957.698 | 1.563  |
| 4203 | -103733.640 | -20957.653 | 0.205  |
| 5790 | -103735.530 | -20957.228 | 1.937  |
| 5791 | -103736.490 | -20957.019 | 0.982  |
| 5792 | -103742.493 | -20955.674 | 6.151  |
| 7476 | -103743.170 | -20937.270 | 18.416 |
| 7477 | -103731.820 | -20936.857 | 11.357 |
| 面積   | 247.4413115 |            |        |
| 地積   | 247.44㎡     |            |        |

| 2661 |              |            |        |
|------|--------------|------------|--------|
| 地番   | 幡四五五B        |            |        |
| N O  | X            | Y          | 辺 長    |
| 7476 | -103743.170  | -20937.270 |        |
| 5792 | -103742.493  | -20955.674 | 18.416 |
| 5793 | -103747.885  | -20954.472 | 5.524  |
| 5794 | -103749.512  | -20954.110 | 1.666  |
| 4199 | -103759.721  | -20949.381 | 11.251 |
| 5796 | -103771.340  | -20944.035 | 12.789 |
| 5797 | -103774.479  | -20942.592 | 3.454  |
| 5812 | -103786.113  | -20926.525 | 19.836 |
| 5813 | -103792.548  | -20917.626 | 10.981 |
| 5828 | -103798.175  | -20909.850 | 9.598  |
| 7475 | -103779.383  | -20899.676 | 21.369 |
| 3317 | -103771.859  | -20913.594 | 15.821 |
| 3310 | -103762.944  | -20930.074 | 18.736 |
| 3311 | -103746.344  | -20937.386 | 18.139 |
| 7476 | -103743.170  | -20937.270 | 3.176  |
| 面積   | 1169.6926065 |            |        |
| 地積   | 1169.69㎡     |            |        |

| 2662 |             |            |        |
|------|-------------|------------|--------|
| 地番   | 幡四五一        |            |        |
| N O  | X           | Y          | 辺 長    |
| 7475 | -103779.383 | -20899.676 |        |
| 5828 | -103798.175 | -20909.850 | 21.369 |
| 5829 | -103798.488 | -20909.420 | 0.531  |
| 5830 | -103806.498 | -20898.402 | 13.621 |
| 7474 | -103786.059 | -20887.334 | 23.243 |
| 3316 | -103779.750 | -20898.997 | 13.260 |
| 7475 | -103779.383 | -20899.676 | 0.771  |
| 面積   | 312.9824740 |            |        |
| 地積   | 312.98㎡     |            |        |

| 2663 |             |            |        |
|------|-------------|------------|--------|
| 地番   | 幡四五〇        |            |        |
| N O  | X           | Y          | 辺 長    |
| 7474 | -103786.059 | -20887.334 |        |
| 5830 | -103806.498 | -20898.402 | 23.243 |
| 5831 | -103808.296 | -20895.893 | 3.086  |
| 7473 | -103817.803 | -20878.298 | 19.999 |
| 3325 | -103812.490 | -20875.423 | 6.040  |
| 3326 | -103799.663 | -20868.482 | 14.584 |
| 3327 | -103795.590 | -20869.700 | 4.251  |
| 3315 | -103787.699 | -20884.302 | 16.597 |
| 7474 | -103786.059 | -20887.334 | 3.447  |
| 面積   | 539.7585675 |            |        |
| 地積   | 539.75㎡     |            |        |

| 2664 |             |            |        |
|------|-------------|------------|--------|
| 地番   | 幡四五二ノ三      |            |        |
| N O  | X           | Y          | 辺 長    |
| 7473 | -103817.803 | -20878.298 |        |
| 5831 | -103808.296 | -20895.893 | 19.999 |
| 6021 | -103815.637 | -20900.388 | 8.607  |
| 6020 | -103820.179 | -20891.993 | 9.544  |
| 7472 | -103825.371 | -20882.394 | 10.913 |
| 3392 | -103825.310 | -20882.361 | 0.069  |
| 7473 | -103817.803 | -20878.298 | 8.535  |
| 面積   | 173.9798110 |            |        |
| 地積   | 173.97㎡     |            |        |

| 2665 |             |            |        |
|------|-------------|------------|--------|
| 地番   | 幡四五二ノ一      |            |        |
| N O  | X           | Y          | 辺 長    |
| 7472 | -103825.371 | -20882.394 |        |
| 6020 | -103820.179 | -20891.993 | 10.913 |
| 7471 | -103835.278 | -20900.941 | 17.551 |
| 2371 | -103839.356 | -20893.379 | 8.591  |
| 3391 | -103838.134 | -20889.298 | 4.260  |
| 7472 | -103825.371 | -20882.394 | 14.510 |
| 面積   | 192.7969160 |            |        |
| 地積   | 192.79㎡     |            |        |

| 2666 |             |            |        |
|------|-------------|------------|--------|
| 地番   | 幡四五二ノ二      |            |        |
| N O  | X           | Y          | 辺 長    |
| 7471 | -103835.278 | -20900.941 |        |
| 6020 | -103820.179 | -20891.993 | 17.551 |
| 6021 | -103815.637 | -20900.388 | 9.544  |
| 7470 | -103830.418 | -20909.443 | 17.334 |
| 2360 | -103830.598 | -20909.153 | 0.341  |
| 2361 | -103831.782 | -20907.177 | 2.303  |
| 2369 | -103834.070 | -20903.173 | 4.611  |
| 2370 | -103834.465 | -20902.448 | 0.825  |
| 7471 | -103835.278 | -20900.941 | 1.712  |
| 面積   | 168.9726975 |            |        |
| 地積   | 168.97㎡     |            |        |

| 2667 |             |            |        |
|------|-------------|------------|--------|
| 地番   | 幡四五三ノ三      |            |        |
| N O  | X           | Y          | 辺 長    |
| 7470 | -103830.418 | -20909.443 |        |
| 6021 | -103815.637 | -20900.388 | 17.334 |
| 5831 | -103808.296 | -20895.893 | 8.607  |
| 5830 | -103806.498 | -20898.402 | 3.086  |
| 5829 | -103798.488 | -20909.420 | 13.621 |
| 6019 | -103806.744 | -20916.055 | 10.591 |
| 6018 | -103810.509 | -20919.083 | 4.831  |
| 6017 | -103819.123 | -20907.232 | 14.650 |
| 7469 | -103828.256 | -20912.822 | 10.707 |
| 2359 | -103829.383 | -20911.110 | 2.049  |
| 7470 | -103830.418 | -20909.443 | 1.962  |
| 面積   | 315.1415095 |            |        |
| 地積   | 315.14㎡     |            |        |

| 2668 |             |            |        |
|------|-------------|------------|--------|
| 地番   | 幡四五三ノ一      |            |        |
| N O  | X           | Y          | 辺 長    |
| 7468 | -103818.752 | -20925.730 |        |
| 2356 | -103821.407 | -20922.417 | 4.245  |
| 2357 | -103824.180 | -20918.735 | 4.609  |
| 2358 | -103826.847 | -20914.965 | 4.617  |
| 7469 | -103828.256 | -20912.822 | 2.564  |
| 6017 | -103819.123 | -20907.232 | 10.707 |
| 6018 | -103810.509 | -20919.083 | 14.650 |
| 7468 | -103818.752 | -20925.730 | 10.589 |
| 面積   | 165.2687655 |            |        |
| 地積   | 165.26㎡     |            |        |

| 2669 |             |            |        |
|------|-------------|------------|--------|
| 地番   | 幡四五四ノ三      |            |        |
| N O  | X           | Y          | 辺 長    |
| 7468 | -103818.752 | -20925.730 |        |
| 6018 | -103810.509 | -20919.083 | 10.589 |
| 6019 | -103806.744 | -20916.055 | 4.831  |
| 6193 | -103800.855 | -20922.159 | 8.481  |
| 7467 | -103812.216 | -20933.102 | 15.774 |
| 2334 | -103812.411 | -20932.903 | 0.278  |
| 2335 | -103815.520 | -20929.506 | 4.604  |
| 2354 | -103817.035 | -20927.777 | 2.298  |
| 2355 | -103818.527 | -20926.011 | 2.311  |
| 7468 | -103818.752 | -20925.730 | 0.359  |
| 面積   | 143.3337840 |            |        |
| 地積   | 143.33㎡     |            |        |

| 2670 |             |            |        |
|------|-------------|------------|--------|
| 地番   | 幡四五四ノ五      |            |        |
| N O  | X           | Y          | 辺 長    |
| 7467 | -103812.216 | -20933.102 |        |
| 6193 | -103800.855 | -20922.159 | 15.774 |
| 6019 | -103806.744 | -20916.055 | 8.481  |
| 5829 | -103798.488 | -20909.420 | 10.591 |
| 5828 | -103798.175 | -20909.850 | 0.531  |
| 5813 | -103792.548 | -20917.626 | 9.598  |
| 7466 | -103810.463 | -20934.893 | 24.881 |
| 7467 | -103812.216 | -20933.102 | 2.506  |
| 面積   | 143.1672915 |            |        |
| 地積   | 143.16㎡     |            |        |

|      |                       |            |        |
|------|-----------------------|------------|--------|
| 2671 |                       |            |        |
| 地 番  | 幡四五四ノ四                |            |        |
| N O  | X                     | Y          | 辺 長    |
| 7466 | -103810.463           | -20934.893 |        |
| 5813 | -103792.548           | -20917.626 | 24.881 |
| 5812 | -103786.113           | -20926.525 | 10.981 |
| 6006 | -103791.757           | -20933.189 | 8.732  |
| 6022 | -103798.160           | -20926.524 | 9.242  |
| 7465 | -103808.696           | -20936.668 | 14.625 |
| 2333 | -103809.186           | -20936.197 | 0.679  |
| 7466 | -103810.463           | -20934.893 | 1.825  |
| 面 積  | 143.3276385           |            |        |
| 地 積  | 143.32 m <sup>2</sup> |            |        |

2675

|      |             |            |        |
|------|-------------|------------|--------|
| 地 番  | 幡四五三ノ四      |            |        |
| N O  | X           | Y          | 辺 長    |
| 7462 | -103766.670 | -20965.325 |        |
| 4199 | -103759.721 | -20949.381 | 17.392 |
| 5794 | -103749.512 | -20954.110 | 11.251 |
| 5793 | -103747.885 | -20954.472 | 1.666  |
| 7461 | -103753.154 | -20970.586 | 16.953 |
| 2300 | -103754.830 | -20970.032 | 1.765  |
| 2301 | -103759.155 | -20968.449 | 4.605  |
| 2302 | -103763.433 | -20966.726 | 4.611  |
| 7462 | -103766.670 | -20965.325 | 3.527  |
| 面積   | 234.4849525 |            |        |
| 地積   | 234.48㎡     |            |        |

2676

|      |             |            |        |
|------|-------------|------------|--------|
| 地 番  | 幡四五三ノ五      |            |        |
| N O  | X           | Y          | 辺 長    |
| 7461 | -103753.154 | -20970.586 |        |
| 5793 | -103747.885 | -20954.472 | 16.953 |
| 5792 | -103742.493 | -20955.674 | 5.524  |
| 5791 | -103736.490 | -20957.019 | 6.151  |
| 7460 | -103740.346 | -20974.202 | 17.610 |
| 2296 | -103741.559 | -20973.931 | 1.242  |
| 2297 | -103743.794 | -20973.377 | 2.302  |
| 2298 | -103746.021 | -20972.773 | 2.307  |
| 2299 | -103750.449 | -20971.480 | 4.612  |
| 7461 | -103753.154 | -20970.586 | 2.848  |
| 面積   | 217.0449180 |            |        |
| 地積   | 217.04㎡     |            |        |

2677

|      |             |            |        |
|------|-------------|------------|--------|
| 地 番  | 保四四ノ三       |            |        |
| N O  | X           | Y          | 辺 長    |
| 7459 | -103739.384 | -20974.417 |        |
| 7460 | -103740.346 | -20974.202 | 0.985  |
| 5791 | -103736.490 | -20957.019 | 17.610 |
| 5790 | -103735.530 | -20957.228 | 0.982  |
| 7459 | -103739.384 | -20974.417 | 17.615 |
| 面積   | 17.3330060  |            |        |
| 地積   | 17.33㎡      |            |        |

2678

|      |             |            |        |
|------|-------------|------------|--------|
| 地 番  | 幡四六一ノ二      |            |        |
| N O  | X           | Y          | 辺 長    |
| 7458 | -103736.971 | -20974.953 |        |
| 2295 | -103737.053 | -20974.937 | 0.083  |
| 7459 | -103739.384 | -20974.417 | 2.388  |
| 5790 | -103735.530 | -20957.228 | 17.615 |
| 4203 | -103733.640 | -20957.653 | 1.937  |
| 7458 | -103736.971 | -20974.953 | 17.617 |
| 面積   | 38.8304100  |            |        |
| 地積   | 38.83㎡      |            |        |

2679

|      |                    |            |        |
|------|--------------------|------------|--------|
| 地 番  | 幡四六一ノ九 幡四六二 幡四六三ノ二 |            |        |
| N O  | X                  | Y          | 辺 長    |
| 7456 | -103735.228        | -20975.287 |        |
| 7457 | -103736.769        | -20974.991 | 1.569  |
| 7458 | -103736.971        | -20974.953 | 0.205  |
| 4203 | -103733.640        | -20957.653 | 17.617 |
| 4201 | -103733.440        | -20957.698 | 0.205  |
| 5789 | -103731.915        | -20958.041 | 1.563  |
| 7456 | -103735.228        | -20975.287 | 17.561 |
| 面積   | 31.1499945         |            |        |
| 地積   | 31.14㎡             |            |        |


2680

|      |             |            |        |
|------|-------------|------------|--------|
| 地 番  | 幡四六三ノ四      |            |        |
| N O  | X           | Y          | 辺 長    |
| 7456 | -103735.228 | -20975.287 |        |
| 5789 | -103731.915 | -20958.041 | 17.561 |
| 5785 | -103728.797 | -20958.748 | 3.197  |
| 5786 | -103727.782 | -20962.013 | 3.419  |
| 5787 | -103726.255 | -20966.671 | 4.901  |
| 5788 | -103723.384 | -20973.596 | 7.496  |
| 7455 | -103723.807 | -20977.050 | 3.479  |
| 2293 | -103727.972 | -20976.526 | 4.197  |
| 2294 | -103732.530 | -20975.804 | 4.614  |
| 7456 | -103735.228 | -20975.287 | 2.747  |
| 面積   | 138.8438750 |            |        |
| 地積   | 138.84㎡     |            |        |

2681

|      |             |            |       |
|------|-------------|------------|-------|
| 地 番  | 幡四六八        |            |       |
| N O  | X           | Y          | 辺 長   |
| 7455 | -103723.807 | -20977.050 |       |
| 5788 | -103723.384 | -20973.596 | 3.479 |
| 6016 | -103718.589 | -20972.185 | 4.998 |
| 7454 | -103719.089 | -20977.499 | 5.337 |
| 2292 | -103723.399 | -20977.101 | 4.328 |
| 7455 | -103723.807 | -20977.050 | 0.411 |
| 面積   | 20.6592275  |            |       |
| 地積   | 20.65㎡      |            |       |

|                               |                     |       |  |
|-------------------------------|---------------------|-------|--|
| 図面の種類                         | 画 地 出 来 形 確 認 測 量 図 |       |  |
| 街 区 名                         | 44 2/2              | 求 積 表 |  |
| 町 名                           | 岩 倉 幡 枝 町           |       |  |
| 京 都 市 洛 北 第 三 土 地 区 画 整 理 組 合 |                     |       |  |

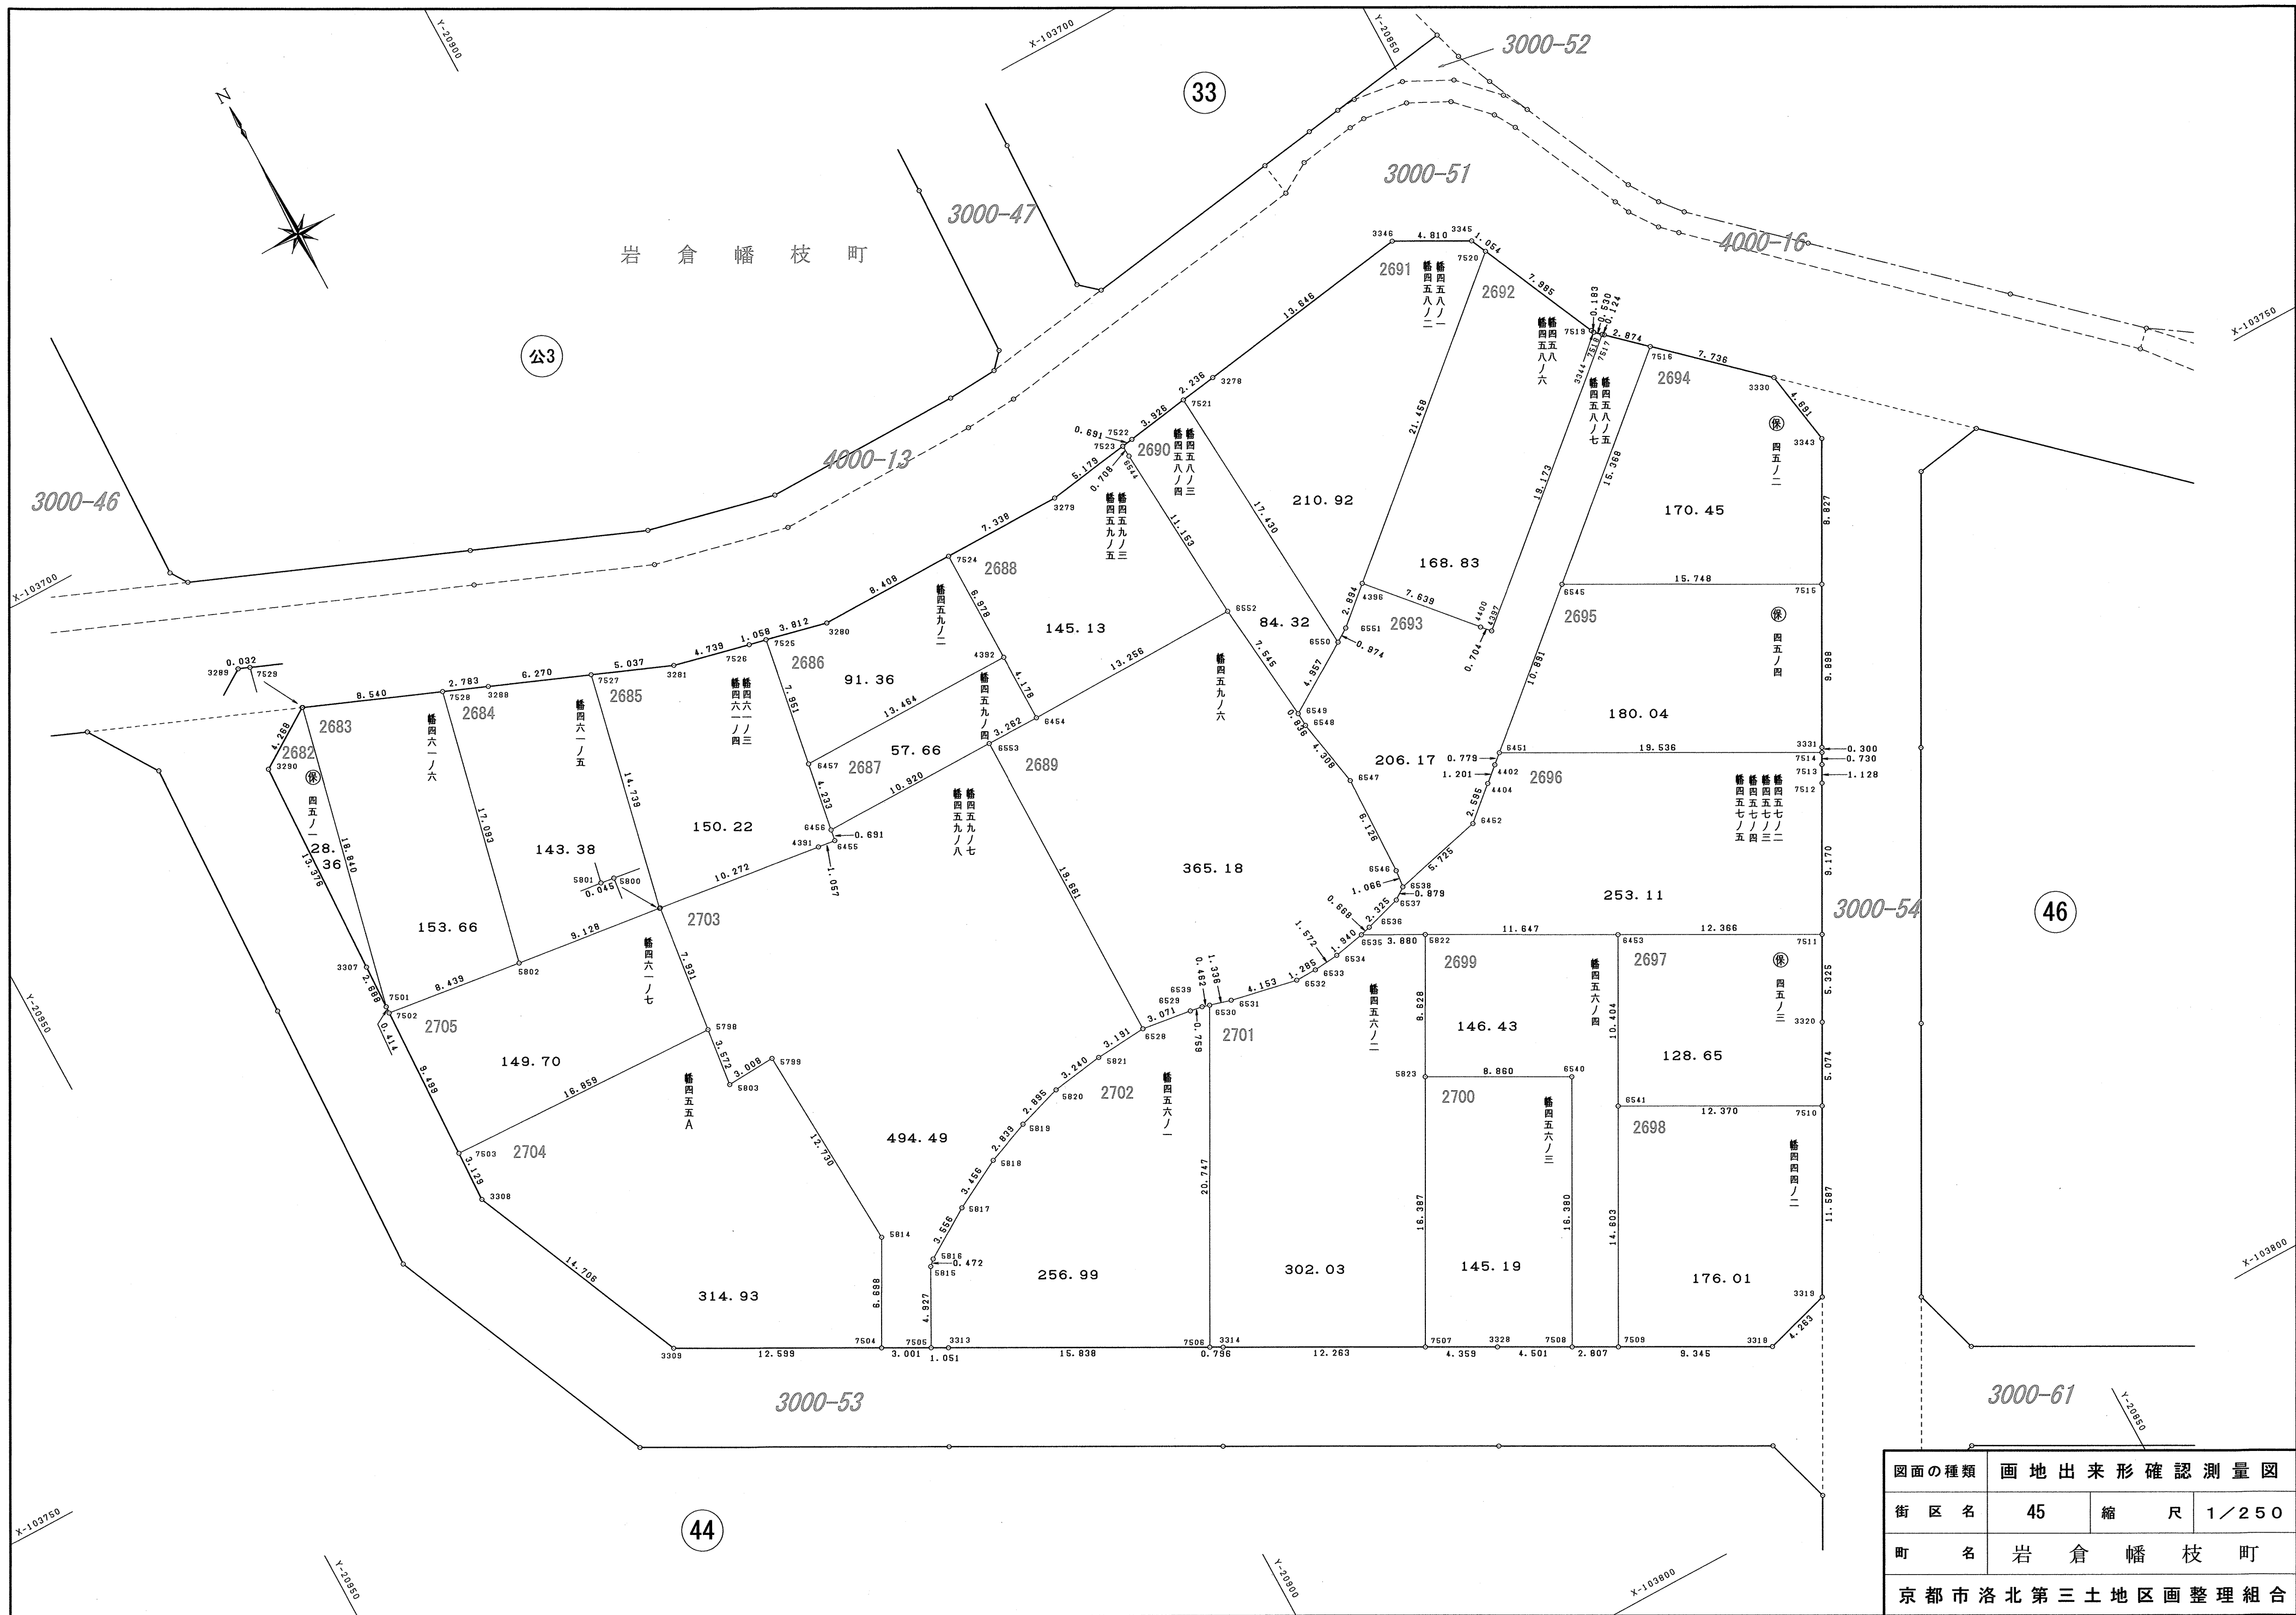

|                 |            |    |       |
|-----------------|------------|----|-------|
| 図面の種類           | 画地出来形確認測量図 |    |       |
| 街区名             | 45         | 縮尺 | 1／250 |
| 町名              | 岩倉幡枝町      |    |       |
| 京都市洛北第三土地区画整理組合 |            |    |       |

2682

| 地番   | 保四五ノ一       |            |        |
|------|-------------|------------|--------|
| N O  | X           | Y          | 辺 長    |
| 3290 | -103716.086 | -20930.268 |        |
| 3307 | -103729.453 | -20930.763 | 13.376 |
| 7501 | -103732.140 | -20930.860 | 2.688  |
| 7529 | -103713.774 | -20926.658 | 18.840 |
| 3289 | -103713.762 | -20926.688 | 0.032  |
| 3290 | -103716.086 | -20930.268 | 4.268  |
| 面積   | 28.3661910  |            |        |
| 地積   | 28.36㎡      |            |        |

2683

| 地番   | 幡四六一ノ六      |            |        |
|------|-------------|------------|--------|
| N O  | X           | Y          | 辺 長    |
| 7529 | -103713.774 | -20926.658 |        |
| 7501 | -103732.140 | -20930.860 | 18.840 |
| 7502 | -103732.554 | -20930.875 | 0.414  |
| 5802 | -103733.641 | -20922.506 | 8.439  |
| 7528 | -103716.968 | -20918.737 | 17.093 |
| 7529 | -103713.774 | -20926.658 | 8.540  |
| 面積   | 153.6614280 |            |        |
| 地積   | 153.66㎡     |            |        |

2684

| 地番   | 幡四六一ノ五      |            |        |
|------|-------------|------------|--------|
| N O  | X           | Y          | 辺 長    |
| 7528 | -103716.968 | -20918.737 |        |
| 5802 | -103733.641 | -20922.506 | 17.093 |
| 5801 | -103734.762 | -20913.447 | 9.128  |
| 7527 | -103720.354 | -20910.340 | 14.739 |
| 3288 | -103718.009 | -20916.156 | 6.270  |
| 7528 | -103716.968 | -20918.737 | 2.783  |
| 面積   | 143.3840115 |            |        |
| 地積   | 143.38㎡     |            |        |

2685

| 地番   | 幡四六一ノ三 幡四六一ノ四 |            |        |
|------|---------------|------------|--------|
| N O  | X             | Y          | 辺 長    |
| 7525 | -103723.542   | -20900.019 |        |
| 7526 | -103723.304   | -20901.050 | 1.058  |
| 3281 | -103722.238   | -20905.668 | 4.739  |
| 7527 | -103720.354   | -20910.340 | 5.037  |
| 5801 | -103734.762   | -20913.447 | 14.739 |
| 5800 | -103734.770   | -20913.402 | 0.045  |
| 4391 | -103736.101   | -20903.216 | 10.272 |
| 6455 | -103736.238   | -20902.167 | 1.057  |
| 6456 | -103735.556   | -20902.054 | 0.691  |
| 6457 | -103731.382   | -20901.345 | 4.233  |
| 7525 | -103723.542   | -20900.019 | 7.951  |
| 面積   | 150.2295635   |            |        |
| 地積   | 150.22㎡       |            |        |

2686

| 地番   | 幡四五九ノ二      |            |        |
|------|-------------|------------|--------|
| N O  | X           | Y          | 辺 長    |
| 7525 | -103723.542 | -20900.019 |        |
| 6457 | -103731.382 | -20901.345 | 7.951  |
| 4392 | -103731.339 | -20887.881 | 13.464 |
| 7524 | -103724.361 | -20887.896 | 6.978  |
| 3280 | -103724.399 | -20896.304 | 8.408  |
| 7525 | -103723.542 | -20900.019 | 3.812  |
| 面積   | 91.3679625  |            |        |
| 地積   | 91.36㎡      |            |        |

2687

| 地番   | 幡四五九ノ四      |            |        |
|------|-------------|------------|--------|
| N O  | X           | Y          | 辺 長    |
| 6457 | -103731.382 | -20901.345 |        |
| 6456 | -103735.556 | -20902.054 | 4.233  |
| 6553 | -103735.519 | -20891.134 | 10.920 |
| 6454 | -103735.517 | -20887.872 | 3.262  |
| 4392 | -103731.339 | -20887.881 | 4.178  |
| 6457 | -103731.382 | -20901.345 | 13.464 |
| 面積   | 57.6610710  |            |        |
| 地積   | 57.66㎡      |            |        |

2688

| 地番   | 幡四五九ノ三 幡四五九ノ五 |            |        |
|------|---------------|------------|--------|
| N O  | X             | Y          | 辺 長    |
| 7524 | -103724.361   | -20887.896 |        |
| 4392 | -103731.339   | -20887.881 | 6.978  |
| 6454 | -103735.517   | -20887.872 | 4.178  |
| 6552 | -103735.368   | -20874.616 | 13.256 |
| 6544 | -103724.242   | -20875.395 | 11.153 |
| 7523 | -103723.535   | -20875.439 | 0.708  |
| 3279 | -103724.327   | -20880.558 | 5.179  |
| 7524 | -103724.361   | -20887.896 | 7.338  |
| 面積   | 145.1361320   |            |        |
| 地積   | 145.13㎡       |            |        |

2689

| 地番   | 幡四五九ノ六      |            |        |
|------|-------------|------------|--------|
| N O  | X           | Y          | 辺 長    |
| 6552 | -103735.368 | -20874.616 |        |
| 6454 | -103735.517 | -20887.872 | 13.256 |
| 6553 | -103735.519 | -20891.134 | 3.262  |
| 6528 | -103755.180 | -20891.192 | 19.661 |
| 6529 | -103755.596 | -20888.149 | 3.071  |
| 6539 | -103755.719 | -20887.400 | 0.759  |
| 6530 | -103755.845 | -20886.955 | 0.462  |
| 6531 | -103756.208 | -20885.669 | 1.336  |
| 6532 | -103757.041 | -20881.600 | 4.153  |
| 6533 | -103757.016 | -20880.315 | 1.285  |
| 6534 | -103756.872 | -20878.749 | 1.572  |
| 6535 | -103756.480 | -20876.849 | 1.940  |
| 6536 | -103756.302 | -20876.205 | 0.668  |
| 6537 | -103755.629 | -20873.979 | 2.325  |
| 6538 | -103755.126 | -20873.257 | 0.879  |
| 6546 | -103754.066 | -20873.142 | 1.066  |
| 6547 | -103747.942 | -20872.983 | 6.126  |
| 6548 | -103743.707 | -20873.777 | 4.308  |
| 6549 | -103742.872 | -20873.827 | 0.836  |
| 6552 | -103735.368 | -20874.616 | 7.545  |
| 面積   | 365.1868005 |            |        |
| 地積   | 365.18㎡     |            |        |

2690

| 地番   | 幡四五八ノ三 幡四五八ノ四 |            |        |
|------|---------------|------------|--------|
| N O  | X             | Y          | 辺 長    |
| 7522 | -103723.429   | -20874.756 |        |
| 7523 | -103723.535   | -20875.439 | 0.691  |
| 6544 | -103724.242   | -20875.395 | 0.708  |
| 6552 | -103735.368   | -20874.616 | 11.153 |
| 6549 | -103742.872   | -20873.827 | 7.545  |
| 6550 | -103740.215   | -20869.642 | 4.957  |
| 7521 | -103722.828   | -20870.876 | 17.430 |
| 7522 | -103723.429   | -20874.756 | 3.926  |
| 面積   | 84.3200995    |            |        |
| 地積   | 84.32㎡        |            |        |

2691

| 地番   | 幡四五八ノ一 幡四五八ノ二 |            |        |
|------|---------------|------------|--------|
| N O  | X             | Y          | 辺 長    |
| 7521 | -103722.828   | -20870.876 |        |
| 6550 | -103740.215   | -20869.642 | 17.430 |
| 6551 | -103739.685   | -20868.824 | 0.974  |
| 4396 | -103737.778   | -20866.647 | 2.894  |
| 7520 | -103723.639   | -20850.505 | 21.458 |
| 3345 | -103722.681   | -20850.945 | 1.054  |
| 3346 | -103720.400   | -20855.180 | 4.810  |
| 3278 | -103722.486   | -20868.666 | 13.646 |
| 7521 | -103722.828   | -20870.876 | 2.236  |
| 面積   | 210.9250280   |            |        |
| 地積   | 210.92㎡       |            |        |

2692

| 地番   | 幡四五八 幡四五八ノ六 |            |        |
|------|-------------|------------|--------|
| N O  | X           | Y          | 辺 長    |
| 7520 | -103723.639 | -20850.505 |        |
| 4396 | -103737.778 | -20866.647 | 21.458 |
| 4400 | -103743.517 | -20861.604 | 7.639  |
| 4397 | -103744.046 | -20861.139 | 0.704  |
| 7518 | -103731.423 | -20846.707 | 19.173 |
| 3344 | -103731.064 | -20847.097 | 0.530  |
| 7519 | -103730.897 | -20847.174 | 0.183  |
| 7520 | -103723.639 | -20850.505 | 7.985  |
| 面積   | 168.8312655 |            |        |
| 地積   | 168.83㎡     |            |        |

2693

| 地番   | 幡四五八ノ五 幡四五八ノ七 |            |        |
|------|---------------|------------|--------|
| N O  | X             | Y          | 辺 長    |
| 7518 | -103731.423   | -20846.707 |        |
| 4397 | -103744.046   | -20861.139 | 19.173 |
| 4400 | -103743.517   | -20861.604 | 0.704  |
| 4396 | -103737.778   | -20866.647 | 7.639  |
| 6551 | -103739.685   | -20868.824 | 2.894  |
| 6550 | -103740.215   | -20869.642 | 0.974  |
| 6549 | -103742.872   | -20873.827 | 4.957  |
| 6548 | -103743.707   | -20873.777 | 0.836  |
| 6547 | -103747.942   | -20872.983 | 4.308  |
| 6546 | -103754.066   | -20873.142 | 6.126  |
| 6538 | -103755.126   | -20873.257 | 1.066  |
| 6452 | -103753.770   | -20867.694 | 5.725  |
| 4404 | -103752.060   | -20865.741 | 2.595  |
| 4402 | -103751.268   | -20864.837 | 1.201  |
| 6451 | -103750.754   | -20864.251 | 0.779  |
| 6545 | -103743.575   | -20856.060 | 10.891 |
| 7516 | -103733.451   | -20844.497 | 15.368 |
| 7517 | -103731.507   | -20846.615 | 2.874  |
| 7518 | -103731.423   | -20846.707 | 0.124  |
| 面積   | 206.1746425   |            |        |
| 地積   | 206.17㎡       |            |        |

2694

| 地番   | 保四五ノ二       |            |        |
|------|-------------|------------|--------|
| N O  | X           | Y          | 辺 長    |
| 7516 | -103733.451 | -20844.497 |        |
| 6545 | -103743.575 | -20856.060 | 15.368 |
| 7515 | -103751.073 | -20842.211 | 15.748 |
| 3343 | -103743.309 | -20838.010 | 8.827  |
| 3330 | -103738.684 | -20838.799 | 4.691  |
| 7516 | -103733.451 | -20844.497 | 7.736  |
| 面積   | 170.4547945 |            |        |
| 地積   | 170.45㎡     |            |        |

2695

| 地番   | 保四五ノ四       |            |        |
|------|-------------|------------|--------|
| N O  | X           | Y          | 辺 長    |
| 7515 | -103751.073 | -20842.211 |        |
| 6545 | -103743.575 | -20856.060 | 15.748 |
| 6451 | -103750.754 | -20864.251 | 10.891 |
| 7514 | -103760.043 | -20847.064 | 19.536 |
| 3331 | -103759.779 | -20846.921 | 0.300  |
| 7515 | -103751.073 | -20842.211 | 9.898  |
| 面積   | 180.0432570 |            |        |
| 地積   | 180.04㎡     |            |        |

2696

| 地番   | 幡四五七ノ二<br>幡四五七ノ四 | 幡四五七ノ三<br>幡四五七ノ五 |        |
|------|------------------|------------------|--------|
| N O  | X                | Y                | 辺 長    |
| 7514 | -103760.043      | -20847.064       |        |
| 6451 | -103750.754      | -20864.251       | 19.536 |
| 4402 | -103751.268      | -20864.837       | 0.779  |
| 4404 | -103752.060      | -20865.741       | 1.201  |
| 6452 | -103753.770      | -20867.694       | 2.595  |
| 6538 | -103755.126      | -20873.257       | 5.725  |
| 6537 | -103755.629      | -20873.979       | 0.879  |
| 6536 | -103756.302      | -20876.205       | 2.325  |
| 6535 | -103756.480      | -20876.849       | 0.668  |
| 5822 | -103758.312      | -20873.428       | 3.880  |
| 6453 | -103763.859      | -20863.186       | 11.647 |
| 7511 | -103769.745      | -20852.310       | 12.366 |
| 7512 | -103761.678      | -20847.948       | 9.170  |
| 7513 | -103760.686      | -20847.411       | 1.128  |
| 7514 | -103760.043      | -20847.064       | 0.730  |
| 面積   | 253.1172350      |                  |        |
| 地積   | 253.11㎡          |                  |        |

2697

| 地番   | 保四五ノ三       |            |        |
|------|-------------|------------|--------|
| N O  | X           | Y          | 辺 長    |
| 7511 | -103769.745 | -20852.310 |        |
| 6453 | -103763.859 | -20863.186 | 12.366 |
| 6541 | -103773.009 | -20868.138 | 10.404 |
| 7510 | -103778.893 | -20857.257 | 12.370 |
| 3320 | -103774.430 | -20854.843 | 5.074  |
| 7511 | -103769.745 | -20852.310 | 5.325  |
| 面積   | 128.6576095 |            |        |
| 地積   | 128.65㎡     |            |        |

2698

| 地番   | 幡四四四ノ二      |            |        |
|------|-------------|------------|--------|
| N O  | X           | Y          | 辺 長    |
| 7510 | -103778.893 | -20857.257 |        |
| 6541 | -103773.009 | -20868.138 | 12.370 |
| 7509 | -103785.856 | -20875.081 | 14.603 |
| 3318 | -103790.297 | -20866.858 | 9.345  |
| 3319 | -103789.085 | -20862.770 | 4.263  |
| 7510 | -103778.893 | -20857.257 | 11.587 |
| 面積   | 176.0185460 |            |        |
| 地積   | 176.01㎡     |            |        |

2699

| 地番   | 幡四五六ノ四      |            |        |
|------|-------------|------------|--------|
| N O  | X           | Y          | 辺 長    |
| 7509 | -103785.856 | -20875.081 |        |
| 6541 | -103773.009 | -20868.138 | 14.603 |
| 6453 | -103763.859 | -20863.186 | 10.404 |
| 5822 | -103758.312 | -20873.428 | 11.647 |
| 5823 | -103765.896 | -20877.543 | 8.628  |
| 6540 | -103770.117 | -20869.752 | 8.860  |
| 7508 | -103784.522 | -20877.551 | 16.380 |
| 7509 | -103785.856 | -20875.081 | 2.807  |
| 面積   | 146.430055  |            |        |
| 地積   | 146.43 ㎡    |            |        |

2702

| 地 番  | 幅四五六ノ一                |            |        |
|------|-----------------------|------------|--------|
| N O  | X                     | Y          | 辺 長    |
| 7506 | -103774.091           | -20886.832 |        |
| 6530 | -103755.845           | -20886.955 | 20.747 |
| 6539 | -103755.719           | -20887.400 | 0.462  |
| 6529 | -103755.596           | -20888.149 | 0.759  |
| 6528 | -103755.180           | -20891.192 | 3.071  |
| 5821 | -103755.425           | -20894.374 | 3.191  |
| 5820 | -103755.910           | -20897.578 | 3.240  |
| 5819 | -103756.800           | -20900.333 | 2.895  |
| 5818 | -103757.855           | -20902.969 | 2.839  |
| 5817 | -103759.492           | -20906.013 | 3.456  |
| 5816 | -103761.390           | -20909.021 | 3.556  |
| 5815 | -103761.716           | -20909.363 | 0.472  |
| 7505 | -103766.059           | -20911.691 | 4.927  |
| 3313 | -103766.560           | -20910.766 | 1.051  |
| 7506 | -103774.091           | -20896.832 | 15.838 |
| 面積   | 256.9901710           |            |        |
| 地 積  | 256.99 m <sup>2</sup> |            |        |

2703

| 地 番  | 幅四五九ノ七 幅四五九ノ八         |            |        |
|------|-----------------------|------------|--------|
| N O  | X                     | Y          | 辺 長    |
| 7505 | -103766.059           | -20911.691 |        |
| 5815 | -103761.716           | -20909.363 | 4.927  |
| 5816 | -103761.390           | -20909.021 | 0.472  |
| 5817 | -103759.492           | -20906.013 | 3.556  |
| 5818 | -103757.855           | -20902.969 | 3.456  |
| 5819 | -103756.800           | -20900.333 | 2.839  |
| 5820 | -103755.910           | -20897.578 | 2.895  |
| 5821 | -103755.425           | -20894.374 | 3.240  |
| 6528 | -103755.180           | -20891.192 | 3.191  |
| 6553 | -103735.519           | -20891.134 | 19.661 |
| 6456 | -103735.556           | -20902.054 | 10.920 |
| 6455 | -103736.238           | -20902.167 | 0.691  |
| 4391 | -103736.101           | -20903.216 | 1.057  |
| 5800 | -103734.770           | -20913.402 | 10.272 |
| 5798 | -103742.642           | -20914.370 | 7.931  |
| 5803 | -103746.189           | -20914.798 | 3.572  |
| 5799 | -103746.026           | -20911.794 | 3.008  |
| 5814 | -103758.740           | -20911.142 | 12.730 |
| 7504 | -103764.631           | -20914.331 | 6.698  |
| 7505 | -103766.059           | -20911.691 | 3.001  |
| 面積   | 494.4901740           |            |        |
| 地 積  | 494.49 m <sup>2</sup> |            |        |


2704

| 地 番  | 幅四五五A                 |            |        |
|------|-----------------------|------------|--------|
| N O  | X                     | Y          | 辺 長    |
| 7503 | -103742.047           | -20931.219 |        |
| 3308 | -103745.174           | -20931.332 | 3.129  |
| 3309 | -103758.637           | -20925.413 | 14.706 |
| 7504 | -103764.631           | -20914.331 | 12.599 |
| 5814 | -103758.740           | -20911.142 | 6.698  |
| 5799 | -103746.026           | -20911.794 | 12.730 |
| 5803 | -103746.189           | -20914.798 | 3.008  |
| 5798 | -103742.642           | -20914.370 | 3.572  |
| 7503 | -103742.047           | -20931.219 | 16.859 |
| 面積   | 314.9304230           |            |        |
| 地 積  | 314.93 m <sup>2</sup> |            |        |

2705

| 地 番  | 幅四六一ノ七                |            |        |
|------|-----------------------|------------|--------|
| N O  | X                     | Y          | 辺 長    |
| 7502 | -103732.554           | -20930.875 |        |
| 7503 | -103742.047           | -20931.219 | 9.499  |
| 5798 | -103742.642           | -20914.370 | 16.859 |
| 5800 | -103734.770           | -20913.402 | 7.931  |
| 5801 | -103734.762           | -20913.447 | 0.045  |
| 5802 | -103733.641           | -20922.506 | 9.128  |
| 7502 | -103732.554           | -20930.875 | 8.439  |
| 面積   | 149.7096805           |            |        |
| 地 積  | 149.70 m <sup>2</sup> |            |        |

|                 |                     |       |  |
|-----------------|---------------------|-------|--|
| 図面の種類           | 画 地 出 来 形 確 認 測 量 図 |       |  |
| 街 区 名           | 45 2/2              | 求 積 表 |  |
| 町 名             | 岩 倉 幡 枝 町           |       |  |
| 京都市洛北第三土地区画整理組合 |                     |       |  |

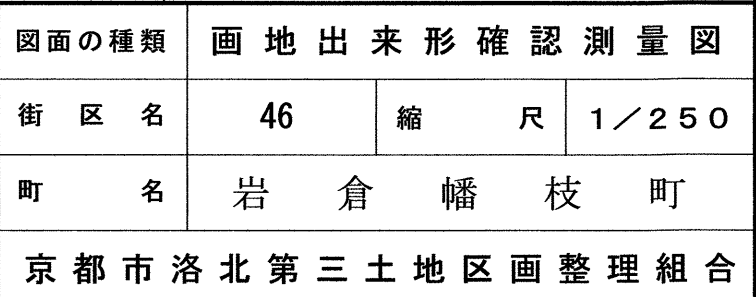

2740

|      |             |            |        |
|------|-------------|------------|--------|
| 地番   | 幡四五七ノ一      |            |        |
| N O  | X           | Y          | 辺長     |
| 3335 | -103747.236 | -20829.496 |        |
| 3334 | -103747.940 | -20833.677 | 4.239  |
| 3333 | -103762.654 | -20841.647 | 16.733 |
| 7263 | -103769.678 | -20845.449 | 7.986  |
| 5836 | -103780.136 | -20826.136 | 21.962 |
| 7262 | -103760.239 | -20815.361 | 22.627 |
| 3335 | -103747.236 | -20829.496 | 19.206 |
| 面積   | 552.1239910 |            |        |
| 地積   | 552.12㎡     |            |        |

2741

|      |             |            |        |
|------|-------------|------------|--------|
| 地番   | 幡四四五ノ三 幡四四六 |            |        |
| N O  | X           | Y          | 辺長     |
| 7267 | -103802.666 | -20813.588 |        |
| 7268 | -103802.050 | -20813.255 | 0.700  |
| 3353 | -103800.367 | -20812.345 | 1.913  |
| 3365 | -103787.990 | -20805.633 | 14.079 |
| 3364 | -103775.612 | -20798.927 | 14.077 |
| 3363 | -103773.920 | -20798.085 | 1.889  |
| 3362 | -103769.849 | -20799.669 | 4.368  |
| 3361 | -103760.549 | -20815.024 | 17.951 |
| 7262 | -103760.239 | -20815.361 | 0.457  |
| 5836 | -103780.136 | -20826.136 | 22.627 |
| 4094 | -103791.689 | -20832.393 | 13.138 |
| 5858 | -103792.299 | -20832.724 | 0.694  |
| 5832 | -103793.397 | -20830.712 | 2.292  |
| 5859 | -103796.748 | -20824.492 | 7.065  |
| 7267 | -103802.666 | -20813.588 | 12.406 |
| 面積   | 775.5644630 |            |        |
| 地積   | 775.56㎡     |            |        |

2742

|      |             |            |        |
|------|-------------|------------|--------|
| 地番   | 幡四四五ノ二      |            |        |
| N O  | X           | Y          | 辺長     |
| 7267 | -103802.666 | -20813.588 |        |
| 5859 | -103796.748 | -20824.492 | 12.406 |
| 7266 | -103809.479 | -20831.381 | 14.475 |
| 3351 | -103813.942 | -20823.129 | 9.381  |
| 3352 | -103812.756 | -20819.042 | 4.255  |
| 7267 | -103802.666 | -20813.588 | 11.469 |
| 面積   | 174.9941735 |            |        |
| 地積   | 174.99㎡     |            |        |

2743

|      |             |            |        |
|------|-------------|------------|--------|
| 地番   | 幡四四五ノ一      |            |        |
| N O  | X           | Y          | 辺長     |
| 5859 | -103796.748 | -20824.492 |        |
| 5832 | -103793.397 | -20830.712 | 7.065  |
| 7265 | -103806.122 | -20837.590 | 14.464 |
| 7266 | -103809.479 | -20831.381 | 7.058  |
| 5859 | -103796.748 | -20824.492 | 14.475 |
| 面積   | 102.1854150 |            |        |
| 地積   | 102.18㎡     |            |        |


2744

|      |             |            |        |
|------|-------------|------------|--------|
| 地番   | 幡四四八B       |            |        |
| N O  | X           | Y          | 辺長     |
| 5832 | -103793.397 | -20830.712 |        |
| 5858 | -103792.299 | -20832.724 | 2.292  |
| 7264 | -103805.033 | -20839.603 | 14.473 |
| 7265 | -103806.122 | -20837.590 | 2.288  |
| 5832 | -103793.397 | -20830.712 | 14.464 |
| 面積   | 33.1397585  |            |        |
| 地積   | 33.13㎡      |            |        |

2745

|      |             |            |        |
|------|-------------|------------|--------|
| 地番   | 幡四四八A       |            |        |
| N O  | X           | Y          | 辺長     |
| 7263 | -103769.678 | -20845.449 |        |
| 3332 | -103777.351 | -20849.601 | 8.724  |
| 3321 | -103791.940 | -20857.492 | 16.586 |
| 3322 | -103796.020 | -20856.273 | 4.258  |
| 3350 | -103804.982 | -20839.698 | 18.842 |
| 7264 | -103805.033 | -20839.603 | 0.107  |
| 5858 | -103792.299 | -20832.724 | 14.473 |
| 4094 | -103791.689 | -20832.393 | 0.694  |
| 5836 | -103780.136 | -20826.136 | 13.138 |
| 7263 | -103769.678 | -20845.449 | 21.962 |
| 面積   | 617.2206125 |            |        |
| 地積   | 617.22㎡     |            |        |

|                 |            |       |  |
|-----------------|------------|-------|--|
| 図面の種類           | 画地出来形確認測量図 |       |  |
| 街 区 名           | 46         | 求 積 表 |  |
| 町 名             | 岩 倉 幡 枝 町  |       |  |
| 京都市洛北第三土地区画整理組合 |            |       |  |

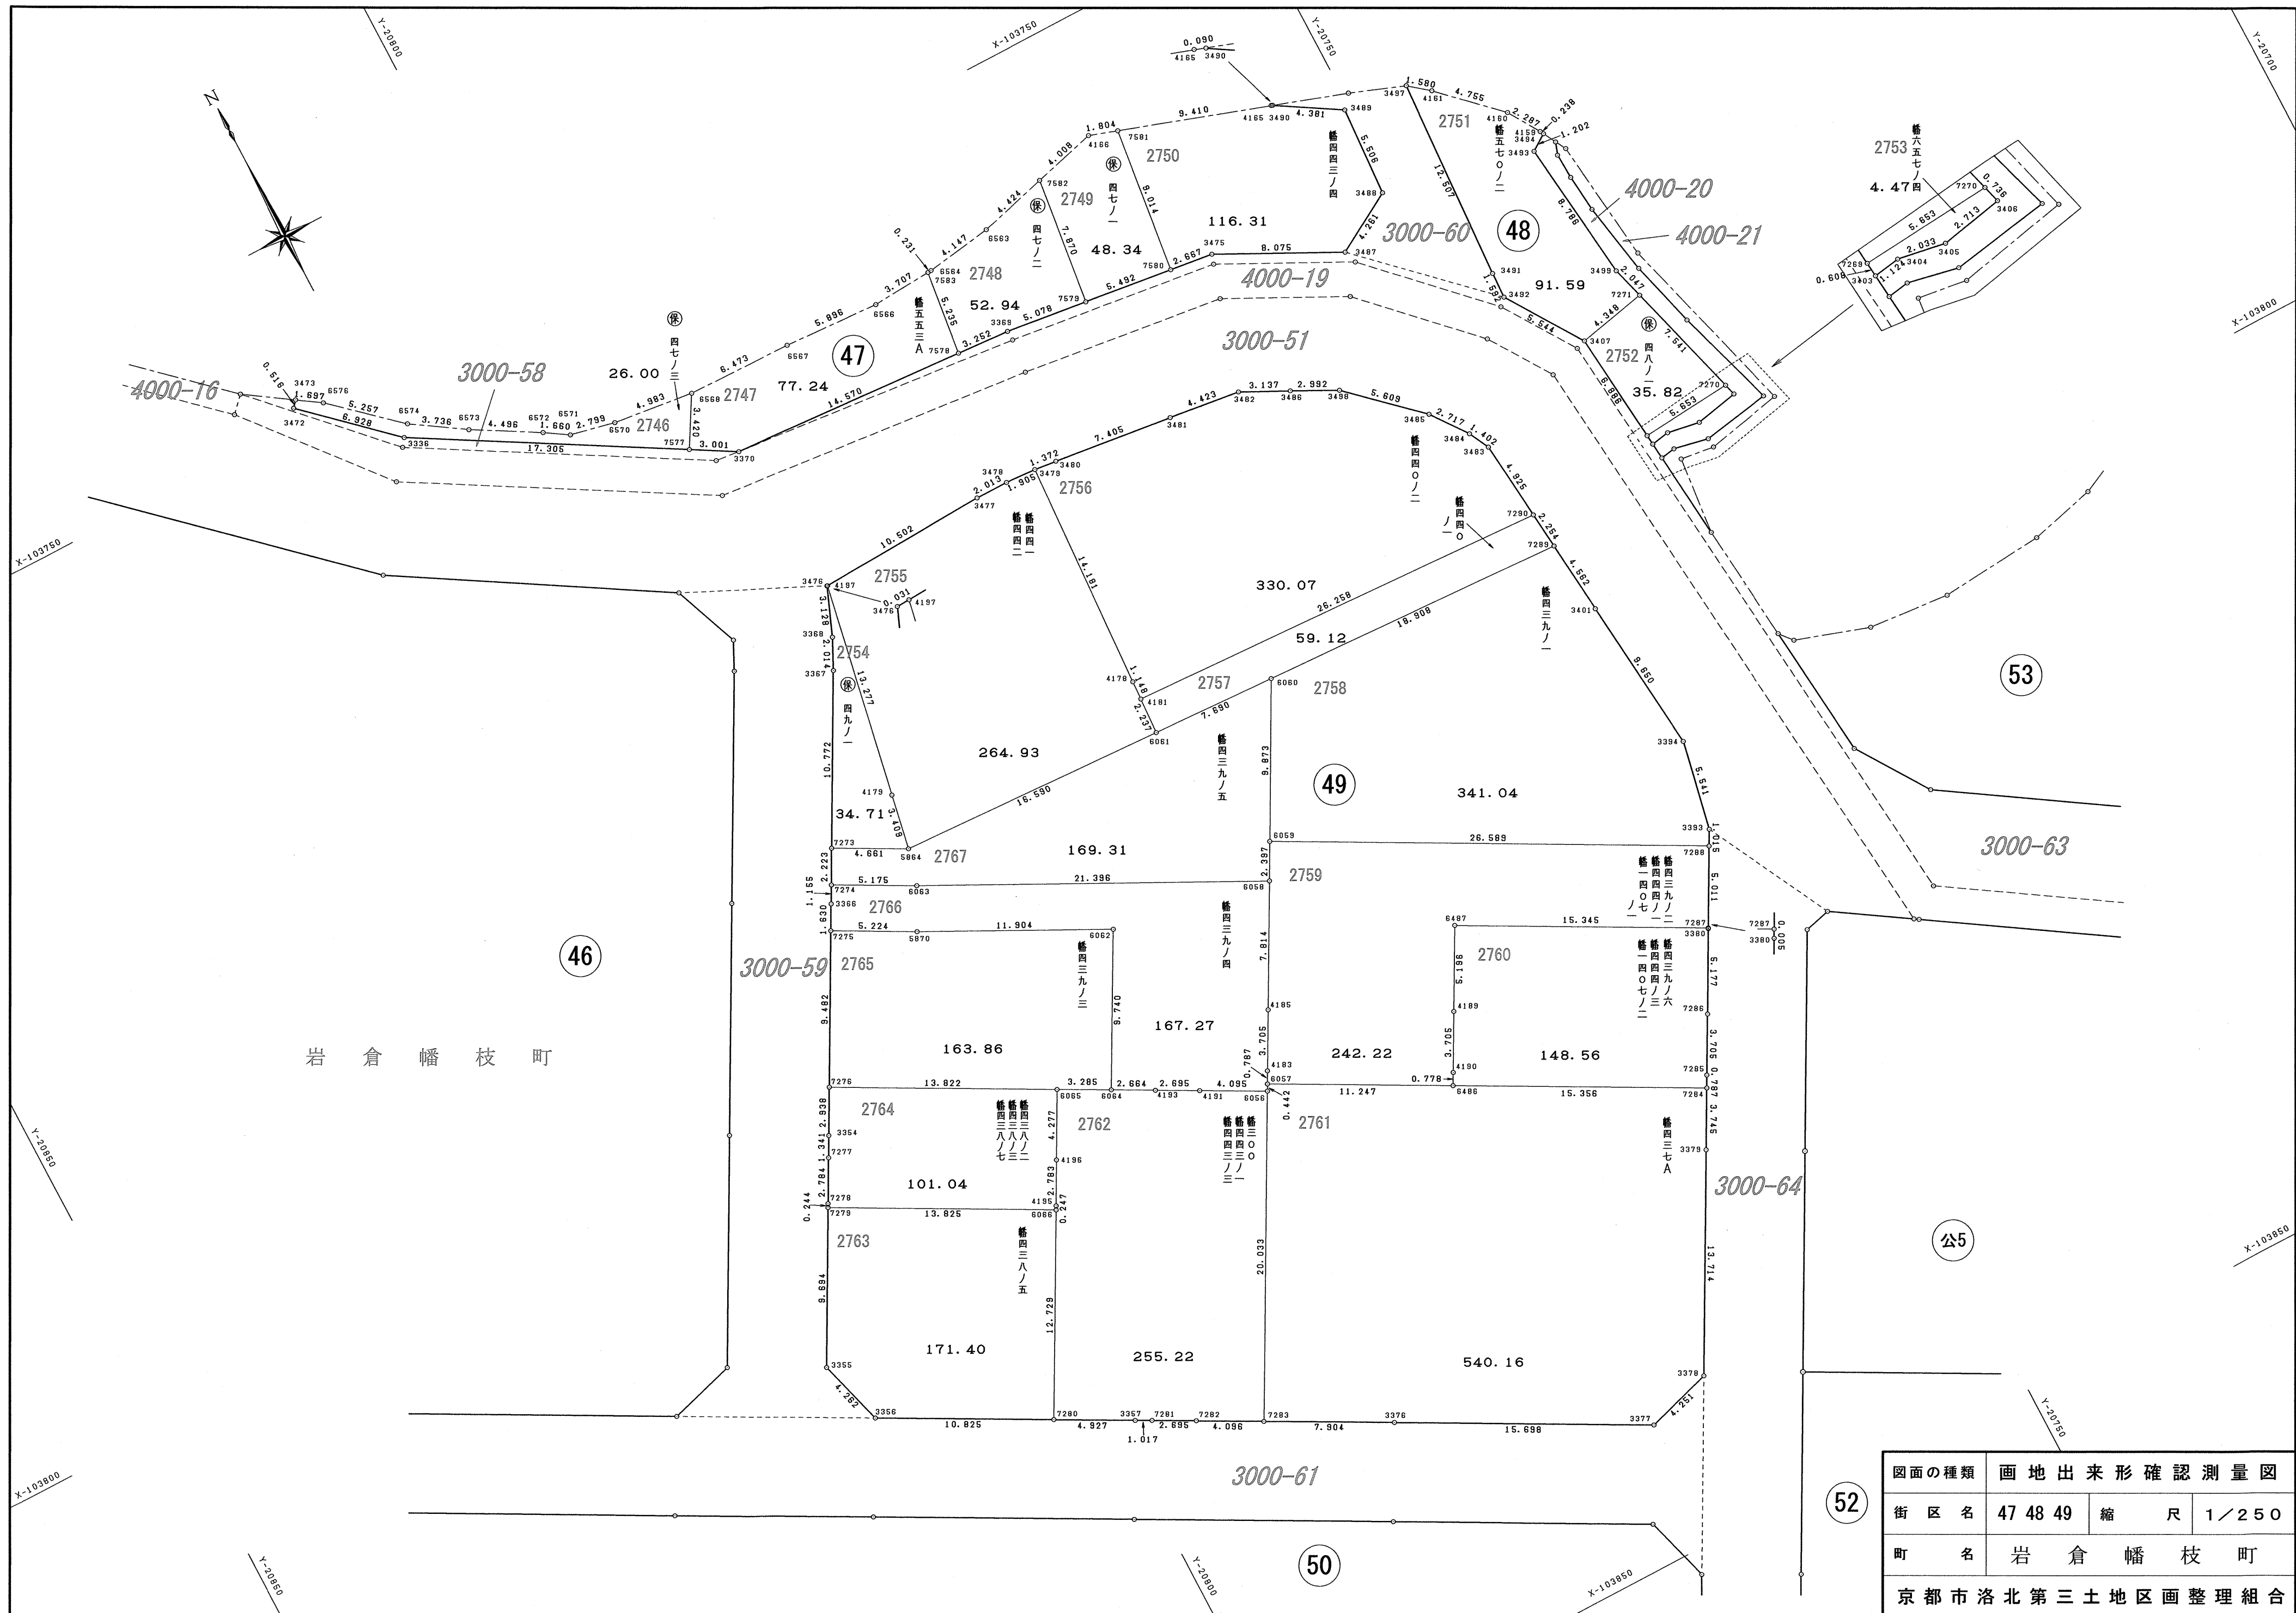

|                 |            |    |       |
|-----------------|------------|----|-------|
| 図面の種類           | 画地出来形確認測量図 |    |       |
| 街区名             | 47 48 49   | 縮尺 | 1／250 |
| 町名              | 岩倉幡枝町      |    |       |
| 京都市洛北第三土地区画整理組合 |            |    |       |

4 7 街 区

2746

| 地 番  | 保四七ノ三       |            |        |
|------|-------------|------------|--------|
| N O  | X           | Y          | 辺 長    |
| 3473 | -103748.668 | -20814.764 |        |
| 3472 | -103749.059 | -20815.101 | 0.516  |
| 3336 | -103753.753 | -20810.005 | 6.928  |
| 7577 | -103762.462 | -20795.051 | 17.305 |
| 6568 | -103759.504 | -20793.333 | 3.420  |
| 6570 | -103758.907 | -20798.281 | 4.983  |
| 6571 | -103758.308 | -20801.016 | 2.799  |
| 6572 | -103757.418 | -20802.418 | 1.660  |
| 6573 | -103755.159 | -20806.306 | 4.496  |
| 6574 | -103753.119 | -20809.436 | 3.736  |
| 6576 | -103749.611 | -20813.352 | 5.257  |
| 3473 | -103748.668 | -20814.764 | 1.697  |
| 面積   | 26.0070010  |            |        |
| 地積   | 26.00㎡      |            |        |

2747

| 地 番  | 幡五五三A       |            |        |
|------|-------------|------------|--------|
| N O  | X           | Y          | 辺 長    |
| 7577 | -103762.462 | -20795.051 |        |
| 3370 | -103763.973 | -20792.457 | 3.001  |
| 7578 | -103764.933 | -20777.918 | 14.570 |
| 7583 | -103759.737 | -20777.274 | 5.235  |
| 6566 | -103759.980 | -20780.974 | 3.707  |
| 6567 | -103759.651 | -20786.861 | 5.896  |
| 6568 | -103759.504 | -20793.333 | 6.473  |
| 7577 | -103762.462 | -20795.051 | 3.420  |
| 面積   | 77.2474295  |            |        |
| 地積   | 77.24㎡      |            |        |

2748

| 地 番  | 保四七ノ二       |            |       |
|------|-------------|------------|-------|
| N O  | X           | Y          | 辺 長   |
| 7578 | -103764.933 | -20777.918 |       |
| 3369 | -103765.147 | -20774.673 | 3.252 |
| 7579 | -103765.786 | -20769.635 | 5.078 |
| 7582 | -103757.976 | -20768.663 | 7.870 |
| 6563 | -103759.101 | -20772.942 | 4.424 |
| 6564 | -103759.722 | -20777.043 | 4.147 |
| 7583 | -103759.737 | -20777.274 | 0.231 |
| 7578 | -103764.933 | -20777.918 | 5.235 |
| 面積   | 52.9493015  |            |       |
| 地積   | 52.94㎡      |            |       |

2749

| 地 番  | 保四七ノ一       |            |       |
|------|-------------|------------|-------|
| N O  | X           | Y          | 辺 長   |
| 7579 | -103765.786 | -20769.635 |       |
| 7580 | -103766.477 | -20764.186 | 5.492 |
| 7581 | -103757.531 | -20763.076 | 9.014 |
| 4166 | -103756.956 | -20764.786 | 1.804 |
| 7582 | -103757.976 | -20768.663 | 4.008 |
| 7579 | -103765.786 | -20769.635 | 7.870 |
| 面積   | 48.3445845  |            |       |
| 地積   | 48.34㎡      |            |       |

4 8 街 区

2751

| 地 番  | 幡五七〇ノ二      |            |        |
|------|-------------|------------|--------|
| N O  | X           | Y          | 辺 長    |
| 3497 | -103763.310 | -20746.361 |        |
| 3491 | -103775.799 | -20747.046 | 12.507 |
| 3492 | -103777.390 | -20747.119 | 1.592  |
| 3407 | -103782.012 | -20744.056 | 5.544  |
| 7271 | -103781.119 | -20739.800 | 4.348  |
| 3499 | -103779.149 | -20740.358 | 2.047  |
| 3493 | -103770.422 | -20741.380 | 8.786  |
| 3494 | -103769.748 | -20740.384 | 1.202  |
| 4159 | -103769.532 | -20740.485 | 0.238  |
| 4160 | -103767.593 | -20741.698 | 2.287  |
| 4161 | -103764.307 | -20745.135 | 4.755  |
| 3497 | -103763.310 | -20746.361 | 1.580  |
| 面積   | 91.5904835  |            |        |
| 地積   | 91.59㎡      |            |        |

2752

| 地 番  | 保四八ノ一       |            |       |
|------|-------------|------------|-------|
| N O  | X           | Y          | 辺 長   |
| 3407 | -103782.012 | -20744.056 |       |
| 7269 | -103788.865 | -20743.379 | 6.886 |
| 7270 | -103788.376 | -20737.747 | 5.653 |
| 7271 | -103781.119 | -20739.800 | 7.541 |
| 3407 | -103782.012 | -20744.056 | 4.348 |
| 面積   | 35.8231350  |            |       |
| 地積   | 35.82㎡      |            |       |

2753

| 地 番  | 幡六五七ノ四      |            |       |
|------|-------------|------------|-------|
| N O  | X           | Y          | 辺 長   |
| 7269 | -103788.865 | -20743.379 |       |
| 3403 | -103789.471 | -20743.319 | 0.608 |
| 3404 | -103789.287 | -20742.210 | 1.124 |
| 3405 | -103789.624 | -20740.205 | 2.033 |
| 3406 | -103789.085 | -20737.546 | 2.713 |
| 7270 | -103788.376 | -20737.747 | 0.736 |
| 7269 | -103788.865 | -20743.379 | 5.653 |
| 面積   | 4.4777975   |            |       |
| 地積   | 4.47㎡       |            |       |

|                 |                     |     |       |
|-----------------|---------------------|-----|-------|
| 図面の種類           | 画 地 出 来 形 確 認 測 量 図 |     |       |
| 街 区 名           | 47 48 49            | 1/2 | 求 積 表 |
| 町 名             | 岩 倉 幡 枝 町           |     |       |
| 京都市洛北第三土地区画整理組合 |                     |     |       |

4 9 街 区

2754

| 地 番      保四九ノ一 |                         |            |        |
|----------------|-------------------------|------------|--------|
| N O            | X                       | Y          | 辺 長    |
| 3476           | -103773.685             | -20791.552 |        |
| 3368           | -103776.591             | -20792.711 | 3.128  |
| 3367           | -103778.394             | -20793.610 | 2.014  |
| 7273           | -103787.869             | -20798.736 | 10.772 |
| 5864           | -103790.079             | -20794.632 | 4.661  |
| 4179           | -103786.729             | -20793.996 | 3.409  |
| 4197           | -103773.684             | -20791.521 | 13.277 |
| 3476           | -103773.685             | -20791.552 | 0.031  |
| 面積             | 34.7183395              |            |        |
| 地積             | 34.71    m <sup>2</sup> |            |        |

2755

| 地 番      幡四四一    幡四四二 |                          |            |        |
|-----------------------|--------------------------|------------|--------|
| N O                   | X                        | Y          | 辺 長    |
| 3479                  | -103773.339              | -20777.114 |        |
| 3478                  | -103773.220              | -20779.016 | 1.905  |
| 3477                  | -103773.221              | -20781.029 | 2.013  |
| 4197                  | -103773.684              | -20791.521 | 10.502 |
| 4179                  | -103786.729              | -20793.996 | 13.277 |
| 5864                  | -103790.079              | -20794.632 | 3.409  |
| 6061                  | -103790.881              | -20778.061 | 16.590 |
| 4181                  | -103788.647              | -20777.940 | 2.237  |
| 4178                  | -103787.500              | -20777.878 | 1.148  |
| 3479                  | -103773.339              | -20777.114 | 14.181 |
| 面積                    | 264.9364420              |            |        |
| 地積                    | 264.93    m <sup>2</sup> |            |        |

2756

| 地 番      幡四四〇ノ二 |                          |            |        |
|-----------------|--------------------------|------------|--------|
| N O             | X                        | Y          | 辺 長    |
| 3479            | -103773.339              | -20777.114 |        |
| 4178            | -103787.500              | -20777.878 | 14.181 |
| 4181            | -103788.647              | -20777.940 | 1.148  |
| 7290            | -103789.890              | -20751.711 | 26.258 |
| 3483            | -103784.988              | -20752.190 | 4.925  |
| 3484            | -103783.739              | -20752.828 | 1.402  |
| 3485            | -103781.549              | -20754.437 | 2.717  |
| 3498            | -103777.735              | -20758.550 | 5.609  |
| 3486            | -103776.363              | -20761.210 | 2.992  |
| 3482            | -103774.952              | -20764.012 | 3.137  |
| 3481            | -103774.391              | -20768.400 | 4.423  |
| 3480            | -103773.490              | -20775.750 | 7.405  |
| 3479            | -103773.339              | -20777.114 | 1.372  |
| 面積              | 330.0722455              |            |        |
| 地積              | 330.07    m <sup>2</sup> |            |        |

2757

| 地 番      幡四四〇ノ一 |                         |            |        |
|-----------------|-------------------------|------------|--------|
| N O             | X                       | Y          | 辺 長    |
| 7290            | -103789.890             | -20751.711 |        |
| 4181            | -103788.647             | -20777.940 | 26.258 |
| 6061            | -103790.881             | -20778.061 | 2.237  |
| 6060            | -103791.249             | -20770.379 | 7.690  |
| 7289            | -103792.134             | -20751.491 | 18.908 |
| 7290            | -103789.890             | -20751.711 | 2.254  |
| 面積              | 59.1228115              |            |        |
| 地積              | 59.12    m <sup>2</sup> |            |        |

2758

| 地 番      幡四三九ノ一 |                          |            |        |
|-----------------|--------------------------|------------|--------|
| N O             | X                        | Y          | 辺 長    |
| 7289            | -103792.134              | -20751.491 |        |
| 6060            | -103791.249              | -20770.379 | 18.908 |
| 6059            | -103799.942              | -20775.060 | 9.873  |
| 7288            | -103812.604              | -20751.679 | 26.589 |
| 3393            | -103811.710              | -20751.197 | 1.015  |
| 3394            | -103806.279              | -20750.098 | 5.541  |
| 3401            | -103796.675              | -20751.047 | 9.650  |
| 7289            | -103792.134              | -20751.491 | 4.562  |
| 面積              | 341.0447840              |            |        |
| 地積              | 341.04    m <sup>2</sup> |            |        |

2759

| 地 番      幡四三九ノ二    幡四四四ノ一<br>幡一四〇七ノ一 |                          |            |        |
|--------------------------------------|--------------------------|------------|--------|
| N O                                  | X                        | Y          | 辺 長    |
| 7288                                 | -103812.604              | -20751.679 |        |
| 6059                                 | -103799.942              | -20775.060 | 26.589 |
| 6058                                 | -103802.050              | -20776.203 | 2.397  |
| 4185                                 | -103808.919              | -20779.929 | 7.814  |
| 4183                                 | -103812.176              | -20781.696 | 3.705  |
| 6057                                 | -103812.868              | -20782.071 | 0.787  |
| 6486                                 | -103818.210              | -20772.173 | 11.247 |
| 4190                                 | -103817.526              | -20771.801 | 0.778  |
| 4189                                 | -103814.270              | -20770.032 | 3.705  |
| 6487                                 | -103809.704              | -20767.552 | 5.196  |
| 7287                                 | -103817.014              | -20754.059 | 15.345 |
| 7288                                 | -103812.604              | -20751.679 | 5.011  |
| 面積                                   | 242.2257765              |            |        |
| 地積                                   | 242.22    m <sup>2</sup> |            |        |

2760

| 地 番      幡四三九ノ六    幡四四四ノ三<br>幡一四〇七ノ二 |                          |            |        |
|--------------------------------------|--------------------------|------------|--------|
| N O                                  | X                        | Y          | 辺 長    |
| 7287                                 | -103817.014              | -20754.059 |        |
| 6487                                 | -103809.704              | -20767.552 | 15.345 |
| 4189                                 | -103814.270              | -20770.032 | 5.196  |
| 4190                                 | -103817.526              | -20771.801 | 3.705  |
| 6486                                 | -103818.210              | -20772.173 | 0.778  |
| 7284                                 | -103825.521              | -20758.668 | 15.356 |
| 7285                                 | -103824.829              | -20758.293 | 0.787  |
| 7286                                 | -103821.571              | -20756.528 | 3.705  |
| 3380                                 | -103817.019              | -20754.062 | 5.177  |
| 7287                                 | -103817.014              | -20754.059 | 0.005  |
| 面積                                   | 148.5635170              |            |        |
| 地積                                   | 148.56    m <sup>2</sup> |            |        |

2761

| 地 番      幡四三七A |                          |            |        |
|----------------|--------------------------|------------|--------|
| N O            | X                        | Y          | 辺 長    |
| 7284           | -103825.521              | -20758.668 |        |
| 6486           | -103818.210              | -20772.173 | 15.356 |
| 6057           | -103812.868              | -20782.071 | 11.247 |
| 6056           | -103813.258              | -20782.278 | 0.442  |
| 7283           | -103830.872              | -20791.822 | 20.033 |
| 3376           | -103834.627              | -20784.866 | 7.904  |
| 3377           | -103842.094              | -20771.057 | 15.698 |
| 3378           | -103840.873              | -20766.985 | 4.251  |
| 3379           | -103828.814              | -20760.452 | 13.714 |
| 7284           | -103825.521              | -20758.668 | 3.745  |
| 面積             | 540.1638855              |            |        |
| 地積             | 540.16    m <sup>2</sup> |            |        |

2762

| 地 番      幡三〇〇    幡四四三ノ一<br>幡四四三ノ三 |                          |            |        |
|-----------------------------------|--------------------------|------------|--------|
| N O                               | X                        | Y          | 辺 長    |
| 7283                              | -103830.872              | -20791.822 |        |
| 6056                              | -103813.258              | -20782.279 | 20.033 |
| 4191                              | -103811.308              | -20785.881 | 4.095  |
| 4193                              | -103810.025              | -20788.252 | 2.695  |
| 6064                              | -103808.757              | -20790.595 | 2.664  |
| 6065                              | -103807.197              | -20793.487 | 3.285  |
| 4196                              | -103810.960              | -20795.521 | 4.277  |
| 4195                              | -103813.409              | -20796.845 | 2.783  |
| 6066                              | -103813.627              | -20796.962 | 0.247  |
| 7280                              | -103824.818              | -20803.028 | 12.729 |
| 3357                              | -103827.163              | -20798.694 | 4.927  |
| 7281                              | -103827.646              | -20797.799 | 1.017  |
| 7282                              | -103828.926              | -20795.427 | 2.695  |
| 7283                              | -103830.872              | -20791.822 | 4.096  |
| 面積                                | 255.2269640              |            |        |
| 地積                                | 255.22    m <sup>2</sup> |            |        |

2763

| 地 番      幡四三八ノ五 |                          |            |        |
|-----------------|--------------------------|------------|--------|
| N O             | X                        | Y          | 辺 長    |
| 7279            | -103807.041              | -20809.118 |        |
| 3355            | -103815.569              | -20813.729 | 9.694  |
| 3356            | -103819.665              | -20812.548 | 4.262  |
| 7280            | -103824.818              | -20803.028 | 10.825 |
| 6066            | -103813.627              | -20796.962 | 12.729 |
| 7279            | -103807.041              | -20809.118 | 13.825 |
| 面積              | 171.4009830              |            |        |
| 地積              | 171.40    m <sup>2</sup> |            |        |

2764

| 地 番      幡四三八ノ二    幡四三八ノ三<br>幡四三八ノ七 |                          |            |        |
|-------------------------------------|--------------------------|------------|--------|
| N O                                 | X                        | Y          | 辺 長    |
| 7276                                | -103800.612              | -20805.640 |        |
| 3354                                | -103803.196              | -20807.040 | 2.938  |
| 7277                                | -103804.376              | -20807.678 | 1.341  |
| 7278                                | -103806.826              | -20809.002 | 2.784  |
| 7279                                | -103807.041              | -20809.118 | 0.244  |
| 6066                                | -103813.627              | -20796.962 | 13.825 |
| 4195                                | -103813.409              | -20796.845 | 0.247  |
| 4196                                | -103810.960              | -20795.521 | 2.783  |
| 6065                                | -103807.197              | -20793.487 | 4.277  |
| 7276                                | -103800.612              | -20805.640 | 13.822 |
| 面積                                  | 101.0471905              |            |        |
| 地積                                  | 101.04    m <sup>2</sup> |            |        |

2765

| 地 番      幡四三九ノ三 |                          |            |        |
|-----------------|--------------------------|------------|--------|
| N O             | X                        | Y          | 辺 長    |
| 7275            | -103792.275              | -20801.121 |        |
| 7276            | -103800.612              | -20805.640 | 9.482  |
| 6065            | -103807.197              | -20793.487 | 13.822 |
| 6064            | -103808.757              | -20790.595 | 3.285  |
| 6062            | -103800.202              | -20785.938 | 9.740  |
| 5870            | -103794.765              | -20796.528 | 11.904 |
| 7275            | -103792.275              | -20801.121 | 5.224  |
| 面積              | 163.8661025              |            |        |
| 地積              | 163.86    m <sup>2</sup> |            |        |


2766

| 地 番      幡四三九ノ四 |                          |            |        |
|-----------------|--------------------------|------------|--------|
| N O             | X                        | Y          | 辺 長    |
| 7274            | -103789.825              | -20799.794 |        |
| 3366            | -103790.841              | -20800.344 | 1.155  |
| 7275            | -103792.275              | -20801.121 | 1.630  |
| 5870            | -103794.765              | -20796.528 | 5.224  |
| 6062            | -103800.202              | -20785.938 | 11.904 |
| 6064            | -103808.757              | -20790.595 | 9.740  |
| 4193            | -103810.025              | -20788.252 | 2.664  |
| 4191            | -103811.308              | -20785.881 | 2.695  |
| 6056            | -103813.258              | -20782.279 | 4.095  |
| 6057            | -103812.868              | -20782.071 | 0.442  |
| 4183            | -103812.176              | -20781.696 | 0.787  |
| 4185            | -103808.919              | -20779.929 | 3.705  |
| 6058            | -103802.050              | -20776.203 | 7.814  |
| 6063            | -103792.285              | -20795.241 | 21.396 |
| 7274            | -103789.825              | -20799.794 | 5.175  |
| 面積              | 167.2768815              |            |        |
| 地積              | 167.27    m <sup>2</sup> |            |        |

2767

| 地 番      幡四三九ノ五 |                          |            |        |
|-----------------|--------------------------|------------|--------|
| N O             | X                        | Y          | 辺 長    |
| 7273            | -103787.869              | -20798.736 |        |
| 7274            | -103789.825              | -20799.794 | 2.223  |
| 6063            | -103792.285              | -20795.241 | 5.175  |
| 6058            | -103802.050              | -20776.203 | 21.396 |
| 6059            | -103799.942              | -20775.060 | 2.397  |
| 6060            | -103791.249              | -20770.379 | 9.873  |
| 6061            | -103790.881              | -20778.061 | 7.690  |
| 5864            | -103790.079              | -20794.632 | 16.590 |
| 7273            | -103787.869              | -20798.736 | 4.661  |
| 面積              | 169.3144115              |            |        |
| 地積              | 169.31    m <sup>2</sup> |            |        |

|                               |                         |       |  |
|-------------------------------|-------------------------|-------|--|
| 図面の種類                         | 画 地 出 来 形 確 認 測 量 図     |       |  |
| 街 区 名                         | 47 48 49 <sub>2/2</sub> | 求 積 表 |  |
| 町 名                           | 岩 倉 幡 枝 町               |       |  |
| 京 都 市 洛 北 第 三 土 地 区 画 整 理 組 合 |                         |       |  |

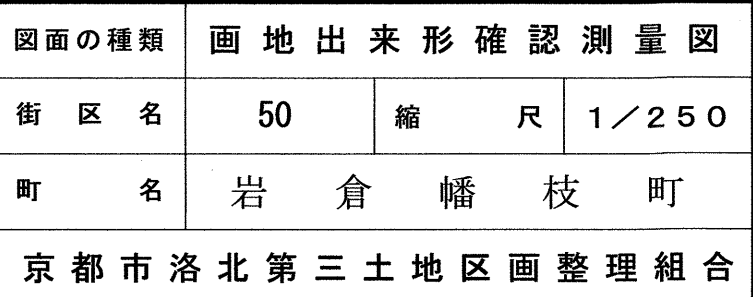

|      |             |            |        |
|------|-------------|------------|--------|
| 2768 |             |            |        |
| 地番   | 幡四四九ノ一      |            |        |
| N O  | X           | Y          | 辺 長    |
| 7306 | -103804.080 | -20853.986 |        |
| 3323 | -103801.310 | -20859.112 | 5.826  |
| 3329 | -103802.544 | -20863.218 | 4.287  |
| 3388 | -103815.409 | -20870.180 | 14.627 |
| 4123 | -103821.653 | -20873.559 | 7.099  |
| 4124 | -103825.867 | -20865.775 | 8.851  |
| 7306 | -103804.080 | -20853.986 | 24.772 |
| 面積   | 214.6329575 |            |        |
| 地積   | 214.63㎡     |            |        |

|      |             |            |        |
|------|-------------|------------|--------|
| 2769 |             |            |        |
| 地番   | 幡四四九A       |            |        |
| N O  | X           | Y          | 辺 長    |
| 7306 | -103804.080 | -20853.986 |        |
| 4124 | -103825.867 | -20865.775 | 24.772 |
| 6024 | -103831.596 | -20855.192 | 12.034 |
| 6023 | -103832.999 | -20852.591 | 2.955  |
| 7305 | -103811.202 | -20840.813 | 24.775 |
| 3324 | -103810.237 | -20842.595 | 2.026  |
| 7306 | -103804.080 | -20853.986 | 12.948 |
| 面積   | 371.2037370 |            |        |
| 地積   | 371.20㎡     |            |        |

|      |             |            |        |
|------|-------------|------------|--------|
| 2770 |             |            |        |
| 地番   | 幡四四五ノ四      |            |        |
| N O  | X           | Y          | 辺 長    |
| 7305 | -103811.202 | -20840.813 |        |
| 6023 | -103832.999 | -20852.591 | 24.775 |
| 6026 | -103837.909 | -20843.494 | 10.337 |
| 6027 | -103840.033 | -20839.595 | 4.439  |
| 6028 | -103831.452 | -20834.943 | 9.760  |
| 7304 | -103818.247 | -20827.798 | 15.014 |
| 7305 | -103811.202 | -20840.813 | 14.799 |
| 面積   | 366.3576980 |            |        |
| 地積   | 366.35㎡     |            |        |

|      |             |            |        |
|------|-------------|------------|--------|
| 2771 |             |            |        |
| 地番   | 幡四四五ノ九      |            |        |
| N O  | X           | Y          | 辺 長    |
| 7304 | -103818.247 | -20827.798 |        |
| 6028 | -103831.452 | -20834.943 | 15.014 |
| 6031 | -103836.691 | -20825.240 | 11.027 |
| 7303 | -103823.484 | -20818.109 | 15.009 |
| 3360 | -103819.202 | -20826.035 | 9.008  |
| 7304 | -103818.247 | -20827.798 | 2.005  |
| 面積   | 165.4241380 |            |        |
| 地積   | 165.42㎡     |            |        |

|      |             |            |        |
|------|-------------|------------|--------|
| 2772 |             |            |        |
| 地番   | 幡四四五ノ五      |            |        |
| N O  | X           | Y          | 辺 長    |
| 7303 | -103823.484 | -20818.109 |        |
| 6031 | -103836.691 | -20825.240 | 15.009 |
| 6028 | -103831.452 | -20834.943 | 11.027 |
| 6027 | -103840.033 | -20839.595 | 9.760  |
| 6030 | -103846.697 | -20827.237 | 14.040 |
| 3359 | -103824.916 | -20815.460 | 24.761 |
| 7303 | -103823.484 | -20818.109 | 3.011  |
| 面積   | 182.0681835 |            |        |
| 地積   | 182.06㎡     |            |        |

|      |             |            |        |
|------|-------------|------------|--------|
| 2773 |             |            |        |
| 地番   | 幡四四五ノ六      |            |        |
| N O  | X           | Y          | 辺 長    |
| 3359 | -103824.916 | -20815.460 |        |
| 6030 | -103846.697 | -20827.237 | 24.761 |
| 6038 | -103849.152 | -20822.677 | 5.178  |
| 6033 | -103853.364 | -20814.903 | 8.841  |
| 6032 | -103844.784 | -20810.259 | 9.756  |
| 6029 | -103839.558 | -20819.972 | 11.029 |
| 5857 | -103827.691 | -20813.542 | 13.497 |
| 7302 | -103827.052 | -20811.511 | 2.129  |
| 3359 | -103824.916 | -20815.460 | 4.489  |
| 面積   | 182.8012300 |            |        |
| 地積   | 182.80㎡     |            |        |

|      |             |            |        |
|------|-------------|------------|--------|
| 2774 |             |            |        |
| 地番   | 幡四四五ノ七      |            |        |
| N O  | X           | Y          | 辺 長    |
| 7302 | -103827.052 | -20811.511 |        |
| 5857 | -103827.691 | -20813.542 | 2.129  |
| 6029 | -103839.558 | -20819.972 | 13.497 |
| 6032 | -103844.784 | -20810.259 | 11.029 |
| 7301 | -103831.595 | -20803.112 | 15.000 |
| 7302 | -103827.052 | -20811.511 | 9.548  |
| 面積   | 164.4621515 |            |        |
| 地積   | 164.46㎡     |            |        |

|      |             |            |        |
|------|-------------|------------|--------|
| 2775 |             |            |        |
| 地番   | 幡六五五        |            |        |
| N O  | X           | Y          | 辺 長    |
| 7301 | -103831.595 | -20803.112 |        |
| 6032 | -103844.784 | -20810.259 | 15.000 |
| 6033 | -103853.364 | -20814.903 | 9.756  |
| 6034 | -103861.380 | -20800.034 | 16.892 |
| 6035 | -103859.551 | -20799.045 | 2.079  |
| 7300 | -103839.632 | -20788.254 | 22.654 |
| 3358 | -103832.441 | -20801.548 | 15.114 |
| 7301 | -103831.595 | -20803.112 | 1.778  |
| 面積   | 418.0211285 |            |        |
| 地積   | 418.02㎡     |            |        |

|      |             |            |        |
|------|-------------|------------|--------|
| 2776 |             |            |        |
| 地番   | 幡四三八ノ一      |            |        |
| N O  | X           | Y          | 辺 長    |
| 7300 | -103839.632 | -20788.254 |        |
| 6035 | -103859.551 | -20799.045 | 22.654 |
| 7299 | -103868.724 | -20782.057 | 19.306 |
| 3372 | -103864.270 | -20779.647 | 5.064  |
| 3373 | -103851.444 | -20772.710 | 14.581 |
| 3374 | -103847.375 | -20773.913 | 4.243  |
| 3375 | -103839.911 | -20787.738 | 15.711 |
| 7300 | -103839.632 | -20788.254 | 0.586  |
| 面積   | 432.7115550 |            |        |
| 地積   | 432.71㎡     |            |        |

|      |             |            |        |
|------|-------------|------------|--------|
| 2777 |             |            |        |
| 地番   | 幡五三〇ノ九      |            |        |
| N O  | X           | Y          | 辺 長    |
| 7299 | -103868.724 | -20782.057 |        |
| 6035 | -103859.551 | -20799.045 | 19.306 |
| 6034 | -103861.380 | -20800.034 | 2.079  |
| 6040 | -103867.511 | -20803.350 | 6.970  |
| 6041 | -103872.075 | -20794.918 | 9.587  |
| 7298 | -103876.703 | -20786.374 | 9.716  |
| 7299 | -103868.724 | -20782.057 | 9.071  |
| 面積   | 174.9088640 |            |        |
| 地積   | 174.90㎡     |            |        |

|      |             |            |        |
|------|-------------|------------|--------|
| 2778 |             |            |        |
| 地番   | 幡五二九ノ五〇     |            |        |
| N O  | X           | Y          | 辺 長    |
| 7298 | -103876.703 | -20786.374 |        |
| 6041 | -103872.075 | -20794.918 | 9.716  |
| 7297 | -103887.940 | -20803.486 | 18.030 |
| 2385 | -103891.138 | -20797.597 | 6.701  |
| 3386 | -103889.899 | -20793.512 | 4.268  |
| 3371 | -103877.081 | -20786.578 | 14.573 |
| 7298 | -103876.703 | -20786.374 | 0.429  |
| 面積   | 170.5849955 |            |        |
| 地積   | 170.58㎡     |            |        |

|      |             |            |        |
|------|-------------|------------|--------|
| 2779 |             |            |        |
| 地番   | 幡五二九ノ一      |            |        |
| N O  | X           | Y          | 辺 長    |
| 7297 | -103887.940 | -20803.486 |        |
| 6041 | -103872.075 | -20794.918 | 18.030 |
| 6040 | -103867.511 | -20803.350 | 9.587  |
| 7296 | -103883.358 | -20811.920 | 18.015 |
| 7297 | -103887.940 | -20803.486 | 9.598  |
| 面積   | 172.8996850 |            |        |
| 地積   | 172.89㎡     |            |        |

|      |             |            |        |
|------|-------------|------------|--------|
| 2780 |             |            |        |
| 地番   | 幡四三六ノ二      |            |        |
| N O  | X           | Y          | 辺 長    |
| 7296 | -103883.358 | -20811.920 |        |
| 6040 | -103867.511 | -20803.350 | 18.015 |
| 6034 | -103861.380 | -20800.034 | 6.970  |
| 6033 | -103853.364 | -20814.903 | 16.892 |
| 6038 | -103849.152 | -20822.677 | 8.841  |
| 6037 | -103859.698 | -20828.366 | 11.982 |
| 6039 | -103867.642 | -20813.681 | 16.695 |
| 7295 | -103879.071 | -20819.846 | 12.985 |
| 2384 | -103881.895 | -20814.614 | 5.945  |
| 7296 | -103883.358 | -20811.920 | 3.065  |
| 面積   | 425.4411325 |            |        |
| 地積   | 425.44㎡     |            |        |

|      |             |            |        |
|------|-------------|------------|--------|
| 2781 |             |            |        |
| 地番   | 幡四三六ノ一      |            |        |
| N O  | X           | Y          | 辺 長    |
| 7295 | -103879.071 | -20819.846 |        |
| 6039 | -103867.642 | -20813.681 | 12.985 |
| 6037 | -103859.698 | -20828.366 | 16.695 |
| 7294 | -103871.141 | -20834.534 | 12.999 |
| 2381 | -103872.697 | -20831.653 | 3.274  |
| 7295 | -103879.071 | -20819.846 | 13.417 |
| 面積   | 216.9024235 |            |        |
| 地積   | 216.90㎡     |            |        |

|      |             |            |        |
|------|-------------|------------|--------|
| 2782 |             |            |        |
| 地番   | 幡四四七ノ一      |            |        |
| N O  | X           | Y          | 辺 長    |
| 7294 | -103871.141 | -20834.534 |        |
| 6037 | -103859.698 | -20828.366 | 12.999 |
| 6038 | -103849.152 | -20822.677 | 11.982 |
| 6030 | -103846.697 | -20827.237 | 5.178  |
| 6027 | -103840.033 | -20839.595 | 14.040 |
| 6026 | -103837.909 | -20843.494 | 4.439  |
| 7293 | -103859.898 | -20855.353 | 24.983 |
| 2374 | -103863.498 | -20848.690 | 7.573  |
| 7294 | -103871.141 | -20834.534 | 16.087 |
| 面積   | 590.8649915 |            |        |
| 地積   | 590.86㎡     |            |        |

|      |             |            |        |
|------|-------------|------------|--------|
| 2783 |             |            |        |
| 地番   | 幡四四七ノ二      |            |        |
| N O  | X           | Y          | 辺 長    |
| 7293 | -103859.898 | -20855.353 |        |
| 6026 | -103837.909 | -20843.494 | 24.983 |
| 6023 | -103832.999 | -20852.591 | 10.337 |
| 6024 | -103831.596 | -20855.192 | 2.955  |
| 6025 | -103839.930 | -20859.691 | 9.470  |
| 6042 | -103844.968 | -20850.361 | 10.603 |
| 7292 | -103858.616 | -20857.725 | 15.507 |
| 7293 | -103859.898 | -20855.353 | 2.696  |
| 面積   | 167.7285200 |            |        |
| 地積   | 167.72㎡     |            |        |

|      |             |            |        |
|------|-------------|------------|--------|
| 2784 |             |            |        |
| 地番   | 幡四四七ノ三      |            |        |
| N O  | X           | Y          | 辺 長    |
| 7292 | -103858.616 | -20857.725 |        |
| 6042 | -103844.968 | -20850.361 | 15.507 |
| 6025 | -103839.930 | -20859.691 | 10.603 |
| 7291 | -103853.566 | -20867.070 | 15.504 |
| 2373 | -103854.292 | -20865.728 | 1.525  |
| 7292 | -103858.616 | -20857.725 | 9.096  |
| 面積   | 164.5677060 |            |        |
| 地積   | 164.56㎡     |            |        |

|      |             |            |        |
|------|-------------|------------|--------|
| 2785 |             |            |        |
| 地番   | 幡四四九B       |            |        |
| N O  | X           | Y          | 辺 長    |
| 7291 | -103853.566 | -20867.070 |        |
| 6025 | -103839.930 | -20859.691 | 15.504 |
| 6024 | -103831.596 | -20855.192 | 9.470  |
| 4124 | -103825.867 | -20865.775 | 12.034 |
| 4123 | -103821.653 | -20873.559 | 8.851  |
| 3389 | -103828.213 | -20877.109 | 7.458  |
| 3390 | -103840.997 | -20884.024 | 14.534 |
| 2372 | -103845.060 | -20882.791 | 4.245  |
| 7291 | -103853.566 | -20867.070 | 17.874 |
| 面積   | 517.3360130 |            |        |
| 地積   | 517.33㎡     |            |        |

|                               |                     |       |  |
|-------------------------------|---------------------|-------|--|
| 図面の種類                         | 画 地 出 来 形 確 認 測 量 図 |       |  |
| 街 区 名                         | 50                  | 求 積 表 |  |
| 町 名                           | 岩 倉 幡 枝 町           |       |  |
| 京 都 市 洛 北 第 三 土 地 区 画 整 理 組 合 |                     |       |  |

|      |             |            |        |
|------|-------------|------------|--------|
| 2822 |             |            |        |
| 地番   | 保五一ノ一       |            |        |
| N O  | X           | Y          | 辺 長    |
| 2378 | -103855.704 | -20888.384 |        |
| 2377 | -103856.827 | -20892.567 | 4.331  |
| 7595 | -103863.708 | -20896.295 | 7.825  |
| 5899 | -103872.242 | -20880.548 | 17.910 |
| 7596 | -103862.677 | -20875.494 | 10.818 |
| 2378 | -103855.704 | -20888.384 | 14.655 |
| 面積   | 188.3412665 |            |        |
| 地積   | 188.34㎡     |            |        |

|      |             |            |        |
|------|-------------|------------|--------|
| 2823 |             |            |        |
| 地番   | 幡四〇二ノ三      |            |        |
| N O  | X           | Y          | 辺 長    |
| 7596 | -103862.677 | -20875.494 |        |
| 5899 | -103872.242 | -20880.548 | 10.818 |
| 5898 | -103876.195 | -20882.653 | 4.478  |
| 7870 | -103880.596 | -20877.270 | 6.953  |
| 7869 | -103865.912 | -20869.514 | 16.606 |
| 2379 | -103864.817 | -20871.537 | 2.300  |
| 7596 | -103862.677 | -20875.494 | 4.498  |
| 面積   | 108.5114825 |            |        |
| 地積   | 108.51㎡     |            |        |

|      |             |            |        |
|------|-------------|------------|--------|
| 2824 |             |            |        |
| 地番   | 幡四〇二ノ二      |            |        |
| N O  | X           | Y          | 辺 長    |
| 7869 | -103865.912 | -20869.514 |        |
| 7870 | -103880.596 | -20877.270 | 16.606 |
| 4988 | -103884.987 | -20871.899 | 6.937  |
| 4987 | -103869.150 | -20863.533 | 17.910 |
| 7869 | -103865.912 | -20869.514 | 6.801  |
| 面積   | 117.3672825 |            |        |
| 地積   | 117.36㎡     |            |        |

|      |             |            |        |
|------|-------------|------------|--------|
| 2825 |             |            |        |
| 地番   | 幡四〇二ノ一      |            |        |
| N O  | X           | Y          | 辺 長    |
| 4987 | -103869.150 | -20863.533 |        |
| 4988 | -103884.987 | -20871.899 | 17.910 |
| 5897 | -103894.756 | -20859.950 | 15.434 |
| 7612 | -103901.198 | -20852.101 | 10.154 |
| 7597 | -103881.182 | -20841.290 | 22.749 |
| 2380 | -103874.062 | -20854.459 | 14.970 |
| 4987 | -103869.150 | -20863.533 | 10.318 |
| 面積   | 512.0390835 |            |        |
| 地積   | 512.03㎡     |            |        |

|      |             |            |        |
|------|-------------|------------|--------|
| 2826 |             |            |        |
| 地番   | 幡四三五        |            |        |
| N O  | X           | Y          | 辺 長    |
| 7597 | -103881.182 | -20841.290 |        |
| 7612 | -103901.198 | -20852.101 | 22.749 |
| 6174 | -103904.898 | -20847.593 | 5.831  |
| 6171 | -103911.224 | -20833.331 | 15.602 |
| 7611 | -103919.958 | -20814.202 | 21.028 |
| 7598 | -103901.300 | -20804.107 | 21.213 |
| 2383 | -103892.441 | -20820.473 | 18.609 |
| 2382 | -103883.271 | -20837.427 | 19.275 |
| 7597 | -103881.182 | -20841.290 | 4.391  |
| 面積   | 955.2570735 |            |        |
| 地積   | 955.25㎡     |            |        |

|      |             |            |        |
|------|-------------|------------|--------|
| 2827 |             |            |        |
| 地番   | 幡四三四ノ四      |            |        |
| N O  | X           | Y          | 辺 長    |
| 7598 | -103901.300 | -20804.107 |        |
| 7611 | -103919.958 | -20814.202 | 21.213 |
| 7610 | -103923.826 | -20805.730 | 9.313  |
| 7599 | -103905.711 | -20795.943 | 20.589 |
| 2388 | -103901.740 | -20803.293 | 8.354  |
| 7598 | -103901.300 | -20804.107 | 0.925  |
| 面積   | 194.0888735 |            |        |
| 地積   | 194.08㎡     |            |        |

|      |             |            |        |
|------|-------------|------------|--------|
| 2828 |             |            |        |
| 地番   | 幡四三四ノ一      |            |        |
| N O  | X           | Y          | 辺 長    |
| 7599 | -103905.711 | -20795.943 |        |
| 7610 | -103923.826 | -20805.730 | 20.589 |
| 6167 | -103924.347 | -20804.588 | 1.255  |
| 7613 | -103922.372 | -20792.024 | 12.718 |
| 2390 | -103911.126 | -20785.943 | 12.784 |
| 2389 | -103907.409 | -20792.801 | 7.800  |
| 7599 | -103905.711 | -20795.943 | 3.571  |
| 面積   | 194.1388655 |            |        |
| 地積   | 194.13㎡     |            |        |

|      |             |            |        |
|------|-------------|------------|--------|
| 2829 |             |            |        |
| 地番   | 保五一ノ二       |            |        |
| N O  | X           | Y          | 辺 長    |
| 2391 | -103911.598 | -20785.069 |        |
| 7614 | -103922.438 | -20790.928 | 12.322 |
| 6170 | -103923.090 | -20788.930 | 2.101  |
| 6166 | -103929.096 | -20777.198 | 13.179 |
| 6165 | -103929.413 | -20776.611 | 0.667  |
| 7600 | -103919.177 | -20771.051 | 11.648 |
| 2392 | -103914.824 | -20779.095 | 9.146  |
| 2391 | -103911.598 | -20785.069 | 6.789  |
| 面積   | 188.4751415 |            |        |
| 地積   | 188.47㎡     |            |        |

|      |             |            |        |
|------|-------------|------------|--------|
| 2830 |             |            |        |
| 地番   | 保五一ノ三       |            |        |
| N O  | X           | Y          | 辺 長    |
| 7600 | -103919.177 | -20771.051 |        |
| 6165 | -103929.413 | -20776.611 | 11.648 |
| 6164 | -103937.046 | -20762.599 | 15.956 |
| 7601 | -103926.757 | -20757.047 | 11.691 |
| 2394 | -103922.332 | -20765.221 | 9.294  |
| 7600 | -103919.177 | -20771.051 | 6.628  |
| 面積   | 186.0232040 |            |        |
| 地積   | 186.02㎡     |            |        |

|      |             |            |        |
|------|-------------|------------|--------|
| 2831 |             |            |        |
| 地番   | 幡四三三ノ七      |            |        |
| N O  | X           | Y          | 辺 長    |
| 7601 | -103926.757 | -20757.047 |        |
| 6164 | -103937.046 | -20762.599 | 11.691 |
| 6706 | -103942.846 | -20765.731 | 6.591  |
| 6156 | -103943.791 | -20764.020 | 1.954  |
| 6155 | -103947.161 | -20757.772 | 7.098  |
| 7602 | -103931.060 | -20749.095 | 18.290 |
| 2395 | -103927.973 | -20754.802 | 6.488  |
| 7601 | -103926.757 | -20757.047 | 2.553  |
| 面積   | 165.5007195 |            |        |
| 地積   | 165.50㎡     |            |        |

|      |             |            |        |
|------|-------------|------------|--------|
| 2832 |             |            |        |
| 地番   | 幡四三三ノ八      |            |        |
| N O  | X           | Y          | 辺 長    |
| 7602 | -103931.060 | -20749.095 |        |
| 6155 | -103947.161 | -20757.772 | 18.290 |
| 6154 | -103951.451 | -20749.793 | 9.059  |
| 7603 | -103935.374 | -20741.122 | 18.266 |
| 7602 | -103931.060 | -20749.095 | 9.065  |
| 面積   | 165.6414120 |            |        |
| 地積   | 165.64㎡     |            |        |

|      |             |            |        |
|------|-------------|------------|--------|
| 2833 |             |            |        |
| 地番   | 幡四三三ノ九      |            |        |
| N O  | X           | Y          | 辺 長    |
| 7603 | -103935.374 | -20741.122 |        |
| 6154 | -103951.451 | -20749.793 | 18.266 |
| 6153 | -103955.748 | -20741.813 | 9.063  |
| 7604 | -103939.683 | -20733.154 | 18.250 |
| 2396 | -103935.643 | -20740.625 | 8.493  |
| 7603 | -103935.374 | -20741.122 | 0.565  |
| 面積   | 165.4347395 |            |        |
| 地積   | 165.43㎡     |            |        |

|      |             |            |        |
|------|-------------|------------|--------|
| 2834 |             |            |        |
| 地番   | 幡四三三ノ一〇     |            |        |
| N O  | X           | Y          | 辺 長    |
| 6153 | -103955.748 | -20741.813 |        |
| 6341 | -103958.899 | -20735.926 | 6.677  |
| 7605 | -103957.664 | -20731.858 | 4.251  |
| 6347 | -103949.789 | -20727.692 | 8.909  |
| 2398 | -103947.260 | -20726.349 | 2.863  |
| 2397 | -103942.752 | -20727.477 | 4.646  |
| 7604 | -103939.683 | -20733.154 | 6.453  |
| 6153 | -103955.748 | -20741.813 | 18.250 |
| 面積   | 165.6185590 |            |        |
| 地積   | 165.61㎡     |            |        |

|      |             |            |        |
|------|-------------|------------|--------|
| 2835 |             |            |        |
| 地番   | 幡四三三ノ一      |            |        |
| N O  | X           | Y          | 辺 長    |
| 7605 | -103957.664 | -20731.858 |        |
| 6341 | -103958.899 | -20735.926 | 4.251  |
| 6153 | -103955.748 | -20741.813 | 6.677  |
| 6154 | -103951.451 | -20749.793 | 9.063  |
| 6155 | -103947.161 | -20757.772 | 9.059  |
| 6156 | -103943.791 | -20764.020 | 7.098  |
| 6157 | -103947.772 | -20766.156 | 4.517  |
| 6158 | -103949.074 | -20766.864 | 1.482  |
| 6159 | -103950.343 | -20764.499 | 2.683  |
| 6160 | -103957.479 | -20751.249 | 15.049 |
| 6161 | -103963.677 | -20739.744 | 13.068 |
| 7606 | -103967.831 | -20738.815 | 4.256  |
| 6340 | -103960.378 | -20733.293 | 9.275  |
| 7605 | -103957.664 | -20731.858 | 3.070  |
| 面積   | 216.7009060 |            |        |
| 地積   | 216.70㎡     |            |        |

|      |             |            |        |
|------|-------------|------------|--------|
| 2836 |             |            |        |
| 地番   | 幡四三三ノ三      |            |        |
| N O  | X           | Y          | 辺 長    |
| 7606 | -103967.831 | -20738.815 |        |
| 6161 | -103963.677 | -20739.744 | 4.256  |
| 6160 | -103957.479 | -20751.249 | 13.068 |
| 7607 | -103967.160 | -20756.465 | 10.996 |
| 6163 | -103974.148 | -20743.495 | 14.732 |
| 7606 | -103967.831 | -20738.815 | 7.861  |
| 面積   | 165.5193720 |            |        |
| 地積   | 165.51㎡     |            |        |


|      |             |            |        |
|------|-------------|------------|--------|
| 2837 |             |            |        |
| 地番   | 幡四三三ノ四      |            |        |
| N O  | X           | Y          | 辺 長    |
| 6160 | -103957.479 | -20751.249 |        |
| 6159 | -103950.343 | -20764.499 | 15.049 |
| 7608 | -103960.020 | -20769.718 | 10.994 |
| 7607 | -103967.160 | -20756.465 | 15.053 |
| 6160 | -103957.479 | -20751.249 | 10.996 |
| 面積   | 165.5037835 |            |        |
| 地積   | 165.50㎡     |            |        |

|      |             |            |        |
|------|-------------|------------|--------|
| 2838 |             |            |        |
| 地番   | 幡四三三ノ五      |            |        |
| N O  | X           | Y          | 辺 長    |
| 6159 | -103950.343 | -20764.499 |        |
| 6158 | -103949.074 | -20766.864 | 2.683  |
| 6157 | -103947.772 | -20766.156 | 1.482  |
| 7609 | -103941.342 | -20778.059 | 13.528 |
| 6345 | -103945.176 | -20778.357 | 3.845  |
| 6344 | -103954.672 | -20779.643 | 9.582  |
| 7608 | -103960.020 | -20769.718 | 11.274 |
| 6159 | -103950.343 | -20764.499 | 10.994 |
| 面積   | 166.4187630 |            |        |
| 地積   | 166.41㎡     |            |        |


|      |             |            |        |
|------|-------------|------------|--------|
| 2839 |             |            |        |
| 地番   | 幡四三三ノ六      |            |        |
| N O  | X           | Y          | 辺 長    |
| 6157 | -103947.772 | -20766.156 |        |
| 6156 | -103943.791 | -20764.020 | 4.517  |
| 6706 | -103942.846 | -20765.731 | 1.954  |
| 6164 | -103937.046 | -20762.599 | 6.591  |
| 6165 | -103929.413 | -20776.611 | 15.956 |
| 6166 | -103929.096 | -20777.198 | 0.667  |
| 9770 | -103931.274 | -20777.278 | 2.179  |
| 7609 | -103941.342 | -20778.059 | 10.098 |
| 6157 | -103947.772 | -20766.156 | 13.528 |
| 面積   | 165.5886800 |            |        |
| 地積   | 165.58㎡     |            |        |

|      |             |            |        |
|------|-------------|------------|--------|
| 2840 |             |            |        |
| 地番   | 保五一ノ四       |            |        |
| N O  | X           | Y          | 辺 長    |
| 7595 | -103863.708 | -20896.295 |        |
| 2410 | -103873.213 | -20901.445 | 10.810 |
| 5911 | -103879.969 | -20887.219 | 15.748 |
| 5898 | -103876.195 | -20882.653 | 5.923  |
| 5899 | -103872.242 | -20880.548 | 4.478  |
| 7595 | -103863.708 | -20896.295 | 17.910 |
| 面積   | 179.3620205 |            |        |
| 地積   | 179.36㎡     |            |        |

|                               |                     |       |  |
|-------------------------------|---------------------|-------|--|
| 図面の種類                         | 画 地 出 来 形 確 認 測 量 図 |       |  |
| 街 区 名                         | 51                  | 求 積 表 |  |
| 町 名                           | 岩 倉 幡 枝 町           |       |  |
| 京 都 市 洛 北 第 三 土 地 区 画 整 理 組 合 |                     |       |  |

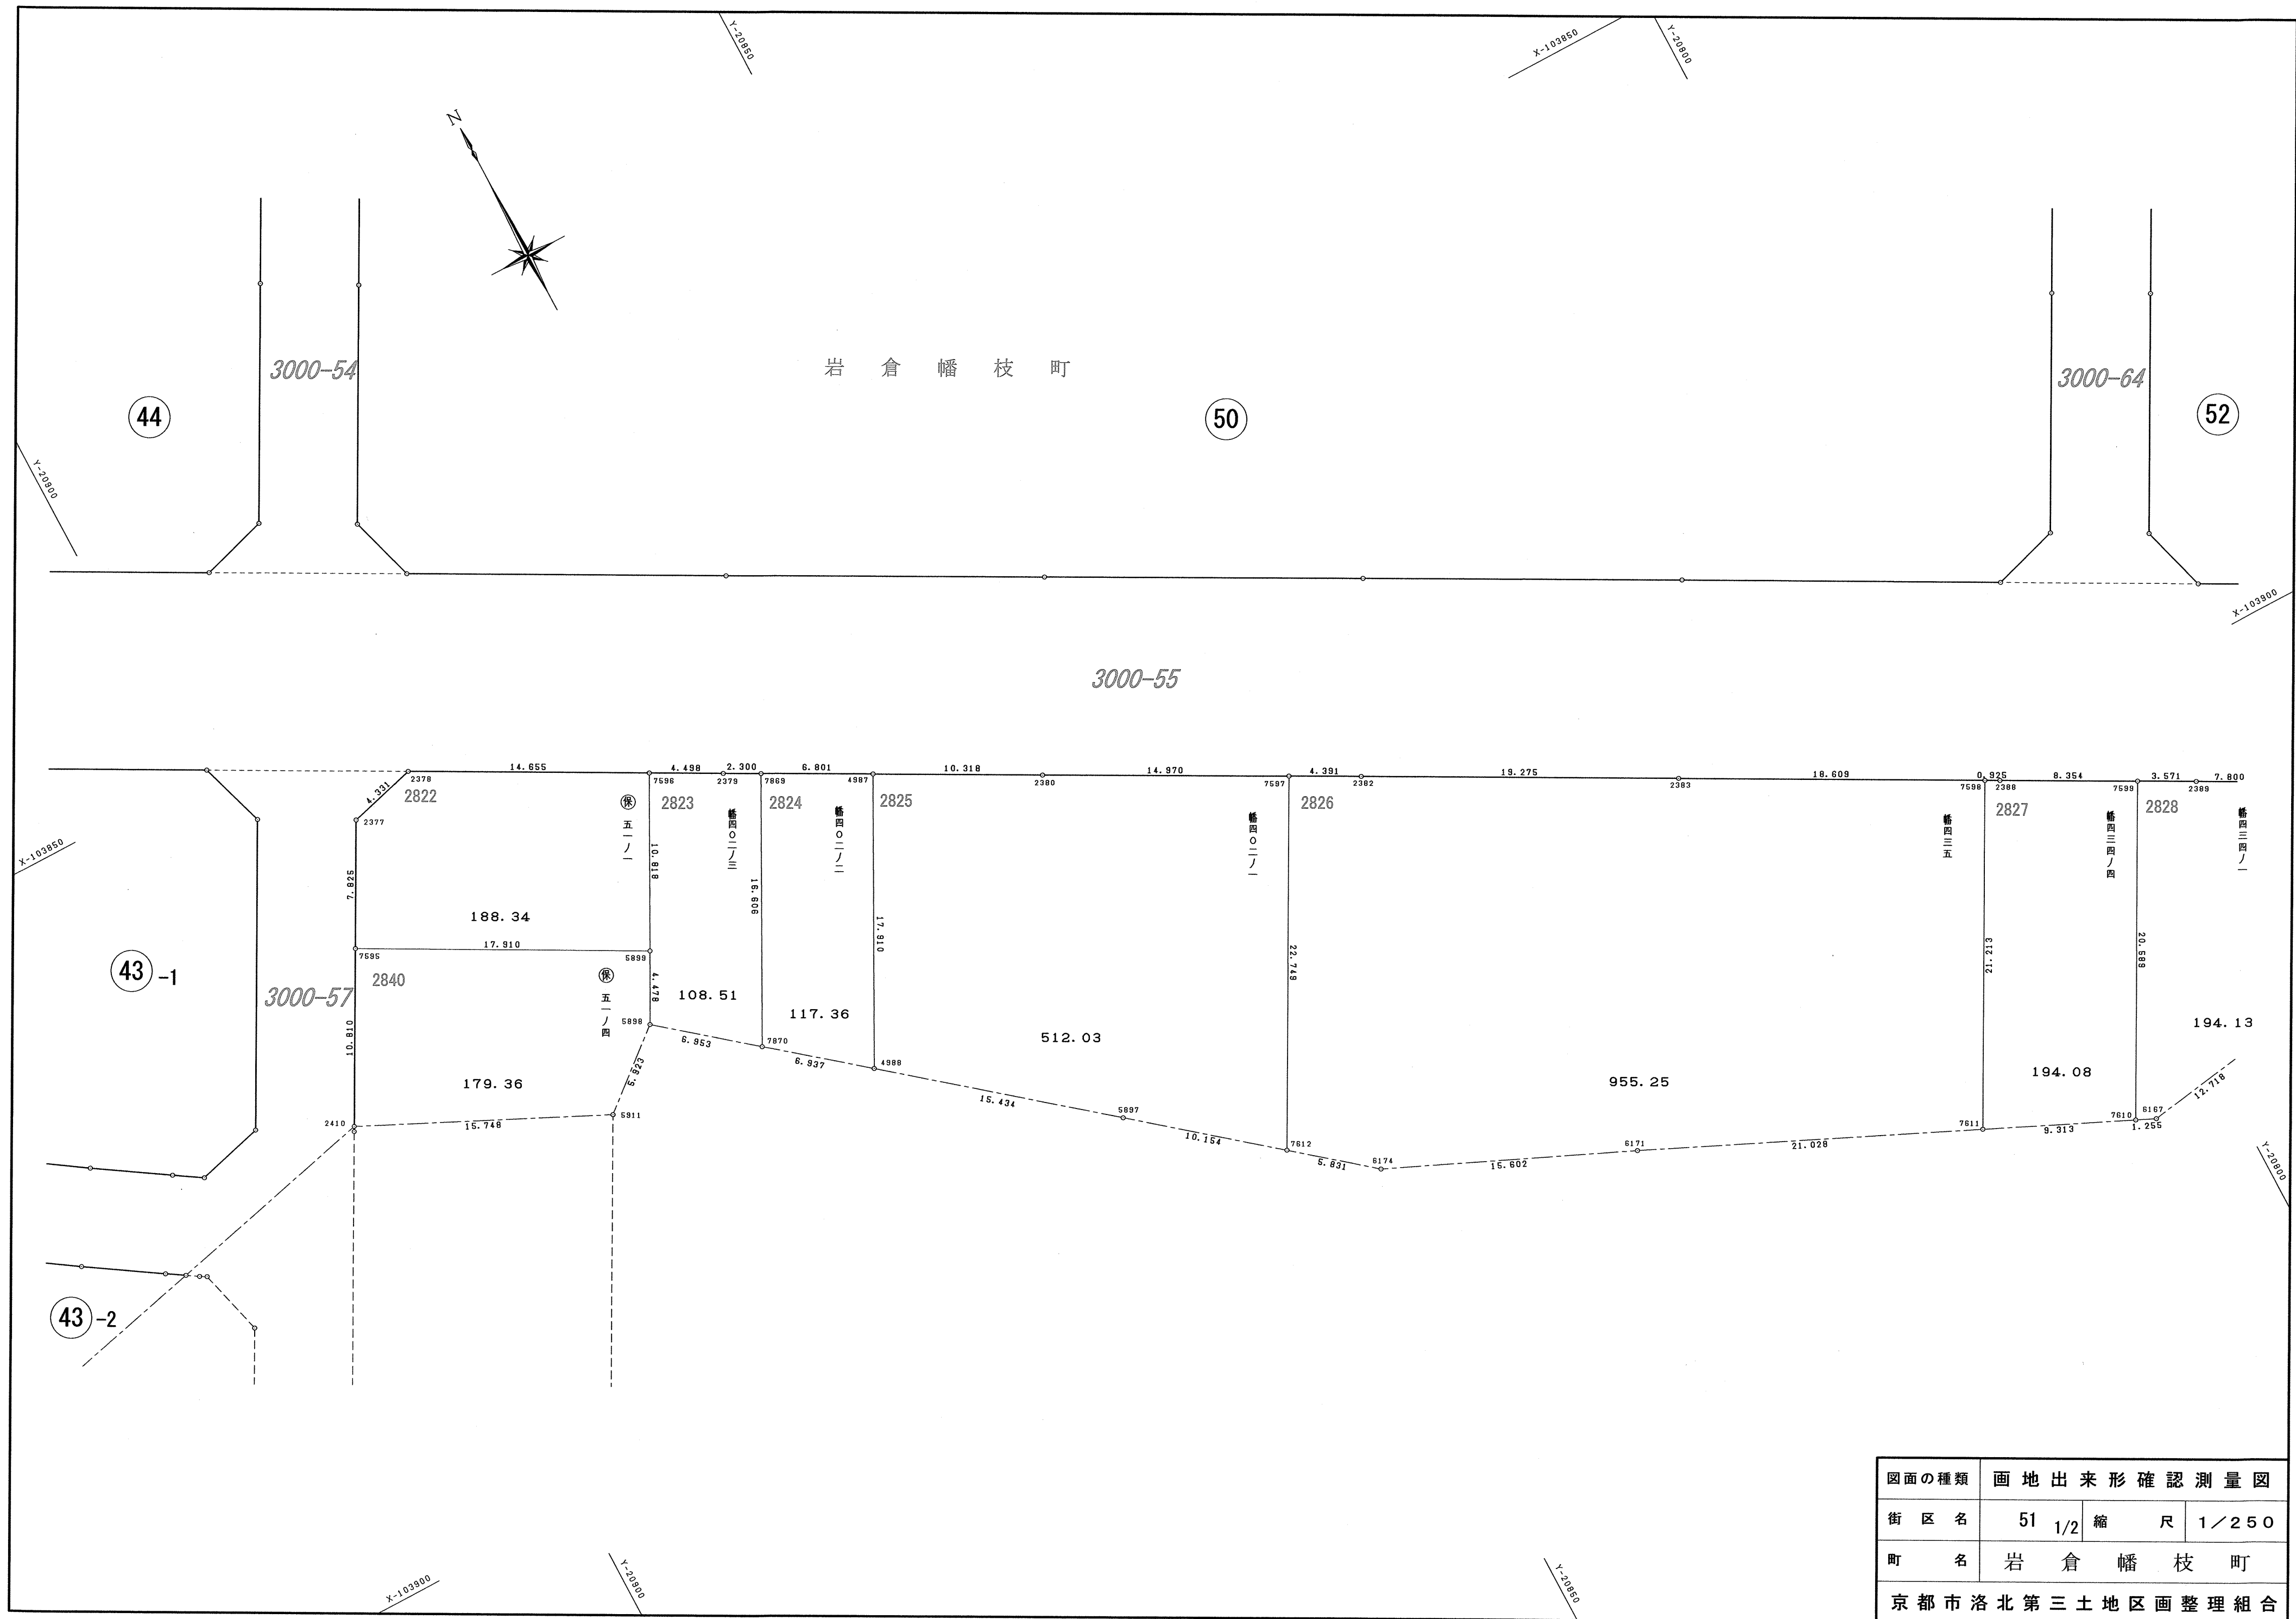

|                 |            |    |       |
|-----------------|------------|----|-------|
| 図面の種類           | 画地出来形確認測量図 |    |       |
| 街区名             | 51 1/2     | 縮尺 | 1／250 |
| 町名              | 岩倉幡枝町      |    |       |
| 京都市洛北第三土地区画整理組合 |            |    |       |

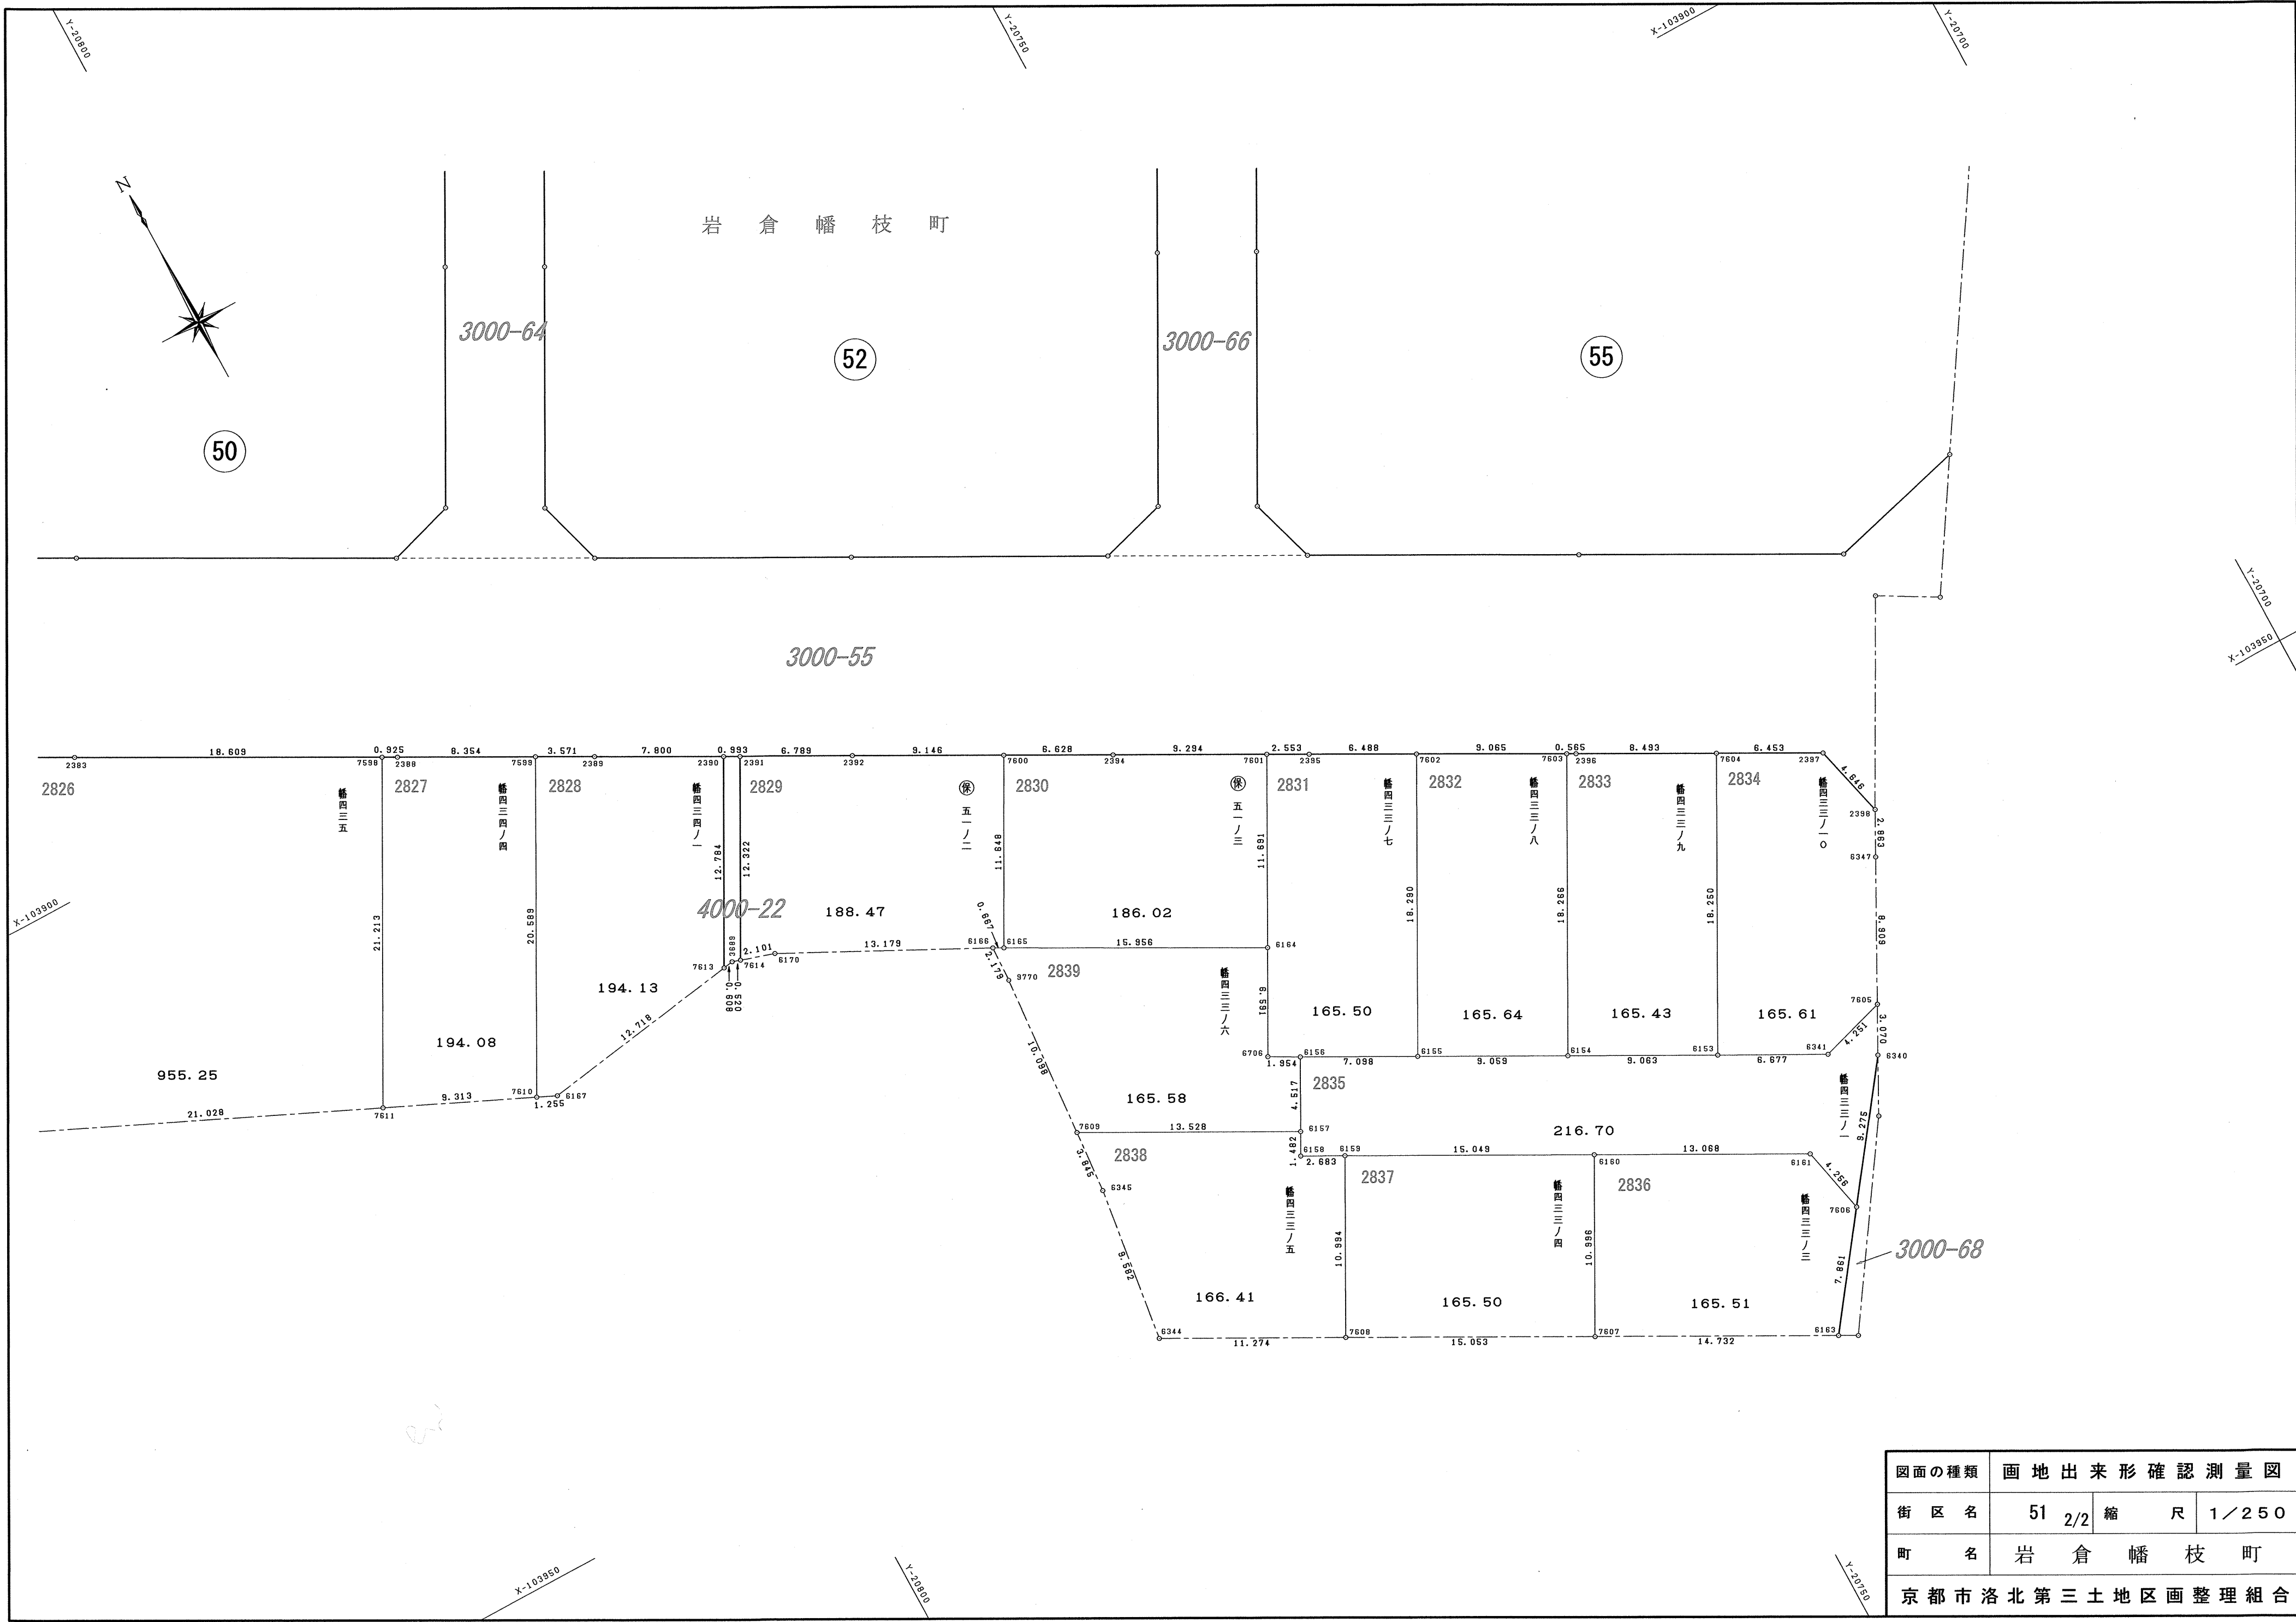

|                 |            |     |       |
|-----------------|------------|-----|-------|
| 図面の種類           | 画地出来形確認測量図 |     |       |
| 街 区 名           | 51 2/2     | 縮 尺 | 1／250 |
| 町 名             | 岩 倉 幡 枝 町  |     |       |
| 京都市洛北第三土地区画整理組合 |            |     |       |

|      |             |            |        |
|------|-------------|------------|--------|
| 2822 |             |            |        |
| 地番   | 保五一ノ一       |            |        |
| N O  | X           | Y          | 辺 長    |
| 2378 | -103855.704 | -20888.384 |        |
| 2377 | -103856.827 | -20892.567 | 4.331  |
| 7595 | -103863.708 | -20896.295 | 7.825  |
| 5899 | -103872.242 | -20880.548 | 17.910 |
| 7596 | -103862.677 | -20875.494 | 10.818 |
| 2378 | -103855.704 | -20888.384 | 14.655 |
| 面積   | 188.3412665 |            |        |
| 地積   | 188.34㎡     |            |        |

|      |             |            |        |
|------|-------------|------------|--------|
| 2823 |             |            |        |
| 地番   | 幡四〇二ノ三      |            |        |
| N O  | X           | Y          | 辺 長    |
| 7596 | -103862.677 | -20875.494 |        |
| 5899 | -103872.242 | -20880.548 | 10.818 |
| 5898 | -103876.195 | -20882.653 | 4.478  |
| 7870 | -103880.596 | -20877.270 | 6.953  |
| 7869 | -103865.912 | -20869.514 | 16.606 |
| 2379 | -103864.817 | -20871.537 | 2.300  |
| 7596 | -103862.677 | -20875.494 | 4.498  |
| 面積   | 108.5114825 |            |        |
| 地積   | 108.51㎡     |            |        |

|      |             |            |        |
|------|-------------|------------|--------|
| 2824 |             |            |        |
| 地番   | 幡四〇二ノ二      |            |        |
| N O  | X           | Y          | 辺 長    |
| 7869 | -103865.912 | -20869.514 |        |
| 7870 | -103880.596 | -20877.270 | 16.606 |
| 4988 | -103884.987 | -20871.899 | 6.937  |
| 4987 | -103869.150 | -20863.533 | 17.910 |
| 7869 | -103865.912 | -20869.514 | 6.801  |
| 面積   | 117.3672825 |            |        |
| 地積   | 117.36㎡     |            |        |

|      |             |            |        |
|------|-------------|------------|--------|
| 2825 |             |            |        |
| 地番   | 幡四〇二ノ一      |            |        |
| N O  | X           | Y          | 辺 長    |
| 4987 | -103869.150 | -20863.533 |        |
| 4988 | -103884.987 | -20871.899 | 17.910 |
| 5897 | -103894.756 | -20859.950 | 15.434 |
| 7612 | -103901.198 | -20852.101 | 10.154 |
| 7597 | -103881.182 | -20841.290 | 22.749 |
| 2380 | -103874.062 | -20854.459 | 14.970 |
| 4987 | -103869.150 | -20863.533 | 10.318 |
| 面積   | 512.0390835 |            |        |
| 地積   | 512.03㎡     |            |        |

|      |             |            |        |
|------|-------------|------------|--------|
| 2826 |             |            |        |
| 地番   | 幡四三五        |            |        |
| N O  | X           | Y          | 辺 長    |
| 7597 | -103881.182 | -20841.290 |        |
| 7612 | -103901.198 | -20852.101 | 22.749 |
| 6174 | -103904.898 | -20847.593 | 5.831  |
| 6171 | -103911.224 | -20833.331 | 15.602 |
| 7611 | -103919.958 | -20814.202 | 21.028 |
| 7598 | -103901.300 | -20804.107 | 21.213 |
| 2383 | -103892.441 | -20820.473 | 18.609 |
| 2382 | -103883.271 | -20837.427 | 19.275 |
| 7597 | -103881.182 | -20841.290 | 4.391  |
| 面積   | 955.2570735 |            |        |
| 地積   | 955.25㎡     |            |        |

|      |             |            |        |
|------|-------------|------------|--------|
| 2827 |             |            |        |
| 地番   | 幡四三四ノ四      |            |        |
| N O  | X           | Y          | 辺 長    |
| 7598 | -103901.300 | -20804.107 |        |
| 7611 | -103919.958 | -20814.202 | 21.213 |
| 7610 | -103923.826 | -20805.730 | 9.313  |
| 7599 | -103905.711 | -20795.943 | 20.589 |
| 2388 | -103901.740 | -20803.293 | 8.354  |
| 7598 | -103901.300 | -20804.107 | 0.925  |
| 面積   | 194.0888735 |            |        |
| 地積   | 194.08㎡     |            |        |

|      |             |            |        |
|------|-------------|------------|--------|
| 2828 |             |            |        |
| 地番   | 幡四三四ノ一      |            |        |
| N O  | X           | Y          | 辺 長    |
| 7599 | -103905.711 | -20795.943 |        |
| 7610 | -103923.826 | -20805.730 | 20.589 |
| 6167 | -103924.347 | -20804.588 | 1.255  |
| 7613 | -103922.372 | -20792.024 | 12.718 |
| 2390 | -103911.126 | -20785.943 | 12.784 |
| 2389 | -103907.409 | -20792.801 | 7.800  |
| 7599 | -103905.711 | -20795.943 | 3.571  |
| 面積   | 194.1388655 |            |        |
| 地積   | 194.13㎡     |            |        |

|      |             |            |        |
|------|-------------|------------|--------|
| 2829 |             |            |        |
| 地番   | 保五一ノ二       |            |        |
| N O  | X           | Y          | 辺 長    |
| 2391 | -103911.598 | -20785.069 |        |
| 7614 | -103922.438 | -20790.928 | 12.322 |
| 6170 | -103923.090 | -20788.930 | 2.101  |
| 6166 | -103929.096 | -20777.198 | 13.179 |
| 6165 | -103929.413 | -20776.611 | 0.667  |
| 7600 | -103919.177 | -20771.051 | 11.648 |
| 2392 | -103914.824 | -20779.095 | 9.146  |
| 2391 | -103911.598 | -20785.069 | 6.789  |
| 面積   | 188.4751415 |            |        |
| 地積   | 188.47㎡     |            |        |

|      |             |            |        |
|------|-------------|------------|--------|
| 2830 |             |            |        |
| 地番   | 保五一ノ三       |            |        |
| N O  | X           | Y          | 辺 長    |
| 7600 | -103919.177 | -20771.051 |        |
| 6165 | -103929.413 | -20776.611 | 11.648 |
| 6164 | -103937.046 | -20762.599 | 15.956 |
| 7601 | -103926.757 | -20757.047 | 11.691 |
| 2394 | -103922.332 | -20765.221 | 9.294  |
| 7600 | -103919.177 | -20771.051 | 6.628  |
| 面積   | 186.0232040 |            |        |
| 地積   | 186.02㎡     |            |        |

|      |             |            |        |
|------|-------------|------------|--------|
| 2831 |             |            |        |
| 地番   | 幡四三三ノ七      |            |        |
| N O  | X           | Y          | 辺 長    |
| 7601 | -103926.757 | -20757.047 |        |
| 6164 | -103937.046 | -20762.599 | 11.691 |
| 6706 | -103942.846 | -20765.731 | 6.591  |
| 6156 | -103943.791 | -20764.020 | 1.954  |
| 6155 | -103947.161 | -20757.772 | 7.098  |
| 7602 | -103931.060 | -20749.095 | 18.290 |
| 2395 | -103927.973 | -20754.802 | 6.488  |
| 7601 | -103926.757 | -20757.047 | 2.553  |
| 面積   | 165.5007195 |            |        |
| 地積   | 165.50㎡     |            |        |

|      |             |            |        |
|------|-------------|------------|--------|
| 2832 |             |            |        |
| 地番   | 幡四三三ノ八      |            |        |
| N O  | X           | Y          | 辺 長    |
| 7602 | -103931.060 | -20749.095 |        |
| 6155 | -103947.161 | -20757.772 | 18.290 |
| 6154 | -103951.451 | -20749.793 | 9.059  |
| 7603 | -103935.374 | -20741.122 | 18.266 |
| 7602 | -103931.060 | -20749.095 | 9.065  |
| 面積   | 165.6414120 |            |        |
| 地積   | 165.64㎡     |            |        |

|      |             |            |        |
|------|-------------|------------|--------|
| 2833 |             |            |        |
| 地番   | 幡四三三ノ九      |            |        |
| N O  | X           | Y          | 辺 長    |
| 7603 | -103935.374 | -20741.122 |        |
| 6154 | -103951.451 | -20749.793 | 18.266 |
| 6153 | -103955.748 | -20741.813 | 9.063  |
| 7604 | -103939.683 | -20733.154 | 18.250 |
| 2396 | -103935.643 | -20740.625 | 8.493  |
| 7603 | -103935.374 | -20741.122 | 0.565  |
| 面積   | 165.4347395 |            |        |
| 地積   | 165.43㎡     |            |        |

|      |             |            |        |
|------|-------------|------------|--------|
| 2834 |             |            |        |
| 地番   | 幡四三三ノ一〇     |            |        |
| N O  | X           | Y          | 辺 長    |
| 6153 | -103955.748 | -20741.813 |        |
| 6341 | -103958.899 | -20735.926 | 6.677  |
| 7605 | -103957.664 | -20731.858 | 4.251  |
| 6347 | -103949.789 | -20727.692 | 8.909  |
| 2398 | -103947.260 | -20726.349 | 2.863  |
| 2397 | -103942.752 | -20727.477 | 4.646  |
| 7604 | -103939.683 | -20733.154 | 6.453  |
| 6153 | -103955.748 | -20741.813 | 18.250 |
| 面積   | 165.6185590 |            |        |
| 地積   | 165.61㎡     |            |        |

|      |             |            |        |
|------|-------------|------------|--------|
| 2835 |             |            |        |
| 地番   | 幡四三三ノ一      |            |        |
| N O  | X           | Y          | 辺 長    |
| 7605 | -103957.664 | -20731.858 |        |
| 6341 | -103958.899 | -20735.926 | 4.251  |
| 6153 | -103955.748 | -20741.813 | 6.677  |
| 6154 | -103951.451 | -20749.793 | 9.063  |
| 6155 | -103947.161 | -20757.772 | 9.059  |
| 6156 | -103943.791 | -20764.020 | 7.098  |
| 6157 | -103947.772 | -20766.156 | 4.517  |
| 6158 | -103949.074 | -20766.864 | 1.482  |
| 6159 | -103950.343 | -20764.499 | 2.683  |
| 6160 | -103957.479 | -20751.249 | 15.049 |
| 6161 | -103963.677 | -20739.744 | 13.068 |
| 7606 | -103967.831 | -20738.815 | 4.256  |
| 6340 | -103960.378 | -20733.293 | 9.275  |
| 7605 | -103957.664 | -20731.858 | 3.070  |
| 面積   | 216.7009060 |            |        |
| 地積   | 216.70㎡     |            |        |

|      |             |            |        |
|------|-------------|------------|--------|
| 2836 |             |            |        |
| 地番   | 幡四三三ノ三      |            |        |
| N O  | X           | Y          | 辺 長    |
| 7606 | -103967.831 | -20738.815 |        |
| 6161 | -103963.677 | -20739.744 | 4.256  |
| 6160 | -103957.479 | -20751.249 | 13.068 |
| 7607 | -103967.160 | -20756.465 | 10.996 |
| 6163 | -103974.148 | -20743.495 | 14.732 |
| 7606 | -103967.831 | -20738.815 | 7.861  |
| 面積   | 165.5193720 |            |        |
| 地積   | 165.51㎡     |            |        |


|      |             |            |        |
|------|-------------|------------|--------|
| 2837 |             |            |        |
| 地番   | 幡四三三ノ四      |            |        |
| N O  | X           | Y          | 辺 長    |
| 6160 | -103957.479 | -20751.249 |        |
| 6159 | -103950.343 | -20764.499 | 15.049 |
| 7608 | -103960.020 | -20769.718 | 10.994 |
| 7607 | -103967.160 | -20756.465 | 15.053 |
| 6160 | -103957.479 | -20751.249 | 10.996 |
| 面積   | 165.5037835 |            |        |
| 地積   | 165.50㎡     |            |        |

|      |             |            |        |
|------|-------------|------------|--------|
| 2838 |             |            |        |
| 地番   | 幡四三三ノ五      |            |        |
| N O  | X           | Y          | 辺 長    |
| 6159 | -103950.343 | -20764.499 |        |
| 6158 | -103949.074 | -20766.864 | 2.683  |
| 6157 | -103947.772 | -20766.156 | 1.482  |
| 7609 | -103941.342 | -20778.059 | 13.528 |
| 6345 | -103945.176 | -20778.357 | 3.845  |
| 6344 | -103954.672 | -20779.643 | 9.582  |
| 7608 | -103960.020 | -20769.718 | 11.274 |
| 6159 | -103950.343 | -20764.499 | 10.994 |
| 面積   | 166.4187630 |            |        |
| 地積   | 166.41㎡     |            |        |

|      |             |            |        |
|------|-------------|------------|--------|
| 2839 |             |            |        |
| 地番   | 幡四三三ノ六      |            |        |
| N O  | X           | Y          | 辺 長    |
| 6157 | -103947.772 | -20766.156 |        |
| 6156 | -103943.791 | -20764.020 | 4.517  |
| 6706 | -103942.846 | -20765.731 | 1.954  |
| 6164 | -103937.046 | -20762.599 | 6.591  |
| 6165 | -103929.413 | -20776.611 | 15.956 |
| 6166 | -103929.096 | -20777.198 | 0.667  |
| 9770 | -103931.274 | -20777.278 | 2.179  |
| 7609 | -103941.342 | -20778.059 | 10.098 |
| 6157 | -103947.772 | -20766.156 | 13.528 |
| 面積   | 165.5886800 |            |        |
| 地積   | 165.58㎡     |            |        |

|      |             |            |        |
|------|-------------|------------|--------|
| 2840 |             |            |        |
| 地番   | 保五一ノ四       |            |        |
| N O  | X           | Y          | 辺 長    |
| 7595 | -103863.708 | -20896.295 |        |
| 2410 | -103873.213 | -20901.445 | 10.810 |
| 5911 | -103879.969 | -20887.219 | 15.748 |
| 5898 | -103876.195 | -20882.653 | 5.923  |
| 5899 | -103872.242 | -20880.548 | 4.478  |
| 7595 | -103863.708 | -20896.295 | 17.910 |
| 面積   | 179.3620205 |            |        |
| 地積   | 179.36㎡     |            |        |

|                               |                     |       |  |
|-------------------------------|---------------------|-------|--|
| 図面の種類                         | 画 地 出 来 形 確 認 測 量 図 |       |  |
| 街 区 名                         | 51                  | 求 積 表 |  |
| 町 名                           | 岩 倉 幡 枝 町           |       |  |
| 京 都 市 洛 北 第 三 土 地 区 画 整 理 組 合 |                     |       |  |

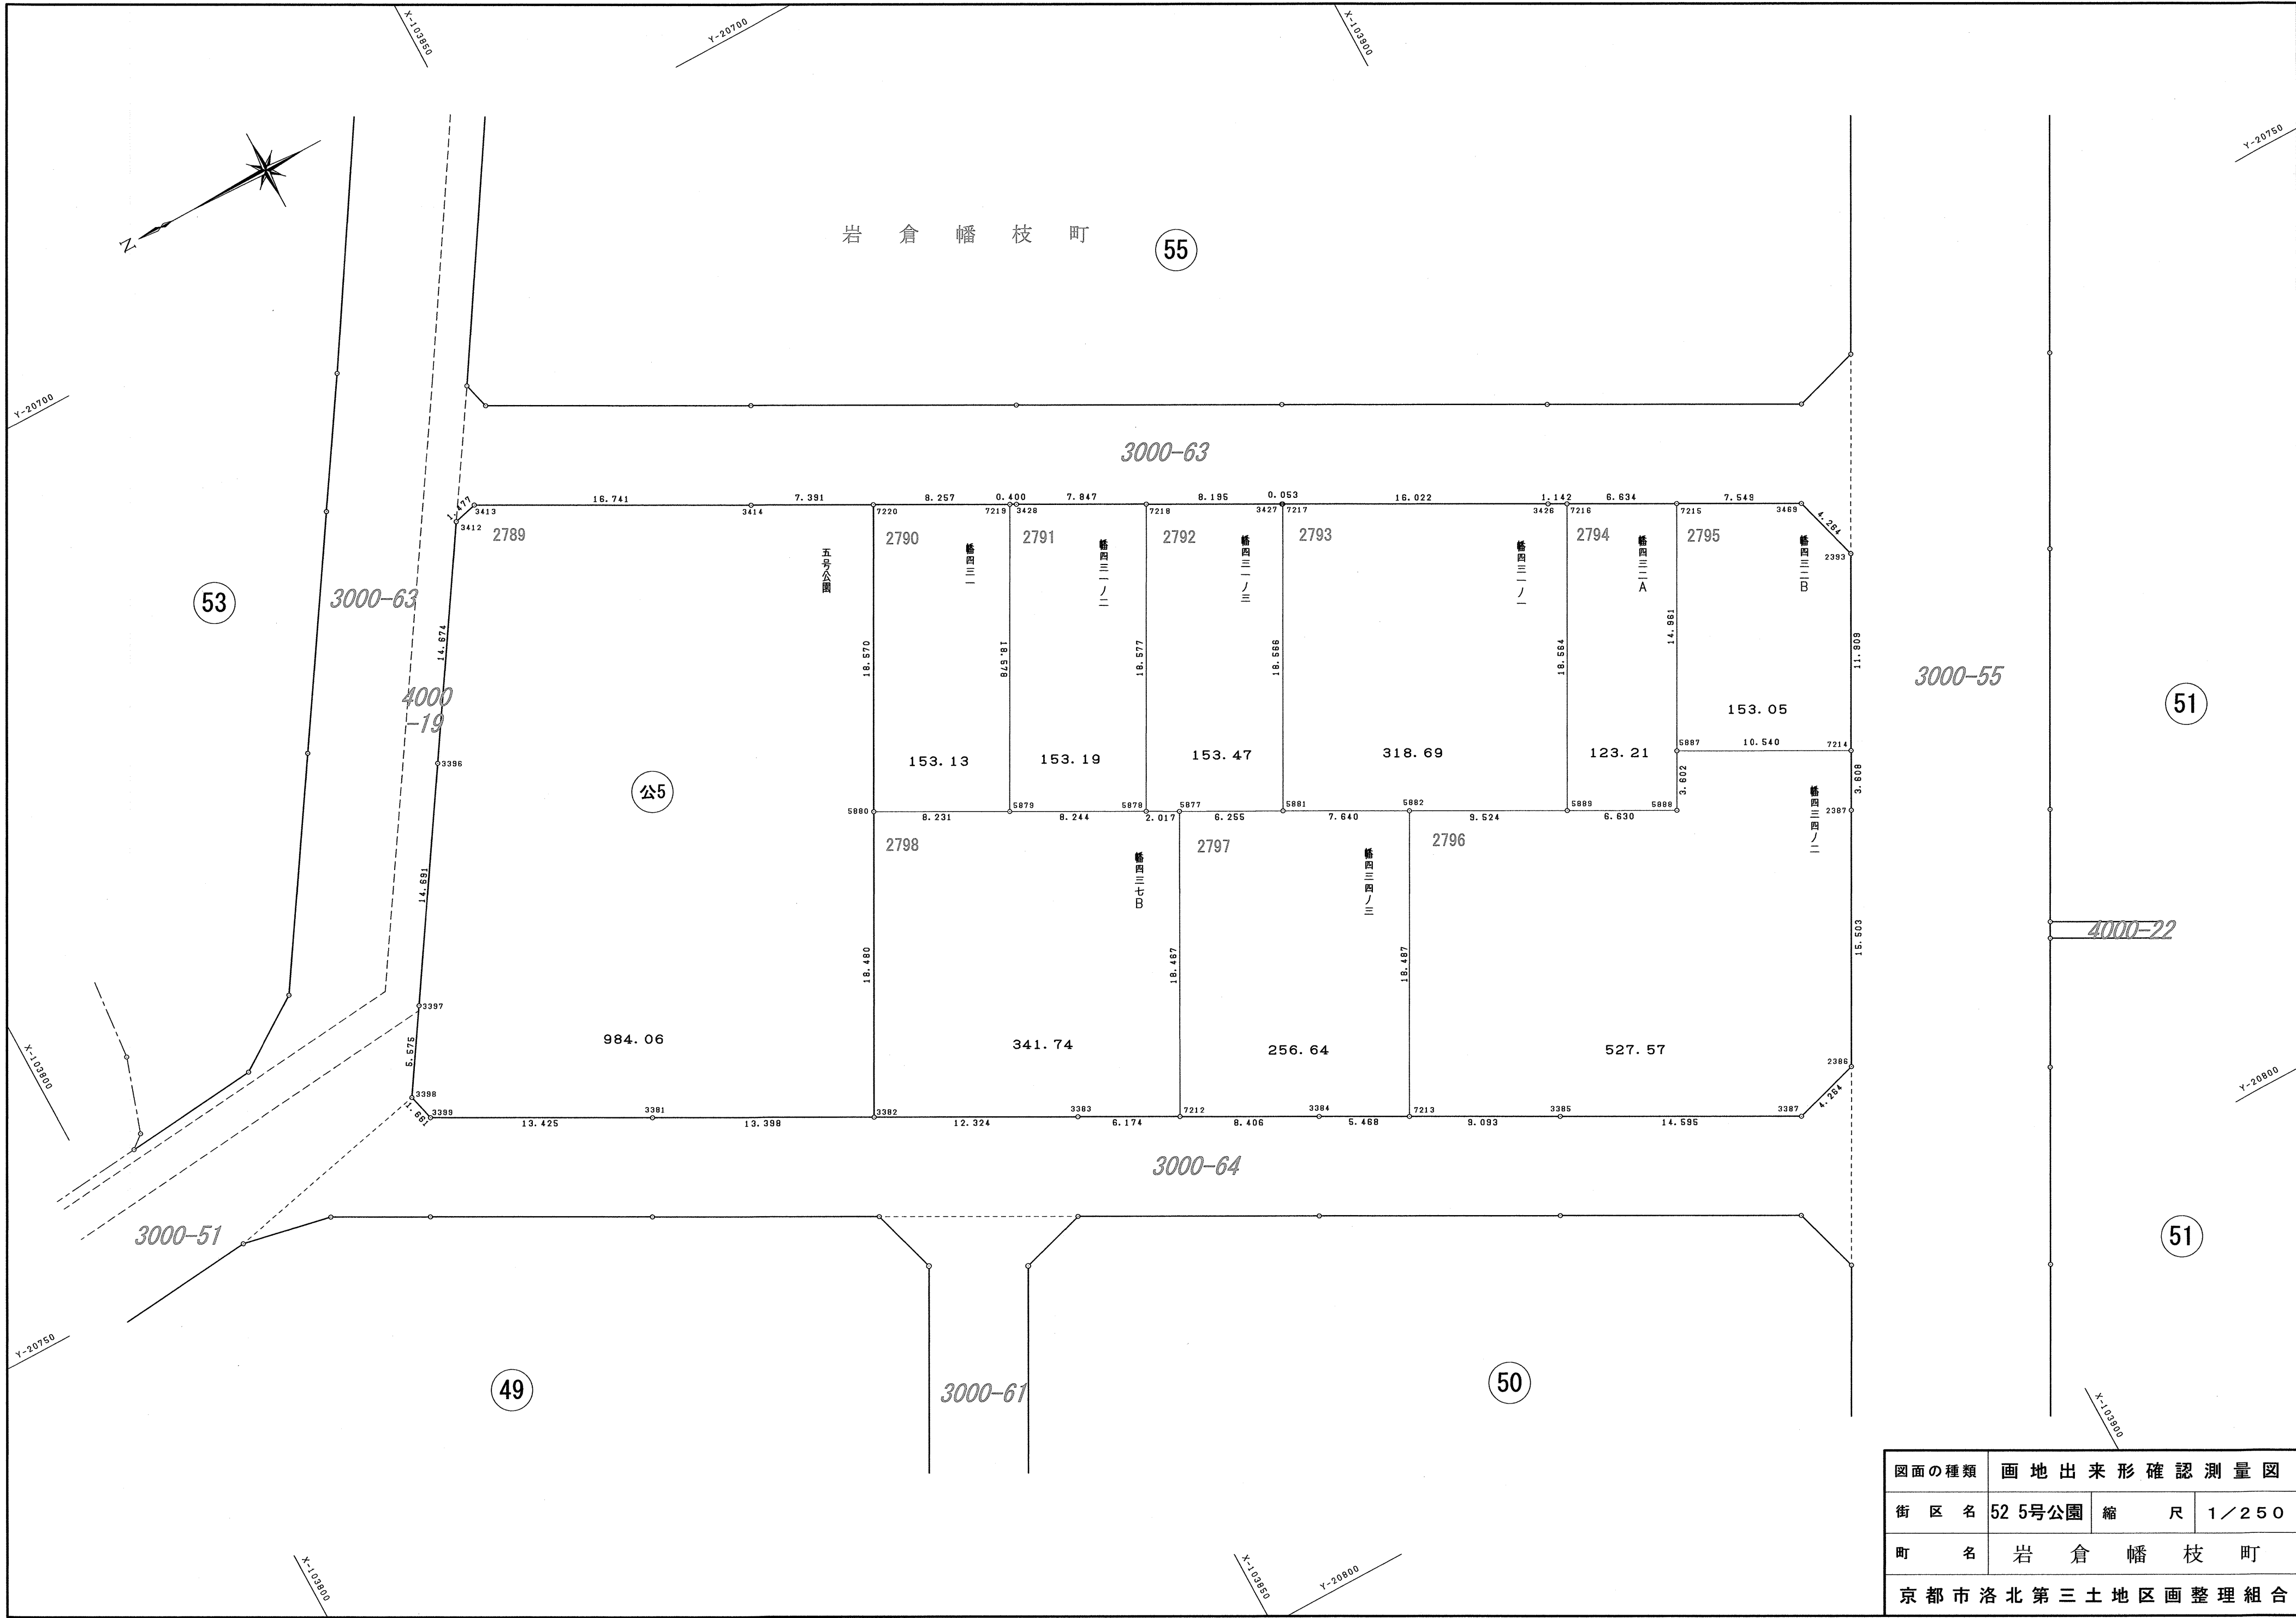

|                 |            |     |       |
|-----------------|------------|-----|-------|
| 図面の種類           | 画地出来形確認測量図 |     |       |
| 街 区 名           | 52 5号公園    | 縮 尺 | 1／250 |
| 町 名             | 岩 倉 幡 枝 町  |     |       |
| 京都市洛北第三土地区画整理組合 |            |     |       |

5 2 街 区

2790

|      |                       |            |        |
|------|-----------------------|------------|--------|
| 地 番  | 幡四三一                  |            |        |
| N O  | X                     | Y          | 辺 長    |
| 7220 | -103861.090           | -20728.962 |        |
| 5880 | -103852.258           | -20745.298 | 18.570 |
| 5879 | -103859.497           | -20749.216 | 8.231  |
| 7219 | -103868.356           | -20732.886 | 18.578 |
| 7220 | -103861.090           | -20728.962 | 8.257  |
| 面積   | 153.1382880           |            |        |
| 地積   | 153.13 m <sup>2</sup> |            |        |

2791

|      |                       |            |        |
|------|-----------------------|------------|--------|
| 地 番  | 幡四三一ノ二                |            |        |
| N O  | X                     | Y          | 辺 長    |
| 7219 | -103868.356           | -20732.886 |        |
| 5879 | -103859.497           | -20749.216 | 18.578 |
| 5878 | -103866.748           | -20753.140 | 8.244  |
| 7218 | -103875.609           | -20736.812 | 18.577 |
| 3428 | -103868.708           | -20733.076 | 7.847  |
| 7219 | -103868.356           | -20732.886 | 0.400  |
| 面積   | 153.1953490           |            |        |
| 地積   | 153.19 m <sup>2</sup> |            |        |

2792

|      |                       |            |        |
|------|-----------------------|------------|--------|
| 地 番  | 幡四三一ノ三                |            |        |
| N O  | X                     | Y          | 辺 長    |
| 7218 | -103875.609           | -20736.812 |        |
| 5878 | -103866.748           | -20753.140 | 18.577 |
| 5877 | -103868.518           | -20754.109 | 2.017  |
| 5881 | -103874.028           | -20757.070 | 6.255  |
| 7217 | -103882.863           | -20740.740 | 18.566 |
| 3427 | -103882.816           | -20740.714 | 0.053  |
| 7218 | -103875.609           | -20736.812 | 8.195  |
| 面積   | 153.4777390           |            |        |
| 地積   | 153.47 m <sup>2</sup> |            |        |

2793

|      |                       |            |        |
|------|-----------------------|------------|--------|
| 地 番  | 幡四三一ノ一                |            |        |
| N O  | X                     | Y          | 辺 長    |
| 7217 | -103882.863           | -20740.740 |        |
| 5881 | -103874.028           | -20757.070 | 18.566 |
| 5882 | -103880.746           | -20760.709 | 7.640  |
| 5889 | -103889.124           | -20765.239 | 9.524  |
| 7216 | -103897.958           | -20748.911 | 18.564 |
| 3426 | -103896.953           | -20748.368 | 1.142  |
| 7217 | -103882.863           | -20740.740 | 16.022 |
| 面積   | 318.6921505           |            |        |
| 地積   | 318.69 m <sup>2</sup> |            |        |

2794

|      |                       |            |        |
|------|-----------------------|------------|--------|
| 地 番  | 幡四三二A                 |            |        |
| N O  | X                     | Y          | 辺 長    |
| 7216 | -103897.958           | -20748.911 |        |
| 5889 | -103889.124           | -20765.239 | 18.564 |
| 5888 | -103894.958           | -20768.390 | 6.630  |
| 5887 | -103896.681           | -20765.226 | 3.602  |
| 7215 | -103903.795           | -20752.064 | 14.961 |
| 7216 | -103897.958           | -20748.911 | 6.634  |
| 面積   | 123.2104195           |            |        |
| 地積   | 123.21 m <sup>2</sup> |            |        |

2795

|      |                       |            |        |
|------|-----------------------|------------|--------|
| 地 番  | 幡四三二B                 |            |        |
| N O  | X                     | Y          | 辺 長    |
| 7215 | -103903.795           | -20752.064 |        |
| 5887 | -103896.681           | -20765.226 | 14.961 |
| 7214 | -103905.957           | -20770.232 | 10.540 |
| 2393 | -103911.612           | -20759.751 | 11.909 |
| 3469 | -103910.437           | -20755.652 | 4.264  |
| 7215 | -103903.795           | -20752.064 | 7.549  |
| 面積   | 153.0565080           |            |        |
| 地積   | 153.05 m <sup>2</sup> |            |        |

2796

|      |                       |            |        |
|------|-----------------------|------------|--------|
| 地 番  | 幡四三四ノ二                |            |        |
| N O  | X                     | Y          | 辺 長    |
| 7213 | -103871.941           | -20776.965 |        |
| 3385 | -103879.938           | -20781.294 | 9.093  |
| 3387 | -103892.772           | -20788.244 | 14.595 |
| 2386 | -103896.864           | -20787.043 | 4.264  |
| 2387 | -103904.243           | -20773.408 | 15.503 |
| 7214 | -103905.957           | -20770.232 | 3.608  |
| 5887 | -103896.681           | -20765.226 | 10.540 |
| 5888 | -103894.958           | -20768.390 | 3.602  |
| 5889 | -103889.124           | -20765.239 | 6.630  |
| 5882 | -103880.746           | -20760.709 | 9.524  |
| 7213 | -103871.941           | -20776.965 | 18.487 |
| 面積   | 527.5784660           |            |        |
| 地積   | 527.57 m <sup>2</sup> |            |        |

2797

|      |                       |            |        |
|------|-----------------------|------------|--------|
| 地 番  | 幡四三四ノ三                |            |        |
| N O  | X                     | Y          | 辺 長    |
| 7212 | -103859.741           | -20770.357 |        |
| 3384 | -103867.132           | -20774.362 | 8.406  |
| 7213 | -103871.941           | -20776.965 | 5.468  |
| 5882 | -103880.746           | -20760.709 | 18.487 |
| 5881 | -103874.028           | -20757.070 | 7.640  |
| 5877 | -103868.518           | -20754.109 | 6.255  |
| 7212 | -103859.741           | -20770.357 | 18.467 |
| 面積   | 256.6477740           |            |        |
| 地積   | 256.64 m <sup>2</sup> |            |        |

2798


|      |                       |            |        |
|------|-----------------------|------------|--------|
| 地 番  | 幡四三七B                 |            |        |
| N O  | X                     | Y          | 辺 長    |
| 3382 | -103843.470           | -20761.555 |        |
| 3383 | -103854.312           | -20767.416 | 12.324 |
| 7212 | -103859.741           | -20770.357 | 6.174  |
| 5877 | -103868.518           | -20754.109 | 18.467 |
| 5878 | -103866.748           | -20753.140 | 2.017  |
| 5879 | -103859.497           | -20749.216 | 8.244  |
| 5880 | -103852.258           | -20745.298 | 8.231  |
| 3382 | -103843.470           | -20761.555 | 18.480 |
| 面積   | 341.7430925           |            |        |
| 地積   | 341.74 m <sup>2</sup> |            |        |

5 号 公 園

2789

|      |                       |            |        |
|------|-----------------------|------------|--------|
| 地 番  | 五号公園                  |            |        |
| N O  | X                     | Y          | 辺 長    |
| 3398 | -103819.466           | -20747.178 |        |
| 3399 | -103819.879           | -20748.787 | 1.661  |
| 3381 | -103831.684           | -20755.182 | 13.425 |
| 3382 | -103843.470           | -20761.555 | 13.388 |
| 5880 | -103852.258           | -20745.298 | 18.480 |
| 7220 | -103861.090           | -20728.962 | 18.570 |
| 3414 | -103854.586           | -20725.450 | 7.391  |
| 3413 | -103839.868           | -20717.472 | 16.741 |
| 3412 | -103838.436           | -20717.834 | 1.477  |
| 3396 | -103830.472           | -20730.160 | 14.674 |
| 3397 | -103822.495           | -20742.497 | 14.691 |
| 3398 | -103819.466           | -20747.178 | 5.575  |
| 面積   | 984.0619200           |            |        |
| 地積   | 984.06 m <sup>2</sup> |            |        |

|                 |                     |       |  |
|-----------------|---------------------|-------|--|
| 図面の種類           | 画 地 出 来 形 確 認 測 量 図 |       |  |
| 街 区 名           | 52 5号公園             | 求 積 表 |  |
| 町 名             | 岩 倉 幡 枝 町           |       |  |
| 京都市洛北第三土地区画整理組合 |                     |       |  |

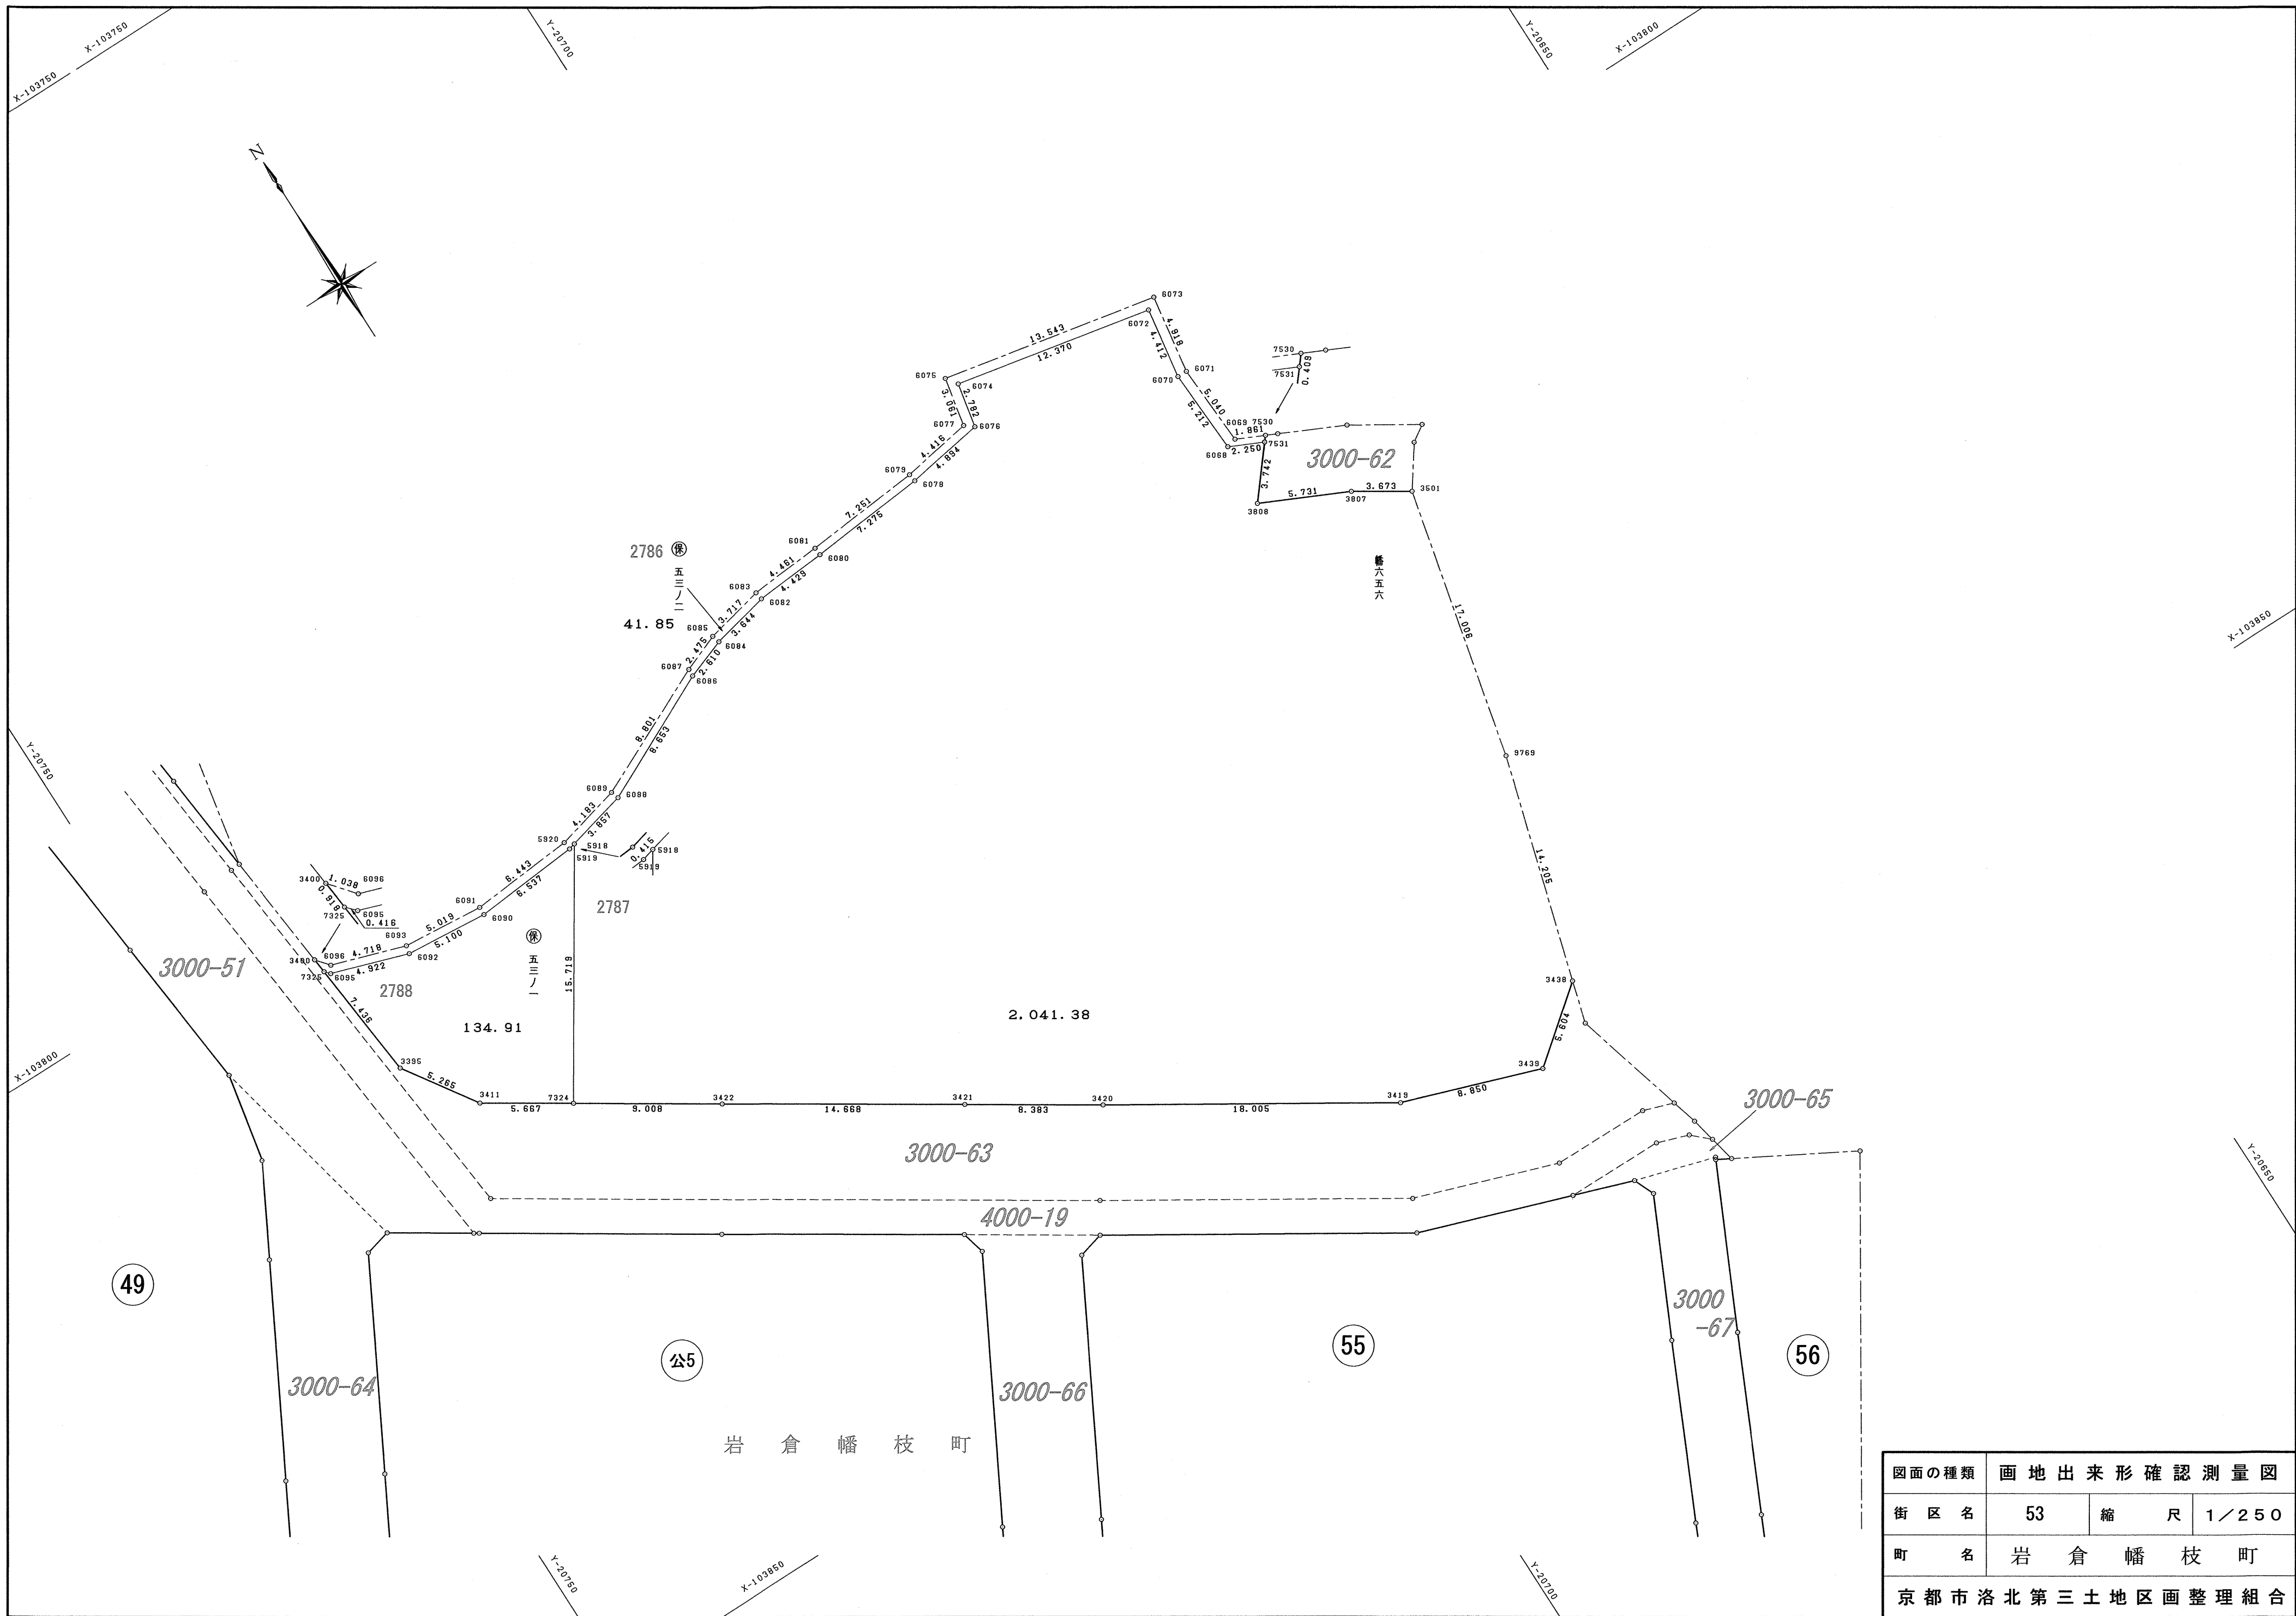

|                 |            |     |       |
|-----------------|------------|-----|-------|
| 図面の種類           | 画地出来形確認測量図 |     |       |
| 街 区 名           | 53         | 縮 尺 | 1／250 |
| 町 名             | 岩 倉 幡 枝 町  |     |       |
| 京都市洛北第三土地区画整理組合 |            |     |       |

|      |                      |            |        |
|------|----------------------|------------|--------|
| 2786 |                      |            |        |
| 地 番  | 保五三ノ二                |            |        |
| N O  | X                    | Y          | 辺 長    |
| 3400 | -103803.187          | -20741.956 |        |
| 7325 | -103804.101          | -20741.865 | 0.918  |
| 6095 | -103804.408          | -20741.584 | 0.416  |
| 6092 | -103805.864          | -20736.914 | 4.922  |
| 6090 | -103806.404          | -20731.833 | 5.100  |
| 5919 | -103805.856          | -20725.319 | 6.537  |
| 5918 | -103805.749          | -20724.917 | 0.415  |
| 6088 | -103804.818          | -20721.174 | 3.857  |
| 6086 | -103801.051          | -20713.383 | 8.653  |
| 6084 | -103800.163          | -20710.928 | 2.610  |
| 6082 | -103799.373          | -20707.370 | 3.644  |
| 6080 | -103799.035          | -20702.953 | 4.429  |
| 6078 | -103798.361          | -20695.709 | 7.275  |
| 6076 | -103797.579          | -20690.877 | 4.894  |
| 6074 | -103794.851          | -20690.331 | 2.782  |
| 6072 | -103797.309          | -20678.207 | 12.370 |
| 6070 | -103801.668          | -20678.889 | 4.412  |
| 6068 | -103806.875          | -20678.649 | 5.212  |
| 7531 | -103807.841          | -20676.616 | 2.250  |
| 7530 | -103807.524          | -20676.356 | 0.409  |
| 6069 | -103806.722          | -20678.036 | 1.861  |
| 6071 | -103801.688          | -20678.285 | 5.040  |
| 6073 | -103796.828          | -20677.527 | 4.918  |
| 6075 | -103794.153          | -20690.804 | 13.543 |
| 6077 | -103797.153          | -20691.417 | 3.061  |
| 6079 | -103797.882          | -20695.773 | 4.416  |
| 6081 | -103798.544          | -20702.994 | 7.251  |
| 6083 | -103798.881          | -20707.443 | 4.461  |
| 6085 | -103799.694          | -20711.070 | 3.717  |
| 6087 | -103800.595          | -20713.376 | 2.475  |
| 6089 | -103804.346          | -20721.338 | 8.801  |
| 5920 | -103805.362          | -20725.396 | 4.183  |
| 6091 | -103805.906          | -20731.816 | 6.443  |
| 6093 | -103805.466          | -20736.816 | 5.019  |
| 6096 | -103803.989          | -20741.297 | 4.718  |
| 3400 | -103803.187          | -20741.956 | 1.038  |
| 面積   | 41.8562975           |            |        |
| 地積   | 41.85 m <sup>2</sup> |            |        |

|      |                        |            |        |
|------|------------------------|------------|--------|
| 2787 |                        |            |        |
| 地 番  | 幡六五六                   |            |        |
| N O  | X                      | Y          | 辺 長    |
| 7324 | -103818.955            | -20733.444 |        |
| 3422 | -103823.844            | -20725.878 | 9.008  |
| 3421 | -103831.810            | -20713.561 | 14.668 |
| 3420 | -103836.360            | -20706.520 | 8.383  |
| 3419 | -103845.970            | -20691.293 | 18.005 |
| 3439 | -103848.873            | -20682.932 | 8.850  |
| 3438 | -103845.366            | -20678.560 | 5.604  |
| 9769 | -103831.726            | -20674.591 | 14.205 |
| 3501 | -103815.167            | -20670.717 | 17.006 |
| 3807 | -103813.192            | -20673.815 | 3.673  |
| 3808 | -103810.732            | -20678.992 | 5.731  |
| 7531 | -103807.841            | -20676.616 | 3.742  |
| 6068 | -103806.875            | -20678.649 | 2.250  |
| 6070 | -103801.668            | -20678.889 | 5.212  |
| 6072 | -103797.309            | -20678.207 | 4.412  |
| 6074 | -103794.851            | -20690.331 | 12.370 |
| 6076 | -103797.579            | -20690.877 | 2.782  |
| 6078 | -103798.361            | -20695.709 | 4.894  |
| 6080 | -103799.035            | -20702.953 | 7.275  |
| 6082 | -103799.373            | -20707.370 | 4.429  |
| 6084 | -103800.163            | -20710.928 | 3.644  |
| 6086 | -103801.051            | -20713.383 | 2.610  |
| 6088 | -103804.818            | -20721.174 | 8.653  |
| 5918 | -103805.749            | -20724.917 | 3.857  |
| 7324 | -103818.955            | -20733.444 | 15.719 |
| 面積   | 2041.3808955           |            |        |
| 地積   | 2041.38 m <sup>2</sup> |            |        |

|      |                       |            |        |
|------|-----------------------|------------|--------|
| 2788 |                       |            |        |
| 地 番  | 保五三ノ一                 |            |        |
| N O  | X                     | Y          | 辺 長    |
| 7325 | -103804.101           | -20741.865 |        |
| 3395 | -103811.501           | -20741.129 | 7.436  |
| 3411 | -103815.879           | -20738.204 | 5.265  |
| 7324 | -103818.955           | -20733.444 | 5.667  |
| 5918 | -103805.749           | -20724.917 | 15.719 |
| 5919 | -103805.856           | -20725.319 | 0.415  |
| 6090 | -103806.404           | -20731.833 | 6.537  |
| 6092 | -103805.864           | -20736.914 | 5.100  |
| 6095 | -103804.408           | -20741.584 | 4.922  |
| 7325 | -103804.101           | -20741.865 | 0.416  |
| 面積   | 134.9167465           |            |        |
| 地積   | 134.91 m <sup>2</sup> |            |        |

|                               |                     |       |  |
|-------------------------------|---------------------|-------|--|
| 図面の種類                         | 画 地 出 来 形 確 認 測 量 図 |       |  |
| 街 区 名                         | 53                  | 求 積 表 |  |
| 町 名                           | 岩 倉 幡 枝 町           |       |  |
| 京 都 市 洛 北 第 三 土 地 区 画 整 理 組 合 |                     |       |  |



5 5 街 区

| 2799 |             |            |        |
|------|-------------|------------|--------|
| 地 番  | 幡四三〇ノ五      |            |        |
| N O  | X           | Y          | 辺 長    |
| 3417 | -103842.912 | -20710.923 |        |
| 3416 | -103843.326 | -20712.524 | 1.653  |
| 7307 | -103855.077 | -20718.877 | 13.358 |
| 6049 | -103859.731 | -20710.249 | 9.803  |
| 7323 | -103847.520 | -20703.636 | 13.886 |
| 3417 | -103842.912 | -20710.923 | 8.621  |
| 面積   | 138.8075030 |            |        |
| 地積   | 138.80　㎡    |            |        |

| 2800 |             |            |        |
|------|-------------|------------|--------|
| 地 番  | 保五五ノ三       |            |        |
| N O  | X           | Y          | 辺 長    |
| 7323 | -103847.520 | -20703.636 |        |
| 6049 | -103859.731 | -20710.249 | 13.886 |
| 6052 | -103865.041 | -20700.410 | 11.180 |
| 6051 | -103860.205 | -20697.815 | 5.488  |
| 6050 | -103859.479 | -20699.164 | 1.531  |
| 7322 | -103852.669 | -20695.491 | 7.737  |
| 7323 | -103847.520 | -20703.636 | 9.636  |
| 面積   | 138.9103490 |            |        |
| 地積   | 138.91　㎡    |            |        |

| 2801 |             |            |        |
|------|-------------|------------|--------|
| 地 番  | 幡四三〇ノ一      |            |        |
| N O  | X           | Y          | 辺 長    |
| 7322 | -103852.669 | -20695.491 |        |
| 6050 | -103859.479 | -20699.164 | 7.737  |
| 6051 | -103860.205 | -20697.815 | 1.531  |
| 7321 | -103867.008 | -20685.291 | 14.252 |
| 3431 | -103866.948 | -20685.263 | 0.066  |
| 3430 | -103858.852 | -20681.395 | 8.972  |
| 3429 | -103857.574 | -20681.932 | 1.386  |
| 3418 | -103853.155 | -20694.723 | 13.532 |
| 7322 | -103852.669 | -20695.491 | 0.908  |
| 面積   | 136.4833295 |            |        |
| 地積   | 136.48　㎡    |            |        |

| 2802 |             |            |        |
|------|-------------|------------|--------|
| 地 番  | 幡四三〇ノ八      |            |        |
| N O  | X           | Y          | 辺 長    |
| 7321 | -103867.008 | -20685.291 |        |
| 6051 | -103860.205 | -20697.815 | 14.252 |
| 6052 | -103865.041 | -20700.410 | 5.488  |
| 6055 | -103869.869 | -20703.034 | 5.494  |
| 7320 | -103876.981 | -20689.970 | 14.874 |
| 7321 | -103867.008 | -20685.291 | 11.016 |
| 面積   | 159.9700545 |            |        |
| 地積   | 159.97　㎡    |            |        |

| 2803 |             |            |        |
|------|-------------|------------|--------|
| 地 番  | 幡四三〇ノ九      | 幡四三〇ノ一     |        |
| N O  | X           | Y          | 辺 長    |
| 7320 | -103876.981 | -20689.970 |        |
| 6055 | -103869.869 | -20703.034 | 14.874 |
| 6048 | -103873.489 | -20704.969 | 4.104  |
| 4127 | -103879.740 | -20708.361 | 7.112  |
| 6053 | -103880.164 | -20708.591 | 0.482  |
| 6054 | -103880.483 | -20708.069 | 0.611  |
| 4129 | -103880.946 | -20706.132 | 1.991  |
| 7319 | -103884.039 | -20693.210 | 13.287 |
| 3433 | -103883.753 | -20693.107 | 0.303  |
| 3432 | -103877.034 | -20689.995 | 7.404  |
| 7320 | -103876.981 | -20689.970 | 0.058  |
| 面積   | 148.8035770 |            |        |
| 地積   | 148.80　㎡    |            |        |

| 2804 |             |            |        |
|------|-------------|------------|--------|
| 地 番  | 幡四二三ノ五      |            |        |
| N O  | X           | Y          | 辺 長    |
| 7319 | -103884.039 | -20693.210 |        |
| 4129 | -103880.946 | -20706.132 | 13.287 |
| 6054 | -103880.483 | -20708.069 | 1.991  |
| 4126 | -103881.052 | -20708.207 | 0.585  |
| 7318 | -103884.593 | -20693.409 | 15.215 |
| 7319 | -103884.039 | -20693.210 | 0.588  |
| 面積   | 8.9282525   |            |        |
| 地積   | 8.92　㎡      |            |        |

| 2805 |             |            |        |
|------|-------------|------------|--------|
| 地 番  | 幡四二三ノ四      |            |        |
| N O  | X           | Y          | 辺 長    |
| 7318 | -103884.593 | -20693.409 |        |
| 4126 | -103881.052 | -20708.207 | 15.215 |
| 6047 | -103882.493 | -20708.556 | 1.482  |
| 4130 | -103887.179 | -20709.680 | 4.818  |
| 6045 | -103891.185 | -20710.641 | 4.119  |
| 6044 | -103893.463 | -20711.182 | 2.341  |
| 3456 | -103894.467 | -20698.007 | 13.213 |
| 3457 | -103888.614 | -20695.206 | 6.488  |
| 3458 | -103886.484 | -20694.090 | 2.404  |
| 7318 | -103884.593 | -20693.409 | 2.009  |
| 面積   | 165.1974105 |            |        |
| 地積   | 165.19　㎡    |            |        |

| 2806 |             |            |        |
|------|-------------|------------|--------|
| 地 番  | 幡四二三ノ三      | 幡四二四ノ二     |        |
| N O  | X           | Y          | 辺 長    |
| 3456 | -103894.467 | -20698.007 |        |
| 6044 | -103893.463 | -20711.182 | 13.213 |
| 6043 | -103892.477 | -20723.501 | 12.358 |
| 6046 | -103892.136 | -20734.325 | 10.829 |
| 4132 | -103892.142 | -20737.587 | 3.262  |
| 4133 | -103897.030 | -20738.413 | 4.957  |
| 5947 | -103902.046 | -20727.479 | 12.029 |
| 5948 | -103904.444 | -20722.261 | 5.742  |
| 4136 | -103909.908 | -20709.696 | 13.701 |
| 5939 | -103911.064 | -20707.038 | 2.898  |
| 4134 | -103913.400 | -20701.667 | 5.857  |
| 3445 | -103913.173 | -20701.733 | 0.236  |
| 3446 | -103912.131 | -20702.175 | 1.131  |
| 3447 | -103911.233 | -20702.713 | 1.046  |
| 3448 | -103910.065 | -20703.541 | 1.431  |
| 3449 | -103909.587 | -20703.865 | 0.577  |
| 3450 | -103909.311 | -20704.025 | 0.319  |
| 3451 | -103909.021 | -20704.147 | 0.314  |
| 3452 | -103908.657 | -20704.269 | 0.383  |
| 3453 | -103908.255 | -20704.353 | 0.410  |
| 3454 | -103906.566 | -20704.574 | 1.703  |
| 3455 | -103897.914 | -20699.828 | 9.868  |
| 3456 | -103894.467 | -20698.007 | 3.898  |
| 面積   | 448.0023480 |            |        |
| 地積   | 448.00　㎡    |            |        |

| 2807 |             |            |        |
|------|-------------|------------|--------|
| 地 番  | 幡四二二ノ二B     |            |        |
| N O  | X           | Y          | 辺 長    |
| 4134 | -103913.400 | -20701.667 |        |
| 5939 | -103911.064 | -20707.038 | 5.857  |
| 4135 | -103913.413 | -20708.242 | 2.639  |
| 4138 | -103914.990 | -20705.308 | 3.330  |
| 4137 | -103931.288 | -20714.878 | 18.899 |
| 2608 | -103930.574 | -20712.140 | 2.829  |
| 3444 | -103913.887 | -20701.525 | 19.777 |
| 4134 | -103913.400 | -20701.667 | 0.507  |
| 面積   | 58.5222035  |            |        |
| 地積   | 58.52　㎡     |            |        |

| 2808 |             |            |        |
|------|-------------|------------|--------|
| 地 番  | 保五五ノ四       |            |        |
| N O  | X           | Y          | 辺 長    |
| 5941 | -103932.046 | -20717.788 |        |
| 4137 | -103931.288 | -20714.878 | 3.007  |
| 4138 | -103914.990 | -20705.308 | 18.899 |
| 4135 | -103913.413 | -20708.242 | 3.330  |
| 5941 | -103932.046 | -20717.788 | 20.935 |
| 面積   | 54.9481920  |            |        |
| 地積   | 54.94　㎡     |            |        |

| 2809 |             |            |        |
|------|-------------|------------|--------|
| 地 番  | 幡四二四ノ一      |            |        |
| N O  | X           | Y          | 辺 長    |
| 5941 | -103932.046 | -20717.788 |        |
| 4135 | -103913.413 | -20708.242 | 20.935 |
| 5939 | -103911.064 | -20707.038 | 2.639  |
| 4136 | -103909.908 | -20709.696 | 2.898  |
| 4139 | -103932.453 | -20721.248 | 25.332 |
| 2607 | -103932.786 | -20720.633 | 0.699  |
| 5941 | -103932.046 | -20717.788 | 2.939  |
| 面積   | 71.4465495  |            |        |
| 地積   | 71.44　㎡     |            |        |

| 2810 |             |            |        |
|------|-------------|------------|--------|
| 地 番  | 幡四二三ノ一      |            |        |
| N O  | X           | Y          | 辺 長    |
| 4139 | -103932.453 | -20721.248 |        |
| 4136 | -103909.908 | -20709.696 | 25.332 |
| 5948 | -103904.444 | -20722.261 | 13.701 |
| 5947 | -103902.046 | -20727.479 | 5.742  |
| 4140 | -103908.310 | -20730.868 | 7.122  |
| 5946 | -103909.561 | -20731.545 | 1.422  |
| 5945 | -103907.847 | -20734.728 | 3.615  |
| 7317 | -103921.255 | -20741.950 | 15.229 |
| 2606 | -103925.161 | -20734.724 | 8.214  |
| 4139 | -103932.453 | -20721.248 | 15.322 |
| 面積   | 537.0926965 |            |        |
| 地積   | 537.09　㎡    |            |        |

| 2811 |             |            |        |
|------|-------------|------------|--------|
| 地 番  | 保五五ノ一       |            |        |
| N O  | X           | Y          | 辺 長    |
| 7316 | -103902.538 | -20744.557 |        |
| 3470 | -103913.301 | -20750.374 | 12.234 |
| 2605 | -103917.365 | -20749.145 | 4.245  |
| 7317 | -103921.255 | -20741.950 | 8.179  |
| 5945 | -103907.847 | -20734.728 | 15.229 |
| 7316 | -103902.538 | -20744.557 | 11.171 |
| 面積   | 165.7622150 |            |        |
| 地積   | 165.76　㎡    |            |        |


| 2812 |             |            |        |
|------|-------------|------------|--------|
| 地 番  | 幡四二三ノ六      | 幡四二八       | 幡四二九   |
| N O  | X           | Y          | 辺 長    |
| 7315 | -103901.282 | -20743.878 |        |
| 7316 | -103902.538 | -20744.557 | 1.427  |
| 5945 | -103907.847 | -20734.728 | 11.171 |
| 5946 | -103909.561 | -20731.545 | 3.615  |
| 4140 | -103908.310 | -20730.868 | 1.422  |
| 5947 | -103902.046 | -20727.479 | 7.122  |
| 4133 | -103897.030 | -20738.413 | 12.029 |
| 7314 | -103895.867 | -20740.946 | 2.787  |
| 3425 | -103899.765 | -20743.058 | 4.433  |
| 7315 | -103901.282 | -20743.878 | 1.724  |
| 面積   | 119.2733955 |            |        |
| 地積   | 119.27　㎡    |            |        |

| 2813 |             |            |       |
|------|-------------|------------|-------|
| 地 番  | 保五五ノ二       |            |       |
| N O  | X           | Y          | 辺 長   |
| 7314 | -103895.867 | -20740.946 |       |
| 4133 | -103897.030 | -20738.413 | 2.787 |
| 4132 | -103892.142 | -20737.587 | 4.957 |
| 7313 | -103892.144 | -20738.929 | 1.342 |
| 7314 | -103895.867 | -20740.946 | 4.234 |
| 面積   | 9.1670870   |            |       |
| 地積   | 9.16　㎡      |            |       |

| 2814 |             |            |        |
|------|-------------|------------|--------|
| 地 番  | 幡四二三ノ七      |            |        |
| N O  | X           | Y          | 辺 長    |
| 7313 | -103892.144 | -20738.929 |        |
| 4132 | -103892.142 | -20737.587 | 1.342  |
| 6046 | -103892.136 | -20734.325 | 3.262  |
| 6043 | -103892.477 | -20723.501 | 10.829 |
| 6044 | -103893.463 | -20711.182 | 12.358 |
| 6045 | -103891.185 | -20710.641 | 2.341  |
| 7312 | -103879.521 | -20732.098 | 24.422 |
| 3424 | -103885.683 | -20735.429 | 7.004  |
| 7313 | -103892.144 | -20738.929 | 7.348  |
| 面積   | 200.8197610 |            |        |
| 地積   | 200.81　㎡    |            |        |

| 2815 |             |            |        |
|------|-------------|------------|--------|
| 地 番  | 幡四二三ノ二      | 幡四三〇ノ一〇    |        |
| N O  | X           | Y          | 辺 長    |
| 7312 | -103879.521 | -20732.098 |        |
| 6045 | -103891.185 | -20710.641 | 24.422 |
| 4130 | -103887.179 | -20709.680 | 4.119  |
| 6047 | -103882.493 | -20708.556 | 4.818  |
| 7310 | -103871.958 | -20728.010 | 22.123 |
| 7311 | -103876.017 | -20730.204 | 4.614  |
| 7312 | -103879.521 | -20732.098 | 3.983  |
| 面積   | 200.5109490 |            |        |
| 地積   | 200.51　㎡    |            |        |

|      |                       |            |        |
|------|-----------------------|------------|--------|
| 2816 |                       |            |        |
| 地 番  | 幡四三〇ノ三 幡四三〇ノ七         |            |        |
| N O  | X                     | Y          | 辺 長    |
| 7310 | -103871.958           | -20728.010 |        |
| 6047 | -103882.493           | -20708.556 | 22.123 |
| 4126 | -103881.052           | -20708.207 | 1.482  |
| 6054 | -103880.483           | -20708.069 | 0.585  |
| 6053 | -103880.164           | -20708.591 | 0.611  |
| 4127 | -103879.740           | -20708.361 | 0.482  |
| 6048 | -103873.489           | -20704.969 | 7.112  |
| 7308 | -103863.511           | -20723.440 | 20.993 |
| 7309 | -103869.749           | -20726.815 | 7.092  |
| 3423 | -103871.558           | -20727.794 | 2.056  |
| 7310 | -103871.958           | -20728.010 | 0.454  |
| 面積   | 203.5566170           |            |        |
| 地積   | 203.55 m <sup>2</sup> |            |        |

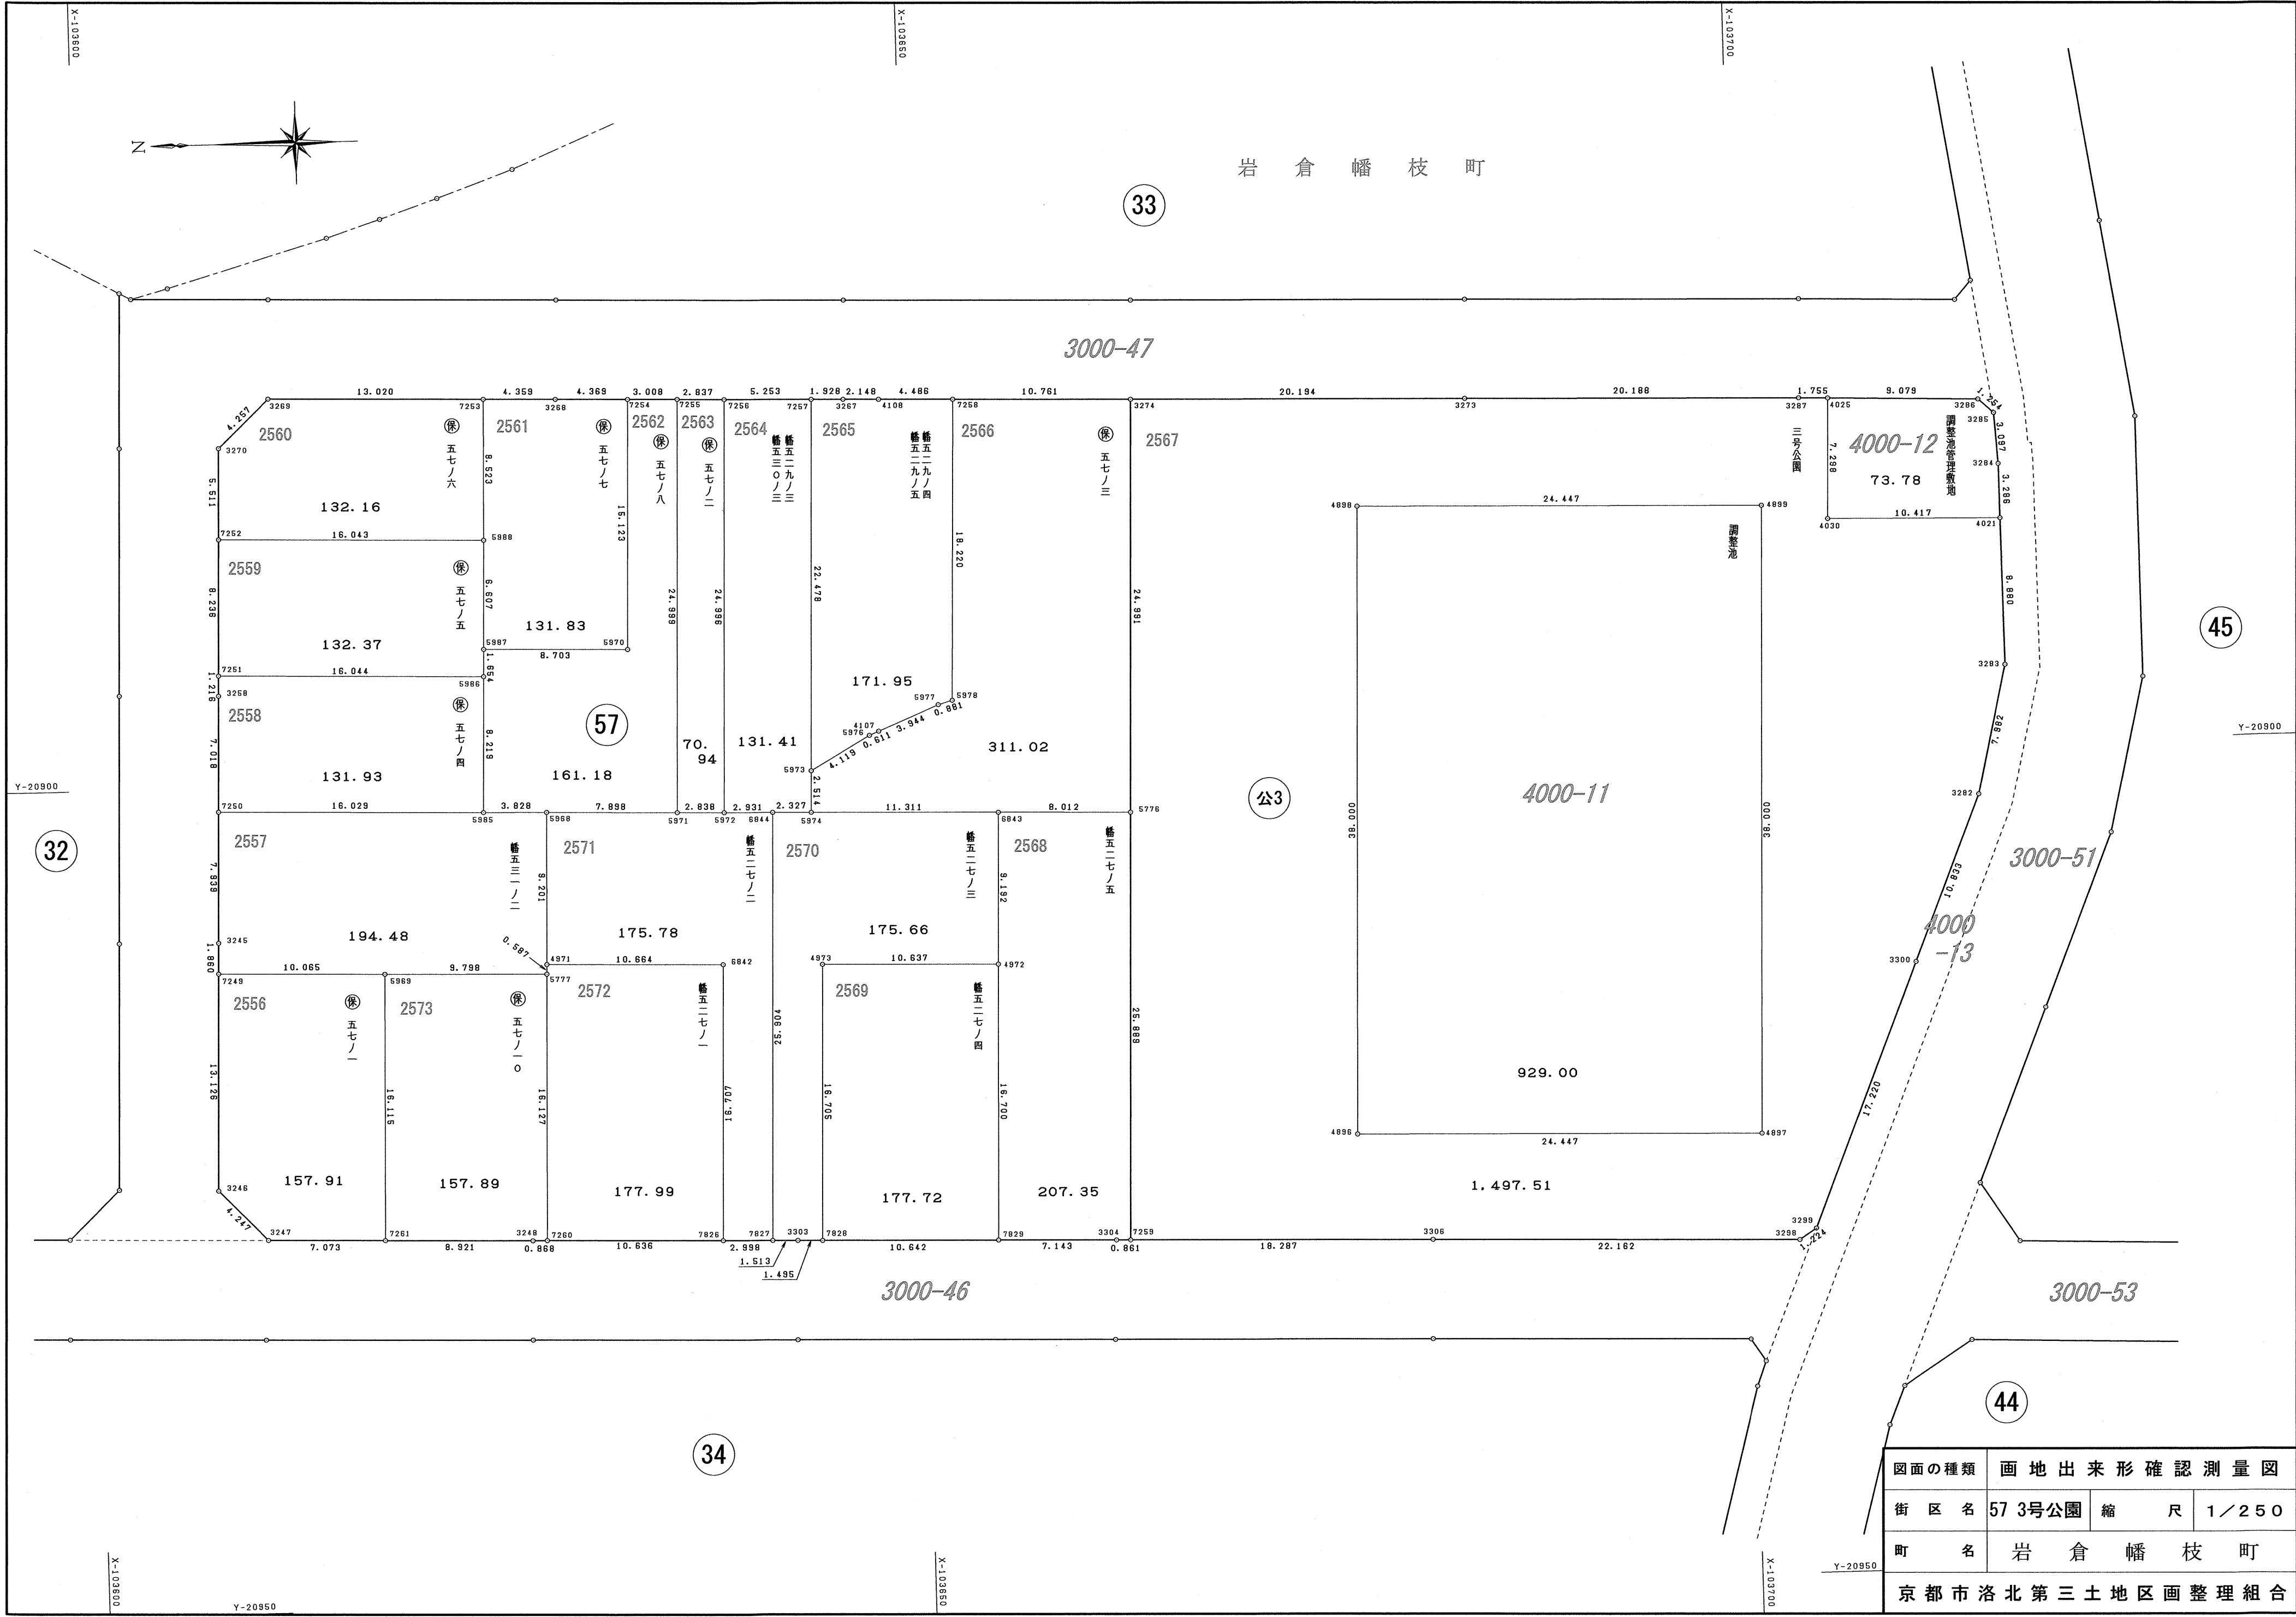

|                 |            |     |       |
|-----------------|------------|-----|-------|
| 図面の種類           | 画地出来形確認測量図 |     |       |
| 街 区 名           | 57 3号公園    | 縮 尺 | 1／250 |
| 町 名             | 岩 倉 幡 枝 町  |     |       |
| 京都市洛北第三土地区画整理組合 |            |     |       |

5 7 街 区

|      |                       |            |        |
|------|-----------------------|------------|--------|
| 2556 |                       |            |        |
| 地 番  | 保五七ノ一                 |            |        |
| N O  | X                     | Y          | 辺 長    |
| 3247 | -103610.199           | -20927.427 |        |
| 7261 | -103617.270           | -20927.615 | 7.073  |
| 5969 | -103617.657           | -20911.504 | 16.115 |
| 7249 | -103607.595           | -20911.242 | 10.065 |
| 3246 | -103607.256           | -20924.364 | 13.126 |
| 3247 | -103610.199           | -20927.427 | 4.247  |
| 面積   | 157.9106310           |            |        |
| 地積   | 157.91 m <sup>2</sup> |            |        |

|      |                       |            |        |
|------|-----------------------|------------|--------|
| 2557 |                       |            |        |
| 地 番  | 幡五三一ノ二                |            |        |
| N O  | X                     | Y          | 辺 長    |
| 7249 | -103607.595           | -20911.242 |        |
| 5969 | -103617.657           | -20911.504 | 10.065 |
| 5777 | -103627.452           | -20911.752 | 9.798  |
| 4971 | -103627.467           | -20911.165 | 0.587  |
| 5968 | -103627.700           | -20901.966 | 9.201  |
| 5985 | -103623.873           | -20901.874 | 3.828  |
| 7250 | -103607.849           | -20901.445 | 16.029 |
| 3245 | -103607.643           | -20909.382 | 7.939  |
| 7249 | -103607.595           | -20911.242 | 1.860  |
| 面積   | 194.4832000           |            |        |
| 地積   | 194.48 m <sup>2</sup> |            |        |

|      |                       |            |        |
|------|-----------------------|------------|--------|
| 2558 |                       |            |        |
| 地 番  | 保五七ノ四                 |            |        |
| N O  | X                     | Y          | 辺 長    |
| 7250 | -103607.849           | -20901.445 |        |
| 5985 | -103623.873           | -20901.874 | 16.029 |
| 5986 | -103624.102           | -20893.658 | 8.219  |
| 7251 | -103608.064           | -20893.213 | 16.044 |
| 3258 | -103608.032           | -20894.429 | 1.216  |
| 7250 | -103607.849           | -20901.445 | 7.018  |
| 面積   | 131.9369500           |            |        |
| 地積   | 131.93 m <sup>2</sup> |            |        |

|      |                       |            |        |
|------|-----------------------|------------|--------|
| 2559 |                       |            |        |
| 地 番  | 保五七ノ五                 |            |        |
| N O  | X                     | Y          | 辺 長    |
| 7251 | -103608.064           | -20893.213 |        |
| 5986 | -103624.102           | -20893.658 | 16.044 |
| 5987 | -103624.150           | -20892.004 | 1.654  |
| 5988 | -103624.316           | -20885.399 | 6.607  |
| 7252 | -103608.278           | -20884.979 | 16.043 |
| 7251 | -103608.064           | -20893.213 | 8.236  |
| 面積   | 132.3711600           |            |        |
| 地積   | 132.37 m <sup>2</sup> |            |        |

|      |                       |            |        |
|------|-----------------------|------------|--------|
| 2560 |                       |            |        |
| 地 番  | 保五七ノ六                 |            |        |
| N O  | X                     | Y          | 辺 長    |
| 7252 | -103608.278           | -20884.979 |        |
| 5988 | -103624.316           | -20885.399 | 16.043 |
| 7253 | -103624.524           | -20876.878 | 8.523  |
| 3269 | -103611.508           | -20876.536 | 13.020 |
| 3270 | -103608.422           | -20879.469 | 4.257  |
| 7252 | -103608.278           | -20884.979 | 5.511  |
| 面積   | 132.1637070           |            |        |
| 地積   | 132.16 m <sup>2</sup> |            |        |

|      |                       |            |        |
|------|-----------------------|------------|--------|
| 2561 |                       |            |        |
| 地 番  | 保五七ノ七                 |            |        |
| N O  | X                     | Y          | 辺 長    |
| 7253 | -103624.524           | -20876.878 |        |
| 5988 | -103624.316           | -20885.399 | 8.523  |
| 5987 | -103624.150           | -20892.004 | 6.607  |
| 5970 | -103632.851           | -20892.227 | 8.703  |
| 7254 | -103633.250           | -20877.109 | 15.123 |
| 3268 | -103628.882           | -20876.993 | 4.369  |
| 7253 | -103624.524           | -20876.878 | 4.359  |
| 面積   | 131.8345635           |            |        |
| 地積   | 131.83 m <sup>2</sup> |            |        |

|      |                       |            |        |
|------|-----------------------|------------|--------|
| 2562 |                       |            |        |
| 地 番  | 保五七ノ八                 |            |        |
| N O  | X                     | Y          | 辺 長    |
| 7254 | -103633.250           | -20877.109 |        |
| 5970 | -103632.851           | -20892.227 | 15.123 |
| 5987 | -103624.150           | -20892.004 | 8.703  |
| 5986 | -103624.102           | -20893.658 | 1.654  |
| 5985 | -103623.873           | -20901.874 | 8.219  |
| 5968 | -103627.700           | -20901.966 | 3.828  |
| 5971 | -103635.596           | -20902.180 | 7.898  |
| 7255 | -103636.257           | -20877.109 | 24.999 |
| 7254 | -103633.250           | -20877.109 | 3.008  |
| 面積   | 161.1868600           |            |        |
| 地積   | 161.18 m <sup>2</sup> |            |        |

|      |                      |            |        |
|------|----------------------|------------|--------|
| 2563 |                      |            |        |
| 地 番  | 保五七ノ二                |            |        |
| N O  | X                    | Y          | 辺 長    |
| 7255 | -103636.257          | -20877.189 |        |
| 5971 | -103635.596          | -20902.180 | 24.999 |
| 5972 | -103638.434          | -20902.253 | 2.838  |
| 7256 | -103639.093          | -20877.265 | 24.996 |
| 7255 | -103636.257          | -20877.189 | 2.837  |
| 面積   | 70.9443815           |            |        |
| 地積   | 70.94 m <sup>2</sup> |            |        |

|      |                       |            |        |
|------|-----------------------|------------|--------|
| 2564 |                       |            |        |
| 地 番  | 幡五二九ノ三 幡五三〇ノ三         |            |        |
| N O  | X                     | Y          | 辺 長    |
| 7256 | -103639.093           | -20877.265 |        |
| 5972 | -103638.434           | -20902.253 | 24.996 |
| 6844 | -103641.365           | -20902.327 | 2.931  |
| 5974 | -103643.692           | -20902.390 | 2.327  |
| 5973 | -103643.760           | -20899.876 | 2.514  |
| 7257 | -103644.345           | -20877.405 | 22.478 |
| 7256 | -103639.093           | -20877.265 | 5.253  |
| 面積   | 131.4173550           |            |        |
| 地積   | 131.41 m <sup>2</sup> |            |        |

|      |                       |            |        |
|------|-----------------------|------------|--------|
| 2565 |                       |            |        |
| 地 番  | 幡五二九ノ四 幡五二九ノ五         |            |        |
| N O  | X                     | Y          | 辺 長    |
| 7257 | -103644.345           | -20877.405 |        |
| 5973 | -103643.760           | -20899.876 | 22.478 |
| 5976 | -103647.333           | -20897.826 | 4.119  |
| 4107 | -103647.898           | -20897.593 | 0.611  |
| 5977 | -103651.545           | -20896.091 | 3.944  |
| 5978 | -103652.392           | -20895.847 | 0.881  |
| 7258 | -103652.906           | -20877.634 | 18.220 |
| 4108 | -103648.421           | -20877.514 | 4.486  |
| 3267 | -103646.273           | -20877.456 | 2.148  |
| 7257 | -103644.345           | -20877.405 | 1.928  |
| 面積   | 171.9557580           |            |        |
| 地積   | 171.95 m <sup>2</sup> |            |        |

|      |                       |            |        |
|------|-----------------------|------------|--------|
| 2566 |                       |            |        |
| 地 番  | 保五七ノ三                 |            |        |
| N O  | X                     | Y          | 辺 長    |
| 7258 | -103652.906           | -20877.634 |        |
| 5978 | -103652.392           | -20895.847 | 18.220 |
| 5977 | -103651.545           | -20896.091 | 0.881  |
| 4107 | -103647.898           | -20897.593 | 3.944  |
| 5976 | -103647.333           | -20897.826 | 0.611  |
| 5973 | -103643.760           | -20899.876 | 4.119  |
| 5974 | -103643.692           | -20902.390 | 2.514  |
| 6843 | -103654.999           | -20902.694 | 11.311 |
| 5776 | -103663.009           | -20902.905 | 8.012  |
| 3274 | -103663.664           | -20877.922 | 24.991 |
| 7258 | -103652.906           | -20877.634 | 10.761 |
| 面積   | 311.0208390           |            |        |
| 地積   | 311.02 m <sup>2</sup> |            |        |

|      |                       |            |        |
|------|-----------------------|------------|--------|
| 2568 |                       |            |        |
| 地 番  | 幡五二七ノ五                |            |        |
| N O  | X                     | Y          | 辺 長    |
| 7829 | -103654.334           | -20928.578 |        |
| 3304 | -103661.475           | -20928.764 | 7.143  |
| 7259 | -103662.336           | -20928.786 | 0.861  |
| 5776 | -103663.009           | -20902.905 | 25.889 |
| 6843 | -103654.999           | -20902.694 | 8.012  |
| 4972 | -103654.763           | -20911.883 | 9.192  |
| 7829 | -103654.334           | -20928.578 | 16.700 |
| 面積   | 207.3559420           |            |        |
| 地積   | 207.35 m <sup>2</sup> |            |        |

|      |                       |            |        |
|------|-----------------------|------------|--------|
| 2569 |                       |            |        |
| 地 番  | 幡五二七ノ四                |            |        |
| N O  | X                     | Y          | 辺 長    |
| 7828 | -103643.695           | -20928.301 |        |
| 7829 | -103654.334           | -20928.578 | 10.642 |
| 4972 | -103654.763           | -20911.883 | 16.700 |
| 4973 | -103644.129           | -20911.601 | 10.637 |
| 7828 | -103643.695           | -20928.301 | 16.705 |
| 面積   | 177.7235630           |            |        |
| 地積   | 177.72 m <sup>2</sup> |            |        |

|      |                       |            |        |
|------|-----------------------|------------|--------|
| 2570 |                       |            |        |
| 地 番  | 幡五二七ノ三                |            |        |
| N O  | X                     | Y          | 辺 長    |
| 7828 | -103643.695           | -20928.301 |        |
| 4973 | -103644.129           | -20911.601 | 16.705 |
| 4972 | -103654.763           | -20911.883 | 10.637 |
| 6843 | -103654.999           | -20902.694 | 9.192  |
| 5974 | -103643.692           | -20902.390 | 11.311 |
| 6844 | -103641.365           | -20902.327 | 2.327  |
| 7827 | -103640.687           | -20928.223 | 25.904 |
| 3303 | -103642.200           | -20928.262 | 1.513  |
| 7828 | -103643.695           | -20928.301 | 1.495  |
| 面積   | 175.6679195           |            |        |
| 地積   | 175.66 m <sup>2</sup> |            |        |

|      |                       |            |        |
|------|-----------------------|------------|--------|
| 2571 |                       |            |        |
| 地 番  | 幡五二七ノ二                |            |        |
| N O  | X                     | Y          | 辺 長    |
| 7826 | -103637.689           | -20928.147 |        |
| 7827 | -103640.687           | -20928.223 | 2.998  |
| 6844 | -103641.365           | -20902.327 | 25.904 |
| 5972 | -103638.434           | -20902.253 | 2.931  |
| 5971 | -103635.596           | -20902.180 | 2.838  |
| 5968 | -103627.700           | -20901.966 | 7.898  |
| 4971 | -103627.467           | -20911.165 | 9.201  |
| 6842 | -103638.128           | -20911.445 | 10.664 |
| 7826 | -103637.689           | -20928.147 | 16.707 |
| 面積   | 175.7866545           |            |        |
| 地積   | 175.78 m <sup>2</sup> |            |        |

|      |                       |            |        |
|------|-----------------------|------------|--------|
| 2572 |                       |            |        |
| 地 番  | 幡五二七ノ一                |            |        |
| N O  | X                     | Y          | 辺 長    |
| 7260 | -103627.056           | -20927.875 |        |
| 7826 | -103637.689           | -20928.147 | 10.636 |
| 6842 | -103638.128           | -20911.445 | 16.707 |
| 4971 | -103627.467           | -20911.165 | 10.664 |
| 5777 | -103627.452           | -20911.752 | 0.587  |
| 7260 | -103627.056           | -20927.875 | 16.127 |
| 面積   | 177.9907785           |            |        |
| 地積   | 177.99 m <sup>2</sup> |            |        |

|      |                       |            |        |
|------|-----------------------|------------|--------|
| 2573 |                       |            |        |
| 地 番  | 保五七ノ一〇                |            |        |
| N O  | X                     | Y          | 辺 長    |
| 7261 | -103617.270           | -20927.615 |        |
| 3248 | -103626.188           | -20927.853 | 8.921  |
| 7260 | -103627.056           | -20927.875 | 0.868  |
| 5777 | -103627.452           | -20911.752 | 16.127 |
| 5969 | -103617.657           | -20911.504 | 9.798  |
| 7261 | -103617.270           | -20927.615 | 16.115 |
| 面積   | 157.8981235           |            |        |
| 地積   | 157.89 m <sup>2</sup> |            |        |

3 号 公 園

|      |                        |            |        |
|------|------------------------|------------|--------|
| 2567 |                        |            |        |
| 地 番  | 三号公園                   |            |        |
| N O  | X                      | Y          | 辺 長    |
| 7259 | -103662.336            | -20928.786 |        |
| 3306 | -103680.618            | -20929.253 | 18.287 |
| 3298 | -103702.773            | -20929.847 | 22.162 |
| 3299 | -103703.794            | -20929.171 | 1.224  |
| 4897 | -103700.656            | -20923.349 | 6.613  |
| 4896 | -103676.216            | -20922.750 | 24.447 |
| 4898 | -103677.185            | -20884.762 | 38.000 |
| 4899 | -103701.625            | -20885.361 | 24.447 |
| 4897 | -103700.656            | -20923.349 | 38.000 |
| 3299 | -103703.794            | -20929.171 | 6.613  |
| 3300 | -103710.234            | -20913.200 | 17.220 |
| 3282 | -103714.292            | -20903.155 | 10.833 |
| 3283 | -103716.084            | -20895.376 | 7.982  |
| 4021 | -103716.018            | -20886.496 | 8.880  |
| 4030 | -103705.603            | -20886.271 | 10.417 |
| 4025 | -103705.789            | -20878.975 | 7.298  |
| 3287 | -103704.034            | -20878.918 | 1.755  |
| 3273 | -103693.852            | -20878.423 | 20.188 |
| 3274 | -103663.664            | -20877.922 | 20.194 |
| 5776 | -103663.009            | -20902.905 | 24.991 |
| 7259 | -103662.336            | -20928.786 | 25.889 |
| 面積   | 1497.5104950           |            |        |
| 地積   | 1497.51 m <sup>2</sup> |            |        |

|       |                   |
|-------|-------------------|
| 図面の種類 | 画 地 出 来 形 確 認 測 量 |
|-------|-------------------|