

京都都市計画（京都国際文化観光都市建設計画）
 都市建設事業洛西第二地区土地区画整理事業

画地出来形確認測量図

1 / 5

1 街区～29 街区
 平成17年9月2日現在


洛西第二土地区画整理組合
 第一測量設計株式会社

洛西第二土地区画整理事業画地出来形測量図

嵐山	嵐山宮ノ前町	1		
桂	桂池尻町			5
	桂上野今井町	2		
	桂上野北町		3	
	桂上野中町		3	
	桂上野西町	2		
	桂上野東町		3	4
	桂上野南町		3	
	桂河田町		4	5
	桂清水町			5
	桂徳大寺町		4	
	桂徳大寺北町		4	5
	桂徳大寺東町		4	
	桂徳大寺南町			5
	桂畑ヶ田町		4	
	桂久方町			5
上桂	上桂今井町	2		
	上桂北ノ口町	2	3	
	上桂北村町		3	
	上桂東ノ口町			5
	上桂前川町	2		
松室	松室吾田神町	1	2	
	松室荒堀町	1		
	松室河原町	1		
	松室北河原町	1		
	松室中溝町	1		
	松尾東ノ口町		2	

京都都市計画（京都国際文化観光都市建設計画）
都市計画事業洛西第二地区土地区画整理事業

新町界図

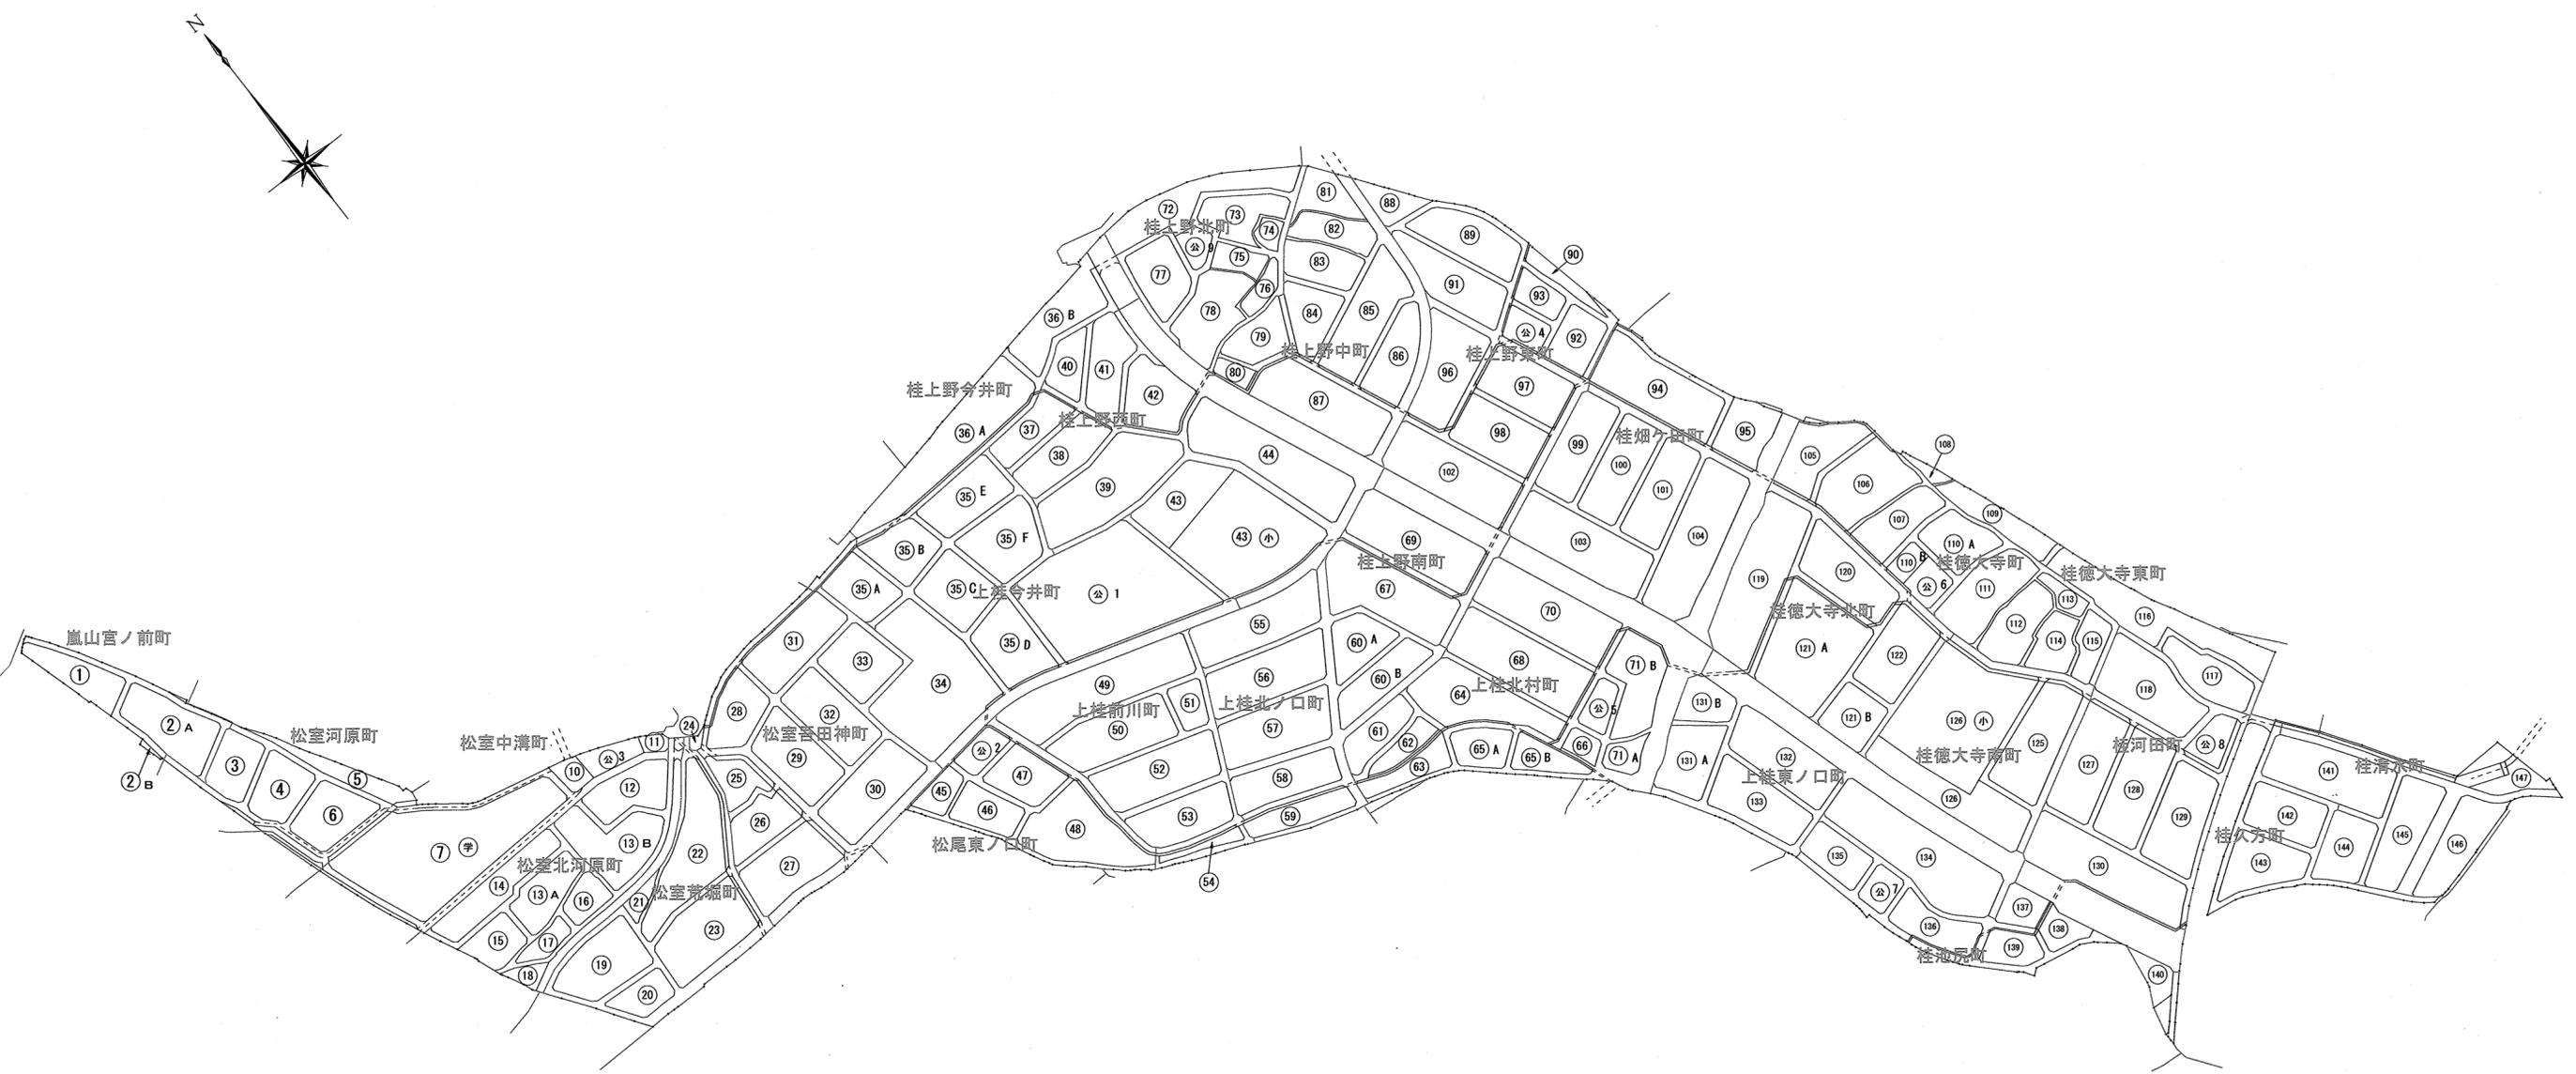

101

Table with 4 columns: NO, X, Y, 辺長. Includes area and ground area calculations.

102

Table with 4 columns: NO, X, Y, 辺長. Includes area and ground area calculations.

103

Table with 4 columns: NO, X, Y, 辺長. Includes area and ground area calculations.

Summary table with columns: 図面の種類, 画地面積求積表, 街区番号, 町名, 京都市洛西第二土地区画整理組合.

122

地番 嵐宮五一ノ一			
N O	X	Y	辺長
1082	-110899.185	-28419.145	
1088	-110903.497	-28420.908	4.658
1085	-110916.081	-28417.057	13.160
1084	-110920.799	-28415.618	4.933
1090	-110911.267	-28398.798	19.333
1089	-110909.369	-28399.885	2.187
1081	-110893.519	-28408.908	18.238
1082	-110899.185	-28419.145	11.700
面積	344.6431740		
地積	344.64 m ²		

123

地番 嵐宮五五ノ一六			
N O	X	Y	辺長
1079	-110889.369	-28401.457	
1080	-110893.362	-28408.624	8.204
1081	-110893.519	-28408.908	0.325
1089	-110909.369	-28399.885	18.238
808	-110905.139	-28392.480	8.528
1079	-110889.369	-28401.457	18.146
面積	155.1422835		
地積	155.14 m ²		

124

地番 嵐宮五五ノ二八			
N O	X	Y	辺長
1078	-110886.385	-28396.101	
1079	-110889.369	-28401.457	6.131
808	-110905.139	-28392.480	18.146
807	-110902.101	-28387.162	6.125
1078	-110886.385	-28396.101	18.080
面積	110.9929290		
地積	110.99 m ²		

125

地番 嵐宮五五ノ一八			
N O	X	Y	辺長
1076	-110884.801	-28387.057	
1077	-110883.559	-28391.028	4.161
1078	-110886.385	-28396.101	5.807
807	-110902.101	-28387.162	18.080
1075	-110898.197	-28380.326	7.872
1076	-110884.801	-28387.057	14.992
面積	145.8352360		
地積	145.83 m ²		

126

地番 嵐宮五五ノ二二			
N O	X	Y	辺長
1089	-110909.369	-28399.885	
1090	-110911.267	-28398.798	2.187
1091	-110913.429	-28397.570	2.486
1073	-110902.358	-28378.200	22.311
1074	-110901.259	-28378.787	1.246
1075	-110898.197	-28380.326	3.427
807	-110902.101	-28387.162	7.872
808	-110905.139	-28392.480	6.125
1089	-110909.369	-28399.885	8.528
面積	104.6475295		
地積	104.64 m ²		

127

地番 嵐宮五二ノ一B			
N O	X	Y	辺長
1091	-110913.429	-28397.570	
1093	-110923.740	-28391.685	11.872
1094	-110921.312	-28387.534	4.809
1095	-110912.630	-28372.715	17.175
1073	-110902.358	-28378.200	11.645
1091	-110913.429	-28397.570	22.311
面積	260.3667725		
地積	260.36 m ²		

128

地番 嵐宮五三ノ三			
N O	X	Y	辺長
1094	-110921.312	-28387.534	
1101	-110931.187	-28381.761	11.439
1146	-110922.927	-28368.166	15.908
1072	-110918.213	-28369.733	4.968
1095	-110912.630	-28372.715	6.329
1094	-110921.312	-28387.534	17.175
面積	189.6649265		
地積	189.66 m ²		

129

地番 嵐宮五三ノ四			
N O	X	Y	辺長
1093	-110923.740	-28391.685	
1100	-110933.748	-28385.985	11.517
1101	-110931.187	-28381.761	4.940
1094	-110921.312	-28387.534	11.439
1093	-110923.740	-28391.685	4.809
面積	55.9397305		
地積	55.93 m ²		

130

地番 嵐宮五五ノ二〇			
N O	X	Y	辺長
1100	-110933.748	-28385.985	
809	-110936.453	-28384.443	3.114
1145	-110926.486	-28366.982	20.105
1146	-110922.927	-28368.166	3.751
1101	-110931.187	-28381.761	15.908
1100	-110933.748	-28385.985	4.940
面積	69.3787795		
地積	69.37 m ²		

131

地番 嵐宮五四ノ一B			
N O	X	Y	辺長
1145	-110926.486	-28366.982	
809	-110936.453	-28384.443	20.105
1147	-110946.094	-28378.947	11.098
1144	-110937.619	-28363.281	17.811
1145	-110926.486	-28366.982	11.732
面積	214.4478430		
地積	214.44 m ²		

132

地番 松河原一〇ノ一			
N O	X	Y	辺長
1104	-110953.337	-28392.305	
1127	-110960.683	-28387.453	8.804
1142	-110954.497	-28375.647	13.328
1141	-110947.453	-28362.173	15.204
1143	-110945.603	-28358.630	3.997
1144	-110937.619	-28363.281	9.240
1147	-110946.094	-28378.947	17.811
1104	-110953.337	-28392.305	15.195
面積	294.8495750		
地積	294.84 m ²		

133

地番 松河原一〇ノ四			
N O	X	Y	辺長
1143	-110945.603	-28358.630	
1141	-110947.453	-28362.173	3.997
811	-110951.651	-28360.063	4.698
810	-110949.658	-28356.261	4.293
1140	-110947.332	-28357.623	2.695
1143	-110945.603	-28358.630	2.001
面積	19.4514625		
地積	19.45 m ²		

134

地番 松河原一〇ノ二			
N O	X	Y	辺長
810	-110949.658	-28356.261	
811	-110951.651	-28360.063	4.293
1141	-110947.453	-28362.173	4.698
1142	-110954.497	-28375.647	15.204
1139	-110961.863	-28372.061	8.193
1136	-110957.354	-28363.420	9.747
1135	-110956.120	-28364.056	1.388
1134	-110951.470	-28355.200	10.003
810	-110949.658	-28356.261	2.100
面積	126.4056335		
地積	126.40 m ²		

135

地番 松河原一〇ノ三			
N O	X	Y	辺長
1127	-110960.683	-28387.453	
1126	-110966.096	-28383.872	6.490
1125	-110969.265	-28381.775	3.800
1138	-110965.251	-28374.130	8.635
1137	-110961.204	-28366.384	8.739
815	-110958.626	-28361.445	5.571
1133	-110954.452	-28353.454	9.015
1134	-110951.470	-28355.200	3.456
1135	-110956.120	-28364.056	10.003
1136	-110957.354	-28363.420	1.388
1139	-110961.863	-28372.061	9.747
1142	-110954.497	-28375.647	8.193
1127	-110960.683	-28387.453	13.328
面積	184.1830045		
地積	184.18 m ²		

136

地番 松河原一一ノ四			
N O	X	Y	辺長
1133	-110954.452	-28353.454	
815	-110958.626	-28361.445	9.015
814	-110965.767	-28357.403	8.206
813	-110960.793	-28351.001	8.107
812	-110959.184	-28350.683	1.640
1133	-110954.452	-28353.454	5.484
面積	66.3473290		
地積	66.34 m ²		

137

地番 松河原一一ノ五			
N O	X	Y	辺長
812	-110959.184	-28350.683	
813	-110960.793	-28351.001	1.640
814	-110965.767	-28357.403	8.107
815	-110958.626	-28361.445	8.206
1137	-110961.204	-28366.384	5.571
1130	-110970.914	-28359.962	11.642
1131	-110964.466	-28347.610	13.934
1132	-110964.091	-28347.810	0.425
812	-110959.184	-28350.683	5.686
面積	98.8841995		
地積	98.88 m ²		

138

地番 松河原一一ノ二			
N O	X	Y	辺長
1130	-110970.914	-28359.962	
1122	-110981.730	-28352.796	12.974
1128	-110977.029	-28344.312	9.699
1129	-110972.934	-28343.083	4.275
1131	-110964.466	-28347.610	9.602
1130	-110970.914	-28359.962	13.934
面積	165.4196135		
地積	165.41 m ²		

139

地番 松河原一一ノ三			
N O	X	Y	辺長
1138	-110965.251	-28374.130	
1121	-110985.956	-28360.423	24.831
1122	-110981.730	-28352.796	8.720
1130	-110970.914	-28359.962	12.974
1137	-110961.204	-28366.384	11.642
1138	-110965.251	-28374.130	8.739
面積	214.8531705		
地積	214.85 m ²		

140

地番 松河原一一ノ一			
N O	X	Y	辺長
1125	-110969.265	-28381.775	
1124	-110972.046	-28379.948	3.327
1119	-110990.139	-28367.969	21.699
1120	-110986.847	-28362.031	6.789
1121	-110985.956	-28360.423	1.838
1138	-110965.251	-28374.130	24.831
1125	-110969.265	-28381.775	8.635
面積	214.4151175		
地積	214.41 m ²		

141

地番 松河原九A			
N O	X	Y	辺長
1123	-110978.474	-28391.568	
1117	-110997.415	-28381.091	21.646
1118	-110996.541	-28379.520	1.798
1119	-110990.139	-28367.969	13.206
1124	-110972.046	-28379.948	21.699
1123	-110978.474	-28391.568	13.279
面積	305.9890470		
地積	305.98 m ²		

142

地番 松河原八ノ一			
N O	X	Y	辺長
1108	-110984.098	-28401.655	
1114	-111002.648	-28396.487	19.256
1115	-111004.068	-28393.048	3.721
1117	-110997.415	-28381.091	13.683
1123	-110978.474	-28391.568	21.646
1108	-110984.098	-28401.655	11.549
面積	301.2395330		
地積	301.23 m ²		

143

地番 松河原九B			
N O	X	Y	辺長
1106	-110977.049	-28403.629	
1107	-110983.288	-28401.881	6.479
1108	-110984.098	-28401.655	0.841
1123	-110978.474	-28391.568	11.549
1124	-110972.046	-28379.948	13.279
1125	-110969.265	-28381.775	3.32

148

地番	松吾田一ノ二, 松吾田一ノ三, 松吾田四一ノ二 松尾東二ノ一		
N O	X	Y	辺長
1113	-110960.593	-28416.854	
1112	-110965.595	-28415.305	5.236
1110	-110965.627	-28413.057	2.248
1111	-110960.160	-28413.825	5.521
1113	-110960.593	-28416.854	3.060
面積	14.0435075		
地積	14.04 m ²		

149

地番	松河原一ノ三, 六ノ一, 六ノ四, 八ノ三 松荒堀一六ノ三, 二四ノ三, 三〇ノ四		
N O	X	Y	辺長
1097	-110939.610	-28422.888	
1098	-110957.420	-28417.837	18.512
1113	-110960.593	-28416.854	3.322
1111	-110960.160	-28413.825	3.060
1096	-110951.361	-28415.062	8.886
1083	-110936.508	-28417.115	14.994
1097	-110939.610	-28422.888	6.554
面積	107.0451990		
地積	107.04 m ²		

図面の種類	画地面積求積表			
街区番号	2B	番号	/	
町名	嵐山宮ノ前町			
京都市洛西第二土地区画整理組合				

51

地番 松河原七ノ一			
NO	X	Y	辺長
1164	-111009.990	-28391.380	
1165	-111014.240	-28393.177	4.614
1166	-111026.701	-28389.458	13.004
1167	-111034.043	-28387.285	7.657
1172	-111028.146	-28376.648	12.162
1160	-111008.017	-28387.827	23.025
1164	-111009.990	-28391.380	4.064
面積	216.9871630		
地積	216.98 m ²		

52

地番 松河原一四B			
NO	X	Y	辺長
1160	-111008.017	-28387.827	
1172	-111028.146	-28376.648	23.025
1173	-111025.852	-28372.530	4.714
1176	-111018.464	-28359.288	15.164
1163	-111014.338	-28351.891	8.470
1162	-111013.662	-28350.686	1.382
1158	-110993.590	-28361.820	22.953
1159	-111001.774	-28376.585	16.881
1160	-111008.017	-28387.827	12.859
面積	683.7375785		
地積	683.73 m ²		

53

地番 松河原一二			
NO	X	Y	辺長
1158	-110993.590	-28361.820	
1162	-111013.662	-28350.686	22.953
1161	-111008.062	-28340.576	11.557
1153	-111001.493	-28328.673	13.595
1154	-110989.085	-28334.967	13.913
1155	-110983.554	-28337.718	6.177
1156	-110982.378	-28341.597	4.053
1157	-110992.079	-28359.094	20.006
1158	-110993.590	-28361.820	3.117
面積	583.4103505		
地積	583.41 m ²		

54

地番 松河原一三ノ一			
NO	X	Y	辺長
1161	-111008.062	-28340.576	
1185	-111028.203	-28329.366	23.050
1186	-111023.489	-28320.874	9.713
1187	-111019.338	-28319.644	4.329
1152	-111003.198	-28327.808	18.087
1153	-111001.493	-28328.673	1.912
1161	-111008.062	-28340.576	13.595
面積	298.2007700		
地積	298.20 m ²		

55

地番 松河原一三ノ三			
NO	X	Y	辺長
1163	-111014.338	-28351.891	
1183	-111034.486	-28340.685	23.055
1184	-111033.435	-28338.789	2.168
1185	-111028.203	-28329.366	10.778
1161	-111008.062	-28340.576	23.050
1162	-111013.662	-28350.686	11.557
1163	-111014.338	-28351.891	1.382
面積	298.4072720		
地積	298.40 m ²		

56

地番 松河原一三ノ四			
NO	X	Y	辺長
1176	-111018.464	-28359.288	
1182	-111038.591	-28348.089	23.033
1183	-111034.486	-28340.685	8.466
1163	-111014.338	-28351.891	23.055
1176	-111018.464	-28359.288	8.470
面積	195.1314575		
地積	195.13 m ²		

57

地番 松河原一四A			
NO	X	Y	辺長
1173	-111025.852	-28372.530	
1174	-111035.834	-28366.985	11.419
1180	-111045.958	-28361.366	11.579
1181	-111043.138	-28356.292	5.805
1182	-111038.591	-28348.089	8.379
1176	-111018.464	-28359.288	23.033
1173	-111025.852	-28372.530	15.164
面積	349.1713960		
地積	349.17 m ²		

58

地番 松河原七ノ五			
NO	X	Y	辺長
1169	-111044.567	-28382.703	
1178	-111052.039	-28378.353	8.646
1179	-111053.402	-28374.760	3.843
1180	-111045.958	-28361.366	15.324
1174	-111035.834	-28366.985	11.579
1169	-111044.567	-28382.703	17.981
面積	203.2906435		
地積	203.29 m ²		


59

地番 松河原七ノ四			
NO	X	Y	辺長
1167	-111034.043	-28387.285	
1168	-111039.442	-28385.687	5.631
1169	-111044.567	-28382.703	5.930
1174	-111035.834	-28366.985	17.981
1173	-111025.852	-28372.530	11.419
1172	-111028.146	-28376.648	4.714
1167	-111034.043	-28387.285	12.162
面積	202.9688885		
地積	202.96 m ²		

図面の種類	画地面積求積表			
街区番号	3	番号	/	
町名	松室河原町			
京都市洛西第二土地区画整理組合				



S = 1 : 250

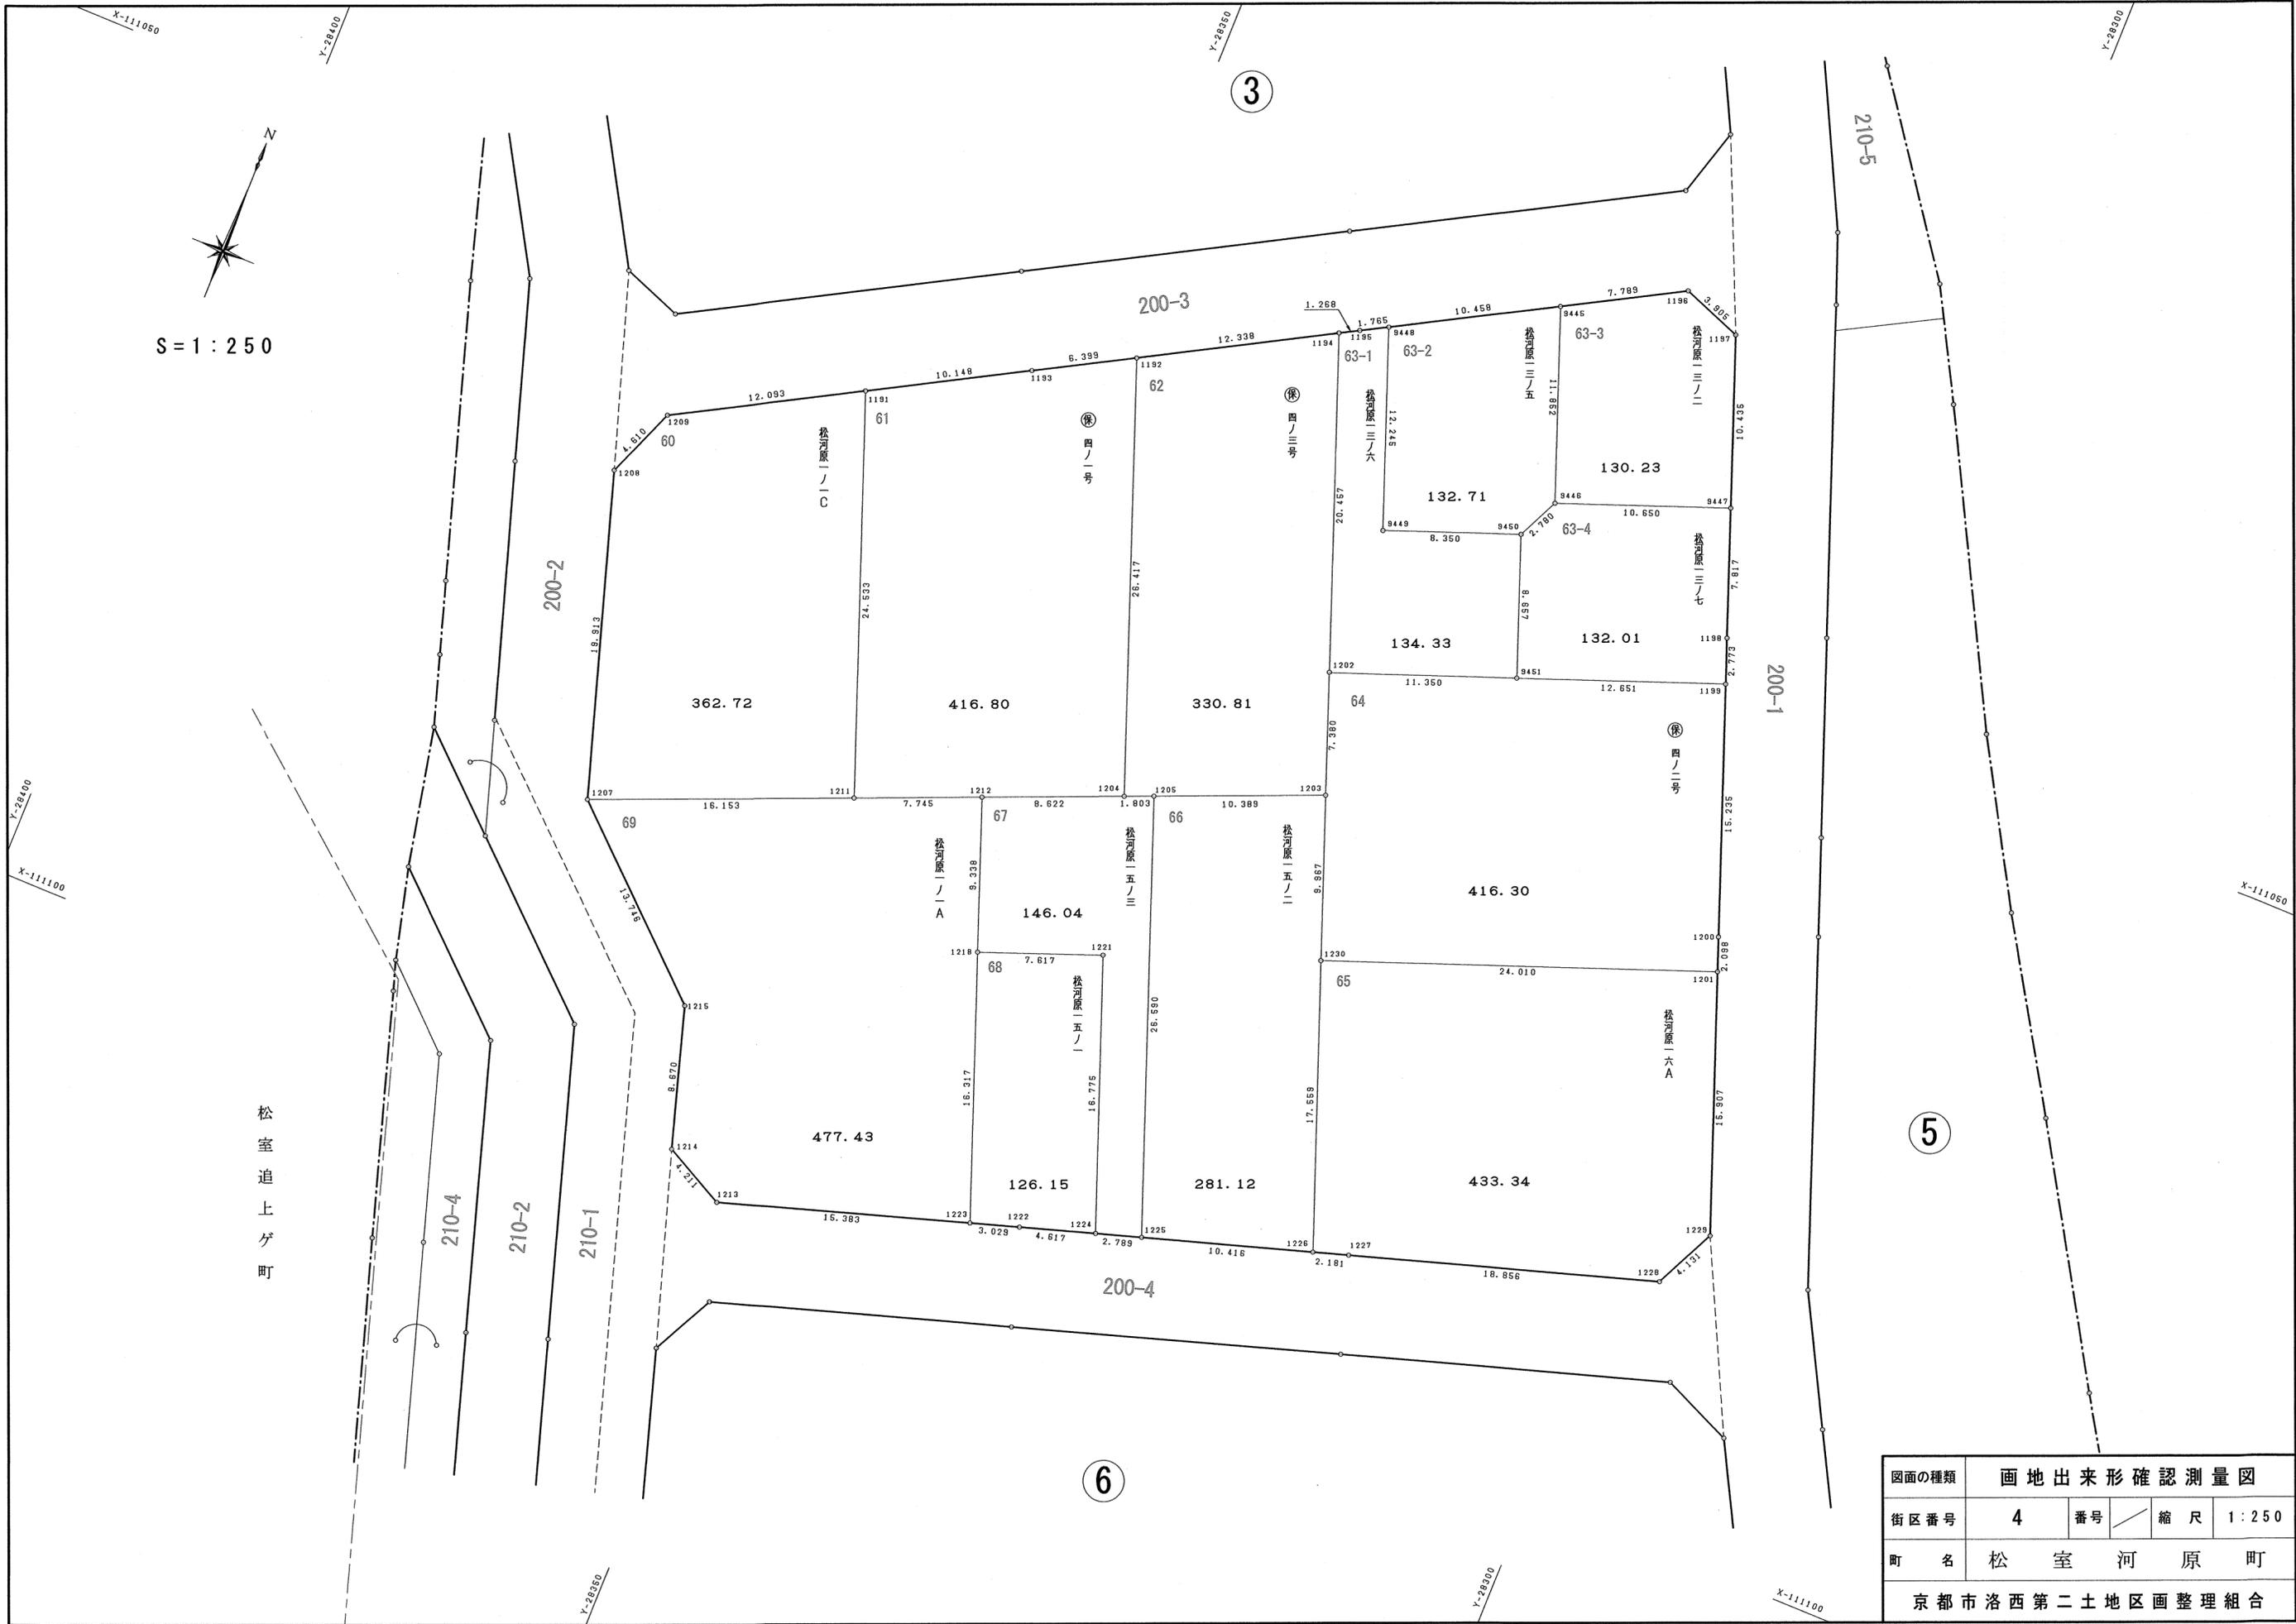

図面の種類	画地出来形確認測量図		
街区番号	4	番号	縮尺 1:250
町名	松室河原町		
京都市洛西第二土地区画整理組合			

60

地番 松河原一ノ一C			
NO	X	Y	辺長
1209	-111059.232	-28372.911	
1208	-111063.505	-28374.642	4.610
1207	-111082.498	-28368.659	19.913
1211	-111076.334	-28353.728	16.153
1191	-111053.362	-28362.338	24.533
1209	-111059.232	-28372.911	12.093
面積	362.7299360		
地積	362.72 m ²		

61

地番 保四ノ一号			
NO	X	Y	辺長
1191	-111053.362	-28362.338	
1211	-111076.334	-28353.728	24.533
1212	-111073.368	-28346.573	7.745
1204	-111070.071	-28338.606	8.622
1192	-111045.332	-28347.870	26.417
1193	-111048.436	-28353.466	6.399
1191	-111053.362	-28362.338	10.148
面積	416.8039535		
地積	416.80 m ²		

62

地番 保四ノ三号			
NO	X	Y	辺長
1192	-111045.332	-28347.870	
1204	-111070.071	-28338.606	26.417
1205	-111069.385	-28336.939	1.803
1203	-111065.423	-28327.335	10.389
1202	-111058.509	-28329.917	7.380
1194	-111039.347	-28337.081	20.457
1192	-111045.332	-28347.870	12.338
面積	330.8140185		
地積	330.81 m ²		

63-1

地番 松河原一三ノ六			
NO	X	Y	辺長
1194	-111039.347	-28337.081	
1202	-111058.509	-28329.917	20.457
9451	-111054.524	-28319.290	11.350
9450	-111046.415	-28322.321	8.657
9449	-111049.346	-28330.140	8.350
9448	-111037.876	-28334.428	12.245
1195	-111038.732	-28335.972	1.765
1194	-111039.347	-28337.081	1.268
面積	134.3302040		
地積	134.33 m ²		

63-2

地番 松河原一三ノ五			
NO	X	Y	辺長
9445	-111032.803	-28325.283	
9448	-111037.876	-28334.428	10.458
9449	-111049.346	-28330.140	12.245
9450	-111046.415	-28322.321	8.350
9446	-111043.903	-28321.129	2.780
9445	-111032.803	-28325.283	11.852
面積	132.7130360		
地積	132.71 m ²		

63-3

地番 松河原一三ノ二			
NO	X	Y	辺長
9445	-111032.803	-28325.283	
9446	-111043.903	-28321.129	11.852
9447	-111040.164	-28311.157	10.650
1197	-111030.391	-28314.814	10.435
1196	-111029.025	-28318.472	3.905
9445	-111032.803	-28325.283	7.789
面積	130.2394885		
地積	130.23 m ²		

63-4

地番 松河原一三ノ七			
NO	X	Y	辺長
9447	-111040.164	-28311.157	
9446	-111043.903	-28321.129	10.650
9450	-111046.415	-28322.321	2.780
9451	-111054.524	-28319.290	8.657
1199	-111050.082	-28307.445	12.651
1198	-111047.485	-28308.418	2.773
9447	-111040.164	-28311.157	7.817
面積	132.0128485		
地積	132.01 m ²		

64

地番 保四ノ二号			
NO	X	Y	辺長
1202	-111058.509	-28329.917	
1203	-111065.423	-28327.335	7.380
1230	-111074.756	-28323.838	9.967
1201	-111066.313	-28301.361	24.010
1200	-111064.348	-28302.097	2.098
1199	-111050.082	-28307.445	15.235
9451	-111054.524	-28319.290	12.651
1202	-111058.509	-28329.917	11.350
面積	416.3042015		
地積	416.30 m ²		

65

地番 松河原一六A			
NO	X	Y	辺長
1230	-111074.756	-28323.838	
1226	-111091.195	-28317.668	17.559
1227	-111090.547	-28315.585	2.181
1228	-111084.924	-28297.587	18.856
1229	-111081.209	-28295.780	4.131
1201	-111066.313	-28301.361	15.907
1230	-111074.756	-28323.838	24.010
面積	433.3437250		
地積	433.34 m ²		

66

地番 松河原一五ノ二			
NO	X	Y	辺長
1205	-111069.385	-28336.939	
1225	-111094.287	-28327.615	26.590
1226	-111091.195	-28317.668	10.416
1230	-111074.756	-28323.838	17.559
1203	-111065.423	-28327.335	9.967
1205	-111069.385	-28336.939	10.389
面積	281.1237585		
地積	281.12 m ²		

67

地番 松河原一五ノ三			
NO	X	Y	辺長
1212	-111073.368	-28346.573	
1218	-111082.114	-28343.302	9.338
1221	-111079.413	-28336.180	7.617
1224	-111095.115	-28330.278	16.775
1225	-111094.287	-28327.615	2.789
1205	-111069.385	-28336.939	26.590
1204	-111070.071	-28338.606	1.803
1212	-111073.368	-28346.573	8.622
面積	146.0446525		
地積	146.04 m ²		


68

地番 松河原一五ノ一			
NO	X	Y	辺長
1218	-111082.114	-28343.302	
1223	-111097.394	-28337.577	16.317
1222	-111096.486	-28334.687	3.029
1224	-111095.115	-28330.278	4.617
1221	-111079.413	-28336.180	16.775
1218	-111082.114	-28343.302	7.617
面積	126.1528785		
地積	126.15 m ²		

69

地番 松河原一ノ一A			
NO	X	Y	辺長
1207	-111082.498	-28368.659	
1215	-111091.774	-28358.515	13.746
1214	-111100.068	-28355.990	8.670
1213	-111102.006	-28352.252	4.211
1223	-111097.394	-28337.577	15.383
1218	-111082.114	-28343.302	16.317
1212	-111073.368	-28346.573	9.338
1211	-111076.334	-28353.728	7.745
1207	-111082.498	-28368.659	16.153
面積	477.4302530		
地積	477.43 m ²		

図面の種類	画 地 面 積 求 積 表			
街区番号	4	番号	/	
町 名	松 室 河 原 町			
京都市洛西第二土地区画整理組合				

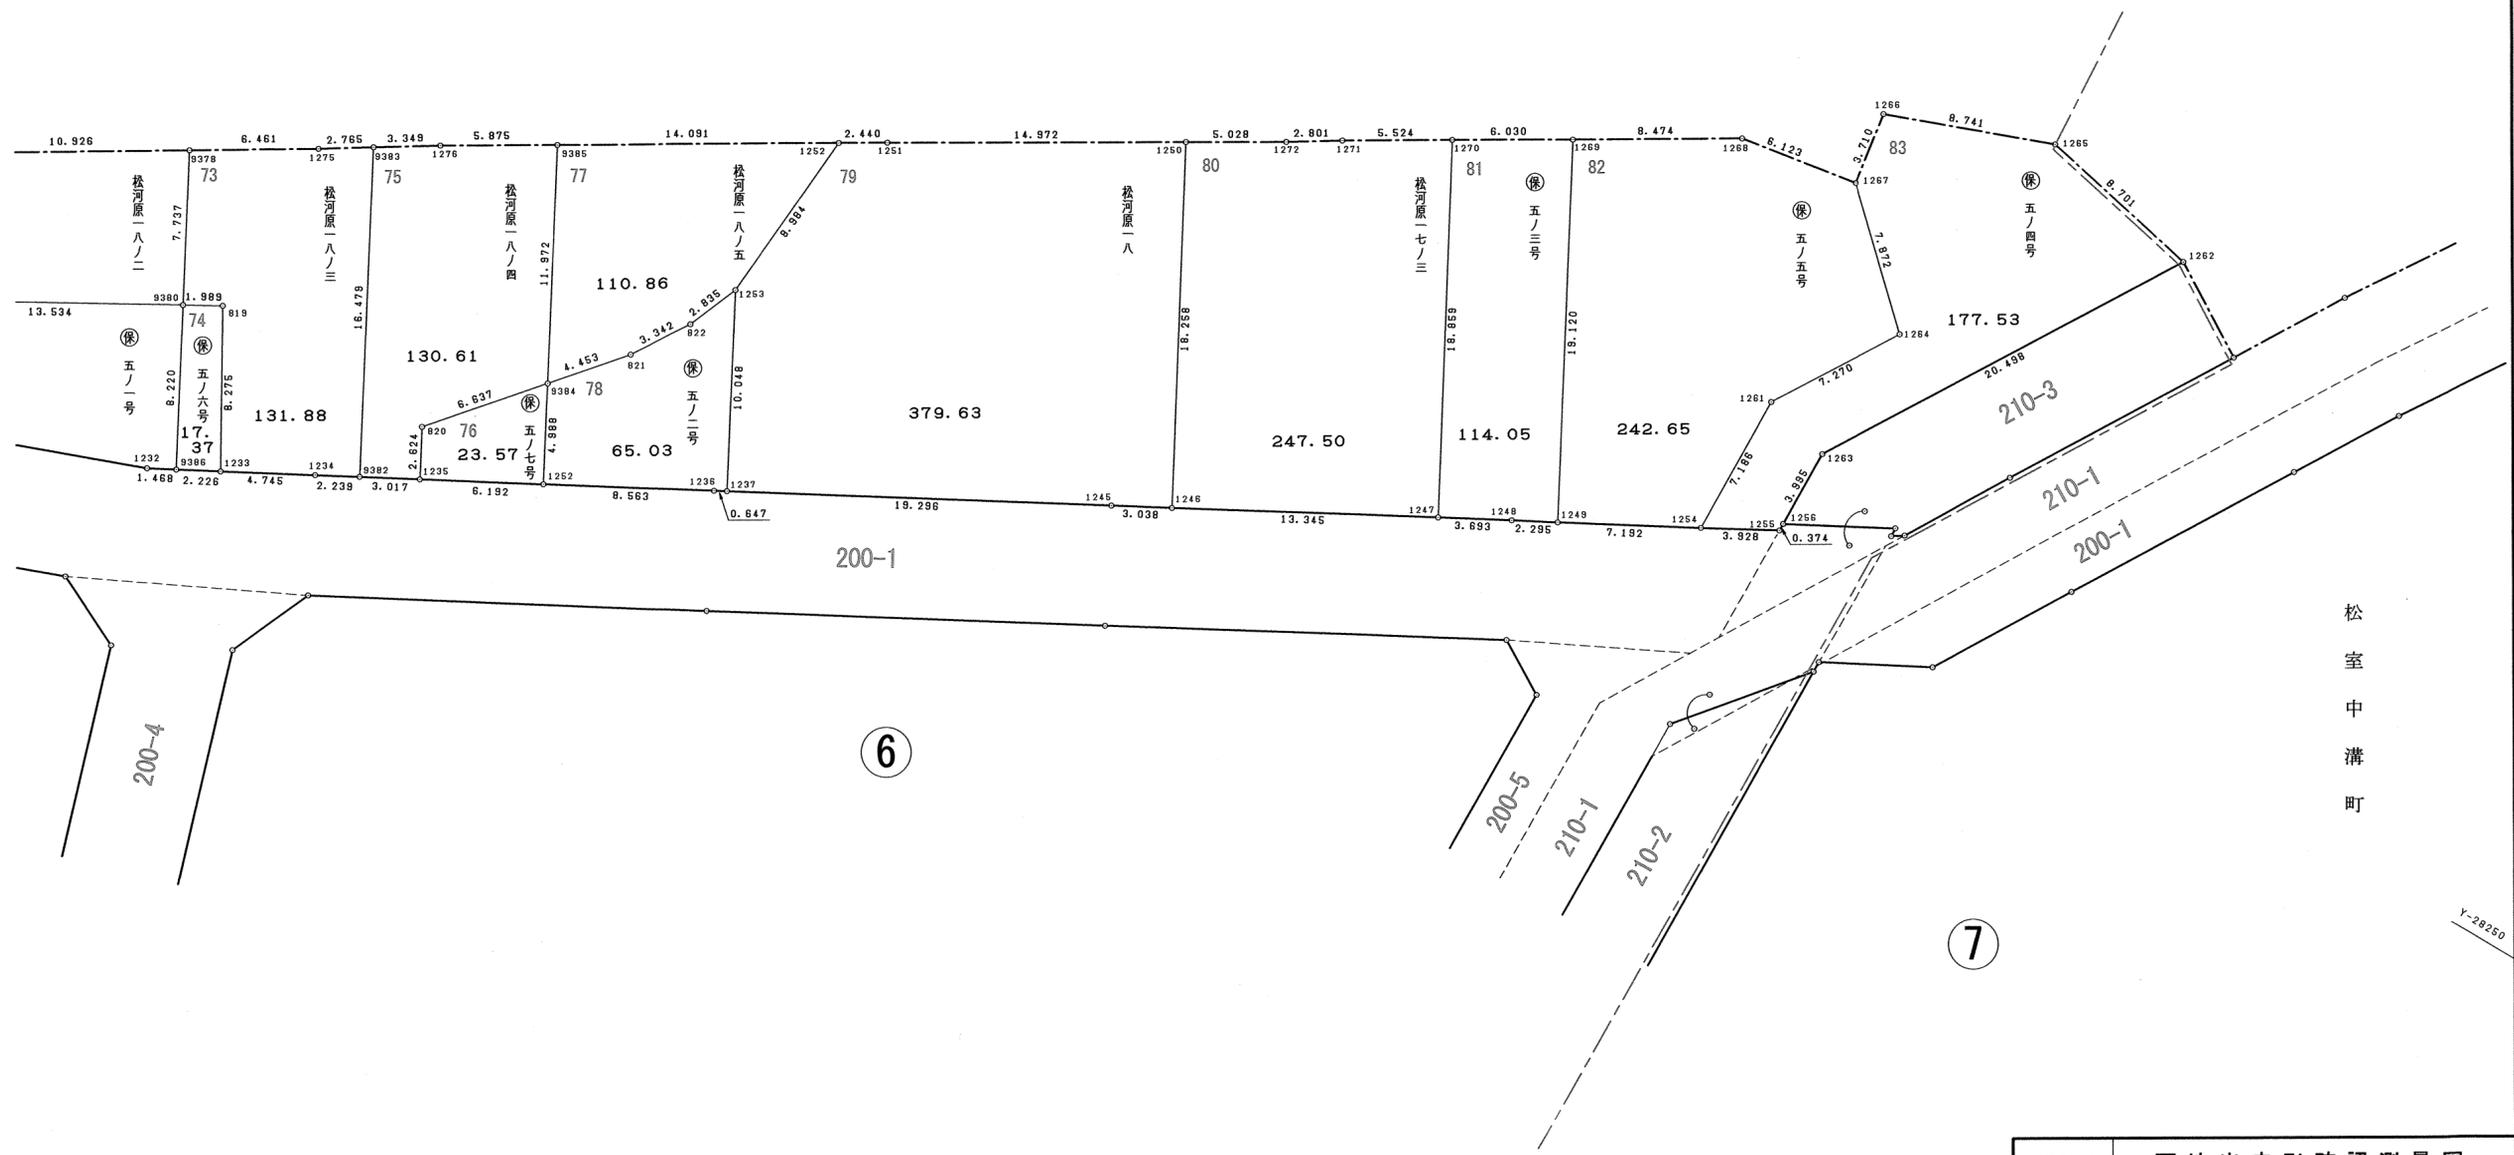

図面の種類	画地出来形確認測量図		
街区番号	5 2/2	番号	縮尺 1:250
町名	松室河原町		
京都市洛西第二土地区画整理組合			

Y-28250 X-111050
 X-11100
 Y-28300
 X-11100
 Y-28250
 X-11100
 Y-28300 X-11100

70			
地番	松河原一七ノ二		
NO	X	Y	辺長
1239	-111027.873	-28309.299	
1241	-111042.410	-28303.854	15.523
816	-111041.589	-28302.378	1.689
9381	-111049.145	-28298.161	8.653
1238	-111046.918	-28291.665	6.867
1244	-111029.293	-28300.999	19.944
1278	-111024.721	-28303.504	5.213
1239	-111027.873	-28309.299	6.597
面積	180.9416055		
地積	180.94 m ²		

71-1			
地番	保五ノ八号		
NO	X	Y	辺長
1241	-111042.410	-28303.854	
1240	-111045.199	-28302.810	2.978
5280	-111051.584	-28300.415	6.819
5279	-111050.098	-28297.629	3.158
9381	-111049.145	-28298.161	1.091
816	-111041.589	-28302.378	8.653
1241	-111042.410	-28303.854	1.689
面積	23.5700275		
地積	23.57 m ²		

71-2			
地番	保五ノ九号		
NO	X	Y	辺長
5279	-111050.098	-28297.629	
5280	-111051.584	-28300.415	3.158
1242	-111056.460	-28298.587	5.207
1243	-111062.064	-28296.486	5.985
7329	-111063.013	-28296.132	1.013
7330	-111060.664	-28291.726	4.993
817	-111056.242	-28294.201	5.068
5279	-111050.098	-28297.629	7.036
面積	49.2797770		
地積	49.27 m ²		

71-3			
地番	保五ノ一号		
NO	X	Y	辺長
7330	-111060.664	-28291.726	
7329	-111063.013	-28296.132	4.993
1232	-111081.994	-28289.056	20.257
9386	-111083.288	-28288.362	1.468
9380	-111079.420	-28281.109	8.220
818	-111067.661	-28287.810	13.534
7330	-111060.664	-28291.726	8.018
面積	143.9325105		
地積	143.93 m ²		

72-1			
地番	松河原一八ノ六		
NO	X	Y	辺長
1238	-111046.918	-28291.665	
9381	-111049.145	-28298.161	6.867
5279	-111050.098	-28297.629	1.091
1238	-111046.918	-28291.665	6.759
面積	3.6877260		
地積	3.68 m ²		

72-2			
地番	松河原一八ノ二		
NO	X	Y	辺長
7331	-111057.372	-28285.554	
7330	-111060.664	-28291.726	6.995
818	-111067.661	-28287.810	8.018
9380	-111079.420	-28281.109	13.534
9378	-111075.780	-28274.282	7.737
1274	-111066.973	-28279.616	10.296
7331	-111057.372	-28285.554	11.289
面積	159.6687885		
地積	159.66 m ²		

72-3			
地番	松河原一八ノ七		
NO	X	Y	辺長
1238	-111046.918	-28291.665	
5279	-111050.098	-28297.629	6.759
817	-111056.242	-28294.201	7.036
7330	-111060.664	-28291.726	5.068
7331	-111057.372	-28285.554	6.995
1273	-111056.310	-28286.211	1.249
1238	-111046.918	-28291.665	10.861
面積	83.0480260		
地積	83.04 m ²		

73			
地番	松河原一八ノ三		
NO	X	Y	辺長
9378	-111075.780	-28274.282	
9380	-111079.420	-28281.109	7.737
819	-111081.148	-28280.124	1.989
1233	-111085.250	-28287.311	8.275
1234	-111089.433	-28285.070	4.745
9382	-111091.406	-28284.011	2.239
9383	-111083.652	-28269.470	16.479
1275	-111081.307	-28270.935	2.765
9378	-111075.780	-28274.282	6.461
面積	131.8815060		
地積	131.88 m ²		

74			
地番	保五ノ六号		
NO	X	Y	辺長
9380	-111079.420	-28281.109	
9386	-111083.288	-28288.362	8.220
1233	-111085.250	-28287.311	2.226
819	-111081.148	-28280.124	8.275
9380	-111079.420	-28281.109	1.989
面積	17.3776300		
地積	17.37 m ²		

75			
地番	松河原一八ノ四		
NO	X	Y	辺長
9383	-111083.652	-28269.470	
9382	-111091.406	-28284.011	16.479
1235	-111094.064	-28282.583	3.017
820	-111092.827	-28280.269	2.624
9384	-111097.173	-28275.253	6.637
9385	-111091.540	-28264.689	11.972
1276	-111086.493	-28267.696	5.875
9383	-111083.652	-28269.470	3.349
面積	130.6101135		
地積	130.61 m ²		

76			
地番	保五ノ七号		
NO	X	Y	辺長
1235	-111094.064	-28282.583	
9387	-111099.520	-28279.654	6.192
9384	-111097.173	-28275.253	4.988
820	-111092.827	-28280.269	6.637
1235	-111094.064	-28282.583	2.624
面積	23.5738275		
地積	23.57 m ²		

77			
地番	松河原一八ノ五		
NO	X	Y	辺長
9385	-111091.540	-28264.689	
9384	-111097.173	-28275.253	11.972
821	-111100.089	-28271.888	4.453
822	-111101.902	-28269.081	3.342
1253	-111102.906	-28266.430	2.835
1252	-111103.646	-28257.477	8.984
9385	-111091.540	-28264.689	14.091
面積	110.8679335		
地積	110.86 m ²		

78			
地番	保五ノ二号		
NO	X	Y	辺長
9387	-111099.520	-28279.654	
1236	-111107.064	-28275.603	8.563
1237	-111107.634	-28275.296	0.647
1253	-111102.906	-28266.430	10.048
822	-111101.902	-28269.081	2.835
821	-111100.089	-28271.888	3.342
9384	-111097.173	-28275.253	4.453
9387	-111099.520	-28279.654	4.988
面積	65.0322210		
地積	65.03 m ²		

79			
地番	松河原一八		
NO	X	Y	辺長
1252	-111103.646	-28257.477	
1253	-111102.906	-28266.430	8.984
1237	-111107.634	-28275.296	10.048
1245	-111124.624	-28266.148	19.296
1246	-111127.298	-28264.706	3.038
1250	-111118.643	-28248.630	18.258
1251	-111105.746	-28256.235	14.972
1252	-111103.646	-28257.477	2.440
面積	379.6321595		
地積	379.63 m ²		

80			
地番	松河原一七ノ三		
NO	X	Y	辺長
1250	-111118.643	-28248.630	
1246	-111127.298	-28264.706	18.258
1247	-111139.043	-28258.371	13.345
1270	-111130.098	-28241.768	18.859
1271	-111125.354	-28244.599	5.524
1272	-111122.974	-28246.076	2.801
1250	-111118.643	-28248.630	5.028
面積	247.5079280		
地積	247.50 m ²		

81			
地番	保五ノ三号		
NO	X	Y	辺長
1270	-111130.098	-28241.768	
1247	-111139.043	-28258.371	18.859
1248	-111142.293	-28256.618	3.693
1249	-111144.313	-28255.528	2.295
1269	-111135.276	-28238.678	19.120
1270	-111130.098	-28241.768	6.030
面積	114.0517575		
地積	114.05 m ²		

82			
地番	保五ノ五号		
NO	X	Y	辺長
1269	-111135.276	-28238.678	
1249	-111144.313	-28255.528	19.120
1254	-111150.642	-28252.113	7.192
1261	-111150.491	-28244.929	7.186
1264	-111154.331	-28238.756	7.270
1267	-111148.598	-28233.362	7.872
1268	-111142.553	-28234.335	6.123
1269	-111135.276	-28238.678	8.474
面積	242.6500545		
地積	242.65 m ²		

83			
地番	保五ノ四号		
NO	X	Y	辺長
1267	-111148.598	-28233.362	
1264	-111154.331	-28238.756	7.872
1261	-111150.491	-28244.929	7.270
1254	-111150.642	-28252.113	7.186
1255	-111154.099	-28250.247	3.928
1256	-111154.097	-28249.873	0.374
1263	-111154.011	-28245.879	3.995
1262	-111164.758	-28228.424	20.498
1265	-111156.245	-28226.625	8.701
1266	-111148.059	-28229.691	8.741
1267	-111148.598	-28233.362	3.710
面積	177.5320195		
地積	177.53 m ²		

図面の種類	画地面積求積表		
街区番号	5	番号	/
町名	松室河原町		
京都市洛西第二土地区画整理組合			

S = 1 : 250



松室追上ゲ町

4


200-4

5

松室中溝町

7

図面の種類	画地出来形確認測量図			
街区番号	6	番号	縮尺	1 : 250
町名	松室河原町			
京都市洛西第二土地区画整理組合				

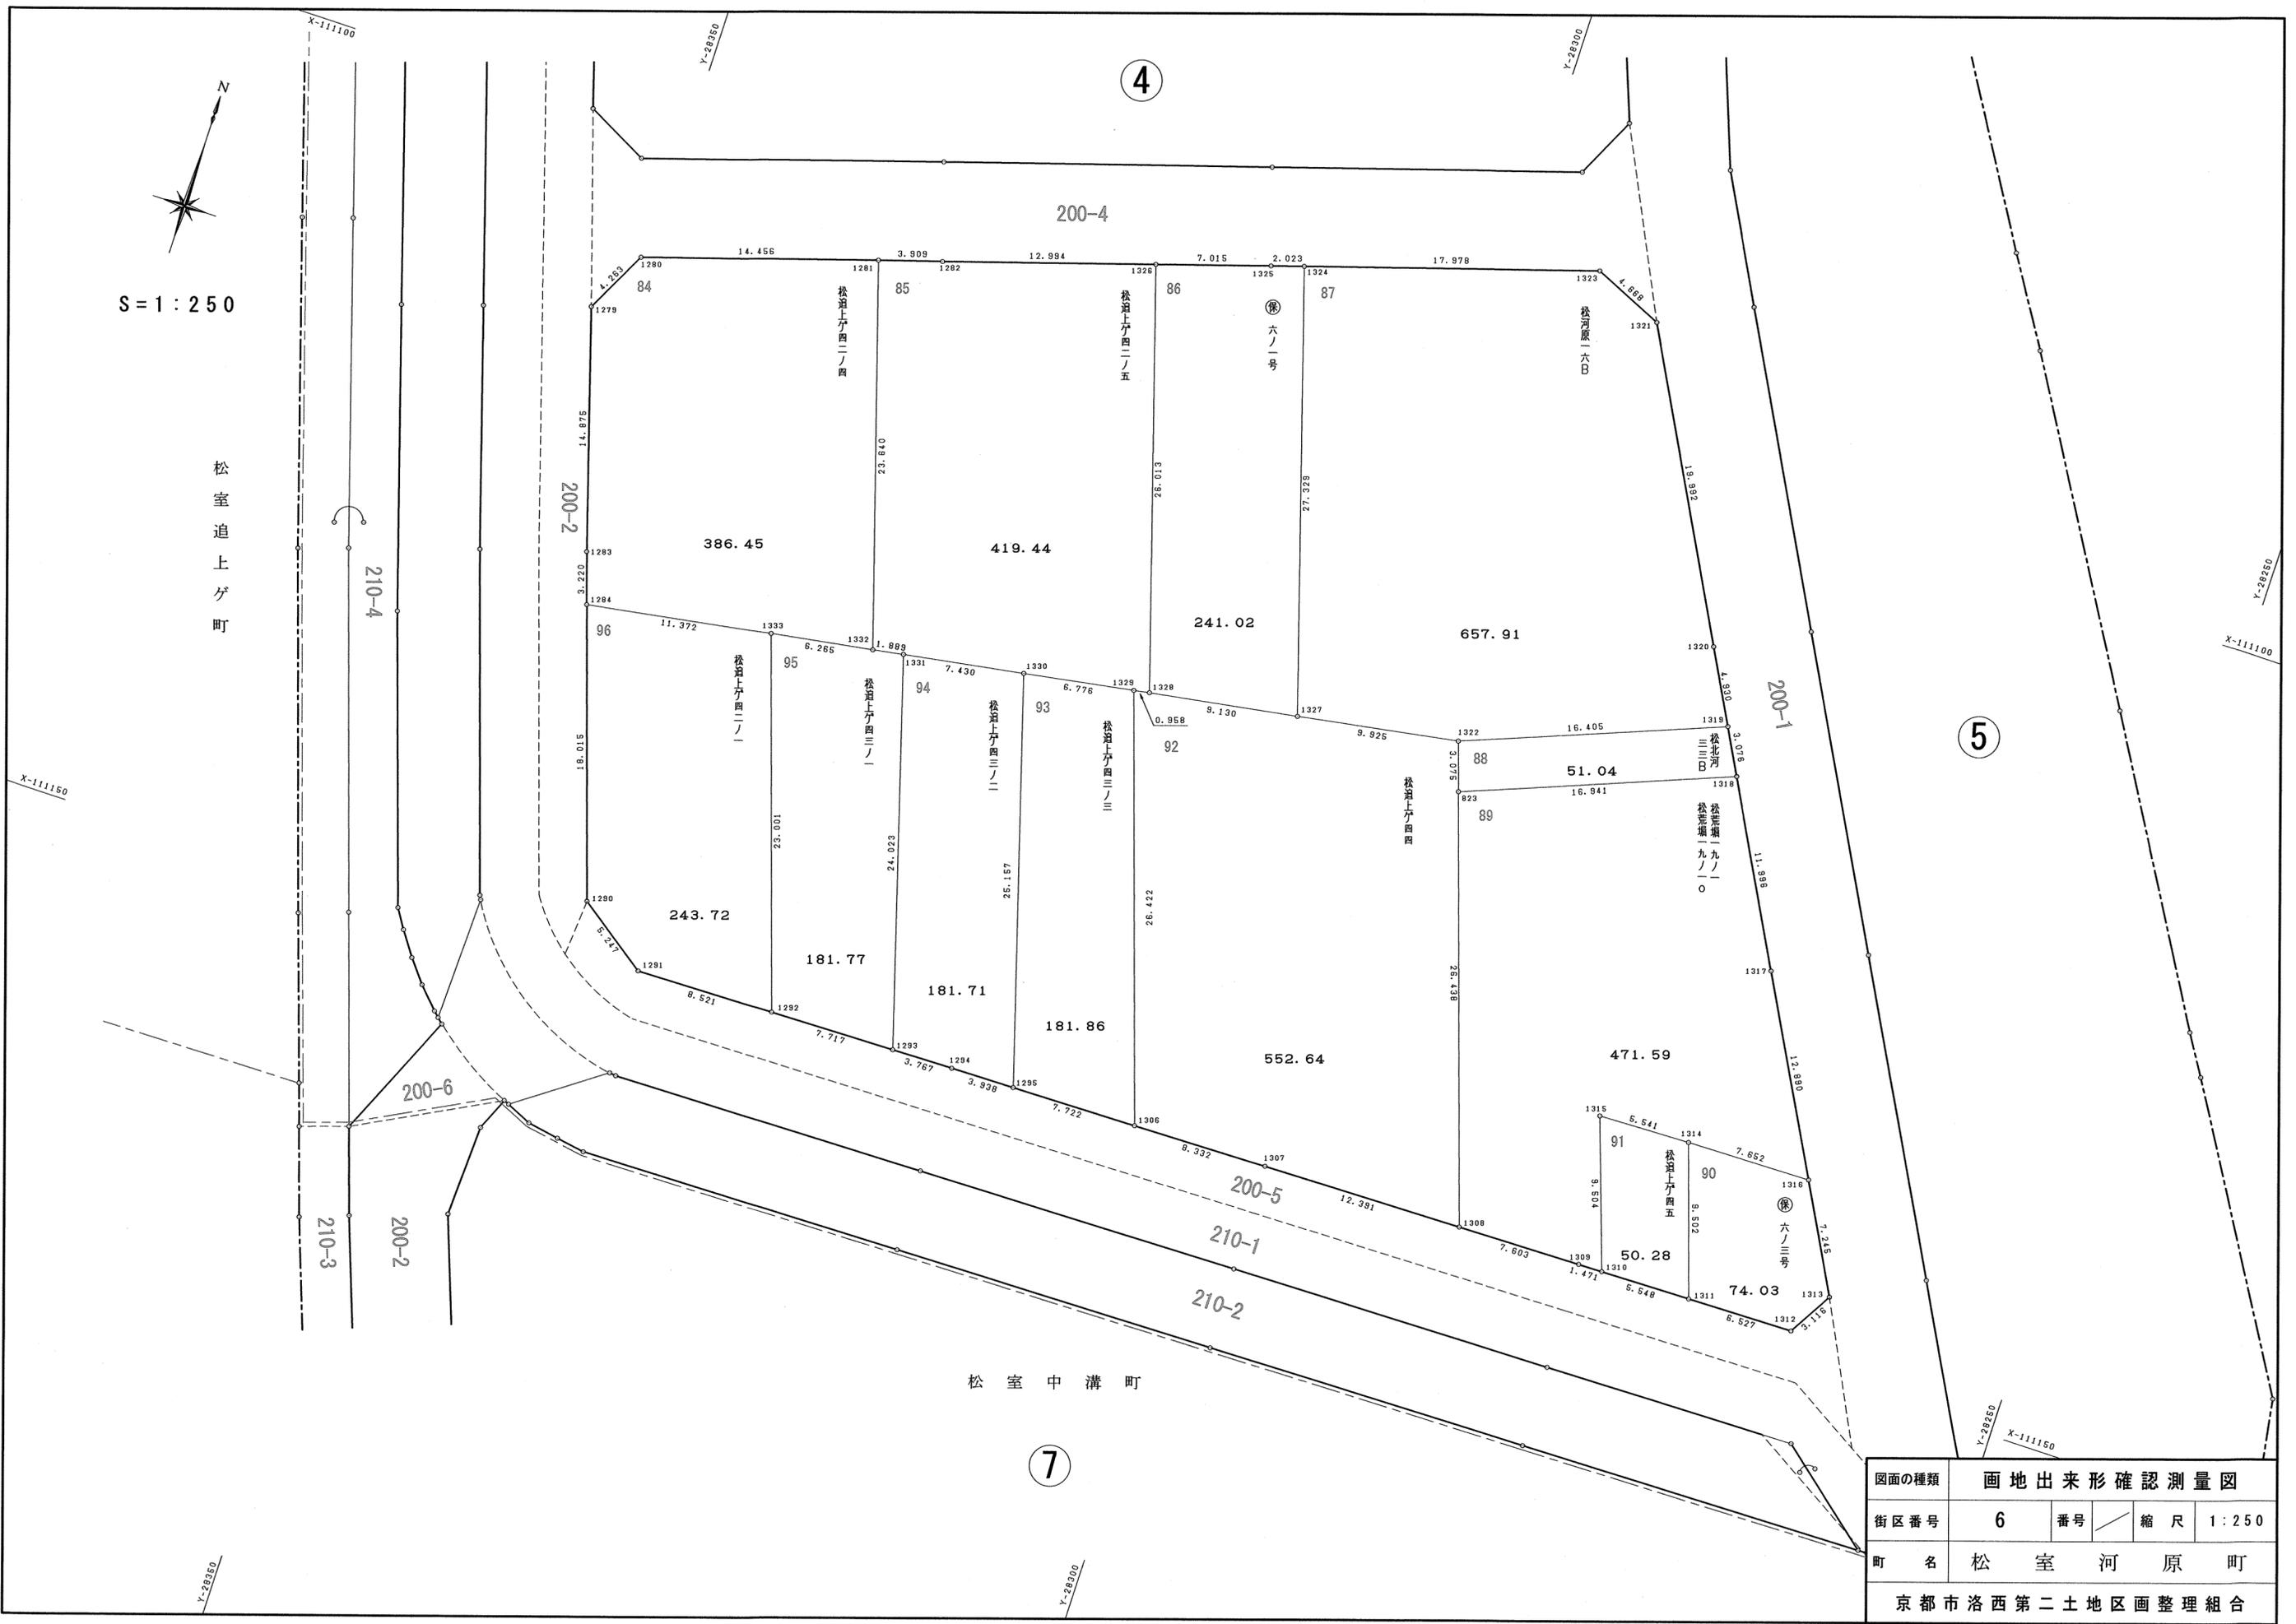

84

地番 松追上ゲ四二ノ四			
N O	X	Y	辺長
1280	-111107.720	-28350.404	
1279	-111111.517	-28352.341	4.263
1283	-111125.732	-28347.958	14.875
1284	-111128.790	-28346.949	3.220
1333	-111126.954	-28335.726	11.372
1332	-111125.965	-28329.540	6.265
1281	-111103.406	-28336.607	23.640
1280	-111107.720	-28350.404	14.456
面積	386.4572815		
地積	386.45 m ²		

85

地番 松追上ゲ四二ノ五			
N O	X	Y	辺長
1281	-111103.406	-28336.607	
1332	-111125.965	-28329.540	23.640
1331	-111125.647	-28327.678	1.889
1330	-111124.452	-28320.345	7.430
1329	-111123.339	-28313.661	6.776
1328	-111123.181	-28312.716	0.958
1326	-111098.353	-28320.477	26.013
1282	-111102.240	-28332.876	12.994
1281	-111103.406	-28336.607	3.909
面積	419.4478025		
地積	419.44 m ²		

86

地番 保六ノ一号			
N O	X	Y	辺長
1326	-111098.353	-28320.477	
1328	-111123.181	-28312.716	26.013
1327	-111121.736	-28303.701	9.130
1324	-111095.651	-28311.852	27.329
1325	-111096.255	-28313.783	2.023
1326	-111098.353	-28320.477	7.015
面積	241.0271270		
地積	241.02 m ²		

87

地番 松河原一六B			
N O	X	Y	辺長
1324	-111095.651	-28311.852	
1327	-111121.736	-28303.701	27.329
1322	-111120.091	-28293.913	9.925
1319	-111114.126	-28278.631	16.405
1320	-111109.786	-28280.970	4.930
1321	-111092.170	-28290.422	19.992
1323	-111090.287	-28294.693	4.668
1324	-111095.651	-28311.852	17.978
面積	657.9130190		
地積	657.91 m ²		

88

地番 松北河三三B			
N O	X	Y	辺長
1322	-111120.091	-28293.913	
823	-111123.010	-28292.947	3.075
1318	-111116.834	-28277.172	16.941
1319	-111114.126	-28278.631	3.076
1322	-111120.091	-28293.913	16.405
面積	51.0499160		
地積	51.04 m ²		

89

地番 松荒堀一九ノ一, 松荒堀一九ノ一〇			
N O	X	Y	辺長
823	-111123.010	-28292.947	
1308	-111148.111	-28284.646	26.438
1309	-111147.994	-28277.044	7.603
1310	-111147.971	-28275.573	1.471
1315	-111138.943	-28278.542	9.504
1314	-111138.861	-28273.002	5.541
1316	-111138.733	-28265.351	7.652
1317	-111127.394	-28271.481	12.890
1318	-111116.834	-28277.172	11.996
823	-111123.010	-28292.947	16.941
面積	471.5945880		
地積	471.59 m ²		

90

地番 保六ノ三号			
N O	X	Y	辺長
1314	-111138.861	-28273.002	
1311	-111147.885	-28270.026	9.502
1312	-111147.783	-28263.500	6.527
1313	-111145.106	-28261.905	3.116
1316	-111138.733	-28265.351	7.245
1314	-111138.861	-28273.002	7.652
面積	74.0312655		
地積	74.03 m ²		

91

地番 松追上ゲ四五			
N O	X	Y	辺長
1315	-111138.943	-28278.542	
1310	-111147.971	-28275.573	9.504
1311	-111147.885	-28270.026	5.548
1314	-111138.861	-28273.002	9.502
1315	-111138.943	-28278.542	5.541
面積	50.2853210		
地積	50.28 m ²		

92

地番 松追上ゲ四四			
N O	X	Y	辺長
1329	-111123.339	-28313.661	
1306	-111148.425	-28305.367	26.422
1307	-111148.302	-28297.036	8.332
1308	-111148.111	-28284.646	12.391
823	-111123.010	-28292.947	26.438
1322	-111120.091	-28293.913	3.075
1327	-111121.736	-28303.701	9.925
1328	-111123.181	-28312.716	9.130
1329	-111123.339	-28313.661	0.958
面積	552.6492525		
地積	552.64 m ²		

93

地番 松追上ゲ四三ノ三			
N O	X	Y	辺長
1330	-111124.452	-28320.345	
1295	-111148.540	-28313.088	25.157
1306	-111148.425	-28305.367	7.722
1329	-111123.339	-28313.661	26.422
1330	-111124.452	-28320.345	6.776
面積	181.8620245		
地積	181.86 m ²		

94

地番 松追上ゲ四三ノ二			
N O	X	Y	辺長
1331	-111125.647	-28327.678	
1293	-111148.662	-28320.792	24.023
1294	-111148.598	-28317.026	3.767
1295	-111148.540	-28313.088	3.938
1330	-111124.452	-28320.345	25.157
1331	-111125.647	-28327.678	7.430
面積	181.7117335		
地積	181.71 m ²		

95

地番 松追上ゲ四三ノ一			
N O	X	Y	辺長
1333	-111126.954	-28335.726	
1292	-111148.793	-28328.508	23.001
1293	-111148.662	-28320.792	7.717
1331	-111125.647	-28327.678	24.023
1332	-111125.965	-28329.540	1.889
1333	-111126.954	-28335.726	6.265
面積	181.7771870		
地積	181.77 m ²		


96

地番 松追上ゲ四二ノ一			
N O	X	Y	辺長
1284	-111128.790	-28346.949	
1290	-111145.898	-28341.304	18.015
1291	-111148.938	-28337.028	5.247
1292	-111148.793	-28328.508	8.521
1333	-111126.954	-28335.726	23.001
1284	-111128.790	-28346.949	11.372
面積	243.7219290		
地積	243.72 m ²		

図面の種類	画地面積求積表			
街区番号	6	番号	/	
町名	松室河原町			
京都市洛西第二土地区画整理組合				

地番	松中溝一ノ二, 四, 五ノ一, 六ノ一, 七ノ一, 八, 八ノ一 九, 一〇, 一一, 一二ノ一, 一二, 一三, 一四, 一四ノ一 一五, 一六ノ一, 一七ノ一, 一八ノ一, 一八ノ二, 一九ノ一 二〇ノ一, 二一ノ一, 二二, 二三ノ一, 二四ノ一, 二五ノ一 二五ノ二, 二五ノ三, 二五ノ四, 二六ノ九, 四九ノ一 四九ノ二, 四九ノ三			
	N O	X	Y	辺長
1355	-111160.991	-28343.171		
1356	-111166.592	-28343.415		5.606
1357	-111184.501	-28336.896		19.059
1365	-111203.261	-28330.114		19.948
1367	-111221.788	-28323.028		19.836
1369	-111239.969	-28315.354		19.734
1370	-111255.505	-28308.625		16.931
1374	-111269.050	-28302.761		14.760
1375	-111271.714	-28298.746		4.818
1382	-111270.764	-28279.120		19.649
1383	-111269.885	-28259.139		20.000
1384	-111268.960	-28239.162		19.998
1387	-111268.059	-28219.189		19.993
1388	-111267.160	-28199.204		20.005
1389	-111266.242	-28179.225		20.000
1390	-111265.328	-28159.243		20.003
1391	-111264.422	-28139.267		19.997
1392	-111263.356	-28115.290		24.001
1393	-111262.784	-28102.708		12.595
1394	-111259.369	-28099.796		4.488
1400	-111244.248	-28101.765		15.249
1399	-111232.219	-28103.310		12.128
1398	-111228.290	-28106.915		5.332
1396	-111223.659	-28128.722		22.293
1395	-111219.139	-28150.249		21.996
1409	-111214.552	-28171.765		22.000
1410	-111212.315	-28180.385		8.906
1411	-111209.857	-28186.299		6.404
1412	-111206.790	-28191.194		5.776
1413	-111203.513	-28195.744		5.607
1402	-111194.606	-28207.213		14.521
1415	-111185.399	-28219.058		15.002
1416	-111181.393	-28224.386		6.666
1341	-111177.975	-28229.560		6.201
1340	-111168.275	-28245.461		18.626
1339	-111164.186	-28252.237		7.914
1337	-111159.129	-28254.916		5.723
1338	-111159.144	-28255.457		0.541
1342	-111159.504	-28276.852		21.398
1343	-111159.809	-28296.768		19.918
1344	-111160.107	-28316.752		19.986
1351	-111160.418	-28336.774		20.024
1350	-111160.133	-28338.521		1.770
1354	-111159.797	-28340.448		1.956
1353	-111159.108	-28341.988		1.687
1352	-111158.973	-28342.303		0.343
1355	-111160.991	-28343.171		2.197
面積				17183.3907780
地積				17183.39 m ²

図面の種類	画地面積求積表		
街区番号	7	番号	/
町名	松室中溝町		
京都市洛西第二土地区画整理組合			

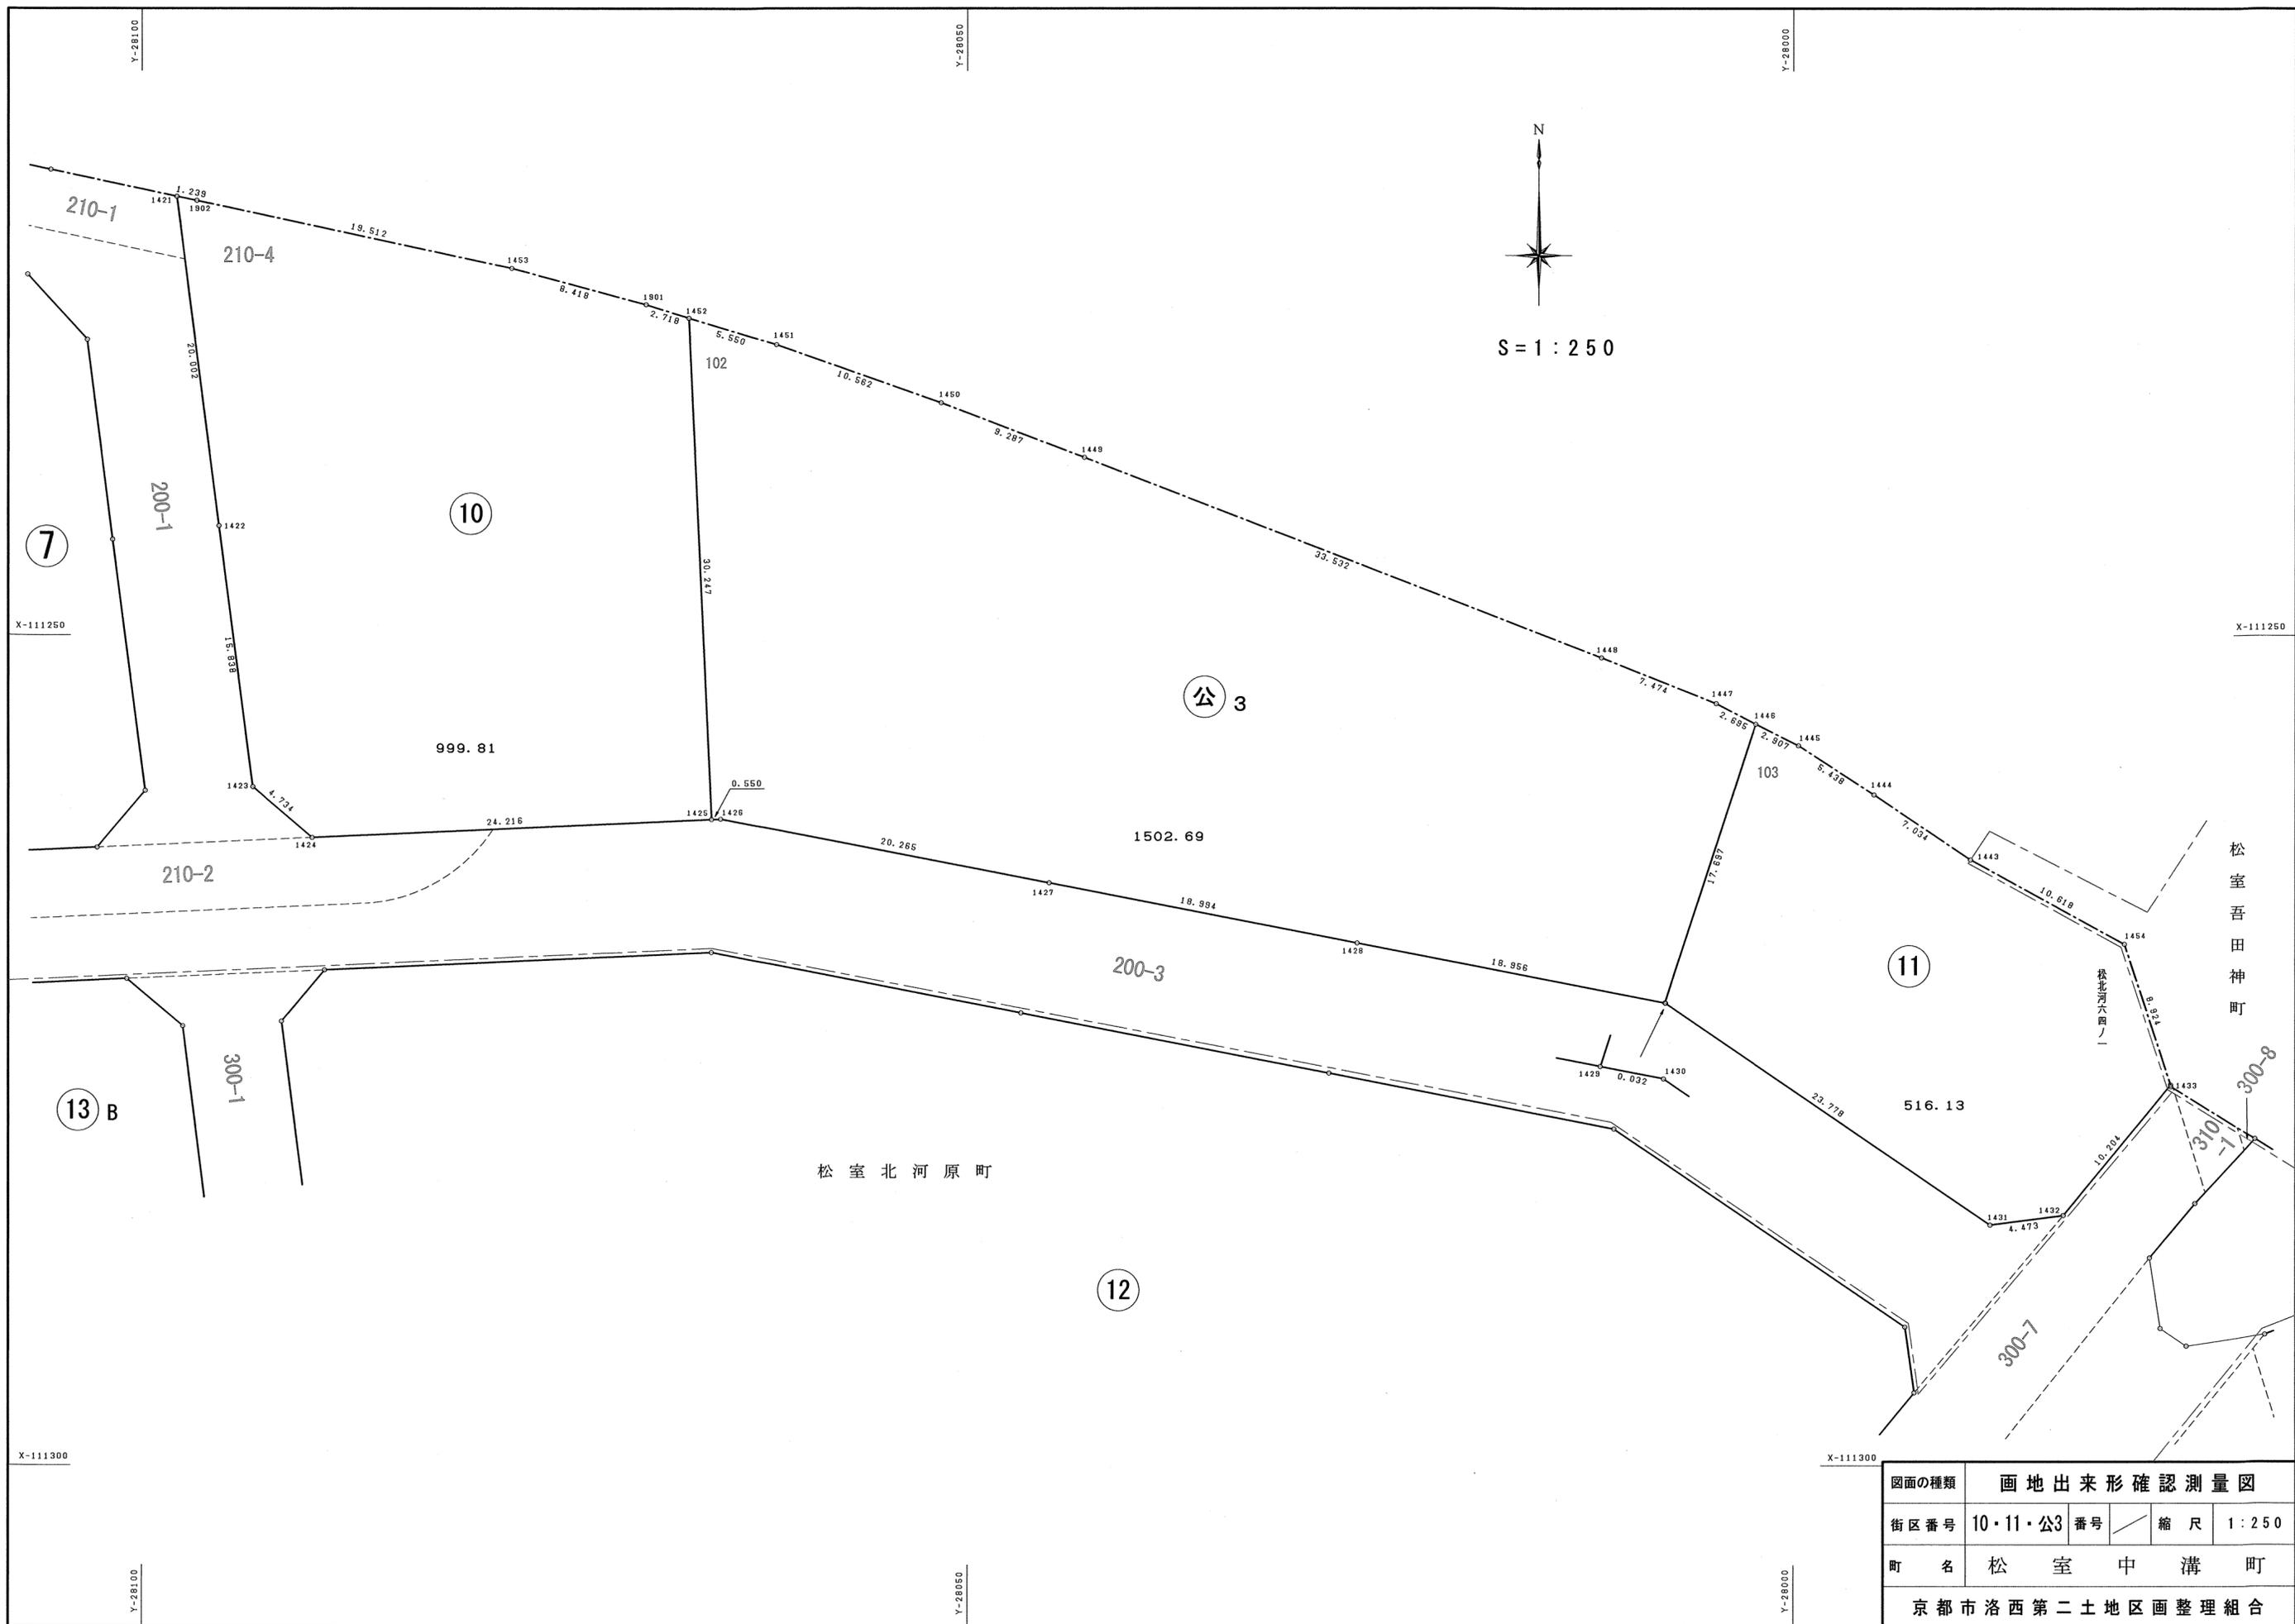

図面の種類	画地出来形確認測量図		
街区番号	10・11・公3	番号	縮尺 1:250
町名	松室中溝町		
京都市洛西第二土地区画整理組合			

210-4 10街区

地番			
N O	X	Y	辺長
1421	-111223.590	-28097.898	
1422	-111243.427	-28095.331	20.002
1423	-111259.133	-28093.289	15.838
1424	-111262.190	-28089.675	4.734
1425	-111261.091	-28065.484	24.216
1452	-111230.876	-28066.869	30.247
1901	-111230.084	-28069.469	2.718
1453	-111227.909	-28077.601	8.418
1902	-111223.840	-28096.684	19.512
1421	-111223.590	-28097.898	1.239
面積	999.8182970		
地積	999.81 m ²		

102

地番	公3		
N O	X	Y	辺長
1452	-111230.876	-28066.869	
1425	-111261.091	-28065.484	30.247
1426	-111261.066	-28064.935	0.550
1427	-111264.904	-28045.037	20.265
1428	-111268.532	-28026.393	18.994
1429	-111272.140	-28007.784	18.956
1446	-111255.323	-28002.272	17.697
1447	-111254.103	-28004.675	2.695
1448	-111251.348	-28011.623	7.474
1449	-111239.280	-28042.908	33.532
1450	-111235.993	-28051.594	9.287
1451	-111232.494	-28061.560	10.562
1452	-111230.876	-28066.869	5.550
面積	1502.6981900		
地積	1502.69 m ²		


103 11街区

地番	松北河六四ノ一		
N O	X	Y	辺長
1446	-111255.323	-28002.272	
1429	-111272.140	-28007.784	17.697
1430	-111272.146	-28007.753	0.032
1431	-111285.505	-27988.083	23.778
1432	-111284.923	-27983.648	4.473
1433	-111277.061	-27977.144	10.204
1454	-111268.589	-27979.947	8.924
1443	-111263.504	-27989.268	10.618
1444	-111259.591	-27995.113	7.034
1445	-111256.639	-27999.680	5.438
1446	-111255.323	-28002.272	2.907
面積	516.1350520		
地積	516.13 m ²		

図面の種類	画地面積求積表			
街区番号	10・11・公3	番号	/	
町名	松室中溝町			
京都市洛西第二土地区画整理組合				



S = 1 : 250

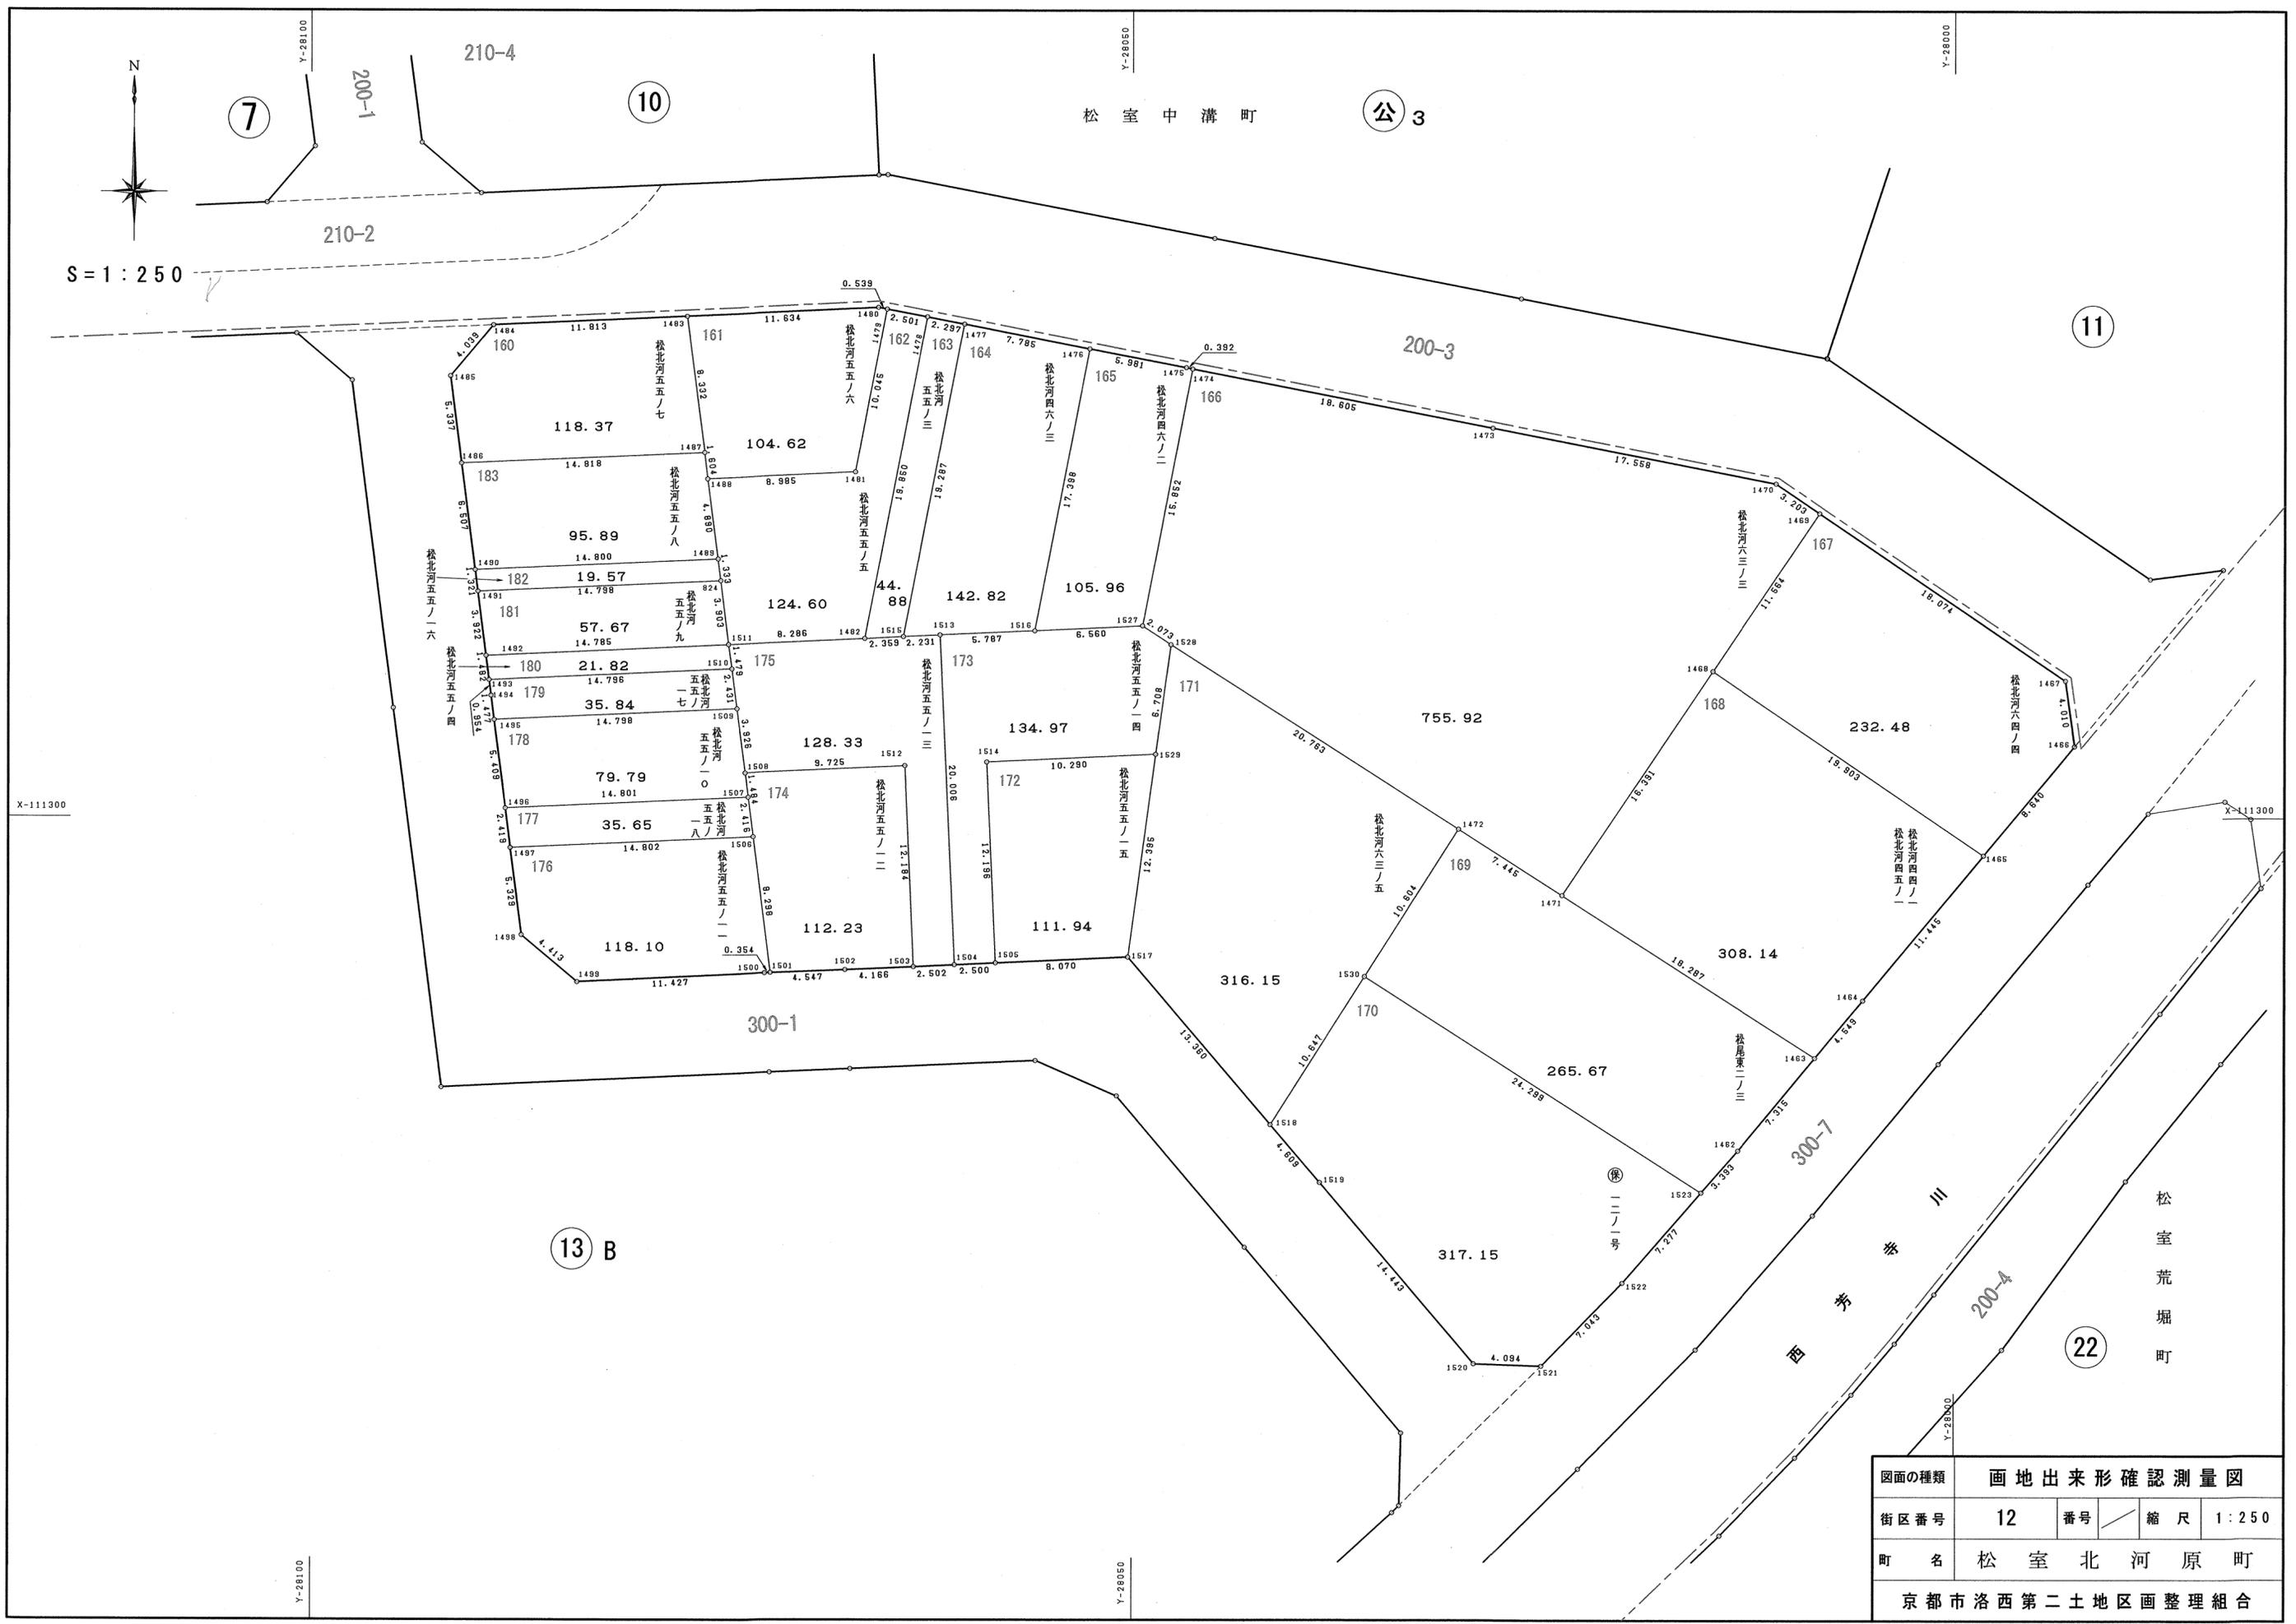

図面の種類	画地出来形確認測量図		
街区番号	12	番号	縮尺 1:250
町名	松室北河原町		
京都市洛西第二土地区画整理組合			

160 地番 松北河五五ノ七

N O	X	Y	辺長
1484	-111270.175	-28088.921	
1485	-111273.260	-28091.528	4.039
1486	-111278.554	-28090.848	5.337
1487	-111277.894	-28076.045	14.818
1483	-111269.632	-28077.120	8.332
1484	-111270.175	-28088.921	11.813
面積	118.3726810		
地積	118.37 m ²		

161 地番 松北河五五ノ六

N O	X	Y	辺長
1483	-111269.632	-28077.120	
1487	-111277.894	-28076.045	8.332
1488	-111279.487	-28075.861	1.604
1481	-111279.060	-28066.886	8.985
1479	-111269.200	-28064.969	10.045
1480	-111269.097	-28065.498	0.539
1483	-111269.632	-28077.120	11.634
面積	104.6273740		
地積	104.62 m ²		

162 地番 松北河五五ノ五

N O	X	Y	辺長
1479	-111269.200	-28064.969	
1481	-111279.060	-28066.886	10.045
1488	-111279.487	-28075.861	8.985
1489	-111284.337	-28075.233	4.890
824	-111285.660	-28075.067	1.333
1511	-111289.532	-28074.580	3.903
1482	-111289.162	-28066.302	8.286
1478	-111269.677	-28062.514	19.850
1479	-111269.200	-28064.969	2.501
面積	124.6068810		
地積	124.60 m ²		

163 地番 松北河五五ノ三

N O	X	Y	辺長
1478	-111269.677	-28062.514	
1482	-111289.162	-28066.302	19.850
1515	-111289.046	-28063.946	2.359
1477	-111270.115	-28060.259	19.287
1478	-111269.677	-28062.514	2.297
面積	44.8857815		
地積	44.88 m ²		

164 地番 松北河四六ノ三

N O	X	Y	辺長
1477	-111270.115	-28060.259	
1515	-111289.046	-28063.946	19.287
1513	-111288.937	-28061.718	2.231
1516	-111288.679	-28055.937	5.787
1476	-111271.601	-28052.617	17.398
1477	-111270.115	-28060.259	7.785
面積	142.8267705		
地積	142.82 m ²		

165 地番 松北河四六ノ二

N O	X	Y	辺長
1476	-111271.601	-28052.617	
1516	-111288.679	-28055.937	17.398
1527	-111288.378	-28049.384	6.560
1474	-111272.817	-28046.361	15.852
1475	-111272.742	-28046.746	0.392
1476	-111271.601	-28052.617	5.981
面積	105.9697190		
地積	105.96 m ²		

166 地番 松北河六三ノ三

N O	X	Y	辺長
1474	-111272.817	-28046.361	
1527	-111288.378	-28049.384	15.852
1528	-111289.516	-28047.651	2.073
1472	-111300.676	-28030.142	20.763
1471	-111304.685	-28023.868	7.445
1468	-111291.100	-28014.697	16.391
1469	-111281.526	-28008.212	11.564
1470	-111279.732	-28010.865	3.203
1473	-111276.374	-28028.099	17.558
1474	-111272.817	-28046.361	18.605
面積	755.9269920		
地積	755.92 m ²		

167 地番 松北河六四ノ四

N O	X	Y	辺長
1469	-111281.526	-28008.212	
1468	-111291.100	-28014.697	11.564
1465	-111302.252	-27998.212	19.903
1466	-111295.620	-27992.674	8.640
1467	-111291.650	-27993.239	4.010
1469	-111281.526	-28008.212	18.074
面積	232.4857240		
地積	232.48 m ²		

168 地番 松北河四四ノ一, 松北河四五ノ一

N O	X	Y	辺長
1468	-111291.100	-28014.697	
1471	-111304.685	-28023.868	16.391
1463	-111314.532	-28008.459	18.287
1464	-111311.037	-28005.547	4.549
1465	-111302.252	-27998.212	11.445
1468	-111291.100	-28014.697	19.903
面積	308.1472705		
地積	308.14 m ²		

169 地番 松尾東二ノ三

N O	X	Y	辺長
1472	-111300.676	-28030.142	
1530	-111309.614	-28035.848	10.604
1523	-111322.705	-28015.377	24.299
1462	-111320.152	-28013.142	3.393
1463	-111314.532	-28008.459	7.315
1471	-111304.685	-28023.868	18.287
1472	-111300.676	-28030.142	7.445
面積	265.6742045		
地積	265.67 m ²		

170 地番 保 一 二 一 号

N O	X	Y	辺長
1530	-111309.614	-28035.848	
1518	-111318.591	-28041.572	10.647
1519	-111322.093	-28038.575	4.609
1520	-111333.075	-28029.195	14.443
1521	-111333.207	-28025.103	4.094
1522	-111328.181	-28020.169	7.043
1523	-111322.705	-28015.377	7.277
1530	-111309.614	-28035.848	24.299
面積	317.1590835		
地積	317.15 m ²		

171 地番 松北河六三ノ五

N O	X	Y	辺長
1528	-111289.516	-28047.651	
1529	-111296.159	-28048.582	6.708
1517	-111308.440	-28050.258	12.395
1518	-111318.591	-28041.572	13.360
1530	-111309.614	-28035.848	10.647
1472	-111300.676	-28030.142	10.604
1528	-111289.516	-28047.651	20.763
面積	316.1541745		
地積	316.15 m ²		

172 地番 松北河五五ノ一五

N O	X	Y	辺長
1514	-111296.624	-28058.861	
1505	-111308.808	-28058.320	12.196
1517	-111308.440	-28050.258	8.070
1529	-111296.159	-28048.582	12.395
1514	-111296.624	-28058.861	10.290
面積	111.9417775		
地積	111.94 m ²		

173 地番 松北河五五ノ一四

N O	X	Y	辺長
1513	-111288.937	-28061.718	
1504	-111308.923	-28060.817	20.006
1505	-111308.808	-28058.320	2.500
1514	-111296.624	-28058.861	12.196
1529	-111296.159	-28048.582	10.290
1528	-111289.516	-28047.651	6.708
1527	-111288.378	-28049.384	2.073
1516	-111288.679	-28055.937	6.560
1513	-111288.937	-28061.718	5.787
面積	134.9722090		
地積	134.97 m ²		

174 地番 松北河五五ノ一二

N O	X	Y	辺長
1508	-111297.303	-28073.566	
1507	-111298.775	-28073.377	1.484
1506	-111301.171	-28073.068	2.416
1501	-111309.403	-28072.022	8.298
1502	-111309.227	-28067.478	4.547
1503	-111309.037	-28063.316	4.166
1512	-111296.865	-28063.851	12.184
1508	-111297.303	-28073.566	9.725
面積	112.2361290		
地積	112.23 m ²		

175 地番 松北河五五ノ一三

N O	X	Y	辺長
1511	-111289.532	-28074.580	
1510	-111290.998	-28074.381	1.479
1509	-111293.409	-28074.069	2.431
1508	-111297.303	-28073.566	3.926
1512	-111296.865	-28063.851	9.725
1503	-111309.037	-28063.316	12.184
1504	-111308.923	-28060.817	2.502
1513	-111288.937	-28061.718	20.006
1515	-111289.046	-28063.946	2.231
1482	-111289.162	-28066.302	2.359
1511	-111289.532	-28074.580	8.286
面積	128.3326780		
地積	128.33 m ²		

176 地番 松北河五五ノ一一

N O	X	Y	辺長
1497	-111301.853	-28087.854	
1498	-111307.139	-28087.175	5.329
1499	-111309.971	-28083.790	4.413
1500	-111309.417	-28072.376	11.427
1501	-111309.403	-28072.022	0.354
1506	-111301.171	-28073.068	8.298
1497	-111301.853	-28087.854	14.802
面積	118.1032810		
地積	118.10 m ²		

177 地番 松北河五五ノ一八

N O	X	Y	辺長
1496	-111299.454	-28088.162	
1497	-111301.853	-28087.854	2.419
1506	-111301.171	-28073.068	14.802
1507	-111298.775	-28073.377	2.416
1496	-111299.454	-28088.162	14.801
面積	35.6581705		
地積	35.65 m ²		

178 地番 松北河五五ノ一〇

N O	X	Y	辺長
1495	-111294.089	-28088.851	
1496	-111299.454	-28088.162	5.409
1507	-111298.775	-28073.377	14.801
1508	-111297.303	-28073.566	1.484
1509	-111293.409	-28074.069	3.926
1495	-111294.089	-28088.851	14.798
面積	79.7922890		
地積	79.79 m ²		

179 地番 松北河五五ノ一七

N O	X	Y	辺長
1493	-111291.678	-28089.161	
1494	-111292.624	-28089.039	0.954
1495	-111294.089	-28088.851	1.477
1509	-111293.409	-28074.069	14.798
1510	-111290.998	-28074.381	2.431
1493	-111291.678	-28089.161	14.796
面積	35.8480300		
地積	35.84 m ²		

180 地番 松北河五五ノ四

N O	X	Y	辺長
1492	-111290.208	-28089.350	
1493	-111291.678	-28089.161	1.482
1510	-111290.998	-28074.381	14.796
1511	-111289.532	-28074.580	1.479
1492	-111290.208	-28089.350	14.785
面積	21.8212320		
地積	21.82 m ²		

181 地番 松北河五五ノ九

N O	X	Y	辺長
1491	-111286.318	-28089.850	
1492	-111290.208	-28089.350	3.922
1511	-111289.532	-28074.580	14.785
824	-111285.660	-28075.067	3.903
1491	-111286.318	-28089.850	14.798
面積	57.6767610		
地積	57.67 m ²		

182 地番 松北河五五ノ一六

N O	X	Y	辺長
1490	-111285.008	-28090.018	
1491	-111286.318	-28089.850	1.321
824	-111285.660	-28075.067	14.788
1489	-111284.337	-28075.233	1.333
1490	-111285.008	-28090.018	14.800
面積	19.5741075		
地積	19.57 m ²		

183 地番 松北河五五ノ八

N O	X	Y	辺長
1486	-111278.554	-28090.848	
1490	-111285.008	-28090.018	6.507
1489	-111284.337	-28075.233	14.800
1488	-111279.487	-28075.861	4.890
1487	-111277.894	-28076.045	1.604
1486	-111278.554	-28090.848	14.818
面積	95.8914825		
地積	95.89 m ²		



S = 1 : 250

X-111300

X-111300

Y-28200

Y-28150

14

15

13 B

16


17

X-111350

X-111350

Y-28200

Y-28150

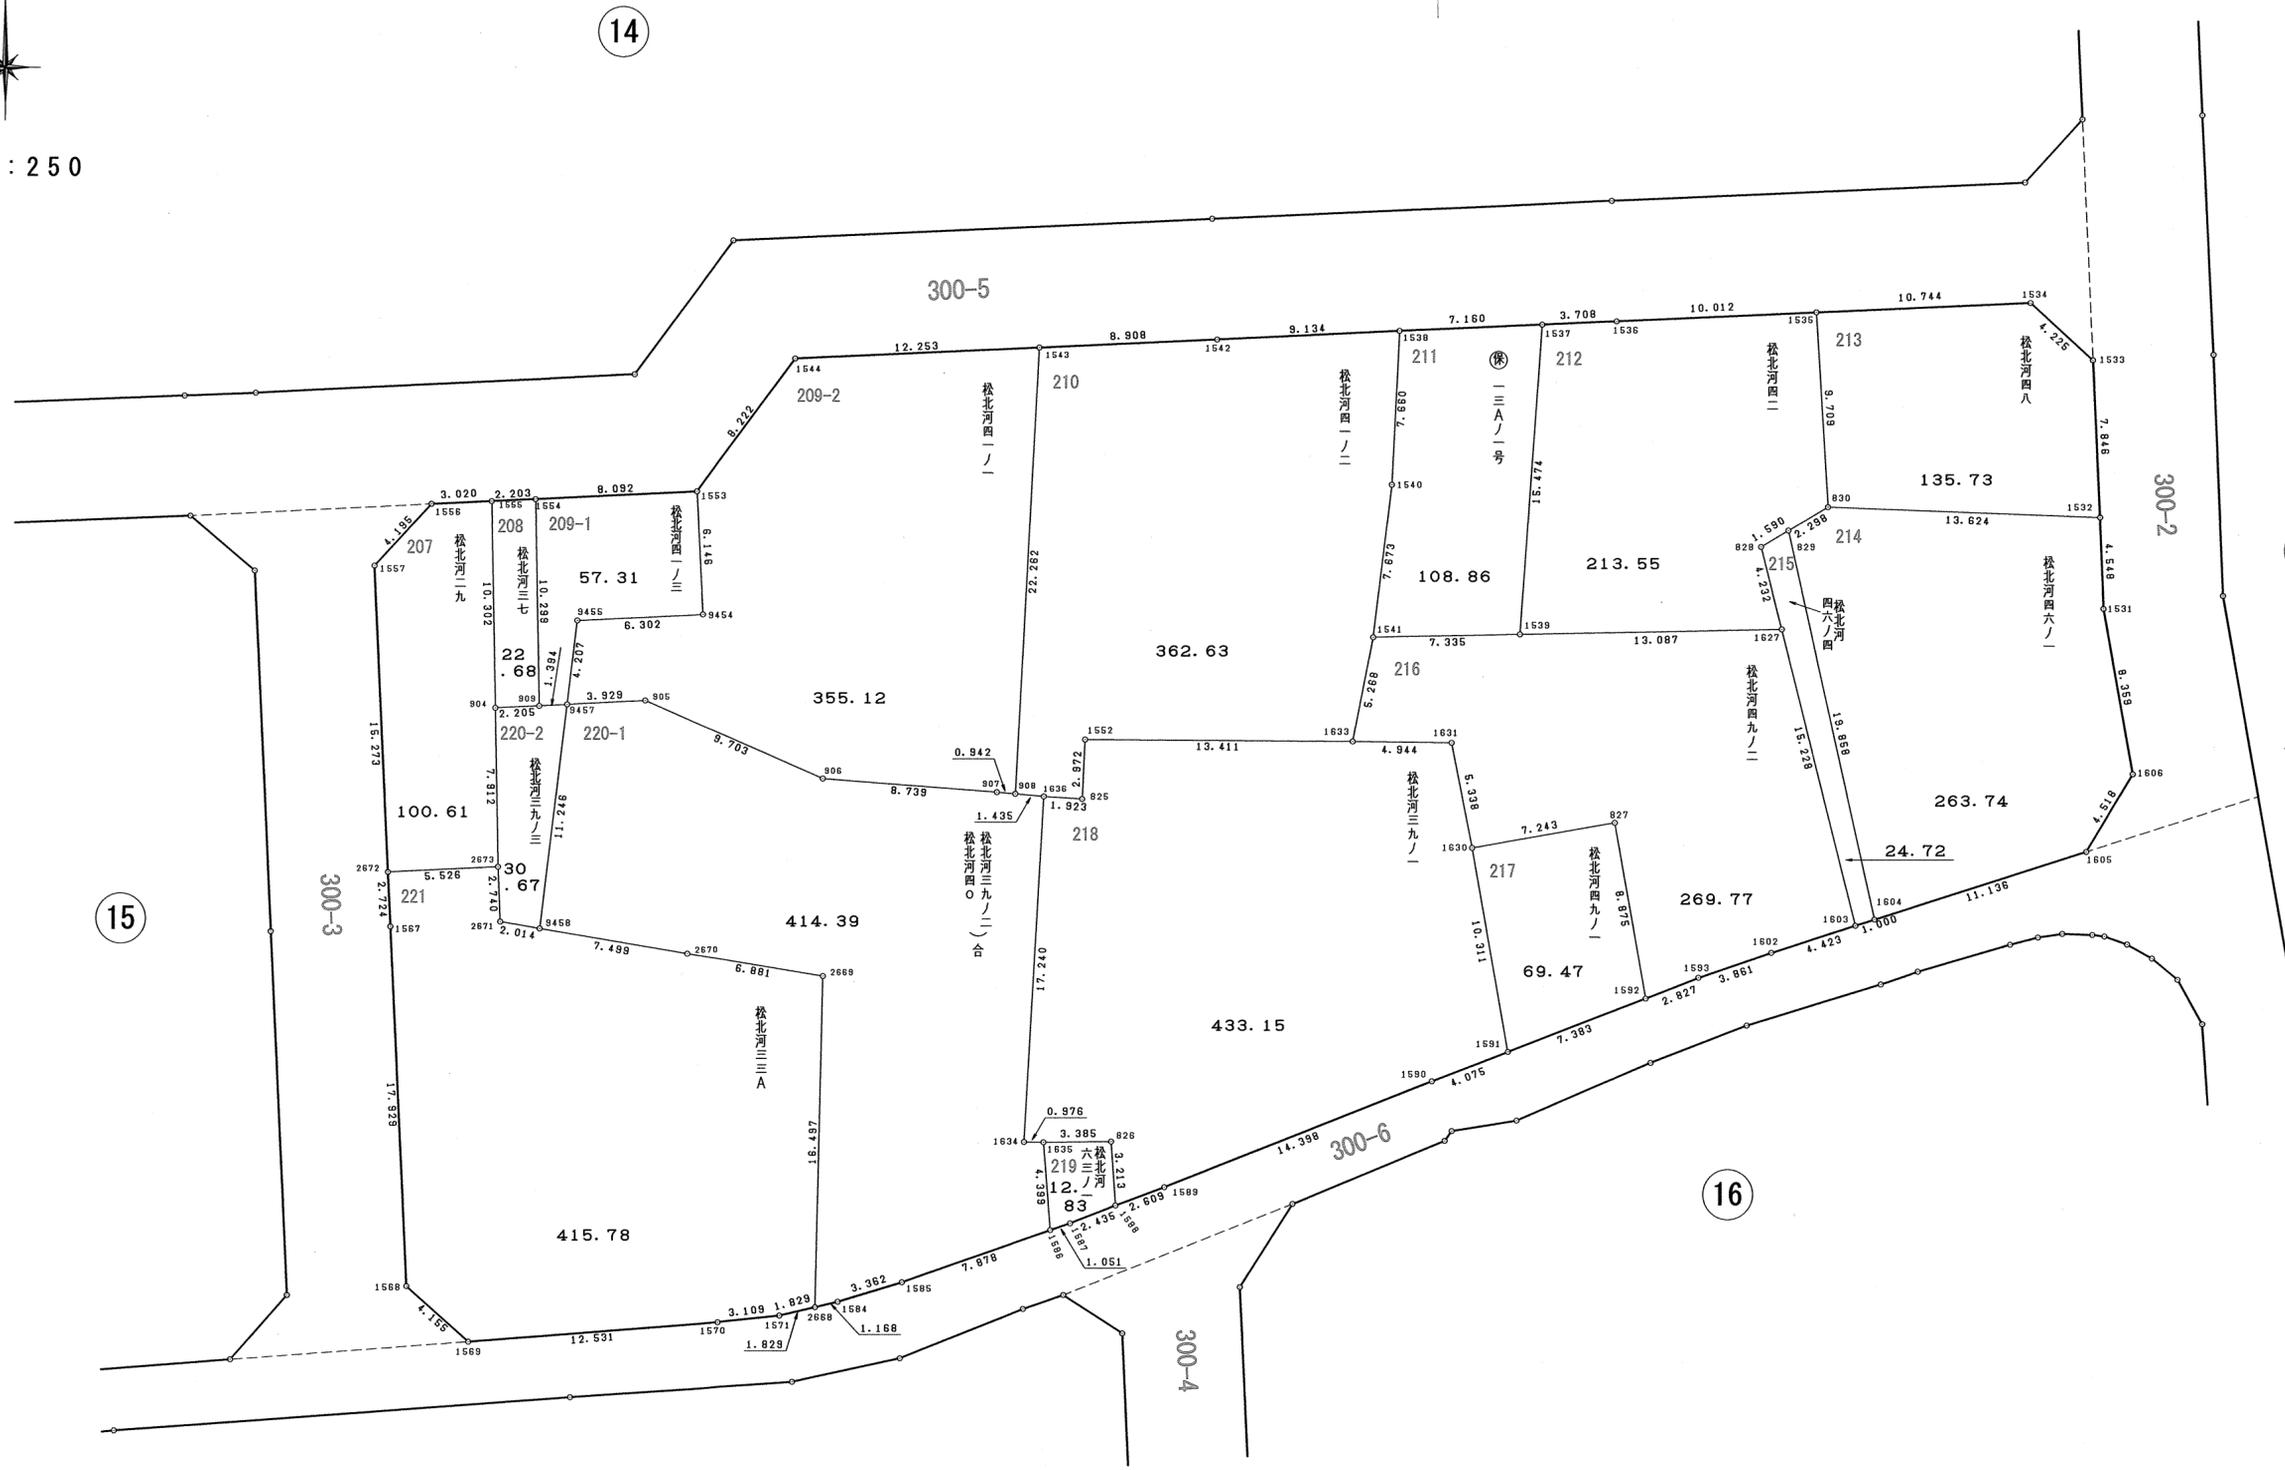

図面の種類	画地出来形確認測量図		
街区番号	13A	番号	箱尺 1:250
町名	松室北河原町		
京都市洛西第二土地区画整理組合			

207

地番 松北河二九			
N O	X	Y	辺長
1555	-111311.961	-28214.664	
1556	-111312.109	-28217.680	3.020
1557	-111315.182	-28220.536	4.195
2672	-111330.440	-28219.858	15.273
2673	-111330.172	-28214.339	5.526
904	-111322.261	-28214.480	7.912
1555	-111311.961	-28214.664	10.302
面積	100.6106135		
地積	100.61 m ²		

208

地番 松北河三七			
N O	X	Y	辺長
1555	-111311.961	-28214.664	
904	-111322.261	-28214.480	10.302
909	-111322.151	-28212.278	2.205
1554	-111311.854	-28212.464	10.299
1555	-111311.961	-28214.664	2.203
面積	22.6870710		
地積	22.68 m ²		

209-1

地番 松北河四一ノ三			
N O	X	Y	辺長
1554	-111311.854	-28212.464	
909	-111322.151	-28212.278	10.299
9457	-111322.082	-28210.886	1.394
9455	-111317.908	-28210.375	4.207
9454	-111317.597	-28204.081	6.302
1553	-111311.458	-28204.382	6.146
1554	-111311.854	-28212.464	8.092
面積	57.3169385		
地積	57.31 m ²		

209-2

地番 松北河四一ノ一			
N O	X	Y	辺長
1553	-111311.458	-28204.382	
9454	-111317.597	-28204.081	6.146
9455	-111317.908	-28210.375	6.302
9457	-111322.082	-28210.886	4.207
905	-111321.886	-28206.962	3.929
906	-111325.782	-28198.075	9.703
907	-111326.464	-28189.363	8.739
908	-111326.548	-28188.425	0.942
1543	-111304.318	-28187.232	22.262
1544	-111304.862	-28189.473	12.253
1553	-111311.458	-28204.382	8.222
面積	355.1200195		
地積	355.12 m ²		

210

地番 松北河四一ノ二			
N O	X	Y	辺長
1543	-111304.318	-28187.232	
908	-111326.548	-28188.425	22.262
1636	-111326.677	-28186.996	1.435
825	-111326.800	-28185.077	1.923
1552	-111323.831	-28184.938	2.972
1633	-111323.943	-28171.527	13.411
1541	-111318.776	-28170.498	5.268
1540	-111311.157	-28169.587	7.673
1538	-111303.506	-28169.208	7.660
1542	-111303.922	-28178.333	9.134
1543	-111304.318	-28187.232	8.908
面積	362.6342020		
地積	362.63 m ²		

211

地番 保一三Aノ一			
N O	X	Y	辺長
1538	-111303.506	-28169.208	
1540	-111311.157	-28169.587	7.660
1541	-111318.776	-28170.498	7.673
1539	-111318.614	-28163.165	7.335
1537	-111303.180	-28162.055	15.474
1538	-111303.506	-28169.208	7.160
面積	108.8605060		
地積	108.86 m ²		

212

地番 松北河四二			
N O	X	Y	辺長
1537	-111303.180	-28162.055	
1539	-111318.614	-28163.165	15.474
1627	-111318.344	-28150.081	13.087
828	-111314.239	-28151.110	4.232
829	-111313.428	-28149.742	1.590
830	-111312.256	-28147.765	2.298
1535	-111302.565	-28148.349	9.709
1536	-111303.011	-28158.351	10.012
1537	-111303.180	-28162.055	3.708
面積	213.5534345		
地積	213.55 m ²		

213

地番 松北河四八			
N O	X	Y	辺長
1535	-111302.565	-28148.349	
830	-111312.256	-28147.765	9.709
1532	-111312.772	-28134.151	13.624
1533	-111304.934	-28134.495	7.846
1534	-111302.086	-28137.616	4.225
1535	-111302.565	-28148.349	10.744
面積	135.7335945		
地積	135.73 m ²		

214

地番 松北河四六ノ一			
N O	X	Y	辺長
830	-111312.256	-28147.765	
829	-111313.428	-28149.742	2.298
1604	-111332.811	-28145.424	19.858
1605	-111329.420	-28134.817	11.136
1606	-111325.547	-28132.491	4.518
1531	-111317.316	-28133.951	8.359
1532	-111312.772	-28134.151	4.548
830	-111312.256	-28147.765	13.624
面積	263.7457105		
地積	263.74 m ²		

215

地番 松北河四六ノ四			
N O	X	Y	辺長
828	-111314.239	-28151.110	
1627	-111318.344	-28150.081	4.232
1603	-111333.115	-28146.377	15.228
1604	-111332.811	-28145.424	1.000
829	-111313.428	-28149.742	19.858
828	-111314.239	-28151.110	1.590
面積	24.7255315		
地積	24.72 m ²		

216

地番 松北河四九ノ二			
N O	X	Y	辺長
1541	-111318.776	-28170.498	
1633	-111323.943	-28171.527	5.268
1631	-111324.007	-28166.583	4.944
1630	-111329.245	-28165.555	5.338
827	-111327.987	-28158.422	7.243
1592	-111336.727	-28156.881	8.875
1593	-111335.704	-28154.246	2.827
1602	-111334.462	-28150.590	3.861
1603	-111333.115	-28146.377	4.423
1627	-111318.344	-28150.081	15.228
1539	-111318.614	-28163.165	13.087
1541	-111318.776	-28170.498	7.335
面積	269.7755695		
地積	269.77 m ²		

217

地番 松北河四九ノ一			
N O	X	Y	辺長
1630	-111329.245	-28165.555	
1591	-111339.399	-28163.764	10.311
1592	-111336.727	-28156.881	7.383
827	-111327.987	-28158.422	8.875
1630	-111329.245	-28165.555	7.243
面積	69.4782660		
地積	69.47 m ²		

218

地番 松北河三九ノ一			
N O	X	Y	辺長
1552	-111323.831	-28184.938	
825	-111326.800	-28185.077	2.972
1636	-111326.677	-28186.996	1.923
1634	-111343.889	-28187.985	17.240
1635	-111343.896	-28187.009	0.976
826	-111343.864	-28183.624	3.385
1588	-111347.069	-28183.401	3.213
1589	-111346.140	-28180.963	2.609
1590	-111340.874	-28167.563	14.398
1591	-111339.399	-28163.764	4.075
1630	-111329.245	-28165.555	10.311
1631	-111324.007	-28166.583	5.338
1633	-111323.943	-28171.527	4.944
1552	-111323.831	-28184.938	13.411
面積	433.1579340		
地積	433.15 m ²		

219

地番 松北河六三ノ一			
N O	X	Y	辺長
1635	-111343.896	-28187.009	
1586	-111348.282	-28186.668	4.399
1587	-111347.936	-28185.676	1.051
1588	-111347.069	-28183.401	2.435
826	-111343.864	-28183.624	3.213
1635	-111343.896	-28187.009	3.385
面積	12.8358350		
地積	12.83 m ²		

220-1

地番 松北河三九ノ二 松北河四〇)合			
N O	X	Y	辺長
9457	-111322.082	-28210.886	
9458	-111333.245	-28212.252	11.246
2670	-111334.492	-28204.857	7.499
2669	-111335.624	-28198.070	6.881
2668	-111352.116	-28198.462	16.497
1584	-111351.848	-28197.325	1.168
1585	-111350.875	-28194.107	3.362
1586	-111348.282	-28186.668	7.878
1635	-111343.896	-28187.009	4.399
1634	-111343.889	-28187.985	0.976
1636	-111326.677	-28186.996	17.240
908	-111326.548	-28188.425	1.435
907	-111326.464	-28189.363	0.942
906	-111325.782	-28198.075	8.739
905	-111321.886	-28206.962	9.703
9457	-111322.082	-28210.886	3.929
面積	414.3961425		
地積	414.39 m ²		

220-2

地番 松北河三九ノ三			
N O	X	Y	辺長
904	-111322.261	-28214.480	
2673	-111330.172	-28214.339	7.912
2671	-111332.910	-28214.238	2.740
9458	-111333.245	-28212.252	2.014
9457	-111322.082	-28210.886	11.246
909	-111322.151	-28212.278	1.394
904	-111322.261	-28214.480	2.205
面積	30.6786435		
地積	30.67 m ²		

221

地番 松北河三三A			
N O	X	Y	辺長
2668	-111352.116	-28198.462	
2669	-111335.624	-28198.070	16.497
2670	-111334.492	-28204.857	6.881
9458	-111333.245	-28212.252	7.499
2671	-111332.910	-28214.238	2.014
2673	-111330.172	-28214.339	2.740
2672	-111330.440	-28219.858	5.526
1567	-111333.161	-28219.737	2.724
1568	-111351.072	-28218.928	17.929
1569	-111353.837	-28215.827	4.155
1570	-111352.857	-28203.334	12.531
1571	-111352.536	-28200.242	3.109
2668	-111352.116	-28198.462	1.829
面積	415.7879090		
地積	415.78 m ²		

図面の種類	画地面積求積表		
街区番号	13A	番号	/
町名	松室北河原町		
京都市洛西第二土地区画整理組合			

X-111250

X-111250

12



S = 1 : 250


13 A

X-111350

X-111350

16

22

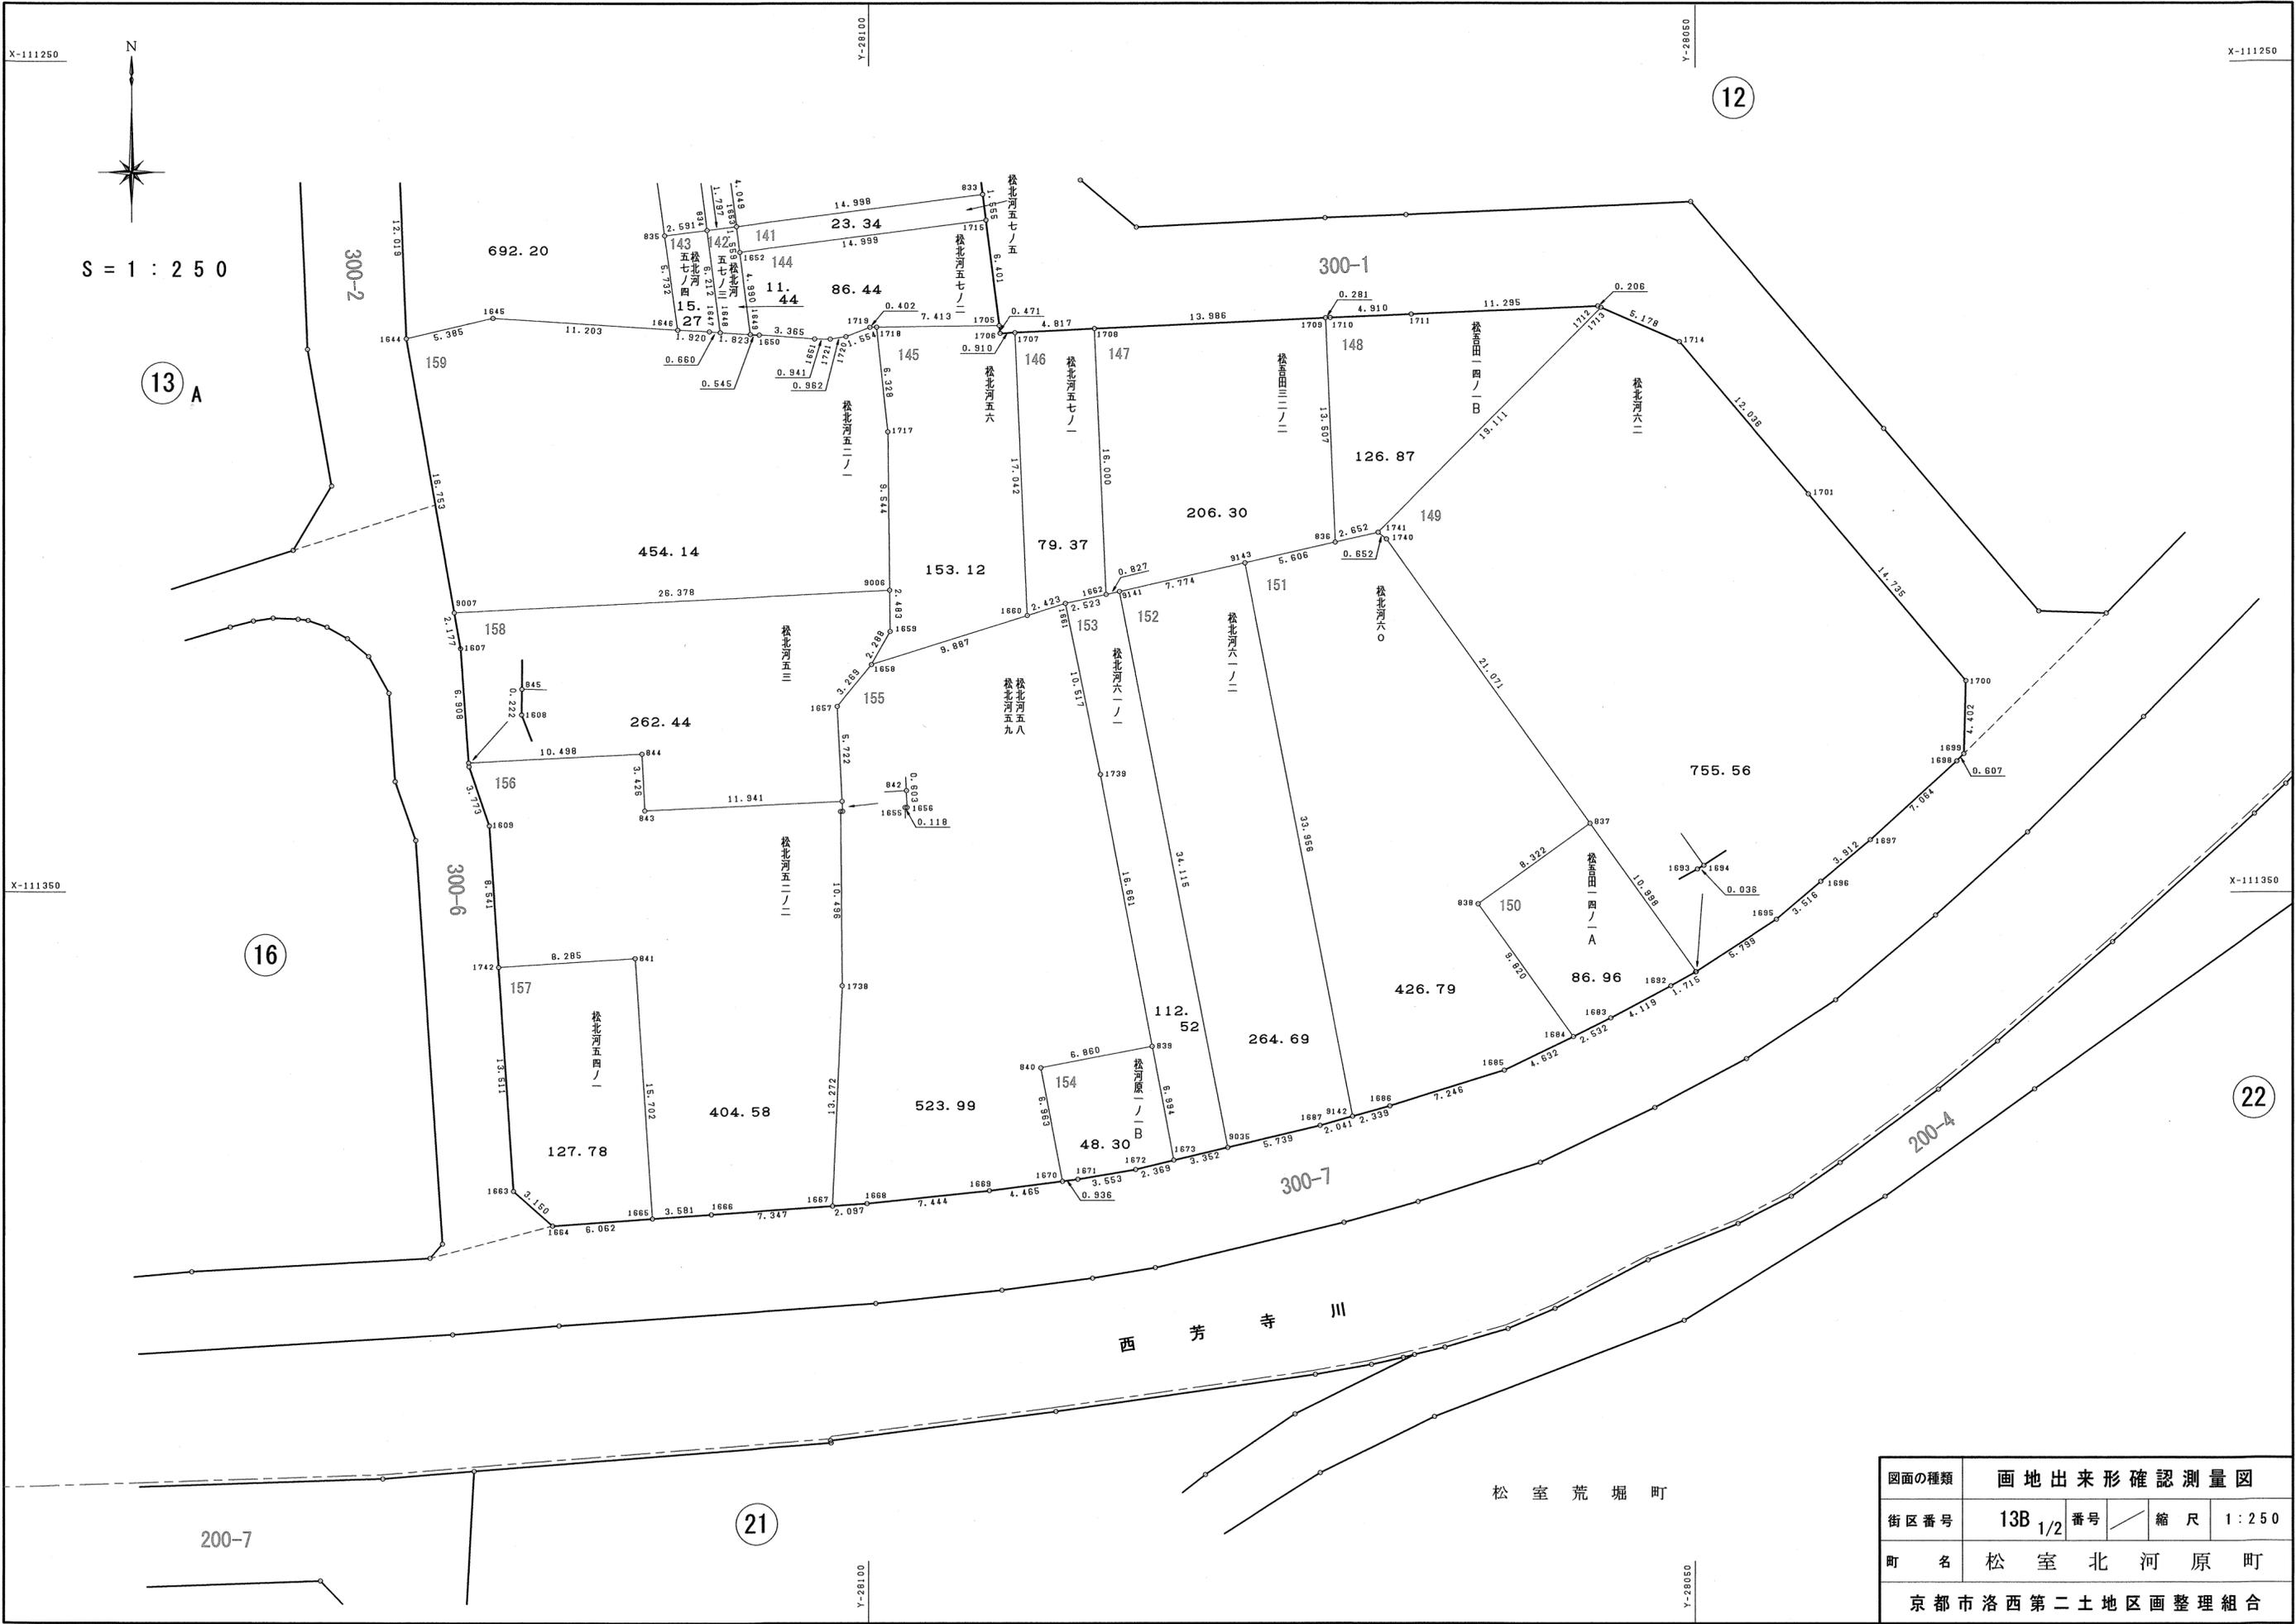


200-7

21

松室荒堀町

図面の種類	画地出来形確認測量図		
街区番号	13B _{1/2}	番号	縮尺 1:250
町名	松室北河原町		
京都市洛西第二土地区画整理組合			

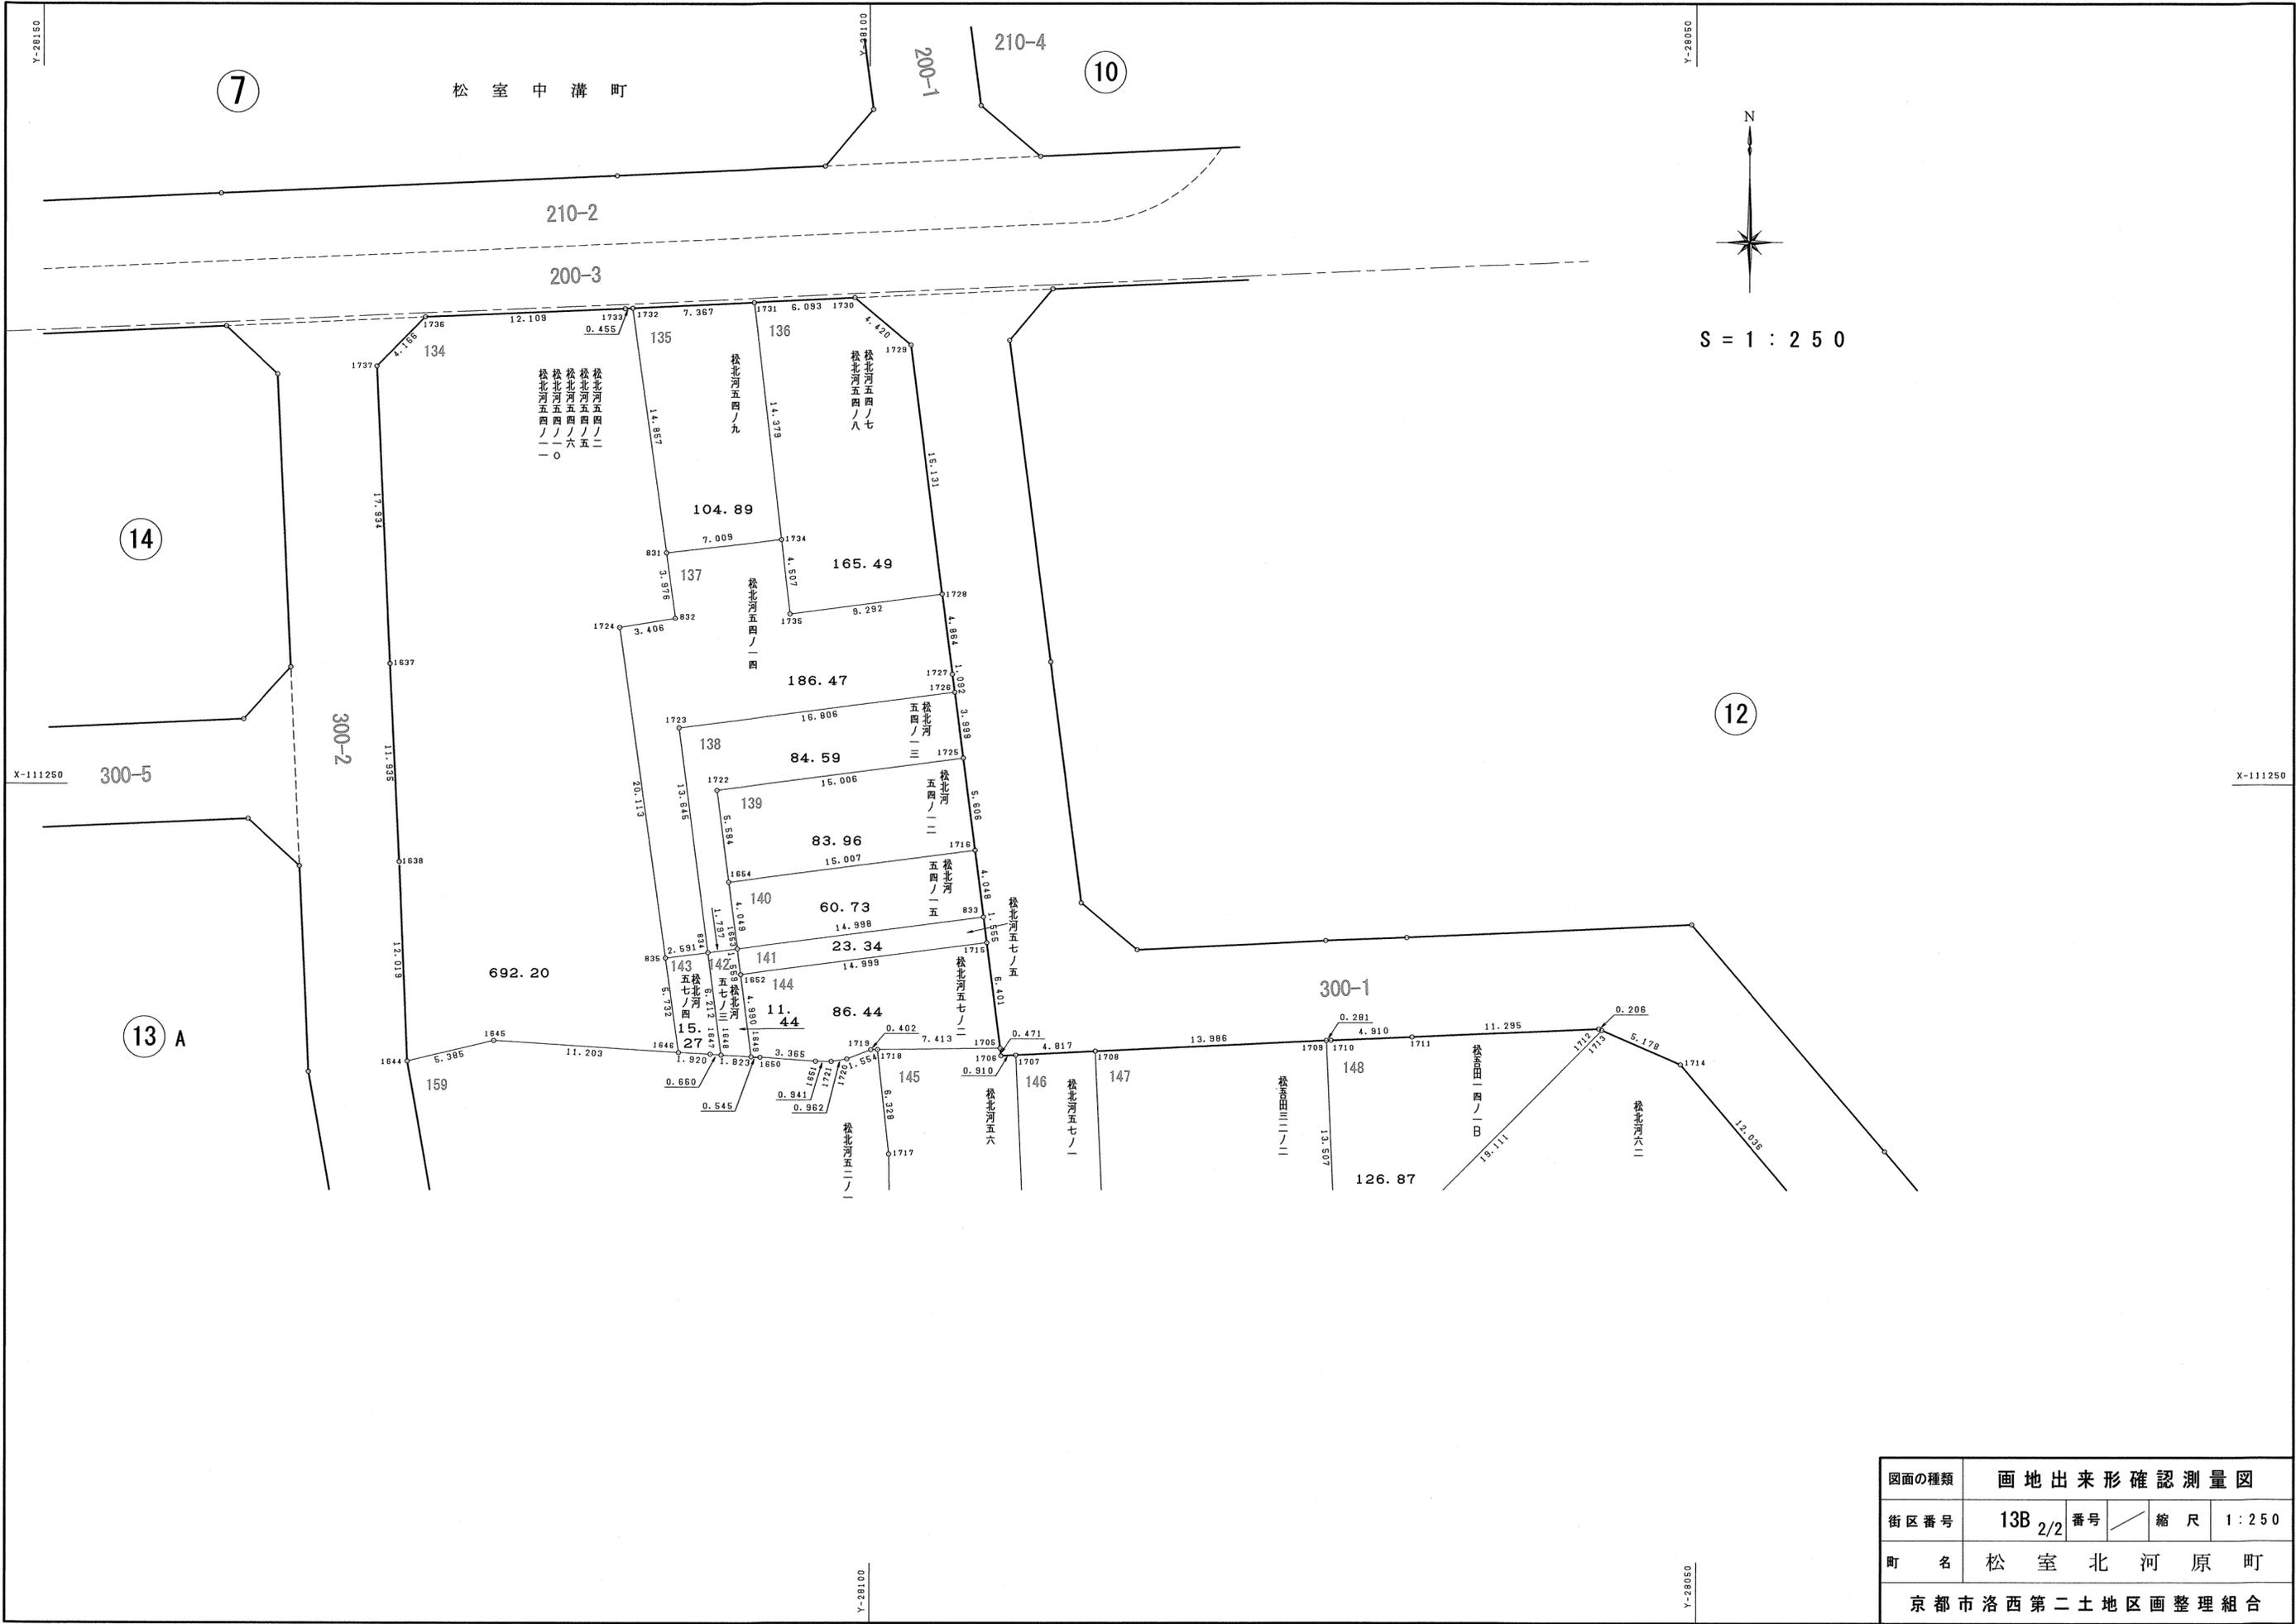

N
 S = 1 : 2 5 0

図面の種類	画地出来形確認測量図			
街区番号	13B	2/2	番号	縮尺 1 : 2 5 0
町名	松室北河原町			
京都市洛西第二土地区画整理組合				

Table 134: Land parcels in area 134. Columns: 地番 (Parcel No.), NO, X, Y, 辺長 (Perimeter). Rows include parcels 1736, 1737, 1637, 1638, 1644, 1645, 1646, 835, 1724, 832, 831, 1732, 1733, 1736, 面積 (Area), and 地積 (Total Area).

Table 135: Land parcels in area 135. Columns: 地番 (Parcel No.), NO, X, Y, 辺長 (Perimeter). Rows include parcels 1732, 831, 1734, 1731, 1732, 面積 (Area), and 地積 (Total Area).

Table 136: Land parcels in area 136. Columns: 地番 (Parcel No.), NO, X, Y, 辺長 (Perimeter). Rows include parcels 1731, 1734, 1735, 1728, 1729, 1730, 1731, 面積 (Area), and 地積 (Total Area).

Table 137: Land parcels in area 137. Columns: 地番 (Parcel No.), NO, X, Y, 辺長 (Perimeter). Rows include parcels 831, 832, 1724, 835, 834, 1723, 1726, 1727, 1728, 1735, 1734, 831, 面積 (Area), and 地積 (Total Area).

Table 138: Land parcels in area 138. Columns: 地番 (Parcel No.), NO, X, Y, 辺長 (Perimeter). Rows include parcels 1726, 1723, 834, 1653, 1654, 1722, 1725, 1726, 面積 (Area), and 地積 (Total Area).

Table 139: Land parcels in area 139. Columns: 地番 (Parcel No.), NO, X, Y, 辺長 (Perimeter). Rows include parcels 1722, 1654, 1716, 1725, 1722, 面積 (Area), and 地積 (Total Area).

Table 140: Land parcels in area 140. Columns: 地番 (Parcel No.), NO, X, Y, 辺長 (Perimeter). Rows include parcels 1654, 1653, 833, 1716, 1654, 面積 (Area), and 地積 (Total Area).

Table 141: Land parcels in area 141. Columns: 地番 (Parcel No.), NO, X, Y, 辺長 (Perimeter). Rows include parcels 1653, 1652, 1715, 833, 1653, 面積 (Area), and 地積 (Total Area).

Table 142: Land parcels in area 142. Columns: 地番 (Parcel No.), NO, X, Y, 辺長 (Perimeter). Rows include parcels 834, 1648, 1649, 1652, 1653, 834, 面積 (Area), and 地積 (Total Area).

Table 143: Land parcels in area 143. Columns: 地番 (Parcel No.), NO, X, Y, 辺長 (Perimeter). Rows include parcels 835, 1646, 1647, 1648, 834, 835, 面積 (Area), and 地積 (Total Area).

Table 144: Land parcels in area 144. Columns: 地番 (Parcel No.), NO, X, Y, 辺長 (Perimeter). Rows include parcels 1652, 1649, 1650, 1651, 1721, 1720, 1719, 1718, 1705, 1715, 1652, 面積 (Area), and 地積 (Total Area).

Table 145: Land parcels in area 145. Columns: 地番 (Parcel No.), NO, X, Y, 辺長 (Perimeter). Rows include parcels 1718, 1717, 9006, 1659, 1658, 1660, 1707, 1706, 1705, 1718, 面積 (Area), and 地積 (Total Area).

Table 146: Land parcels in area 146. Columns: 地番 (Parcel No.), NO, X, Y, 辺長 (Perimeter). Rows include parcels 1707, 1660, 1661, 1662, 1708, 1707, 面積 (Area), and 地積 (Total Area).

Table 147: Land parcels in area 147. Columns: 地番 (Parcel No.), NO, X, Y, 辺長 (Perimeter). Rows include parcels 1708, 1662, 836, 1709, 1708, 面積 (Area), and 地積 (Total Area).

Table 148: Land parcels in area 148. Columns: 地番 (Parcel No.), NO, X, Y, 辺長 (Perimeter). Rows include parcels 1709, 836, 1741, 1713, 1712, 1711, 1710, 1709, 面積 (Area), and 地積 (Total Area).

Table 149: Land parcels in area 149. Columns: 地番 (Parcel No.), NO, X, Y, 辺長 (Perimeter). Rows include parcels 1741, 1740, 837, 1694, 1695, 1696, 1697, 1698, 1699, 1700, 1701, 1714, 1713, 1741, 面積 (Area), and 地積 (Total Area).

Table 150: Land parcels in area 150. Columns: 地番 (Parcel No.), NO, X, Y, 辺長 (Perimeter). Rows include parcels 838, 1684, 1683, 1692, 1693, 1694, 837, 838, 面積 (Area), and 地積 (Total Area).

Table 151: Land parcels in area 151. Columns: 地番 (Parcel No.), NO, X, Y, 辺長 (Perimeter). Rows include parcels 9142, 1686, 1685, 1684, 838, 837, 1740, 1741, 836, 9143, 9142, 面積 (Area), and 地積 (Total Area).

Table 152: Land parcels in area 152. Columns: 地番 (Parcel No.), NO, X, Y, 辺長 (Perimeter). Rows include parcels 9141, 9035, 1687, 9142, 9143, 9141, 面積 (Area), and 地積 (Total Area).

Table 153: Land parcels in area 153. Columns: 地番 (Parcel No.), NO, X, Y, 辺長 (Perimeter). Rows include parcels 1673, 9035, 9141, 1662, 1661, 1739, 839, 1673, 面積 (Area), and 地積 (Total Area).

Table 154: Land parcels in area 154. Columns: 地番 (Parcel No.), NO, X, Y, 辺長 (Perimeter). Rows include parcels 840, 1670, 1671, 1672, 1673, 839, 840, 面積 (Area), and 地積 (Total Area).

Table 155: Land parcels in area 155. Columns: 地番 (Parcel No.), NO, X, Y, 辺長 (Perimeter). Rows include parcels 1658, 1657, 842, 1656, 1738, 1667, 1668, 1669, 1670, 840, 839, 1739, 1661, 1660, 1658, 面積 (Area), and 地積 (Total Area).


Table 156: Land parcels in area 156. Columns: 地番 (Parcel No.), NO, X, Y, 辺長 (Perimeter). Rows include parcels 845, 1608, 1609, 1742, 841, 1665, 1666, 1667, 1738, 1655, 1656, 842, 843, 844, 845, 面積 (Area), and 地積 (Total Area).

Table 157: Land parcels in area 157. Columns: 地番 (Parcel No.), NO, X, Y, 辺長 (Perimeter). Rows include parcels 1742, 1663, 1664, 1665, 841, 1742, 面積 (Area), and 地積 (Total Area).

Table 158: Land parcels in area 158. Columns: 地番 (Parcel No.), NO, X, Y, 辺長 (Perimeter). Rows include parcels 842, 1657, 1658, 1659, 9006, 9007, 1607, 845, 844, 843, 842, 面積 (Area), and 地積 (Total Area).

地番 松北河五二ノ一			
NO	X	Y	辺長
9006	-111331.813	-28098.715	
1717	-111322.270	-28098.831	9.544
1718	-111315.979	-28099.512	6.328
1719	-111315.990	-28099.914	0.402
1720	-111316.551	-28101.363	1.554
1721	-111316.702	-28102.313	0.962
1651	-111316.691	-28103.254	0.941
1650	-111316.440	-28106.610	3.365
1649	-111316.407	-28107.154	0.545
1648	-111316.302	-28108.974	1.823
1647	-111316.246	-28109.632	0.660
1646	-111316.147	-28111.549	1.920
1645	-111315.438	-28122.730	11.203
1644	-111316.677	-28127.971	5.385
9007	-111333.175	-28125.058	16.753
9006	-111331.813	-28098.715	26.378
面積	454.1463020		
地積	454.14 m ²		

図面の種類	画地面積求積表		
街区番号	13B	番号	$\frac{2}{2}$
町名	松室北河原町		
京都市洛西第二土地区画整理組合			

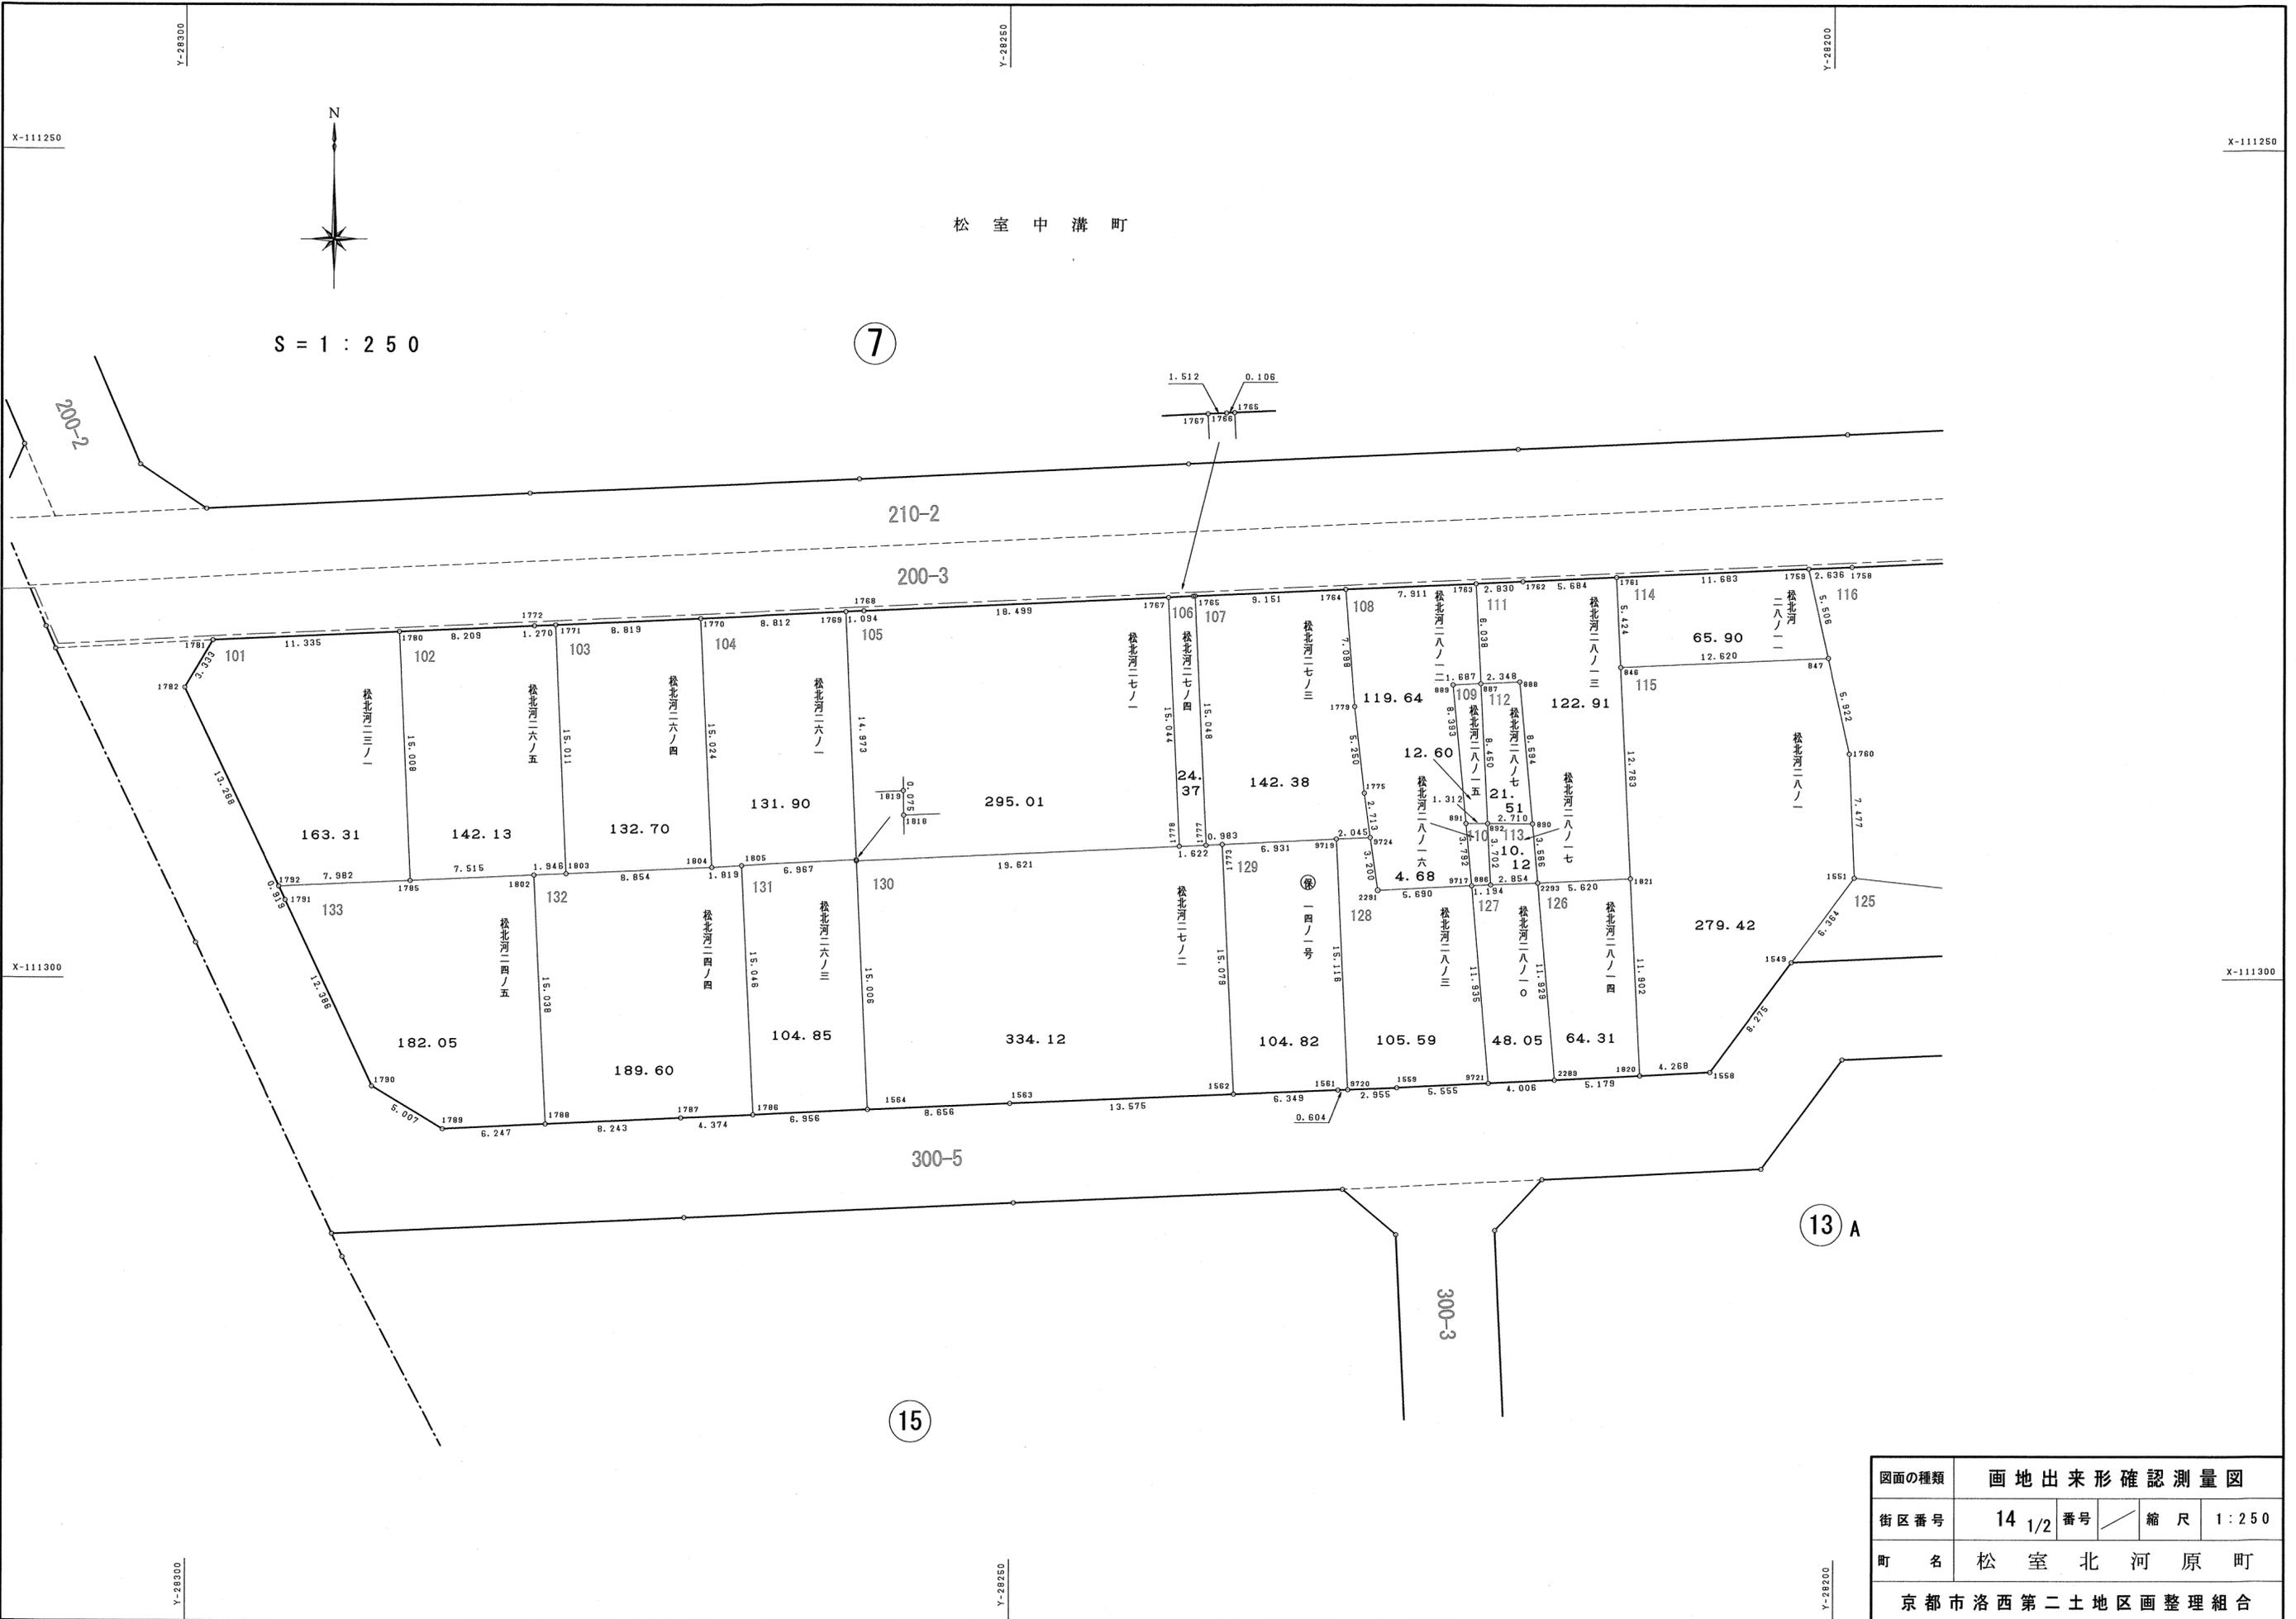

松室中溝町

S = 1 : 250

7

13 A

15

図面の種類	画地出来形確認測量図			
街区番号	14 1/2	番号	縮尺	1 : 250
町名	松室北河原町			
京都市洛西第二土地区画整理組合				

101

Table with 4 columns: NO, X, Y, 辺長. Rows include land parcels 1781, 1782, 1792, 1785, 1780, 1781, 面積, 地積.

102

Table with 4 columns: NO, X, Y, 辺長. Rows include land parcels 1780, 1785, 1802, 1803, 1771, 1772, 1780, 面積, 地積.

103

Table with 4 columns: NO, X, Y, 辺長. Rows include land parcels 1771, 1803, 1804, 1770, 1771, 面積, 地積.

104

Table with 4 columns: NO, X, Y, 辺長. Rows include land parcels 1770, 1804, 1805, 1819, 1769, 1770, 面積, 地積.

105

Table with 4 columns: NO, X, Y, 辺長. Rows include land parcels 1769, 1819, 1818, 1778, 1767, 1768, 1769, 面積, 地積.

106

Table with 4 columns: NO, X, Y, 辺長. Rows include land parcels 1767, 1778, 1777, 1765, 1766, 1767, 面積, 地積.

107

Table with 4 columns: NO, X, Y, 辺長. Rows include land parcels 1765, 1777, 1773, 9719, 9724, 1775, 1779, 1764, 1765, 面積, 地積.

108

Table with 4 columns: NO, X, Y, 辺長. Rows include land parcels 1764, 1779, 1775, 9724, 2291, 9717, 891, 889, 887, 1763, 1764, 面積, 地積.

109

Table with 4 columns: NO, X, Y, 辺長. Rows include land parcels 889, 891, 892, 887, 889, 面積, 地積.

110

Table with 4 columns: NO, X, Y, 辺長. Rows include land parcels 891, 9717, 886, 892, 891, 面積, 地積.

111

Table with 4 columns: NO, X, Y, 辺長. Rows include land parcels 1763, 887, 888, 890, 2293, 1821, 846, 1761, 1762, 1763, 面積, 地積.

112

Table with 4 columns: NO, X, Y, 辺長. Rows include land parcels 887, 892, 890, 888, 887, 面積, 地積.

113

Table with 4 columns: NO, X, Y, 辺長. Rows include land parcels 892, 886, 2293, 890, 892, 面積, 地積.

114

Table with 4 columns: NO, X, Y, 辺長. Rows include land parcels 846, 847, 1759, 1761, 面積, 地積.

115

Table with 4 columns: NO, X, Y, 辺長. Rows include land parcels 846, 1821, 1820, 1558, 1549, 1551, 1760, 847, 846, 面積, 地積.

116

Table with 4 columns: NO, X, Y, 辺長. Rows include land parcels 1759, 847, 1760, 1551, 1550, 1757, 1750, 1758, 1759, 面積, 地積.

117

Table with 4 columns: NO, X, Y, 辺長. Rows include land parcels 1750, 1757, 1756, 1755, 1748, 1749, 1750, 面積, 地積.

118

Table with 4 columns: NO, X, Y, 辺長. Rows include land parcels 1748, 1755, 1754, 1753, 1747, 1748, 面積, 地積.

119

Table with 4 columns: NO, X, Y, 辺長. Rows include land parcels 1747, 1753, 1752, 1745, 1746, 1747, 面積, 地積.

120

Table with 4 columns: NO, X, Y, 辺長. Rows include land parcels 1745, 1752, 1642, 1641, 1640, 1744, 1745, 面積, 地積.

121

Table with 4 columns: NO, X, Y, 辺長. Rows include land parcels 1744, 1640, 1639, 1743, 1751, 1744, 面積, 地積.

122

Table with 4 columns: NO, X, Y, 辺長. Rows include land parcels 1753, 1754, 1545, 1643, 1642, 1752, 1753, 面積, 地積.

123

Table with 4 columns: NO, X, Y, 辺長. Rows include land parcels 1756, 1546, 1545, 1754, 1755, 1756, 面積, 地積.

124

Table with 4 columns: NO, X, Y, 辺長. Rows include land parcels 1757, 1550, 1548, 1547, 1546, 1756, 1757, 面積, 地積.

125

Table with 4 columns: NO, X, Y, 辺長. Rows include land parcels 1551, 1549, 1548, 1550, 1551, 面積, 地積.

126

Table with 4 columns: NO, X, Y, 辺長. Rows include land parcels 2293, 2289, 1820, 1821, 2293, 面積, 地積.

127

Table with 4 columns: NO, X, Y, 辺長. Rows include land parcels 9717, 9721, 2289, 2293, 886, 9717, 面積, 地積.

128

Table with 4 columns: NO, X, Y, 辺長. Rows include land parcels 9719, 9720, 1559, 9721, 9717, 2291, 9724, 9719, 面積, 地積.

129

Table with 4 columns: NO, X, Y, 辺長. Rows include land parcels 1773, 1562, 1561, 9720, 9719, 1773, 面積, 地積.

Summary table with columns: 図面の種類, 街区番号, 町名, 画地面積求積表, 14, 松室北河原町, 京都市洛西第二土地区画整理組合.

130

地番	松北河二七ノ二		
NO	X	Y	辺長
1818	-111292.924	-28259.288	
1564	-111307.914	-28258.597	15.006
1563	-111307.529	-28249.950	8.656
1562	-111306.981	-28236.386	13.575
1773	-111291.918	-28237.084	15.079
1777	-111291.967	-28238.066	0.983
1778	-111292.036	-28239.687	1.622
1818	-111292.924	-28259.288	19.621
面積	334.1259620		
地積	334.12 m ²		

131

地番	松北河二六ノ三		
NO	X	Y	辺長
1805	-111293.194	-28266.249	
1786	-111308.224	-28265.546	15.046
1564	-111307.914	-28258.597	6.956
1818	-111292.924	-28259.288	15.006
1819	-111292.849	-28259.291	0.075
1805	-111293.194	-28266.249	6.967
面積	104.8581225		
地積	104.85 m ²		

132

地番	松北河二四ノ四		
NO	X	Y	辺長
1802	-111293.783	-28278.854	
1788	-111308.805	-28278.150	15.038
1787	-111308.419	-28269.916	8.243
1786	-111308.224	-28265.546	4.374
1805	-111293.194	-28266.249	15.046
1804	-111293.304	-28268.065	1.819
1803	-111293.697	-28276.910	8.854
1802	-111293.783	-28278.854	1.946
面積	189.6060455		
地積	189.60 m ²		


133

地番	松北河二四ノ五		
NO	X	Y	辺長
1792	-111294.471	-28294.335	
1791	-111295.300	-28293.939	0.919
1790	-111306.514	-28288.679	12.386
1789	-111309.097	-28284.390	5.007
1788	-111308.805	-28278.150	6.247
1802	-111293.783	-28278.854	15.038
1785	-111294.121	-28286.361	7.515
1792	-111294.471	-28294.335	7.982
面積	182.0525635		
地積	182.05 m ²		

図面の種類	画地面積求積表			
街区番号	14	番号	2/2	
町名	松室北河原町			
京都市洛西第二土地区画整理組合				



S = 1 : 250

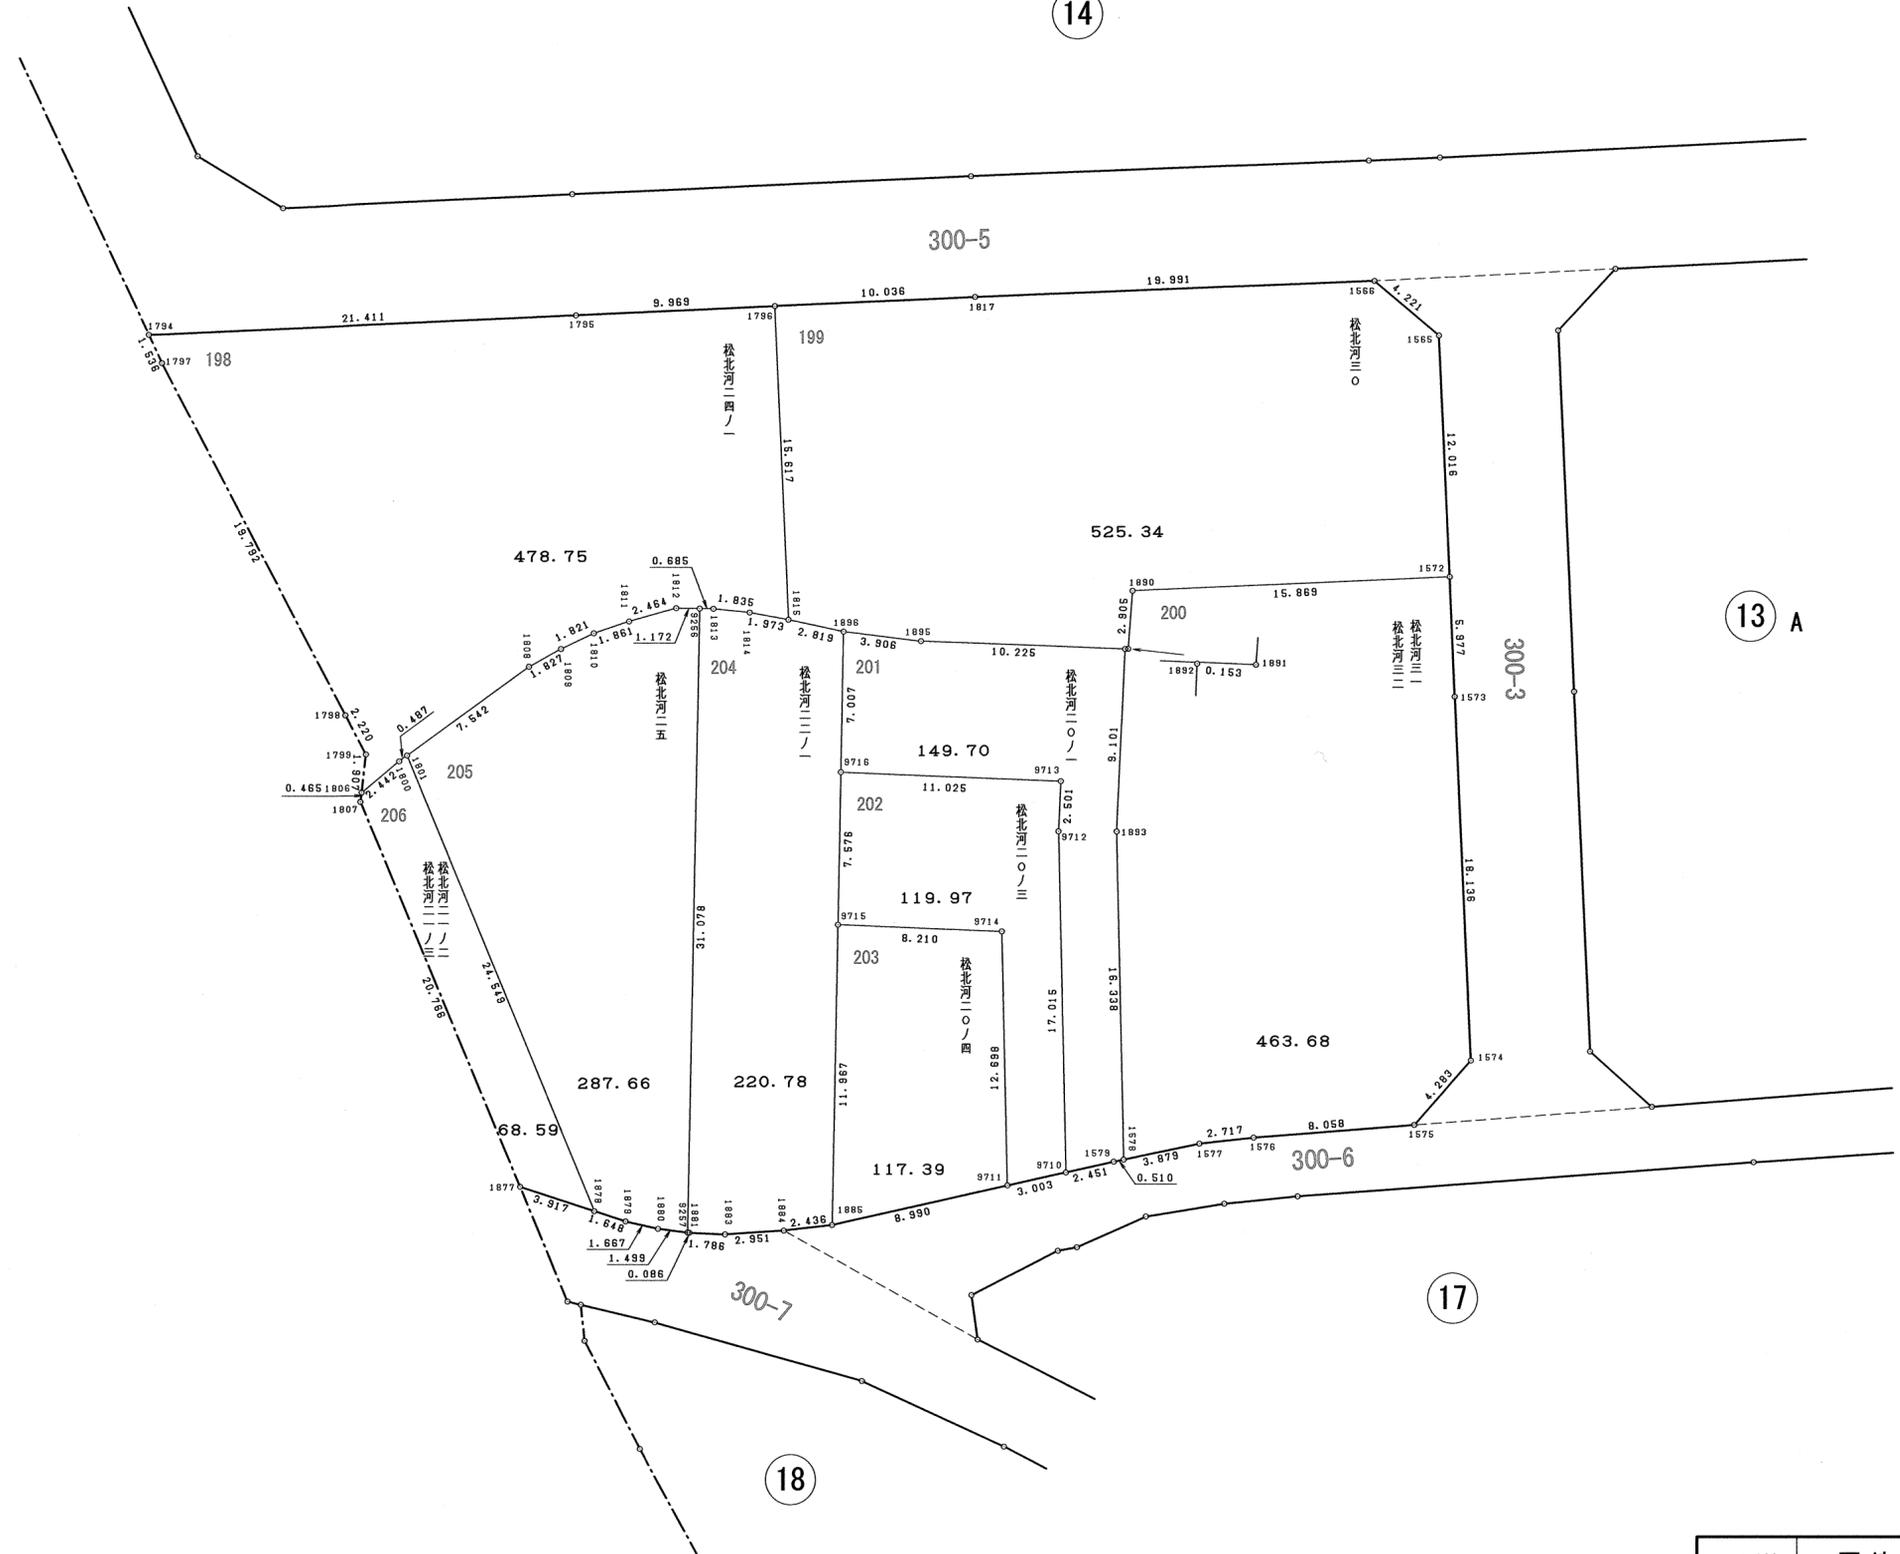

図面の種類	画地出来形確認測量図		
街区番号	15	番号	箱尺 1:250
町名	松室北河原町		
京都市洛西第二土地区画整理組合			

198

地番 松北河二四ノ一			
NO	X	Y	辺長
1794	-111315.418	-28291.107	
1797	-111316.811	-28290.459	1.536
1798	-111334.340	-28281.268	19.792
1799	-111336.306	-28280.236	2.220
1806	-111338.201	-28280.452	1.907
1800	-111336.642	-28278.573	2.442
1801	-111336.358	-28278.177	0.487
1808	-111331.933	-28272.070	7.542
1809	-111331.051	-28270.470	1.827
1810	-111330.269	-28268.825	1.821
1811	-111329.673	-28267.062	1.861
1812	-111329.013	-28264.688	2.464
1813	-111329.037	-28262.831	1.857
1814	-111329.228	-28261.006	1.835
1815	-111329.588	-28259.066	1.973
1796	-111313.986	-28259.760	15.617
1795	-111314.435	-28269.719	9.969
1794	-111315.418	-28291.107	21.411
面積	478.7580465		
地積	478.75 m ²		

199

地番 松北河三〇			
NO	X	Y	辺長
1796	-111313.986	-28259.760	
1815	-111329.588	-28259.066	15.617
1896	-111330.180	-28256.310	2.819
1895	-111330.659	-28252.433	3.906
1892	-111331.047	-28242.215	10.225
1891	-111331.045	-28242.062	0.153
1890	-111328.148	-28241.846	2.905
1572	-111327.437	-28225.993	15.869
1565	-111315.433	-28226.533	12.016
1566	-111312.712	-28229.760	4.221
1817	-111313.534	-28249.734	19.991
1796	-111313.986	-28259.760	10.036
面積	525.3468025		
地積	525.34 m ²		

200

地番 松北河三一, 松北河三二			
NO	X	Y	辺長
1890	-111328.148	-28241.846	
1891	-111331.045	-28242.062	2.905
1892	-111331.047	-28242.215	0.153
1893	-111340.138	-28242.637	9.101
1578	-111356.472	-28242.275	16.338
1577	-111355.680	-28238.478	3.879
1576	-111355.373	-28235.778	2.717
1575	-111354.738	-28227.745	8.058
1574	-111351.526	-28224.912	4.283
1573	-111333.408	-28225.724	18.136
1572	-111327.437	-28225.993	5.977
1890	-111328.148	-28241.846	15.869
面積	463.6880435		
地積	463.68 m ²		

201

地番 松北河二〇ノ一			
NO	X	Y	辺長
1896	-111330.180	-28256.310	
9716	-111337.186	-28256.443	7.007
9713	-111337.600	-28245.426	11.025
9712	-111340.099	-28245.536	2.501
9710	-111357.110	-28245.166	17.015
1579	-111356.576	-28242.774	2.451
1578	-111356.472	-28242.275	0.510
1893	-111340.138	-28242.637	16.338
1892	-111331.047	-28242.215	9.101
1895	-111330.659	-28252.433	10.225
1896	-111330.180	-28256.310	3.906
面積	149.7042635		
地積	149.70 m ²		

202

地番 松北河二〇ノ三			
NO	X	Y	辺長
9716	-111337.186	-28256.443	
9715	-111344.761	-28256.587	7.576
9714	-111345.070	-28248.383	8.210
9711	-111357.765	-28248.097	12.698
9710	-111357.110	-28245.166	3.003
9712	-111340.099	-28245.536	17.015
9713	-111337.600	-28245.426	2.501
9716	-111337.186	-28256.443	11.025
面積	119.9723945		
地積	119.97 m ²		

203

地番 松北河二〇ノ四			
NO	X	Y	辺長
9715	-111344.761	-28256.587	
1885	-111359.725	-28256.871	14.967
9711	-111357.765	-28248.097	8.990
9714	-111345.070	-28248.383	12.698
9715	-111344.761	-28256.587	8.210
面積	117.3994510		
地積	117.39 m ²		

204

地番 松北河二二ノ一			
NO	X	Y	辺長
1885	-111359.725	-28256.871	
9715	-111344.761	-28256.587	14.967
9716	-111337.186	-28256.443	7.576
1896	-111330.180	-28256.310	7.007
1815	-111329.588	-28259.066	2.819
1814	-111329.228	-28261.006	1.973
1813	-111329.037	-28262.831	1.835
9256	-111329.028	-28263.516	0.685
9257	-111360.100	-28264.105	31.078
1881	-111360.110	-28264.020	0.086
1883	-111360.196	-28262.236	1.786
1884	-111360.001	-28259.291	2.951
1885	-111359.725	-28256.871	2.436
面積	220.7833595		
地積	220.78 m ²		

205

地番 松北河二五			
NO	X	Y	辺長
9256	-111329.028	-28263.516	
1812	-111329.013	-28264.688	1.172
1811	-111329.673	-28267.062	2.464
1810	-111330.269	-28268.825	1.861
1809	-111331.051	-28270.470	1.821
1808	-111331.933	-28272.070	1.827
1801	-111336.358	-28278.177	7.542
1878	-111359.040	-28268.786	24.549
1879	-111359.549	-28267.219	1.648
1880	-111359.917	-28265.593	1.667
9257	-111360.100	-28264.105	1.499
9256	-111329.028	-28263.516	31.078
面積	287.6618430		
地積	287.66 m ²		

206

地番 松北河二一ノ二, 松北河二一ノ三			
NO	X	Y	辺長
1806	-111338.201	-28280.452	
1807	-111338.663	-28280.505	0.465
1877	-111357.829	-28272.511	20.766
1878	-111359.040	-28268.786	3.917
1801	-111336.358	-28278.177	24.549
1800	-111336.642	-28278.573	0.487
1806	-111338.201	-28280.452	2.442
面積	68.5998330		
地積	68.59 m ²		

図面の種類	画地面積求積表		
街区番号	15	番号	/
町名	松室北河原町		
京都市洛西第二土地区画整理組合			