



S = 1 : 250

13 A

13 B

17

19

21

松北河三八A

松北河五〇

松北河五一

西 芳 寺 川

松 室 荒 堀 町

図面の種類	画地出来形確認測量図				
街区番号	16	番号	／	縮尺	1：250
町名	松室北河原町				
京都市洛西第二土地区画整理組合					

184

地番	松北河三八A		
N O	X	Y	辺長
1601	-111346.981	-28174.539	
1600	-111351.117	-28177.167	4.900
1832	-111371.409	-28176.256	20.312
1831	-111373.899	-28173.567	3.665
1830	-111374.012	-28162.871	10.697
848	-111369.034	-28163.503	5.018
1625	-111343.580	-28166.737	25.659
1626	-111343.840	-28166.924	0.320
1601	-111346.981	-28174.539	8.237
面積	332.0303535		
地積	332.03㎡		

185

地番	松北河五〇		
N O	X	Y	辺長
1625	-111343.580	-28166.737	
848	-111369.034	-28163.503	25.659
849	-111368.749	-28161.251	2.270
850	-111368.348	-28158.102	3.174
1827	-111373.933	-28157.393	5.630
1676	-111373.439	-28147.322	10.083
1823	-111372.858	-28140.967	6.382
1822	-111372.834	-28140.542	0.426
1824	-111362.648	-28141.543	10.235
1825	-111352.565	-28142.502	10.129
1826	-111345.815	-28143.352	6.803
1628	-111335.933	-28144.850	9.995
1629	-111336.022	-28145.116	0.280
1622	-111338.083	-28151.821	7.015
1623	-111339.938	-28156.638	5.162
1632	-111342.829	-28163.325	7.285
1624	-111343.346	-28166.569	3.285
1625	-111343.580	-28166.737	0.288
面積	745.6244795		
地積	745.62㎡		

186

地番	松北河三八B		
N O	X	Y	辺長
848	-111369.034	-28163.503	
1830	-111374.012	-28162.871	5.018
1829	-111373.991	-28160.582	2.289
849	-111368.749	-28161.251	5.285
848	-111369.034	-28163.503	2.270
面積	11.7017815		
地積	11.70㎡		


187

地番	松荒堀一九A		
N O	X	Y	辺長
849	-111368.749	-28161.251	
1829	-111373.991	-28160.582	5.285
1828	-111373.968	-28158.117	2.465
1827	-111373.933	-28157.393	0.725
850	-111368.348	-28158.102	5.630
849	-111368.749	-28161.251	3.174
面積	17.3483185		
地積	17.34㎡		


188

地番	松北河五一		
N O	X	Y	辺長
1628	-111335.933	-28144.850	
1826	-111345.815	-28143.352	9.995
1825	-111352.565	-28142.502	6.803
1824	-111362.648	-28141.543	10.129
1822	-111372.834	-28140.542	10.235
1675	-111372.026	-28126.531	14.034
1674	-111371.168	-28125.775	1.144
1610	-111346.880	-28127.400	24.342
1611	-111343.330	-28128.644	3.762
1612	-111338.006	-28129.011	5.337
1613	-111335.795	-28130.244	2.532
1614	-111334.732	-28131.521	1.662
1615	-111334.038	-28132.763	1.423
1616	-111333.637	-28133.903	1.208
1617	-111333.561	-28134.509	0.611
1618	-111333.505	-28136.016	1.508
1619	-111333.685	-28137.226	1.223
1620	-111334.045	-28138.623	1.443
1621	-111335.394	-28143.238	4.808
1628	-111335.933	-28144.850	1.700
面積	579.7030520		
地積	579.70㎡		

図面の種類	画 地 面 積 求 積 表				
街 区 番 号	16	番 号	/		
町 名	松 室 北 河 原 町				
京 都 市 洛 西 第 二 土 地 区 画 整 理 組 合					

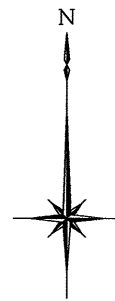

S = 1 : 250

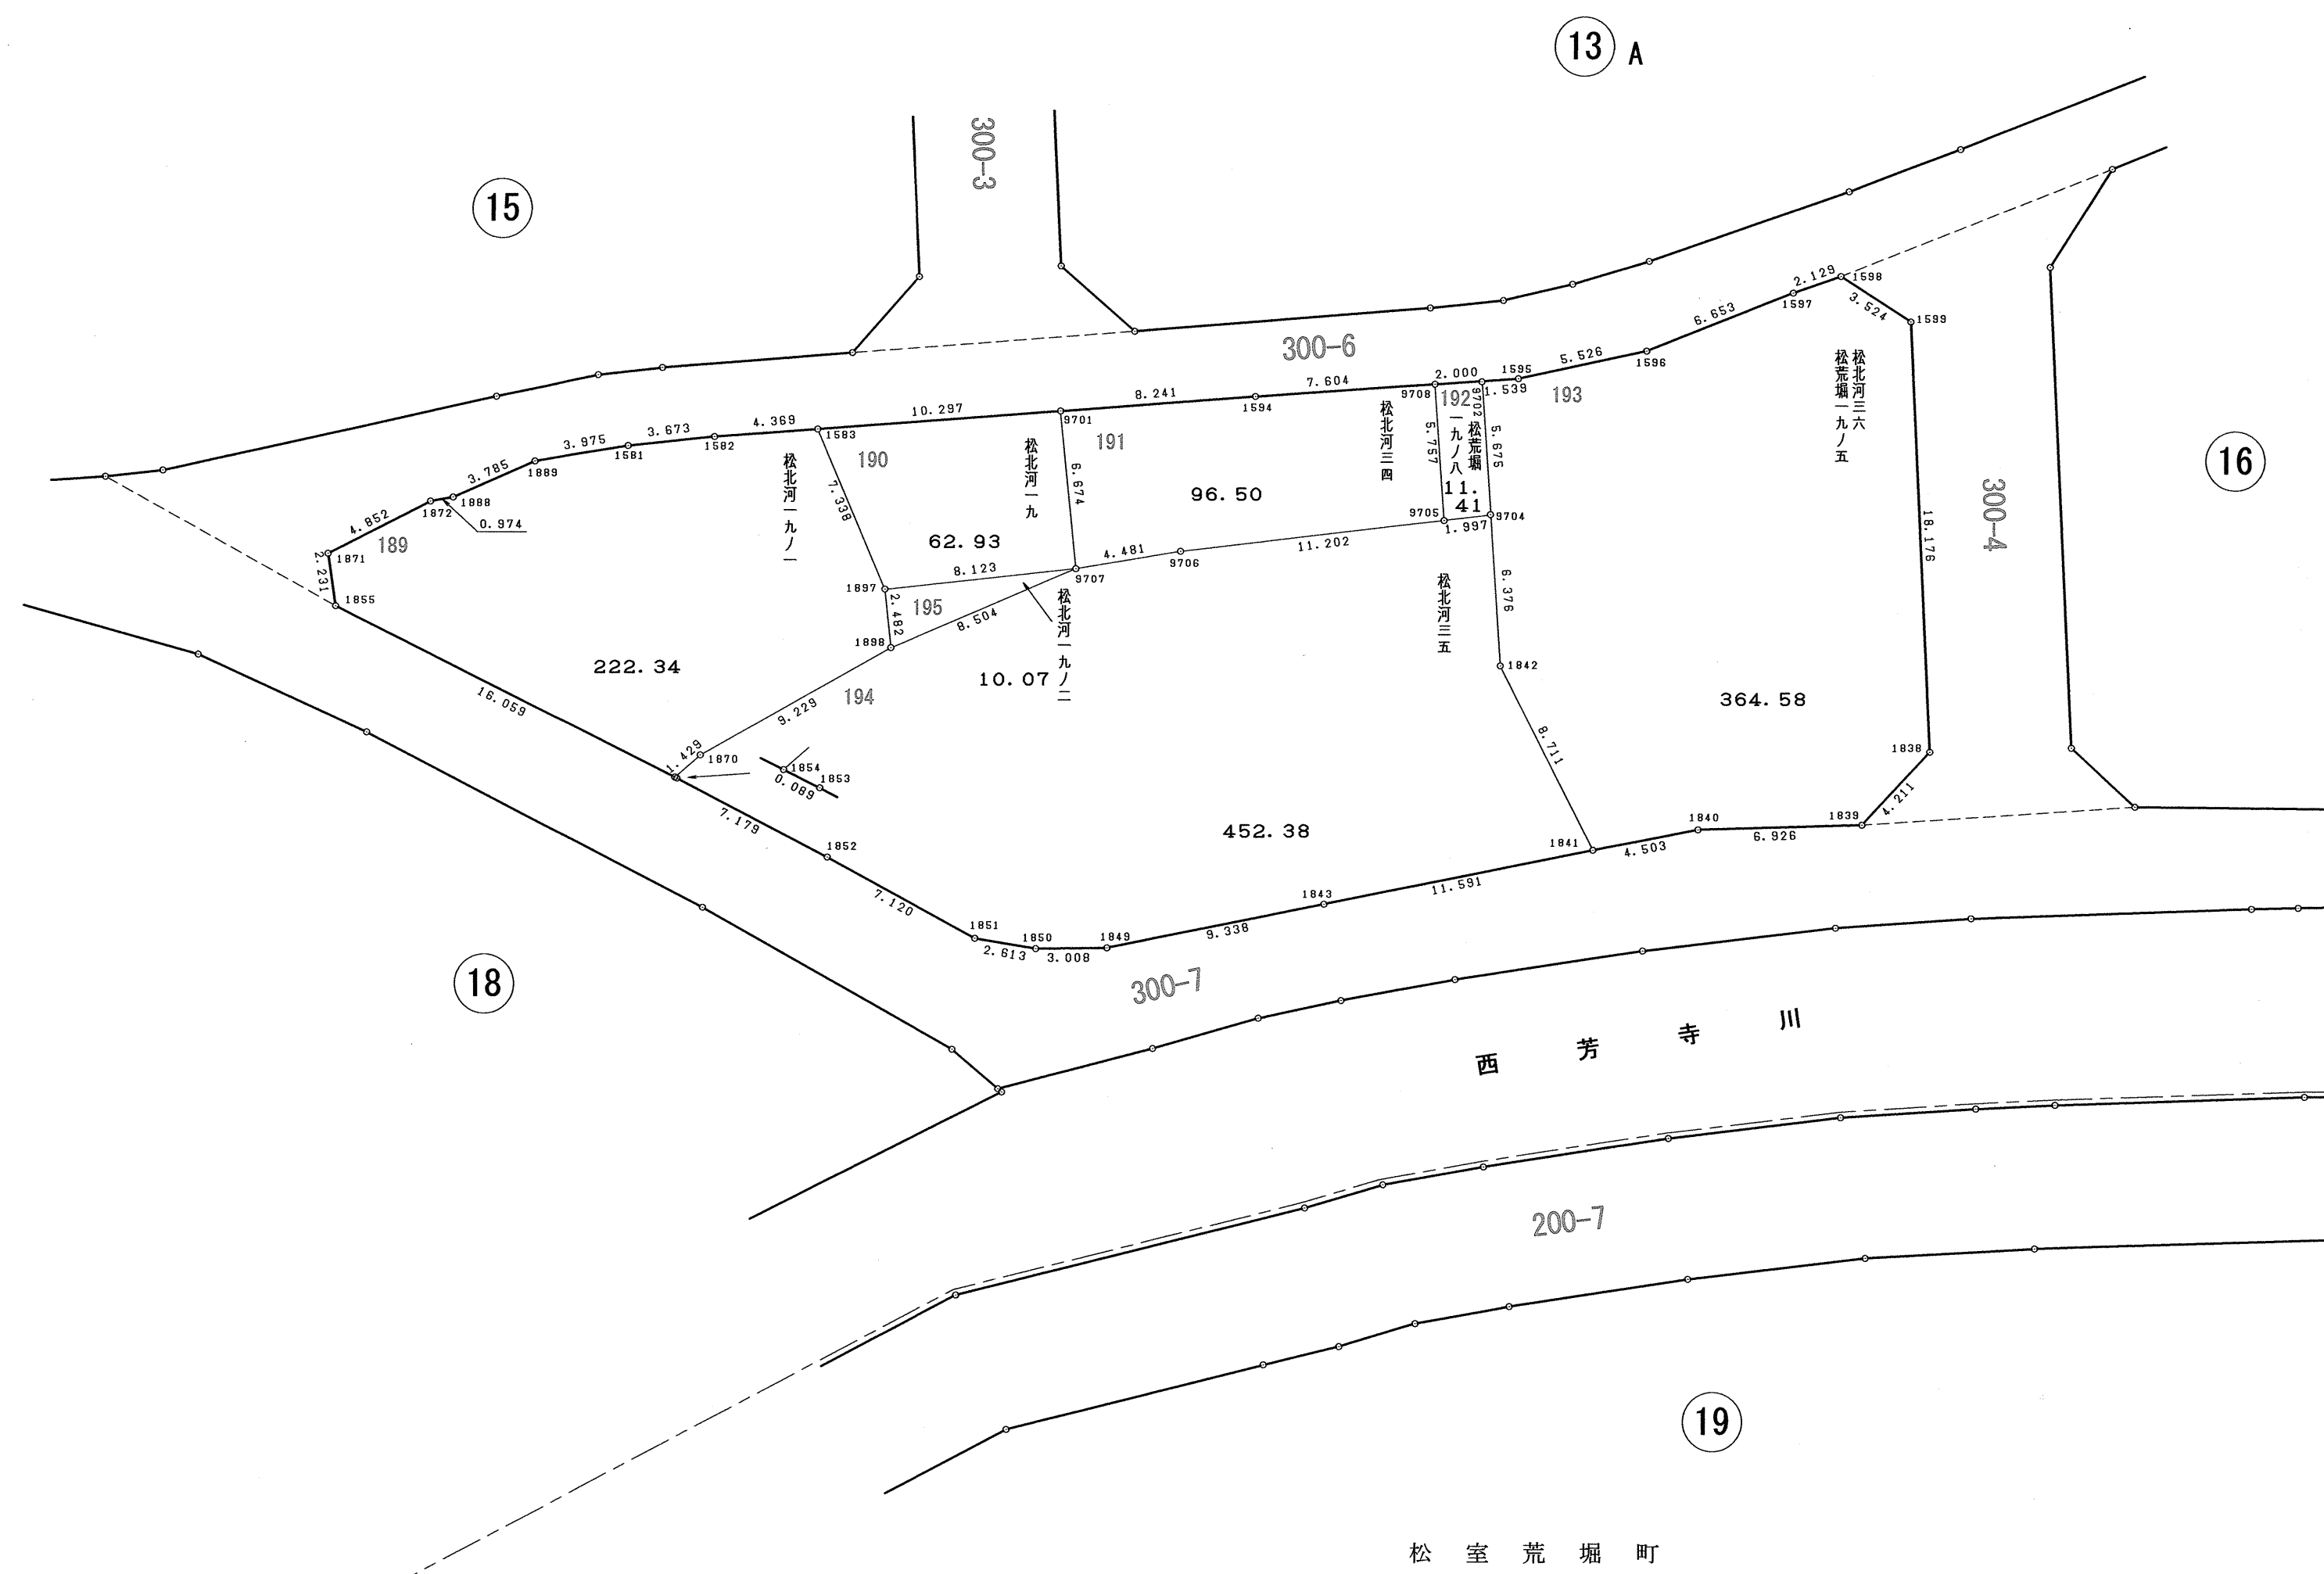

図面の種類	画 地 出 来 形 確 認 測 量 図				
街区 番号	17	番号		縮 尺	1 : 2 5 0
町 名	松 室 北 河 原 町				
京 都 市 洛 西 第 二 土 地 区 画 整 理 組 合					

189

地番	松北河一九ノ一		
N O	X	Y	辺長
1871	-111363.222	-28249.888	
1855	-111365.431	-28249.574	2.231
1854	-111372.665	-28235.237	16.059
1870	-111371.731	-28234.156	1.429
1898	-111367.199	-28226.116	9.229
1897	-111364.731	-28226.376	2.482
1583	-111357.964	-28229.213	7.338
1582	-111358.288	-28233.570	4.369
1581	-111358.674	-28237.223	3.673
1889	-111359.311	-28241.147	3.975
1888	-111360.841	-28244.609	3.785
1872	-111361.016	-28245.567	0.974
1871	-111363.222	-28249.888	4.852
面積	222.3491185		
地積	222.34	㎡	

190

地番	松北河一九		
N O	X	Y	辺長
1583	-111357.964	-28229.213	
1897	-111364.731	-28226.376	7.338
9707	-111363.843	-28218.302	8.123
9701	-111357.200	-28218.944	6.674
1583	-111357.964	-28229.213	10.297
面積	62.9317345		
地積	62.93	㎡	

191

地番	松北河三四		
N O	X	Y	辺長
9701	-111357.200	-28218.944	
9707	-111363.843	-28218.302	6.674
9706	-111363.065	-28213.889	4.481
9705	-111361.817	-28202.757	11.202
9708	-111356.073	-28203.140	5.757
1594	-111356.589	-28210.726	7.604
9701	-111357.200	-28218.944	8.241
面積	96.5086150		
地積	96.50	㎡	

192

地番	松荒堀一九ノ八		
N O	X	Y	辺長
9708	-111356.073	-28203.140	
9705	-111361.817	-28202.757	5.757
9704	-111361.600	-28200.772	1.997
9702	-111355.937	-28201.145	5.675
9708	-111356.073	-28203.140	2.000
面積	11.4166820		
地積	11.41	㎡	

193

地番	松北河三六, 松荒堀一九ノ五		
N O	X	Y	辺長
9702	-111355.937	-28201.145	
9704	-111361.600	-28200.772	5.675
1842	-111367.964	-28200.375	6.376
1841	-111375.742	-28196.452	8.711
1840	-111374.855	-28192.037	4.503
1839	-111374.661	-28185.114	6.926
1838	-111371.579	-28182.245	4.211
1599	-111353.421	-28183.055	18.176
1598	-111351.508	-28186.015	3.524
1597	-111352.202	-28188.028	2.129
1596	-111354.657	-28194.211	6.653
1595	-111355.833	-28199.610	5.526
9702	-111355.937	-28201.145	1.539
面積	364.5823515		
地積	364.58	㎡	

194

地番	松北河三五		
N O	X	Y	辺長
1854	-111372.665	-28235.237	
1853	-111372.705	-28235.157	0.089
1852	-111376.037	-28228.798	7.179
1851	-111379.463	-28222.556	7.120
1850	-111379.898	-28219.979	2.613
1849	-111379.865	-28216.971	3.008
1843	-111378.024	-28207.816	9.338
1841	-111375.742	-28196.452	11.591
1842	-111367.964	-28200.375	8.711
9704	-111361.600	-28200.772	6.376
9705	-111361.817	-28202.757	1.997
9706	-111363.065	-28213.889	11.202
9707	-111363.843	-28218.302	4.481
1898	-111367.199	-28226.116	8.504
1870	-111371.731	-28234.156	9.229
1854	-111372.665	-28235.237	1.429
面積	452.3804075		
地積	452.38	㎡	

195

地番	松北河一九ノ二		
N O	X	Y	辺長
1897	-111364.731	-28226.376	
1898	-111367.199	-28226.116	2.482
9707	-111363.843	-28218.302	8.504
1897	-111364.731	-28226.376	8.123
面積	10.0787560		
地積	10.07	㎡	

図面の種類	画 地 面 積 求 積 表			
街区番号	17	番号	／	
町 名	松 室 北 河 原 町			
京 都 市 洛 西 第 二 土 地 区 画 整 理 組 合				


Y-28300

Y-28250

Y-28200

X-111350

X-111350

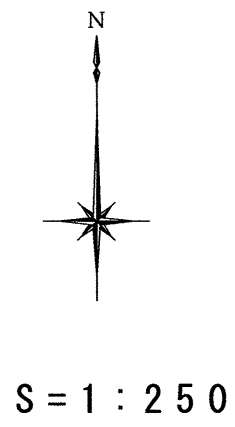

S=1:250


X-111400

X-111400

Y-28300

Y-28250

Y-28200

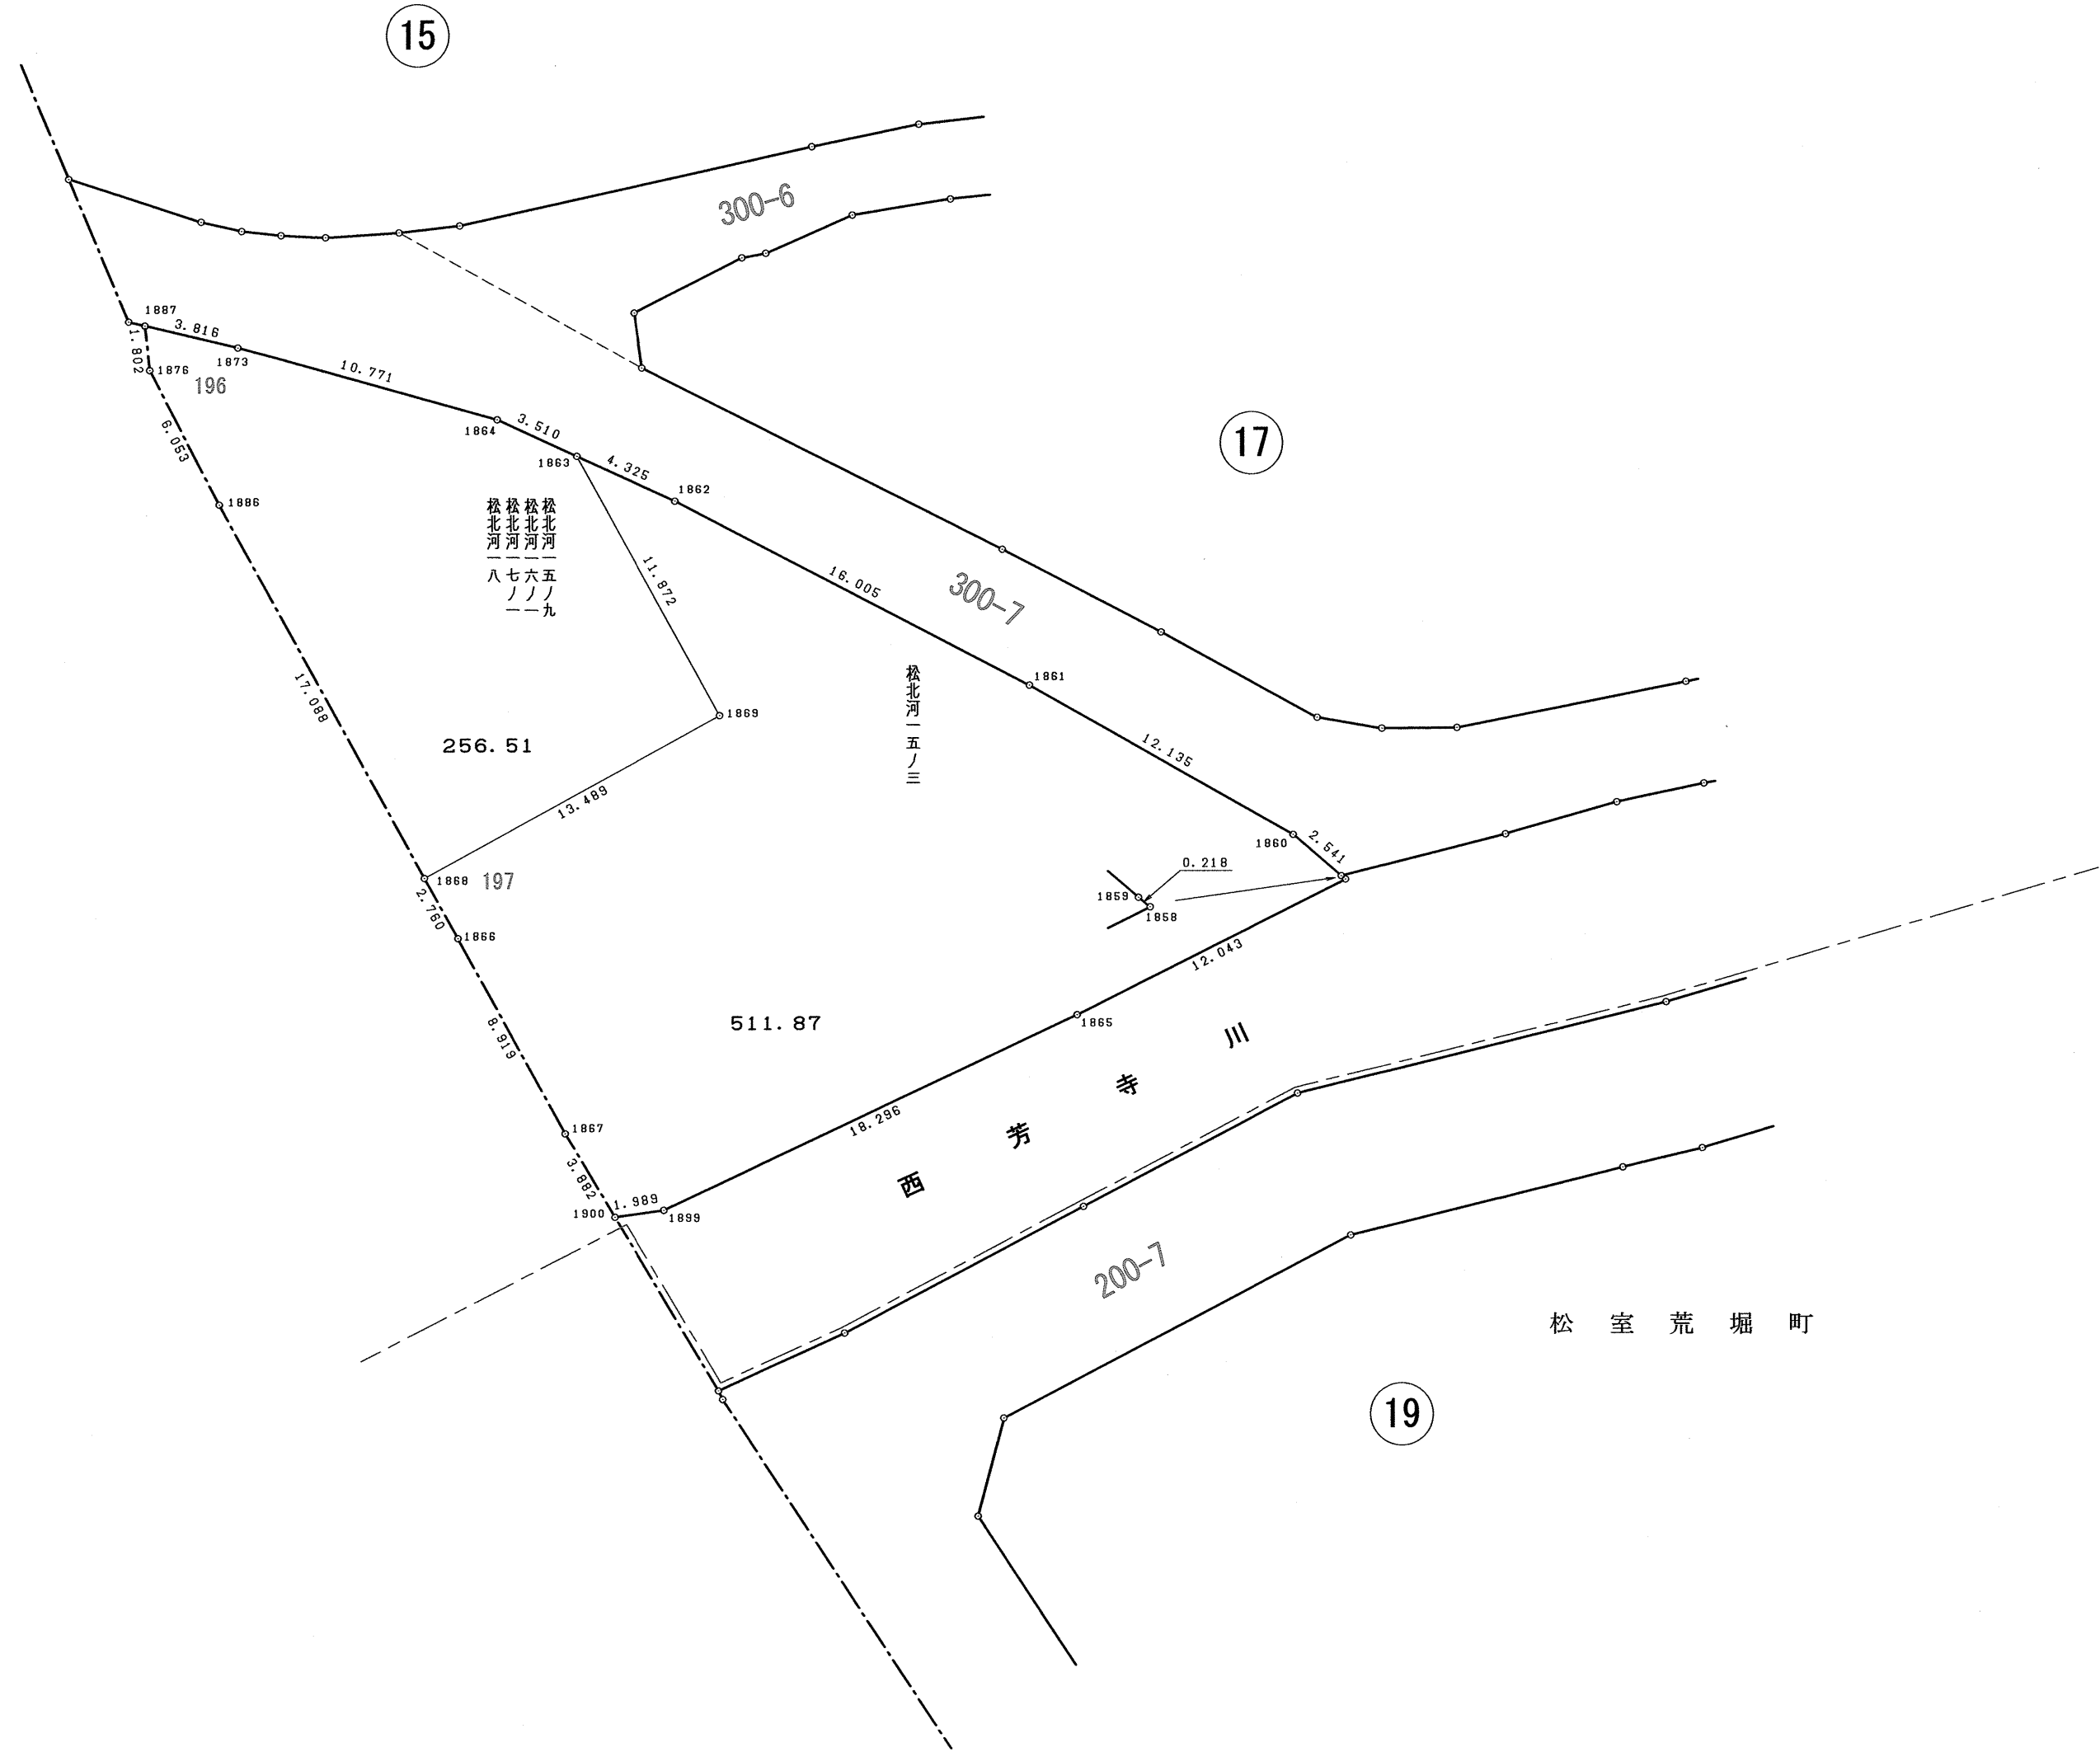

図面の種類	画地出来形確認測量図				
街区番号	18	番号		縮尺	1:250
町名	松室北河原町				
京都市洛西第二土地区画整理組合					


196

地番	松北河一五ノ九, 松北河一六ノ一 松北河一七ノ一, 松北河一八		
N O	X	Y	辺長
1887	-111363.701	-28269.464	
1876	-111365.493	-28269.273	1.802
1886	-111370.877	-28266.507	6.053
1868	-111385.859	-28258.289	17.088
1869	-111379.358	-28246.470	13.489
1863	-111368.955	-28252.190	11.872
1864	-111367.490	-28255.380	3.510
1873	-111364.579	-28265.750	10.771
1887	-111363.701	-28269.464	3.816
面積	256.5171425		
地積	256.51 ㎡		

197

地番	松北河一五ノ三		
N O	X	Y	辺長
1868	-111385.859	-28258.289	
1866	-111388.279	-28256.962	2.760
1867	-111396.096	-28252.668	8.919
1900	-111399.436	-28250.690	3.882
1899	-111399.165	-28248.720	1.989
1865	-111391.356	-28232.174	18.296
1858	-111385.941	-28221.417	12.043
1859	-111385.801	-28221.584	0.218
1860	-111384.145	-28223.511	2.541
1861	-111378.162	-28234.069	12.135
1862	-111370.760	-28248.260	16.005
1863	-111368.955	-28252.190	4.325
1869	-111379.358	-28246.470	11.872
1868	-111385.859	-28258.289	13.489
面積	511.8761800		
地積	511.87 ㎡		

図面の種類	画 地 面 積 求 積 表				
街区番号	18	番号	/		
町 名	松 室 北 河 原 町				
京 都 市 洛 西 第 二 土 地 区 画 整 理 組 合					

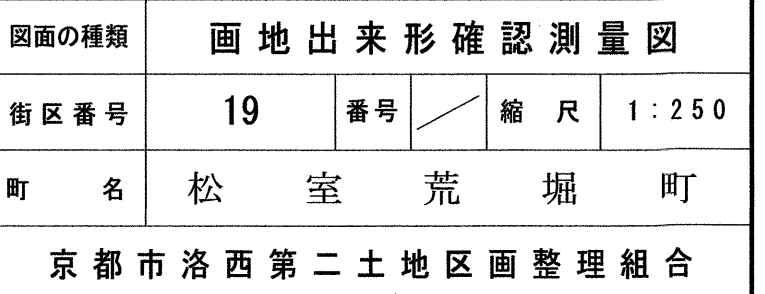

51			
地番	松荒堀三二ノ一		
N O	X	Y	辺 長
3056	-111407.506	-28235.111	
3069	-111411.424	-28236.152	4.054
3068	-111412.636	-28235.359	1.448
3061	-111406.901	-28224.453	12.322
3057	-111401.861	-28224.399	5.040
3056	-111407.506	-28235.111	12.108
面積	56.2889080		
地積	56.28 m ²		

52

地番	松荒堀一九ノ四		
N O	X	Y	辺 長
3057	-111401.861	-28224.399	
3061	-111406.901	-28224.453	5.040
3062	-111412.847	-28224.531	5.947
3170	-111423.660	-28224.671	10.814
3169	-111423.148	-28216.149	8.537
3059	-111398.710	-28215.335	24.452
3058	-111400.188	-28221.224	6.072
3057	-111401.861	-28224.399	3.589
面積	204.7749095		
地積	204.77 ㎡		

53

地番	松荒堀一九ノ三		
N O	X	Y	辺 長
3059	-111398.710	-28215.335	
3169	-111423.148	-28216.149	24.452
3168	-111422.685	-28208.075	8.087
3035	-111396.684	-28207.152	26.017
3034	-111396.688	-28207.166	0.015
3060	-111397.460	-28210.358	3.284
3059	-111398.710	-28215.335	5.132
面積	203.9875515		
地積	203.98 ㎡		

54			
地 番	松荒堀一九ノ二，松荒堀一九ノ九		
N O	X	Y	辺 長
3035	-111396.684	-28207.152	
3168	-111422.685	-28208.075	26.017
3167	-111429.469	-28208.355	6.790
3070	-111428.942	-28198.682	9.687
927	-111424.473	-28198.784	4.470
3176	-111423.482	-28198.807	0.991
3175	-111423.470	-28198.961	0.154
3174	-111414.009	-28198.994	9.461
3173	-111413.938	-28201.431	2.438
3048	-111413.844	-28205.013	3.583
3036	-111395.833	-28204.319	18.024
3035	-111396.684	-28207.152	2.958
面積	188.9017000		
地積	188.90 ㎡		

55

地番	保 一九ノ四号		
N O	X	Y	辺 長
3036	-111395.833	-28204.319	
3048	-111413.844	-28205.013	18.024
3173	-111413.938	-28201.431	3.583
3172	-111395.133	-28200.704	18.819
3037	-111395.722	-28203.951	3.300
3036	-111395.833	-28204.319	0.384
面積	66.0977390		
地積	66.09 ㎡		

56			
地番	保 一九ノ三号		
N O	X	Y	辺 長
3172	-111395.133	-28200.704	
3173	-111413.938	-28201.431	18.819
3174	-111414.009	-28198.994	2.438
3175	-111423.470	-28198.961	9.461
3176	-111423.482	-28198.807	0.154
3177	-111423.979	-28190.153	8.668
3178	-111424.162	-28186.998	3.160
3179	-111392.988	-28185.318	31.219
3180	-111393.840	-28192.444	7.177
3181	-111395.000	-28199.973	7.618
3172	-111395.133	-28200.704	0.743
面積	423.2520375		
地積	423.25 ㎡		

57

地番	松北河六三ノ四		
N O	X	Y	辺 長
3179	-111392.988	-28185.318	
3178	-111424.162	-28186.998	31.219
3086	-111424.279	-28184.199	2.801
3051	-111424.646	-28177.844	6.366
3039	-111392.490	-28176.103	32.203
3038	-111392.544	-28177.788	1.686
3050	-111392.944	-28184.948	7.171
3179	-111392.988	-28185.318	0.373
面積	290.9276500		
地積	290.92 m ²		

58			
地番	松荒堀一九ノ七		
N O	X	Y	辺 長
3039	-111392.490	-28176.103	
3051	-111424.646	-28177.844	32.203
3109	-111424.894	-28173.507	4.344
3040	-111392.352	-28171.805	32.586
3039	-111392.490	-28176.103	4.300
面積	139.7614900		
地積	139.76 m ²		

59

地番	松荒堀一九B		
N O	X	Y	辺 長
3040	-111392.352	-28171.805	
3109	-111424.894	-28173.507	32.586
3108	-111425.009	-28171.298	2.212
3114	-111425.673	-28158.554	12.761
3115	-111424.896	-28158.525	0.778
932	-111425.194	-28150.963	7.568
3121	-111425.936	-28132.108	18.870
3122	-111408.905	-28131.168	17.057
3123	-111394.341	-28130.380	14.585
3043	-111391.448	-28133.164	4.015
3042	-111391.835	-28143.902	10.745
3041	-111392.175	-28166.267	22.368
3040	-111392.352	-28171.805	5.541
面積	1384.3812280		
地積	1384.38 m ²		

60

地番	松荒堀一九ノ六		
N O	X	Y	辺 長
3121	-111425.936	-28132.108	
932	-111425.194	-28150.963	18.870
9258	-111430.211	-28151.136	5.020
9259	-111430.948	-28132.385	18.765
3121	-111425.936	-28132.108	5.020
面積	94.4540310		
地積	94.45 ㎡		

61

地番	松荒堀二〇ノ一		
N O	X	Y	辺長
9259	-111430.948	-28132.385	
9258	-111430.211	-28151.136	18.765
9260	-111432.730	-28151.223	2.521
9261	-111433.465	-28132.523	18.714
3120	-111432.612	-28132.477	0.854
9259	-111430.948	-28132.385	1.667
面積	47.2326430		
地積	47.23 m ²		

62

地番	松荒堀二〇ノ二，松荒堀二一ノ三		
N O	X	Y	辺長
9260	-111432.730	-28151.223	
933	-111444.312	-28151.621	11.589
3119	-111444.544	-28133.114	18.508
9261	-111433.465	-28132.523	11.095
9260	-111432.730	-28151.223	18.714
面積	211.0260475		
地積	211.02 m ²		

63			
地番	松荒堀二一ノ一		
N O	X	Y	辺長
933	-111444.312	-28151.621	
934	-111446.925	-28151.711	2.615
3118	-111447.164	-28133.253	18.460
3119	-111444.544	-28133.114	2.624
933	-111444.312	-28151.621	18.508
面積	48.3864260		
地積	48.38 ㎡		

64

地番	松荒堀二一ノ六		
N O	X	Y	辺 長
934	-111446.925	-28151.711	
3101	-111451.762	-28151.877	4.840
3116	-111452.603	-28136.515	15.385
3117	-111449.763	-28133.392	4.221
3118	-111447.164	-28133.253	2.603
934	-111446.925	-28151.711	18.460
面積	91.6700985		
地積	91.67 m ²		

65

地番	松荒堀二一ノ一〇		
N O	X	Y	辺長
930	-111446.826	-28159.313	
3100	-111451.346	-28159.467	4.523
3101	-111451.762	-28151.877	7.601
934	-111446.925	-28151.711	4.840
930	-111446.826	-28159.313	7.603
面積	35.5790860		
地積	35.57㎡		

66			
地番	松荒堀二一ノ九		
N O	X	Y	辺長
931	-111444.217	-28159.224	
930	-111446.826	-28159.313	2.611
934	-111446.925	-28151.711	7.603
933	-111444.312	-28151.621	2.615
931	-111444.217	-28159.224	7.604
面積	19.8588090		
地積	19.85 m ²		

67			
地番	松荒堀二〇ノ三		
N O	X	Y	辺長
3115	-111424.896	-28158.525	
3114	-111425.673	-28158.554	0.778
3113	-111429.560	-28158.705	3.890
3112	-111433.615	-28158.854	4.058
3111	-111437.662	-28159.001	4.050
3110	-111441.669	-28159.137	4.009
931	-111444.217	-28159.224	2.549
933	-111444.312	-28151.621	7.604
9260	-111432.730	-28151.223	11.589
9258	-111430.211	-28151.136	2.521
932	-111425.194	-28150.963	5.020
3115	-111424.896	-28158.525	7.568
面積	146.0352395		
地積	146.03㎡		

68

地番	松荒堀二二ノ二四		
N O	X	Y	辺長
929	-111441.439	-28163.828	
3098	-111451.090	-28164.162	9.657
3099	-111451.291	-28160.472	3.695
3100	-111451.346	-28159.467	1.007
930	-111446.826	-28159.313	4.523
931	-111444.217	-28159.224	2.611
3110	-111441.669	-28159.137	2.549
929	-111441.439	-28163.828	4.697
面積	45.4325790		
地積	45.43㎡		

69			
地番	松荒堀二二ノ二三		
N O	X	Y	辺長
3103	-111441.177	-28169.168	
3096	-111447.778	-28169.528	6.611
3097	-111450.952	-28166.682	4.263
3098	-111451.090	-28164.162	2.524
929	-111441.439	-28163.828	9.657
3103	-111441.177	-28169.168	5.346
面積	47.9214330		
地積	47.92 m ²		

70				
地番	松荒堀二二ノ二二			
N O	X	Y	辺 長	
3104	-111437.184	-28168.960		
3103	-111441.177	-28169.168	3.998	
929	-111441.439	-28163.828	5.346	
3110	-111441.669	-28159.137	4.697	
3111	-111437.662	-28159.001	4.009	
3104	-111437.184	-28168.960	9.970	
面積				40.0638410
地積				40.06 m ²

80			
地番	松荒堀二二ノ一八		
N O	X	Y	辺長
3086	-111424.279	-28184.199	
3085	-111425.280	-28184.245	1.002
3084	-111428.223	-28184.405	2.947
3094	-111428.761	-28174.499	9.921
3093	-111429.867	-28174.566	1.108
3095	-111430.028	-28171.570	3.000
3108	-111425.009	-28171.298	5.026
3109	-111424.894	-28173.507	2.212
3051	-111424.646	-28177.844	4.344
3086	-111424.279	-28184.199	6.366
面積	54.0608180		
地積	54.06㎡		

81			
地番	松荒堀二四ノ四		
N O	X	Y	辺長
928	-111424.978	-28190.207	
3075	-111449.595	-28191.538	24.653
3078	-111449.923	-28185.554	5.993
3081	-111440.351	-28185.057	9.585
3082	-111436.306	-28184.842	4.051
3083	-111432.264	-28184.631	4.048
3084	-111428.223	-28184.405	4.047
3085	-111425.280	-28184.245	2.947
928	-111424.978	-28190.207	5.970
面積	147.3335490		
地積	147.33㎡		

82			
地番	松荒堀二四ノ五		
N O	X	Y	辺長
3177	-111423.979	-28190.153	
928	-111424.978	-28190.207	1.000
3085	-111425.280	-28184.245	5.970
3086	-111424.279	-28184.199	1.002
3178	-111424.162	-28186.998	2.801
3177	-111423.979	-28190.153	3.160
面積	5.9015090		
地積	5.90㎡		

83			
地番	松荒堀二五ノ三		
N O	X	Y	辺長
927	-111424.473	-28198.784	
3070	-111428.942	-28198.682	4.470
3074	-111449.092	-28200.704	20.251
3075	-111449.595	-28191.538	9.180
928	-111424.978	-28190.207	24.653
927	-111424.473	-28198.784	8.592
面積	213.6720300		
地積	213.67㎡		

84			
地番	松荒堀二五ノ四		
N O	X	Y	辺長
3176	-111423.482	-28198.807	
927	-111424.473	-28198.784	0.991
928	-111424.978	-28190.207	8.592
3177	-111423.979	-28190.153	1.000
3176	-111423.482	-28198.807	8.668
面積	8.5801880		
地積	8.58㎡		


85			
地番	松荒堀二五ノ一		
N O	X	Y	辺長
3166	-111430.374	-28223.005	
3071	-111433.074	-28221.049	3.334
3072	-111446.159	-28211.587	16.148
3073	-111448.755	-28206.848	5.403
3074	-111449.092	-28200.704	6.153
3070	-111428.942	-28198.682	20.251
3167	-111429.469	-28208.355	9.687
3171	-111429.943	-28216.396	8.055
3166	-111430.374	-28223.005	6.623
面積	320.5922740		
地積	320.59㎡		

86			
地番	保 一九ノ二号		
N O	X	Y	辺長
3165	-111423.827	-28227.747	
3166	-111430.374	-28223.005	8.084
3171	-111429.943	-28216.396	6.623
3167	-111429.469	-28208.355	8.055
3168	-111422.685	-28208.075	6.790
3169	-111423.148	-28216.149	8.087
3170	-111423.660	-28224.671	8.537
3165	-111423.827	-28227.747	3.081
面積	116.4838885		
地積	116.48㎡		

87			
地番	保 一九ノ一号		
N O	X	Y	辺長
3067	-111417.036	-28232.480	
3066	-111419.696	-28230.739	3.179
3165	-111423.827	-28227.747	5.101
3170	-111423.660	-28224.671	3.081
3062	-111412.847	-28224.531	10.814
3067	-111417.036	-28232.480	8.985
面積	53.9061265		
地積	53.90㎡		

88			
地番	松荒堀三一ノ一		
N O	X	Y	辺長
3068	-111412.636	-28235.359	
3067	-111417.036	-28232.480	5.258
3062	-111412.847	-28224.531	8.985
3061	-111406.901	-28224.453	5.947
3068	-111412.636	-28235.359	12.322
面積	55.7177385		
地積	55.71㎡		

図面の種類	画 地 面 積 求 積 表				
街区 番号	19	番号	2 / 2		
町 名	松 室 荒 堀 町				
京都市洛西第二土地区画整理組合					

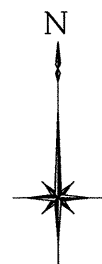

S=1:250

19

23

松 尾 大 利 町

図面の種類	画地出来形確認測量図				
街区番号	20	番号	／	縮尺	1：250
町名	松室荒堀町				
京都市洛西第二土地区画整理組合					

140

地番	松荒堀二四ノ一		
N O	X	Y	辺長
3126	-111454.998	-28202.495	
3127	-111457.327	-28203.792	2.666
3128	-111466.975	-28197.245	11.660
3129	-111474.159	-28192.220	8.767
3131	-111474.523	-28184.911	7.318
3132	-111470.985	-28184.721	3.543
3133	-111467.392	-28184.529	3.598
3124	-111456.028	-28183.907	11.381
3125	-111455.981	-28184.756	0.850
3126	-111454.998	-28202.495	17.766
面積	265.6323895		
地積	265.63㎡		

141

地番	松荒堀二二ノ二		
N O	X	Y	辺長
3124	-111456.028	-28183.907	
3133	-111467.392	-28184.529	11.381
935	-111467.592	-28180.737	3.797
3199	-111456.236	-28180.115	11.373
3124	-111456.028	-28183.907	3.798
面積	43.2040080		
地積	43.20 ㎡		

142

地番	松荒堀二二ノ三		
N O	X	Y	辺長
3199	-111456.236	-28180.115	
935	-111467.592	-28180.737	11.373
936	-111467.785	-28177.045	3.697
3198	-111456.439	-28176.420	11.363
3199	-111456.236	-28180.115	3.701
面積	42.0483715		
地積	42.04 ㎡		

143

地番	松荒堀二ノ四		
N O	X	Y	辺長
3198	-111456.439	-28176.420	
936	-111467.785	-28177.045	11.363
3195	-111467.987	-28173.222	3.828
3196	-111458.139	-28172.672	9.863
3197	-111456.594	-28173.590	1.797
3198	-111456.439	-28176.420	2.834
面積	42.7886860		
地積	42.78 ㎡		

144

地番	松荒堀二二ノ五		
N O	X	Y	辺長
3133	-111467.392	-28184.529	
3132	-111470.985	-28184.721	3.598
3194	-111471.575	-28173.476	11.260
3195	-111467.987	-28173.222	3.597
936	-111467.785	-28177.045	3.828
935	-111467.592	-28180.737	3.697
3133	-111467.392	-28184.529	3.797
面積	40.6199980		
地積	40.61 ㎡		

145			
地番	松荒堀二二ノ六		
N O	X	Y	辺長
3132	-111470.985	-28184.721	
3131	-111474.523	-28184.911	3.543
3193	-111475.151	-28173.626	11.302
3194	-111471.575	-28173.476	3.579
3132	-111470.985	-28184.721	11.260
面積	40.1731350		
地積	40.17 m ²		

146			
地番	松荒堀二二ノ七		
N O	X	Y	辺長
3197	-111456.594	-28173.590	
3196	-111458.139	-28172.672	1.797
3195	-111467.987	-28173.222	9.863
3194	-111471.575	-28173.476	3.597
3193	-111475.151	-28173.626	3.579
3227	-111475.253	-28171.629	2.000
3226	-111456.759	-28170.583	18.524
3197	-111456.594	-28173.590	3.012
面積	38.0434075		
地積	38.04㎡		

147

地番	松荒堀二二ノ八		
N O	X	Y	辺長
3226	-111456.759	-28170.583	
3227	-111475.253	-28171.629	18.524
3192	-111475.327	-28170.691	0.941
3191	-111475.382	-28169.629	1.063
3190	-111471.803	-28169.433	3.584
3189	-111468.200	-28169.230	3.609
3188	-111458.449	-28168.685	9.766
3187	-111456.923	-28167.600	1.872
3226	-111456.759	-28170.583	2.988
面積	37.7851170		
地積	37.78㎡		

148

地番	松荒堀二二ノ九		
N O	X	Y	辺長
3187	-111456.923	-28167.600	
3188	-111458.449	-28168.685	1.872
3189	-111468.200	-28169.230	9.766
937	-111468.276	-28167.864	1.368
3186	-111456.944	-28167.223	11.350
3187	-111456.923	-28167.600	0.378
面積	14.7810260		
地積	14.78 m ²		

149

地番	松荒堀二一ノ一二		
N O	X	Y	辺長
3186	-111456.944	-28167.223	
937	-111468.276	-28167.864	11.350
938	-111468.413	-28165.395	2.473
3185	-111457.079	-28164.766	11.351
3186	-111456.944	-28167.223	2.461
面積	27.9995390		
地積	27.99㎡		

150

地番	松荒堀二一ノ一五		
N O	X	Y	辺長
3185	-111457.079	-28164.766	
938	-111468.413	-28165.395	11.351
939	-111468.618	-28161.697	3.704
3184	-111457.282	-28161.065	11.354
3185	-111457.079	-28164.766	3.707
面積	42.0624545		
地積	42.06 m ²		

151				
地番	松荒堀二一ノ一六			
N O	X	Y	辺長	
3184	-111457.282	-28161.065		
939	-111468.618	-28161.697	11.354	
3200	-111468.828	-28157.899	3.804	
3202	-111457.487	-28157.266	11.359	
3183	-111457.297	-28160.791	3.530	
3184	-111457.282	-28161.065	0.274	
面積				43.2001285
地積				43.20 ㎡

152				
地番	松荒堀二二ノ一〇			
N O	X	Y	辺長	
3189	-111468.200	-28169.230		
3190	-111471.803	-28169.433	3.609	
940	-111471.878	-28168.067	1.368	
937	-111468.276	-28167.864	3.608	
3189	-111468.200	-28169.230	1.368	
面積				4.9363415
地積				4.93 m ²

153				
地番	松荒堀二一ノ一七			
N O	X	Y	辺長	
937	-111468.276	-28167.864		
940	-111471.878	-28168.067	3.608	
3201	-111472.422	-28158.103	9.979	
3200	-111468.828	-28157.899	3.600	
939	-111468.618	-28161.697	3.804	
938	-111468.413	-28165.395	3.704	
937	-111468.276	-28167.864	2.473	
面積	35.9616255			
地積	35.96㎡			

154


地番	松荒堀二二ノ一一		
N O	X	Y	辺長
3190	-111471.803	-28169.433	
3191	-111475.382	-28169.629	3.584
3145	-111475.448	-28168.269	1.362
940	-111471.878	-28168.067	3.576
3190	-111471.803	-28169.433	1.368
面積	4.8860730		
地積	4.88 ㎡		

155

地 番	松荒堀二一ノ一八		
N O	X	Y	辺 長
940	-111471.878	-28168.067	
3145	-111475.448	-28168.269	3.576
3146	-111475.997	-28158.300	9.984
3201	-111472.422	-28158.103	3.580
940	-111471.878	-28168.067	9.979
面積	35.7143480		
地積	35.71 m ²		

156			
地番	松荒堀二一ノ七		
N O	X	Y	辺長
3202	-111457.487	-28157.266	
3200	-111468.828	-28157.899	11.359
3201	-111472.422	-28158.103	3.600
3146	-111475.997	-28158.300	3.580
3147	-111476.605	-28147.383	10.934
941	-111475.110	-28147.289	1.498
3182	-111458.082	-28146.221	17.061
3202	-111457.487	-28157.266	11.061
面積	203.9978785		
地積	203.99 ㎡		

157				
地番	松荒堀二一ノ四			
N O	X	Y	辺長	
3182	-111458.082	-28146.221		
941	-111475.110	-28147.289	17.061	
3149	-111475.184	-28146.147	1.144	
3164	-111475.792	-28134.777	11.386	
3203	-111461.746	-28134.009	14.067	
3204	-111458.587	-28136.835	4.239	
3182	-111458.082	-28146.221	9.400	
面積	208.2483520			
地積	208.24 m ²			

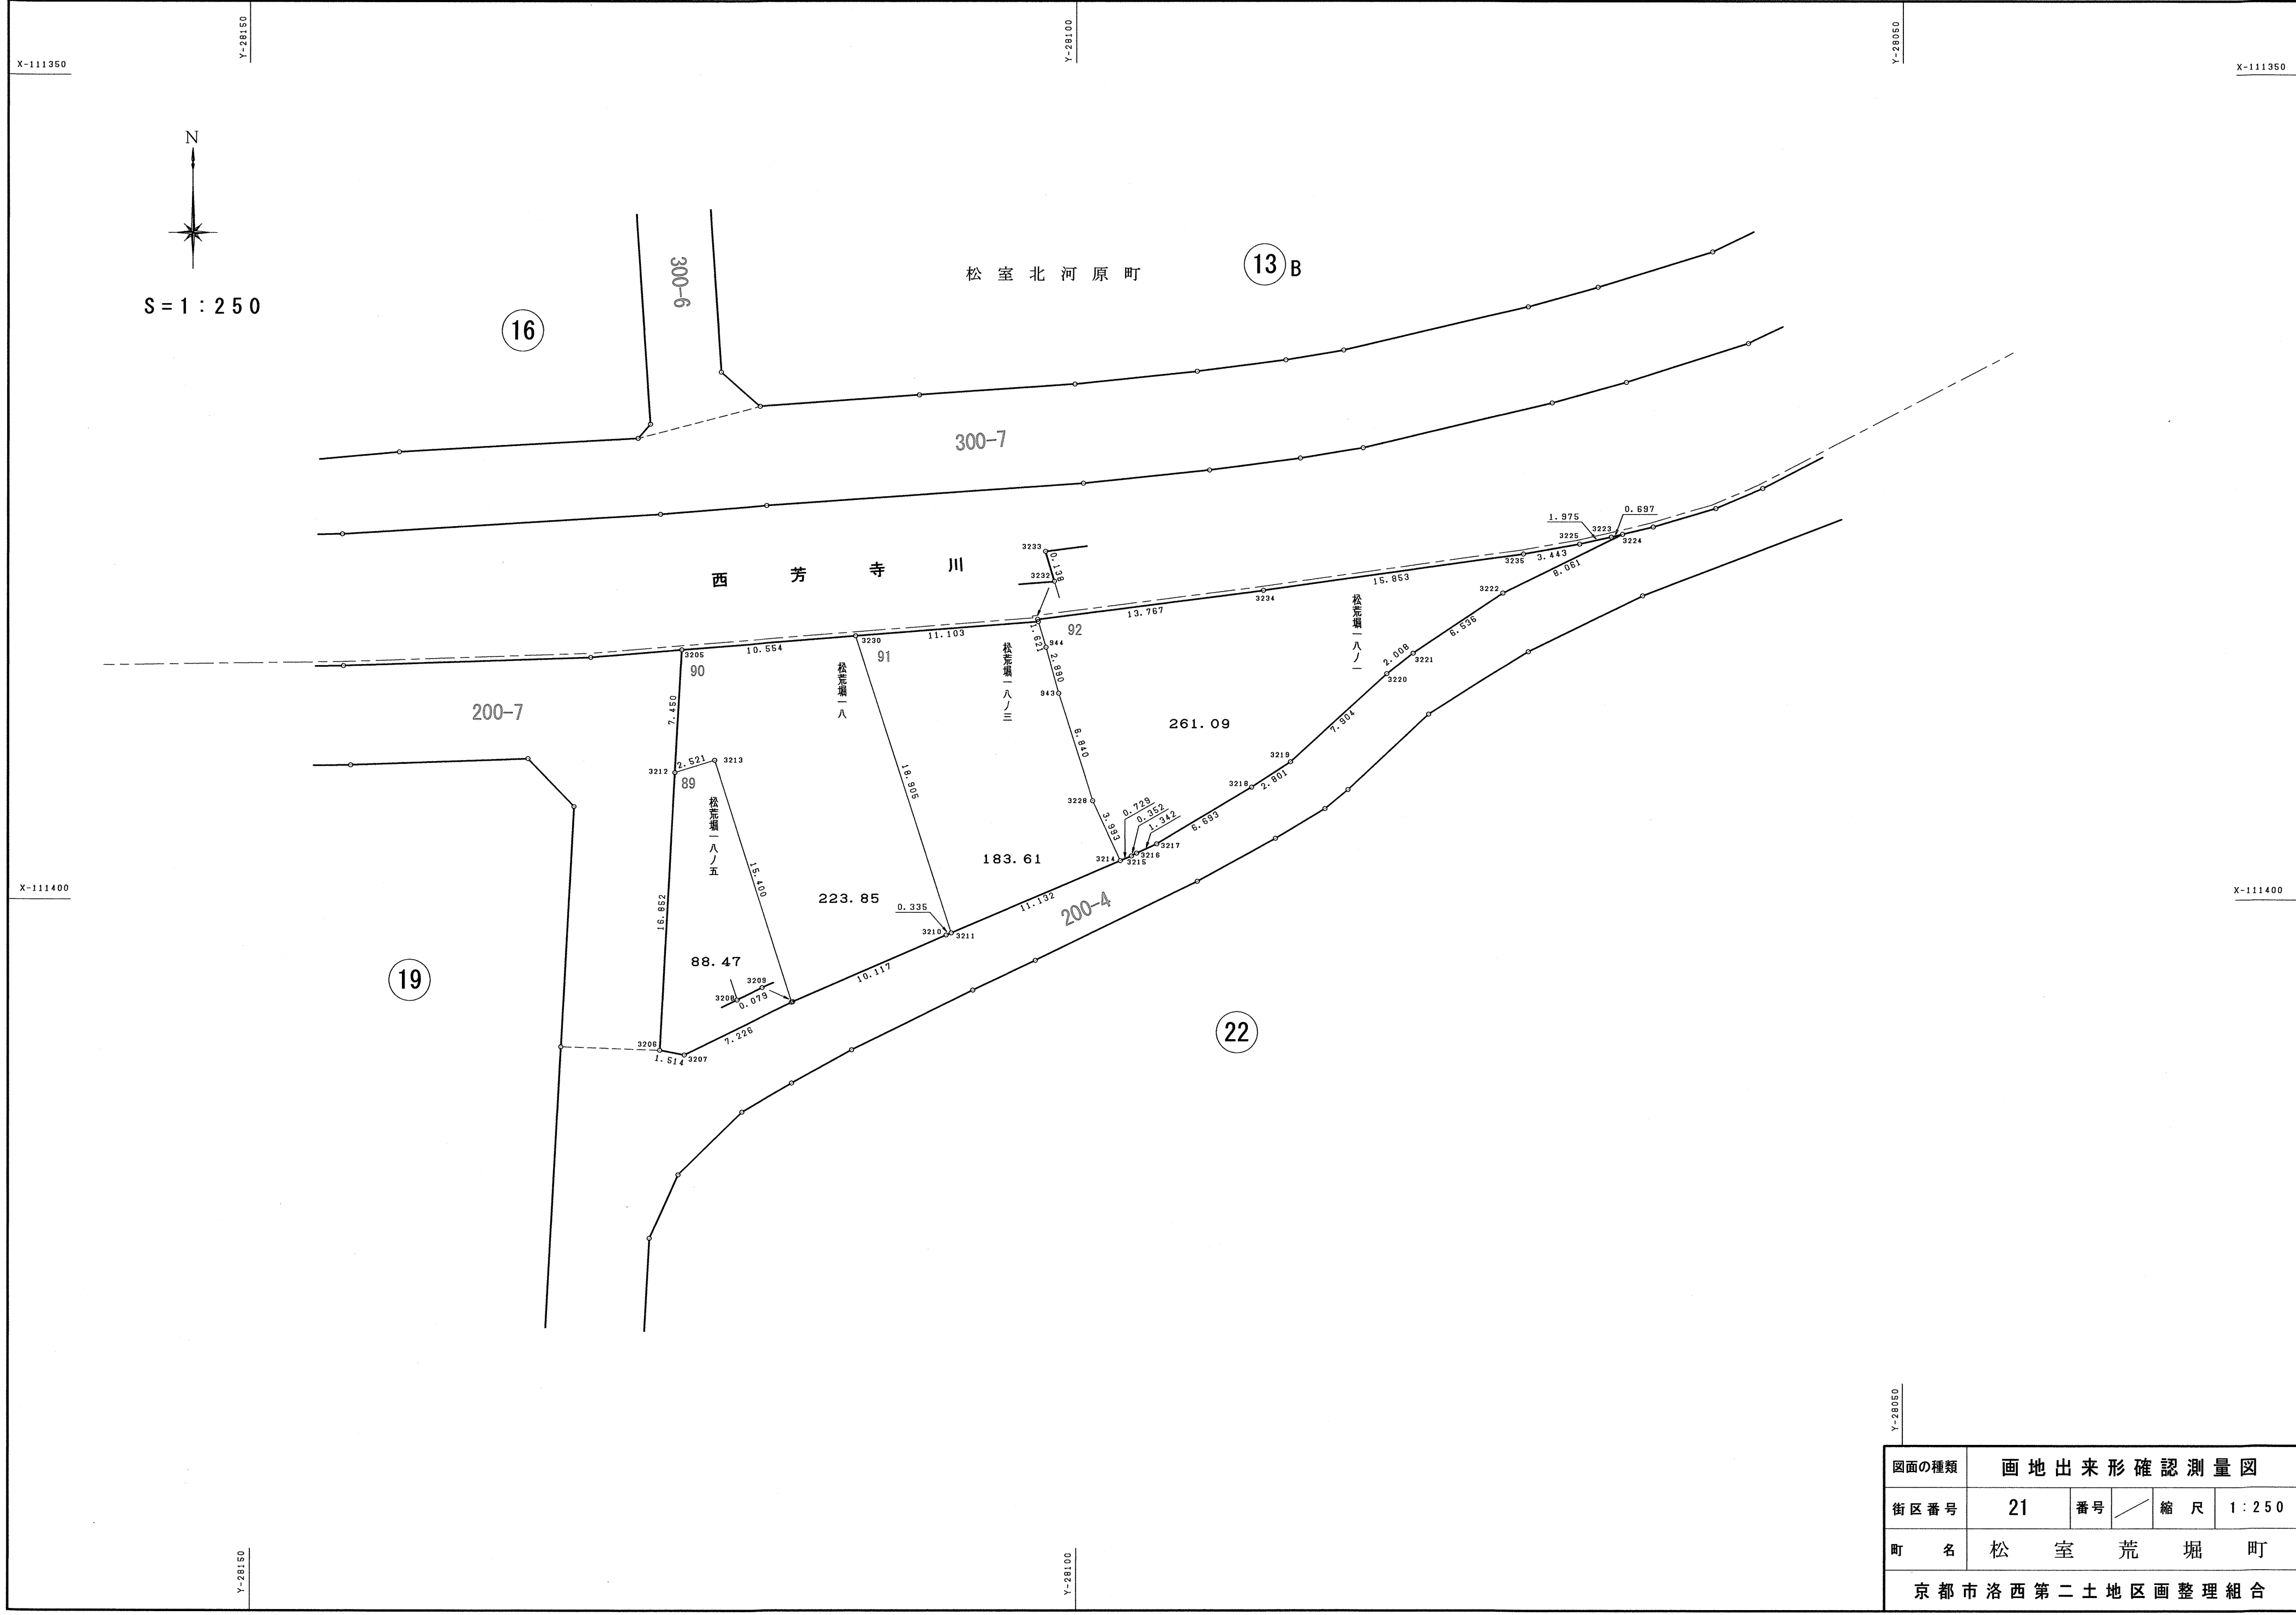

Y-20050

図面の種類	画 地 出 来 形 確 認 測 量 図				
街 区 番 号	21	番 号		縮 尺	1 : 2 5 0
町 名	松 室 荒 堀 町				
京 都 市 洛 西 第 二 土 地 区 画 整 理 組 合					

89

地番	松荒堀一八ノ五		
N O	X	Y	辺長
3212	-111392.281	-28124.259	
3206	-111409.109	-28125.163	16.852
3207	-111409.396	-28123.676	1.514
3208	-111406.209	-28117.191	7.226
3213	-111391.531	-28121.852	15.400
3212	-111392.281	-28124.259	2.521
面積	88.4785880		
地積	88.47㎡		

90

地番	松荒堀一八		
N O	X	Y	辺長
3205	-111384.842	-28123.860	
3212	-111392.281	-28124.259	7.450
3213	-111391.531	-28121.852	2.521
3208	-111406.209	-28117.191	15.400
3209	-111406.174	-28117.120	0.079
3210	-111402.137	-28107.843	10.117
3211	-111402.005	-28107.535	0.335
3230	-111384.013	-28113.339	18.905
3205	-111384.842	-28123.860	10.554
面積	223.8568480		
地積	223.85㎡		


91

地番	松荒堀一八ノ三		
N O	X	Y	辺長
3230	-111384.013	-28113.339	
3211	-111402.005	-28107.535	18.905
3214	-111397.626	-28097.300	11.132
3228	-111394.000	-28098.971	3.993
943	-111387.479	-28101.035	6.840
944	-111384.694	-28101.807	2.890
3232	-111383.141	-28102.270	1.621
3230	-111384.013	-28113.339	11.103
面積	183.6196340		
地積	183.61㎡		


92

地番	松荒堀一八ノ一		
N O	X	Y	辺長
3233	-111383.008	-28102.307	
3232	-111383.141	-28102.270	0.138
944	-111384.694	-28101.807	1.621
943	-111387.479	-28101.035	2.890
3228	-111394.000	-28098.971	6.840
3214	-111397.626	-28097.300	3.993
3215	-111397.339	-28096.630	0.729
3216	-111397.173	-28096.320	0.352
3217	-111396.606	-28095.104	1.342
3218	-111393.166	-28089.363	6.693
3219	-111391.637	-28087.016	2.801
3220	-111386.294	-28081.192	7.904
3221	-111385.057	-28079.610	2.008
3222	-111381.410	-28074.186	6.536
3224	-111377.838	-28066.960	8.061
3223	-111378.005	-28067.637	0.697
3225	-111378.433	-28069.565	1.975
3235	-111379.036	-28072.955	3.443
3234	-111381.258	-28088.652	15.853
3233	-111383.008	-28102.307	13.767
面積	261.0959260		
地積	261.09㎡		

図面の種類	画 地 面 積 求 積 表				
街区 番号	21	番号	／		
町 名	松 室 荒 堀 町				
京 都 市 洛 西 第 二 土 地 区 画 整 理 組 合					

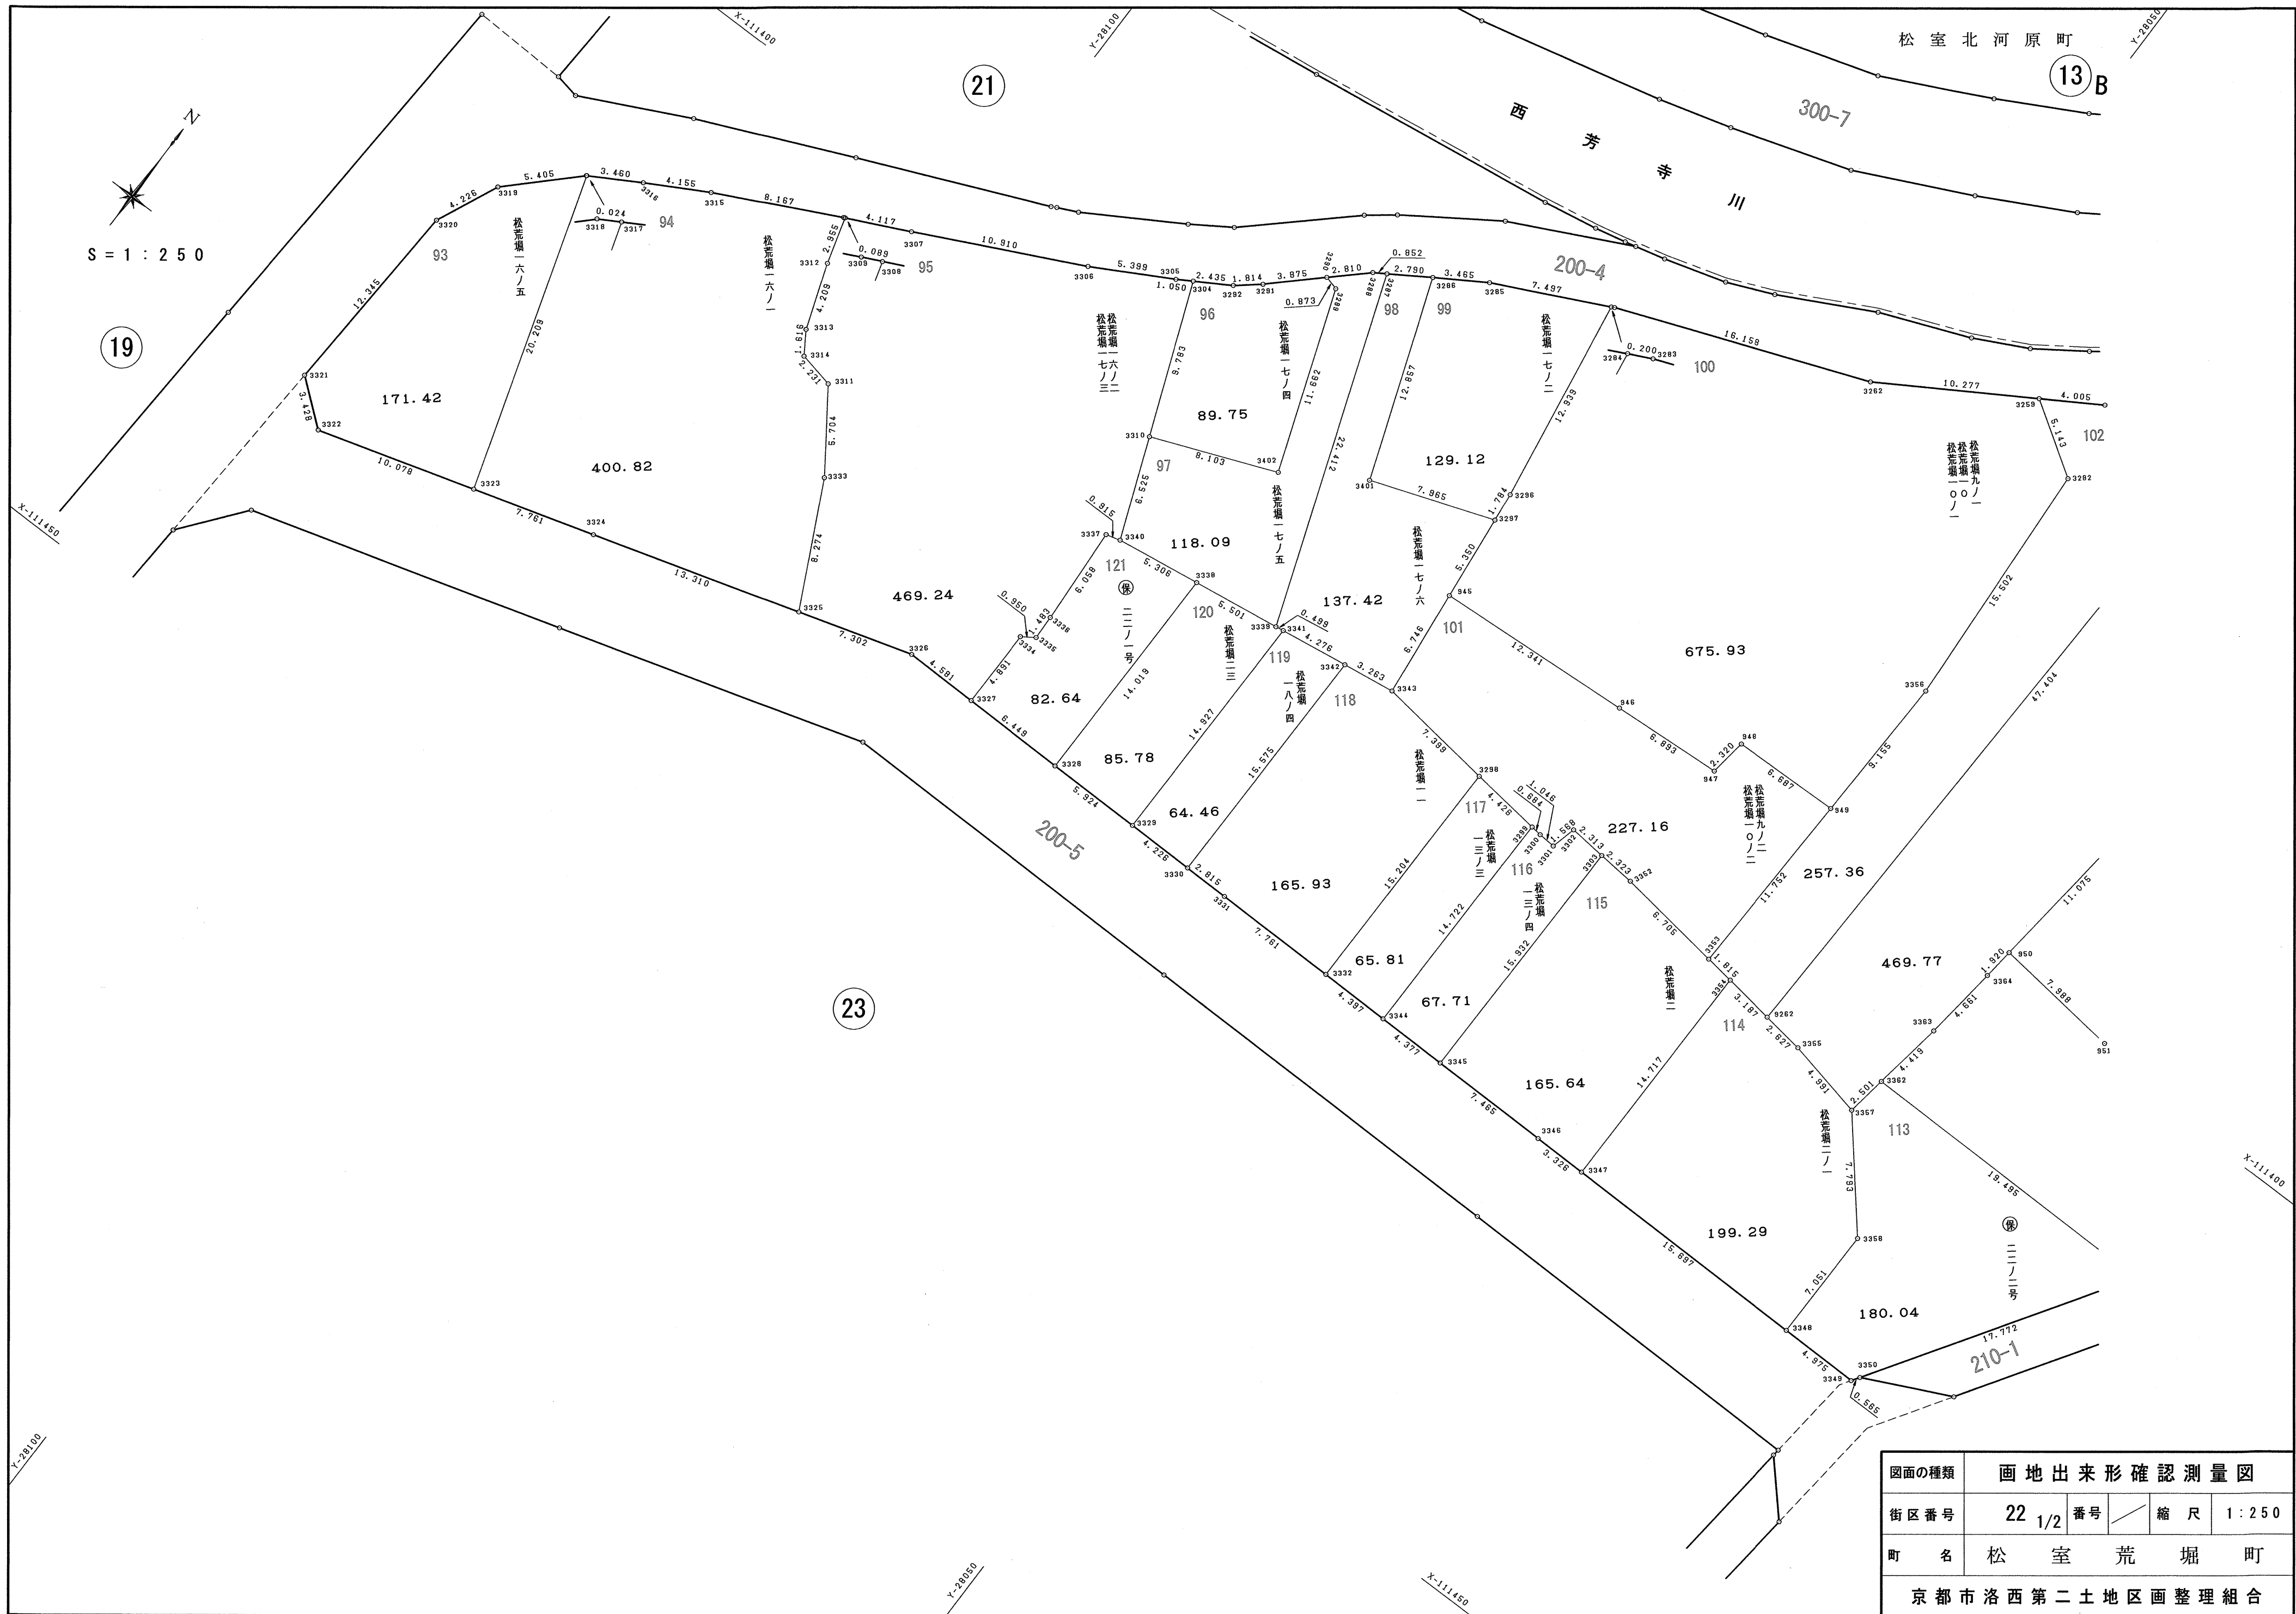

図面の種類	画地出来形確認測量図				
街区番号	22	1/2	番号	縮尺	1 : 250
町名	松室荒堀町				
京都市洛西第二土地区画整理組合					

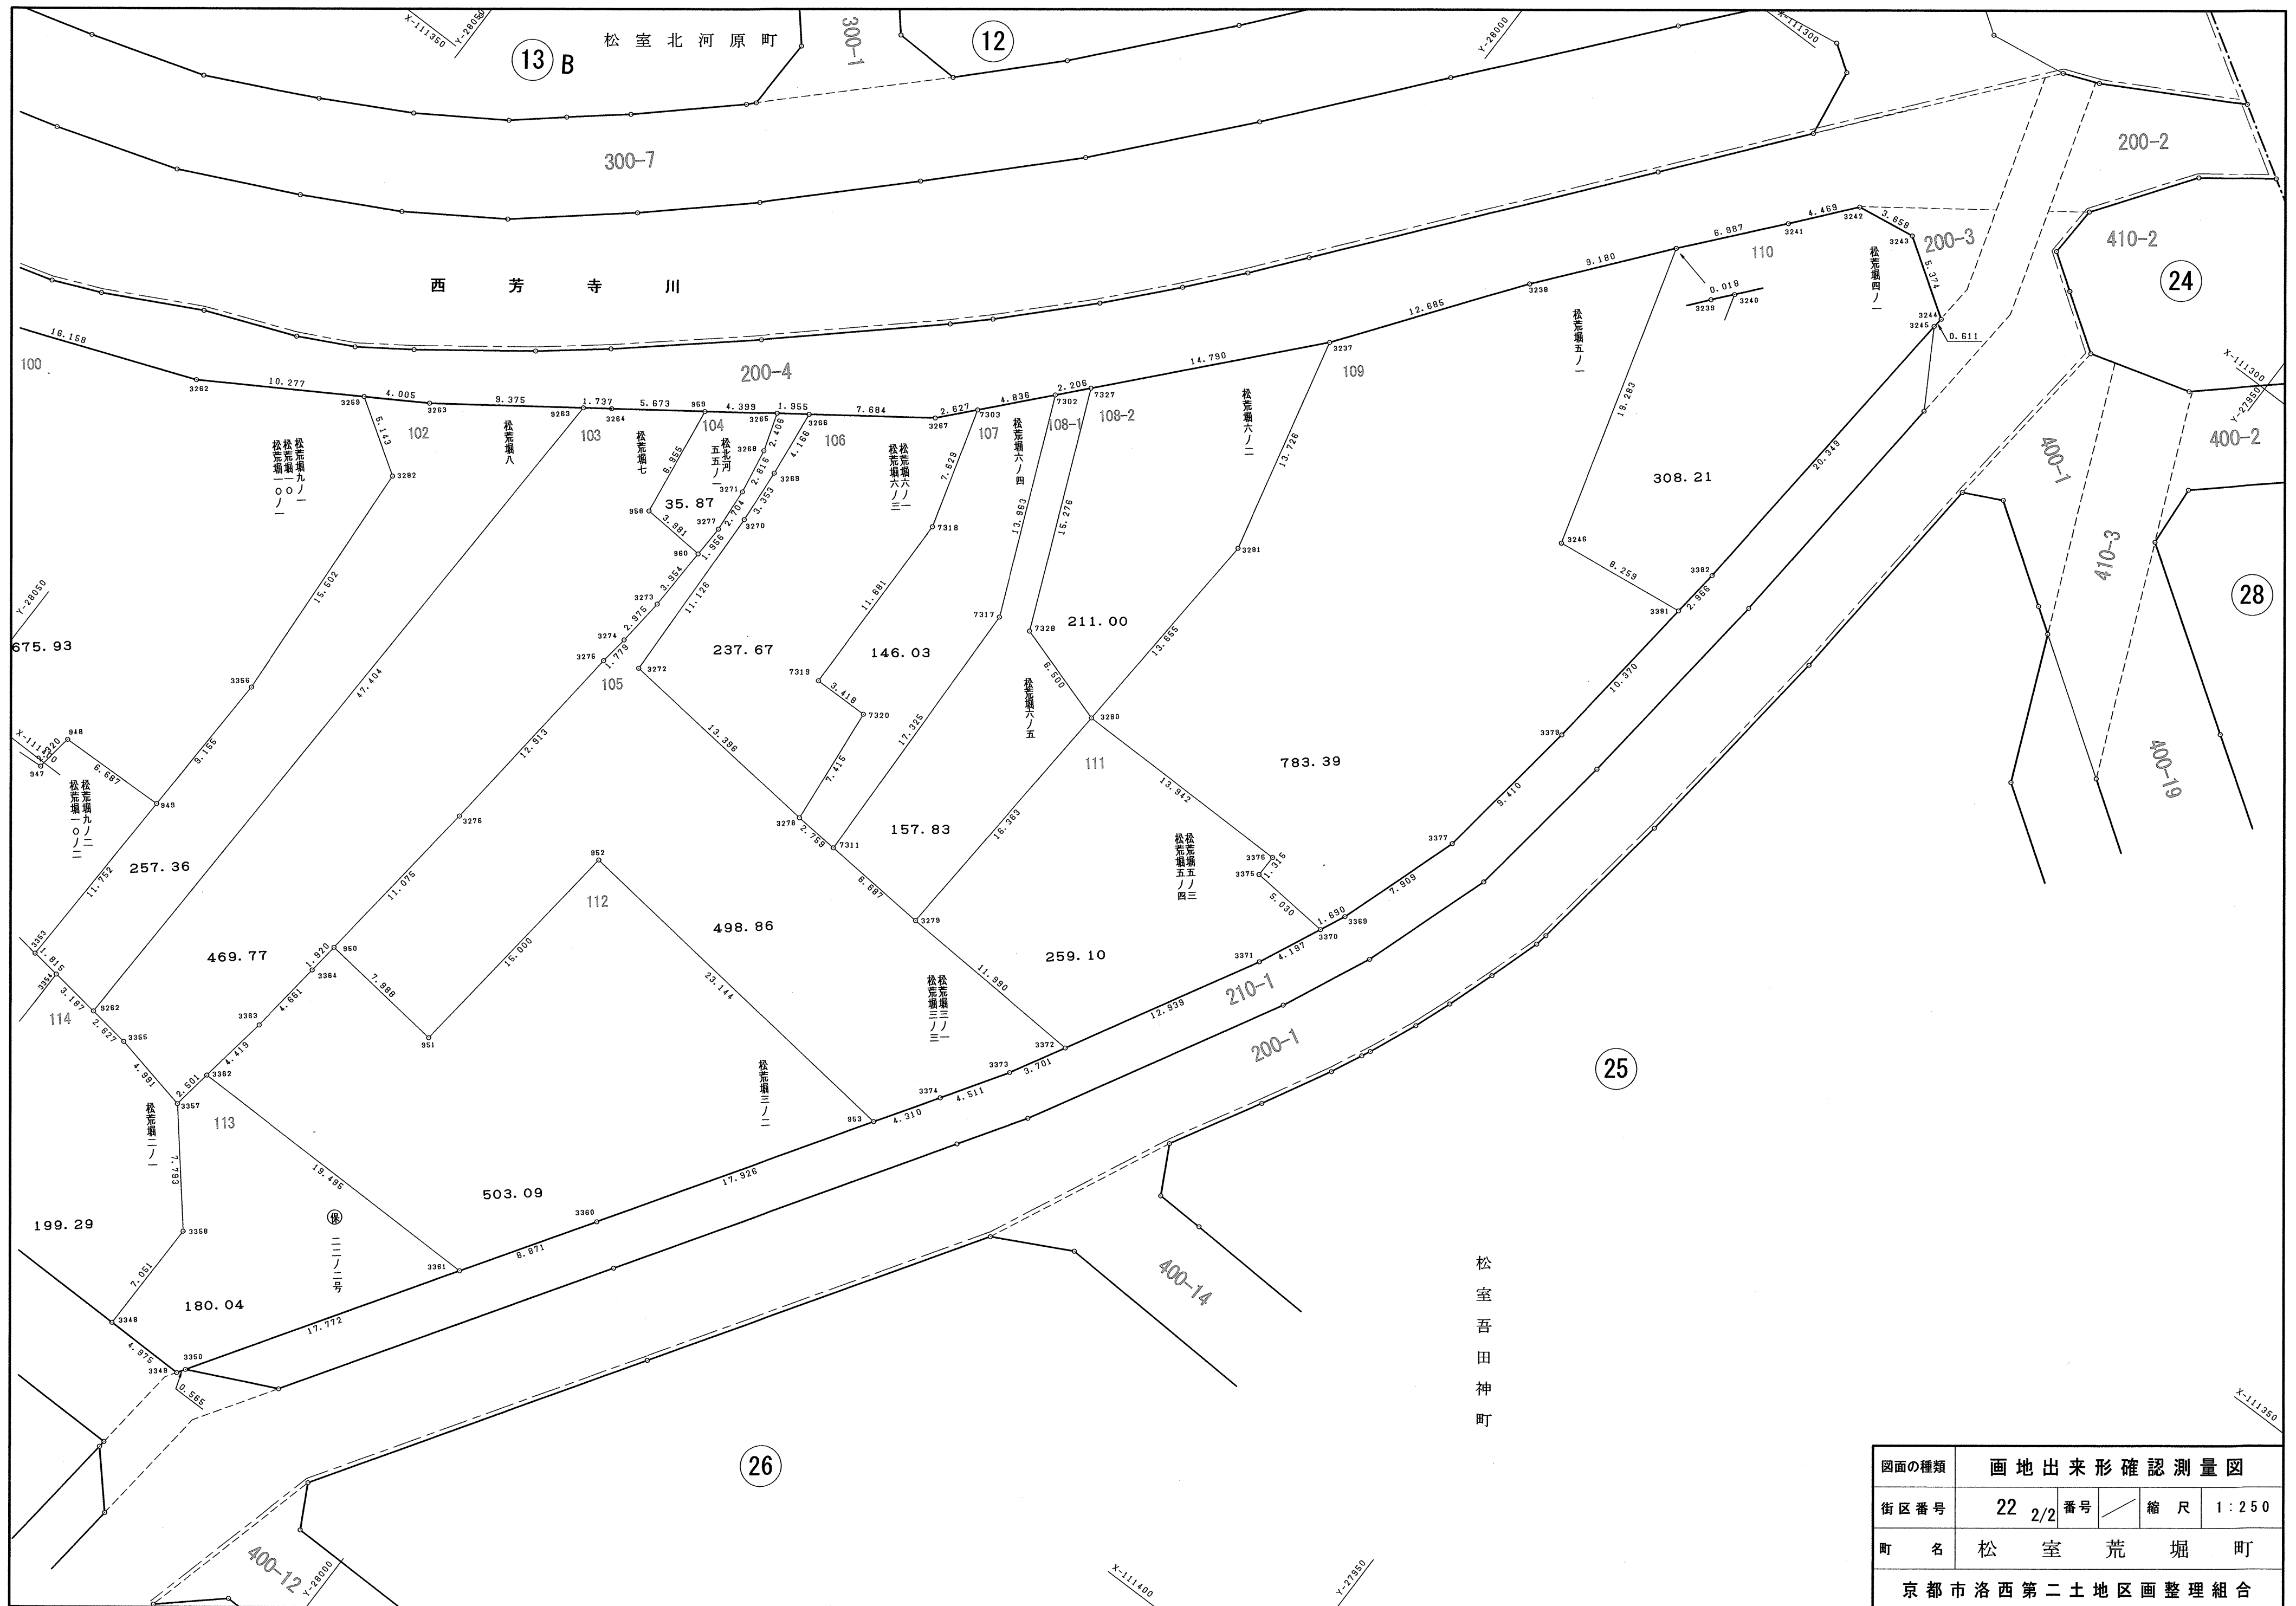

図面の種類	画地出来形確認測量図				
街区番号	22	2/2	番号	縮尺	1 : 250
町名	松室荒堀町				
京都市洛西第二土地区画整理組合					

93

地番	松荒堀一六ノ五		
N O	X	Y	辺長
3320	-111420.506	-28125.810	
3321	-111432.833	-28126.480	12.345
3322	-111434.985	-28123.812	3.428
3323	-111432.133	-28114.146	10.078
3317	-111412.851	-28120.197	20.209
3318	-111412.863	-28120.218	0.024
3319	-111416.656	-28124.068	5.405
3320	-111420.506	-28125.810	4.226
面積	171.4206750		
地積	171.42 ㎡		

94			
地番	松荒堀一六ノ一		
N O	X	Y	辺長
3317	-111412.851	-28120.197	
3323	-111432.133	-28114.146	20.209
3324	-111429.936	-28106.702	7.761
3325	-111426.144	-28093.944	13.310
3333	-111418.735	-28097.628	8.274
3311	-111414.058	-28100.893	5.704
3314	-111413.605	-28103.078	2.231
3313	-111412.248	-28103.956	1.616
3312	-111408.277	-28105.350	4.209
3308	-111405.439	-28106.172	2.955
3309	-111405.477	-28106.252	0.089
3315	-111409.096	-28113.573	8.167
3316	-111411.110	-28117.207	4.155
3317	-111412.851	-28120.197	3.460
面積	400.8209405		
地積	400.82㎡		

95			
地番	松荒堀一六ノ二, 松荒堀一七ノ三		
N O	X	Y	辺長
3308	-111405.439	-28106.172	
3312	-111408.277	-28105.350	2.955
3313	-111412.248	-28103.956	4.209
3314	-111413.605	-28103.078	1.616
3311	-111414.058	-28100.893	2.231
3333	-111418.735	-28097.628	5.704
3325	-111426.144	-28093.944	8.274
3326	-111424.064	-28086.944	7.302
3327	-111424.108	-28082.363	4.581
3334	-111419.217	-28082.326	4.891
3335	-111418.682	-28081.541	0.950
3336	-111417.200	-28081.586	1.483
3337	-111411.152	-28081.937	6.058
3340	-111410.911	-28081.054	0.915
3310	-111404.838	-28083.441	6.525
3304	-111395.734	-28087.022	9.783
3305	-111396.275	-28087.922	1.050
3306	-111398.879	-28092.652	5.399
3307	-111403.668	-28102.455	10.910
3308	-111405.439	-28106.172	4.117
面積	469.2433780		
地積	469.24 ㎡		

96			
地番	松荒堀一七ノ四		
N O	X	Y	辺長
3304	-111395.734	-28087.022	
3310	-111404.838	-28083.441	9.783
3402	-111401.850	-28075.909	8.103
3289	-111390.880	-28079.867	11.662
3290	-111390.669	-28080.714	0.873
3291	-111393.321	-28083.540	3.875
3292	-111394.480	-28084.935	1.814
3304	-111395.734	-28087.022	2.435
面積	89.7551260		
地積	89.75 ㎡		

97			
地番	松荒堀一七ノ五		
N O	X	Y	辺長
3290	-111390.669	-28080.714	
3289	-111390.880	-28079.867	0.873
3402	-111401.850	-28075.909	11.662
3310	-111404.838	-28083.441	8.103
3340	-111410.911	-28081.054	6.525
3338	-111410.151	-28075.803	5.306
3339	-111409.379	-28070.356	5.501
3287	-111388.291	-28077.945	22.412
3288	-111388.746	-28078.665	0.852
3290	-111390.669	-28080.714	2.810
面積	118.0935285		
地積	118.09 m ²		

98			
地番	松荒堀一七ノ六		
N O	X	Y	辺 長
3287	-111388.291	-28077.945	
3339	-111409.379	-28070.356	22.412
3341	-111409.301	-28069.863	0.499
3342	-111408.694	-28065.630	4.276
3343	-111408.234	-28062.400	3.263
945	-111401.527	-28063.127	6.746
3297	-111396.208	-28063.703	5.350
3401	-111398.887	-28071.204	7.965
3286	-111386.800	-28075.587	12.857
3287	-111388.291	-28077.945	2.790
面積	137.4236220		
地積	137.42㎡		

99

地番	松荒堀一七ノ二		
N O	X	Y	辺長
3286	-111386.800	-28075.587	
3401	-111398.887	-28071.204	12.857
3297	-111396.208	-28063.703	7.965
3296	-111394.436	-28063.908	1.784
3284	-111381.655	-28065.924	12.939
3285	-111384.948	-28072.659	7.497
3286	-111386.800	-28075.587	3.465
面積	129.1214455		
地積	129.12㎡		

100			
地番	松荒堀九ノ一，松荒堀一〇 松荒堀一〇ノ一		
N O	X	Y	辺 長
3284	-111381.655	-28065.924	
3296	-111394.436	-28063.908	12.939
3297	-111396.208	-28063.703	1.784
945	-111401.527	-28063.127	5.350
946	-111400.731	-28050.812	12.341
947	-111400.292	-28043.933	6.893
948	-111397.994	-28043.611	2.320
949	-111397.827	-28036.926	6.687
3356	-111388.676	-28036.642	9.155
3282	-111373.203	-28037.591	15.502
3259	-111370.398	-28041.902	5.143
3262	-111375.776	-28050.659	10.277
3283	-111381.567	-28065.744	16.158
3284	-111381.655	-28065.924	0.200
面積	675.9338685		
地積	675.93 ㎡		

101			
地番	松荒堀九ノ二，松荒堀一〇ノ二		
N O	X	Y	辺長
945	-111401.527	-28063.127	
3343	-111408.234	-28062.400	6.746
3298	-111409.155	-28055.059	7.399
3299	-111409.673	-28050.663	4.426
3300	-111409.748	-28049.983	0.684
3301	-111409.810	-28048.939	1.046
3302	-111408.289	-28048.556	1.568
3303	-111408.498	-28046.252	2.313
3352	-111408.697	-28043.938	2.323
3353	-111409.573	-28037.290	6.705
949	-111397.827	-28036.926	11.752
948	-111397.994	-28043.611	6.687
947	-111400.292	-28043.933	2.320
946	-111400.731	-28050.812	6.893
945	-111401.527	-28063.127	12.341
面積	227.1683035		
地積	227.16 ㎡		

102			
地番	松荒堀八		
N O	X	Y	辺長
3259	-111370.398	-28041.902	
3282	-111373.203	-28037.591	5.143
3356	-111388.676	-28036.642	15.502
949	-111397.827	-28036.926	9.155
3353	-111409.573	-28037.290	11.752
3354	-111409.803	-28035.490	1.815
9262	-111410.231	-28032.332	3.187
9263	-111362.850	-28030.862	47.404
3263	-111368.302	-28038.489	9.375
3259	-111370.398	-28041.902	4.005
面積	257.3602340		
地積	257.36 ㎡		

103				
地番	松荒堀七			
N O	X	Y	辺 長	
9262	-111410.231	-28032.332		
3355	-111410.583	-28029.729	2.627	
3357	-111411.621	-28024.847	4.991	
3362	-111409.148	-28024.473	2.501	
3363	-111404.782	-28023.792	4.419	
3364	-111400.153	-28023.243	4.661	
950	-111398.245	-28023.028	1.920	
3276	-111387.239	-28021.790	11.075	
3275	-111374.387	-28020.539	12.913	
3274	-111372.623	-28020.310	1.779	
3273	-111369.661	-28020.037	2.975	
960	-111365.709	-28019.900	3.954	
958	-111365.434	-28023.871	3.981	

112			
地番	松荒堀三ノ二		
N O	X	Y	辺長
950	-111398.245	-28023.028	
3364	-111400.153	-28023.243	1.920
3363	-111404.782	-28023.792	4.661
3362	-111409.148	-28024.473	4.419
3361	-111409.313	-28004.979	19.495
3360	-111401.868	-28000.156	8.871
953	-111386.820	-27990.414	17.926
952	-111384.232	-28013.413	23.144
951	-111399.138	-28015.090	15.000
950	-111398.245	-28023.028	7.988
面積	503.0946430		
地積	503.09㎡		

113			
地番	保 二二ノ二号		
N O	X	Y	辺長
3362	-111409.148	-28024.473	
3357	-111411.621	-28024.847	2.501
3358	-111417.606	-28019.856	7.793
3348	-111424.657	-28019.927	7.051
3349	-111424.701	-28014.952	4.975
3350	-111424.229	-28014.641	0.565
3361	-111409.313	-28004.979	17.772
3362	-111409.148	-28024.473	19.495
面積	180.0405140		
地積	180.04㎡		

114			
地番	松荒堀二ノ一		
N O	X	Y	辺長
3354	-111409.803	-28035.490	
3347	-111424.519	-28035.623	14.717
3348	-111424.657	-28019.927	15.697
3358	-111417.606	-28019.856	7.051
3357	-111411.621	-28024.847	7.793
3355	-111410.583	-28029.729	4.991
9262	-111410.231	-28032.332	2.627
3354	-111409.803	-28035.490	3.187
面積	199.2921220		
地積	199.29㎡		

115			
地番	松荒堀二		
N O	X	Y	辺長
3303	-111408.498	-28046.252	
3345	-111424.429	-28046.414	15.932
3346	-111424.490	-28038.949	7.465
3347	-111424.519	-28035.623	3.326
3354	-111409.803	-28035.490	14.717
3353	-111409.573	-28037.290	1.815
3352	-111408.697	-28043.938	6.705
3303	-111408.498	-28046.252	2.323
面積	165.6449655		
地積	165.64㎡		

116			
地番	松荒堀一三ノ四		
N O	X	Y	辺長
3299	-111409.673	-28050.663	
3344	-111424.394	-28050.791	14.722
3345	-111424.429	-28046.414	4.377
3303	-111408.498	-28046.252	15.932
3302	-111408.289	-28048.556	2.313
3301	-111409.810	-28048.939	1.568
3300	-111409.748	-28049.983	1.046
3299	-111409.673	-28050.663	0.684
面積	67.7189360		
地積	67.71㎡		

117			
地番	松荒堀一三ノ三		
N O	X	Y	辺長
3298	-111409.155	-28055.059	
3332	-111424.358	-28055.188	15.204
3344	-111424.394	-28050.791	4.397
3299	-111409.673	-28050.663	14.722
3298	-111409.155	-28055.059	4.426
面積	65.8160275		
地積	65.81㎡		


118			
地番	松荒堀一一		
N O	X	Y	辺長
3342	-111408.694	-28065.630	
3330	-111424.268	-28065.764	15.575
3331	-111424.295	-28062.949	2.815
3332	-111424.358	-28055.188	7.761
3298	-111409.155	-28055.059	15.204
3343	-111408.234	-28062.400	7.399
3342	-111408.694	-28065.630	3.263
面積	165.9384790		
地積	165.93㎡		

119			
地番	松荒堀一八ノ四		
N O	X	Y	辺長
3341	-111409.301	-28069.863	
3329	-111424.227	-28069.990	14.927
3330	-111424.268	-28065.764	4.226
3342	-111408.694	-28065.630	15.575
3341	-111409.301	-28069.863	4.276
面積	64.4629435		
地積	64.46㎡		

120			
地番	松荒堀二三		
N O	X	Y	辺長
3338	-111410.151	-28075.803	
3328	-111424.170	-28075.914	14.019
3329	-111424.227	-28069.990	5.924
3341	-111409.301	-28069.863	14.927
3339	-111409.379	-28070.356	0.499
3338	-111410.151	-28075.803	5.501
面積	85.7815515		
地積	85.78㎡		

121			
地番	保 二二ノ一号		
N O	X	Y	辺長
3337	-111411.152	-28081.937	
3336	-111417.200	-28081.586	6.058
3335	-111418.682	-28081.541	1.483
3334	-111419.217	-28082.326	0.950
3327	-111424.108	-28082.363	4.891
3328	-111424.170	-28075.914	6.449
3338	-111410.151	-28075.803	14.019
3340	-111410.911	-28081.054	5.306
3337	-111411.152	-28081.937	0.915
面積	82.6443820		
地積	82.64㎡		

図面の種類	画 地 面 積 求 積 表				
街区 番号	22	番号	$\frac{2}{2}$		
町 名	松 室 荒 堀 町				
京 都 市 洛 西 第 二 土 地 区 画 整 理 組 合					

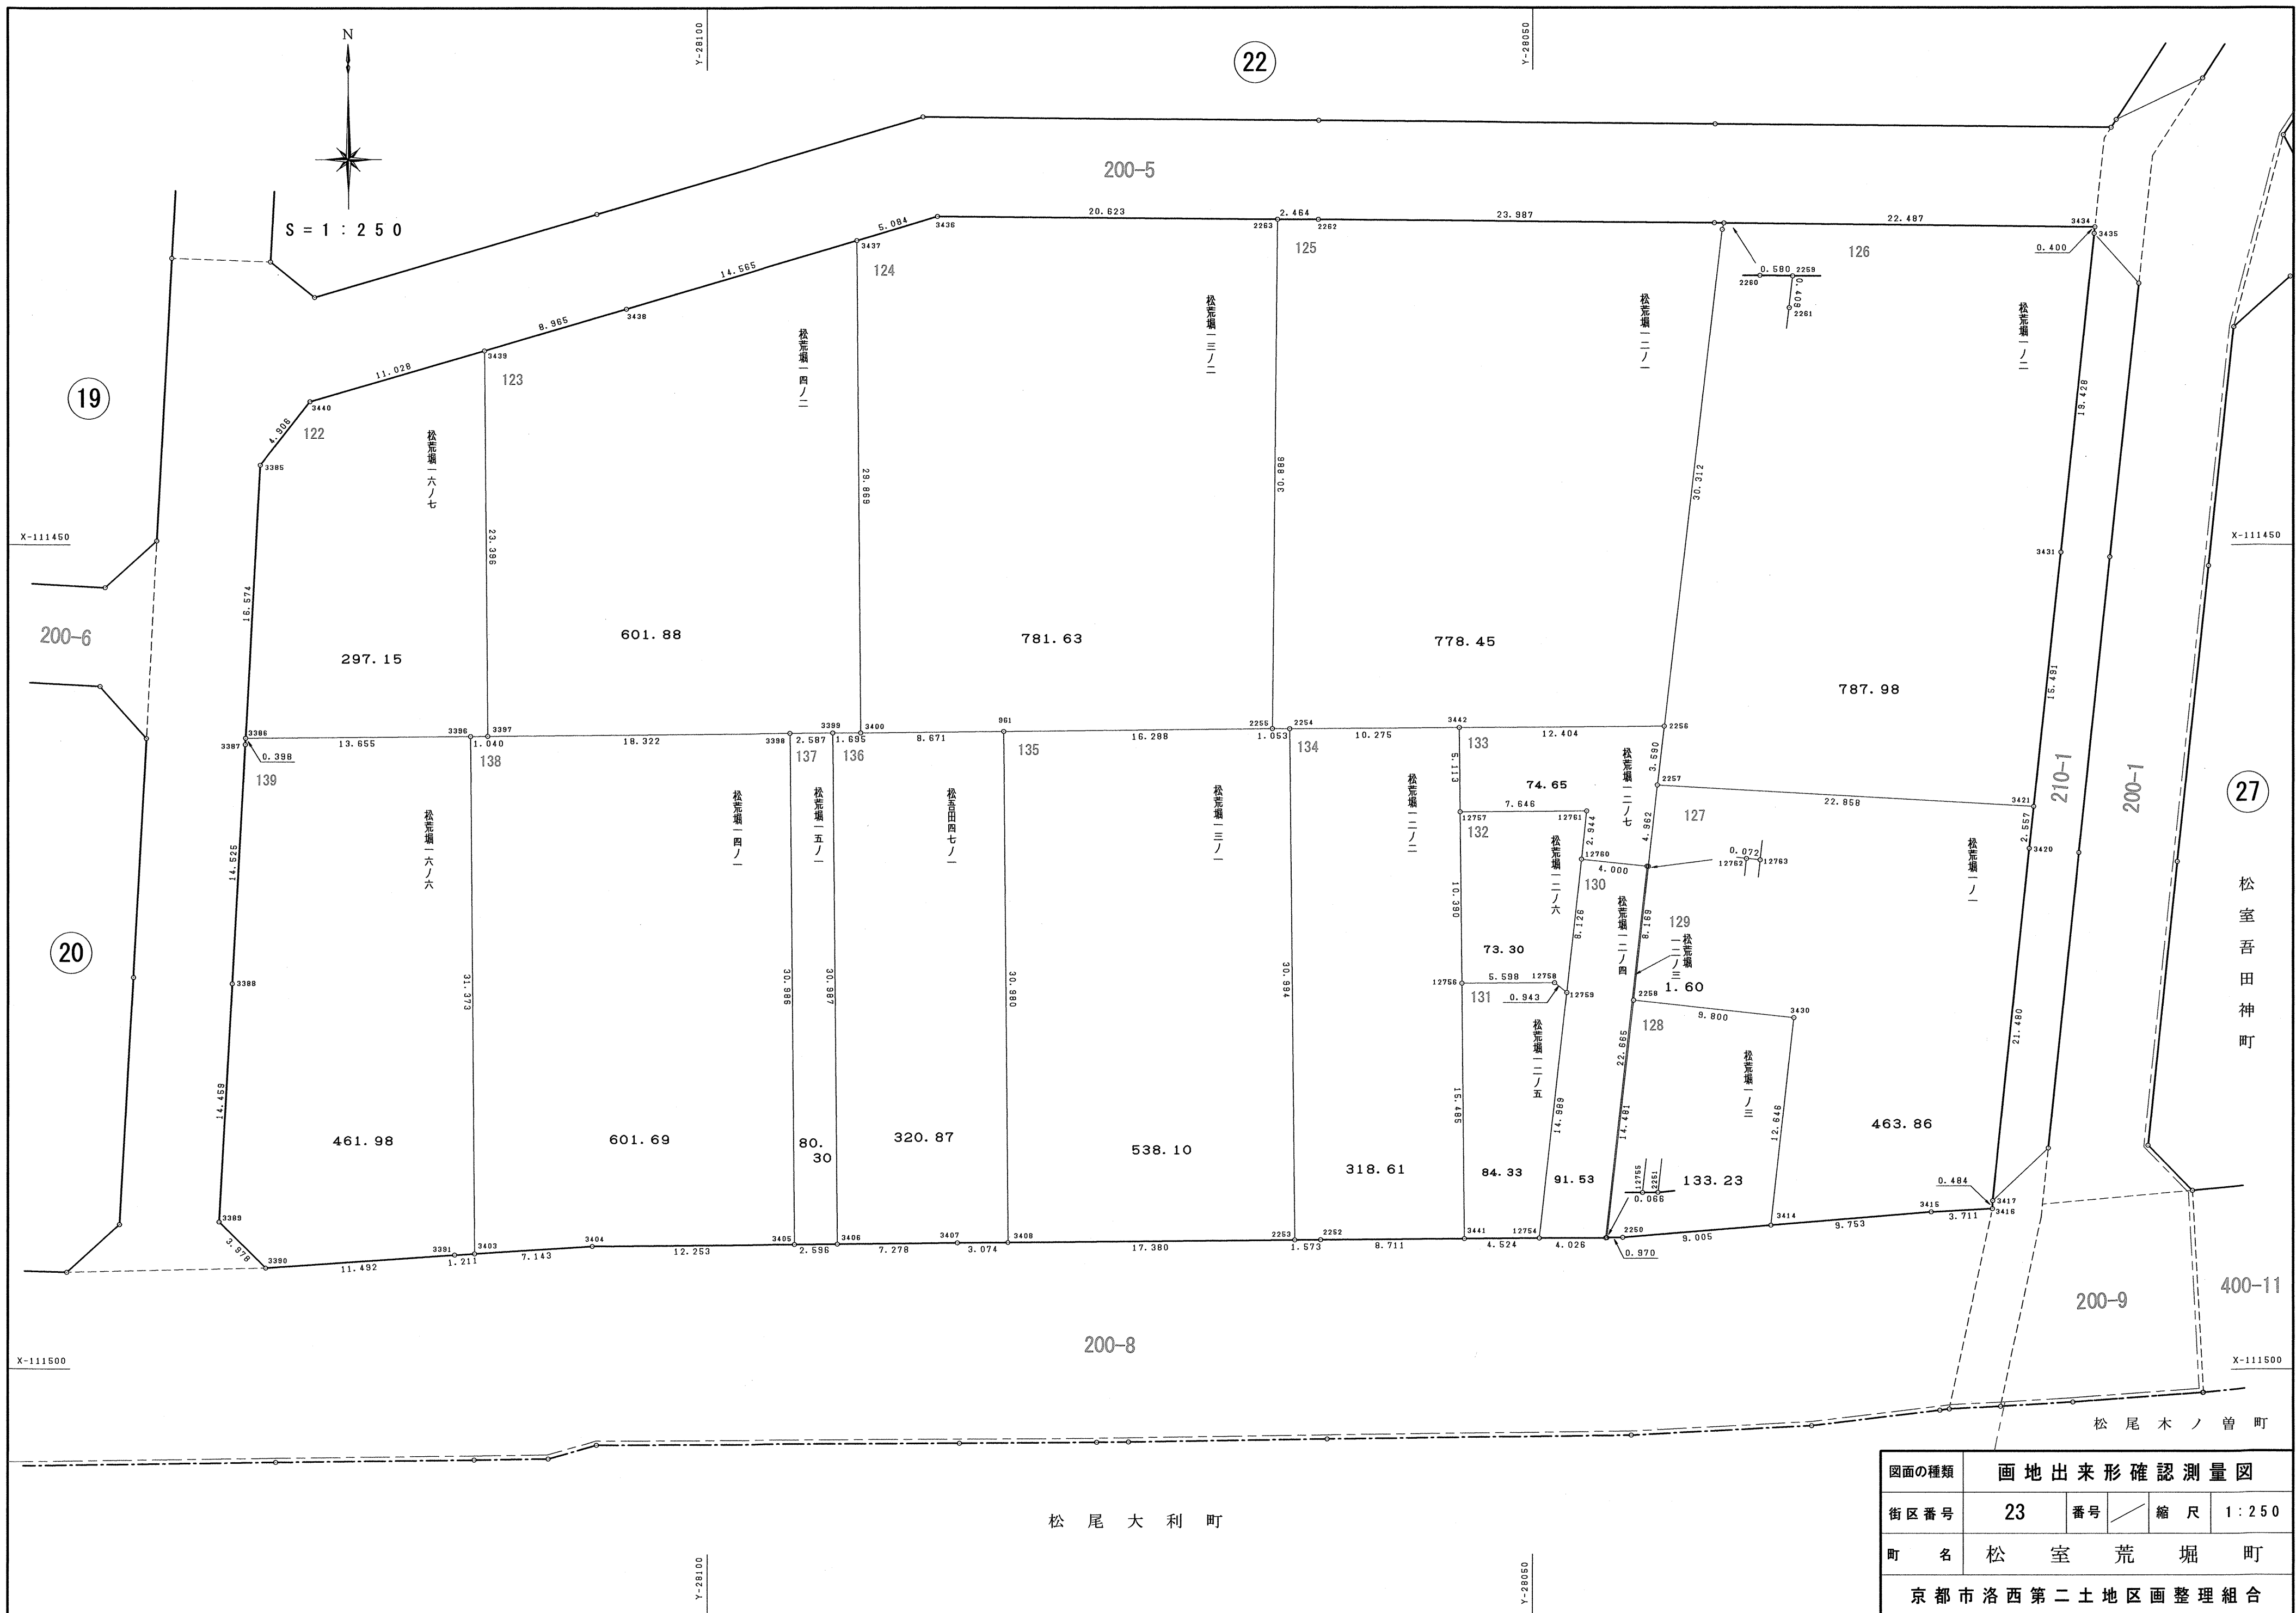

図面の種類	画 地 出 来 形 確 認 測 量 図				
街区 番号	23	番号		縮 尺	1 : 2 5 0
町 名	松 室 荒 堀 町				
京 都 市 洛 西 第 二 土 地 区 画 整 理 組 合					

122			
地番	松荒堀一六ノ七		
N O	X	Y	辺長
3440	-111441.308	-28124.093	
3385	-111445.170	-28127.119	4.906
3386	-111461.720	-28128.008	16.574
3396	-111461.607	-28114.353	13.655
3397	-111461.596	-28113.313	1.040
3439	-111438.201	-28113.512	23.396
3440	-111441.308	-28124.093	11.028
面積	297.1546675		
地積	297.15㎡		

123			
地番	松荒堀一四ノ二		
N O	X	Y	辺長
3439	-111438.201	-28113.512	
3397	-111461.596	-28113.313	23.396
3398	-111461.429	-28094.992	18.322
3399	-111461.404	-28092.405	2.587
3400	-111461.405	-28090.710	1.695
3437	-111431.537	-28090.945	29.869
3438	-111435.676	-28104.910	14.565
3439	-111438.201	-28113.512	8.965
面積	601.8849925		
地積	601.88㎡		

124			
地番	松荒堀一三ノ二		
N O	X	Y	辺長
3437	-111431.537	-28090.945	
3400	-111461.405	-28090.710	29.869
961	-111461.320	-28082.039	8.671
2255	-111461.159	-28065.752	16.288
2263	-111430.274	-28065.449	30.886
3436	-111430.092	-28086.071	20.623
3437	-111431.537	-28090.945	5.084
面積	781.6310595		
地積	781.63㎡		

125			
地番	松荒堀一二ノ一		
N O	X	Y	辺長
2263	-111430.274	-28065.449	
2255	-111461.159	-28065.752	30.886
2254	-111461.169	-28064.699	1.053
3442	-111461.091	-28054.424	10.275
2256	-111460.998	-28042.020	12.404
2261	-111430.888	-28038.523	30.312
2259	-111430.492	-28038.419	0.409
2260	-111430.486	-28038.999	0.580
2262	-111430.296	-28062.985	23.987
2263	-111430.274	-28065.449	2.464
面積	778.4503655		
地積	778.45㎡		

126			
地番	松荒堀一ノ二		
N O	X	Y	辺長
2259	-111430.492	-28038.419	
2261	-111430.888	-28038.523	0.409
2256	-111460.998	-28042.020	30.312
2257	-111464.563	-28042.440	3.590
3421	-111465.862	-28019.619	22.858
3431	-111450.458	-28017.984	15.491
3435	-111431.135	-28015.971	19.428
3434	-111430.737	-28015.933	0.400
2259	-111430.492	-28038.419	22.487
面積	787.9850970		
地積	787.98㎡		

127			
地番	松荒堀一ノ一		
N O	X	Y	辺長
2257	-111464.563	-28042.440	
12763	-111469.495	-28042.986	4.962
2258	-111477.614	-28043.885	8.169
3430	-111478.687	-28034.144	9.800
3414	-111491.254	-28035.553	12.646
3415	-111490.449	-28025.833	9.753
3416	-111490.254	-28022.127	3.711
3417	-111489.770	-28022.107	0.484
3420	-111468.405	-28019.889	21.480
3421	-111465.862	-28019.619	2.557
2257	-111464.563	-28042.440	22.858
面積	463.8643930		
地積	463.86㎡		

128			
地番	松荒堀一ノ三		
N O	X	Y	辺長
2258	-111477.614	-28043.885	
2251	-111492.005	-28045.497	14.481
2250	-111491.997	-28044.527	0.970
3414	-111491.254	-28035.553	9.005
3430	-111478.687	-28034.144	12.646
2258	-111477.614	-28043.885	9.800
面積	133.2347070		
地積	133.23㎡		

129			
地番	松荒堀一二ノ三		
N O	X	Y	辺長
12762	-111469.491	-28043.058	
12755	-111492.017	-28045.562	22.665
2251	-111492.005	-28045.497	0.066
2258	-111477.614	-28043.885	14.481
12763	-111469.495	-28042.986	8.169
12762	-111469.491	-28043.058	0.072
面積	1.6076125		
地積	1.60㎡		

130			
地番	松荒堀一二ノ四		
N O	X	Y	辺長
12760	-111469.066	-28047.035	
12759	-111477.142	-28047.932	8.126
12754	-111492.039	-28049.588	14.989
12755	-111492.017	-28045.562	4.026
12762	-111469.491	-28043.058	22.665
12760	-111469.066	-28047.035	4.000
面積	91.5359935		
地積	91.53㎡		

131			
地番	松荒堀一二ノ五		
N O	X	Y	辺長
12756	-111476.593	-28054.267	
3441	-111492.077	-28054.112	15.485
12754	-111492.039	-28049.588	4.524
12759	-111477.142	-28047.932	14.989
12758	-111476.553	-28048.669	0.943
12756	-111476.593	-28054.267	5.598
面積	84.3319235		
地積	84.33㎡		

132			
地番	松荒堀一二ノ六		
N O	X	Y	辺長
12757	-111466.204	-28054.371	
12758	-111476.593	-28054.267	10.390
12759	-111476.553	-28048.669	5.598
12759	-111477.142	-28047.932	0.943
12760	-111469.066	-28047.035	8.126
12761	-111466.138	-28046.725	2.944
12757	-111466.204	-28054.371	7.646
面積	73.3051475		
地積	73.30㎡		

133			
地番	松荒堀一二ノ七		
N O	X	Y	辺長
3442	-111461.091	-28054.424	
12757	-111466.204	-28054.371	5.113
12761	-111466.138	-28046.725	7.646
12760	-111469.066	-28047.035	2.944
12762	-111469.491	-28043.058	4.000
12763	-111469.495	-28042.986	0.072
2257	-111464.563	-28042.440	4.962
2256	-111460.998	-28042.020	3.590
3442	-111461.091	-28054.424	12.404
面積	74.6539200		
地積	74.65㎡		

134			
地番	松荒堀一二ノ二		
N O	X	Y	辺長
2254	-111461.169	-28064.699	
2253	-111492.162	-28064.396	30.994
2252	-111492.150	-28062.823	1.573
3441	-111492.077	-28054.112	8.711
12756	-111476.593	-28054.267	15.485
12757	-111466.204	-28054.371	10.390
3442	-111461.091	-28054.424	5.113
2254	-111461.169	-28064.699	10.275
面積	318.6102965		
地積	318.61㎡		

135			
地番	松荒堀一三ノ一		
N O	X	Y	辺長
961	-111461.320	-28082.039	
3408	-111492.299	-28081.775	30.980
2253	-111492.162	-28064.396	17.380
2254	-111461.169	-28064.699	30.994
2255	-111461.159	-28065.752	1.053
961	-111461.320	-28082.039	16.288
面積	538.1084925		
地積	538.10㎡		


136			
地番	松吾田四七ノ一		
N O	X	Y	辺長
3399	-111461.404	-28092.405	
3406	-111492.390	-28092.127	30.987
3407	-111492.323	-28084.849	7.278
3408	-111492.299	-28081.775	3.074
961	-111461.320	-28082.039	30.980
3400	-111461.405	-28090.710	8.671
3399	-111461.404	-28092.405	1.695
面積	320.8794140		
地積	320.87㎡		

137			
地番	松荒堀一五ノ一		
N O	X	Y	辺長
3398	-111461.429	-28094.992	
3405	-111492.414	-28094.723	30.986
3406	-111492.390	-28092.127	2.596
3399	-111461.404	-28092.405	30.987
3398	-111461.429	-28094.992	2.587
面積	80.3056240		
地積	80.30㎡		

138			
地番	松荒堀一四ノ一		
N O	X	Y	辺長
3396	-111461.607	-28114.353	
3403	-111492.979	-28114.104	31.373
3404	-111492.526	-28106.975	7.143
3405	-111492.414	-28094.723	12.253
3398	-111461.429	-28094.992	30.986
3397	-111461.596	-28113.313	18.322
3396	-111461.607	-28114.353	1.040
面積	601.6930135		
地積	601.69㎡		

139			
地番	松荒堀一六ノ六		
N O	X	Y	辺長
3386	-111461.720	-28128.008	
3387	-111462.117	-28128.029	0.398
3388	-111476.621	-28128.814	14.525
3389	-111491.058	-28129.611	14.459
3390	-111493.850	-28126.778	3.978
3391	-111493.056	-28115.313	11.492
3403	-111492.979	-28114.104	1.211
3396	-111461.607	-28114.353	31.373
3386	-111461.720	-28128.008	13.655
面積	461.9829000		
地積	461.98㎡		


図面の種類	画 地 面 積 求 積 表				
街区番号	23	番号	／		
町 名	松 室 荒 堀 町				
京 都 市 洛 西 第 二 土 地 区 画 整 理 組 合					

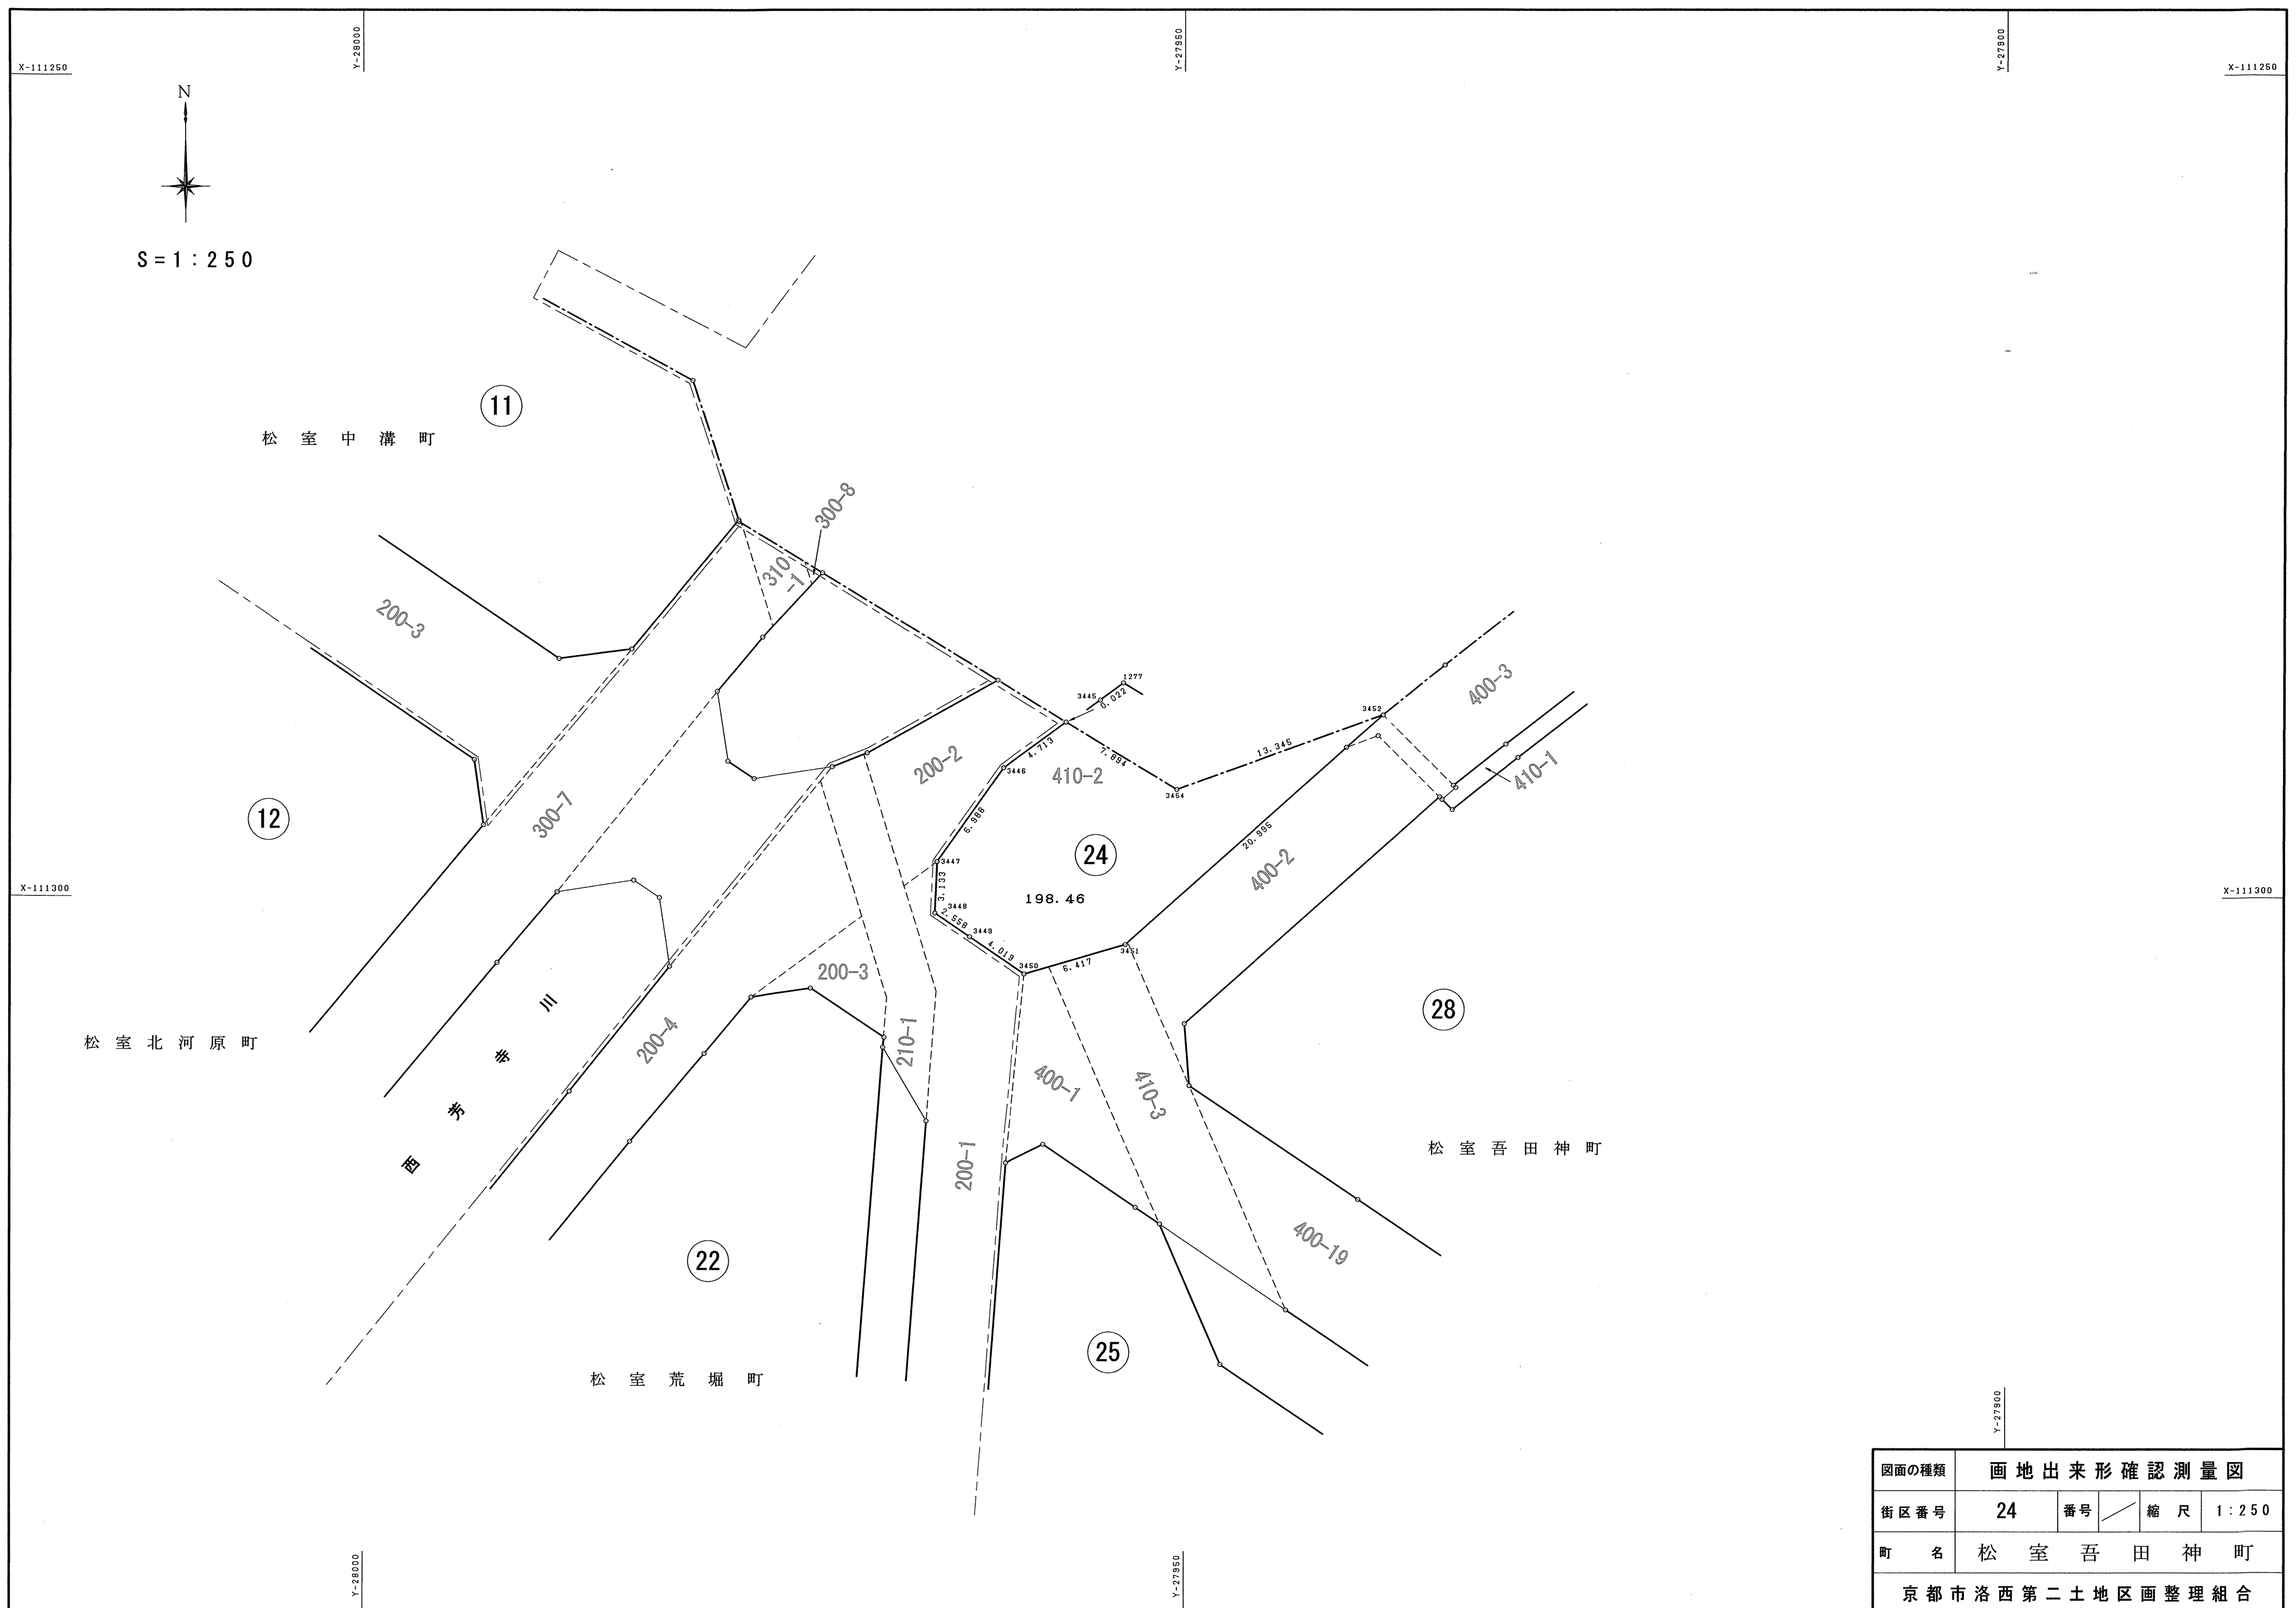

410-2

地番			
N O	X	Y	辺 長
1277	-111289.355	-27957.179	
3445	-111289.368	-27957.197	0.022
3446	-111292.149	-27961.002	4.713
3447	-111297.849	-27965.044	6.988
3448	-111300.979	-27965.179	3.133
3449	-111302.424	-27963.068	2.558
3450	-111304.676	-27959.739	4.018
3451	-111302.888	-27953.576	6.417
3452	-111288.926	-27937.896	20.995
3454	-111293.471	-27950.443	13.345
1277	-111289.355	-27957.179	7.894
面積	198.4630475		
地積	198.46 ㎡		

図面の種類	画 地 面 積 求 積 表			
街区番号	24	番号	／	
町 名	松 室 吾 田 神 町			
京 都 市 洛 西 第 二 土 地 区 画 整 理 組 合				

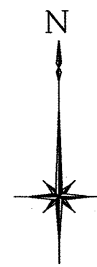

S = 1 : 250

松室荒堀町

22

26

28

29

図面の種類		画地出来形確認測量図			
街区番号		25	番号	縮尺	1 : 250
町名		松室吾田神町			
京都市洛西第二土地地区画整理組合					

304			
地番	松吾田一		
N O	X	Y	辺長
3496	-111315.028	-27958.574	
3455	-111316.155	-27960.855	2.544
3456	-111330.188	-27961.909	14.073
3457	-111331.033	-27962.001	0.850
3634	-111331.064	-27952.564	9.437
3495	-111330.122	-27952.552	0.942
3559	-111330.066	-27947.943	4.609
3558	-111328.436	-27947.783	1.638
3490	-111319.878	-27951.476	9.321
3489	-111318.871	-27952.949	1.784
3496	-111315.028	-27958.574	6.812
面積	160.8607010		
地積	160.86㎡		

305			
地番	保 二五ノ一号		
N O	X	Y	辺長
3558	-111328.436	-27947.783	
3559	-111330.066	-27947.943	1.638
3560	-111332.115	-27947.674	2.067
3561	-111336.347	-27947.484	4.236
970	-111342.879	-27947.782	6.539
3562	-111343.268	-27947.800	0.389
3563	-111346.794	-27948.079	3.537
3564	-111349.305	-27947.931	2.515
3565	-111352.133	-27947.322	2.893
3566	-111355.867	-27945.633	4.098
971	-111355.850	-27945.564	0.071
3567	-111355.722	-27945.040	0.539
964	-111354.857	-27941.469	3.674
3568	-111354.699	-27940.818	0.670
3555	-111351.514	-27926.876	14.301
3554	-111344.375	-27927.946	7.219
3553	-111339.957	-27930.757	5.236
3558	-111328.436	-27947.783	20.558
面積	368.7859815		
地積	368.78㎡		

306			
地番	保 二五ノ三号		
N O	X	Y	辺長
3555	-111351.514	-27926.876	
3568	-111354.699	-27940.818	14.301
964	-111354.857	-27941.469	0.670
963	-111354.886	-27926.371	15.098
3555	-111351.514	-27926.876	3.410
面積	25.5126060		
地積	25.51㎡		

307			
地番	松吾田一三ノ一		
N O	X	Y	辺長
963	-111354.886	-27926.371	
964	-111354.857	-27941.469	15.098
965	-111368.353	-27936.788	14.285
3570	-111368.192	-27936.290	0.523
3572	-111366.542	-27931.198	5.353
3571	-111364.619	-27931.843	2.028
3557	-111363.139	-27927.488	4.600
3556	-111362.565	-27925.221	2.339
963	-111354.886	-27926.371	7.765
面積	147.8003485		
地積	147.80㎡		

308			
地番	保 二五ノ二号		
N O	X	Y	辺長
964	-111354.857	-27941.469	
3567	-111355.722	-27945.040	3.674
3569	-111369.482	-27940.267	14.564
965	-111368.353	-27936.788	3.658
964	-111354.857	-27941.469	14.285
面積	52.7515190		
地積	52.75㎡		

309			
地番	松吾田一二, 松吾田一三ノ二		
N O	X	Y	辺長
3556	-111362.565	-27925.221	
3557	-111363.139	-27927.488	2.339
3571	-111364.619	-27931.843	4.600
3572	-111366.542	-27931.198	2.028
3570	-111368.192	-27936.290	5.353
965	-111368.353	-27936.788	0.523
3569	-111369.482	-27940.267	3.658
3484	-111375.231	-27938.267	6.087
3488	-111374.147	-27934.681	3.746
3485	-111376.502	-27933.815	2.509
3486	-111380.793	-27931.937	4.684
969	-111384.447	-27929.674	4.298
968	-111382.142	-27922.245	7.778
5308	-111382.072	-27922.255	0.071
3498	-111366.722	-27924.598	15.528
3556	-111362.565	-27925.221	4.203
面積	220.6609770		
地積	220.66㎡		

310			
地番	保 二五ノ五号		
N O	X	Y	辺長
968	-111382.142	-27922.245	
969	-111384.447	-27929.674	7.778
3487	-111385.453	-27929.051	1.183
3503	-111386.839	-27925.339	3.962
3501	-111385.708	-27921.718	3.794
968	-111382.142	-27922.245	3.605
面積	22.0708300		
地積	22.07㎡		

311			
地番	保 二五ノ四号		
N O	X	Y	辺長
3484	-111375.231	-27938.267	
3569	-111369.482	-27940.267	6.087
3567	-111355.722	-27945.040	14.564
971	-111355.850	-27945.564	0.539
967	-111359.676	-27943.828	4.201
966	-111375.275	-27938.411	16.513
3484	-111375.231	-27938.267	0.151
面積	3.8835735		
地積	3.88㎡		

312			
地番	松吾田二ノ九		
N O	X	Y	辺長
3628	-111355.925	-27945.884	
3629	-111356.547	-27947.328	1.572
3497	-111359.931	-27948.262	3.511
3483	-111377.238	-27944.902	17.630
966	-111375.275	-27938.411	6.781
967	-111359.676	-27943.828	16.513
971	-111355.850	-27945.564	4.201
3566	-111355.867	-27945.633	0.071
3628	-111355.925	-27945.884	0.258
面積	106.1493675		
地積	106.14㎡		

313			
地番	松吾田二ノ八		
N O	X	Y	辺長
3497	-111359.931	-27948.262	
3471	-111359.796	-27952.871	4.611
3474	-111366.247	-27952.670	6.454
3481	-111379.081	-27950.827	12.966
3482	-111377.444	-27945.584	5.493
3483	-111377.238	-27944.902	0.712
3497	-111359.931	-27948.262	17.630
面積	103.3091315		
地積	103.30㎡		

314			
地番	松吾田二ノ七		
N O	X	Y	辺長
3481	-111379.081	-27950.827	
3474	-111366.247	-27952.670	12.966
3473	-111366.052	-27958.456	5.789
3479	-111380.447	-27959.060	14.408
3480	-111380.596	-27955.682	3.381
3481	-111379.081	-27950.827	5.086
面積	98.7140875		
地積	98.71㎡		

315			
地番	松吾田二ノ六		
N O	X	Y	辺長
3479	-111380.447	-27959.060	
3473	-111366.052	-27958.456	14.408
3472	-111365.823	-27964.435	5.983
3478	-111380.137	-27966.055	14.405
3479	-111380.447	-27959.060	7.002
面積	93.4173255		
地積	93.41㎡		

316			
地番	松吾田二ノ五		
N O	X	Y	辺長
3478	-111380.137	-27966.055	
3472	-111365.823	-27964.435	14.405
3465	-111365.637	-27969.157	4.726
3466	-111367.526	-27970.054	2.091
3467	-111371.623	-27972.256	4.651
3475	-111376.973	-27975.247	6.129
3476	-111379.833	-27973.743	3.231
3477	-111379.930	-27970.744	3.001
3478	-111380.137	-27966.055	4.694
面積	105.4583795		
地積	105.45㎡		

317			
地番	松吾田二ノ四		
N O	X	Y	辺長
3468	-111359.284	-27966.598	
3469	-111359.877	-27966.798	0.626
3470	-111362.179	-27967.651	2.455
3464	-111365.101	-27968.903	3.179
3465	-111365.637	-27969.157	0.593
3472	-111365.823	-27964.435	4.726
3473	-111366.052	-27958.456	5.983
3474	-111366.247	-27952.670	5.789
3471	-111359.796	-27952.871	6.454
3468	-111359.284	-27966.598	13.737
面積	97.1314880		
地積	97.13㎡		

318			
地番	松吾田二		
N O	X	Y	辺長
3462	-111353.822	-27964.838	
3463	-111356.948	-27965.810	3.274
3468	-111359.284	-27966.598	2.465
3471	-111359.796	-27952.871	13.737
3497	-111359.931	-27948.262	4.611
3629	-111356.547	-27947.328	3.511
3630	-111356.525	-27947.364	0.042
3631	-111355.532	-27949.702	2.540
3632	-111355.148	-27950.411	0.806
3633	-111354.461	-27952.727	2.416
3462	-111353.822	-27964.838	12.128
面積	93.0811320		
地積	93.08㎡		

319			
地番	松吾田一ノ一		
N O	X	Y	辺長
3458	-111342.804	-27963.286	
3459	-111343.807	-27963.396	1.009
3460	-111353.008	-27964.685	9.291
3461	-111353.776	-27964.824	0.780
3462	-111353.822	-27964.838	0.048
3633	-111354.461	-27952.727	12.128
3632	-111355.148	-27950.411	2.416
3631	-111355.532	-27949.702	0.806
3630	-111356.525	-27947.364	2.540
3629	-111356.547	-27947.328	0.042
3628	-111355.925	-27945.884	1.572
3566	-111355.867	-27945.633	0.258
3565	-111352.133	-27947.322	4.098
3564	-111349.305	-27947.931	2.893
3563	-111346.794	-27948.079	2.515
3562	-111343.268	-27947.800	3.537
970	-111342.879	-27947.782	0.389
3458	-111342.804	-27963.286	15.504
面積	194.7192100		
地積	194.71㎡		

320			
地番	松吾田一ノ四		
N O	X	Y	辺長
3457	-111331.033	-27962.001	
3458	-111342.804	-27963.286	11.841
970	-111342.879	-27947.782	15.504
3561	-111336.347	-27947.484	6.539
3560	-111332.115	-27947.674	4.236
3559	-111330.066	-27947.943	2.067
3495	-111330.122	-27952.552	4.609
3634	-111331.064	-27952.564	0.942
3457	-111331.033	-27962.001	9.437
面積	181.6367265		
地積	181.63		m ²



S = 1 : 250

松室荒堀町

X-111400

X-111400

Y-28000

Y-27850

Y-27900

Y-28000

Y-27850

X-111450

X-111450

22

25

29

23

27

30

図面の種類	画 地 出 来 形 確 認 測 量 図				
街区 番号	26	番号	／	縮 尺	1 : 2 5 0
町 名	松 室 吾 田 神 町				
京 都 市 洛 西 第 二 土 地 区 画 整 理 組 合					

255

地番	松吾田四ノ一		
N O	X	Y	辺長
3543	-111385.850	-27972.676	
3544	-111385.704	-27975.894	3.221
3545	-111388.099	-27980.513	5.203
3546	-111392.992	-27983.683	5.830
3547	-111393.027	-27980.572	3.111
3548	-111393.064	-27977.373	3.199
3549	-111393.081	-27975.820	1.553
3550	-111393.119	-27972.771	3.049
3543	-111385.850	-27972.676	7.270
面積	59.4519795		
地積	59.45 ㎡		

256

地番	松吾田四ノ二		
N O	X	Y	辺長
3543	-111385.850	-27972.676	
3550	-111393.119	-27972.771	7.270
3551	-111393.140	-27971.065	1.706
3552	-111393.197	-27966.211	4.854
3542	-111386.150	-27966.105	7.048
3543	-111385.850	-27972.676	6.578
面積	47.0171895		
地積	47.01 ㎡		

257

地番	保 二六ノ四号		
N O	X	Y	辺長
3542	-111386.150	-27966.105	
3552	-111393.197	-27966.211	7.048
3601	-111400.755	-27966.338	7.559
3541	-111401.023	-27960.451	5.893
3524	-111386.417	-27960.225	14.608
3542	-111386.150	-27966.105	5.886
面積	85.9459400		
地積	85.94 ㎡		

258

地番	保 二六ノ五号		
N O	X	Y	辺 長
3524	-111386.417	-27960.225	
3541	-111401.023	-27960.451	14.608
976	-111401.033	-27960.235	0.216
3540	-111401.354	-27953.171	7.071
3523	-111386.650	-27955.111	14.831
3524	-111386.417	-27960.225	5.119
面積	90.5760130		
地積	90.57 ㎡		

259			
地番	松吾田九ノ九		
N O	X	Y	辺長
3523	-111386.650	-27955.111	
3540	-111401.354	-27953.171	14.831
3535	-111404.047	-27952.829	2.715
3536	-111403.282	-27947.242	5.639
2969	-111396.814	-27948.123	6.528
3521	-111385.018	-27949.729	11.905
3522	-111386.657	-27954.959	5.481
3523	-111386.650	-27955.111	0.152
面積	100.4061715		
地積	100.40㎡		

260-1

地番	松吾田九ノ二		
N O	X	Y	辺長
3521	-111385.018	-27949.729	
2969	-111396.814	-27948.123	11.905
2970	-111396.019	-27942.277	5.900
2976	-111392.183	-27942.799	3.871
2977	-111383.229	-27944.018	9.037
3521	-111385.018	-27949.729	5.985
面積	73.1983105		
地積	73.19 m ²		

260-2

地番	松吾田九ノ一一		
N O	X	Y	辺長
2977	-111383.229	-27944.018	
2976	-111392.183	-27942.799	9.037
2978	-111389.060	-27932.551	10.713
3518	-111388.108	-27933.286	1.203
3519	-111383.490	-27936.153	5.436
3520	-111381.558	-27938.685	3.185
2977	-111383.229	-27944.018	5.589
面積	76.1524695		
地積	76.15 m ²		

260-3

地番	松吾田九ノ一二		
N O	X	Y	辺長
2969	-111396.814	-27948.123	
3536	-111403.282	-27947.242	6.528
3537	-111404.855	-27947.026	1.588
2984	-111403.252	-27938.768	8.412
2985	-111393.954	-27940.035	9.384
2986	-111391.175	-27930.917	9.532
2978	-111389.060	-27932.551	2.673
2976	-111392.183	-27942.799	10.713
2970	-111396.019	-27942.277	3.871
2969	-111396.814	-27948.123	5.900
面積	98.4967330		
地積	98.49 ㎡		

260-4

地番	松吾田九ノ一三		
N O	X	Y	辺長
2986	-111391.175	-27930.917	
2985	-111393.954	-27940.035	9.532
2984	-111403.252	-27938.768	9.384
3526	-111401.710	-27930.827	8.089
3525	-111394.629	-27933.674	7.632
3517	-111393.291	-27929.283	4.590
2986	-111391.175	-27930.917	2.673
面積	77.1095825		
地積	77.10 ㎡		

261			
地番	松吾田一一ノ一		
N O	X	Y	辺長
3525	-111394.629	-27933.674	
3526	-111401.710	-27930.827	7.632
3527	-111405.218	-27929.362	3.802
3528	-111405.014	-27928.879	0.524
3514	-111401.052	-27919.409	10.265
5315	-111392.792	-27920.646	8.352
3516	-111390.712	-27920.968	2.105
3517	-111393.291	-27929.283	8.706
3525	-111394.629	-27933.674	4.590
面積	130.5493740		
地積	130.54㎡		

262

地番	松吾田五一ノ一四		
N O	X	Y	辺長
3528	-111405.014	-27928.879	
3529	-111410.733	-27926.787	6.090
3512	-111409.417	-27918.150	8.737
3513	-111404.178	-27918.941	5.298
3514	-111401.052	-27919.409	3.161
3528	-111405.014	-27928.879	10.265
面積	68.1659845		
地積	68.16 ㎡		

263

地番	保 二六ノ二号		
N O	X	Y	辺 長
3529	-111410.733	-27926.787	
979	-111417.771	-27924.202	7.498
3539	-111417.407	-27921.803	2.426
3507	-111416.687	-27917.051	4.806
3512	-111409.417	-27918.150	7.353
3529	-111410.733	-27926.787	8.737
面積	58.6828520		
地積	58.68 ㎡		

264

地番	松吾田九ノ七		
N O	X	Y	辺長
3529	-111410.733	-27926.787	
3538	-111418.001	-27925.714	7.347
979	-111417.771	-27924.202	1.529
3529	-111410.733	-27926.787	7.498
面積	5.6180030		
地積	5.61 ㎡		

265

地番	保 二六ノ六号		
N O	X	Y	辺 長
3539	-111417.407	-27921.803	
981	-111422.614	-27921.032	5.264
3506	-111421.897	-27916.264	4.822
3507	-111416.687	-27917.051	5.269
3539	-111417.407	-27921.803	4.806
面積	25.3521715		
地積	25.35 ㎡		

266			
地番	松吾田九ノ五		
N O	X	Y	辺長
981	-111422.614	-27921.032	
3620	-111428.763	-27920.119	6.216
3756	-111428.824	-27915.215	4.904
3757	-111428.434	-27915.277	0.395
3506	-111421.897	-27916.264	6.611
981	-111422.614	-27921.032	4.822
面積	31.9293540		
地積	31.92 ㎡		

267

地番	保 二六ノ七号		
N O	X	Y	辺 長
979	-111417.771	-27924.202	
980	-111422.811	-27922.353	5.368
981	-111422.614	-27921.032	1.336
3539	-111417.407	-27921.803	5.264
979	-111417.771	-27924.202	2.426
面積	9.8971650		
地積	9.89 m ²		

268			
地番	松吾田九ノ六		
N O	X	Y	辺長
3538	-111418.001	-27925.714	
3619	-111428.714	-27924.117	10.831
3620	-111428.763	-27920.119	3.998
981	-111422.614	-27921.032	6.216
980	-111422.811	-27922.353	1.336
979	-111417.771	-27924.202	5.368
3538	-111418.001	-27925.714	1.529
面積	34.1799465		
地積	34.17 m ²		

282			
地番	松吾田七ノ二		
N O	X	Y	辺長
3613	-111428.246	-27960.597	
3612	-111428.273	-27958.220	2.377
3611	-111428.287	-27957.136	1.084
3610	-111425.244	-27960.136	4.273
3609	-111421.839	-27960.088	3.405
3608	-111417.139	-27960.023	4.700
3607	-111412.449	-27959.965	4.690
3606	-111410.526	-27959.941	1.923
3621	-111410.050	-27960.359	0.633
3613	-111428.246	-27960.597	18.198
面積	12.2047725		
地積	12.20㎡		

283			
地番	松吾田八ノ一		
N O	X	Y	辺長
3575	-111399.768	-27988.074	
3576	-111406.731	-27992.585	8.297
3577	-111410.468	-27995.001	4.450
3590	-111407.958	-27990.338	5.296
3589	-111407.958	-27990.194	0.144
3588	-111408.013	-27985.441	4.753
3587	-111408.065	-27980.692	4.749
3586	-111408.116	-27975.942	4.750
3585	-111408.185	-27969.942	6.000
3599	-111412.734	-27965.989	6.027
3598	-111413.524	-27966.001	0.790
3597	-111418.226	-27966.063	4.702
3596	-111425.192	-27966.152	6.967
3595	-111428.149	-27969.234	4.271
3613	-111428.246	-27960.597	8.638
3621	-111410.050	-27960.359	18.198
3605	-111407.639	-27962.441	3.186
3603	-111404.433	-27965.207	4.234
3602	-111403.681	-27965.865	0.999
3600	-111402.186	-27967.151	1.972
3584	-111402.136	-27971.169	4.018
3583	-111402.082	-27975.918	4.749
3582	-111402.028	-27980.665	4.747
3581	-111401.974	-27985.050	4.385
3574	-111399.849	-27986.207	2.420
3575	-111399.768	-27988.074	1.869
面積	296.8326110		
地積	296.83㎡		

284			
地番	松吾田八ノ一一		
N O	X	Y	辺長
983	-111418.144	-27971.327	
3594	-111428.124	-27971.429	9.981
3595	-111428.149	-27969.234	2.195
3596	-111425.192	-27966.152	4.271
3597	-111418.226	-27966.063	6.967
983	-111418.144	-27971.327	5.265
面積	47.8046915		
地積	47.80㎡		

285			
地番	松吾田八ノ一〇		
N O	X	Y	辺長
3627	-111418.070	-27976.079	
3593	-111428.070	-27976.190	10.001
3594	-111428.124	-27971.429	4.761
983	-111418.144	-27971.327	9.981
3627	-111418.070	-27976.079	4.753
面積	47.5242510		
地積	47.52㎡		

286			
地番	松吾田八ノ九		
N O	X	Y	辺長
982	-111413.358	-27975.999	
3626	-111416.084	-27976.029	2.726
3627	-111418.070	-27976.079	1.987
983	-111418.144	-27971.327	4.753
3597	-111418.226	-27966.063	5.265
3598	-111413.524	-27966.001	4.702
982	-111413.358	-27975.999	9.999
面積	47.0759560		
地積	47.07㎡		

287			
地番	松吾田八ノ八		
N O	X	Y	辺長
3586	-111408.116	-27975.942	
982	-111413.358	-27975.999	5.242
3598	-111413.524	-27966.001	9.999
3599	-111412.734	-27965.989	0.790
3585	-111408.185	-27969.942	6.027
3586	-111408.116	-27975.942	6.000
面積	43.6792535		
地積	43.67㎡		

288			
地番	松吾田八ノ七		
N O	X	Y	辺長
3587	-111408.065	-27980.692	
3625	-111416.027	-27980.782	7.963
3626	-111416.084	-27976.029	4.753
982	-111413.358	-27975.999	2.726
3586	-111408.116	-27975.942	5.242
3587	-111408.065	-27980.692	4.750
面積	37.8514155		
地積	37.85㎡		

289			
地番	松吾田八ノ六		
N O	X	Y	辺長
3588	-111408.013	-27985.441	
3624	-111415.980	-27985.532	7.968
3625	-111416.027	-27980.782	4.750
3587	-111408.065	-27980.692	7.963
3588	-111408.013	-27985.441	4.749
面積	37.8318725		
地積	37.83㎡		

290			
地番	松吾田八ノ五		
N O	X	Y	辺長
3589	-111407.958	-27990.194	
3622	-111415.931	-27990.286	7.974
3623	-111415.976	-27986.465	3.821
3624	-111415.980	-27985.532	0.933
3588	-111408.013	-27985.441	7.968
3589	-111407.958	-27990.194	4.753
面積	37.9035035		
地積	37.90㎡		

291			
地番	松吾田八ノ四		
N O	X	Y	辺長
3577	-111410.468	-27995.001	
3580	-111415.850	-27998.481	6.409
3622	-111415.931	-27990.286	8.195
3589	-111407.958	-27990.194	7.974
3590	-111407.958	-27990.338	0.144
3577	-111410.468	-27995.001	5.296
面積	41.4220505		
地積	41.42㎡		

292			
地番	保 二六ノ三号		
N O	X	Y	辺長
3623	-111415.976	-27986.465	
3591	-111427.952	-27986.621	11.977
3592	-111428.025	-27980.212	6.409
3593	-111428.070	-27976.190	4.022
3627	-111418.070	-27976.079	10.001
3626	-111416.084	-27976.029	1.987
3625	-111416.027	-27980.782	4.753
3624	-111415.980	-27985.532	4.750
3623	-111415.976	-27986.465	0.933
面積	124.8376870		
地積	124.93㎡		

293			
地番	松吾田五, 松吾田六		
N O	X	Y	辺長
3580	-111415.850	-27998.481	
3578	-111425.186	-28004.517	11.117
3579	-111427.764	-28003.142	2.922
3591	-111427.952	-27986.621	16.522
3623	-111415.976	-27986.465	11.977
3622	-111415.931	-27990.286	3.821
3580	-111415.850	-27998.481	8.195
面積	185.0439080		
地積	185.04㎡		

294			
地番	松吾田三ノ一		
N O	X	Y	辺長
3573	-111398.239	-27987.083	
3575	-111399.768	-27988.074	1.822
3574	-111399.849	-27986.207	1.869
3573	-111398.239	-27987.083	1.833
面積	1.4674570		
地積	1.46㎡		

295			
地番	松吾田四ノ三		
N O	X	Y	辺長
3546	-111392.992	-27983.683	
3573	-111398.239	-27987.083	6.252
3574	-111399.849	-27986.207	1.833
972	-111400.103	-27980.645	5.568
3547	-111393.027	-27980.572	7.076
3546	-111392.992	-27983.683	3.111
面積	95.4330465		
地積	95.43㎡		

296			
地番	松吾田八ノ一二		
N O	X	Y	辺長
3574	-111399.849	-27986.207	
3581	-111401.974	-27985.050	2.420
3582	-111402.028	-27980.665	4.385
972	-111400.103	-27980.645	1.925
3574	-111399.849	-27986.207	5.568
面積	9.9837885		
地積	9.98㎡		

297			
地番	松吾田四ノ四		
N O	X	Y	辺長
3547	-111393.027	-27980.572	
972	-111400.103	-27980.645	7.076
973	-111400.260	-27977.198	3.451
3548	-111393.064	-27977.373	7.198
3547	-111393.027	-27980.572	3.199
面積	23.7079810		
地積	23.70㎡		


298			
地番	松吾田三ノ四		
N O	X	Y	辺長
3548	-111393.064	-27977.373	
973	-111400.260	-27977.198	7.198
974	-111400.319	-27975.899	1.300
3549	-111393.081	-27975.820	7.238
3548	-111393.064	-27977.373	1.553
面積	10.2896180		
地積	10.28㎡		

299			
地番	松吾田八ノ一三		
N O	X	Y	辺長
972	-111400.103	-27980.645	
3582	-111402.028	-27980.665	1.925
3583	-111402.082	-27975.918	4.747
974	-111400.319	-27975.899	1.763
973	-111400.260	-27977.198	1.300
972	-111400.103	-27980.645	3.451
面積	8.7548935		
地積	8.75㎡		

300			
地番	松吾田三ノ三		
N O	X	Y	辺長
3549	-111393.081	-27975.820	
974	-111400.319	-27975.899	7.238
975	-111400.536	-27971.150	4.754
3551	-111393.140	-27971.065	7.396
3550	-111393.119	-27972.771	1.706
3549	-111393.081	-27975.820	3.049
面積	34.7813005		
地積	34.78㎡		

301			
地番	松吾田八ノ一四		
N O	X	Y	辺長
974	-111400.319	-27975.899	
3583	-111402.082	-27975.918	1.763
3584	-111402.136	-27971.169	4.749
975	-111400.536	-27971.150	1.600
974	-111400.319	-27975.899	4.754
面積	7.9880180		
地積	7.98㎡		

302			
地番	松吾田三ノ二		
N O	X	Y	辺長
3551	-111393.140	-27971.065	
975	-111400.536	-27971.150	7.396
3601	-111400.755	-27966.338	4.817
3552	-111393.197	-27966.211	7.559
3551	-111393.140	-27971.065	4.854
面積	36.1509690		
地積	36.15 m ²		

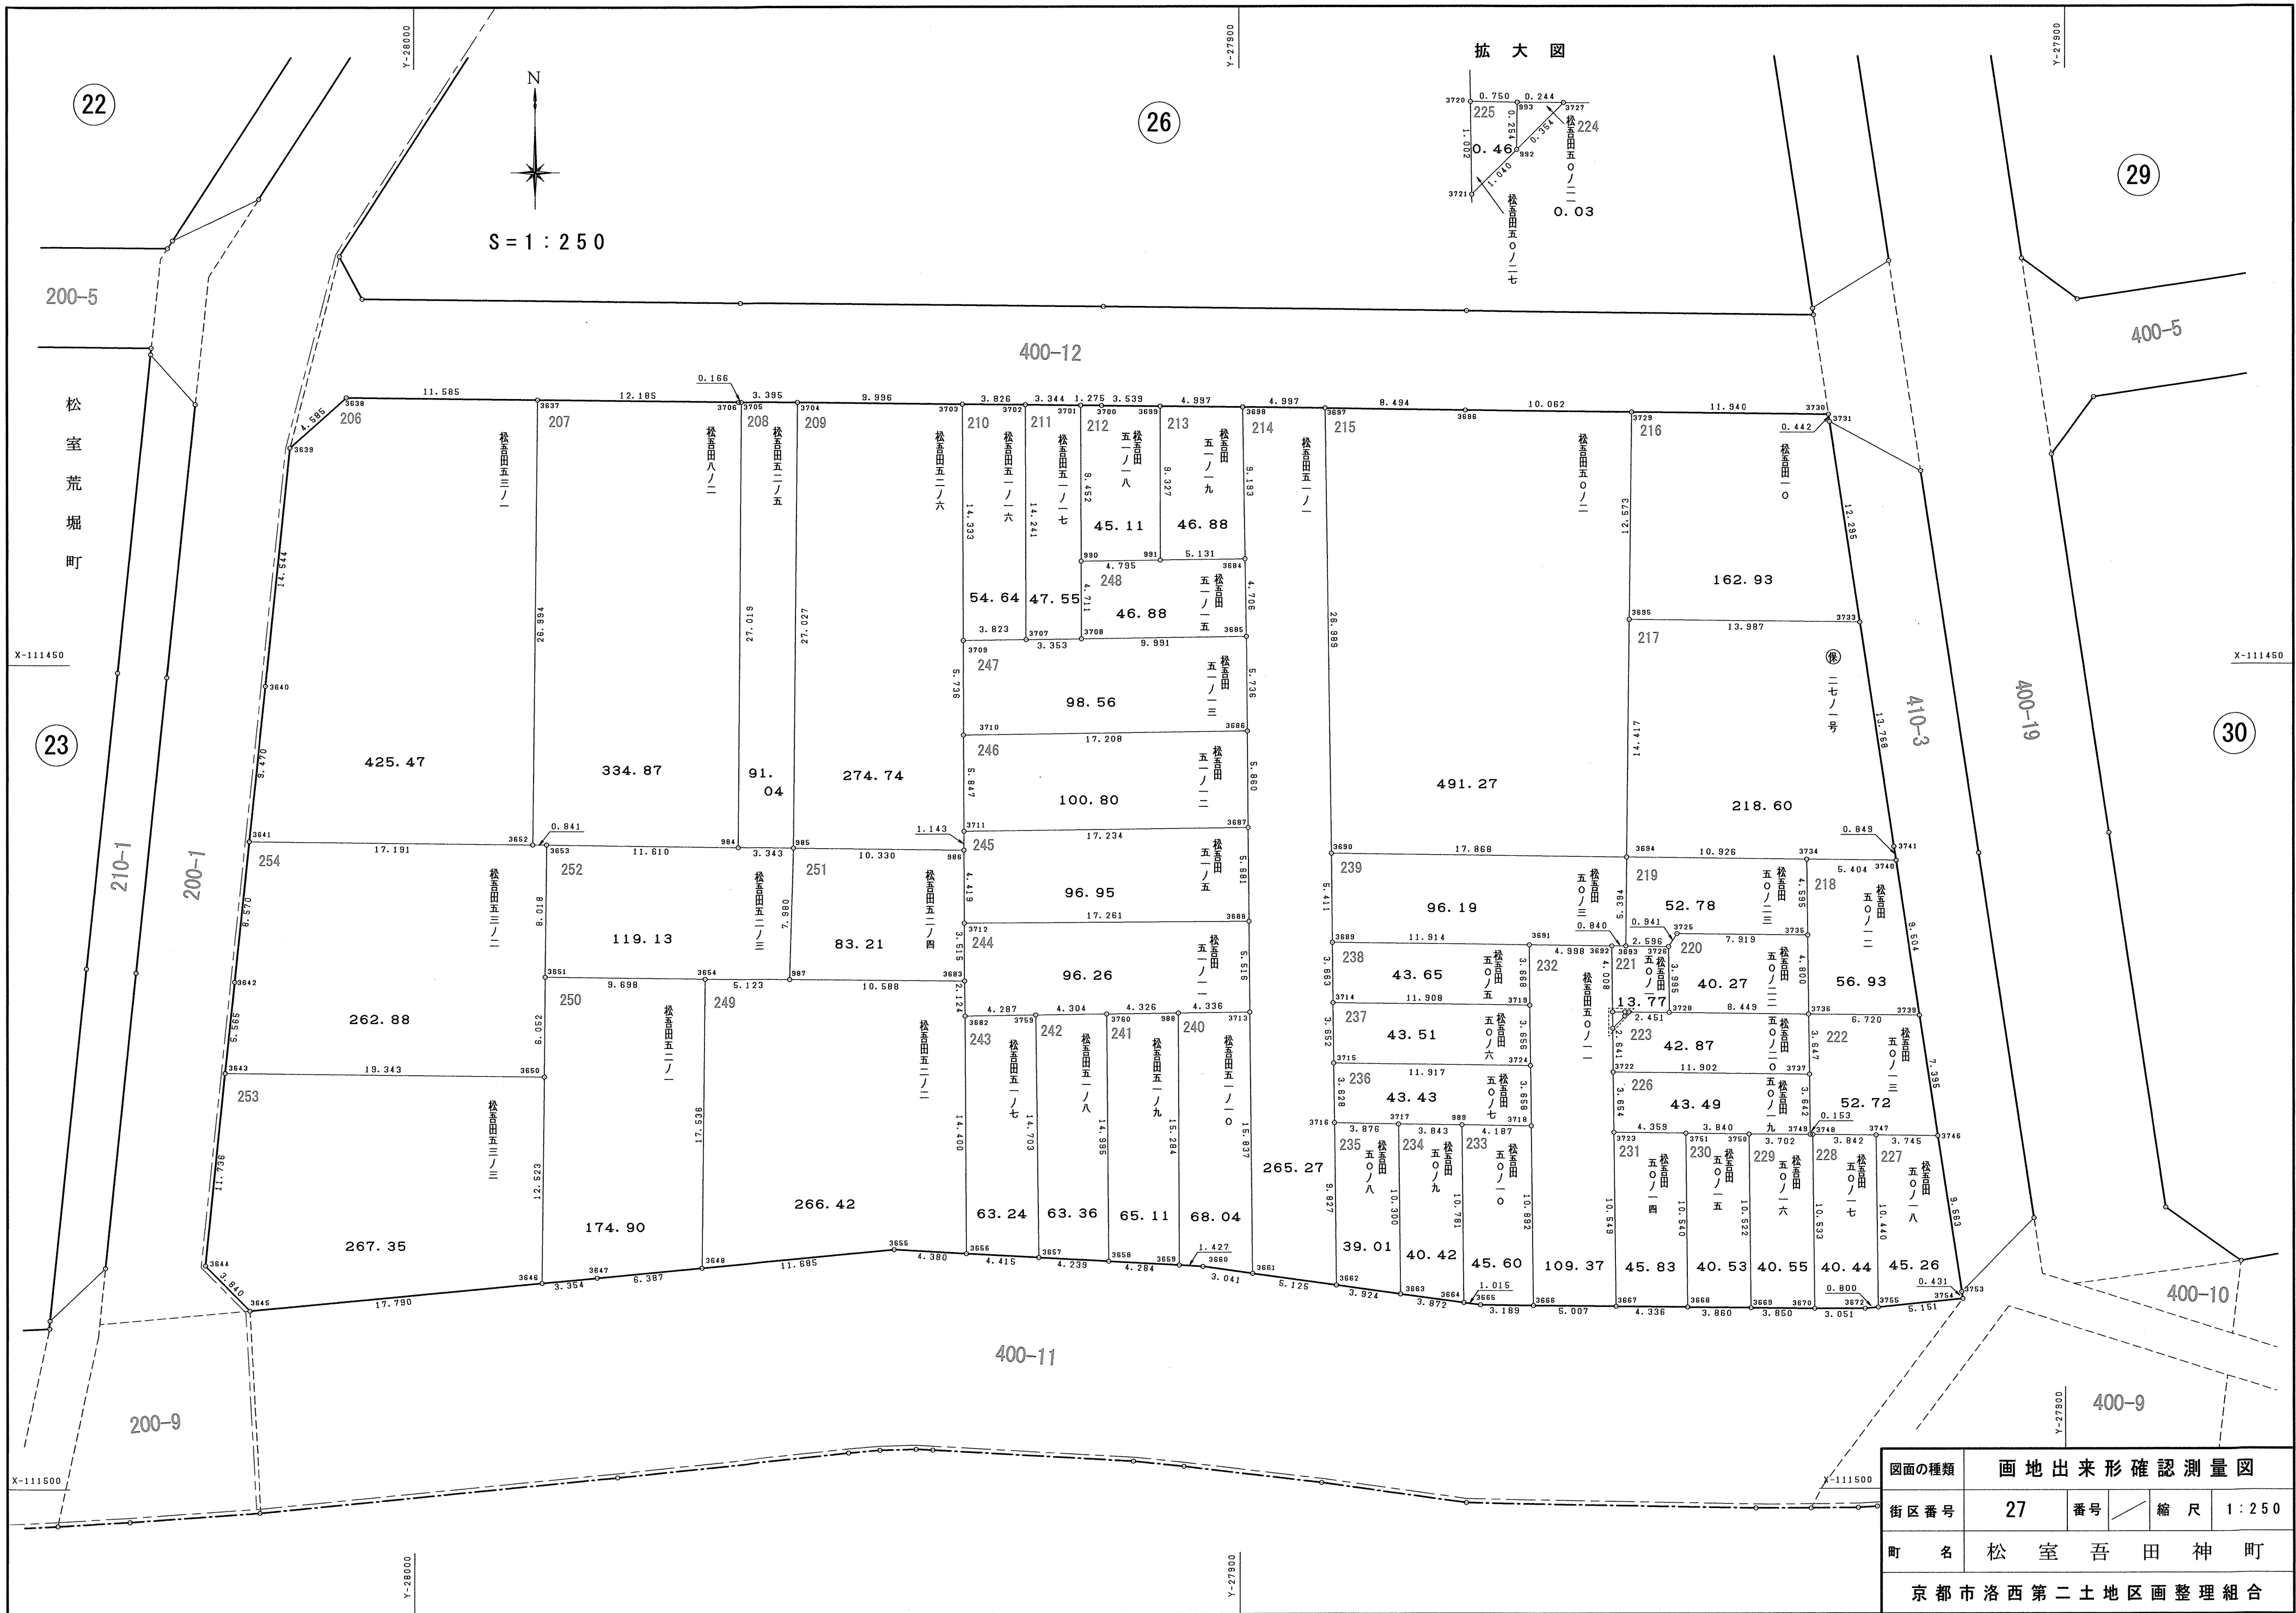

図面の種類	画地出来形確認測量図				
街区番号	27	番号		縮尺	1：250
町名	松室吾田神町				
京都市洛西第二土地区画整理組合					

206			
地番	松吾田五三ノ一		
N O	X	Y	辺長
3638	-111433.746	-28004.097	
3639	-111436.796	-28007.520	4.585
3640	-111451.262	-28009.026	14.544
3641	-111460.681	-28010.012	9.470
3652	-111460.874	-27992.822	17.191
3637	-111433.882	-27992.513	26.994
3638	-111433.746	-28004.097	11.585
面積	425.4754450		
地積	425.47㎡		

207			
地番	松吾田八ノ二		
N O	X	Y	辺長
3637	-111433.882	-27992.513	
3652	-111460.874	-27992.822	26.994
3653	-111460.881	-27991.981	0.841
984	-111461.046	-27980.372	11.610
3705	-111434.028	-27980.163	27.019
3706	-111434.026	-27980.329	0.166
3637	-111433.882	-27992.513	12.185
面積	334.8746620		
地積	334.87㎡		

208			
地番	松吾田五二ノ五		
N O	X	Y	辺長
3705	-111434.028	-27980.163	
984	-111461.046	-27980.372	27.019
985	-111461.093	-27977.029	3.343
3704	-111434.067	-27976.768	27.027
3705	-111434.028	-27980.163	3.395
面積	91.0472230		
地積	91.04㎡		

209			
地番	松吾田五二ノ六		
N O	X	Y	辺長
3704	-111434.067	-27976.768	
985	-111461.093	-27977.029	27.027
986	-111461.240	-27966.700	10.330
3711	-111460.097	-27966.704	1.143
3710	-111454.250	-27966.725	5.847
3709	-111448.514	-27966.738	5.736
3703	-111434.181	-27966.773	14.333
3704	-111434.067	-27976.768	9.996
面積	274.7425725		
地積	274.74㎡		

210			
地番	松吾田五一ノ一六		
N O	X	Y	辺長
3703	-111434.181	-27966.773	
3709	-111448.514	-27966.738	14.333
3707	-111448.465	-27962.915	3.823
3702	-111434.224	-27962.947	14.241
3703	-111434.181	-27966.773	3.826
面積	54.6407320		
地積	54.64㎡		

211			
地番	松吾田五一ノ一七		
N O	X	Y	辺長
3702	-111434.224	-27962.947	
3707	-111448.465	-27962.915	14.241
3708	-111448.425	-27959.562	3.353
990	-111443.714	-27959.576	4.711
3701	-111434.262	-27959.603	9.452
3702	-111434.224	-27962.947	3.344
面積	47.5528680		
地積	47.55㎡		

212			
地番	松吾田五一ノ一八		
N O	X	Y	辺長
3701	-111434.262	-27959.603	
990	-111443.714	-27959.576	9.452
991	-111443.654	-27954.781	4.795
3699	-111434.327	-27954.789	9.327
3700	-111434.277	-27958.328	3.539
3701	-111434.262	-27959.603	1.275
面積	45.1171415		
地積	45.11㎡		

213			
地番	松吾田五一ノ一九		
N O	X	Y	辺長
3699	-111434.327	-27954.789	
991	-111443.654	-27954.781	9.327
3684	-111443.589	-27949.650	5.131
3698	-111434.397	-27949.792	9.193
3699	-111434.327	-27954.789	4.997
面積	46.8899205		
地積	46.88㎡		

214			
地番	松吾田五一ノ一		
N O	X	Y	辺長
3698	-111434.397	-27949.792	
3684	-111443.589	-27949.650	9.193
3685	-111448.294	-27949.572	4.706
3686	-111454.030	-27949.518	5.736
3687	-111459.890	-27949.471	5.860
3688	-111465.571	-27949.424	5.681
3713	-111471.087	-27949.381	5.516
3661	-111486.923	-27949.223	15.837
3662	-111487.634	-27944.148	5.125
3716	-111477.808	-27944.252	9.827
3715	-111474.180	-27944.302	3.628
3714	-111470.528	-27944.339	3.652
3689	-111466.865	-27944.372	3.663
3690	-111461.454	-27944.428	5.411
3697	-111434.467	-27944.795	26.989
3698	-111434.397	-27949.792	4.997
面積	265.2700630		
地積	265.27㎡		

215			
地番	松吾田五〇ノ二		
N O	X	Y	辺長
3697	-111434.467	-27944.795	
3690	-111461.454	-27944.428	26.989
3694	-111461.699	-27926.562	17.868
3695	-111447.283	-27926.397	14.417
3729	-111434.711	-27926.241	12.573
3696	-111434.587	-27936.302	10.062
3697	-111434.467	-27944.795	8.494
面積	491.2723995		
地積	491.27㎡		

216			
地番	松吾田一〇		
N O	X	Y	辺長
3729	-111434.711	-27926.241	
3695	-111447.283	-27926.397	12.573
3733	-111447.454	-27912.411	13.987
3731	-111435.296	-27914.243	12.295
3730	-111434.858	-27914.302	0.442
3729	-111434.711	-27926.241	11.940
面積	162.9396205		
地積	162.93㎡		

217			
地番	保 二七ノ一号		
N O	X	Y	辺長
3695	-111447.283	-27926.397	
3694	-111461.699	-27926.562	14.417
3734	-111461.839	-27915.637	10.926
3740	-111461.907	-27910.233	5.404
3741	-111461.068	-27910.360	0.849
3733	-111447.454	-27912.411	13.768
3695	-111447.283	-27926.397	13.987
面積	218.6029375		
地積	218.60㎡		

218			
地番	松吾田五〇ノ一二		
N O	X	Y	辺長
3734	-111461.839	-27915.637	
3735	-111466.434	-27915.590	4.595
3736	-111471.234	-27915.529	4.800
3739	-111471.304	-27908.809	6.720
3740	-111461.907	-27910.233	9.504
3734	-111461.839	-27915.637	5.404
面積	56.9330455		
地積	56.93㎡		

219			
地番	松吾田五〇ノ二三		
N O	X	Y	辺長
3694	-111461.699	-27926.562	
3693	-111467.093	-27926.621	5.394
3726	-111467.136	-27924.025	2.596
3725	-111466.349	-27923.509	0.941
3735	-111466.434	-27915.590	7.919
3734	-111461.839	-27915.637	4.595
3694	-111461.699	-27926.562	10.926
面積	52.7825560		
地積	52.78㎡		

220			
地番	松吾田五〇ノ二二		
N O	X	Y	辺長
3726	-111467.136	-27924.025	
3728	-111471.131	-27923.977	3.995
3736	-111471.234	-27915.529	8.449
3735	-111466.434	-27915.590	4.800
3725	-111466.349	-27923.509	7.919
3726	-111467.136	-27924.025	0.941
面積	40.2758755		
地積	40.27㎡		

221			
地番	松吾田五〇ノ一		
N O	X	Y	辺長
3692	-111467.085	-27927.461	
3720	-111471.093	-27927.422	4.008
993	-111471.101	-27926.672	0.750
3727	-111471.103	-27926.428	0.244
3728	-111471.131	-27923.977	2.451
3726	-111467.136	-27924.025	3.995
3693	-111467.093	-27926.621	2.596
3692	-111467.085	-27927.461	0.840
面積	13.7714660		
地積	13.77㎡		

222			
地番	松吾田五〇ノ一三		
N O	X	Y	辺長
3736	-111471.234	-27915.529	
3737	-111474.881	-27915.482	3.647
3749	-111478.523	-27915.441	3.642
3748	-111478.527	-27915.288	0.153
3747	-111478.571	-27911.446	3.842
3746	-111478.616	-27907.701	3.745
3739	-111471.304	-27908.809	7.395
3736	-111471.234	-27915.529	6.720
面積	52.7273650		
地積	52.72㎡		

223			
地番	松吾田五〇ノ二〇		
N O	X	Y	辺長
3721	-111472.095	-27927.408	
3722	-111474.736	-27927.383	2.641
3737	-111474.881	-27915.482	11.902
3736	-111471.234	-27915.529	3.647
3728	-111471.131	-27923.977	8.449
3727	-111471.103	-27926.428	2.451
992	-111471.355	-27926.677	0.354
3721	-111472.095	-27927.408	1.040
面積	42.8731205		
地積	42.87㎡		

224			
地番	松吾田五〇ノ二一		
N O	X	Y	辺長
993	-111471.101	-27926.672	
992	-111471.355	-27926.677	0.254
3727	-111471.103	-27926.428	0.354
993	-111471.101	-27926.672	0.244
面積	0.0309930		
地積	0.03㎡		

225			
地番	松吾田五〇ノ二七		
N O	X	Y	辺長
3720	-111471.093	-27927.422	
3721	-111472.095	-27927.408	1.002
992	-111471.355	-27926.677	1.040
993	-111471.101	-27926.672	0.254
3720	-111471.093	-27927.422	0.750
面積	0.4666810		
地積	0.46㎡		

226			
地番	松吾田五〇ノ一九		
N O	X	Y	辺長

235			
地番	松吾田五〇ノ八		
N O	X	Y	辺長
3716	-111477.808	-27944.252	
3662	-111487.634	-27944.148	9.827
3663	-111488.178	-27940.262	3.924
3717	-111477.879	-27940.377	10.300
3716	-111477.808	-27944.252	3.876
面積	39.0138600		
地積	39.01㎡		

236			
地番	松吾田五〇ノ七		
N O	X	Y	辺長
3715	-111474.180	-27944.302	
3716	-111477.808	-27944.252	3.628
3717	-111477.879	-27940.377	3.876
989	-111477.935	-27936.534	3.843
3718	-111477.997	-27932.347	4.187
3724	-111474.339	-27932.386	3.658
3715	-111474.180	-27944.302	11.917
面積	43.4367515		
地積	43.43㎡		

237			
地番	松吾田五〇ノ六		
N O	X	Y	辺長
3714	-111470.528	-27944.339	
3715	-111474.180	-27944.302	3.652
3724	-111474.339	-27932.386	11.917
3719	-111470.683	-27932.432	3.656
3714	-111470.528	-27944.339	11.908
面積	43.6181055		
地積	43.61㎡		

238			
地番	松吾田五〇ノ五		
N O	X	Y	辺長
3689	-111466.865	-27944.372	
3714	-111470.528	-27944.339	3.663
3719	-111470.683	-27932.432	11.908
3691	-111467.015	-27932.459	3.668
3689	-111466.865	-27944.372	11.914
面積	43.6515300		
地積	43.65㎡		

239			
地番	松吾田五〇ノ三		
N O	X	Y	辺長
3690	-111461.454	-27944.428	
3689	-111466.865	-27944.372	5.411
3691	-111467.015	-27932.459	11.914
3692	-111467.085	-27927.461	4.998
3693	-111467.093	-27926.621	0.840
3694	-111461.699	-27926.562	5.394
3690	-111461.454	-27944.428	17.868
面積	96.1934270		
地積	96.19㎡		

240			
地番	松吾田五一ノ一〇		
N O	X	Y	辺長
988	-111471.137	-27953.717	
3659	-111486.421	-27953.660	15.284
3660	-111486.501	-27952.235	1.427
3661	-111486.923	-27949.223	3.041
3713	-111471.087	-27949.381	15.837
988	-111471.137	-27953.717	4.336
面積	68.0494500		
地積	68.04㎡		

241			
地番	松吾田五一ノ九		
N O	X	Y	辺長
3760	-111471.187	-27958.043	
3658	-111486.182	-27957.937	14.995
3659	-111486.421	-27953.660	4.284
988	-111471.137	-27953.717	15.284
3760	-111471.187	-27958.043	4.326
面積	65.1148575		
地積	65.11㎡		

242			
地番	松吾田五一ノ八		
N O	X	Y	辺長
3759	-111471.243	-27962.347	
3657	-111485.945	-27962.169	14.703
3658	-111486.182	-27957.937	4.239
3760	-111471.187	-27958.043	14.995
3759	-111471.243	-27962.347	4.304
面積	63.3605470		
地積	63.36㎡		

243			
地番	松吾田五一ノ七		
N O	X	Y	辺長
3682	-111471.298	-27966.634	
3656	-111485.698	-27966.577	14.400
3657	-111485.945	-27962.169	4.415
3759	-111471.243	-27962.347	14.703
3682	-111471.298	-27966.634	4.287
面積	63.2491925		
地積	63.24㎡		

244			
地番	松吾田五一ノ一		
N O	X	Y	辺長
3712	-111465.659	-27966.685	
3683	-111469.174	-27966.674	3.515
3682	-111471.298	-27966.634	2.124
3759	-111471.243	-27962.347	4.287
3760	-111471.187	-27958.043	4.304
988	-111471.137	-27953.717	4.326
3713	-111471.087	-27949.381	4.336
3688	-111465.571	-27949.424	5.516
3712	-111465.659	-27966.685	17.261
面積	96.2667970		
地積	96.26㎡		

245			
地番	松吾田五一ノ五		
N O	X	Y	辺長
3711	-111460.097	-27966.704	
986	-111461.240	-27966.700	1.143
3712	-111465.659	-27966.685	4.419
3688	-111465.571	-27949.424	17.261
3687	-111459.890	-27949.471	5.681
3711	-111460.097	-27966.704	17.234
面積	96.9586125		
地積	96.95㎡		

246			
地番	松吾田五一ノ一二		
N O	X	Y	辺長
3710	-111454.250	-27966.725	
3711	-111460.097	-27966.704	5.847
3687	-111459.890	-27949.471	17.234
3686	-111454.030	-27949.518	5.860
3710	-111454.250	-27966.725	17.208
面積	100.8045290		
地積	100.80㎡		

247			
地番	松吾田五一ノ一三		
N O	X	Y	辺長
3709	-111448.514	-27966.738	
3710	-111454.250	-27966.725	5.736
3686	-111454.030	-27949.518	17.208
3685	-111448.294	-27949.572	5.736
3708	-111448.425	-27959.562	9.991
3707	-111448.465	-27962.915	3.353
3709	-111448.514	-27966.738	3.823
面積	98.5693495		
地積	98.56㎡		

248			
地番	松吾田五一ノ一五		
N O	X	Y	辺長
990	-111443.714	-27959.576	
3708	-111448.425	-27959.562	4.711
3685	-111448.294	-27949.572	9.991
3684	-111443.589	-27949.650	4.706
991	-111443.654	-27954.781	5.131
990	-111443.714	-27959.576	4.795
面積	46.8862445		
地積	46.88㎡		

249			
地番	松吾田五二ノ二		
N O	X	Y	辺長
3654	-111469.019	-27982.384	
3648	-111486.554	-27982.583	17.536
3655	-111485.453	-27970.950	11.685
3656	-111485.698	-27966.577	4.380
3682	-111471.298	-27966.634	14.400
3683	-111469.174	-27966.674	2.124
987	-111469.070	-27977.261	10.588
3654	-111469.019	-27982.384	5.123
面積	266.4274500		
地積	266.42㎡		

250			
地番	松吾田五二ノ一		
N O	X	Y	辺長
3651	-111468.898	-27992.081	
3650	-111474.950	-27992.135	6.052
3646	-111487.472	-27992.281	12.523
3647	-111487.156	-27988.942	3.354
3648	-111486.554	-27982.583	6.387
3654	-111469.019	-27982.384	17.536
3651	-111468.898	-27992.081	9.698
面積	174.9006280		
地積	174.90㎡		


251			
地番	松吾田五二ノ四		
N O	X	Y	辺長
985	-111461.093	-27977.029	
987	-111469.070	-27977.261	7.980
3683	-111469.174	-27966.674	10.588
3712	-111465.659	-27966.685	3.515
986	-111461.240	-27966.700	4.419
985	-111461.093	-27977.029	10.330
面積	83.2136035		
地積	83.21㎡		

252			
地番	松吾田五二ノ三		
N O	X	Y	辺長
3653	-111460.881	-27991.981	
3651	-111468.898	-27992.081	8.018
3654	-111469.019	-27982.384	9.698
987	-111469.070	-27977.261	5.123
985	-111461.093	-27977.029	7.980
984	-111461.046	-27980.372	3.343
3653	-111460.881	-27991.981	11.610
面積	119.1348960		
地積	119.13㎡		

253			
地番	松吾田五三ノ三		
N O	X	Y	辺長
3643	-111474.739	-28011.477	
3644	-111486.413	-28012.684	11.736
3645	-111489.151	-28009.992	3.840
3646	-111487.472	-27992.281	17.790
3650	-111474.950	-27992.135	12.523
3643	-111474.739	-28011.477	19.343
面積	267.3533755		
地積	267.35㎡		

254			
地番	松吾田五三ノ二		
N O	X	Y	辺長
3641	-111460.681	-28010.012	
3642	-111469.204	-28010.904	8.570
3643	-111474.739	-28011.477	5.565
3650	-111474.950	-27992.135	19.343
3651	-111468.898	-27992.081	6.052
3653	-111460.881	-27991.981	8.018
3652	-111460.874	-27992.822	0.841
3641	-111460.681	-28010.012	17.191
面積	262.8835830		
地積	262.88㎡		

図面の種類	画 地 面 積 求 積 表				
街区番号	27	番号	$\frac{2}{2}$		
町 名	松 室 吾 田 神 町				
京 都 市 洛 西 第 二 土 地 区 画 整 理 組 合					

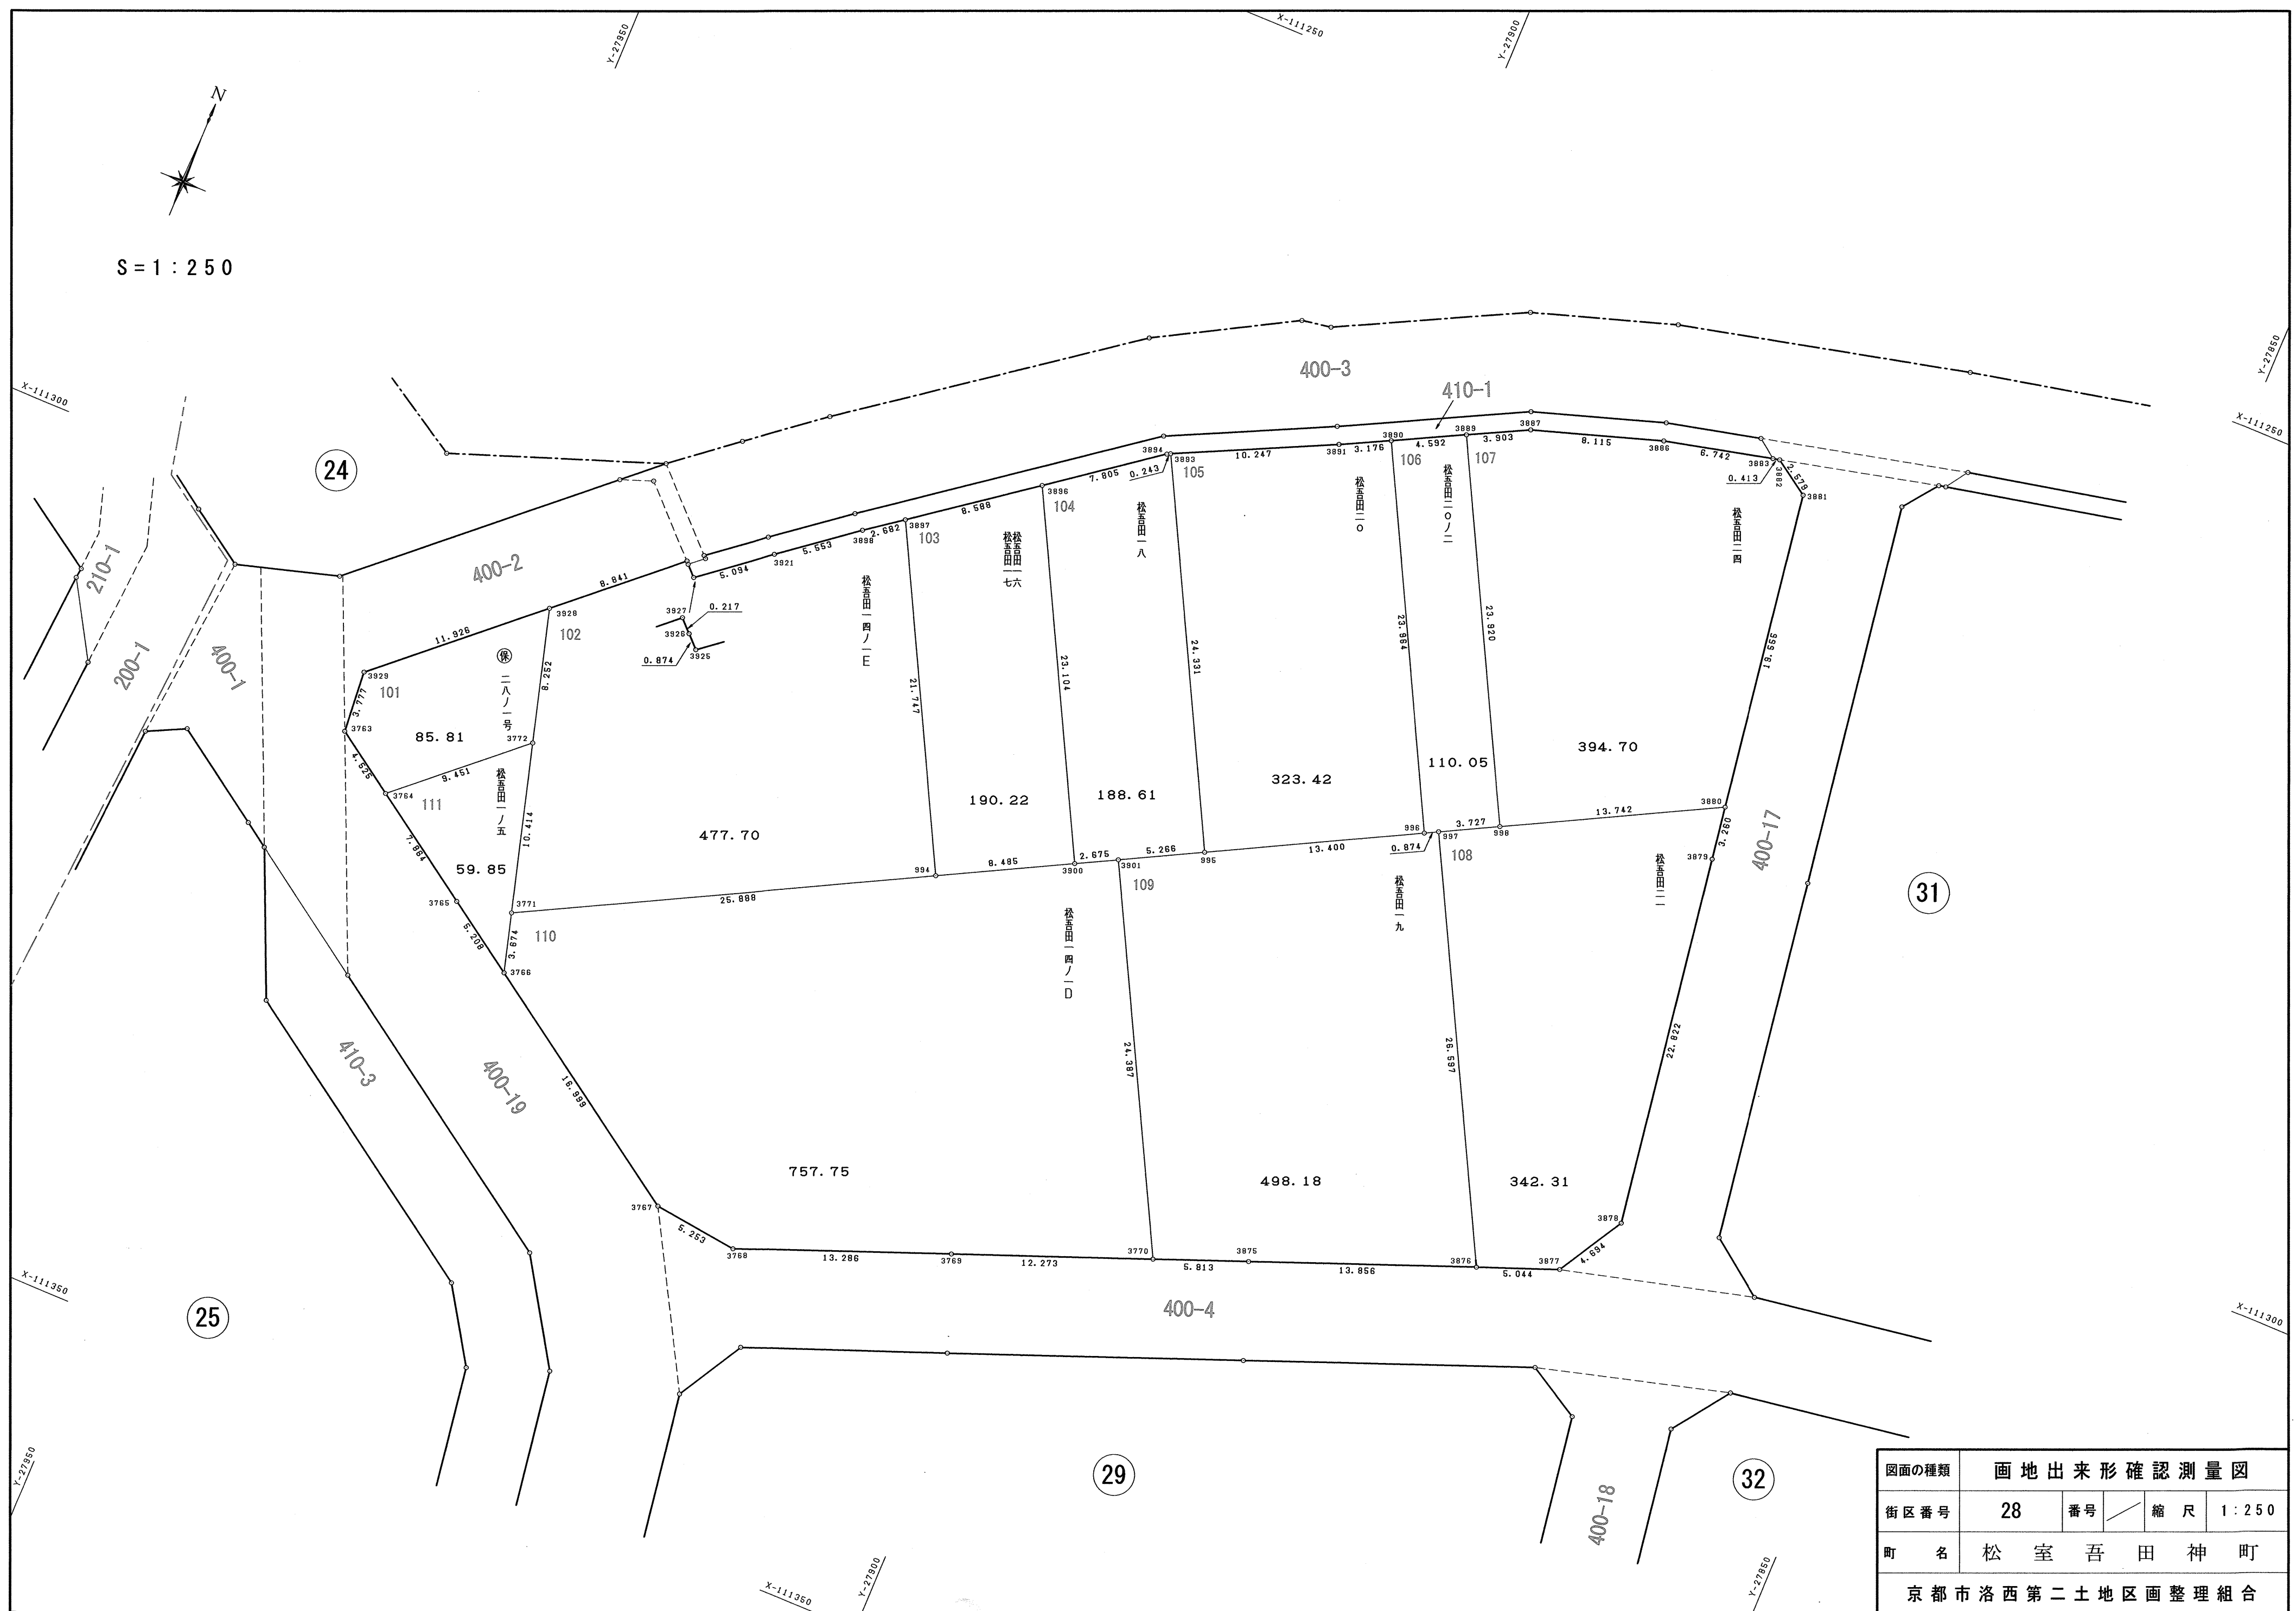

101			
地番	保 二八ノ一号		
N O	X	Y	辺 長
3929	-111307.704	-27949.963	
3763	-111311.470	-27949.670	3.777
3764	-111314.000	-27945.918	4.525
3772	-111307.732	-27938.845	9.451
3928	-111299.780	-27941.050	8.252
3929	-111307.704	-27949.963	11.926
面積	85.8115030		
地積	85.81 ㎡		

102			
地番	松吾田一四ノ一E		
N O	X	Y	辺 長
3928	-111299.780	-27941.050	
3772	-111307.732	-27938.845	8.252
3771	-111317.766	-27936.056	10.414
994	-111305.790	-27913.105	25.888
3897	-111286.502	-27923.150	21.747
3898	-111288.103	-27925.302	2.682
3921	-111291.505	-27929.691	5.553
3925	-111294.680	-27933.674	5.094
3926	-111294.064	-27934.294	0.874
3927	-111293.906	-27934.443	0.217
3928	-111299.780	-27941.050	8.841
面積	477.7009795		
地積	477.70 ㎡		

103			
地番	松吾田一六，松吾田一七		
N O	X	Y	辺 長
3897	-111286.502	-27923.150	
994	-111305.790	-27913.105	21.747
3900	-111301.865	-27905.582	8.485
3896	-111281.376	-27916.259	23.104
3897	-111286.502	-27923.150	8.588
面積	190.2251250		
地積	190.22 ㎡		

104			
地番	松吾田一八		
N O	X	Y	辺 長
3896	-111281.376	-27916.259	
3900	-111301.865	-27905.582	23.104
3901	-111300.629	-27903.210	2.675
995	-111298.192	-27898.542	5.266
3893	-111276.611	-27909.778	24.331
3894	-111276.717	-27909.997	0.243
3896	-111281.376	-27916.259	7.805
面積	188.6163235		
地積	188.61 ㎡		

105			
地番	松吾田二〇		
N O	X	Y	辺 長
3893	-111276.611	-27909.778	
995	-111298.192	-27898.542	24.331
996	-111291.990	-27886.664	13.400
3890	-111270.726	-27897.714	23.964
3891	-111272.168	-27900.544	3.176
3893	-111276.611	-27909.778	10.247
面積	323.4205990		
地積	323.42 ㎡		

106			
地番	松吾田二〇ノ二		
N O	X	Y	辺 長
3890	-111270.726	-27897.714	
996	-111291.990	-27886.664	23.964
997	-111291.586	-27885.889	0.874
998	-111289.861	-27882.585	3.727
3889	-111268.640	-27893.623	23.920
3890	-111270.726	-27897.714	4.592
面積	110.0518720		
地積	110.05 ㎡		

107			
地番	松吾田二四		
N O	X	Y	辺 長
3889	-111268.640	-27893.623	
998	-111289.861	-27882.585	23.920
3880	-111283.502	-27870.403	13.742
3881	-111264.166	-27873.319	19.555
3882	-111262.729	-27875.460	2.579
3883	-111262.808	-27875.865	0.413
3886	-111264.380	-27882.421	6.742
3887	-111266.868	-27890.145	8.115
3889	-111268.640	-27893.623	3.903
面積	394.7083160		
地積	394.70 ㎡		


108			
地番	松吾田二一		
N O	X	Y	辺 長
997	-111291.586	-27885.889	
3876	-111315.163	-27873.580	26.597
3877	-111313.345	-27868.875	5.044
3878	-111309.292	-27866.508	4.694
3879	-111286.726	-27869.917	22.822
3880	-111283.502	-27870.403	3.260
998	-111289.861	-27882.585	13.742
997	-111291.586	-27885.889	3.727
面積	342.3101180		
地積	342.31 ㎡		

109			
地番	松吾田一九		
N O	X	Y	辺 長
3901	-111300.629	-27903.210	
3770	-111322.249	-27891.928	24.387
3875	-111320.157	-27886.505	5.813
3876	-111315.163	-27873.580	13.856
997	-111291.586	-27885.889	26.597
996	-111291.990	-27886.664	0.874
995	-111298.192	-27898.542	13.400
3901	-111300.629	-27903.210	5.266
面積	498.1826345		
地積	498.18 ㎡		

110			
地番	松吾田一四ノ一D		
N O	X	Y	辺 長
3771	-111317.766	-27936.056	
3766	-111321.308	-27935.080	3.674
3767	-111330.813	-27920.987	16.999
3768	-111331.451	-27915.773	5.253
3769	-111326.666	-27903.379	13.286
3770	-111322.249	-27891.928	12.273
3901	-111300.629	-27903.210	24.387
3900	-111301.865	-27905.582	2.675
994	-111305.790	-27913.105	8.485
3771	-111317.766	-27936.056	25.888
面積	757.7510255		
地積	757.75 ㎡		

111			
地番	松吾田一ノ五		
N O	X	Y	辺 長
3764	-111314.000	-27945.918	
3765	-111318.396	-27939.398	7.864
3766	-111321.308	-27935.080	5.208
3771	-111317.766	-27936.056	3.674
3772	-111307.732	-27938.845	10.414
3764	-111314.000	-27945.918	9.451
面積	59.8516050		
地積	59.85 ㎡		

図面の種類	画 地 面 積 求 積 表				
街区番号	28	番号	/		
町 名	松 室 吾 田 神 町				
京 都 市 洛 西 第 二 土 地 区 画 整 理 組 合					

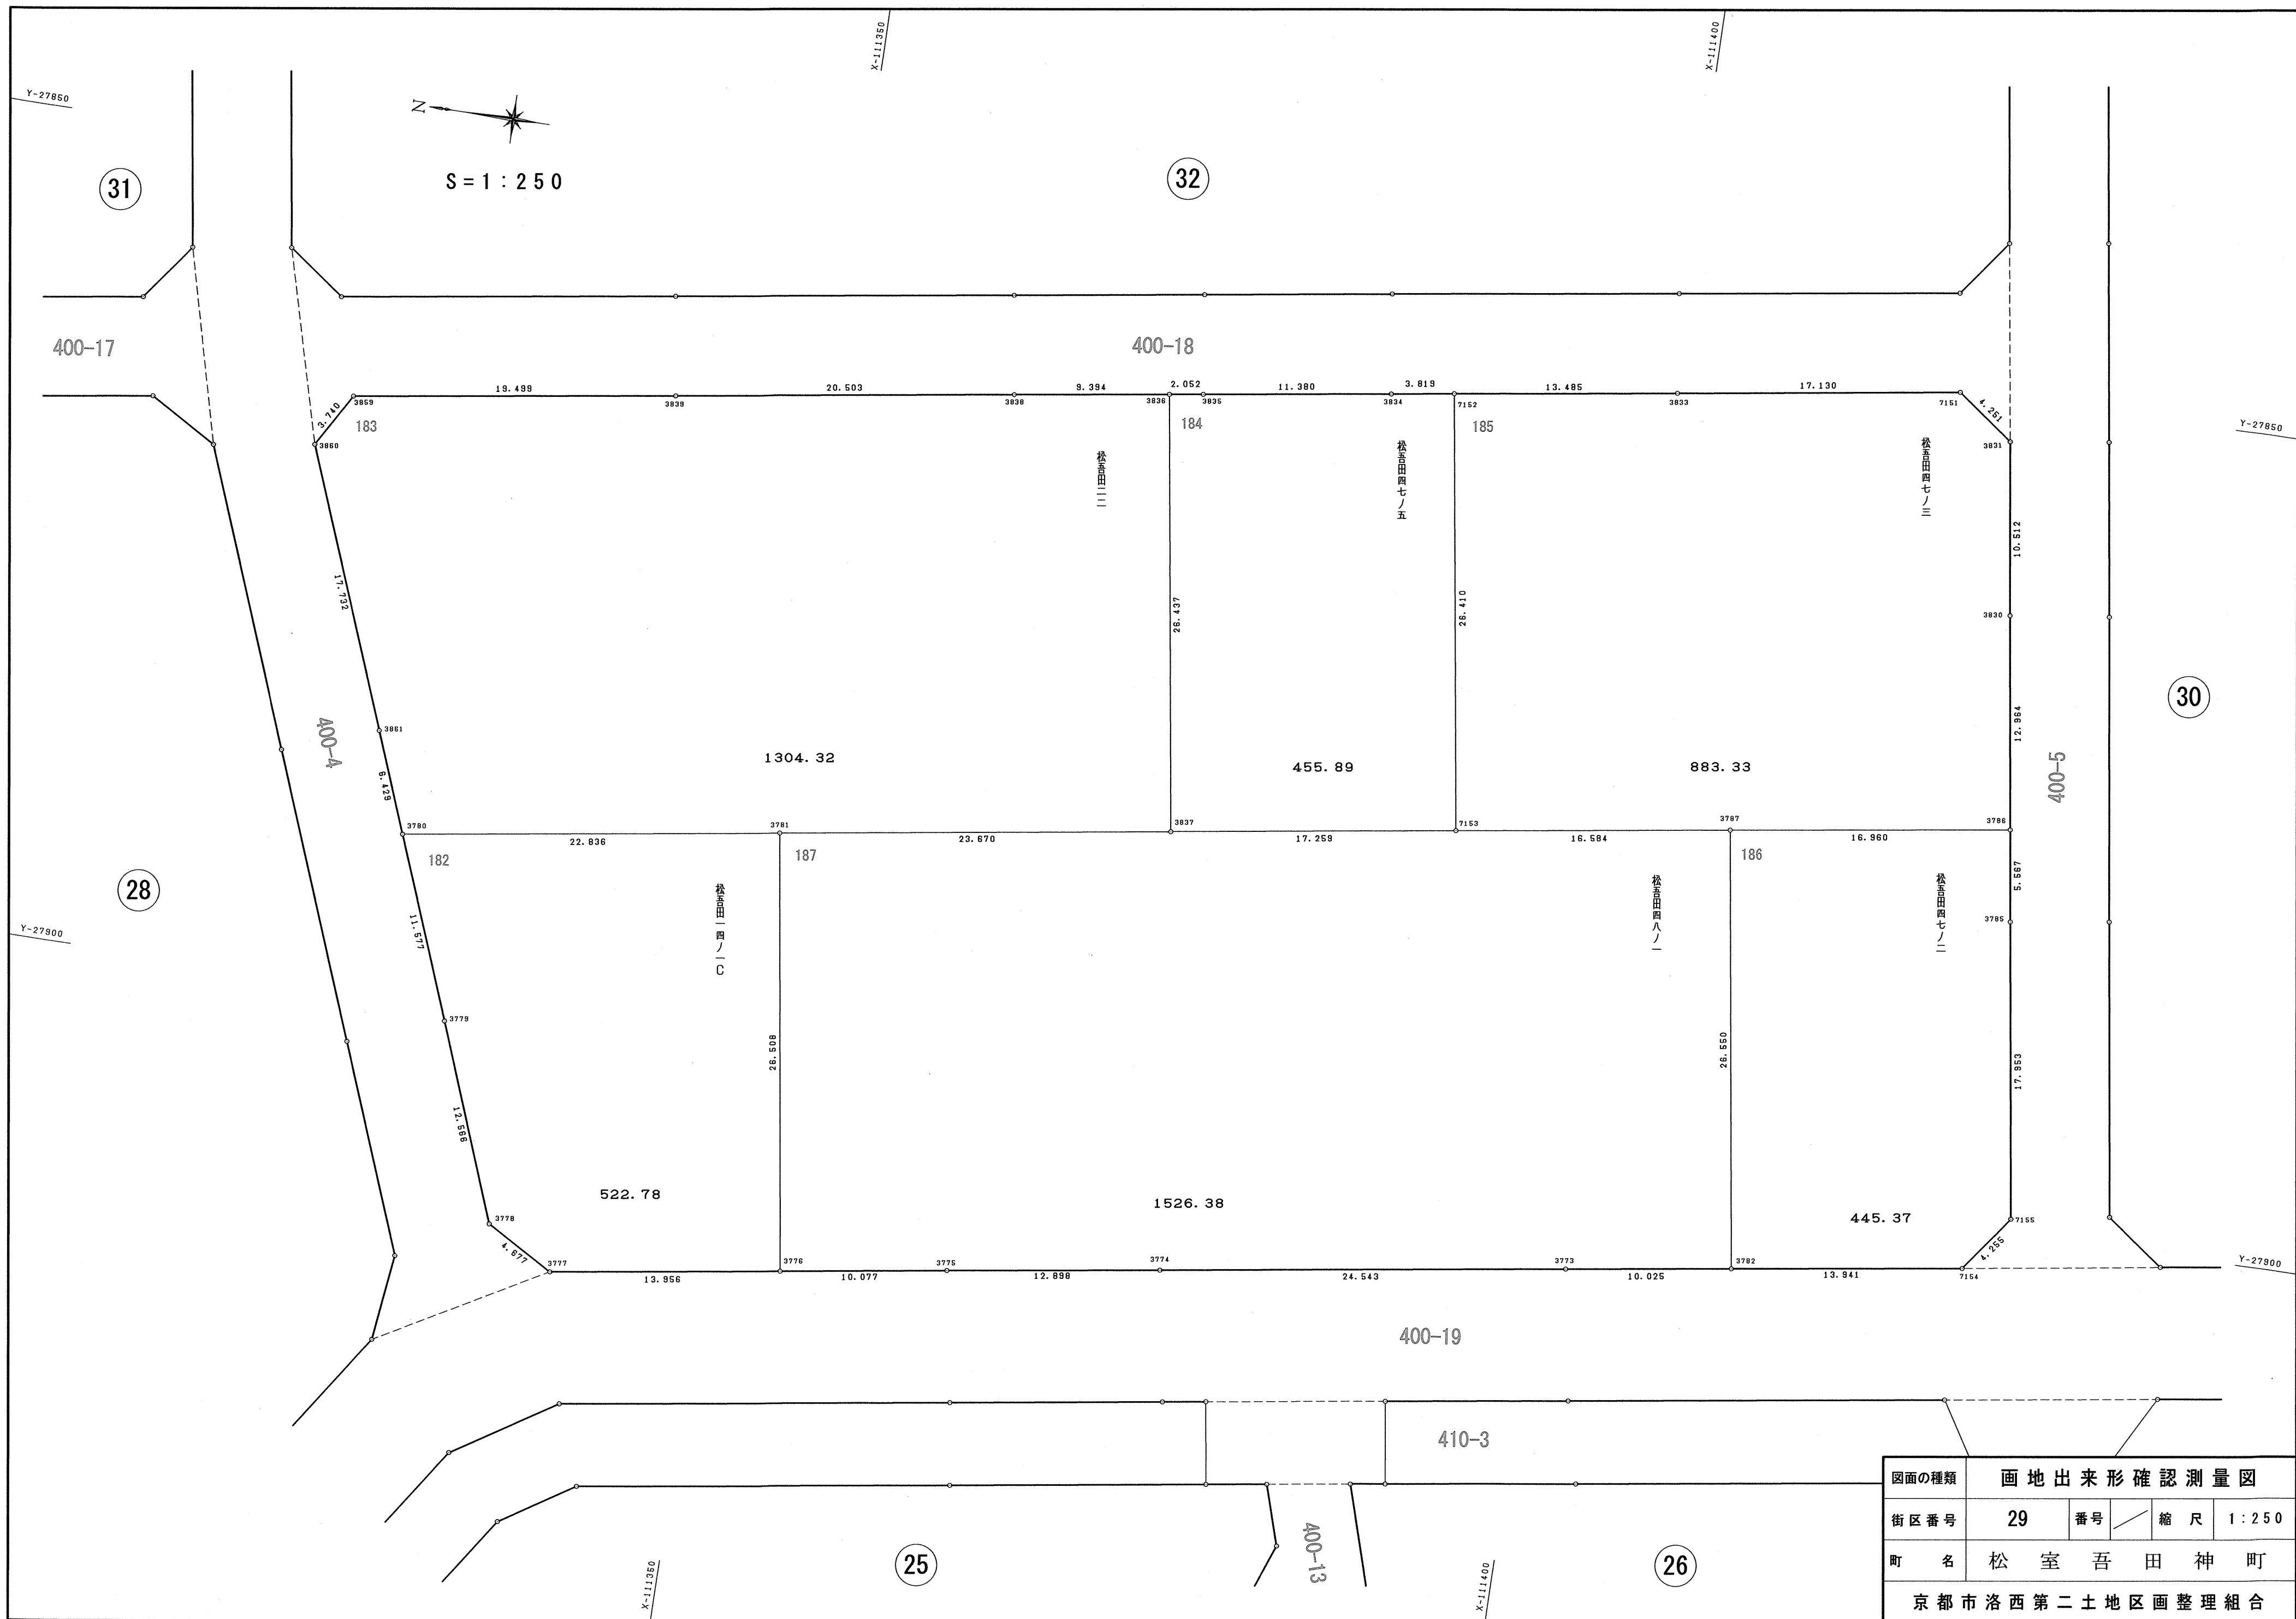

図面の種類	画地出来形確認測量図				
街区番号	29	番号	／	縮尺	1：250
町名	松室吾田神町				
京都市洛西第二土地地区画整理組合					

182

地番	松吾田一四ノ一C		
N O	X	Y	辺長
3780	-111328.160	-27890.477	
3779	-111332.336	-27901.275	11.577
3778	-111336.815	-27913.016	12.566
3777	-111340.867	-27915.351	4.677
3776	-111354.666	-27913.262	13.956
3781	-111350.737	-27887.047	26.508
3780	-111328.160	-27890.477	22.836
面積	522.7831015		
地積	522.78㎡		

183

地番	松吾田二二		
N O	X	Y	辺長
3859	-111321.315	-27864.724	
3860	-111319.424	-27867.951	3.740
3861	-111325.841	-27884.481	17.732
3780	-111328.160	-27890.477	6.429
3781	-111350.737	-27887.047	22.836
3837	-111374.140	-27883.500	23.670
3836	-111370.160	-27857.364	26.437
3838	-111360.869	-27858.754	9.394
3839	-111340.596	-27861.816	20.503
3859	-111321.315	-27864.724	19.499
面積	1304.3208510		
地積	1304.32㎡		

184

地番	松吾田四七ノ五		
N O	X	Y	辺長
3836	-111370.160	-27857.364	
3837	-111374.140	-27883.500	26.437
7153	-111391.203	-27880.906	17.259
7152	-111387.219	-27854.798	26.410
3834	-111383.443	-27855.371	3.819
3835	-111372.189	-27857.060	11.380
3836	-111370.160	-27857.364	2.052
面積	455.8953240		
地積	455.89㎡		

185

地番	松吾田四七ノ三		
N O	X	Y	辺長
7152	-111387.219	-27854.798	
7153	-111391.203	-27880.906	26.410
3787	-111407.602	-27878.438	16.584
3786	-111424.375	-27875.928	16.960
3830	-111422.452	-27863.107	12.964
3831	-111420.917	-27852.708	10.512
7151	-111417.487	-27850.197	4.251
3833	-111400.552	-27852.776	17.130
7152	-111387.219	-27854.798	13.485
面積	883.3357665		
地積	883.33㎡		

186

地番	松吾田四七ノ二		
N O	X	Y	辺長
3787	-111407.602	-27878.438	
3782	-111411.567	-27904.690	26.550
7154	-111425.353	-27902.616	13.941
7155	-111427.871	-27899.186	4.255
3785	-111425.201	-27881.433	17.953
3786	-111424.375	-27875.928	5.567
3787	-111407.602	-27878.438	16.960
面積	445.3733190		
地積	445.37㎡		

187

地番	松吾田四八ノ一		
N O	X	Y	辺長
3781	-111350.737	-27887.047	
3776	-111354.666	-27913.262	26.508
3775	-111364.630	-27911.754	10.077
3774	-111377.385	-27909.841	12.898
3773	-111401.654	-27906.181	24.543
3782	-111411.567	-27904.690	10.025
3787	-111407.602	-27878.438	26.550
7153	-111391.203	-27880.906	16.584
3837	-111374.140	-27883.500	17.259
3781	-111350.737	-27887.047	23.670
面積	1526.3820280		
地積	1526.38㎡		

図面の種類	画 地 面 積 求 積 表				
街区番号	29	番号	/		
町 名	松 室 吾 田 神 町				
京 都 市 洛 西 第 二 土 地 区 画 整 理 組 合					