

京都都市計画（京都国際文化観光都市建設計画）
 都市建設事業洛西第二地区土地区画整理事業

画地出来形確認測量図

5 / 5

洛西第二土地区画整理事業画地出来形測量図

120街区～147街区
 平成17年9月2日現在

洛西第二土地区画整理組合
 第一測量設計株式会社

嵐山	嵐山宮ノ前町	1		
桂	桂池尻町			5
	桂上野今井町	2		
	桂上野北町		3	
	桂上野中町		3	
	桂上野西町	2		
	桂上野東町		3	4
	桂上野南町		3	
	桂河田町		4	5
	桂清水町			5
	桂徳大寺町		4	
	桂徳大寺北町		4	5
	桂徳大寺東町		4	
	桂徳大寺南町			5
	桂畑ヶ田町		4	
桂久方町			5	
上桂	上桂今井町	2		
	上桂北ノ口町	2	3	
	上桂北村町		3	
	上桂東ノ口町			5
	上桂前川町	2		
松室	松室吾田神町	1	2	
	松室荒堀町	1		
	松室河原町	1		
	松室北河原町	1		
	松室中溝町	1		
	松尾東ノ口町		2	

京都都市計画（京都国際文化観光都市建設計画）
都市計画事業洛西第二地区土地区画整理事業

新町界図





S = 1 : 250

桂 徳 大 寺 町

106

107

110 B

公 6


400-5

400-6

410-1

200-2

210-2

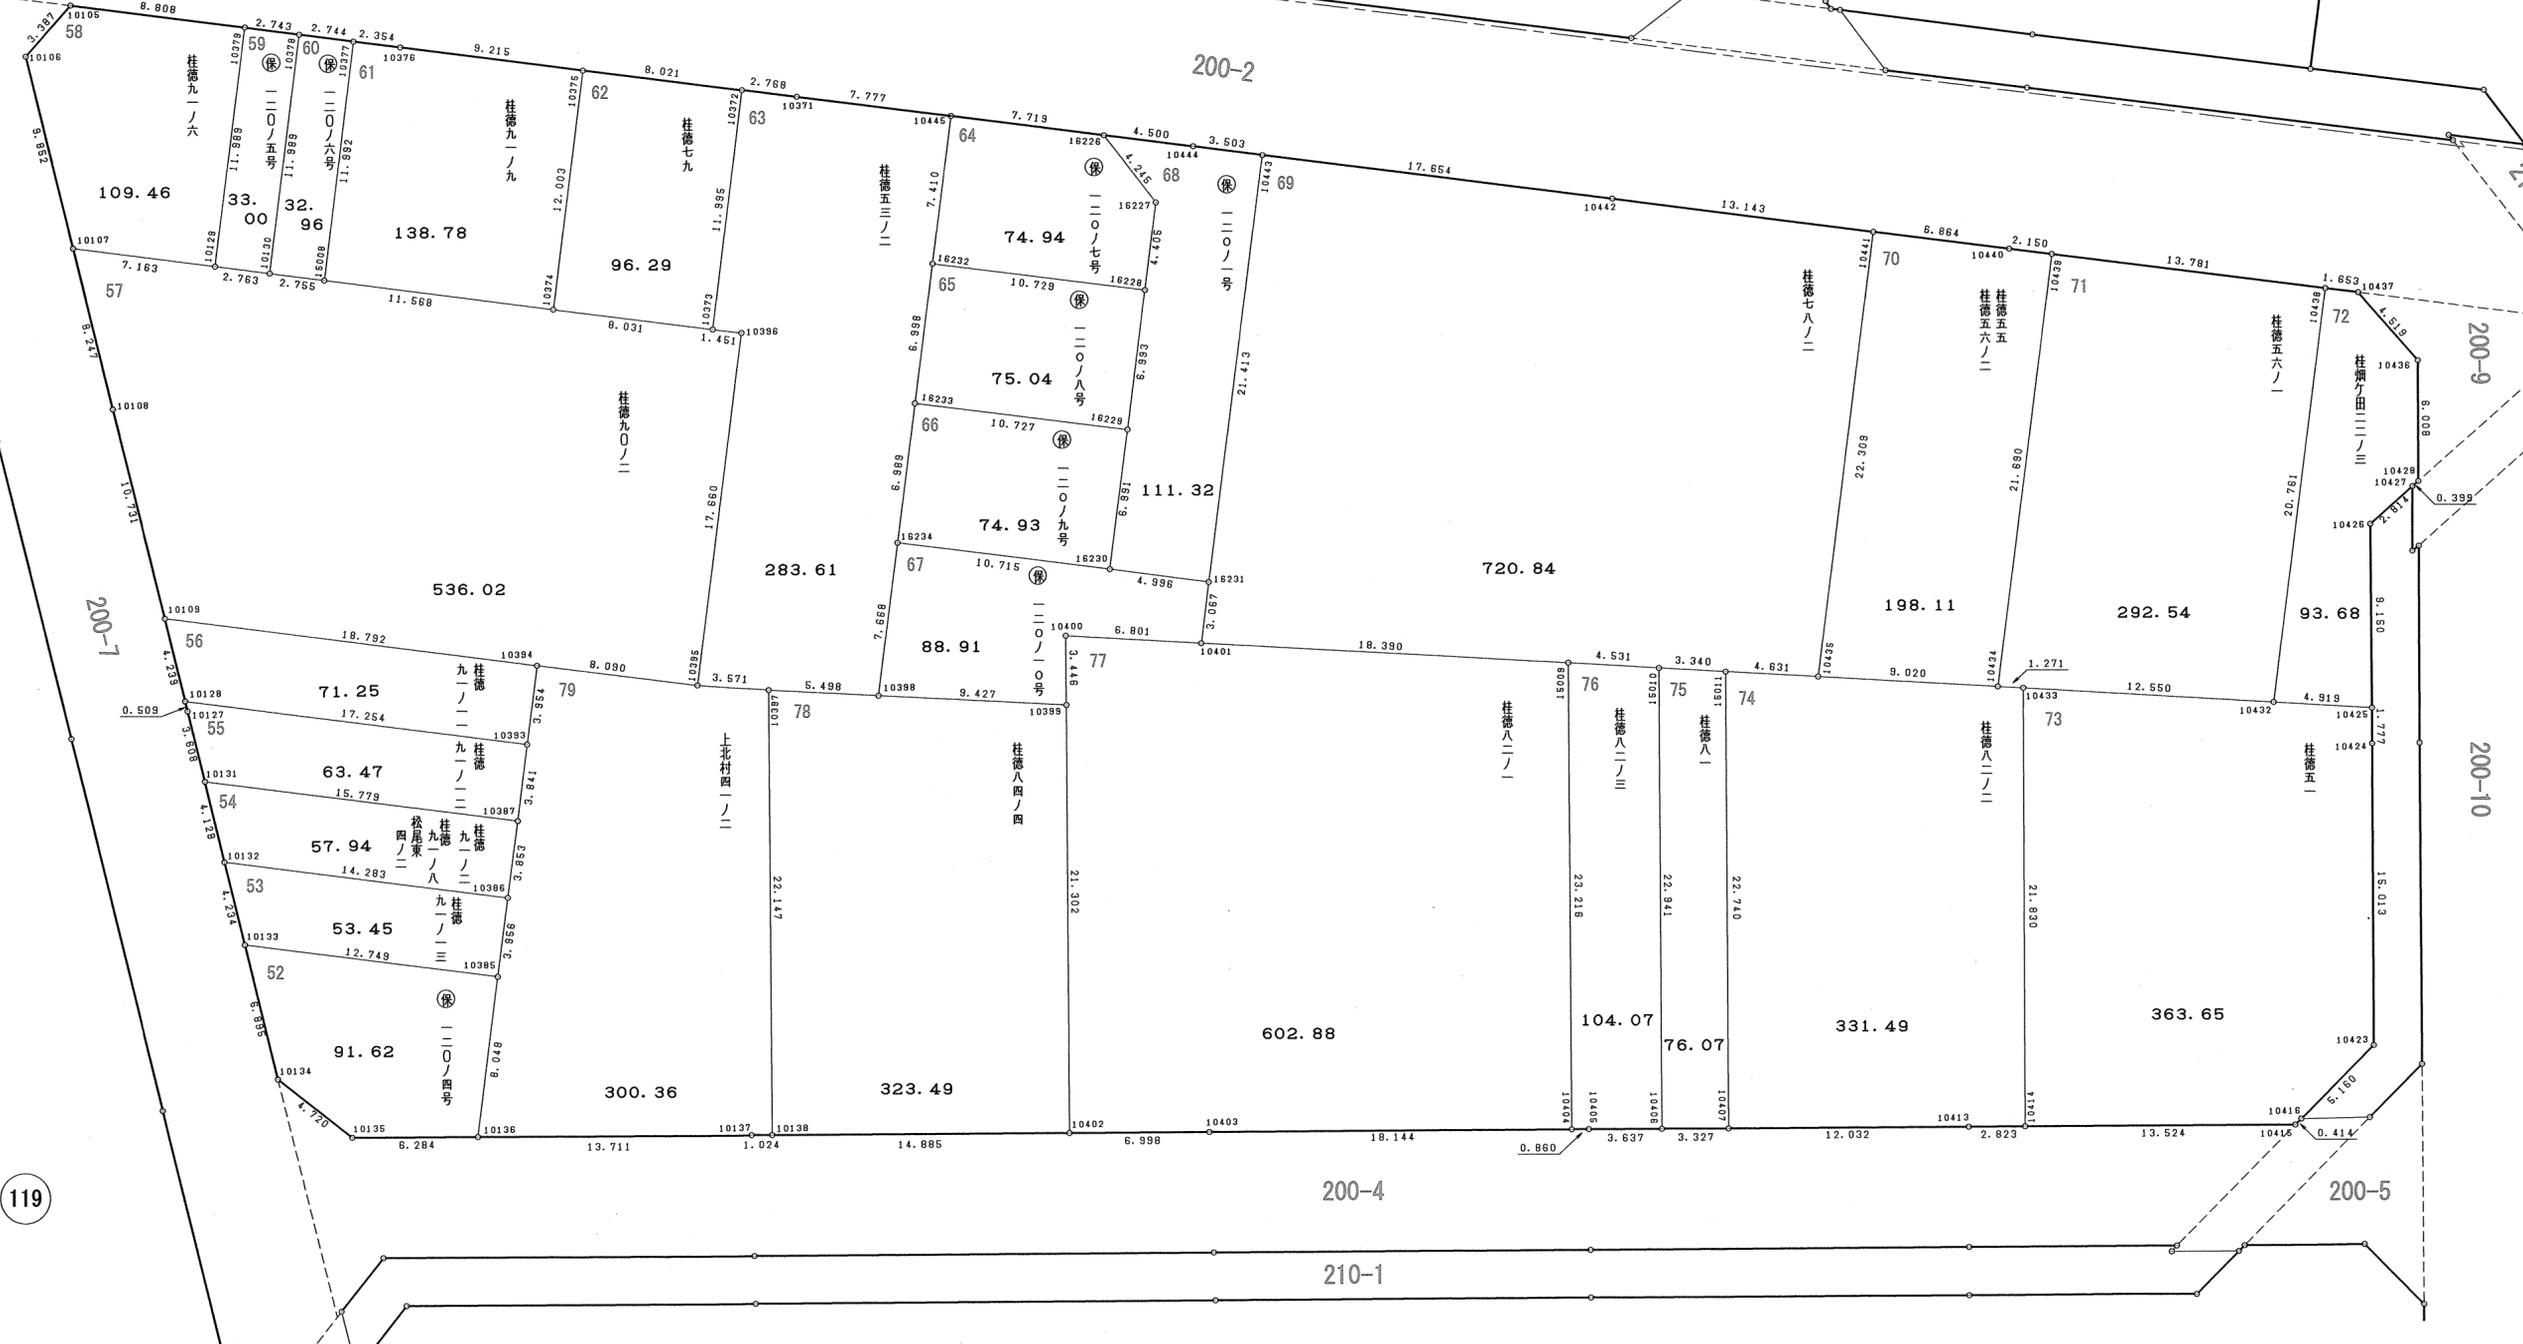

119

200-4

210-1

121 A

図面の種類	画地出来形確認測量図		
街区番号	120	番号	縮尺 1:250
町名	桂 徳 大 寺 北 町		
京都市洛西第二土地区画整理組合			

52

Table with 4 columns: NO, X, Y, 辺長. Includes area and ground area calculations.

53

Table with 4 columns: NO, X, Y, 辺長. Includes area and ground area calculations.

54

Table with 4 columns: NO, X, Y, 辺長. Includes area and ground area calculations.

Summary table: 図面の種類, 画地面積求積表, 街区番号 120, 町名 桂徳大寺北町, 京都市洛西第二土地画整理組合.

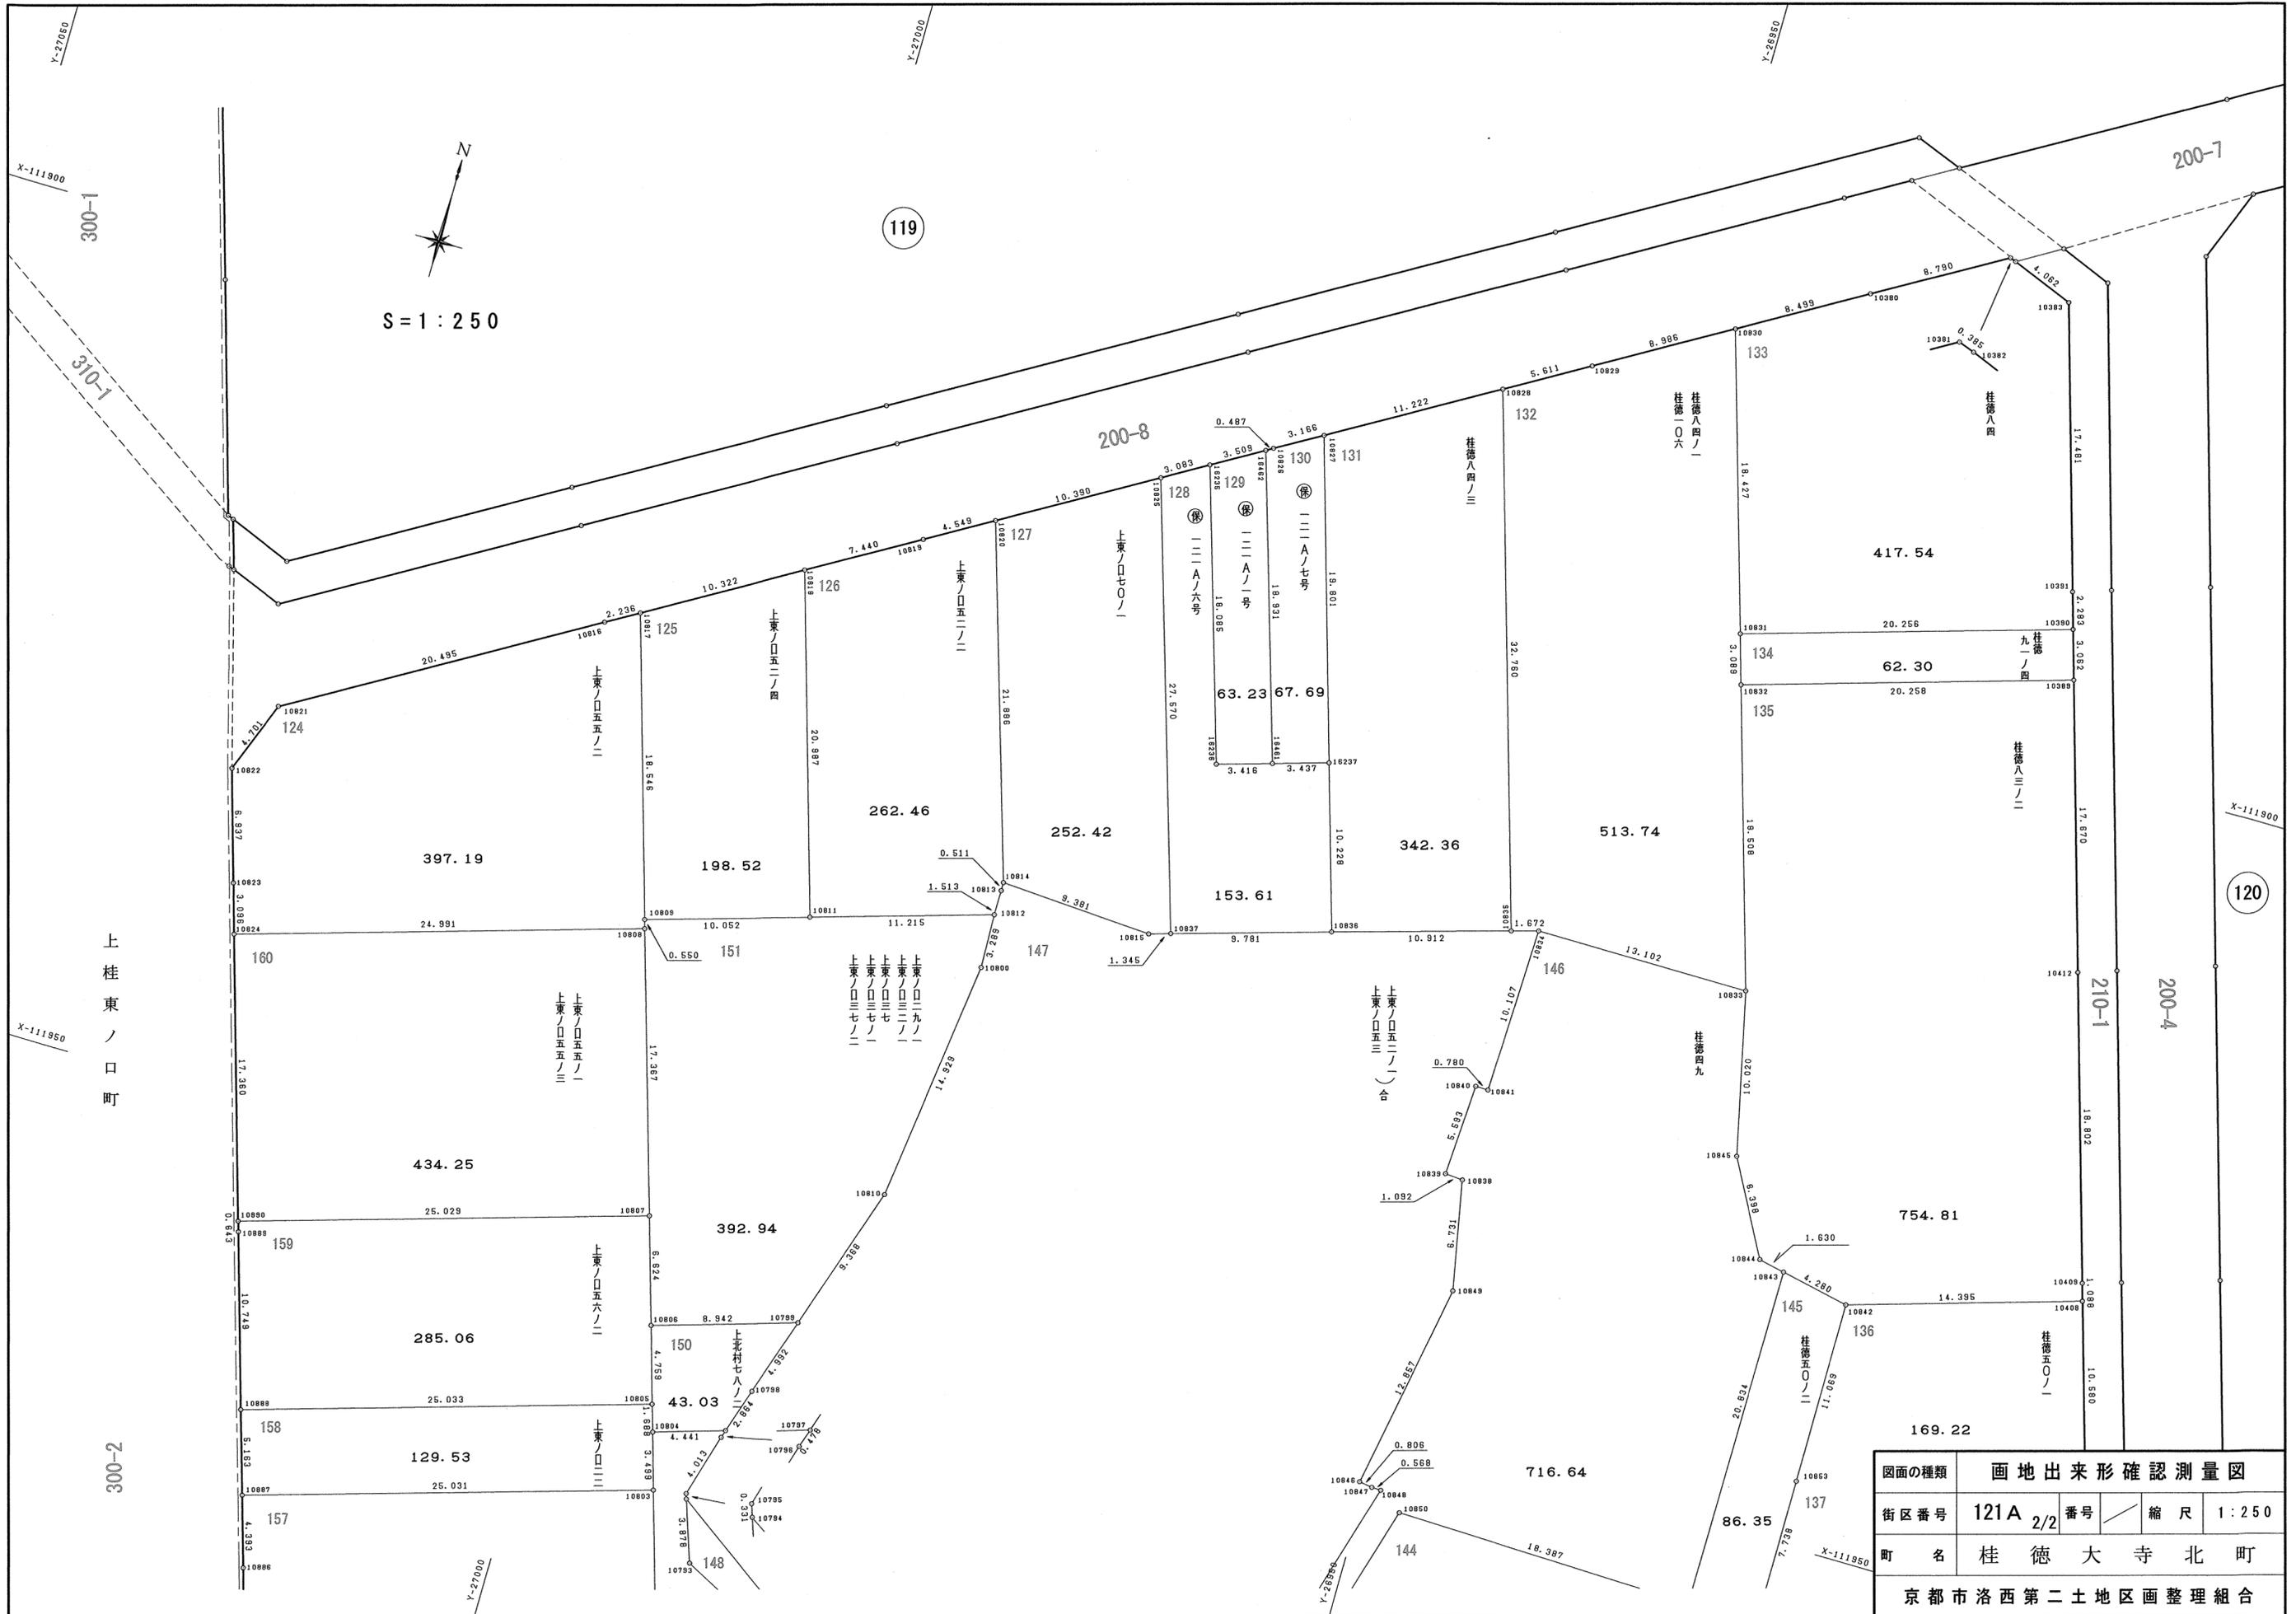

S = 1 : 250



119

120

図面の種類	画地出来形確認測量図		
街区番号	121A 2/2	番号	縮尺 1 : 250
町名	桂徳大寺北町		
京都市洛西第二土地区画整理組合			

124

地番 上東ノ口五五ノ二			
NO	X	Y	辺長
10822	-111930.778	-27028.299	
10823	-111937.422	-27026.304	6.937
10824	-111940.386	-27025.410	3.096
10808	-111933.174	-27001.482	24.991
10809	-111932.644	-27001.628	0.550
10817	-111914.890	-27006.989	18.546
10816	-111916.021	-27008.918	2.236
10821	-111926.398	-27026.592	20.495
10822	-111930.778	-27028.299	4.701
面積	397.1918365		
地積	397.19 m ²		

125

地番 上東ノ口五二ノ四			
NO	X	Y	辺長
10817	-111914.890	-27006.989	
10809	-111932.644	-27001.628	18.546
10811	-111929.756	-26992.000	10.052
10818	-111909.670	-26998.084	20.987
10817	-111914.890	-27006.989	10.322
面積	198.5211950		
地積	198.52 m ²		

126

地番 上東ノ口五二ノ二			
NO	X	Y	辺長
10818	-111909.670	-26998.084	
10811	-111929.756	-26992.000	20.987
10812	-111926.535	-26981.257	11.215
10813	-111925.022	-26981.259	1.513
10814	-111924.511	-26981.259	0.511
10820	-111903.607	-26987.741	21.886
10819	-111905.907	-26991.666	4.549
10818	-111909.670	-26998.084	7.440
面積	262.4611855		
地積	262.46 m ²		

127

地番 上東ノ口七〇ノ一			
NO	X	Y	辺長
10820	-111903.607	-26987.741	
10814	-111924.511	-26981.259	21.886
10815	-111925.074	-26971.895	9.381
10837	-111924.686	-26970.607	1.345
10825	-111898.354	-26978.777	27.570
10820	-111903.607	-26987.741	10.390
面積	252.4252460		
地積	252.42 m ²		

128

地番 保 一 二 一 A 六号			
NO	X	Y	辺長
10825	-111898.354	-26978.777	
10837	-111924.686	-26970.607	27.570
10836	-111921.911	-26961.228	9.781
16237	-111912.119	-26964.184	10.228
16461	-111913.101	-26967.478	3.437
16236	-111914.067	-26970.755	3.416
16235	-111896.795	-26976.117	18.085
10825	-111898.354	-26978.777	3.083
面積	153.6173915		
地積	153.61 m ²		

129

地番 保 一 二 一 A 一 号			
NO	X	Y	辺長
16235	-111896.795	-26976.117	
16236	-111914.067	-26970.755	18.085
16461	-111913.101	-26967.478	3.416
16462	-111895.021	-26973.090	18.931
16235	-111896.795	-26976.117	3.509
面積	63.2319420		
地積	63.23 m ²		

130

地番 保 一 二 一 A 七 号			
NO	X	Y	辺長
16462	-111895.021	-26973.090	
16461	-111913.101	-26967.478	18.931
16237	-111912.119	-26964.184	3.437
10827	-111893.173	-26969.939	19.801
10826	-111894.775	-26972.670	3.166
16462	-111895.021	-26973.090	0.487
面積	67.6997880		
地積	67.69 m ²		

131

地番 桂 徳 八 四 三 号			
NO	X	Y	辺長
10827	-111893.173	-26969.939	
16237	-111912.119	-26964.184	19.801
10836	-111921.911	-26961.228	10.228
10835	-111918.846	-26950.755	10.912
10828	-111887.495	-26960.260	32.760
10827	-111893.173	-26969.939	11.222
面積	342.3697120		
地積	342.36 m ²		

132

地番 桂 徳 八 四 一 号、桂 徳 一 〇 六 号			
NO	X	Y	辺長
10828	-111887.495	-26960.260	
10835	-111918.846	-26950.755	32.760
10834	-111918.383	-26949.148	1.672
10833	-111918.405	-26936.046	13.102
10832	-111900.694	-26941.420	18.508
10831	-111897.736	-26942.310	3.089
10830	-111880.106	-26947.671	18.427
10829	-111884.656	-26955.420	8.986
10828	-111887.495	-26960.260	5.611
面積	513.7456590		
地積	513.74 m ²		

133

地番 桂 徳 八 四 号			
NO	X	Y	辺長
10830	-111880.106	-26947.671	
10831	-111897.736	-26942.310	18.427
10390	-111891.913	-26922.909	20.256
10391	-111889.727	-26923.569	2.283
10383	-111872.988	-26928.608	17.481
10382	-111871.502	-26932.388	4.062
10381	-111871.372	-26932.750	0.385
10380	-111875.803	-26940.342	8.790
10830	-111880.106	-26947.671	8.499
面積	417.5428385		
地積	417.54 m ²		

134

地番 桂 徳 九 一 四 号			
NO	X	Y	辺長
10831	-111897.736	-26942.310	
10832	-111900.694	-26941.420	3.089
10389	-111894.845	-26922.025	20.258
10390	-111891.913	-26922.909	3.062
10831	-111897.736	-26942.310	20.256
面積	62.3036420		
地積	62.30 m ²		

135

地番 桂 徳 八 三 二 号			
NO	X	Y	辺長
10832	-111900.694	-26941.420	
10833	-111918.405	-26936.046	18.508
10845	-111928.174	-26933.818	10.020
10844	-111933.785	-26930.744	6.398
10843	-111934.118	-26929.148	1.630
10842	-111934.977	-26924.955	4.280
10408	-111930.805	-26911.178	14.395
10409	-111929.763	-26911.492	1.088
10412	-111911.762	-26916.920	18.802
10389	-111894.845	-26922.025	17.670
10832	-111900.694	-26941.420	20.258
面積	754.8107245		
地積	754.81 m ²		

136

地番 桂 徳 五 〇 一 号			
NO	X	Y	辺長
10842	-111934.977	-26924.955	
10853	-111946.046	-26924.930	11.069
10861	-111940.935	-26908.124	17.566
10408	-111930.805	-26911.178	10.580
10842	-111934.977	-26924.955	14.395
面積	169.2278435		
地積	169.22 m ²		

137

地番 保 一 二 一 A 二 号			
NO	X	Y	辺長
10853	-111946.046	-26924.930	
10852	-111953.784	-26924.921	7.738
10868	-111950.687	-26914.855	10.532
10864	-111948.032	-26905.985	9.259
10863	-111947.881	-26906.030	0.158
10861	-111940.935	-26908.124	7.255
10853	-111946.046	-26924.930	17.566
面積	138.0208055		
地積	138.02 m ²		

138

地番 上 前 川 二 〇 五 号			
NO	X	Y	辺長
10868	-111950.687	-26914.855	
10874	-111954.534	-26913.701	4.016
10865	-111951.881	-26904.831	9.258
10864	-111948.032	-26905.985	4.018
10868	-111950.687	-26914.855	9.259
面積	37.1944760		
地積	37.19 m ²		

139

地番 上 前 川 二 〇 六 号			
NO	X	Y	辺長
10874	-111954.534	-26913.701	
10875	-111958.379	-26912.544	4.015
10866	-111955.706	-26903.684	9.254
10865	-111951.881	-26904.831	3.993
10874	-111954.534	-26913.701	9.258
面積	37.0650510		
地積	37.06 m ²		

140

地番 上 前 川 二 〇 七 号			
NO	X	Y	辺長
10875	-111958.379	-26912.544	
10876	-111962.176	-26911.410	3.963
15165	-111961.114	-26907.872	3.694
10867	-111959.291	-26901.803	6.337
10870	-111958.776	-26902.763	1.089
10866	-111955.706	-26903.684	3.205
10875	-111958.379	-26912.544	9.254
面積	37.0359965		
地積	37.03 m ²		

141

地番 上 前 川 二 〇 八 号			
NO	X	Y	辺長
15166	-111966.192	-26906.340	
10421	-111963.877	-26898.690	7.993
10422	-111960.388	-26899.758	3.649
10869	-111960.195	-26900.120	0.410
10867	-111959.291	-26901.803	1.910
15165	-111961.114	-26907.872	6.337
15166	-111966.192	-26906.340	5.304
面積	40.9308465		
地積	40.93 m ²		

142

地番 上 前 川 二 〇 九 号			
NO	X	Y	辺長
10881	-111971.265	-26904.809	
10419	-111969.822	-26900.033	4.989
10420	-111966.125	-26898.002	4.218
10421	-111963.877	-26898.690	2.351
15166	-111966.192	-26906.340	7.993
10881	-111971.265	-26904.809	5.299
面積	37.9586550		
地積	37.95 m ²		

143

地番 上 前 川 二 〇 一 〇 号			
NO	X	Y	辺長
10879	-111972.330	-26908.340	
10880	-111972.142	-26907.713	0.655
10881	-111971.265	-26904.809	3.034
15166	-111966.192	-26906.340	5.299
15165	-111961.114	-26907.872	5.304
10876	-111962.176	-26911.410	3.694
10879	-111972.330	-26908.340	10.608
面積	39.1459065		
地積	39.14 m ²		

144

地番 桂 徳 四 八 号			
NO	X	Y	辺長
10850	-111954.533	-26947.615	
10721	-111986.690	-26957.009	33.501
10720	-111985.353	-26951.661	5.513
10877	-111983.648	-26945.988	5.924
10878	-111977.851	-26926.731	20.111
10879	-111972.330	-26908.340	19.202
10876	-111962.176	-26911.410	10.608
10875	-111958.379	-26912.544	3.963
10874	-111954.534	-26913.701	4.015
10868	-111950.687	-26914.855	4.016
10852	-111953.784	-26924.921	10.532
10854	-111954.773	-26925.108	1.007
10851	-111954.952		

149

地番 上東ノ口三三ノ一、三四ノ一 上北村八四ノ一			
NO	X	Y	辺長
10804	-111962.301	-26992.646	
10803	-111965.651	-26991.637	3.499
10885	-111979.711	-26987.408	14.682
10731	-111993.254	-26983.351	14.138
10730	-111990.496	-26972.233	11.455
10725	-111988.558	-26964.481	7.991
10789	-111985.225	-26963.843	3.394
10790	-111984.160	-26966.381	2.752
10791	-111976.189	-26976.642	12.993
10792	-111971.826	-26983.238	7.908
10793	-111969.292	-26988.307	5.667
10794	-111965.620	-26989.555	3.878
10795	-111965.307	-26989.662	0.331
10796	-111961.450	-26988.553	4.013
10797	-111960.997	-26988.401	0.478
10804	-111962.301	-26992.646	4.441
面積	336.9614570		
地積	336.96 m ²		

150

地番 上北村七八ノ二			
NO	X	Y	辺長
10806	-111956.129	-26994.509	
10805	-111960.685	-26993.135	4.759
10804	-111962.301	-26992.646	1.688
10797	-111960.997	-26988.401	4.441
10798	-111958.272	-26987.518	2.864
10799	-111953.532	-26985.952	4.992
10806	-111956.129	-26994.509	8.942
面積	43.0365070		
地積	43.03 m ²		

151

地番 上東ノ口二九ノ一、三二ノ一 三七、三七ノ一、三七ノ二			
NO	X	Y	辺長
10809	-111932.644	-27001.628	
10808	-111933.174	-27001.482	0.550
10807	-111949.790	-26996.431	17.367
10806	-111956.129	-26994.509	6.624
10799	-111953.532	-26985.952	8.942
10810	-111944.633	-26983.026	9.368
10800	-111929.822	-26981.154	14.929
10812	-111926.535	-26981.257	3.289
10811	-111929.756	-26992.000	11.215
10809	-111932.644	-27001.628	10.052
面積	392.9452265		
地積	392.94 m ²		

152

地番 上東ノ口二三ノ八			
NO	X	Y	辺長
10802	-111981.378	-26992.864	
10733	-111994.632	-26988.901	13.834
10732	-111994.555	-26988.594	0.317
10731	-111993.254	-26983.351	5.402
10885	-111979.711	-26987.408	14.138
10802	-111981.378	-26992.864	5.705
面積	79.8350185		
地積	79.83 m ²		

153

地番 上東ノ口二三ノ二			
NO	X	Y	辺長
10734	-111995.077	-26990.679	
10733	-111994.632	-26988.901	1.833
10802	-111981.378	-26992.864	13.834
15164	-111981.905	-26994.622	1.835
10734	-111995.077	-26990.679	13.750
面積	25.2817420		
地積	25.28 m ²		

154

地番 上東ノ口二三ノ五			
NO	X	Y	辺長
10801	-111983.021	-26998.344	
15163	-111988.144	-26996.806	5.349
10735	-111996.020	-26994.441	8.223
10734	-111995.077	-26990.679	3.878
15164	-111981.905	-26994.622	13.750
10801	-111983.021	-26998.344	3.886
面積	53.0059730		
地積	53.00 m ²		

155

地番 上東ノ口二三ノ一			
NO	X	Y	辺長
10765	-111992.062	-27009.807	
10764	-111996.460	-27008.478	4.594
10763	-111998.594	-27004.712	4.329
10735	-111996.020	-26994.441	10.589
15163	-111988.144	-26996.806	8.223
10765	-111992.062	-27009.807	13.579
面積	102.7967150		
地積	102.79 m ²		

156

地番 上東ノ口二三ノ四、二三ノ六			
NO	X	Y	辺長
10766	-111986.930	-27011.357	
10765	-111992.062	-27009.807	5.361
15163	-111988.144	-26996.806	13.579
10801	-111983.021	-26998.344	5.349
10766	-111986.930	-27011.357	13.587
面積	72.7358365		
地積	72.73 m ²		

157

地番 保 一二-Aノ四号			
NO	X	Y	辺長
10887	-111972.854	-27015.609	
10886	-111977.059	-27014.339	4.393
10766	-111986.930	-27011.357	10.312
10801	-111983.021	-26998.344	13.587
15164	-111981.905	-26994.622	3.886
10802	-111981.378	-26992.864	1.835
10885	-111979.711	-26987.408	5.705
10803	-111965.651	-26991.637	14.682
10887	-111972.854	-27015.609	25.031
面積	367.9034915		
地積	367.90 m ²		

158

地番 上東ノ口二二			
NO	X	Y	辺長
10888	-111967.912	-27017.102	
10887	-111972.854	-27015.609	5.163
10803	-111965.651	-26991.637	25.031
10804	-111962.301	-26992.646	3.499
10805	-111960.685	-26993.135	1.688
10888	-111967.912	-27017.102	25.033
面積	129.5387385		
地積	129.53 m ²		

159

地番 上東ノ口五六ノ二			
NO	X	Y	辺長
10890	-111957.006	-27020.397	
10889	-111957.622	-27020.211	0.643
10888	-111967.912	-27017.102	10.749
10805	-111960.685	-26993.135	25.033
10806	-111956.129	-26994.509	4.759
10807	-111949.790	-26996.431	6.624
10890	-111957.006	-27020.397	25.029
面積	285.0693115		
地積	285.06 m ²		

160

地番 上東ノ口五五ノ一、上東ノ口五五ノ三			
NO	X	Y	辺長
10824	-111940.386	-27025.410	
10890	-111957.006	-27020.397	17.360
10807	-111949.790	-26996.431	25.029
10808	-111933.174	-27001.482	17.367
10824	-111940.386	-27025.410	24.991
面積	434.2520940		
地積	434.25 m ²		

図面の種類	画地面積求積表		
街区番号	121A	番号	2/2 縮尺
町名	桂 徳 大 寺 北 町		
京都市洛西第二土地区画整理組合			

X-112000



Y-27000

Y-26950

121 A

200-10

200-11

200-6

上桂東ノ口町 300-2

132

122

X-112050

X-112000

Y-26900

300-8

134

126

126 小

桂徳大寺南町

Y-27000

Y-26950

X-112050

Y-26900

図面の種類	画地出来形確認測量図			
街区番号	121B	番号	縮尺	1:250
町名	桂徳大寺北町			
京都市洛西第二土地区画整理組合				

Table 97: Land parcels with columns for parcel number, coordinates (X, Y), and side lengths. Includes area and ground area calculations.

Table 98: Land parcels with columns for parcel number, coordinates (X, Y), and side lengths. Includes area and ground area calculations.

Table 99: Land parcels with columns for parcel number, coordinates (X, Y), and side lengths. Includes area and ground area calculations.

Table 100: Land parcels with columns for parcel number, coordinates (X, Y), and side lengths. Includes area and ground area calculations.

Table 101: Land parcels with columns for parcel number, coordinates (X, Y), and side lengths. Includes area and ground area calculations.

Table 102: Land parcels with columns for parcel number, coordinates (X, Y), and side lengths. Includes area and ground area calculations.

Table 103: Land parcels with columns for parcel number, coordinates (X, Y), and side lengths. Includes area and ground area calculations.

Table 104: Land parcels with columns for parcel number, coordinates (X, Y), and side lengths. Includes area and ground area calculations.

Table 105: Land parcels with columns for parcel number, coordinates (X, Y), and side lengths. Includes area and ground area calculations.

Table 106: Land parcels with columns for parcel number, coordinates (X, Y), and side lengths. Includes area and ground area calculations.

S = 1 : 250

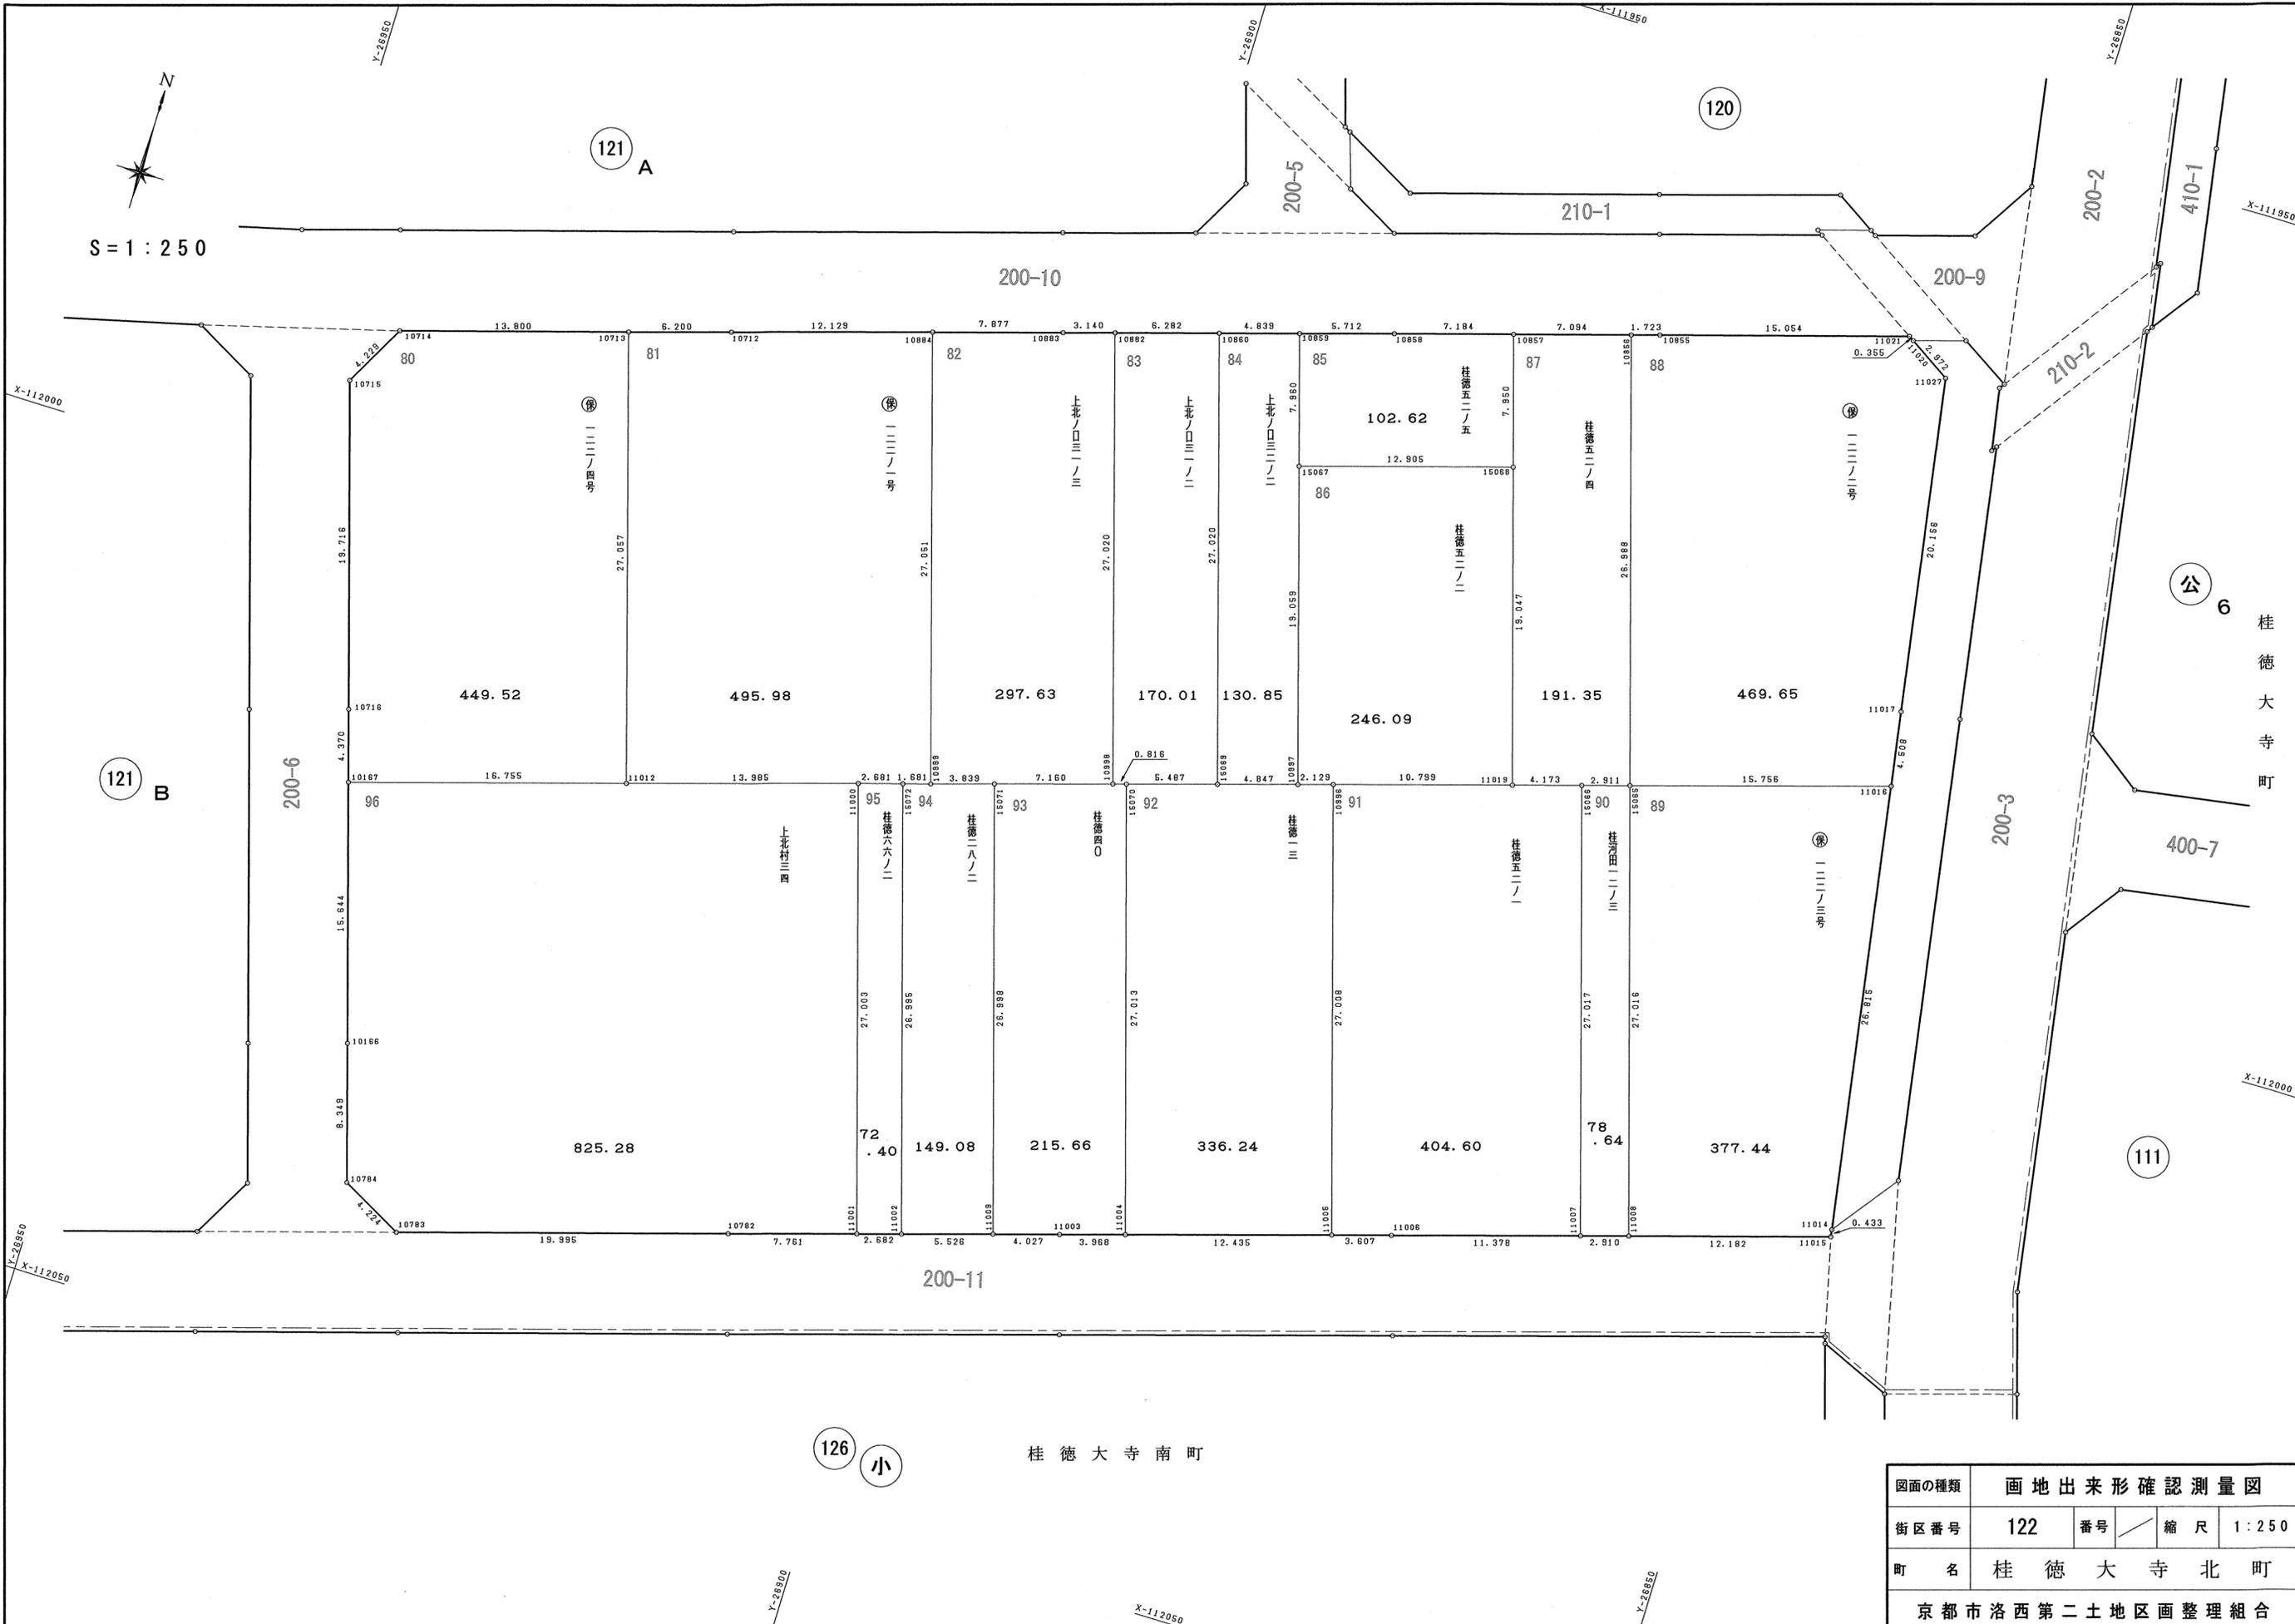

121 B

121 A

120

111

126 小

公 6

桂徳大寺町

桂徳大寺南町

図面の種類	画地出来形確認測量図			
街区番号	122	番号	縮尺	1 : 250
町名	桂徳大寺北町			
京都市洛西第二土地区画整理組合				

80

地番 保 一二二ノ四号			
NO	X	Y	辺長
10715	-111993.140	-26946.259	
10716	-112012.012	-26940.553	19.716
10167	-112016.196	-26939.292	4.370
11012	-112011.344	-26923.255	16.755
10713	-111985.431	-26931.039	27.057
10714	-111989.418	-26944.251	13.800
10715	-111993.140	-26946.259	4.229
面積	449.5242640		
地積	449.52 m ²		

81

地番 保 一二二ノ一号			
NO	X	Y	辺長
10713	-111985.431	-26931.039	
11012	-112011.344	-26923.255	27.057
11000	-112007.287	-26909.871	13.985
15072	-112006.520	-26907.302	2.681
10999	-112006.040	-26905.691	1.681
10884	-111980.138	-26913.491	27.051
10712	-111983.640	-26925.103	12.129
10713	-111985.431	-26931.039	6.200
面積	495.9871275		
地積	495.98 m ²		

82

地番 上北ノ口三ノ三			
NO	X	Y	辺長
10884	-111980.138	-26913.491	
10999	-112006.040	-26905.691	27.051
15071	-112004.922	-26902.018	3.839
10998	-112002.837	-26895.168	7.160
10882	-111976.959	-26902.942	27.020
10883	-111977.864	-26905.949	3.140
10884	-111980.138	-26913.491	7.877
面積	297.6315135		
地積	297.63 m ²		

83

地番 上北ノ口三ノ二			
NO	X	Y	辺長
10882	-111976.959	-26902.942	
10998	-112002.837	-26895.168	27.020
15070	-112002.602	-26894.387	0.816
15069	-112001.019	-26889.133	5.487
10860	-111975.148	-26896.927	27.020
10882	-111976.959	-26902.942	6.282
面積	170.0187470		
地積	170.01 m ²		

84

地番 上北ノ口三ノ二			
NO	X	Y	辺長
10860	-111975.148	-26896.927	
15069	-112001.019	-26889.133	27.020
10997	-111999.621	-26884.492	4.847
15067	-111981.374	-26889.995	19.059
10859	-111973.753	-26892.293	7.960
10860	-111975.148	-26896.927	4.839
面積	130.8556365		
地積	130.85 m ²		

85

地番 桂徳五二ノ五			
NO	X	Y	辺長
10859	-111973.753	-26892.293	
15067	-111981.374	-26889.995	7.960
15068	-111977.645	-26877.641	12.905
10857	-111970.036	-26879.945	7.950
10858	-111972.106	-26886.824	7.184
10859	-111973.753	-26892.293	5.712
面積	102.6239295		
地積	102.62 m ²		

86

地番 桂徳五二ノ二			
NO	X	Y	辺長
15067	-111981.374	-26889.995	
10997	-111999.621	-26884.492	19.059
10996	-111999.005	-26882.454	2.129
11019	-111995.874	-26872.119	10.799
15068	-111977.645	-26877.641	19.047
15067	-111981.374	-26889.995	12.905
面積	246.0985470		
地積	246.09 m ²		

87

地番 桂徳五二ノ四			
NO	X	Y	辺長
10857	-111970.036	-26879.945	
15068	-111977.645	-26877.641	7.950
11019	-111995.874	-26872.119	19.047
15066	-111994.666	-26868.125	4.173
15065	-111993.824	-26865.338	2.911
10856	-111967.992	-26873.152	26.988
10857	-111970.036	-26879.945	7.094
面積	191.3564520		
地積	191.35 m ²		

88

地番 保 一二二ノ二号			
NO	X	Y	辺長
10856	-111967.992	-26873.152	
15065	-111993.824	-26865.338	26.988
11016	-111989.268	-26850.255	15.756
11017	-111984.819	-26850.984	4.508
11027	-111964.931	-26854.259	20.156
11020	-111963.352	-26856.777	2.972
11021	-111963.171	-26857.082	0.355
10855	-111967.495	-26871.502	15.054
10856	-111967.992	-26873.152	1.723
面積	469.6514040		
地積	469.65 m ²		

89

地番 保 一二二ノ三号			
NO	X	Y	辺長
15065	-111993.824	-26865.338	
11008	-112019.683	-26857.515	27.016
11015	-112016.158	-26845.854	12.182
11014	-112015.730	-26845.919	0.433
11016	-111989.268	-26850.255	26.815
15065	-111993.824	-26865.338	15.756
面積	377.4432390		
地積	377.44 m ²		

90

地番 桂河田一二ノ三			
NO	X	Y	辺長
15066	-111994.666	-26868.125	
11007	-112020.525	-26860.301	27.017
11008	-112019.683	-26857.515	2.910
15065	-111993.824	-26865.338	27.016
15066	-111994.666	-26868.125	2.911
面積	78.6434905		
地積	78.64 m ²		

91

地番 桂徳五二ノ一			
NO	X	Y	辺長
10996	-111999.005	-26882.454	
11005	-112024.859	-26874.645	27.008
11006	-112023.817	-26871.192	3.607
11007	-112020.525	-26860.301	11.378
15066	-111994.666	-26868.125	27.017
11019	-111995.874	-26872.119	4.173
10996	-111999.005	-26882.454	10.799
面積	404.6076585		
地積	404.60 m ²		

92

地番 桂徳一三			
NO	X	Y	辺長
15070	-112002.602	-26894.387	
11004	-112028.453	-26886.549	27.013
11005	-112024.859	-26874.645	12.435
10996	-111999.005	-26882.454	27.008
10997	-111999.621	-26884.492	2.129
15069	-112001.019	-26889.133	4.847
15070	-112002.602	-26894.387	5.487
面積	336.2432000		
地積	336.24 m ²		

93

地番 桂徳四〇			
NO	X	Y	辺長
15071	-112004.922	-26902.018	
11009	-112030.764	-26894.203	26.998
11003	-112029.600	-26890.348	4.027
11004	-112028.453	-26886.549	3.968
15070	-112002.602	-26894.387	27.013
10998	-112002.837	-26895.168	0.816
15071	-112004.922	-26902.018	7.160
面積	215.6632790		
地積	215.66 m ²		

94

地番 桂徳二八ノ二			
NO	X	Y	辺長
15072	-112006.520	-26907.302	
11002	-112032.361	-26899.493	26.995
11009	-112030.764	-26894.203	5.526
15071	-112004.922	-26902.018	26.998
10999	-112006.040	-26905.691	3.839
15072	-112006.520	-26907.302	1.681
面積	149.0846515		
地積	149.08 m ²		

95

地番 桂徳六六ノ二			
NO	X	Y	辺長
11000	-112007.287	-26909.871	
11001	-112033.136	-26902.061	27.003
11002	-112032.361	-26899.493	2.682
15072	-112006.520	-26907.302	26.995
11000	-112007.287	-26909.871	2.681
面積	72.4040070		
地積	72.40 m ²		

96

地番 上北村三四			
NO	X	Y	辺長
10167	-112016.196	-26939.292	
10166	-112031.175	-26934.778	15.644
10784	-112039.168	-26932.365	8.349
10783	-112041.150	-26928.635	4.224
10782	-112035.379	-26909.491	19.995
11001	-112033.136	-26902.061	7.761
11000	-112007.287	-26909.871	27.003
11012	-112011.344	-26923.255	13.985
10167	-112016.196	-26939.292	16.755
面積	825.2871025		
地積	825.28 m ²		

図面の種類	画地面積求積表		
街区番号	122	番号	縮尺
町名	桂徳大寺北町		
京都市洛西第二土地区画整理組合			

S = 1 : 250

126 小

100-2

100-3


126

127

130


300-5

拡大図

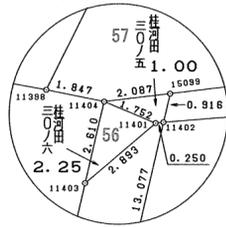

桂河田町

図面の種類	画地出来形確認測量図町		
街区番号	125 1/2	番号	縮尺 1 : 250
町名	桂徳大寺南町		
京都市洛西第二土地区画整理組合			

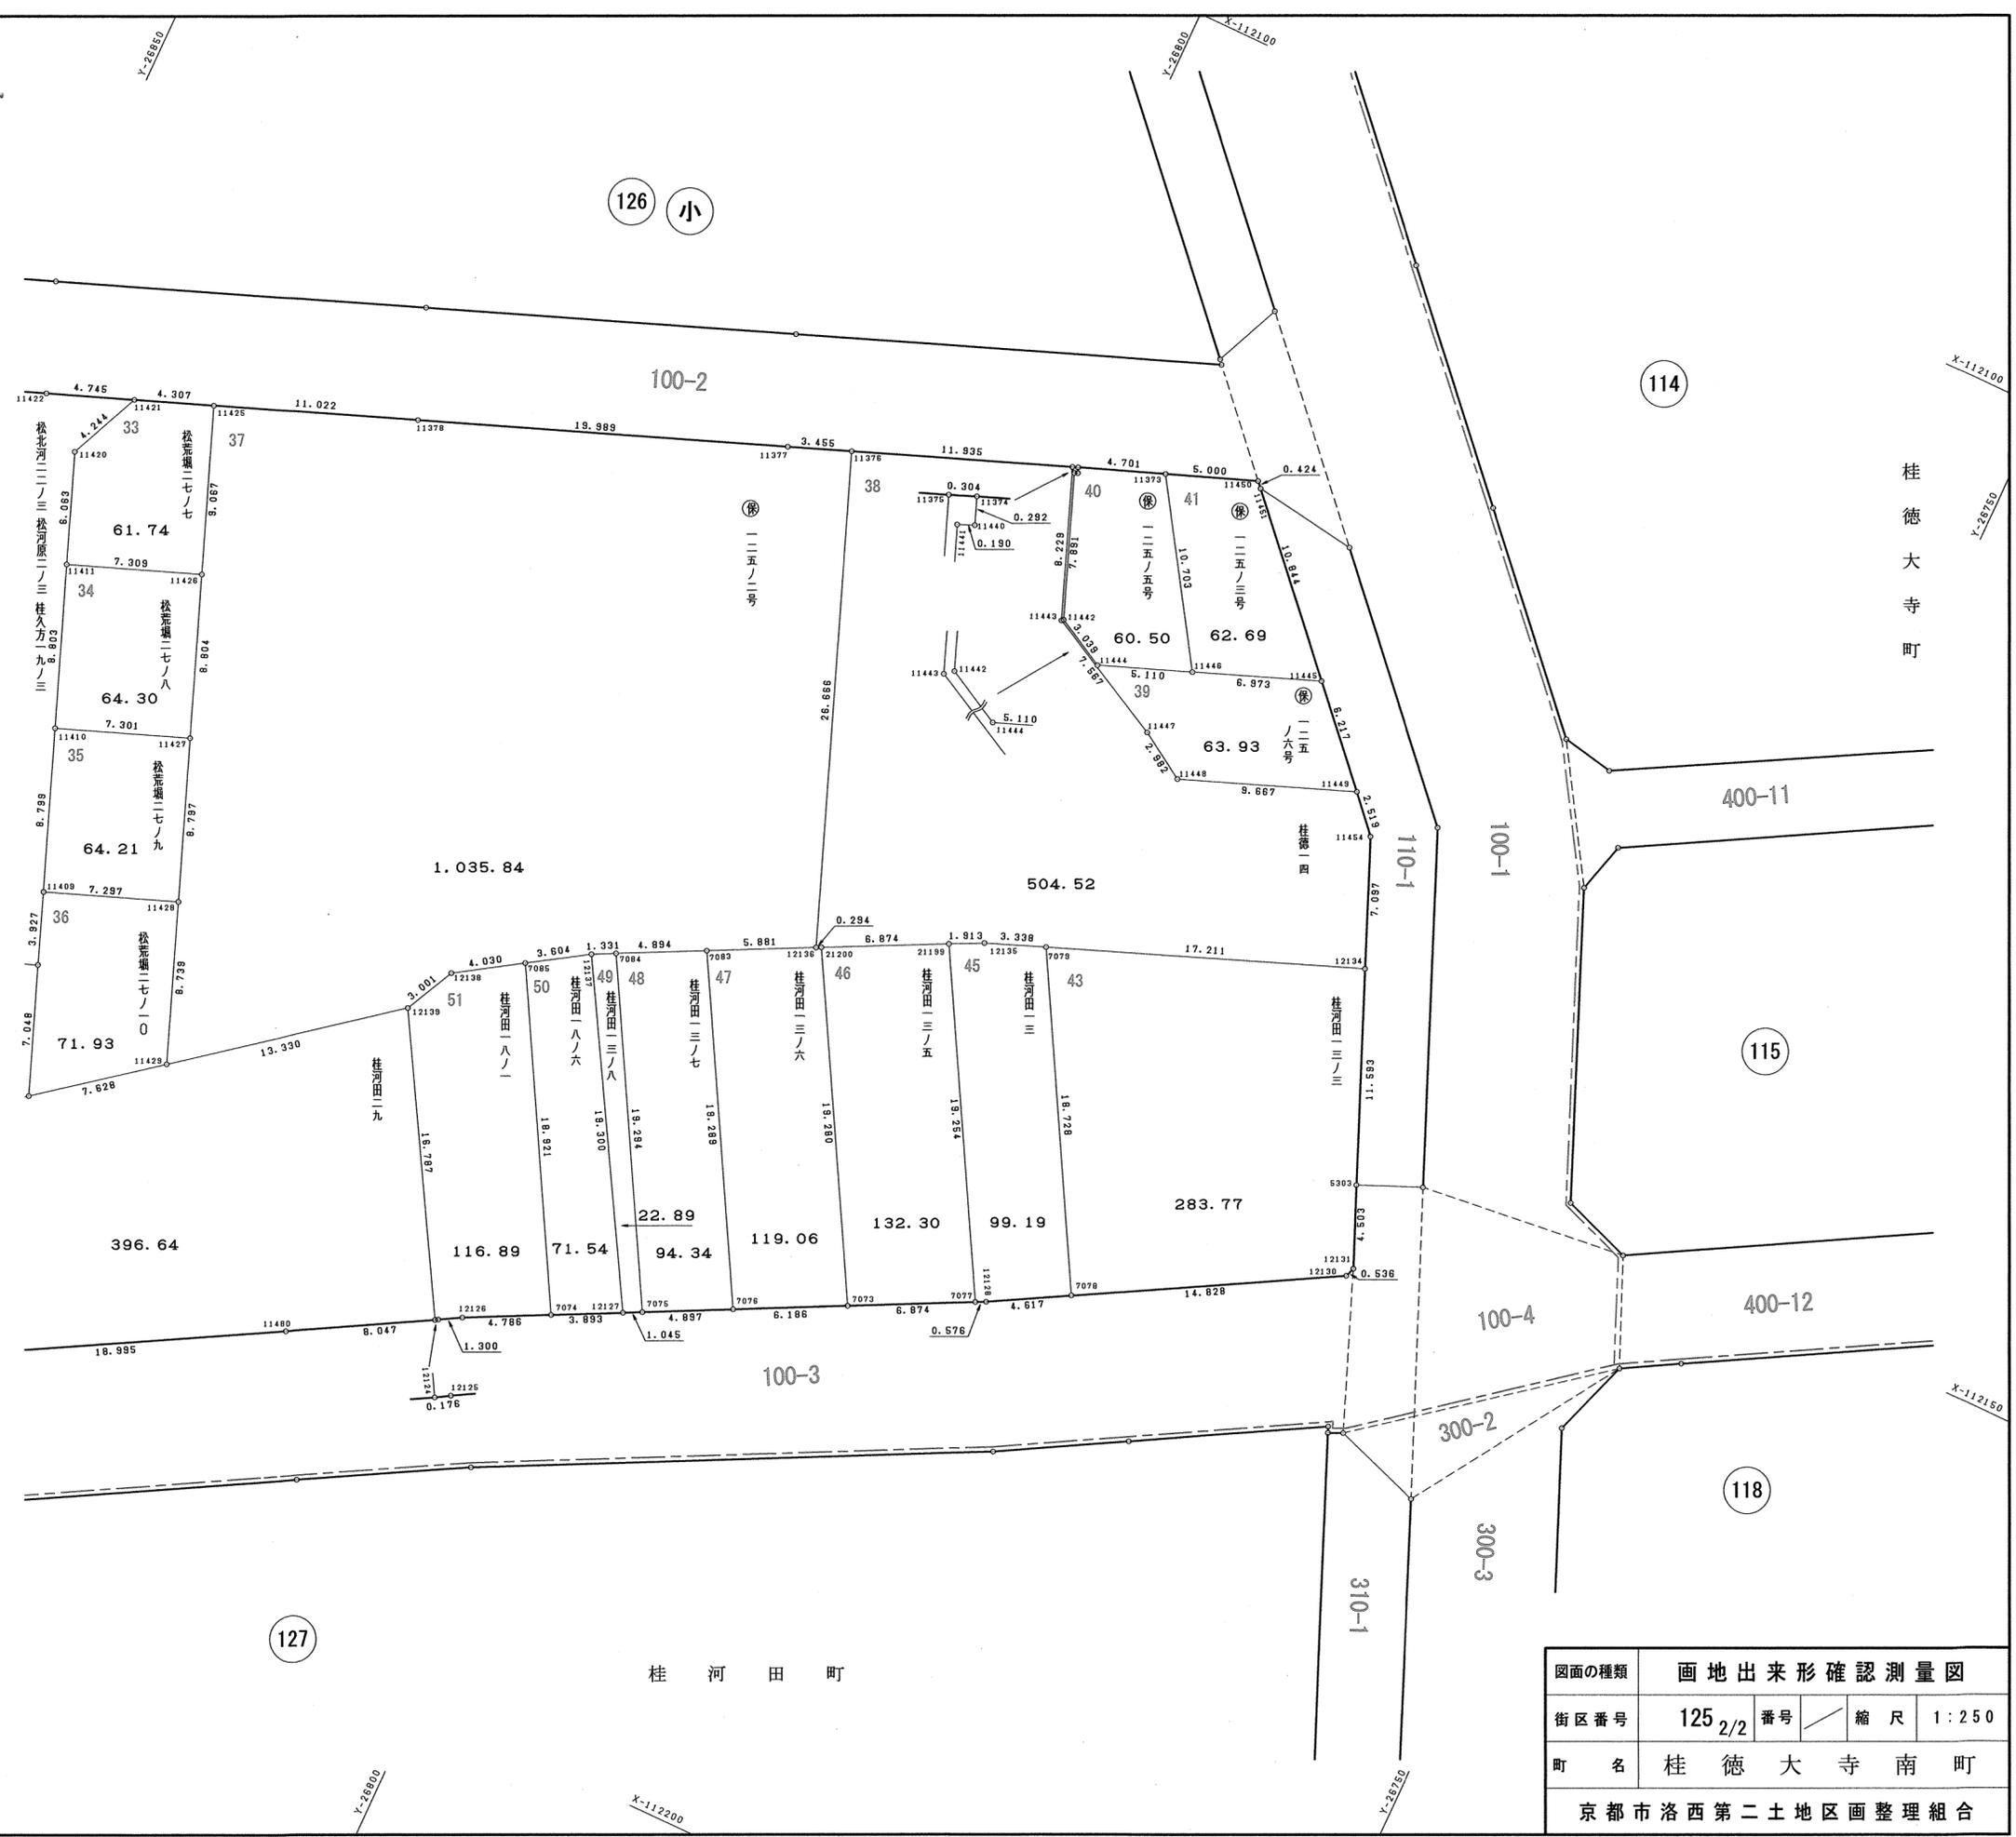

図面の種類	画地出来形確認測量図			
街区番号	125	2/2	番号	縮尺 1:250
町名	桂徳大寺南町			
京都市洛西第二土地区画整理組合				

Table 18: Land parcels with columns for parcel number, coordinates (X, Y), and side length. Includes area and total area calculations.

Table 19: Land parcels with columns for parcel number, coordinates (X, Y), and side length. Includes area and total area calculations.

Table 20: Land parcels with columns for parcel number, coordinates (X, Y), and side length. Includes area and total area calculations.

Table 21: Land parcels with columns for parcel number, coordinates (X, Y), and side length. Includes area and total area calculations.

Table 22: Land parcels with columns for parcel number, coordinates (X, Y), and side length. Includes area and total area calculations.

Table 23: Land parcels with columns for parcel number, coordinates (X, Y), and side length. Includes area and total area calculations.

Table 24: Land parcels with columns for parcel number, coordinates (X, Y), and side length. Includes area and total area calculations.

Table 25: Land parcels with columns for parcel number, coordinates (X, Y), and side length. Includes area and total area calculations.

Table 26: Land parcels with columns for parcel number, coordinates (X, Y), and side length. Includes area and total area calculations.

Table 27: Land parcels with columns for parcel number, coordinates (X, Y), and side length. Includes area and total area calculations.

Table 28: Land parcels with columns for parcel number, coordinates (X, Y), and side length. Includes area and total area calculations.

Table 29: Land parcels with columns for parcel number, coordinates (X, Y), and side length. Includes area and total area calculations.

Table 43: Land parcels with columns for parcel number, coordinates (X, Y), and side length. Includes area and total area calculations.

Table 45: Land parcels with columns for parcel number, coordinates (X, Y), and side length. Includes area and total area calculations.

Diagram type: 画地面積求積表 (Area Calculation Table). Address: 125, 桂徳大寺南町 (Kaidai Daishu Nancho). Organization: 京都市洛西第二土地区画整理組合 (Kyoto City West Second Land District Reorganization Committee).

46

地番 桂河田一三ノ五			
NO	X	Y	辺長
21200	-112153.955	-26797.339	
7073	-112170.783	-26787.929	19.280
7077	-112167.697	-26781.787	6.874
21199	-112150.892	-26791.185	19.254
21200	-112153.955	-26797.339	6.874
面積	132.3004400		
地積	132.30 m ²		

47

地番 桂河田一三ノ六			
NO	X	Y	辺長
7083	-112156.720	-26802.860	
7076	-112173.561	-26793.456	19.289
7073	-112170.783	-26787.929	6.186
21200	-112153.955	-26797.339	19.280
12136	-112154.086	-26797.602	0.294
7083	-112156.720	-26802.860	5.881
面積	119.0672505		
地積	119.06 m ²		

48

地番 桂河田一三ノ七			
NO	X	Y	辺長
7084	-112158.913	-26807.235	
7075	-112175.760	-26797.831	19.294
7076	-112173.561	-26793.456	4.897
7083	-112156.720	-26802.860	19.289
7084	-112158.913	-26807.235	4.894
面積	94.3436840		
地積	94.34 m ²		

49

地番 桂河田一三ノ八			
NO	X	Y	辺長
12137	-112159.518	-26808.420	
12127	-112176.229	-26798.765	19.300
7075	-112175.760	-26797.831	1.045
7084	-112158.913	-26807.235	19.294
12137	-112159.518	-26808.420	1.331
面積	22.8946920		
地積	22.89 m ²		

50

地番 桂河田一八ノ六			
NO	X	Y	辺長
7085	-112161.453	-26811.461	
7074	-112177.977	-26802.243	18.921
12127	-112176.229	-26798.765	3.893
12137	-112159.518	-26808.420	19.300
7085	-112161.453	-26811.461	3.604
面積	71.5420560		
地積	71.54 m ²		

51

地番 桂河田一八ノ一			
NO	X	Y	辺長
12139	-112166.313	-26816.192	
12124	-112180.853	-26807.803	16.787
12125	-112180.767	-26807.650	0.176
12126	-112180.126	-26806.519	1.300
7074	-112177.977	-26802.243	4.786
7085	-112161.453	-26811.461	18.921
12138	-112163.627	-26814.854	4.030
12139	-112166.313	-26816.192	3.001
面積	116.8999725		
地積	116.89 m ²		

52

地番 桂河田二九			
NO	X	Y	辺長
11479	-112194.044	-26831.409	
11480	-112184.785	-26814.824	18.995
12124	-112180.853	-26807.803	8.047
12139	-112166.313	-26816.192	16.787
11429	-112174.522	-26826.695	13.330
11416	-112179.212	-26832.711	7.628
11407	-112183.029	-26837.602	6.204
11479	-112194.044	-26831.409	12.637
面積	396.6431990		
地積	396.64 m ²		

53

地番 桂徳一六ノ二 桂河田二九ノ二、三ノ二			
NO	X	Y	辺長
11402	-112190.758	-26851.180	
11462	-112203.547	-26848.449	13.077
11478	-112194.565	-26832.342	18.442
11479	-112194.044	-26831.409	1.069
11407	-112183.029	-26837.602	12.637
11402	-112190.758	-26851.180	15.624
面積	220.6580805		
地積	220.65 m ²		

54

地番 桂河田二九ノ五			
NO	X	Y	辺長
15099	-112189.862	-26851.371	
11402	-112190.758	-26851.180	0.916
11407	-112183.029	-26837.602	15.624
11406	-112181.110	-26839.409	2.636
11405	-112184.242	-26842.340	4.290
15099	-112189.862	-26851.371	10.637
面積	20.2995985		
地積	20.29 m ²		

55

地番 桂河田三〇ノ一			
NO	X	Y	辺長
11403	-112193.517	-26852.600	
11460	-112204.553	-26850.252	11.283
11461	-112204.326	-26849.845	0.466
11462	-112203.547	-26848.449	1.599
11402	-112190.758	-26851.180	13.077
11401	-112190.888	-26851.393	0.250
11403	-112193.517	-26852.600	2.893
面積	24.1792165		
地積	24.17 m ²		

56

地番 桂河田三〇ノ六			
NO	X	Y	辺長
11404	-112190.964	-26853.143	
11403	-112193.517	-26852.600	2.610
11401	-112190.888	-26851.393	2.893
11404	-112190.964	-26853.143	1.752
面積	2.2545090		
地積	2.25 m ²		

57

地番 桂河田三〇ノ五			
NO	X	Y	辺長
11404	-112190.964	-26853.143	
11401	-112190.888	-26851.393	1.752
11402	-112190.758	-26851.180	0.250
15099	-112189.862	-26851.371	0.916
11404	-112190.964	-26853.143	2.087
面積	1.0047530		
地積	1.00 m ²		

58

地番 桂徳一六ノ五			
NO	X	Y	辺長
11396	-112191.960	-26857.010	
11397	-112193.563	-26856.641	1.645
11459	-112206.571	-26853.873	13.299
11460	-112204.553	-26850.252	4.145
11403	-112193.517	-26852.600	11.283
11404	-112190.964	-26853.143	2.610
11398	-112191.401	-26854.938	1.847
11396	-112191.960	-26857.010	2.146
面積	57.1990965		
地積	57.19 m ²		

59

地番 桂河田三〇ノ四			
NO	X	Y	辺長
11393	-112198.469	-26874.487	
11457	-112214.557	-26868.197	17.274
11458	-112214.070	-26867.327	0.997
11459	-112206.571	-26853.873	15.403
11397	-112193.563	-26856.641	13.299
11395	-112192.541	-26858.698	2.297
11394	-112197.225	-26870.501	12.698
11393	-112198.469	-26874.487	4.176
面積	275.3559110		
地積	275.35 m ²		

60

地番 桂河田三〇ノ七			
NO	X	Y	辺長
11395	-112192.541	-26858.698	
11397	-112193.563	-26856.641	2.297
11396	-112191.960	-26857.010	1.645
11395	-112192.541	-26858.698	1.785
面積	1.4601265		
地積	1.46 m ²		

61

地番 保 一二五ノ四号			
NO	X	Y	辺長
11389	-112200.638	-26883.731	
11455	-112216.399	-26877.559	16.926
11456	-112217.743	-26873.885	3.912
11457	-112214.557	-26868.197	6.520
11393	-112198.469	-26874.487	17.274
11392	-112199.630	-26878.254	3.942
11389	-112200.638	-26883.731	5.569
面積	169.0360815		
地積	169.03 m ²		

62

地番 桂徳一六ノ三			
NO	X	Y	辺長
11337	-112188.953	-26888.304	
11388	-112195.569	-26885.716	7.104
11389	-112200.638	-26883.731	5.444
11392	-112199.630	-26878.254	5.569
11393	-112198.469	-26874.487	3.942
11394	-112197.225	-26870.501	4.176
11435	-112184.140	-26875.328	13.947
11432	-112184.749	-26877.042	1.819
11433	-112185.267	-26878.498	1.545
11434	-112188.209	-26886.428	8.458
11337	-112188.953	-26888.304	2.018
面積	184.8341975		
地積	184.83 m ²		

63


地番 桂徳一六ノ四			
NO	X	Y	辺長
11435	-112184.140	-26875.328	
11394	-112197.225	-26870.501	13.947
11395	-112192.541	-26858.698	12.698
11396	-112191.960	-26857.010	1.785
11398	-112191.401	-26854.938	2.146
11399	-112189.952	-26854.904	1.449
11400	-112189.590	-26855.049	0.390
11340	-112177.456	-26857.391	12.358
16255	-112178.433	-26860.150	2.927
11339	-112179.706	-26863.702	3.773
11436	-112179.828	-26864.385	0.694
16254	-112180.375	-26865.847	1.561
11437	-112181.828	-26869.580	4.006
11435	-112184.140	-26875.328	6.196
面積	250.5277315		
地積	250.52 m ²		

64

地番 桂徳一六ノ一			
NO	X	Y	辺長
11340	-112177.456	-26857.391	
11400	-112189.590	-26855.049	12.358
11399	-112189.952	-26854.904	0.390
11398	-112191.401	-26854.938	1.449
11404	-112190.964	-26853.143	1.847
15099	-112189.862	-26851.371	2.087
11405	-112184.242	-26842.340	10.637
11406	-112181.110	-26839.409	4.290
11417	-112177.648	-26840.895	3.767
11342	-112173.739	-26849.098	9.087
11438	-112174.040	-26850.040	0.999
11341	-112176.255	-26856.308	6.648
11340	-112177.456	-26857.391	1.617
面積	195.1851315		
地積	195.18 m ²		

65

地番 保 一二五ノ七号			
NO	X	Y	辺長
11430	-112176.390	-26893.219	
11361	-112176.974	-26892.990	0.627
1			

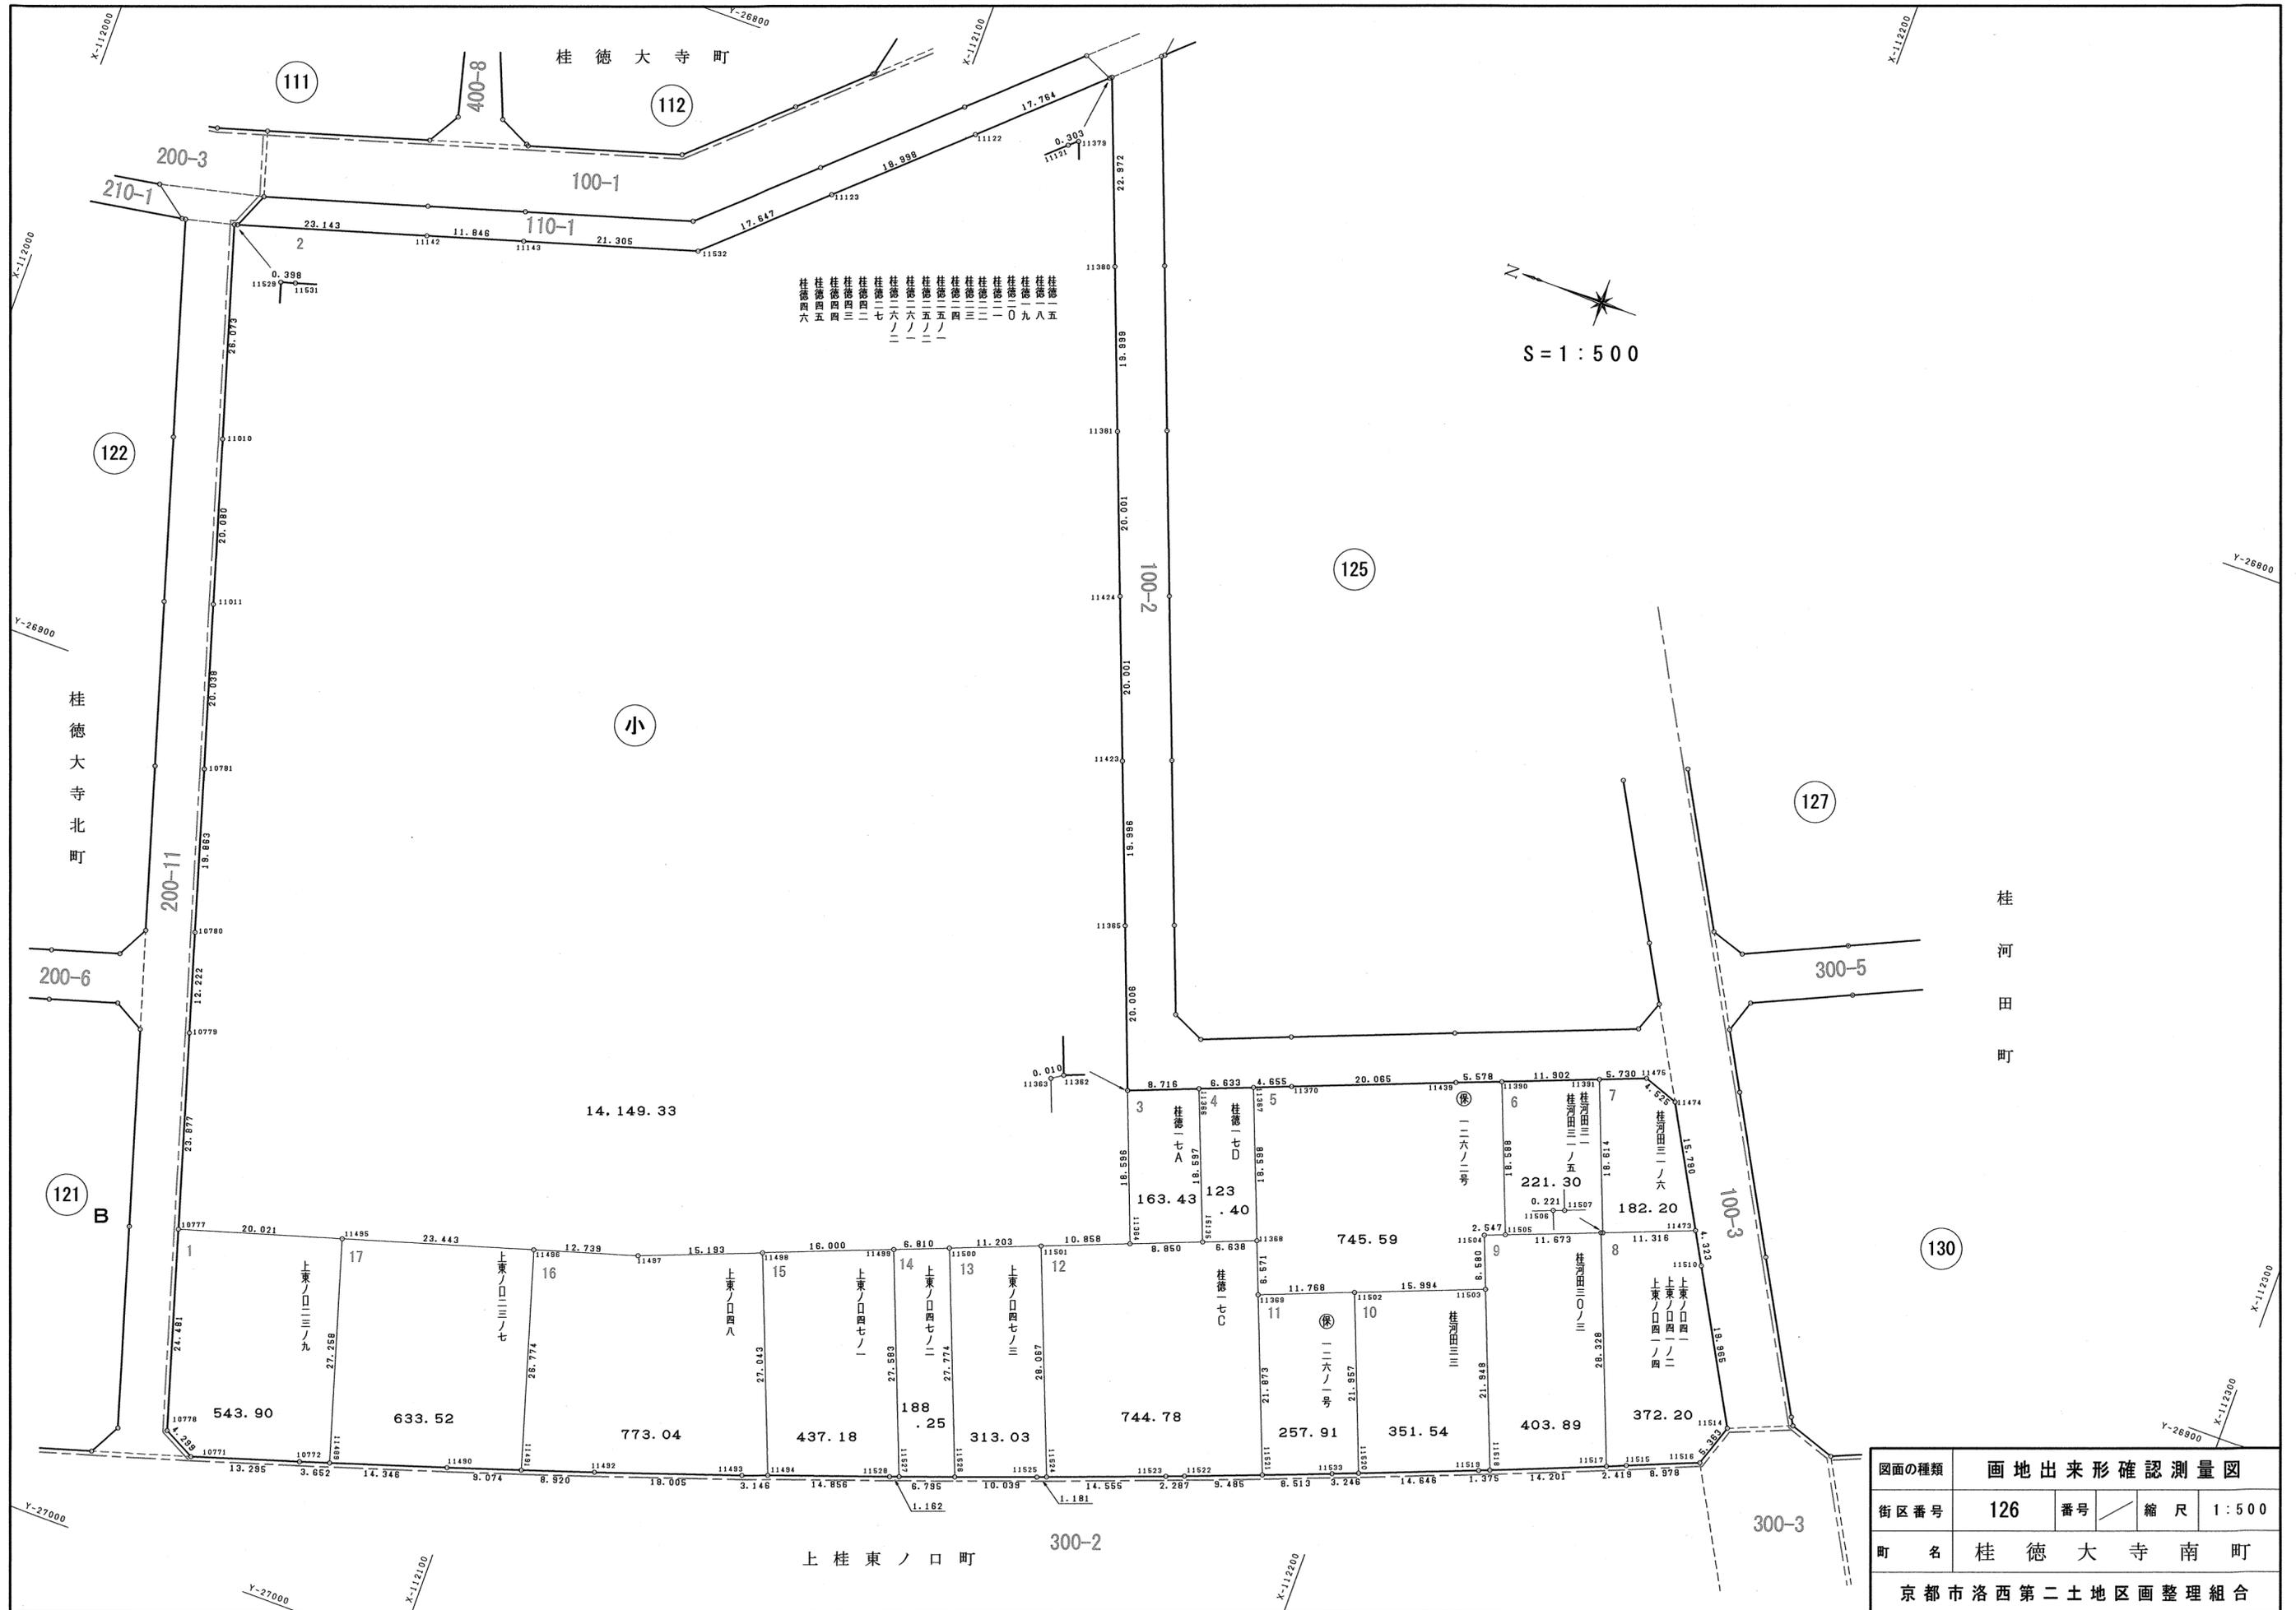

桂徳大寺町
 桂徳四六
 桂徳四五
 桂徳四四
 桂徳四三
 桂徳四二
 桂徳四一
 桂徳三〇
 桂徳二九
 桂徳二八
 桂徳二七
 桂徳二六
 桂徳二五
 桂徳二四
 桂徳二三
 桂徳二二
 桂徳二一
 桂徳二〇
 桂徳一九
 桂徳一八
 桂徳一七
 桂徳一六
 桂徳一五
 桂徳一四
 桂徳一三
 桂徳一二
 桂徳一一
 桂徳一〇
 桂徳〇九
 桂徳〇八
 桂徳〇七
 桂徳〇六
 桂徳〇五
 桂徳〇四
 桂徳〇三
 桂徳〇二
 桂徳〇一

N
 S = 1 : 500

図面の種類	画地出来形確認測量図		
街区番号	126	番号	縮尺 1:500
町名	桂徳大寺南町		
京都市洛西第二土地区画整理組合			

1

地番 上東ノ口二三ノ九			
N O	X	Y	辺長
10778	-112064.374	-26984.801	
10771	-112068.193	-26986.776	4.299
10772	-112080.877	-26982.793	13.295
11489	-112084.355	-26981.678	3.652
11495	-112076.475	-26955.584	27.258
10777	-112057.306	-26961.362	20.021
10778	-112064.374	-26984.801	24.481
面積	543.9067735		
地積	543.90 m ²		

2

地番 桂徳一五、一八、一九、二〇、二一、二二、二三、二四、二五ノ一、二五ノ二、二六ノ一、二六ノ二、二七、四二、四三、四四、四五、四六			
N O	X	Y	辺長
10777	-112057.306	-26961.362	
11495	-112076.475	-26955.584	20.021
11496	-112098.920	-26948.816	23.443
11497	-112111.117	-26945.140	12.739
11498	-112125.267	-26939.609	15.193
11499	-112140.171	-26933.788	16.000
11500	-112146.513	-26931.306	6.810
11501	-112156.948	-26927.230	11.203
11364	-112167.060	-26923.275	10.858
11363	-112160.417	-26905.906	18.596
11362	-112160.425	-26905.900	0.010
11365	-112153.292	-26887.209	20.006
11423	-112146.138	-26868.537	19.996
11424	-112139.007	-26849.850	20.001
11381	-112131.874	-26831.164	20.001
11380	-112124.745	-26812.479	19.999
11379	-112116.549	-26791.019	22.972
11121	-112116.316	-26791.212	0.303
11122	-112103.235	-26803.231	17.764
11123	-112089.247	-26816.086	18.898
11532	-112076.266	-26828.041	17.647
11143	-112055.873	-26834.209	21.305
11142	-112044.531	-26837.629	11.846
11531	-112022.375	-26844.315	23.143
11529	-112021.993	-26844.425	0.398
11010	-112029.550	-26869.379	26.073
11011	-112035.349	-26888.603	20.080
10781	-112041.152	-26907.782	20.038
10780	-112046.885	-26926.800	19.863
10779	-112050.412	-26938.502	12.222
10777	-112057.306	-26961.362	23.877
面積	14149.3351900		
地積	14149.33 m ²		

3

地番 桂徳一七A			
N O	X	Y	辺長
11364	-112167.060	-26923.275	
15135	-112175.303	-26920.053	8.850
11366	-112168.543	-26902.728	18.597
11362	-112160.425	-26905.900	8.716
11363	-112160.417	-26905.906	0.010
11364	-112167.060	-26923.275	18.596
面積	163.4329875		
地積	163.43 m ²		

4

地番 桂徳一七D			
N O	X	Y	辺長
15135	-112175.303	-26920.053	
11368	-112181.486	-26917.637	6.638
11367	-112174.721	-26900.313	18.598
11366	-112168.543	-26902.728	6.633
15135	-112175.303	-26920.053	18.597
面積	123.4088910		
地積	123.40 m ²		

5

地番 保 一六ノ二号			
N O	X	Y	辺長
11369	-112183.870	-26923.760	
11502	-112194.827	-26919.467	11.768
11503	-112209.723	-26913.642	15.994
11504	-112207.320	-26907.516	6.580
11505	-112209.695	-26906.595	2.547
11390	-112202.938	-26889.279	18.588
11439	-112197.743	-26891.309	5.578
11370	-112179.057	-26889.619	20.065
11367	-112174.721	-26900.313	4.655
11368	-112181.486	-26917.637	18.598
11369	-112183.870	-26923.760	6.571
面積	745.5920070		
地積	745.59 m ²		

6

地番 桂河田三一、三一ノ五			
N O	X	Y	辺長
11505	-112209.695	-26906.595	
11506	-112220.576	-26902.369	11.673
11507	-112220.783	-26902.291	0.221
11391	-112214.024	-26884.947	18.614
11390	-112202.938	-26889.279	11.902
11505	-112209.695	-26906.595	18.588
面積	221.3057220		
地積	221.30 m ²		

7

地番 桂河田三一ノ六			
N O	X	Y	辺長
11507	-112220.783	-26902.291	
11473	-112231.319	-26898.162	11.316
11474	-112223.626	-26884.373	15.790
11475	-112219.361	-26882.862	4.525
11391	-112214.024	-26884.947	5.730
11507	-112220.783	-26902.291	18.614
面積	182.2093935		
地積	182.20 m ²		

8

地番 上東ノ口四一、四一ノ二、四一ノ四			
N O	X	Y	辺長
11517	-112230.883	-26928.755	
11515	-112233.125	-26927.848	2.419
11516	-112241.435	-26924.450	8.978
11514	-112243.155	-26919.370	5.363
11510	-112233.425	-26901.937	19.965
11473	-112231.319	-26898.162	4.323
11507	-112220.783	-26902.291	11.316
11506	-112220.576	-26902.369	0.221
11517	-112230.883	-26928.755	28.328
面積	372.2013710		
地積	372.20 m ²		

9

地番 桂河田三〇ノ三			
N O	X	Y	辺長
11518	-112217.719	-26934.082	
11517	-112230.883	-26928.755	14.201
11506	-112220.576	-26902.369	28.328
11505	-112209.695	-26906.595	11.673
11504	-112207.320	-26907.516	2.547
11503	-112209.723	-26913.642	6.580
11518	-112217.719	-26934.082	21.948
面積	403.8920345		
地積	403.89 m ²		

10

地番 桂河田三三			
N O	X	Y	辺長
11520	-112202.801	-26939.925	
11519	-112216.444	-26934.598	14.646
11518	-112217.719	-26934.082	1.375
11503	-112209.723	-26913.642	21.948
11502	-112194.827	-26919.467	15.994
11520	-112202.801	-26939.925	21.957
面積	351.5416645		
地積	351.54 m ²		

11

地番 保 一二六ノ一号			
N O	X	Y	辺長
11521	-112191.822	-26944.136	
11533	-112199.778	-26941.106	8.513
11520	-112202.801	-26939.925	3.246
11502	-112194.827	-26919.467	21.957
11369	-112183.870	-26923.760	11.768
11521	-112191.822	-26944.136	21.873
面積	257.9105050		
地積	257.91 m ²		

12

地番 桂徳一七C			
N O	X	Y	辺長
11524	-112167.167	-26953.371	
11523	-112180.813	-26948.307	14.555
11522	-112182.958	-26947.513	2.287
11521	-112191.822	-26944.136	9.485
11369	-112183.870	-26923.760	21.873
11368	-112181.486	-26917.637	6.571
15135	-112175.303	-26920.053	6.638
11364	-112167.060	-26923.275	8.850
11501	-112156.948	-26927.230	10.858
11524	-112167.167	-26953.371	28.067
面積	744.7871345		
地積	744.78 m ²		

13

地番 上東ノ口四七ノ三			
N O	X	Y	辺長
11526	-112156.613	-26957.178	
11525	-112166.060	-26953.782	10.039
11524	-112167.167	-26953.371	1.181
11501	-112156.948	-26927.230	28.067
11500	-112146.513	-26931.306	11.203
11526	-112156.613	-26957.178	27.774
面積	313.0305560		
地積	313.03 m ²		

14

地番 上東ノ口四七ノ二			
N O	X	Y	辺長
11527	-112150.218	-26959.476	
11526	-112156.613	-26957.178	6.795
11500	-112146.513	-26931.306	27.774
11499	-112140.171	-26933.788	6.810
11527	-112150.218	-26959.476	27.583
面積	188.2555950		
地積	188.25 m ²		

15

地番 上東ノ口四七ノ一			
N O	X	Y	辺長
11498	-112125.267	-26939.609	
11494	-112135.110	-26964.797	27.043
11528	-112149.125	-26959.869	14.856
11527	-112150.218	-26959.476	1.162
11499	-112140.171	-26933.788	27.583
11498	-112125.267	-26939.609	16.000
面積	437.1870185		
地積	437.18 m ²		

16

地番 上東ノ口四八			
N O	X	Y	辺長
11491	-112106.633	-26974.455	
11492	-112115.103	-26971.658	8.920
11493	-112132.142	-26965.841	18.005
11494	-112135.110	-26964.797	3.146
11498	-112125.267	-26939.609	27.043
11497	-112111.117	-26945.140	15.193
11496	-112098.920	-26948.816	12.739
11491	-112106.633	-26974.455	26.774
面積	773.0487190		
地積	773.04 m ²		

17

地番 上東ノ口二三ノ七			
N O	X	Y	辺長
11489	-112084.355	-26981.678	
11490	-112098.017	-26977.300	14.346
11491	-112106.633	-26974.455	9.074
11496	-112098.920	-26948.816	26.774
11495	-112076.475	-26955.584	23.443
11489	-112084.355	-26981.678	27.258
面積	633.5279265		
地積	633.52 m ²		

図面の種類	画地面積求積表		
街区番号	126	番号	縮尺
町名	桂徳大寺南町		
京都市洛西第二土地区画整理組合			

桂徳大寺南町

S = 1 : 250



126

100-2

125


100-3

130

300-5

300-6

128

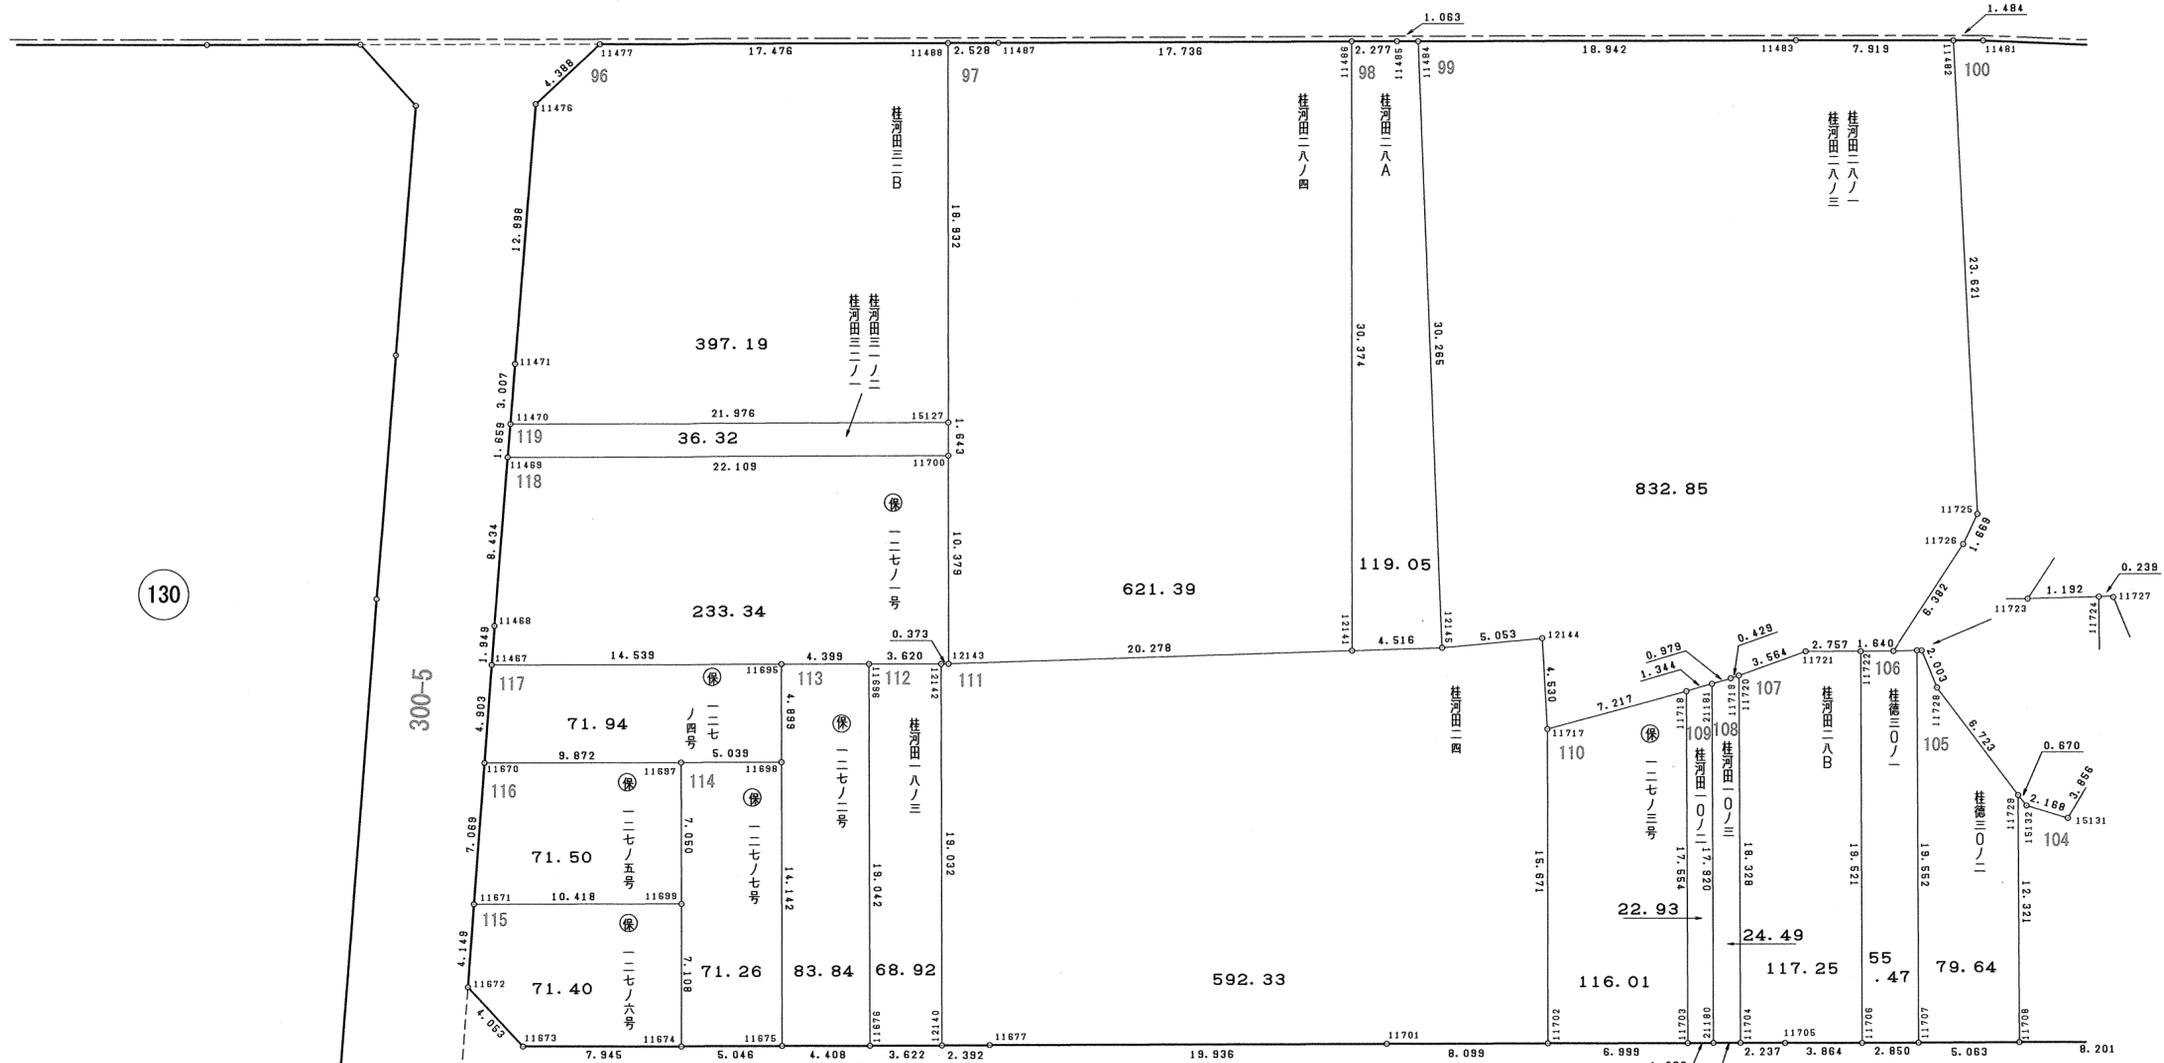


図面の種類	画地出来形確認測量図町			
街区番号	127	1/2	番号	縮尺 1 : 250
町名	桂河田町			
京都市洛西第二土地区画整理組合				

桂徳大寺南町

125

115

S = 1 : 250

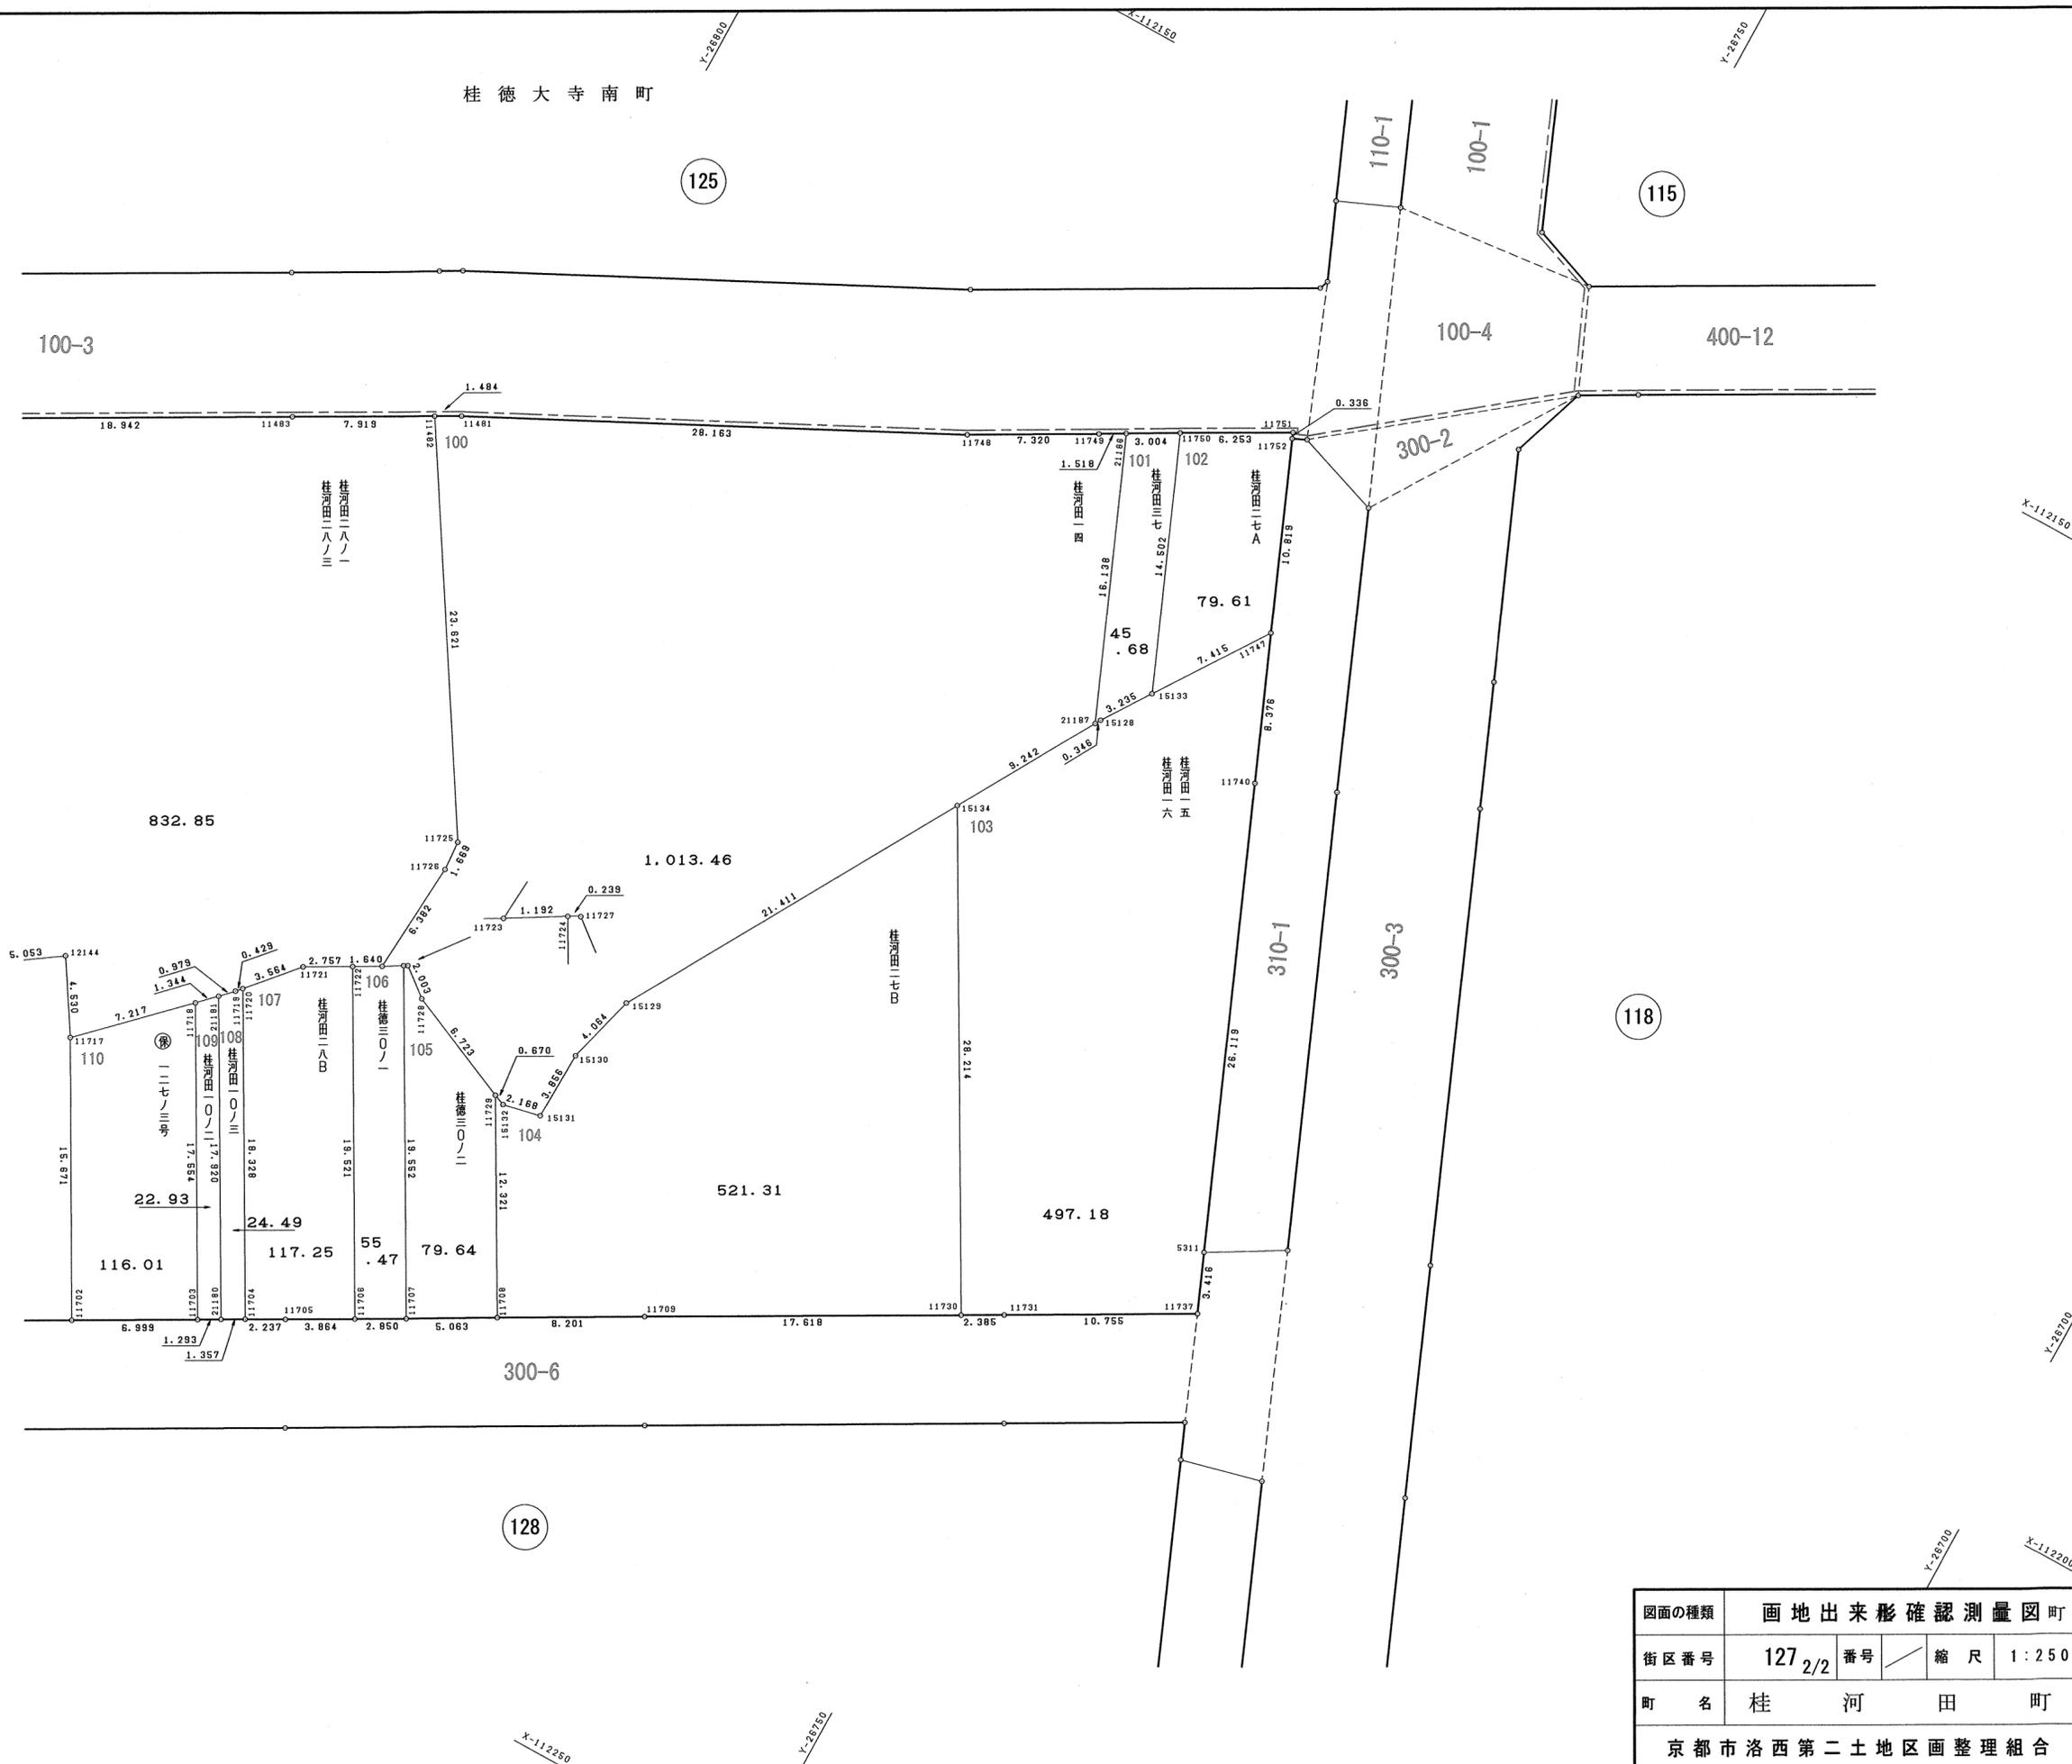

118

128

図面の種類	画地出来形確認測量図町		
街区番号	127	番号	2/2
町名	桂	河	田
京都市洛西第二土地区画整理組合			

Table 96: Land parcels 11477-11477. Columns: 地番, 桂河田三二B, NO, X, Y, 辺長, 面積, 地積.

Table 97: Land parcels 11488-11488. Columns: 地番, 桂河田二八ノ四, NO, X, Y, 辺長, 面積, 地積.

Table 98: Land parcels 11486-11486. Columns: 地番, 桂河田二八A, NO, X, Y, 辺長, 面積, 地積.

Table 99: Land parcels 11484-11484. Columns: 地番, 桂河田二八ノ一、桂河田二八ノ三, NO, X, Y, 辺長, 面積, 地積.

Table 100: Land parcels 21186-21186. Columns: 地番, 桂河田一四, NO, X, Y, 辺長, 面積, 地積.

Table 101: Land parcels 11750-11750. Columns: 地番, 桂河田町三七, NO, X, Y, 辺長, 面積, 地積.

Table 102: Land parcels 11751-11751. Columns: 地番, 桂河田二七A, NO, X, Y, 辺長, 面積, 地積.

Table 103: Land parcels 11730-11730. Columns: 地番, 桂河田一五、桂河田一六, NO, X, Y, 辺長, 面積, 地積.

Table 104: Land parcels 11708-11708. Columns: 地番, 桂河田二七B, NO, X, Y, 辺長, 面積, 地積.

Table 105: Land parcels 11724-11724. Columns: 地番, 桂徳三〇ノ二, NO, X, Y, 辺長, 面積, 地積.

Table 106: Land parcels 11722-11722. Columns: 地番, 桂徳三〇ノ一, NO, X, Y, 辺長, 面積, 地積.

Table 107: Land parcels 11720-11720. Columns: 地番, 桂河田二八B, NO, X, Y, 辺長, 面積, 地積.

Table 108: Land parcels 21180-21180. Columns: 地番, 桂河田一〇ノ三, NO, X, Y, 辺長, 面積, 地積.

Table 109: Land parcels 11718-11718. Columns: 地番, 桂河田一〇ノ二, NO, X, Y, 辺長, 面積, 地積.

Table 110: Land parcels 11717-11717. Columns: 地番, 保 一二七ノ三号, NO, X, Y, 辺長, 面積, 地積.

Table 111: Land parcels 12140-12140. Columns: 地番, 桂河田二四, NO, X, Y, 辺長, 面積, 地積.

Table 112: Land parcels 11676-11676. Columns: 地番, 桂河田一八ノ三, NO, X, Y, 辺長, 面積, 地積.

Table 113: Land parcels 11695-11695. Columns: 地番, 保 一二七ノ二号, NO, X, Y, 辺長, 面積, 地積.

Table 114: Land parcels 11697-11697. Columns: 地番, 保 一二七ノ七号, NO, X, Y, 辺長, 面積, 地積.


Table 115: Land parcels 11671-11671. Columns: 地番, 保 一二七ノ六号, NO, X, Y, 辺長, 面積, 地積.

Table 116: Land parcels 11670-11670. Columns: 地番, 保 一二七ノ五号, NO, X, Y, 辺長, 面積, 地積.

Table 117: Land parcels 11467-11467. Columns: 地番, 保 一二七ノ四号, NO, X, Y, 辺長, 面積, 地積.

Table 118: Land parcels 11469-11469. Columns: 地番, 保 一二七ノ一号, NO, X, Y, 辺長, 面積, 地積.

Table 119: Land parcels 11470-11470. Columns: 地番, 桂河田三一ノ二、桂河田三二ノ一, NO, X, Y, 辺長, 面積, 地積.

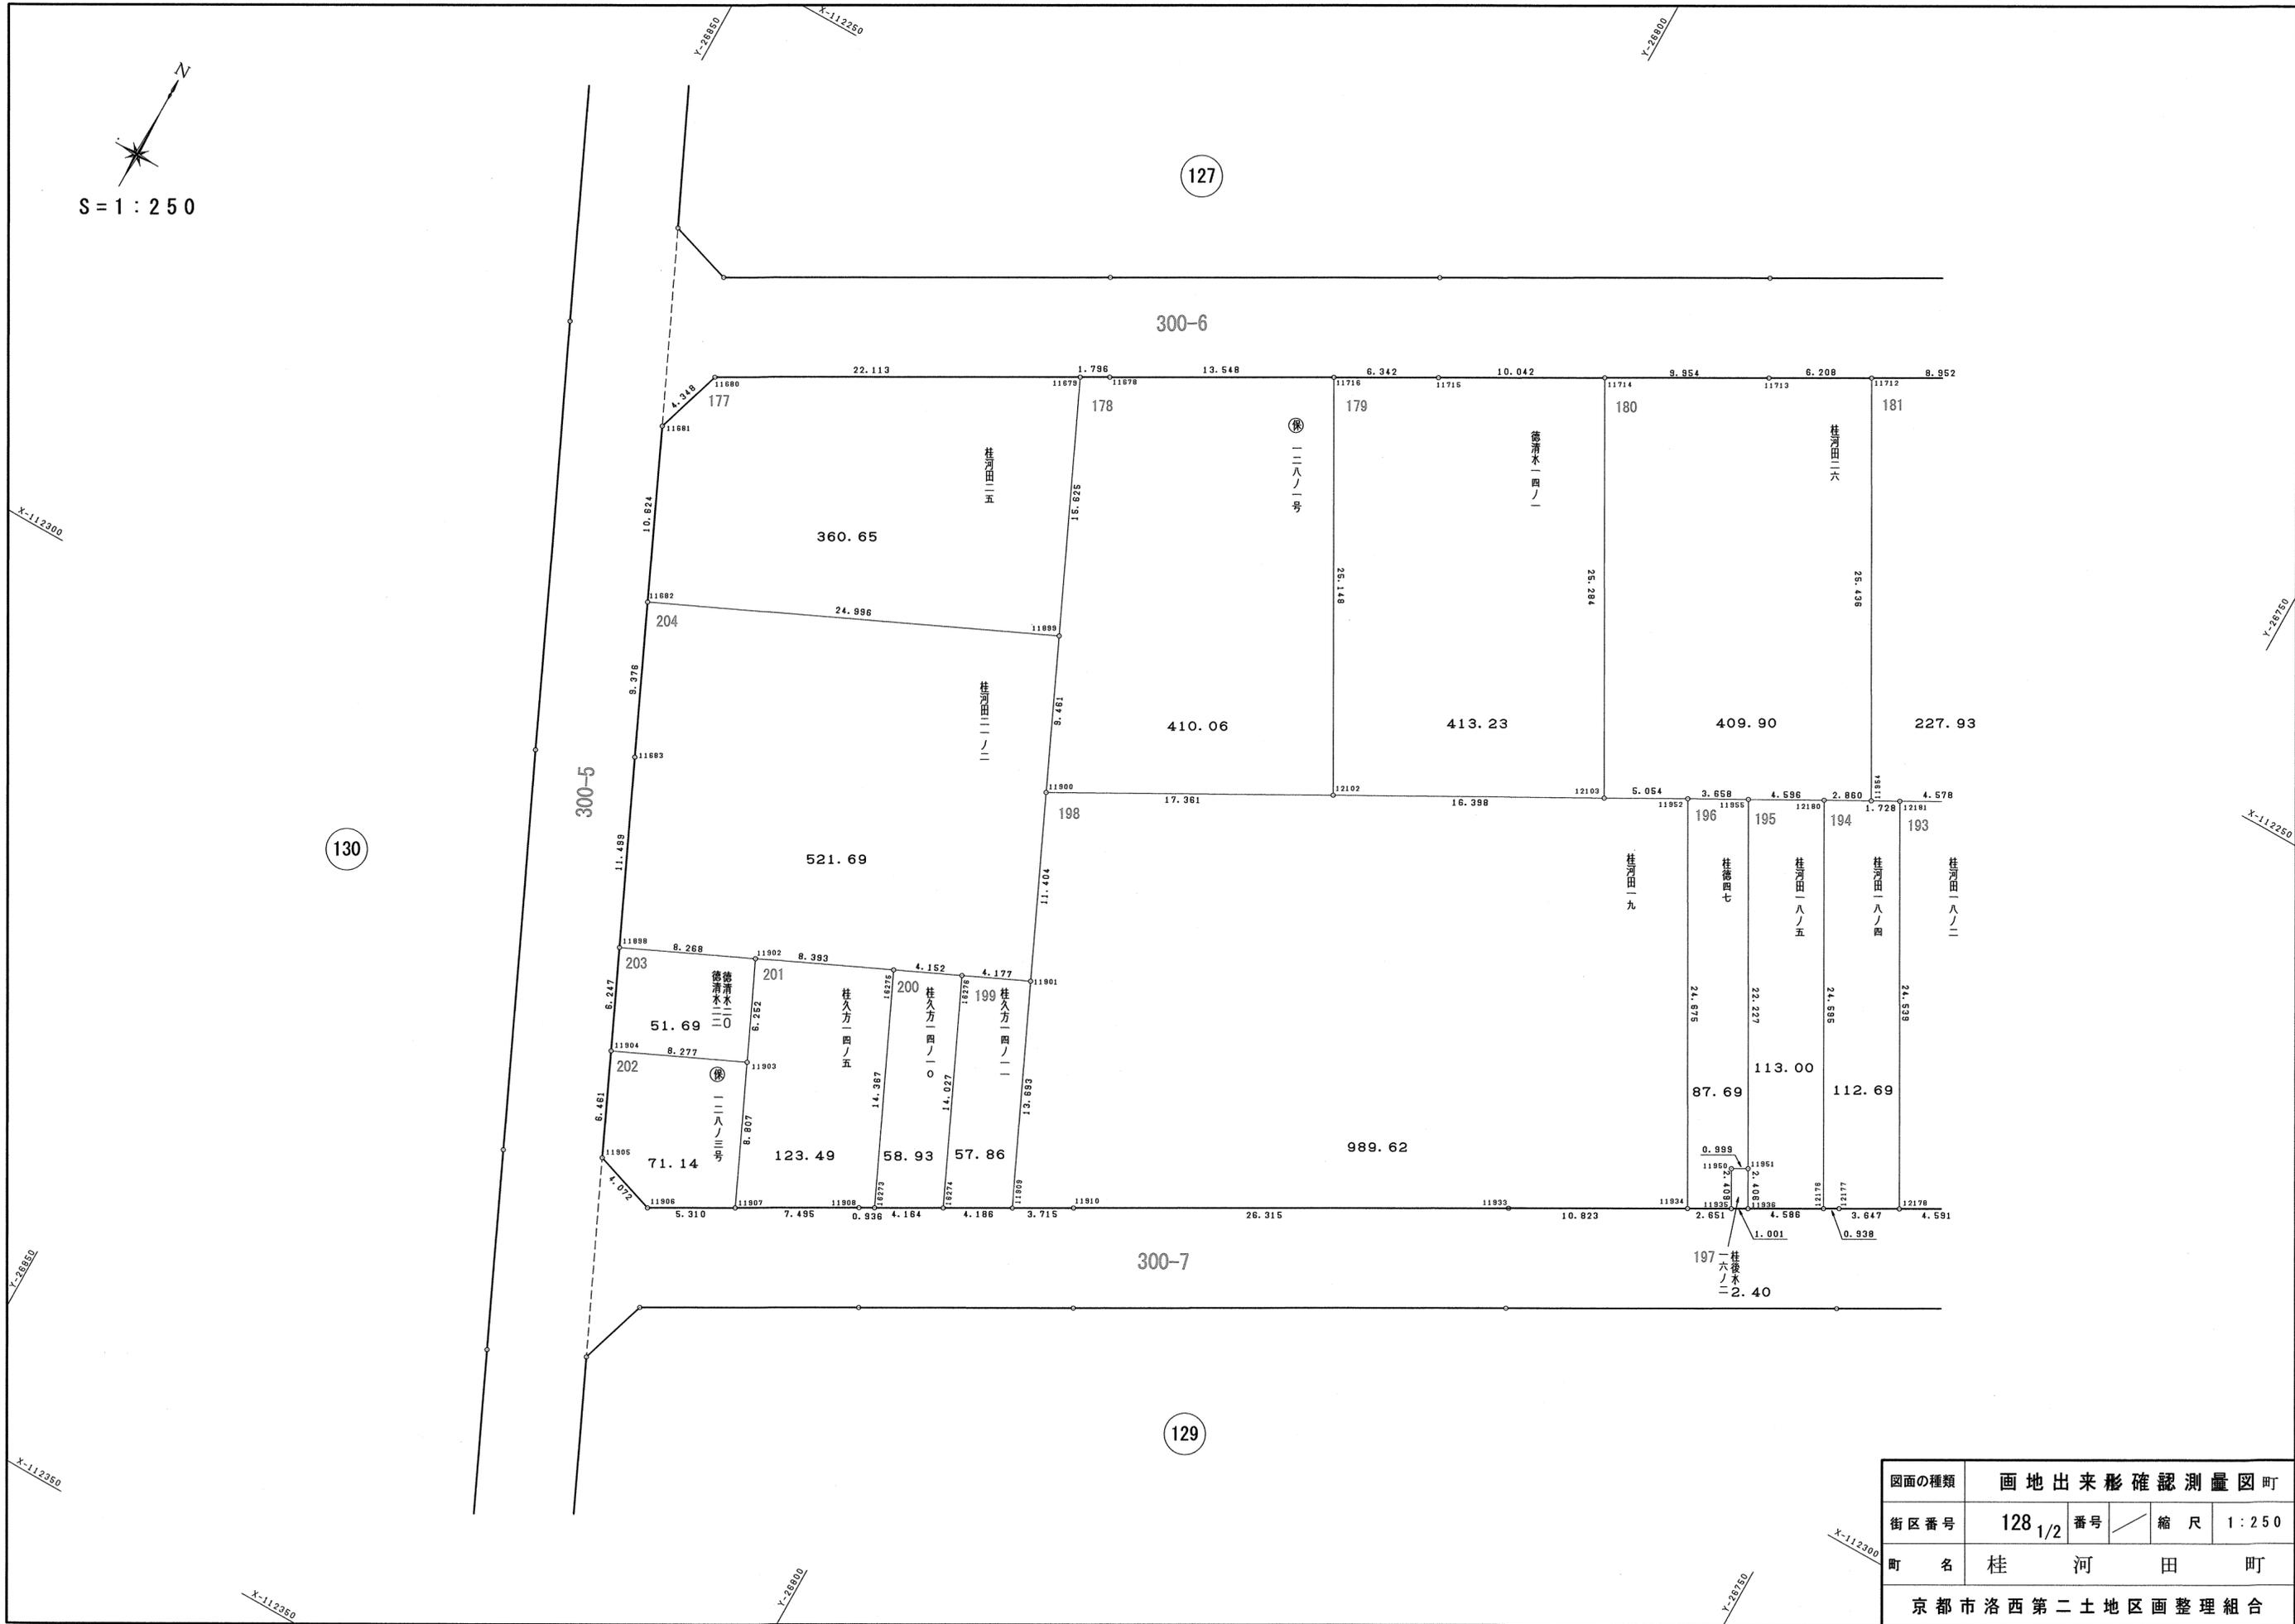


図面の種類	画地出来形確認測量図町			
街区番号	128	1/2	番号	縮尺 1 : 250
町名	桂河田町			
京都市洛西第二土地区画整理組合				

X-112250



S = 1 : 250

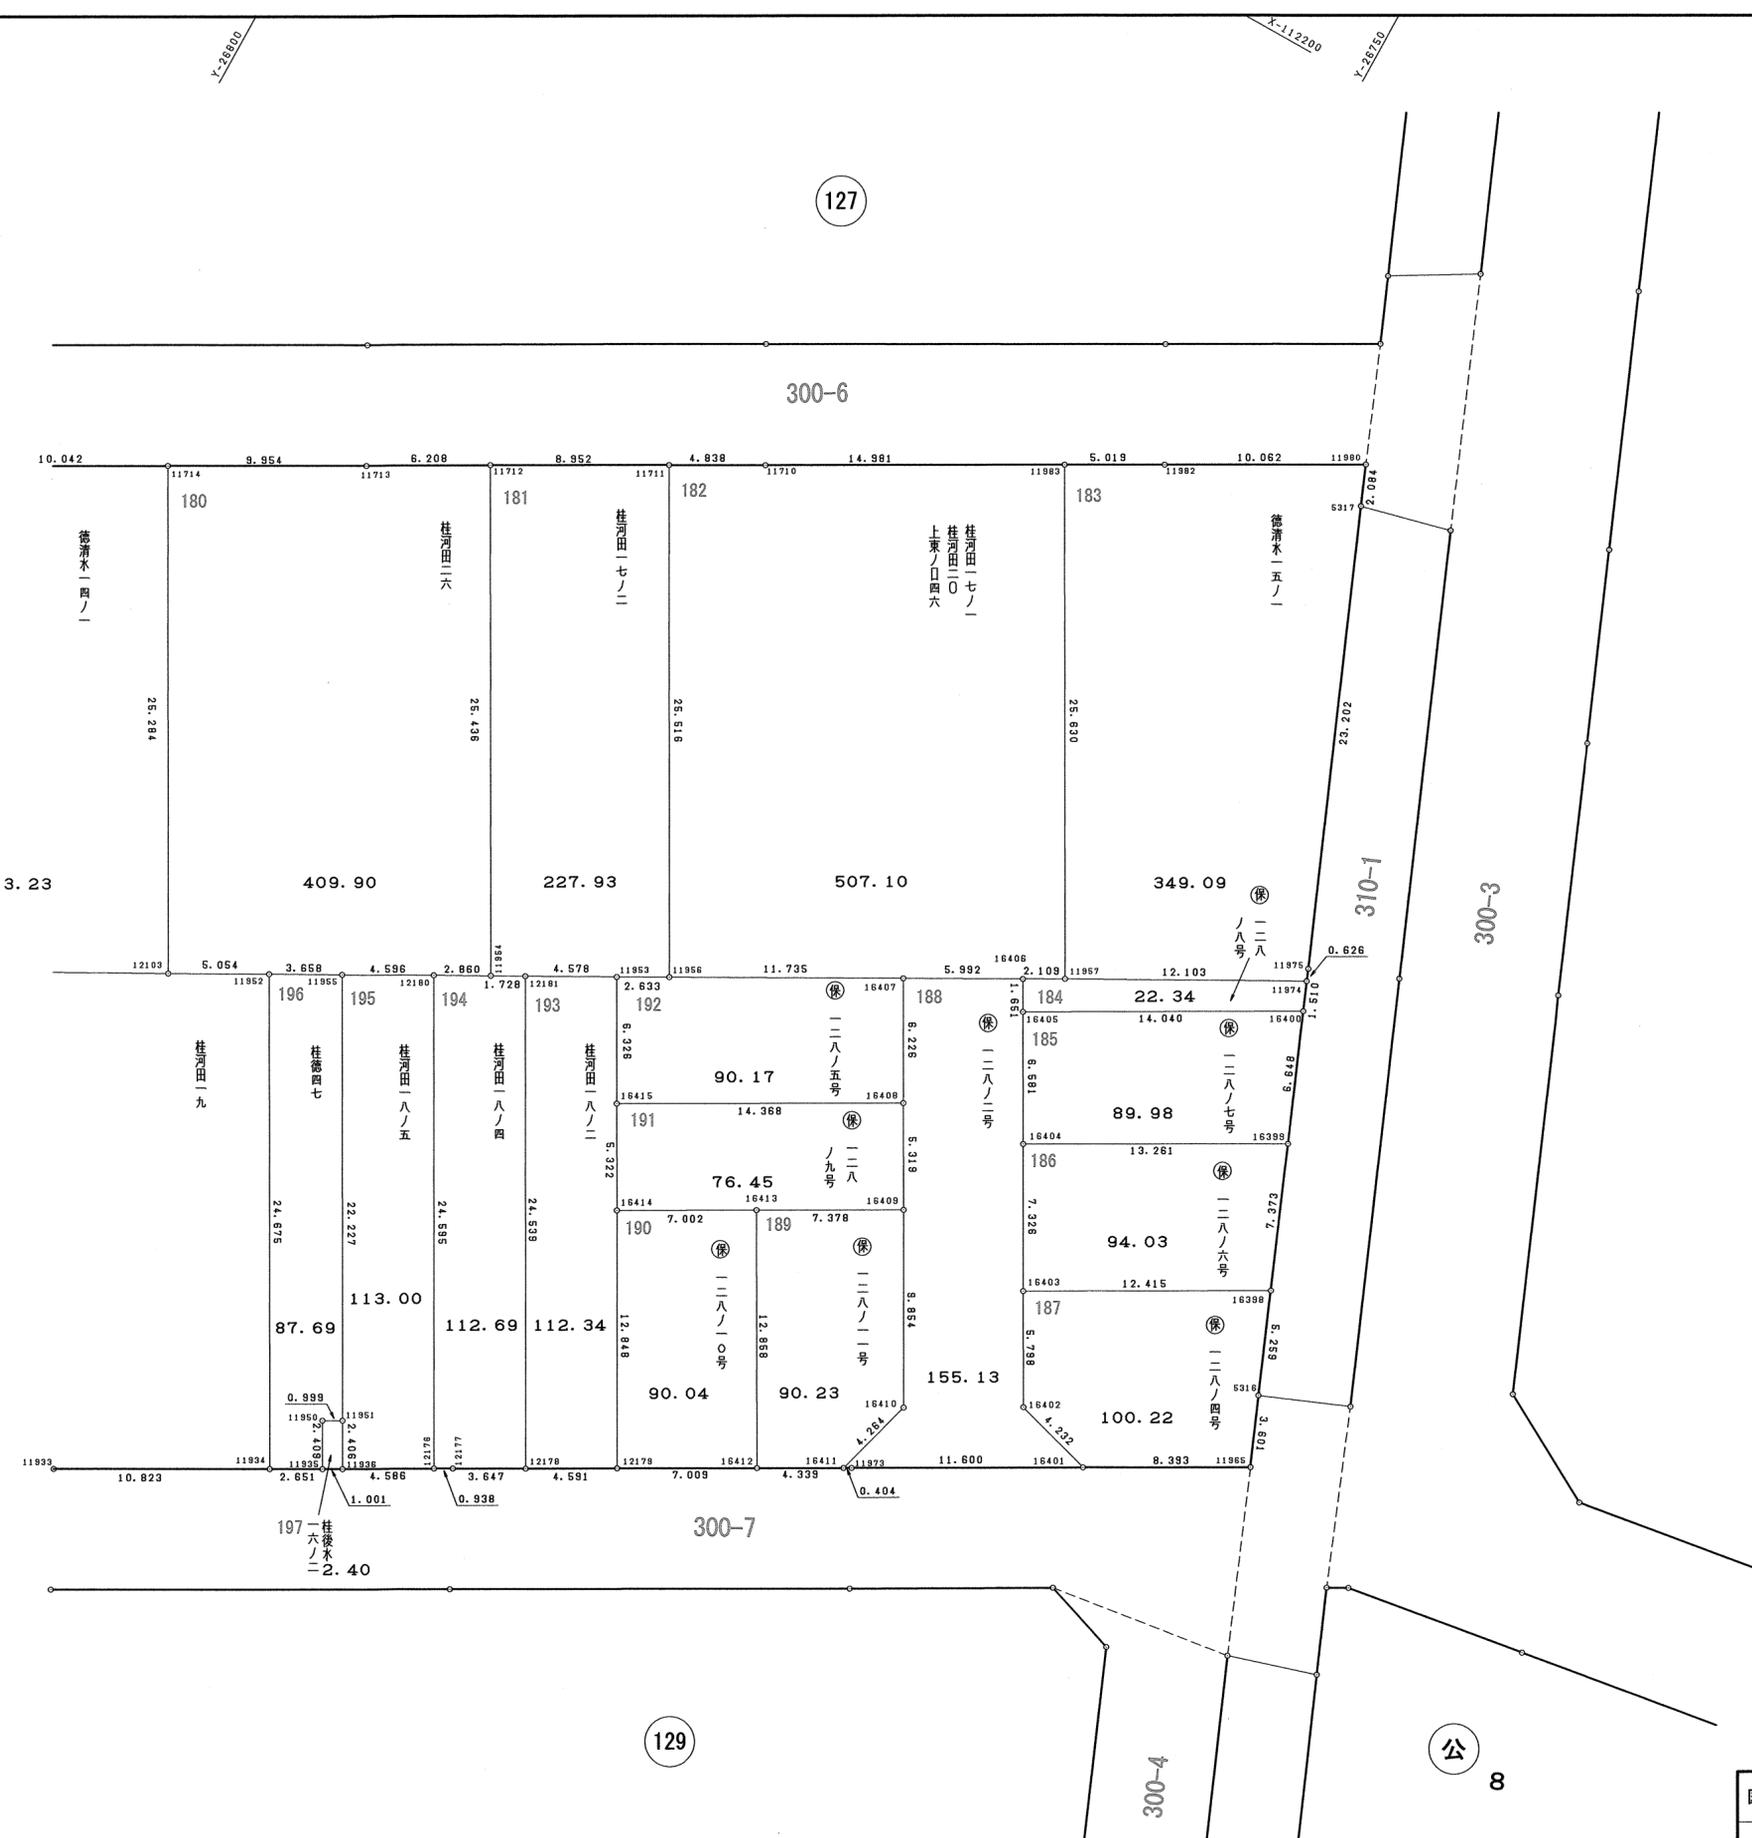

127

118

129

公 8

図面の種類	画地出来形確認測量図町			
街区番号	128 _{2/2}	番号	縮尺	1 : 250
町名	桂河田町			
京都市洛西第二土地区画整理組合				

177

Table with 4 columns: NO, X, Y, 辺長. Contains data for land parcels 11680-11710.

178

Table with 4 columns: NO, X, Y, 辺長. Contains data for land parcels 11679-11710.

179

Table with 4 columns: NO, X, Y, 辺長. Contains data for land parcels 11716-11716.

180

Table with 4 columns: NO, X, Y, 辺長. Contains data for land parcels 11712-11712.

181

Table with 4 columns: NO, X, Y, 辺長. Contains data for land parcels 11712-11712.

182

Table with 4 columns: NO, X, Y, 辺長. Contains data for land parcels 11711-11711.

183

Table with 4 columns: NO, X, Y, 辺長. Contains data for land parcels 11983-11983.

184

Table with 4 columns: NO, X, Y, 辺長. Contains data for land parcels 16406-16406.

185

Table with 4 columns: NO, X, Y, 辺長. Contains data for land parcels 16405-16405.

186

Table with 4 columns: NO, X, Y, 辺長. Contains data for land parcels 16404-16404.

187

Table with 4 columns: NO, X, Y, 辺長. Contains data for land parcels 16403-16403.

188

Table with 4 columns: NO, X, Y, 辺長. Contains data for land parcels 16407-16407.

189

Table with 4 columns: NO, X, Y, 辺長. Contains data for land parcels 16413-16413.

190

Table with 4 columns: NO, X, Y, 辺長. Contains data for land parcels 16414-16414.

191

Table with 4 columns: NO, X, Y, 辺長. Contains data for land parcels 16415-16415.

192

Table with 4 columns: NO, X, Y, 辺長. Contains data for land parcels 11953-11953.

193

Table with 4 columns: NO, X, Y, 辺長. Contains data for land parcels 12178-12178.

194

Table with 4 columns: NO, X, Y, 辺長. Contains data for land parcels 12176-12176.

Diagram types, drawing scale, and address information for the map.



桂久方町

図面の種類	画地出来形確認測量図		
街区番号	129	番号	縮尺 1:250
町名	桂河田町		
京都市洛西第二土地区画整理組合			

143

地番 桂久方一二A				
NO	X	Y	辺長	
11916	-112327.362	-26817.929		
11917	-112345.545	-26809.599	20.000	
11918	-112351.976	-26806.655	7.073	
11919	-112344.329	-26794.641	14.241	
11920	-112343.882	-26793.938	0.833	
11914	-112317.345	-26806.092	29.188	
11915	-112323.180	-26816.559	11.984	
11916	-112327.362	-26817.929	4.401	
面積	437.9335320			
地積	437.93 m ²			

144

地番 桂久方一一				
NO	X	Y	辺長	
11914	-112317.345	-26806.092		
11920	-112343.882	-26793.938	29.188	
11921	-112338.541	-26785.573	9.925	
11922	-112336.363	-26782.136	4.069	
11923	-112335.433	-26780.678	1.729	
11911	-112309.743	-26792.434	28.252	
11912	-112310.412	-26793.631	1.371	
11913	-112316.733	-26804.994	13.003	
11914	-112317.345	-26806.092	1.257	
面積	447.3320495			
地積	447.33 m ²			

145

地番 徳清水一四ノ四				
NO	X	Y	辺長	
11911	-112309.743	-26792.434		
11923	-112335.433	-26780.678	28.252	
16332	-112331.461	-26774.442	7.394	
11944	-112329.275	-26771.012	4.067	
11943	-112304.182	-26782.493	27.595	
11911	-112309.743	-26792.434	11.391	
面積	317.0081390			
地積	317.00 m ²			

146

地番 徳清水一八				
NO	X	Y	辺長	
11943	-112304.182	-26782.493		
11944	-112329.275	-26771.012	27.595	
11945	-112324.518	-26763.541	8.857	
11946	-112319.172	-26755.133	9.964	
11947	-112315.786	-26749.815	6.304	
11941	-112291.552	-26759.904	26.250	
11942	-112297.635	-26770.787	12.468	
11943	-112304.182	-26782.493	13.412	
面積	680.8172395			
地積	680.81 m ²			

147

地番 徳清水一七				
NO	X	Y	辺長	
11941	-112291.552	-26759.904		
11947	-112315.786	-26749.815	26.250	
15149	-112311.673	-26743.346	7.666	
15148	-112311.392	-26742.905	0.523	
11939	-112287.579	-26752.795	25.785	
11940	-112287.874	-26753.322	0.604	
11941	-112291.552	-26759.904	7.540	
面積	210.1840825			
地積	210.18 m ²			

148

地番 徳清水一六ノ三B				
NO	X	Y	辺長	
11939	-112287.579	-26752.795		
15148	-112311.392	-26742.905	25.785	
11948	-112302.739	-26729.299	16.124	
11938	-112279.784	-26738.842	24.860	
11939	-112287.579	-26752.795	15.983	
面積	402.1283240			
地積	402.12 m ²			

149

地番 徳清水一六ノ一B				
NO	X	Y	辺長	
11938	-112279.784	-26738.842		
11948	-112302.739	-26729.299	24.860	
11949	-112302.437	-26728.812	0.573	
11970	-112293.740	-26715.136	16.207	
11971	-112274.384	-26723.177	20.960	
11972	-112273.115	-26726.953	3.984	
11937	-112278.102	-26735.832	10.184	
11938	-112279.784	-26738.842	3.448	
面積	398.9602210			
地積	398.96 m ²			

150

地番 徳清水一六ノ一A				
NO	X	Y	辺長	
11949	-112302.437	-26728.812		
12027	-112324.653	-26719.559	24.066	
12028	-112322.856	-26716.882	3.224	
12029	-112317.506	-26708.464	9.974	
12030	-112313.082	-26707.069	4.639	
11969	-112294.623	-26714.769	20.001	
11970	-112293.740	-26715.136	0.956	
11949	-112302.437	-26728.812	16.207	
面積	378.7542830			
地積	378.75 m ²			

151

地番 徳清水一六ノ三A				
NO	X	Y	辺長	
12025	-112334.302	-26733.927		
12026	-112334.085	-26733.615	0.380	
12027	-112324.653	-26719.559	16.927	
11949	-112302.437	-26728.812	24.066	
11948	-112302.739	-26729.299	0.573	
15148	-112311.392	-26742.905	16.124	
15149	-112311.673	-26743.346	0.523	
12025	-112334.302	-26733.927	24.511	
面積	412.1870320			
地積	412.18 m ²			

152

地番 徳清水一三ノ三				
NO	X	Y	辺長	
11946	-112319.172	-26755.133		
12024	-112342.338	-26745.478	25.097	
12025	-112334.302	-26733.927	14.071	
15149	-112311.673	-26743.346	24.511	
11947	-112315.786	-26749.815	7.666	
11946	-112319.172	-26755.133	6.304	
面積	341.2851250			
地積	341.28 m ²			

153

地番 桂久方六ノ三				
NO	X	Y	辺長	
11945	-112324.518	-26763.541		
16343	-112331.142	-26760.791	7.172	
16342	-112337.056	-26758.326	6.407	
16341	-112342.970	-26755.863	6.406	
12022	-112348.138	-26753.704	5.601	
12023	-112346.140	-26750.944	3.407	
12024	-112342.338	-26745.478	6.658	
11946	-112319.172	-26755.133	25.097	
11945	-112324.518	-26763.541	9.964	
面積	248.7913690			
地積	248.79 m ²			

154

地番 徳清水一九ノ一一				
NO	X	Y	辺長	
16334	-112346.322	-26763.919		
16335	-112351.558	-26761.748	5.668	
16336	-112352.223	-26759.350	2.488	
12022	-112348.138	-26753.704	6.969	
16341	-112342.970	-26755.863	5.601	
16334	-112346.322	-26763.919	8.726	
面積	55.9820000			
地積	55.98 m ²			

155

地番 徳清水一九ノ一三				
NO	X	Y	辺長	
16333	-112340.405	-26766.381		
16334	-112346.322	-26763.919	6.409	
16341	-112342.970	-26755.863	8.726	
16342	-112337.056	-26758.326	6.406	
16333	-112340.405	-26766.381	8.723	
面積	55.9029165			
地積	55.90 m ²			

156

地番 徳清水一九ノ一四				
NO	X	Y	辺長	
16337	-112334.484	-26768.845		
16333	-112340.405	-26766.381	6.413	
16342	-112337.056	-26758.326	8.723	
16343	-112331.142	-26760.791	6.407	
16337	-112334.484	-26768.845	8.720	
面積	55.9074885			
地積	55.90 m ²			

157

地番 徳清水一九ノ一五				
NO	X	Y	辺長	
11944	-112329.275	-26771.012		
16337	-112334.484	-26768.845	5.642	
16343	-112331.142	-26760.791	8.720	
11945	-112324.518	-26763.541	7.172	
11944	-112329.275	-26771.012	8.857	
面積	55.8825270			
地積	55.88 m ²			

158

地番 徳清水一九ノ一				
NO	X	Y	辺長	
16332	-112331.461	-26774.442		
16331	-112338.031	-26771.706	7.117	
16330	-112344.037	-26769.207	6.505	
16329	-112350.190	-26766.648	6.664	
16328	-112353.948	-26765.074	4.074	
16327	-112356.994	-26765.942	3.167	
16336	-112352.223	-26759.350	8.137	
16335	-112351.558	-26761.748	2.488	
16334	-112346.322	-26763.919	5.668	
16333	-112340.405	-26766.381	6.409	
16337	-112334.484	-26768.845	6.413	
11944	-112329.275	-26771.012	5.642	
16332	-112331.461	-26774.442	4.067	
面積	109.0080180			
地積	109.00 m ²			

159

地番 徳清水一九ノ一二				
NO	X	Y	辺長	
16338	-112353.402	-26774.360		
12011	-112360.869	-26770.954	8.207	
12012	-112357.879	-26767.165	4.827	
16327	-112356.994	-26765.942	1.510	
16328	-112353.948	-26765.074	3.167	
16329	-112350.190	-26766.648	4.074	
16338	-112353.402	-26774.360	8.354	
面積	56.5579085			
地積	56.55 m ²			

160

地番 徳清水一九ノ一六				
NO	X	Y	辺長	
16339	-112347.335	-26777.131		
16338	-112353.402	-26774.360	6.670	
16329	-112350.190	-26766.648	8.354	
16330	-112344.037	-26769.207	6.664	
16339	-112347.335	-26777.131	8.583	
面積	56.4425550			
地積	56.44 m ²			

161

地番 徳清水一九ノ一七				
NO	X	Y	辺長	
16340	-112341.417	-26779.832		
12019	-112343.481	-26778.884	2.271	
16339	-112347.335	-26777.131	4.234	
16330	-112344.037	-26769.207	8.583	
16331	-112338.031	-26771.706	6.505	
16340	-112341.417	-26779.832	8.803	
面積	56.5165500			
地積	56.51 m ²			

162

地番 徳清水一九ノ一八				
NO	X	Y	辺長	
11922	-112336.363	-26782.136		
16340	-112341.417	-26779.832	5.554	
16331	-112338.031	-26771.706	8.803	
16332	-112331.461	-26774.442	7.117	
11923	-112335.433	-26780.678	7.394	
11922	-112336.363	-26782.136	1.729	
面積	56.4199520			
地積	56.41 m ²			

163

地番 徳清水一九ノ三				
NO	X	Y	辺長	
12010	-112365.296	-26776.562		
12011	-112360.869	-26770.954	7.145	
16338				

171

地番 桂久方一〇ノ八			
NO	X	Y	辺長
11986	-112377.486	-26791.762	
11987	-112374.061	-26787.585	5.402
11988	-112370.849	-26783.598	5.120
12008	-112370.223	-26782.805	1.010
12014	-112362.145	-26786.475	8.873
11984	-112369.819	-26798.493	14.259
11985	-112376.718	-26795.342	7.585
11986	-112377.486	-26791.762	3.661
面積	132.3462900		
地積	132.34 m ²		

172

地番 桂久方一〇ノ一二			
NO	X	Y	辺長
11984	-112369.819	-26798.493	
12014	-112362.145	-26786.475	14.259
15137	-112360.136	-26787.396	2.210
15138	-112359.509	-26787.684	0.690
12007	-112365.295	-26800.559	14.115
11984	-112369.819	-26798.493	4.973
面積	55.5794075		
地積	55.57 m ²		

173

地番 桂久方一〇ノ一一			
NO	X	Y	辺長
12007	-112365.295	-26800.559	
15138	-112359.509	-26787.684	14.115
15139	-112356.055	-26789.267	3.799
12005	-112361.843	-26802.137	14.112
12006	-112363.729	-26801.274	2.074
12007	-112365.295	-26800.559	1.722
面積	53.5936120		
地積	53.59 m ²		

174

地番 桂久方一〇ノ一〇			
NO	X	Y	辺長
12005	-112361.843	-26802.137	
15139	-112356.055	-26789.267	14.112
15140	-112355.737	-26789.413	0.350
15141	-112352.610	-26790.846	3.440
12004	-112358.388	-26803.719	14.110
12005	-112361.843	-26802.137	3.800
面積	53.5462825		
地積	53.54 m ²		


175

地番 桂久方一〇ノ九			
NO	X	Y	辺長
12003	-112354.932	-26805.301	
12004	-112358.388	-26803.719	3.801
15141	-112352.610	-26790.846	14.110
15143	-112351.419	-26791.392	1.310
15142	-112349.155	-26792.430	2.491
12003	-112354.932	-26805.301	14.108
面積	53.6250355		
地積	53.62 m ²		

176

地番 桂久方一〇ノ一			
NO	X	Y	辺長
11918	-112351.976	-26806.655	
12003	-112354.932	-26805.301	3.251
15142	-112349.155	-26792.430	14.108
15136	-112347.955	-26792.980	1.320
11919	-112344.329	-26794.641	3.988
11918	-112351.976	-26806.655	14.241
面積	60.3773575		
地積	60.37 m ²		


図面の種類	画地面積求積表		
街区番号	129	番号	2/2 縮尺
町名	桂河田町		
京都市洛西第二土地区画整理組合			

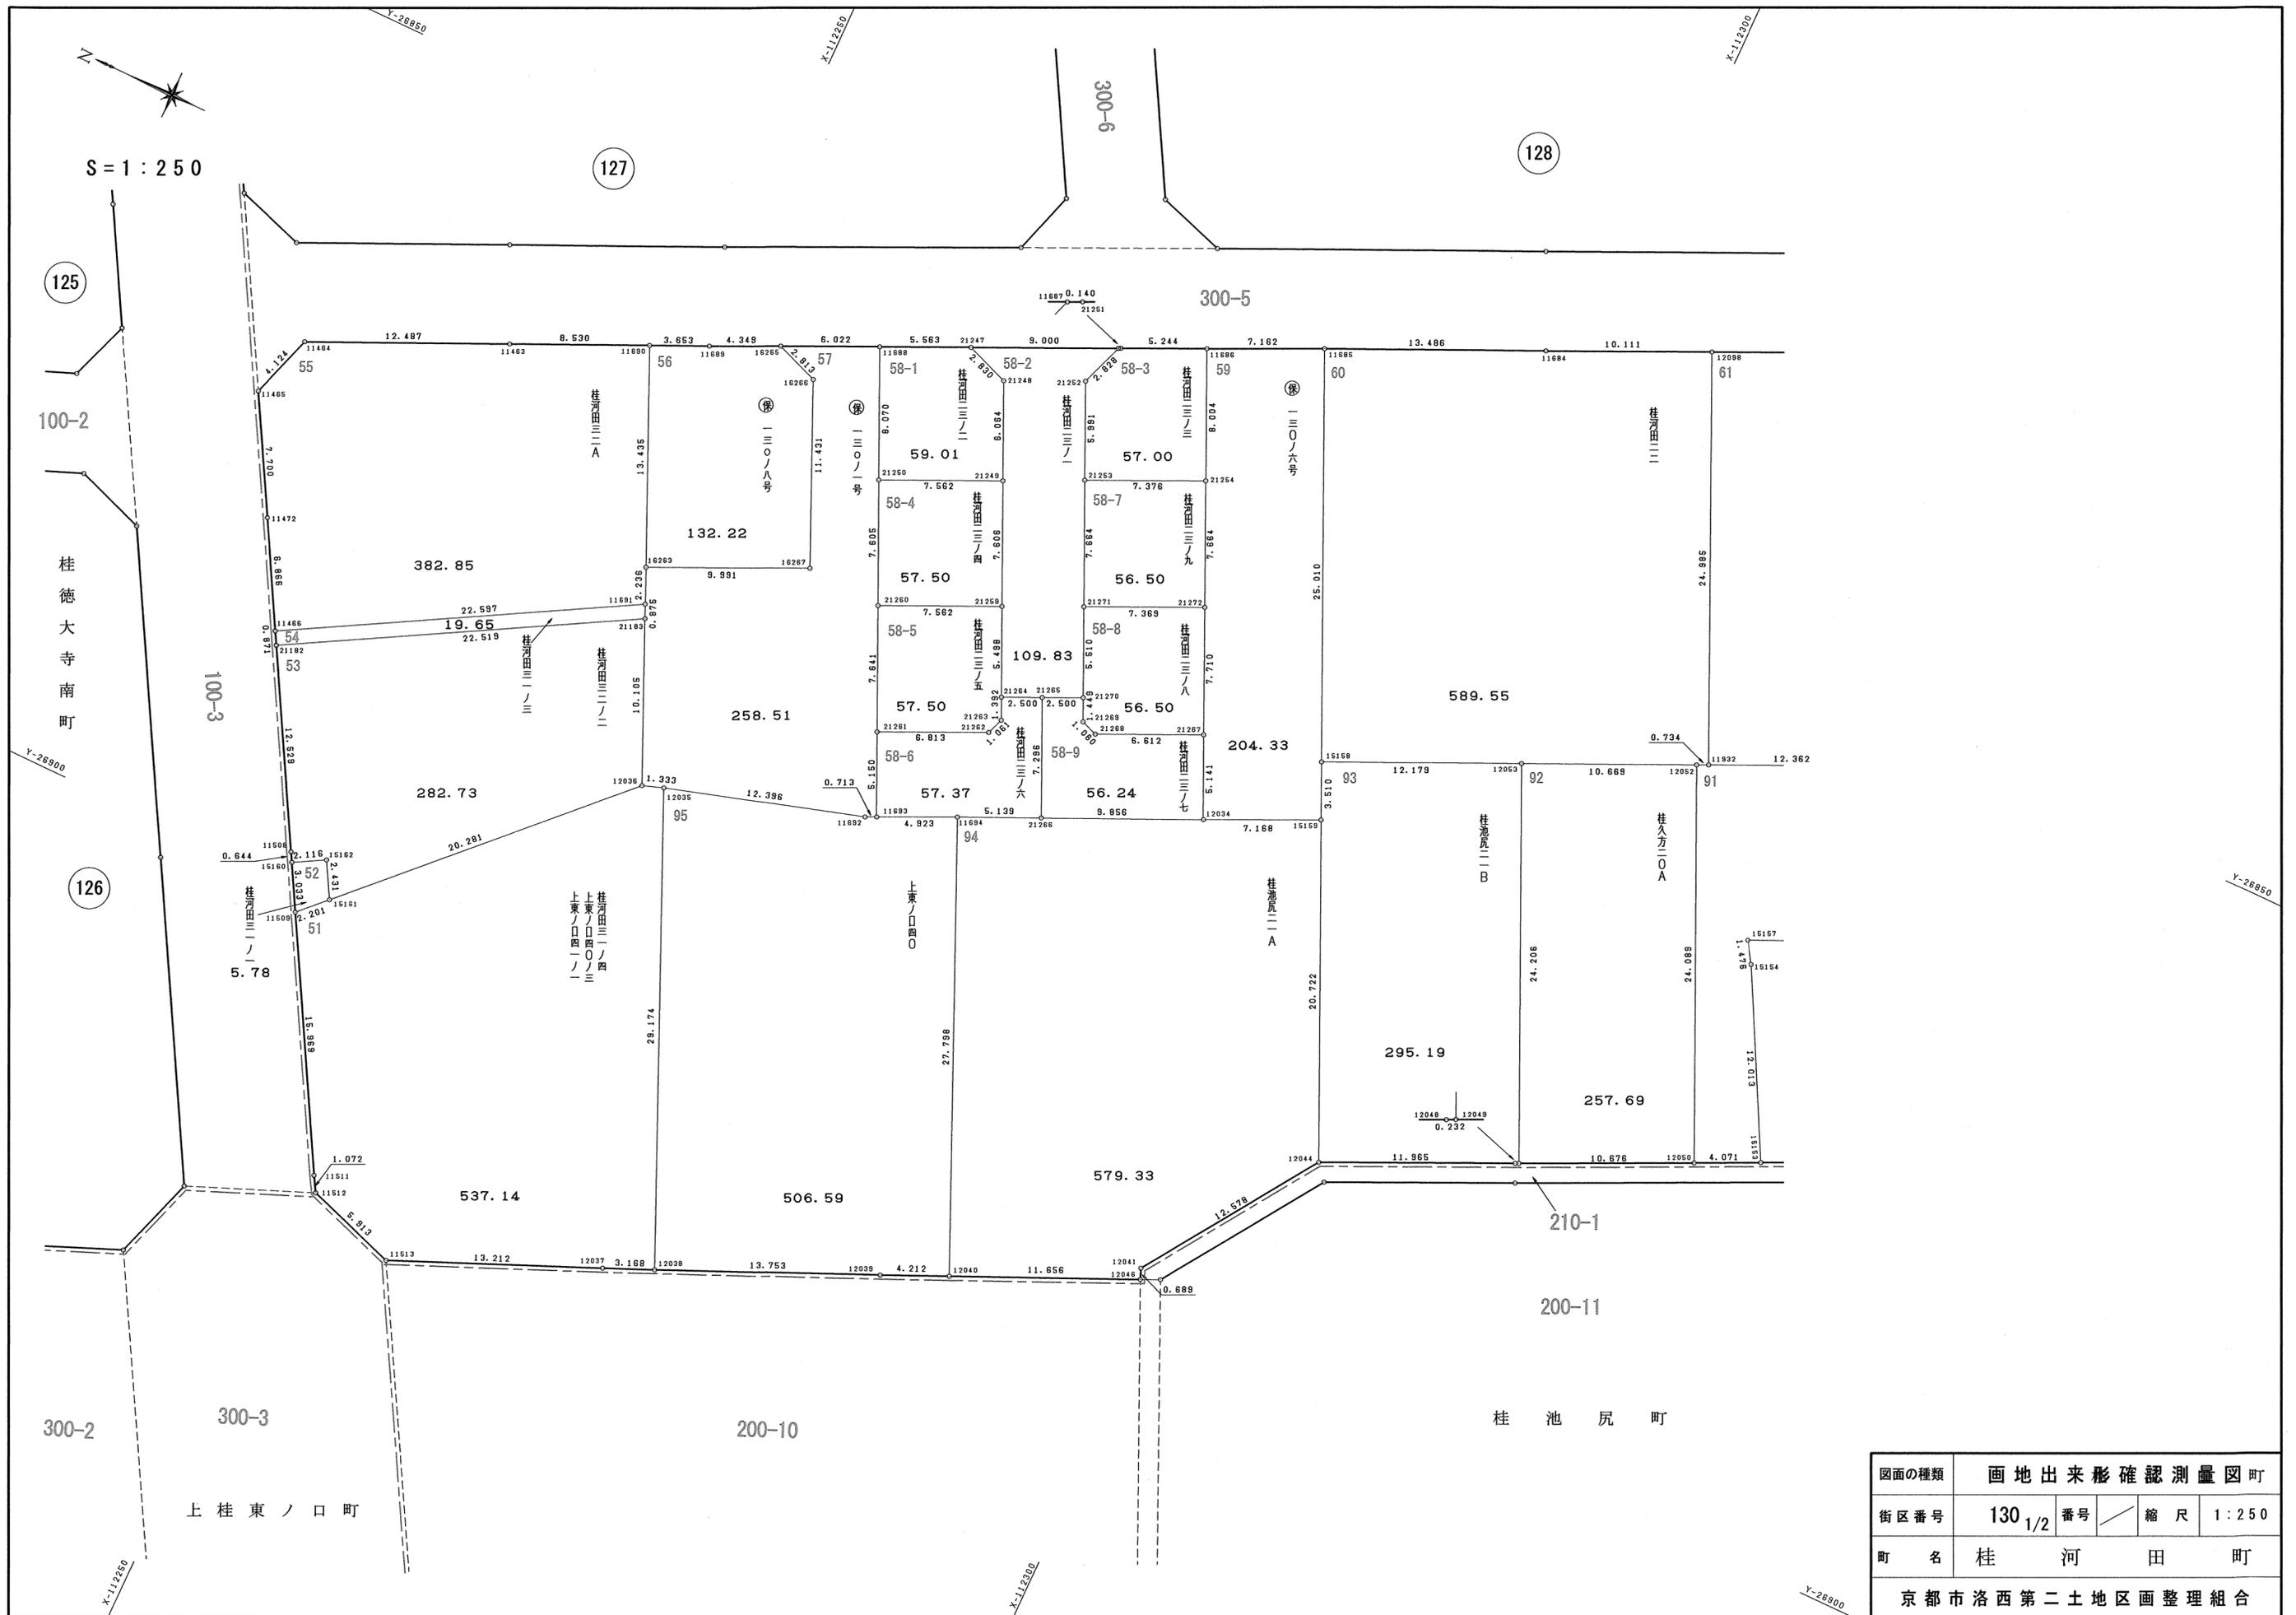

図面の種類	画地出来形確認測量図町			
街区番号	130	1/2	番号	縮尺 1:250
町名	桂河田町			
京都市洛西第二土地区画整理組合				



S = 1 : 250

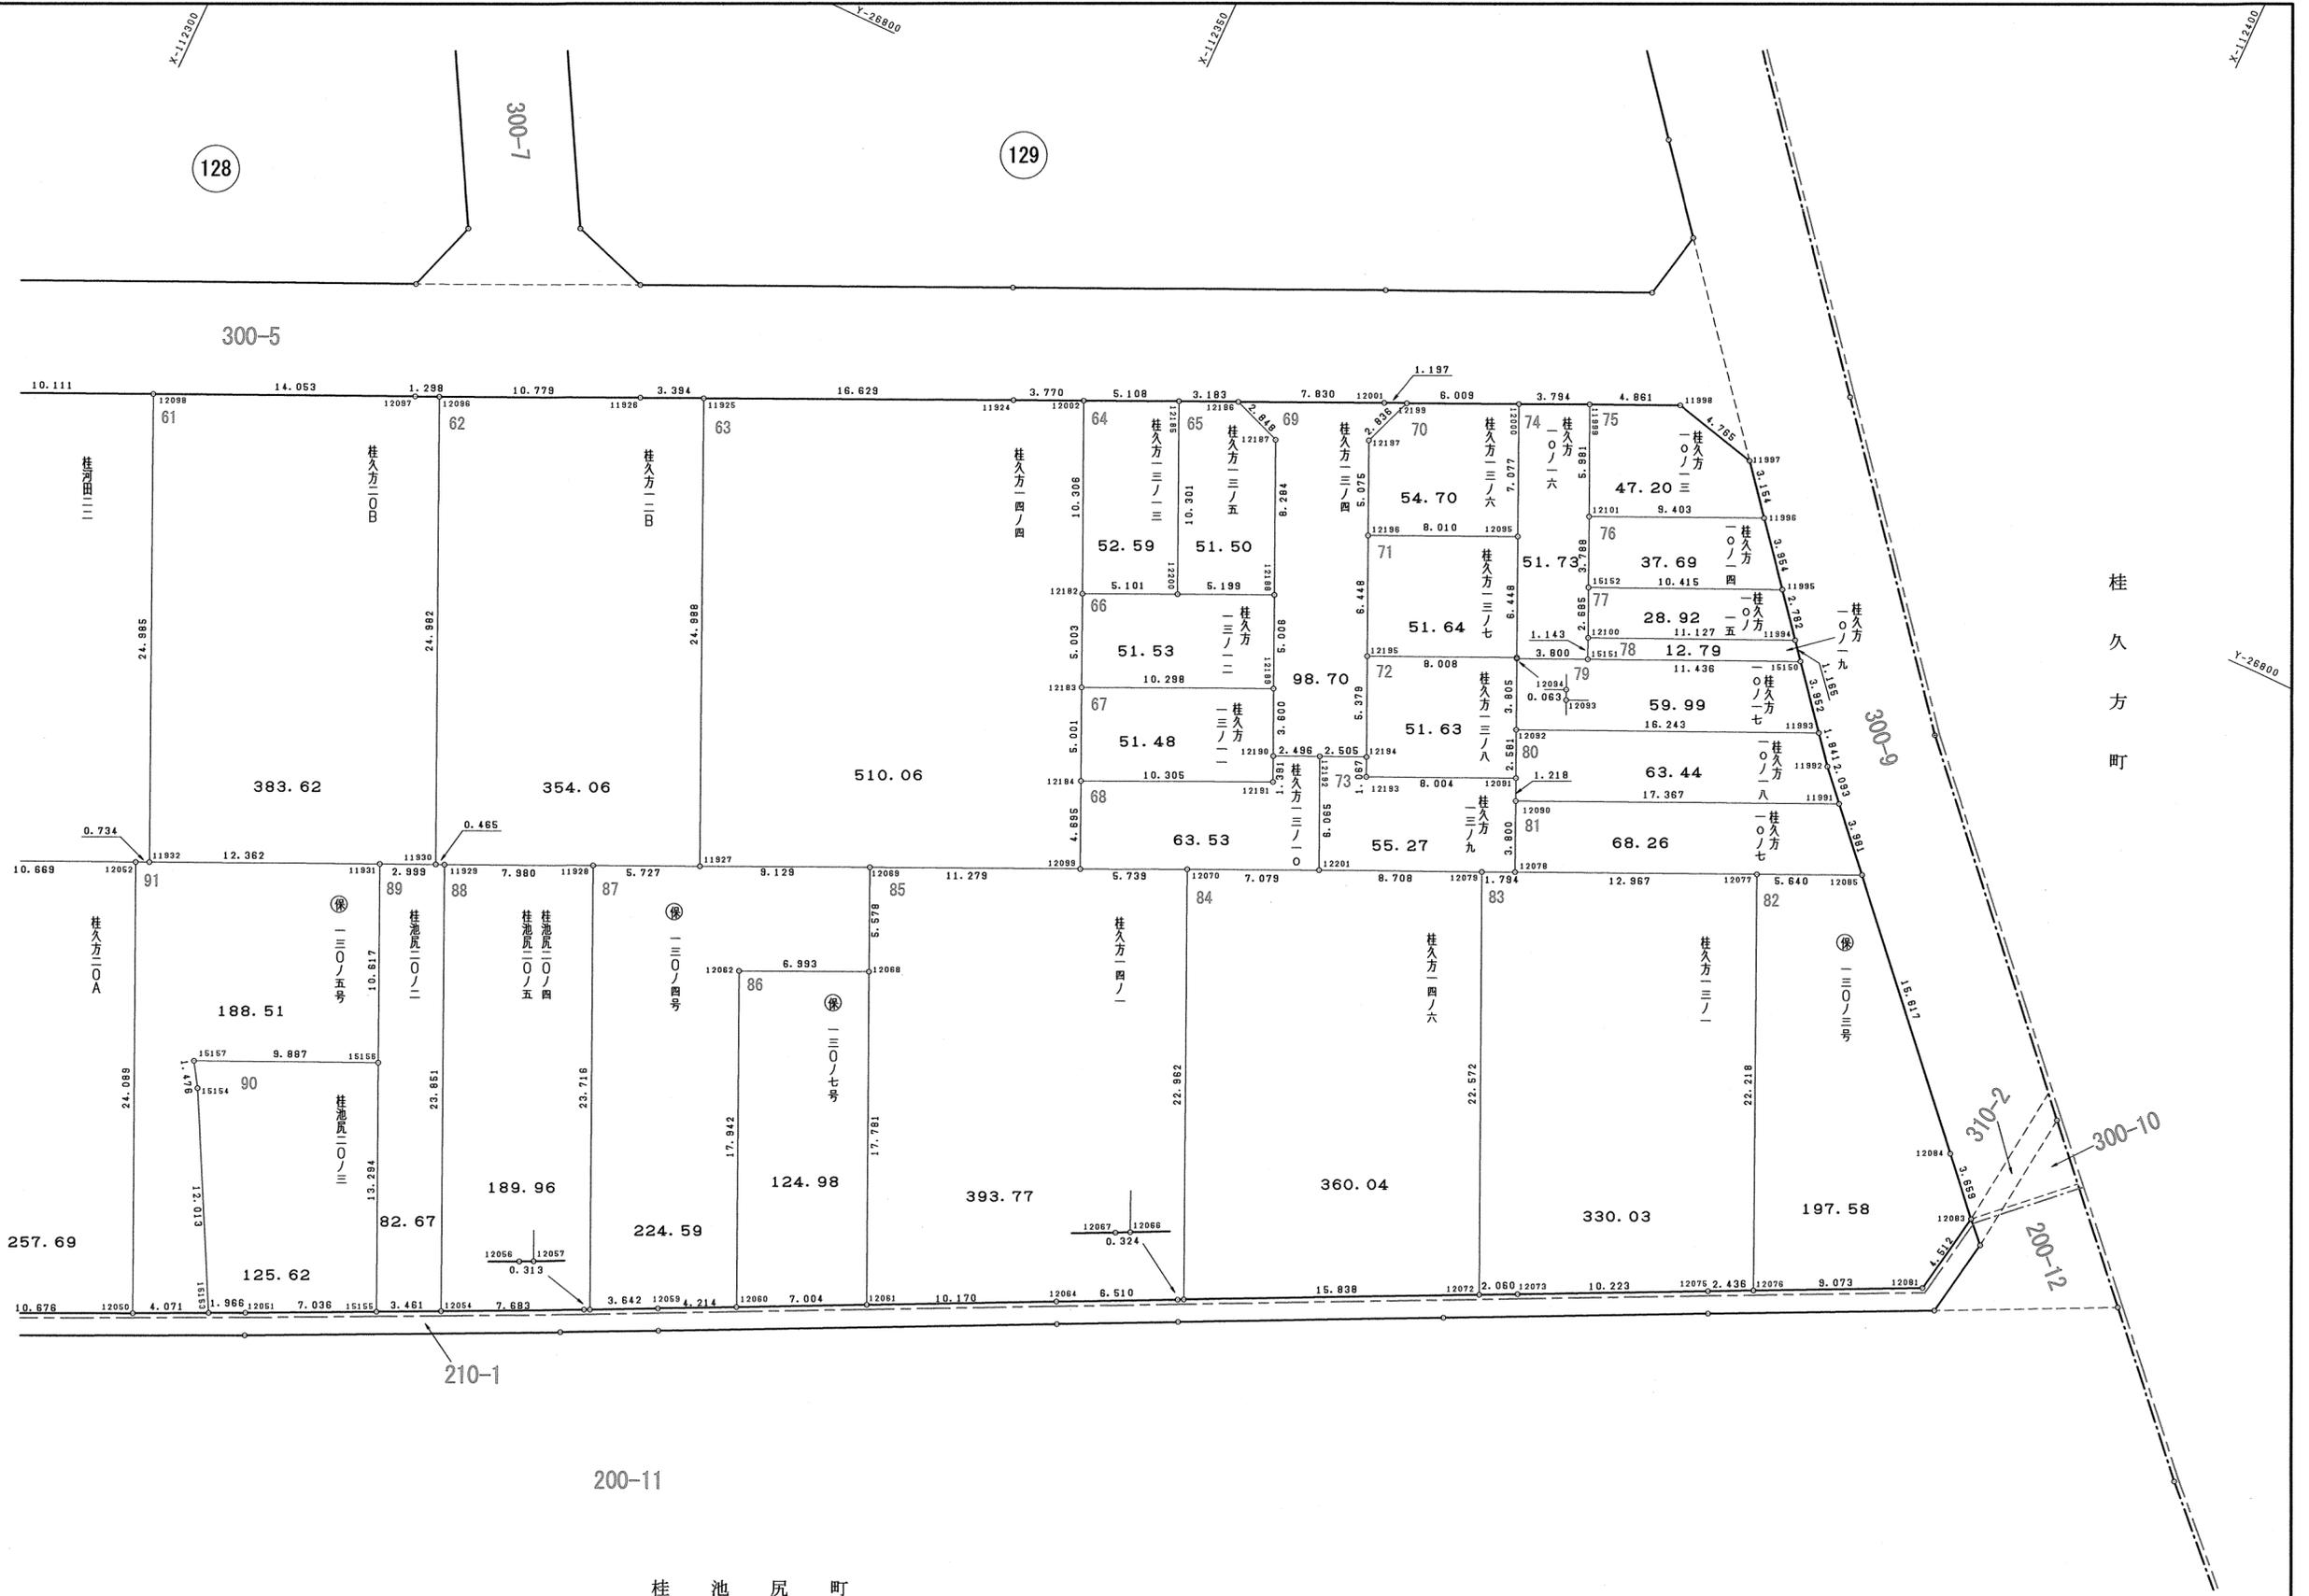

桂池尻町

図面の種類	画地出来形確認測量図町			
街区番号	130	2/2	番号	縮尺 1 : 250
町名	桂河田町			
京都市洛西第二土地区画整理組合				

51

Table with 4 columns: NO, X, Y, 辺長. Title: 桂河田三一ノ四 上東ノ口四〇ノ三、四一ノ一

52

Table with 4 columns: NO, X, Y, 辺長. Title: 桂河田三一ノ一

53

Table with 4 columns: NO, X, Y, 辺長. Title: 桂河田三二ノ二

54

Table with 4 columns: NO, X, Y, 辺長. Title: 桂河田三一ノ三

55

Table with 4 columns: NO, X, Y, 辺長. Title: 桂河田三二A

56

Table with 4 columns: NO, X, Y, 辺長. Title: 保 一三〇ノ八号

57

Table with 4 columns: NO, X, Y, 辺長. Title: 保 一三〇ノ一号

58-1

Table with 4 columns: NO, X, Y, 辺長. Title: 桂河田二三ノ二

58-2

Table with 4 columns: NO, X, Y, 辺長. Title: 桂河田二三ノ一

58-3

Table with 4 columns: NO, X, Y, 辺長. Title: 桂河田二三ノ三

58-4

Table with 4 columns: NO, X, Y, 辺長. Title: 桂河田二三ノ四

58-5

Table with 4 columns: NO, X, Y, 辺長. Title: 桂河田二三ノ五

58-6

Table with 4 columns: NO, X, Y, 辺長. Title: 桂河田二三ノ六

58-7

Table with 4 columns: NO, X, Y, 辺長. Title: 桂河田二三ノ九

58-8

Table with 4 columns: NO, X, Y, 辺長. Title: 桂河田二三ノ八

58-9

Table with 4 columns: NO, X, Y, 辺長. Title: 桂河田二三ノ七

59

Table with 4 columns: NO, X, Y, 辺長. Title: 保 一三〇ノ六号

60

Table with 4 columns: NO, X, Y, 辺長. Title: 桂河田二二

61

Table with 4 columns: NO, X, Y, 辺長. Title: 桂久方二〇B

62

Table with 4 columns: NO, X, Y, 辺長. Title: 桂久方一二B

63

Table with 4 columns: NO, X, Y, 辺長. Title: 桂久方一四ノ四

64

Table with 4 columns: NO, X, Y, 辺長. Title: 桂久方一三ノ一三

65

Table with 4 columns: NO, X, Y, 辺長. Title: 桂久方一三ノ五

66

Table with 4 columns: NO, X, Y, 辺長. Title: 桂久方一三ノ一

67

Table with 4 columns: NO, X, Y, 辺長. Title: 桂久方一三ノ一

68

Table with 4 columns: NO, X, Y, 辺長. Title: 桂久方一三ノ一〇

69

Table with 4 columns: NO, X, Y, 辺長. Title: 桂久方一三ノ四

Diagram type: 画地面積求積表. Address: 130. Name: 桂河田町. Organization: 京都市洛西第二土地区画整理組合

70

地番 桂久方一三ノ六				
N O	X	Y	辺長	
12000	-112372.762	-26803.759		
12199	-112367.300	-26806.263	6.009	
12197	-112366.314	-26808.922	2.836	
12196	-112368.430	-26813.535	5.075	
12095	-112375.709	-26810.193	8.010	
12000	-112372.762	-26803.759	7.077	
面積				54.7030030
地積				54.70 m ²

71

地番 桂久方一三ノ七				
N O	X	Y	辺長	
12095	-112375.709	-26810.193		
12196	-112368.430	-26813.535	8.010	
12195	-112371.115	-26819.397	6.448	
12094	-112378.393	-26816.056	8.008	
12095	-112375.709	-26810.193	6.448	
面積				51.6404630
地積				51.64 m ²

72

地番 桂久方一三ノ八				
N O	X	Y	辺長	
12094	-112378.393	-26816.056		
12195	-112371.115	-26819.397	8.008	
12194	-112373.357	-26824.287	5.379	
12193	-112373.804	-26825.256	1.067	
12091	-112381.079	-26821.918	8.004	
12092	-112380.006	-26819.571	2.581	
12093	-112378.419	-26816.113	3.805	
12094	-112378.393	-26816.056	0.063	
面積				51.6322830
地積				51.63 m ²

73

地番 桂久方一三ノ九				
N O	X	Y	辺長	
12091	-112381.079	-26821.918		
12193	-112373.804	-26825.256	8.004	
12194	-112373.357	-26824.287	1.067	
12192	-112371.078	-26825.326	2.505	
12201	-112373.611	-26830.837	6.065	
12079	-112381.535	-26827.226	8.708	
12078	-112383.167	-26826.480	1.794	
12090	-112381.586	-26823.025	3.800	
12091	-112381.079	-26821.918	1.218	
面積				55.2710895
地積				55.27 m ²

74

地番 桂久方一〇ノ一六				
N O	X	Y	辺長	
12093	-112378.419	-26816.113		
15151	-112381.877	-26814.538	3.800	
12100	-112381.411	-26813.494	1.143	
15152	-112380.293	-26811.053	2.685	
12101	-112378.716	-26807.609	3.788	
11999	-112376.211	-26802.178	5.981	
12000	-112372.762	-26803.759	3.794	
12095	-112375.709	-26810.193	7.077	
12094	-112378.393	-26816.056	6.448	
12093	-112378.419	-26816.113	0.063	
面積				51.7334160
地積				51.73 m ²

75

地番 桂久方一〇ノ一三				
N O	X	Y	辺長	
12101	-112378.716	-26807.609		
11996	-112387.267	-26803.697	9.403	
11997	-112385.264	-26801.261	3.154	
11998	-112380.630	-26800.153	4.765	
11999	-112376.211	-26802.178	4.861	
12101	-112378.716	-26807.609	5.981	
面積				47.2050010
地積				47.20 m ²

76

地番 桂久方一〇ノ一四				
N O	X	Y	辺長	
12101	-112378.716	-26807.609		
15152	-112380.293	-26811.053	3.788	
11995	-112389.778	-26806.751	10.415	
11996	-112387.267	-26803.697	3.954	
12101	-112378.716	-26807.609	9.403	
面積				37.6941900
地積				37.69 m ²

77

地番 桂久方一〇ノ一五				
N O	X	Y	辺長	
12100	-112381.411	-26813.494		
11994	-112391.545	-26808.900	11.127	
11995	-112389.778	-26806.751	2.782	
15152	-112380.293	-26811.053	10.415	
12100	-112381.411	-26813.494	2.685	
面積				28.9290425
地積				28.92 m ²

78

地番 桂久方一〇ノ一九				
N O	X	Y	辺長	
15151	-112381.877	-26814.538		
15150	-112392.285	-26809.800	11.436	
11994	-112391.545	-26808.900	1.165	
12100	-112381.411	-26813.494	11.127	
15151	-112381.877	-26814.538	1.143	
面積				12.7970100
地積				12.79 m ²

79

地番 桂久方一〇ノ一七				
N O	X	Y	辺長	
12092	-112380.006	-26819.571		
11993	-112394.795	-26812.853	16.243	
15150	-112392.285	-26809.800	3.952	
15151	-112381.877	-26814.538	11.436	
12093	-112378.419	-26816.113	3.800	
12092	-112380.006	-26819.571	3.805	
面積				59.9944760
地積				59.99 m ²

80

地番 桂久方一〇ノ一八				
N O	X	Y	辺長	
12090	-112381.586	-26823.025		
11991	-112397.384	-26815.812	17.367	
11992	-112395.964	-26814.275	2.093	
11993	-112394.795	-26812.853	1.841	
12092	-112380.006	-26819.571	16.243	
12091	-112381.079	-26821.918	2.581	
12090	-112381.586	-26823.025	1.218	
面積				63.4480080
地積				63.44 m ²

81

地番 桂久方一〇ノ七				
N O	X	Y	辺長	
12078	-112383.167	-26826.480		
12077	-112394.961	-26821.090	12.967	
12085	-112400.086	-26818.736	5.640	
11991	-112397.384	-26815.812	3.981	
12090	-112381.586	-26823.025	17.367	
12078	-112383.167	-26826.480	3.800	
面積				68.2603065
地積				68.26 m ²

82

地番 保一三〇ノ三				
N O	X	Y	辺長	
12076	-112404.207	-26841.293		
12081	-112412.371	-26837.334	9.073	
12083	-112413.169	-26832.893	4.512	
12084	-112410.685	-26830.206	3.659	
12085	-112400.086	-26818.736	15.617	
12077	-112394.961	-26821.090	5.640	
12076	-112404.207	-26841.293	22.218	
面積				197.5813840
地積				197.58 m ²

83

地番 桂久方一三ノ一				
N O	X	Y	辺長	
12072	-112390.971	-26847.731		
12073	-112392.822	-26846.828	2.060	
12075	-112402.015	-26842.356	10.223	
12076	-112404.207	-26841.293	2.436	
12077	-112394.961	-26821.090	22.218	
12078	-112383.167	-26826.480	12.967	
12079	-112381.535	-26827.226	1.794	
12072	-112390.971	-26847.731	22.572	
面積				330.0340455
地積				330.03 m ²

84

地番 桂久方一四ノ六				
N O	X	Y	辺長	
12066	-112376.735	-26854.671		
12072	-112390.971	-26847.731	15.838	
12079	-112381.535	-26827.226	22.572	
12201	-112373.611	-26830.837	8.708	
12070	-112367.178	-26833.792	7.079	
12066	-112376.735	-26854.671	22.962	
面積				360.0459710
地積				360.04 m ²

85

地番 桂久方一四ノ一				
N O	X	Y	辺長	
12061	-112361.446	-26862.112		
12064	-112370.588	-26857.657	10.170	
12067	-112376.444	-26854.813	6.510	
12068	-112376.735	-26854.671	0.324	
12070	-112367.178	-26833.792	22.962	
12099	-112361.967	-26836.196	5.739	
12069	-112351.707	-26840.880	11.279	
12068	-112354.031	-26845.951	5.578	
12061	-112361.446	-26862.112	17.781	
面積				393.7733160
地積				393.77 m ²

86

地番 保一三〇ノ七				
N O	X	Y	辺長	
12060	-112355.150	-26865.180		
12061	-112361.446	-26862.112	7.004	
12068	-112354.031	-26845.951	17.781	
12062	-112347.676	-26848.869	6.993	
12060	-112355.150	-26865.180	17.942	
面積				124.9822065
地積				124.98 m ²

87

地番 保一三〇ノ四				
N O	X	Y	辺長	
12057	-112348.089	-26868.624		
12059	-112351.362	-26867.026	3.642	
12060	-112355.150	-26865.180	4.214	
12062	-112347.676	-26848.869	17.942	
12068	-112354.031	-26845.951	6.993	
12069	-112351.707	-26840.880	5.578	
11927	-112343.411	-26844.689	9.129	
11928	-112338.201	-26847.068	5.727	
12057	-112348.089	-26868.624	23.716	
面積				224.5952550
地積				224.59 m ²

88

地番 桂池尻二〇ノ四, 桂池尻二〇ノ五				
N O	X	Y	辺長	
11929	-112330.946	-26850.391		
12054	-112340.877	-26872.076	23.851	
12056	-112347.808	-26868.761	7.683	
12057	-112348.089	-26868.624	0.313	
11928	-112338.201	-26847.068	23.716	
11929	-112330.946	-26850.391	7.980	
面積				189.9693340
地積				189.96 m ²

89

地番 桂池尻二〇ノ二				
N O	X	Y	辺長	
15155	-112337.755	-26873.569		
12054	-112340.877	-26872.076	3.461	
11929	-112330.946	-26850.391	23.851	
11930	-112330.523	-26850.585	0.465	
11931	-112327.795	-26851.831	2.999	
15156	-112332.218	-26861.483	10.617	
15155	-112337.755	-26873.569	13.294	
面積				82.6754815
地積				82.67 m ²

90

地番 桂池尻二〇ノ三				
N O	X	Y	辺長	
15153	-112329.630	-26877.443		
12051	-112331.408	-26876.605	1.966	
15155	-112337.755	-26873.569	7.036	
15156	-112332.218	-26861.483	13.294	

101

地番 上東ノ口二ノ一			
NO	X	Y	辺長
1952	-111951.369	-27179.708	
1953	-111956.823	-27180.399	5.498
1957	-111966.122	-27172.574	12.153
1903	-111975.011	-27166.963	10.512
1958	-111972.056	-27161.617	6.108
1950	-111949.193	-27176.699	27.389
1951	-111949.461	-27177.071	0.458
1952	-111951.369	-27179.708	3.255
面積	167.0679910		
地積	167.06 m ²		

102

地番 上東ノ口四ノ一			
NO	X	Y	辺長
1950	-111949.193	-27176.699	
1958	-111972.056	-27161.617	27.389
1959	-111966.299	-27151.007	12.071
1908	-111987.536	-27137.959	24.925
1909	-111983.835	-27131.934	7.071
1913	-111964.966	-27144.287	22.553
1947	-111939.710	-27158.772	29.115
1948	-111940.187	-27159.451	0.830
1949	-111943.729	-27169.133	10.310
1950	-111949.193	-27176.699	9.333
面積	706.1150415		
地積	706.11 m ²		

103

地番 上東ノ口五ノ一,六ノ一,六ノ四 六ノ五,六ノ六			
NO	X	Y	辺長
1947	-111939.710	-27158.772	
1913	-111964.966	-27144.287	29.115
1909	-111983.835	-27131.934	22.553
1910	-111981.843	-27128.690	3.807
1914	-111969.609	-27108.817	23.337
1915	-111967.801	-27105.863	3.463
1932	-111945.635	-27108.061	22.275
1937	-111929.049	-27109.717	16.668
1938	-111923.320	-27117.208	9.431
1939	-111917.718	-27123.676	8.557
1940	-111915.939	-27126.438	3.285
1941	-111915.171	-27128.151	1.877
1942	-111916.942	-27130.747	3.143
1943	-111923.630	-27140.595	11.904
1946	-111931.576	-27147.204	10.335
1947	-111939.710	-27158.772	14.141
面積	2229.0712080		
地積	2229.07 m ²		

104

地番 上東ノ口六ノ八			
NO	X	Y	辺長
1937	-111929.049	-27109.717	
1932	-111945.635	-27108.061	16.668
1944	-111945.308	-27104.317	3.758
1935	-111932.039	-27105.683	13.339
1936	-111929.086	-27109.668	4.960
1937	-111929.049	-27109.717	0.061
面積	56.0397770		
地積	56.03 m ²		

105

地番 上東ノ口六ノ一〇			
NO	X	Y	辺長
1935	-111932.039	-27105.683	
1944	-111945.308	-27104.317	13.339
1945	-111944.984	-27100.612	3.719
1934	-111935.054	-27101.614	9.980
1935	-111932.039	-27105.683	5.064
面積	43.4941845		
地積	43.49 m ²		

106

地番 上東ノ口六ノ三			
NO	X	Y	辺長
1934	-111935.054	-27101.614	
1945	-111944.984	-27100.612	9.980
1916	-111963.422	-27098.706	18.536
1917	-111961.677	-27095.855	3.343
1918	-111952.646	-27081.273	17.152
1919	-111950.595	-27081.282	2.051
1920	-111949.156	-27083.672	2.790
1921	-111943.315	-27091.682	9.913
1922	-111937.253	-27098.836	9.377
1933	-111935.250	-27101.349	3.214
1934	-111935.054	-27101.614	0.330
面積	276.6471535		
地積	276.64 m ²		

107

地番 上東ノ口六ノ九			
NO	X	Y	辺長
1932	-111945.635	-27108.061	
1915	-111967.801	-27105.863	22.275
1916	-111963.422	-27098.706	8.390
1945	-111944.984	-27100.612	18.536
1944	-111945.308	-27104.317	3.719
1932	-111945.635	-27108.061	3.758
面積	153.4255255		
地積	153.42 m ²		

108

地番 上東ノ口二ノ五			
NO	X	Y	辺長
1903	-111975.011	-27166.963	
1904	-111980.207	-27163.684	6.144
1905	-111994.337	-27154.778	16.703
1906	-111995.338	-27150.627	4.270
1907	-111994.076	-27148.608	2.381
1908	-111987.536	-27137.959	12.497
1959	-111966.299	-27151.007	24.925
1958	-111972.056	-27161.617	12.071
1903	-111975.011	-27166.963	6.108
面積	452.8984265		
地積	452.89 m ²		

図面の種類	画地面積求積表		
街区番号	131A	番号	/
町名	上桂東ノ口町		
京都市洛西第二土地区画整理組合			

上桂北村町




S = 1 : 250

131 A

132

121 A

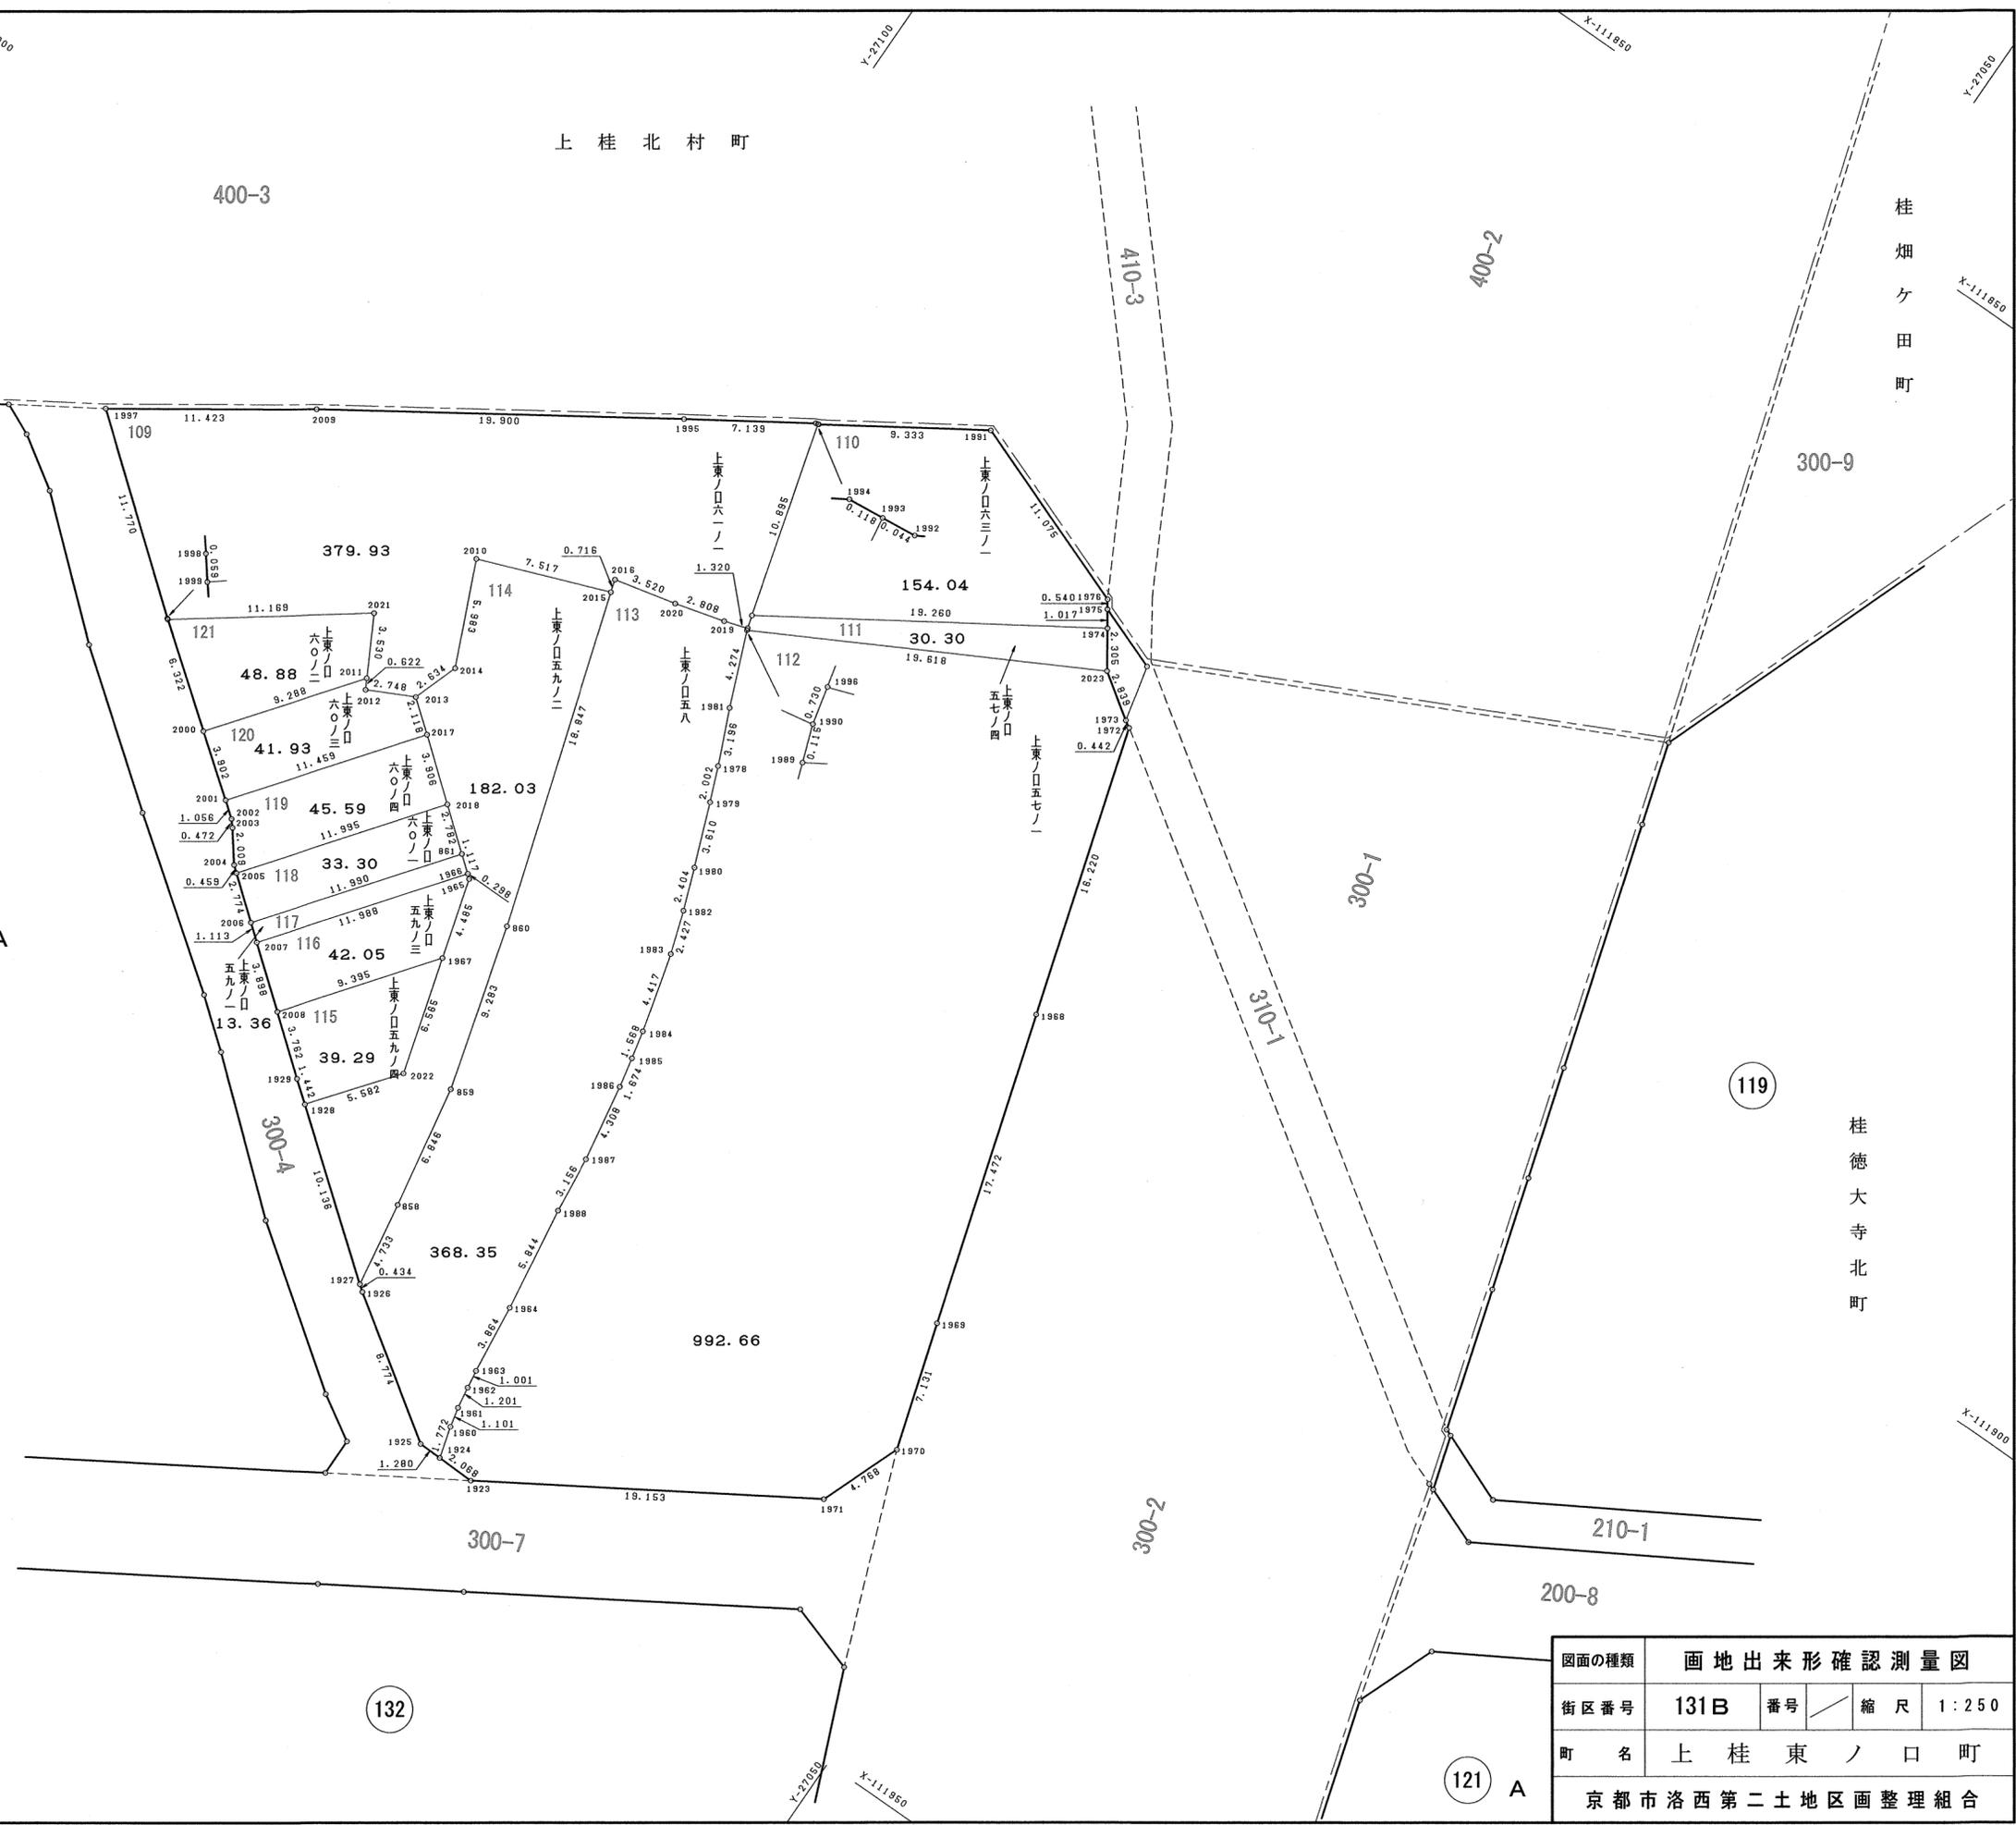

桂畑ヶ田町

桂徳大寺北町

図面の種類	画地出来形確認測量図		
街区番号	131B	番号	縮尺 1:250
町名	上桂東ノ口町		
京都市洛西第二土地区画整理組合			

109

地番 上東ノ口六一ノ一			
NO	X	Y	辺長
1997	-111912.364	-27123.712	
1998	-111919.728	-27114.530	11.770
1999	-111919.764	-27114.483	0.059
2021	-111913.130	-27105.498	11.169
2011	-111916.232	-27103.813	3.530
2012	-111916.780	-27103.518	0.622
2013	-111915.550	-27101.061	2.748
2014	-111913.060	-27100.202	2.634
2010	-111907.582	-27102.609	5.983
2015	-111904.895	-27095.589	7.517
2016	-111904.211	-27095.802	0.716
2020	-111903.408	-27092.375	3.520
2019	-111902.680	-27089.663	2.808
1990	-111902.276	-27088.406	1.320
1996	-111901.575	-27088.610	0.730
1993	-111891.082	-27091.543	10.895
1994	-111891.114	-27091.657	0.118
1995	-111894.988	-27097.653	7.139
2009	-111905.889	-27114.302	19.900
1997	-111912.364	-27123.712	11.423
面積	379.9338365		
地積	379.93 m ²		

110

地番 上東ノ口六三ノ一			
NO	X	Y	辺長
1993	-111891.082	-27091.543	
1996	-111901.575	-27088.610	10.895
1974	-111891.180	-27072.396	19.260
1975	-111890.341	-27072.971	1.017
1976	-111889.893	-27073.273	0.540
1991	-111886.024	-27083.650	11.075
1992	-111891.070	-27091.501	9.333
1993	-111891.082	-27091.543	0.044
面積	154.0406105		
地積	154.04 m ²		

111

地番 上東ノ口五七ノ四			
NO	X	Y	辺長
1996	-111901.575	-27088.610	
1990	-111902.276	-27088.406	0.730
1989	-111902.383	-27088.365	0.115
2023	-111893.081	-27071.093	19.618
1974	-111891.180	-27072.396	2.305
1996	-111901.575	-27088.610	19.260
面積	30.3045890		
地積	30.30 m ²		

112

地番 上東ノ口五七ノ一			
NO	X	Y	辺長
1989	-111902.383	-27088.365	
1981	-111906.345	-27086.761	4.274
1978	-111909.275	-27085.485	3.196
1979	-111911.130	-27084.732	2.002
1980	-111914.496	-27083.426	3.610
1982	-111916.748	-27082.584	2.404
1983	-111919.051	-27081.817	2.427
1984	-111923.322	-27080.692	4.417
1985	-111924.853	-27080.354	1.568
1986	-111926.492	-27080.013	1.674
1987	-111930.740	-27079.297	4.308
1988	-111933.879	-27078.967	3.156
1964	-111939.663	-27078.134	5.844
1963	-111943.503	-27077.704	3.864
1962	-111944.494	-27077.562	1.001
1961	-111945.680	-27077.372	1.201
1960	-111946.754	-27077.131	1.101
1924	-111948.458	-27076.644	1.772
1923	-111948.511	-27074.577	2.068
1971	-111938.435	-27058.289	19.153
1970	-111933.994	-27056.555	4.768
1969	-111927.176	-27058.646	7.131
1968	-111910.452	-27063.705	17.472
1972	-111894.919	-27068.376	16.220
1973	-111894.685	-27068.751	0.442
2023	-111893.081	-27071.093	2.839
1989	-111902.383	-27088.365	19.618
面積	992.6664440		
地積	992.66 m ²		

113

地番 上東ノ口五八			
NO	X	Y	辺長
2016	-111904.211	-27095.802	
2015	-111904.895	-27095.589	0.716
860	-111922.884	-27089.966	18.847
859	-111931.825	-27087.470	9.283
858	-111938.567	-27086.282	6.846
1927	-111943.240	-27085.532	4.733
1926	-111943.508	-27085.191	0.434
1925	-111948.425	-27077.924	8.774
1924	-111948.458	-27076.644	1.280
1960	-111946.754	-27077.131	1.772
1961	-111945.680	-27077.372	1.101
1962	-111944.494	-27077.562	1.201
1963	-111943.503	-27077.704	1.001
1964	-111939.663	-27078.134	3.864
1988	-111933.879	-27078.967	5.844
1987	-111930.740	-27079.297	3.156
1986	-111926.492	-27080.013	4.308
1985	-111924.853	-27080.354	1.674
1984	-111923.322	-27080.692	1.568
1983	-111919.051	-27081.817	4.417
1982	-111916.748	-27082.584	2.427
1980	-111914.496	-27083.426	2.404
1979	-111911.130	-27084.732	3.610
1978	-111909.275	-27085.485	2.002
1981	-111906.345	-27086.761	3.196
1989	-111902.383	-27088.365	4.274
1990	-111902.276	-27088.406	0.115
2019	-111902.680	-27089.663	1.320
2020	-111903.408	-27092.375	2.808
2016	-111904.211	-27095.802	3.520
面積	368.3572350		
地積	368.35 m ²		

114

地番 上東ノ口五九ノ二			
NO	X	Y	辺長
2010	-111907.582	-27102.609	
2014	-111913.060	-27100.202	5.983
2013	-111915.550	-27101.061	2.634
2017	-111916.870	-27099.405	2.118
2018	-111919.328	-27096.370	3.906
861	-111921.072	-27094.202	2.782
1966	-111921.773	-27093.332	1.117
1965	-111921.962	-27093.102	0.298
1967	-111926.273	-27091.864	4.485
2022	-111932.585	-27090.060	6.565
1928	-111936.979	-27093.503	5.582
1927	-111943.240	-27085.532	10.136
858	-111938.567	-27086.282	4.733
859	-111931.825	-27087.470	6.846
860	-111922.884	-27089.966	9.283
2015	-111904.895	-27095.589	18.847
2010	-111907.582	-27102.609	7.517
面積	182.0331230		
地積	182.03 m ²		

115

地番 上東ノ口五九ノ四			
NO	X	Y	辺長
2008	-111933.735	-27097.572	
1929	-111936.088	-27094.637	3.762
1928	-111936.979	-27093.503	1.442
2022	-111932.585	-27090.060	5.582
1967	-111926.273	-27091.864	6.565
2008	-111933.735	-27097.572	9.395
面積	39.2959195		
地積	39.29 m ²		

116

地番 上東ノ口五九ノ三			
NO	X	Y	辺長
2007	-111931.296	-27100.613	
2008	-111933.735	-27097.572	3.898
1967	-111926.273	-27091.864	9.395
1965	-111921.962	-27093.102	4.485
1966	-111921.773	-27093.332	0.298
2007	-111931.296	-27100.613	11.988
面積	42.0577830		
地積	42.05 m ²		

117

地番 上東ノ口五九ノ一			
NO	X	Y	辺長
2006	-111930.600	-27101.481	
2007	-111931.296	-27100.613	1.113
1966	-111921.773	-27093.332	11.988
861	-111921.072	-27094.202	1.117
2006	-111930.600	-27101.481	11.990
面積	13.3627395		
地積	13.36 m ²		

118

地番 上東ノ口六〇ノ一			
NO	X	Y	辺長
2005	-111928.865	-27103.645	
2006	-111930.600	-27101.481	2.774
861	-111921.072	-27094.202	11.990
2018	-111919.328	-27096.370	2.782
2005	-111928.865	-27103.645	11.995
面積	33.3057365		
地積	33.30 m ²		

119

地番 上東ノ口六〇ノ四			
NO	X	Y	辺長
2001	-111925.976	-27106.362	
2002	-111926.618	-27105.523	1.056
2003	-111926.976	-27105.216	0.472
2004	-111928.578	-27104.003	2.009
2005	-111928.865	-27103.645	0.459
2018	-111919.328	-27096.370	11.995
2017	-111916.870	-27099.405	3.906
2001	-111925.976	-27106.362	11.459
面積	45.5974215		
地積	45.59 m ²		

120

地番 上東ノ口六〇ノ三			
NO	X	Y	辺長
2000	-111923.605	-27109.461	
2001	-111925.976	-27106.362	3.902
2017	-111916.870	-27099.405	11.459
2013	-111915.550	-27101.061	2.118
2012	-111916.780	-27103.518	2.748
2011	-111916.232	-27103.813	0.622
2000	-111923.605	-27109.461	9.288
面積	41.9354475		
地積	41.93 m ²		

121

地番 上東ノ口六〇ノ二			
NO	X	Y	辺長
1999	-111919.764	-27114.483	
2000	-111923.605	-27109.461	6.322
2011	-111916.232	-27103.813	9.288
2021	-111913.130	-27105.498	3.530
1999	-111919.764	-27114.483	11.169
面積	48.8854670		
地積	48.88 m ²		

図面の種類	画地面積求積表		
街区番号	131B	番号	/
町名	上桂東ノ口町		
京都市洛西第二土地区画整理組合			



S = 1 : 2 5 0

Y-27000

X-111950

X-112000

300-2

131 B

131 A

133


Y-27050

Y-27100

X-111950

X-112000


Y-27100

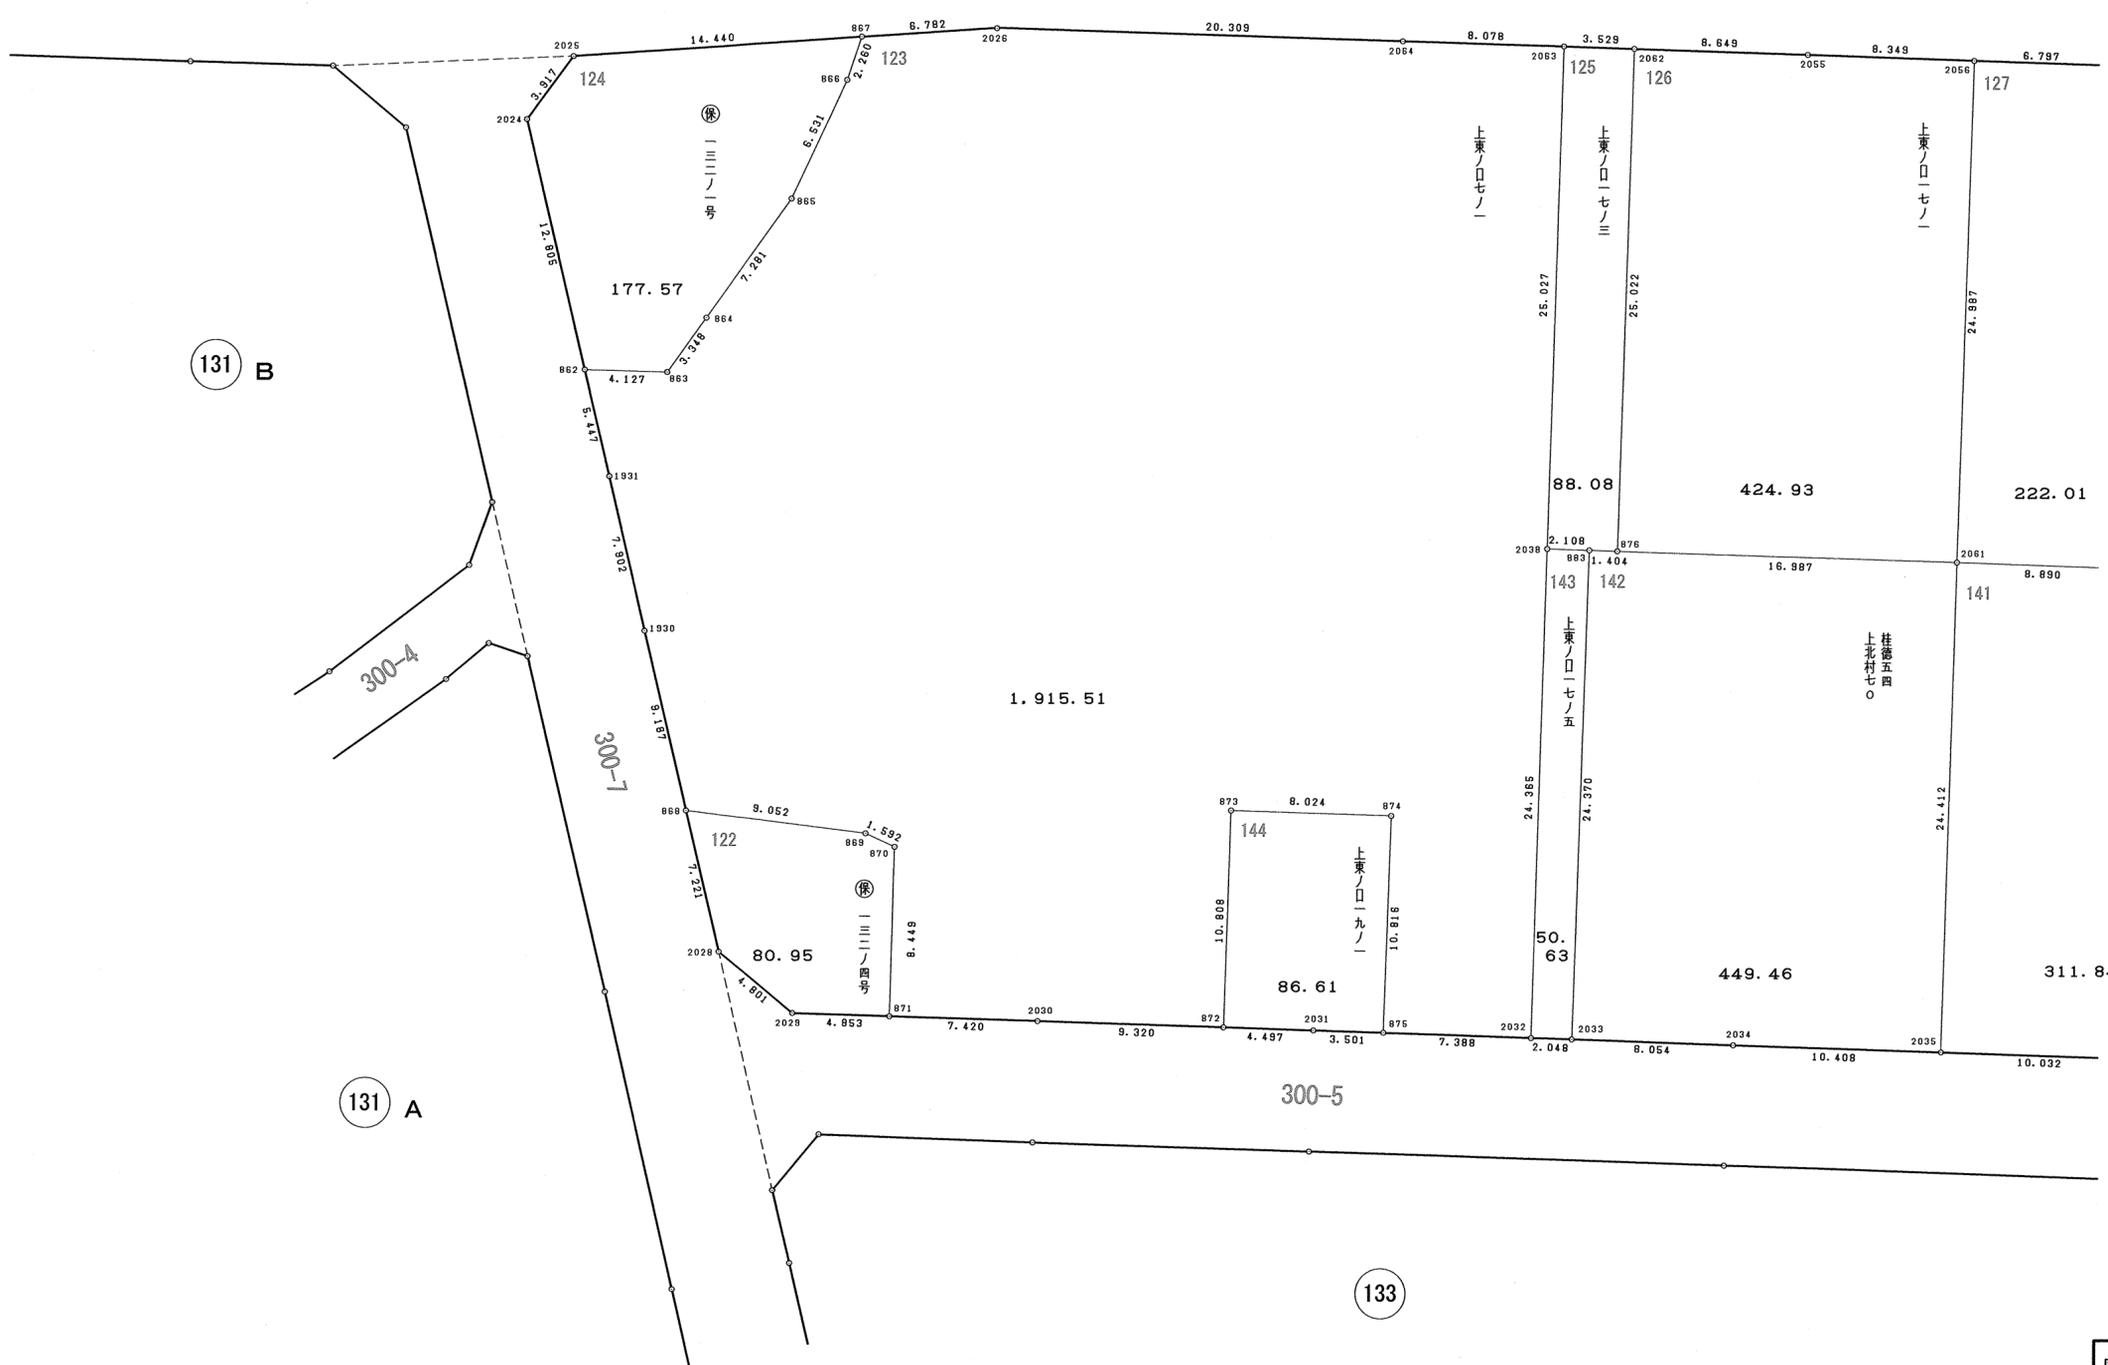

図面の種類	画地出来形確認測量図			
街区番号	132 1/2	番号	縮尺	1 : 250
町名	上桂東ノ口町			
京都市洛西第二土地区画整理組合				



S = 1 : 2 5 0

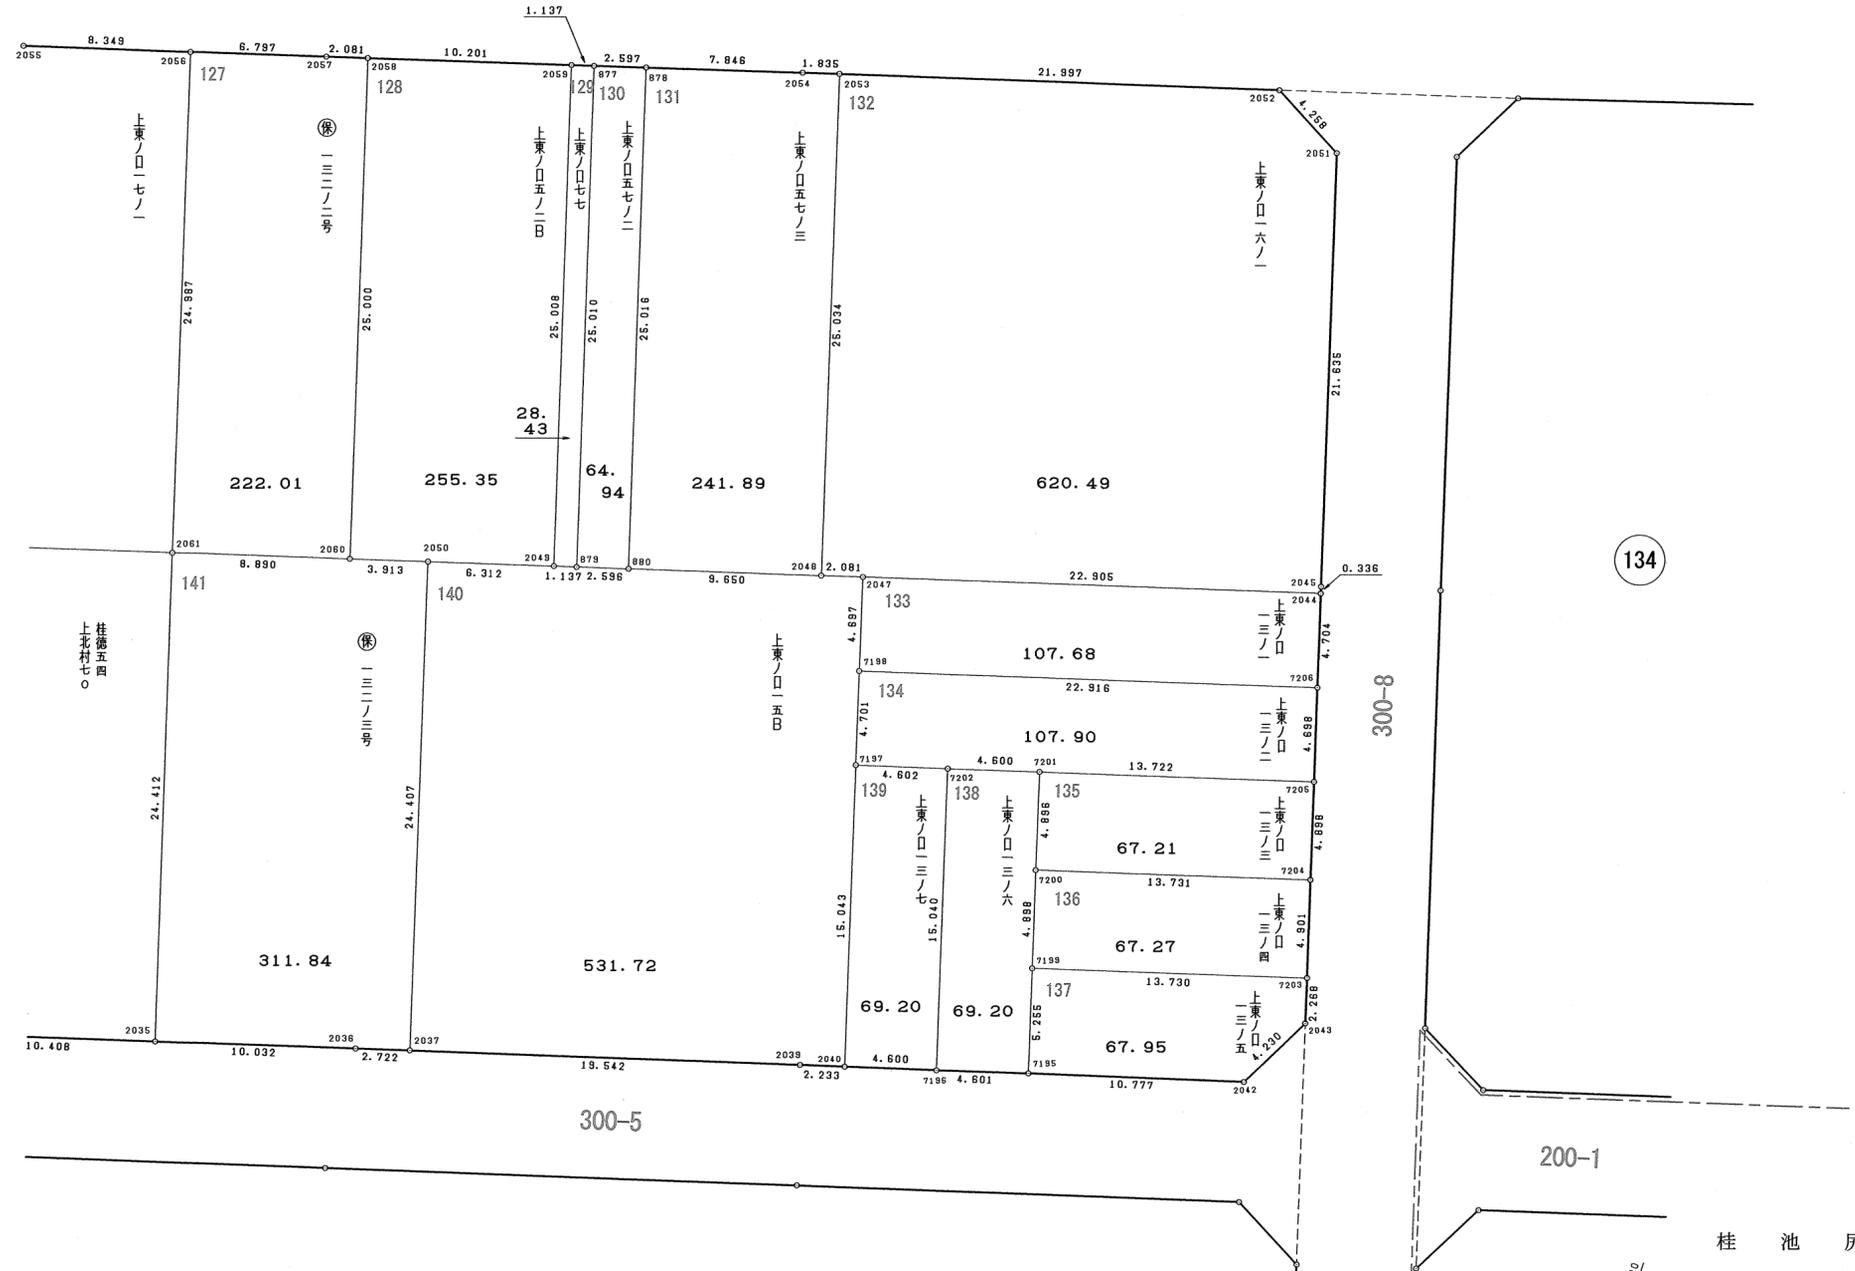

134

133

135

図面の種類	画地出来形確認測量図			
街区番号	132	2/2	番号	縮尺 1 : 250
町名	上 桂 東 ノ 口 町			
京都市洛西第二土地区画整理組合				

122

Table with 4 columns: 地番, NO, X, Y, 辺長. Includes area and ground area calculations.

123

Table with 4 columns: 地番, NO, X, Y, 辺長. Includes area and ground area calculations.

124

Table with 4 columns: 地番, NO, X, Y, 辺長. Includes area and ground area calculations.

Summary table with columns: 図面の種類, 画地, 面積, 求積表, 街区番号, 町名, 京都市洛西第二土地区画整理組合.