

京都都市計画（京都国際文化観光都市建設計画）
 都市建設事業洛西第二地区土地区画整理事業

画地出来形確認測量図

2 / 5

洛西第二土地区画整理事業画地出来形測量図

30街区～59街区
 平成17年9月2日現在

洛西第二土地区画整理組合
 第一測量設計株式会社

嵐山	嵐山宮ノ前町	1		
桂	桂池尻町			5
	桂上野今井町	2		
	桂上野北町		3	
	桂上野中町		3	
	桂上野西町	2		
	桂上野東町		3	4
	桂上野南町		3	
	桂河田町		4	5
	桂清水町			5
	桂徳大寺町		4	
	桂徳大寺北町		4	5
	桂徳大寺東町		4	
	桂徳大寺南町			5
	桂畑ヶ田町		4	
	桂久方町			5
上桂	上桂今井町	2		
	上桂北ノ口町	2	3	
	上桂北村町		3	
	上桂東ノ口町			5
	上桂前川町	2		
松室	松室吾田神町	1	2	
	松室荒堀町	1		
	松室河原町	1		
	松室北河原町	1		
	松室中溝町	1		
	松尾東ノ口町		2	

188

地番 松吾田四八ノ二			
NO	X	Y	辺長
4034	-111433.798	-27898.245	
4035	-111437.272	-27900.805	4.315
4039	-111460.237	-27897.335	23.226
4040	-111460.456	-27897.302	0.221
4037	-111458.047	-27881.278	16.204
4033	-111431.849	-27885.215	26.492
4034	-111433.798	-27898.245	13.175
面積	424.9955045		
地積	424.99 m ²		

189

地番 松吾田四八ノ三			
NO	X	Y	辺長
4033	-111431.849	-27885.215	
4037	-111458.047	-27881.278	26.492
4036	-111456.877	-27873.425	7.940
4031	-111430.676	-27877.366	26.496
4032	-111431.153	-27880.564	3.233
4033	-111431.849	-27885.215	4.703
面積	210.3104535		
地積	210.31 m ²		

190

地番 松吾田四六ノ四			
NO	X	Y	辺長
4031	-111430.676	-27877.366	
4036	-111456.877	-27873.425	26.496
3827	-111454.833	-27859.879	13.699
3826	-111453.819	-27853.004	6.949
3815	-111427.624	-27856.941	26.489
3814	-111428.434	-27862.320	5.440
4031	-111430.676	-27877.366	15.212
面積	546.8532000		
地積	546.85 m ²		

191

地番 松吾田四三ノ三			
NO	X	Y	辺長
3815	-111427.624	-27856.941	
3826	-111453.819	-27853.004	26.489
3824	-111453.331	-27849.868	3.174
3825	-111453.122	-27848.432	1.451
3816	-111426.936	-27852.376	26.481
3815	-111427.624	-27856.941	4.617
面積	122.3574235		
地積	122.35 m ²		

192

地番 松吾田四三ノ二			
NO	X	Y	辺長
3816	-111426.936	-27852.376	
3825	-111453.122	-27848.432	26.481
3811	-111451.202	-27835.593	12.982
3819	-111425.002	-27839.548	26.497
3818	-111425.067	-27839.977	0.434
3817	-111426.858	-27851.859	12.016
3816	-111426.936	-27852.376	0.523
面積	343.7569095		
地積	343.75 m ²		

193

地番 保三〇ノ一			
NO	X	Y	辺長
3819	-111425.002	-27839.548	
3811	-111451.202	-27835.593	26.497
3812	-111450.243	-27829.447	6.220
3796	-111449.556	-27824.797	4.700
3820	-111423.371	-27828.728	26.478
3819	-111425.002	-27839.548	10.942
面積	289.4306215		
地積	289.43 m ²		

194

地番 松吾田四一ノ三			
NO	X	Y	辺長
3820	-111423.371	-27828.728	
3796	-111449.556	-27824.797	26.478
3797	-111448.605	-27818.426	6.442
3813	-111447.821	-27813.206	5.279
3794	-111421.624	-27817.145	26.491
3795	-111421.655	-27817.347	0.204
3820	-111423.371	-27828.728	11.510
面積	310.3381845		
地積	310.33 m ²		

195

地番 松吾田四〇ノ一			
NO	X	Y	辺長
3794	-111421.624	-27817.145	
3813	-111447.821	-27813.206	26.491
3798	-111445.822	-27799.854	13.501
3790	-111443.720	-27785.834	14.177
3791	-111434.721	-27788.375	9.351
3792	-111420.842	-27792.295	14.422
3793	-111418.416	-27796.058	4.477
3794	-111421.624	-27817.145	21.330
面積	685.0335780		
地積	685.03 m ²		

196

地番 松吾田四一ノ一			
NO	X	Y	辺長
3798	-111445.822	-27799.854	
4057	-111472.074	-27796.001	26.533
4056	-111469.953	-27781.501	14.654
3788	-111466.638	-27779.359	3.947
3789	-111454.092	-27782.906	13.038
3790	-111443.720	-27785.834	10.777
3798	-111445.822	-27799.854	14.177
面積	418.1105120		
地積	418.11 m ²		

197

地番 松吾田四二ノ一			
NO	X	Y	辺長
3797	-111448.605	-27818.426	
4059	-111474.797	-27814.587	26.472
4058	-111473.413	-27805.153	9.535
4057	-111472.074	-27796.001	9.249
3798	-111445.822	-27799.854	26.533
3813	-111447.821	-27813.206	13.501
3797	-111448.605	-27818.426	5.279
面積	497.7660490		
地積	497.76 m ²		

198

地番 松尾東一ノ一〇, 松尾東一ノ一一			
NO	X	Y	辺長
3812	-111450.243	-27829.447	
4061	-111476.413	-27825.538	26.460
4060	-111475.490	-27819.306	6.300
4059	-111474.797	-27814.587	4.770
3797	-111448.605	-27818.426	26.472
3796	-111449.556	-27824.797	6.442
3812	-111450.243	-27829.447	4.700
面積	293.8863970		
地積	293.88 m ²		

199

地番 松吾田四五			
NO	X	Y	辺長
3824	-111453.331	-27849.868	
3823	-111463.286	-27848.381	10.065
4050	-111479.454	-27845.981	16.345
4062	-111476.897	-27828.806	17.364
4061	-111476.413	-27825.538	3.304
3812	-111450.243	-27829.447	26.460
3811	-111451.202	-27835.593	6.220
3825	-111453.122	-27848.432	12.982
3824	-111453.331	-27849.868	1.451
面積	545.7346830		
地積	545.73 m ²		

200

地番 松吾田四六ノ五			
NO	X	Y	辺長
3822	-111464.036	-27853.393	
4048	-111480.198	-27850.979	16.341
4049	-111479.842	-27848.589	2.416
4050	-111479.454	-27845.981	2.637
3823	-111463.286	-27848.381	16.345
3822	-111464.036	-27853.393	5.068
面積	82.7032900		
地積	82.70 m ²		

201

地番 松吾田四六ノ三			
NO	X	Y	辺長
3821	-111464.778	-27858.392	
4047	-111480.945	-27855.982	16.346
4048	-111480.198	-27850.979	5.058
3822	-111464.036	-27853.393	16.341
3821	-111464.778	-27858.392	5.054
面積	82.6343985		
地積	82.63 m ²		

202

地番 松吾田四六ノ二			
NO	X	Y	辺長
3827	-111454.833	-27859.879	
3821	-111464.778	-27858.392	10.056
3822	-111464.036	-27853.393	5.054
3823	-111463.286	-27848.381	5.068
3824	-111453.331	-27849.868	10.065
3826	-111453.819	-27853.004	3.174
3827	-111454.833	-27859.879	6.949
面積	101.7631140		
地積	101.76 m ²		

203

地番 松吾田四四			
NO	X	Y	辺長
4037	-111458.047	-27881.278	
4038	-111460.928	-27880.843	2.914
4045	-111484.148	-27877.349	23.481
4046	-111482.791	-27868.361	9.090
4047	-111480.945	-27855.982	12.516
3821	-111464.778	-27858.392	16.346
3827	-111454.833	-27859.879	10.056
4036	-111456.877	-27873.425	13.699
4037	-111458.047	-27881.278	7.940
面積	570.6047630		
地積	570.60 m ²		


204

地番 松吾田四八ノ五			
NO	X	Y	辺長
4041	-111463.339	-27896.867	
4042	-111482.971	-27893.906	19.854
4043	-111486.227	-27889.356	5.595
4044	-111484.493	-27879.631	9.878
4045	-111484.148	-27877.349	2.308
4038	-111460.928	-27880.843	23.481
4041	-111463.339	-27896.867	16.204
面積	375.0078100		
地積	375.00 m ²		

205

地番 松吾田四八ノ四			
NO	X	Y	辺長
4040	-111460.456	-27897.302	
4041	-111463.339	-27896.867	2.916
4038	-111460.928	-27880.843	16.204
4037	-111458.047	-27881.278	2.914
4040	-111460.456	-27897.302	16.204
面積	47.2295180		
地積	47.22 m ²		

図面の種類	画地面積求積表		
街区番号	30	番号	/
町名	松室吾田神町		
京都市洛西第二土地区画整理組合			

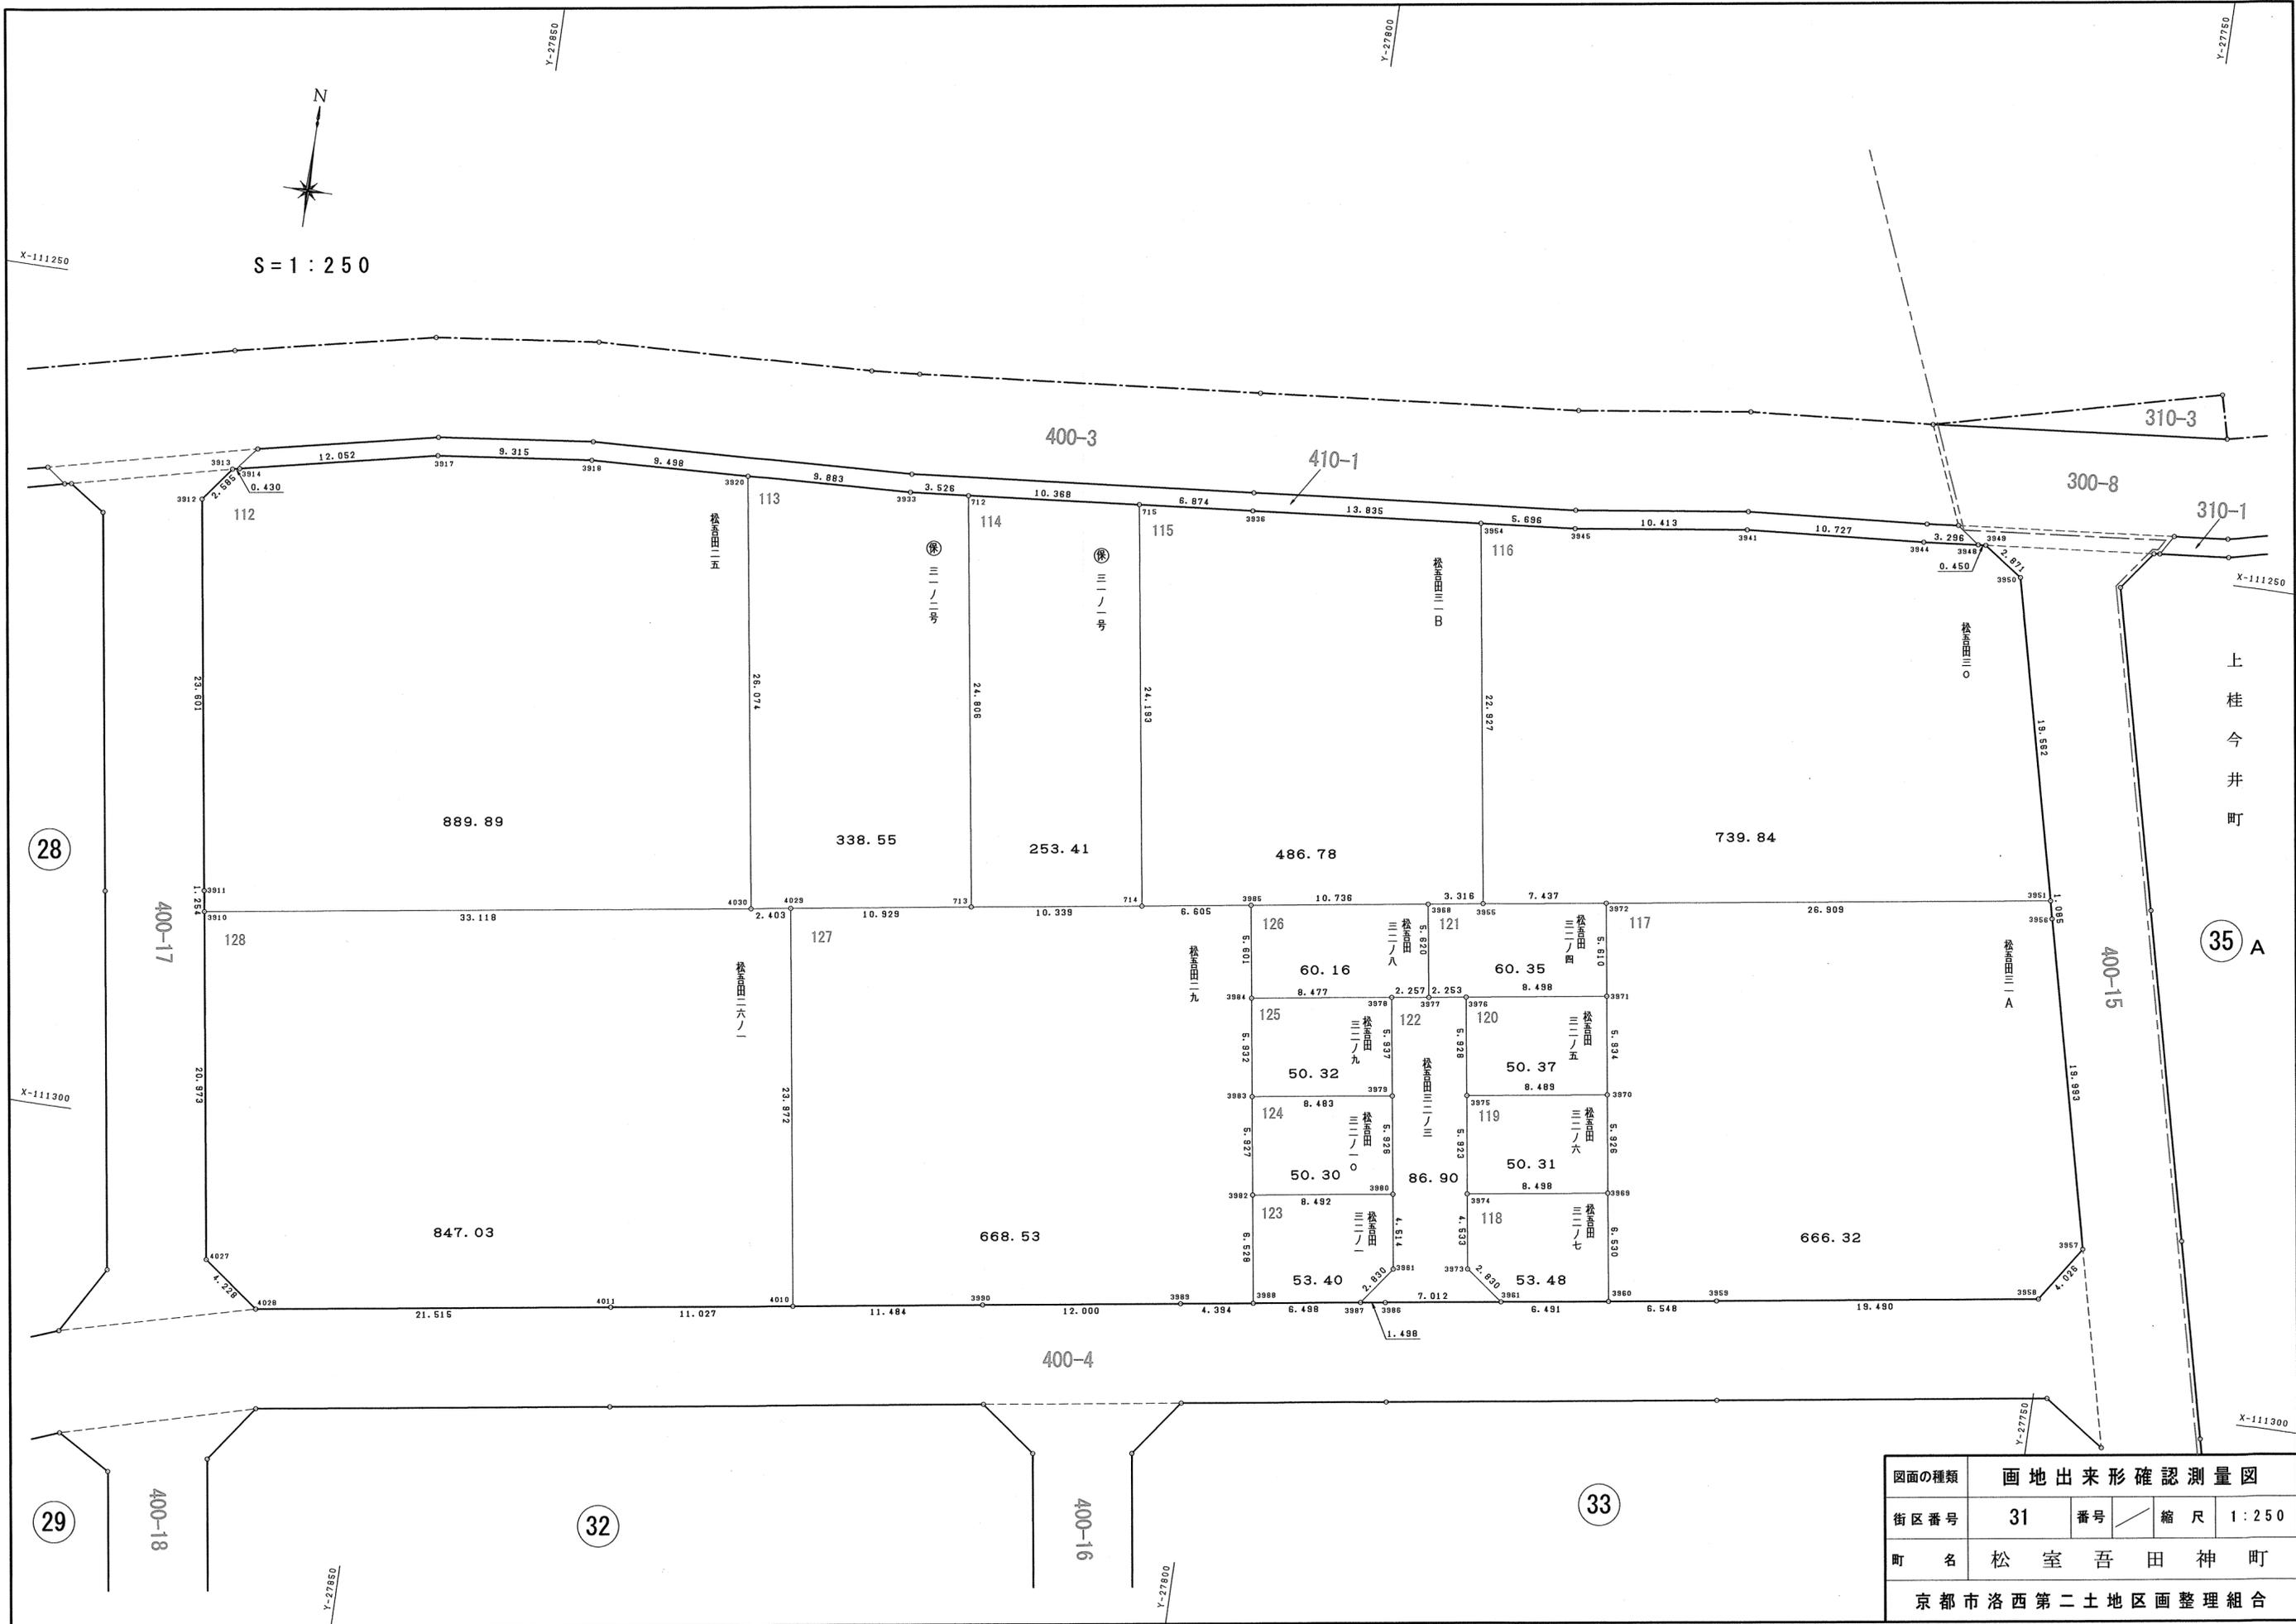

112

地番 松吾田二五			
NO	X	Y	辺長
3913	-111260.461	-27865.926	
3912	-111262.511	-27867.500	2.585
3911	-111285.847	-27863.974	23.601
3910	-111287.087	-27863.787	1.254
4030	-111282.138	-27831.041	33.118
3920	-111256.363	-27834.978	26.074
3918	-111256.776	-27844.467	9.498
3917	-111257.855	-27853.719	9.315
3914	-111260.359	-27865.508	12.052
3913	-111260.461	-27865.926	0.430
面積	889.8924310		
地積	889.89 m ²		

113

地番 保 三一ノ二号			
NO	X	Y	辺長
3920	-111256.363	-27834.978	
4030	-111282.138	-27831.041	26.074
4029	-111281.782	-27828.665	2.403
713	-111280.142	-27817.860	10.929
712	-111255.618	-27821.592	24.806
3933	-111255.933	-27825.104	3.526
3920	-111256.363	-27834.978	9.883
面積	338.5535205		
地積	338.55 m ²		

114

地番 保 三一ノ一号			
NO	X	Y	辺長
712	-111255.618	-27821.592	
713	-111280.142	-27817.860	24.806
714	-111278.610	-27807.635	10.339
715	-111254.691	-27811.266	24.193
712	-111255.618	-27821.592	10.368
面積	253.4144275		
地積	253.41 m ²		

115

地番 松吾田三一B			
NO	X	Y	辺長
715	-111254.691	-27811.266	
714	-111278.610	-27807.635	24.193
3985	-111277.612	-27801.106	6.605
3968	-111276.008	-27790.490	10.736
3955	-111275.511	-27787.211	3.316
3954	-111252.842	-27790.639	22.927
3936	-111254.077	-27804.419	13.835
715	-111254.691	-27811.266	6.874
面積	486.7888450		
地積	486.78 m ²		

116

地番 松吾田三〇			
NO	X	Y	辺長
3954	-111252.842	-27790.639	
3955	-111275.511	-27787.211	22.927
3972	-111274.395	-27779.858	7.437
3951	-111270.381	-27753.250	26.909
3950	-111251.368	-27757.854	19.562
3949	-111249.749	-27760.225	2.871
3948	-111249.792	-27760.673	0.450
3944	-111250.105	-27763.954	3.296
3941	-111250.907	-27774.651	10.727
3945	-111252.334	-27784.966	10.413
3954	-111252.842	-27790.639	5.696
面積	739.8478775		
地積	739.84 m ²		

117

地番 松吾田三一A			
NO	X	Y	辺長
3972	-111274.395	-27779.858	
3971	-111279.942	-27779.019	5.610
3970	-111285.810	-27778.135	5.934
3969	-111291.669	-27777.245	5.926
3960	-111298.126	-27776.270	6.530
3959	-111297.149	-27769.795	6.548
3958	-111294.222	-27750.526	19.490
3957	-111290.869	-27748.297	4.026
3956	-111271.436	-27752.995	19.993
3951	-111270.381	-27753.250	1.085
3972	-111274.395	-27779.858	26.909
面積	666.3245880		
地積	666.32 m ²		

118

地番 松吾田三二ノ七			
NO	X	Y	辺長
3974	-111292.940	-27785.647	
3973	-111297.422	-27784.971	4.533
3961	-111299.095	-27782.688	2.830
3960	-111298.126	-27776.270	6.491
3969	-111291.669	-27777.245	6.530
3974	-111292.940	-27785.647	8.498
面積	53.4812290		
地積	53.48 m ²		

119

地番 松吾田三二ノ六			
NO	X	Y	辺長
3975	-111287.083	-27786.528	
3974	-111292.940	-27785.647	5.923
3969	-111291.669	-27777.245	8.498
3970	-111285.810	-27778.135	5.926
3975	-111287.083	-27786.528	8.489
面積	50.3189110		
地積	50.31 m ²		

120

地番 松吾田三二ノ五			
NO	X	Y	辺長
3976	-111281.222	-27787.420	
3975	-111287.083	-27786.528	5.928
3970	-111285.810	-27778.135	8.489
3971	-111279.942	-27779.019	5.934
3976	-111281.222	-27787.420	8.498
面積	50.3777385		
地積	50.37 m ²		

121

地番 松吾田三二ノ四			
NO	X	Y	辺長
3968	-111276.008	-27790.490	
3977	-111281.564	-27789.647	5.620
3976	-111281.222	-27787.420	2.253
3971	-111279.942	-27779.019	8.498
3972	-111274.395	-27779.858	5.610
3955	-111275.511	-27787.211	7.437
3968	-111276.008	-27790.490	3.316
面積	60.3590100		
地積	60.35 m ²		

122

地番 松吾田三二ノ三			
NO	X	Y	辺長
3978	-111281.886	-27791.881	
3979	-111287.756	-27790.994	5.937
3980	-111293.614	-27790.100	5.926
3981	-111298.079	-27789.434	4.514
3987	-111300.364	-27791.103	2.830
3986	-111300.141	-27789.622	1.498
3961	-111299.095	-27782.688	7.012
3973	-111297.422	-27784.971	2.830
3974	-111292.940	-27785.647	4.533
3975	-111287.083	-27786.528	5.923
3976	-111281.222	-27787.420	5.928
3977	-111281.564	-27789.647	2.253
3978	-111281.886	-27791.881	2.257
面積	86.9003330		
地積	86.90 m ²		

123

地番 松吾田三二ノ一			
NO	X	Y	辺長
3982	-111294.876	-27798.498	
3988	-111301.332	-27797.528	6.528
3987	-111300.364	-27791.103	6.498
3981	-111298.079	-27789.434	2.830
3980	-111293.614	-27790.100	4.514
3982	-111294.876	-27798.498	8.492
面積	53.4066845		
地積	53.40 m ²		

124

地番 松吾田三二ノ〇			
NO	X	Y	辺長
3983	-111289.015	-27799.383	
3982	-111294.876	-27798.498	5.927
3980	-111293.614	-27790.100	8.492
3979	-111287.756	-27790.994	5.926
3983	-111289.015	-27799.383	8.483
面積	50.3029280		
地積	50.30 m ²		

125

地番 松吾田三二ノ九			
NO	X	Y	辺長
3984	-111283.149	-27800.263	
3983	-111289.015	-27799.383	5.932
3979	-111287.756	-27790.994	8.483
3978	-111281.886	-27791.881	5.937
3984	-111283.149	-27800.263	8.477
面積	50.3202075		
地積	50.32 m ²		

126

地番 松吾田三二ノ八			
NO	X	Y	辺長
3985	-111277.612	-27801.106	
3984	-111283.149	-27800.263	5.601
3978	-111281.886	-27791.881	8.477
3977	-111281.564	-27789.647	2.257
3968	-111276.008	-27790.490	5.620
3985	-111277.612	-27801.106	10.736
面積	60.1645385		
地積	60.16 m ²		

127


地番 松吾田二九			
NO	X	Y	辺長
4029	-111281.782	-27828.665	
4010	-111305.487	-27825.095	23.972
3990	-111303.777	-27813.739	11.484
3989	-111301.986	-27801.873	12.000
3988	-111301.332	-27797.528	4.394
3982	-111294.876	-27798.498	6.528
3983	-111289.015	-27799.383	5.927
3984	-111283.149	-27800.263	5.932
3985	-111277.612	-27801.106	5.601
714	-111278.610	-27807.635	6.605
713	-111280.142	-27817.860	10.339
4029	-111281.782	-27828.665	10.929
面積	668.5300930		
地積	668.53 m ²		

128

地番 松吾田二六ノ一			
NO	X	Y	辺長
3910	-111287.087	-27863.787	
4027	-111307.826	-27860.665	20.973
4028	-111310.348	-27857.272	4.228
4011	-111307.129	-27835.999	21.515
4010	-111305.487	-27825.095	11.027
4029	-111281.782	-27828.665	23.972
4030	-111282.138	-27831.041	2.403
3910	-111287.087	-27863.787	33.118
面積	847.0348765		
地積	847.03 m ²		

図面の種類	画地面積求積表		
街区番号	31	番号	/
町名	松室吾田神町		
京都市洛西第二土地区画整理組合			

上桂今井町

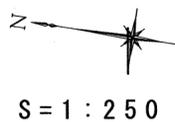

S = 1 : 250

33

34

400-16

400-15

31

Y-27800

400-4

400-5

30

Y-27850


400-18

400-17

Y-27850

29

28

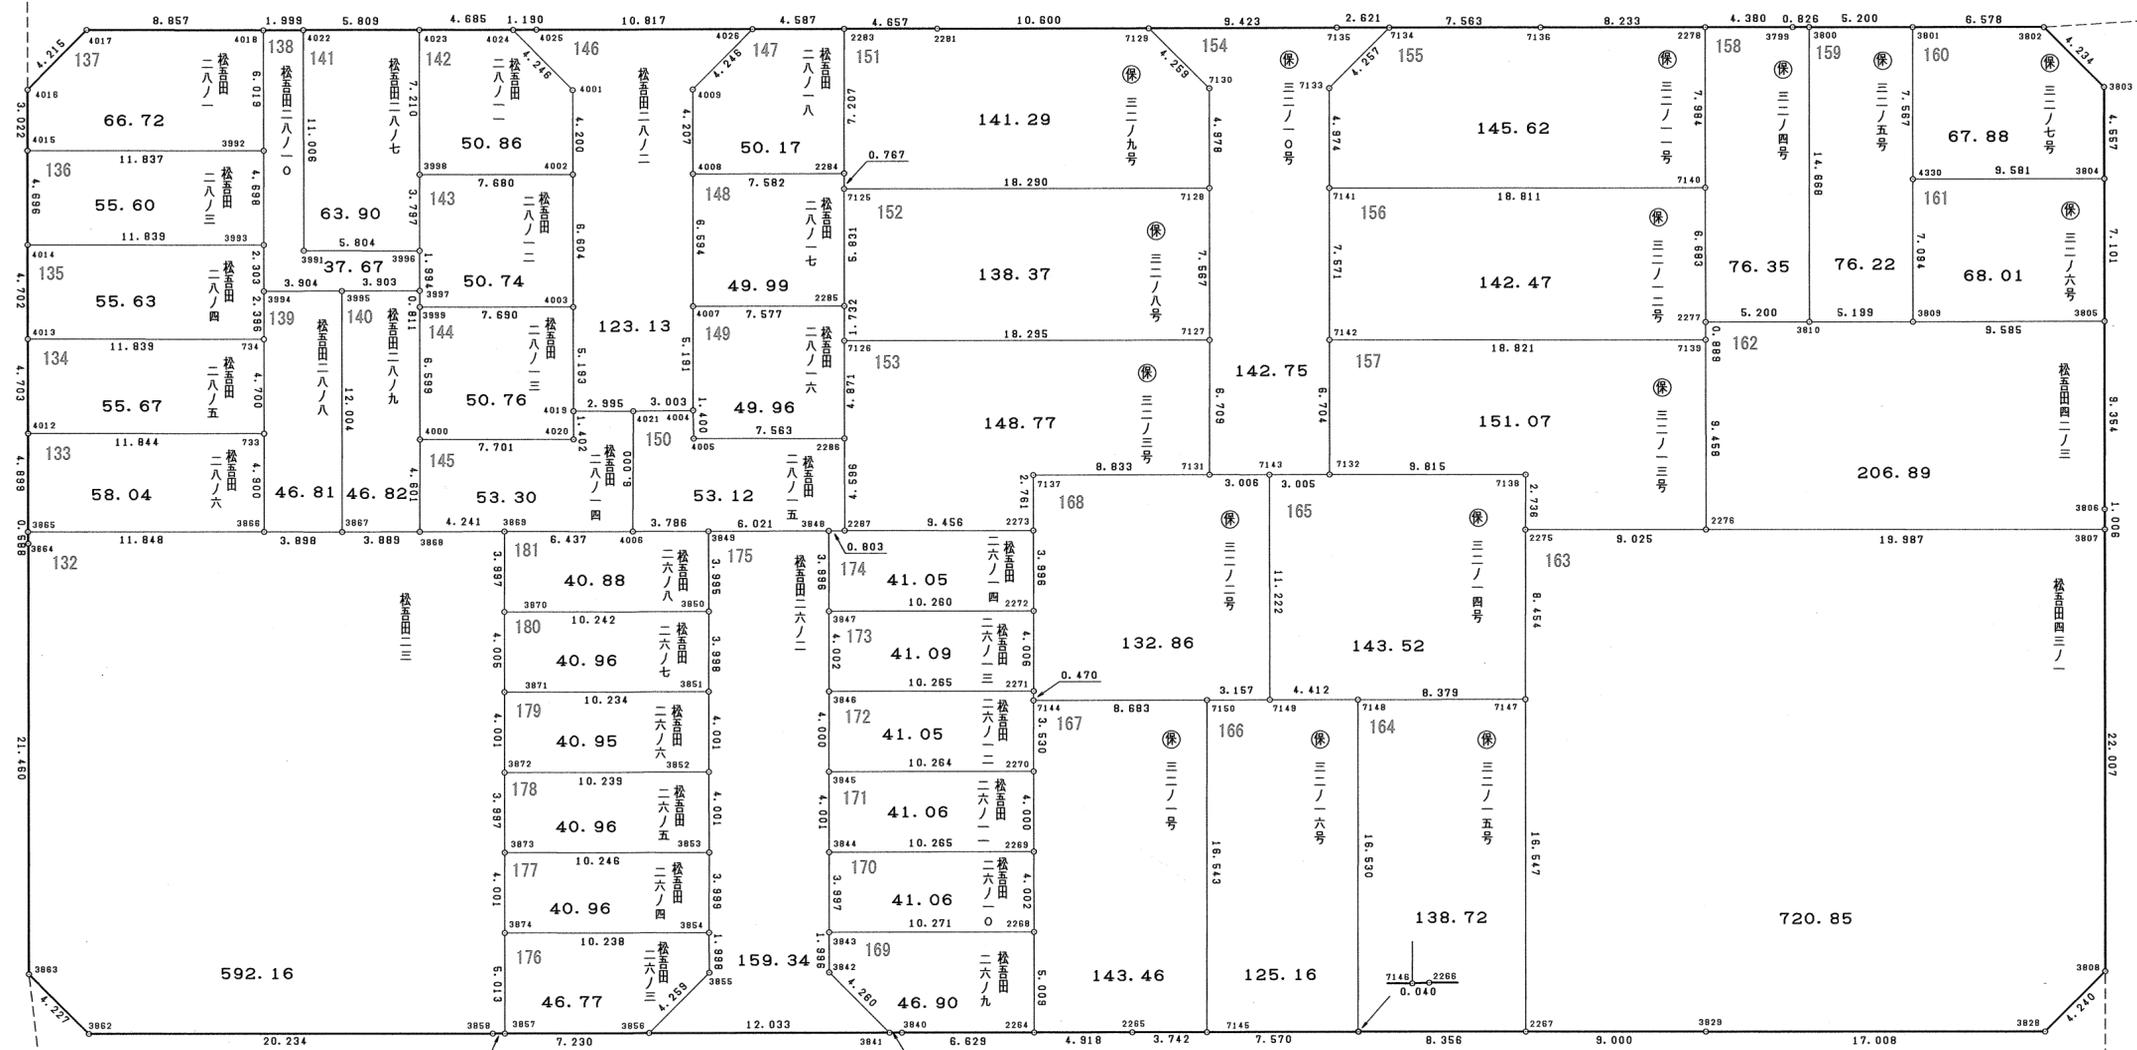

132

Table with 4 columns: NO, X, Y, 辺長. Includes area and total area (592.16 m²).

133

Table with 4 columns: NO, X, Y, 辺長. Includes area and total area (58.04 m²).

134

Table with 4 columns: NO, X, Y, 辺長. Includes area and total area (55.67 m²).

135

Table with 4 columns: NO, X, Y, 辺長. Includes area and total area (55.63 m²).

136

Table with 4 columns: NO, X, Y, 辺長. Includes area and total area (55.60 m²).

137

Table with 4 columns: NO, X, Y, 辺長. Includes area and total area (66.72 m²).

138

Table with 4 columns: NO, X, Y, 辺長. Includes area and total area (37.67 m²).

139

Table with 4 columns: NO, X, Y, 辺長. Includes area and total area (46.81 m²).

140

Table with 4 columns: NO, X, Y, 辺長. Includes area and total area (46.82 m²).

141

Table with 4 columns: NO, X, Y, 辺長. Includes area and total area (63.90 m²).

152

Table with 4 columns: NO, X, Y, 辺長. Includes area and total area (138.37 m²).

153

Table with 4 columns: NO, X, Y, 辺長. Includes area and total area (148.77 m²).

154

Table with 4 columns: NO, X, Y, 辺長. Includes area and total area (142.75 m²).

155

Table with 4 columns: NO, X, Y, 辺長. Includes area and total area (145.62 m²).

156

Table with 4 columns: NO, X, Y, 辺長. Includes area and total area (142.47 m²).

157

Table with 4 columns: NO, X, Y, 辺長. Includes area and total area (151.07 m²).

Summary table with 2 columns: 図面の種類, 画地面積求積表. Includes address: 京都市洛西第二土地区画整理組合.

158

地番	保 三二ノ四号		
N O	X	Y	辺長
2278	-111392.334	-27797.338	
7140	-111393.527	-27805.232	7.984
2277	-111394.535	-27811.839	6.683
3810	-111399.677	-27811.064	5.200
3800	-111397.482	-27796.561	14.668
3799	-111396.665	-27796.684	0.826
2278	-111392.334	-27797.338	4.380
面積	76.3567410		
地積	76.35 m ²		

159

地番	保 三二ノ五号		
N O	X	Y	辺長
3800	-111397.482	-27796.561	
3810	-111399.677	-27811.064	14.668
3809	-111404.817	-27810.286	5.199
4330	-111403.753	-27803.272	7.094
3801	-111402.625	-27795.790	7.567
3800	-111397.482	-27796.561	5.200
面積	76.2235170		
地積	76.22 m ²		

160

地番	保 三二ノ七号		
N O	X	Y	辺長
3801	-111402.625	-27795.790	
4330	-111403.753	-27803.272	7.567
3804	-111413.225	-27801.831	9.581
3803	-111412.539	-27797.326	4.557
3802	-111409.130	-27794.815	4.234
3801	-111402.625	-27795.790	6.578
面積	67.8808280		
地積	67.88 m ²		

161

地番	保 三二ノ六号		
N O	X	Y	辺長
4330	-111403.753	-27803.272	
3809	-111404.817	-27810.286	7.094
3805	-111414.294	-27808.851	9.585
3804	-111413.225	-27801.831	7.101
4330	-111403.753	-27803.272	9.581
面積	68.0161935		
地積	68.01 m ²		

162

地番	松吾田四二ノ三		
N O	X	Y	辺長
2277	-111394.535	-27811.839	
7139	-111394.666	-27812.718	0.889
2276	-111396.088	-27822.068	9.458
3807	-111415.852	-27819.093	19.987
3806	-111415.702	-27818.098	1.006
3805	-111414.294	-27808.851	9.354
3809	-111404.817	-27810.286	9.585
3810	-111399.677	-27811.064	5.199
2277	-111394.535	-27811.839	5.200
面積	206.8991230		
地積	206.89 m ²		

163

地番	松吾田四三ノ一		
N O	X	Y	辺長
2275	-111387.163	-27823.410	
7147	-111388.416	-27831.771	8.454
2267	-111390.886	-27848.133	16.547
3829	-111399.785	-27846.791	9.000
3828	-111416.604	-27844.260	17.008
3808	-111419.130	-27840.854	4.240
3807	-111415.852	-27819.093	22.007
2276	-111396.088	-27822.068	19.987
2275	-111387.163	-27823.410	9.025
面積	720.8573310		
地積	720.85 m ²		

164

地番	保 三二ノ一五号		
N O	X	Y	辺長
7148	-111380.133	-27833.038	
7146	-111382.583	-27849.385	16.530
2266	-111382.623	-27849.379	0.040
2267	-111390.886	-27848.133	8.356
7147	-111388.416	-27831.771	16.547
7148	-111380.133	-27833.038	8.379
面積	138.7263695		
地積	138.72 m ²		

165

地番	保 三二ノ一四号		
N O	X	Y	辺長
7143	-111374.086	-27822.601	
7149	-111375.770	-27833.696	11.222
7148	-111380.133	-27833.038	4.412
7147	-111388.416	-27831.771	8.379
2275	-111387.163	-27823.410	8.454
7138	-111386.765	-27820.703	2.736
7132	-111377.058	-27822.154	9.815
7143	-111374.086	-27822.601	3.005
面積	143.5270055		
地積	143.52 m ²		

166

地番	保 三二ノ一六号		
N O	X	Y	辺長
7150	-111372.648	-27834.163	
7145	-111375.099	-27850.523	16.543
7146	-111382.583	-27849.385	7.570
7148	-111380.133	-27833.038	16.530
7149	-111375.770	-27833.696	4.412
7150	-111372.648	-27834.163	3.157
面積	125.1621340		
地積	125.16 m ²		

167

地番	保 三二ノ一七号		
N O	X	Y	辺長
7144	-111364.063	-27835.463	
2270	-111364.588	-27838.954	3.530
2269	-111365.186	-27842.909	4.000
2268	-111365.789	-27846.865	4.002
2264	-111366.536	-27851.818	5.009
2265	-111371.399	-27851.085	4.918
7145	-111375.099	-27850.523	3.742
7150	-111372.648	-27834.163	16.543
7144	-111364.063	-27835.463	8.683
面積	143.4676075		
地積	143.46 m ²		

168

地番	保 三二ノ二号		
N O	X	Y	辺長
7137	-111362.378	-27824.357	
2273	-111362.799	-27827.086	2.761
2272	-111363.398	-27831.037	3.996
2271	-111363.996	-27834.998	4.006
7144	-111364.063	-27835.463	0.470
7150	-111372.648	-27834.163	8.683
7149	-111375.770	-27833.696	3.157
7143	-111374.086	-27822.601	11.222
7131	-111371.113	-27823.044	3.006
7137	-111362.378	-27824.357	8.833
面積	132.8617685		
地積	132.86 m ²		

169

地番	松吾田二六ノ九		
N O	X	Y	辺長
3843	-111355.633	-27848.397	
3842	-111355.933	-27850.370	1.996
3841	-111359.360	-27852.901	4.260
3840	-111359.981	-27852.807	0.628
2264	-111366.536	-27851.818	6.629
2268	-111365.789	-27846.865	5.009
3843	-111355.633	-27848.397	10.271
面積	46.9021435		
地積	46.90 m ²		

170

地番	松吾田二六ノ一〇		
N O	X	Y	辺長
3844	-111355.037	-27844.445	
3843	-111355.633	-27848.397	3.997
2268	-111365.789	-27846.865	10.271
2269	-111365.186	-27842.909	4.002
3844	-111355.037	-27844.445	10.265
面積	41.0626180		
地積	41.06 m ²		

171

地番	松吾田二六ノ一一		
N O	X	Y	辺長
3845	-111354.439	-27840.489	
3844	-111355.037	-27844.445	4.001
2269	-111365.186	-27842.909	10.265
2270	-111364.588	-27838.954	4.000
3845	-111354.439	-27840.489	10.264
面積	41.0625985		
地積	41.06 m ²		

172

地番	松吾田二六ノ一二		
N O	X	Y	辺長
3846	-111353.846	-27836.533	
3845	-111354.439	-27840.489	4.000
2270	-111364.588	-27838.954	10.264
7144	-111364.063	-27835.463	3.530
2271	-111363.996	-27834.998	0.470
3846	-111353.846	-27836.533	10.265
面積	41.0557955		
地積	41.05 m ²		

173

地番	松吾田二六ノ一三		
N O	X	Y	辺長
3847	-111353.254	-27832.575	
3846	-111353.846	-27836.533	4.002
2271	-111363.996	-27834.998	10.265
2272	-111363.398	-27831.037	4.006
3847	-111353.254	-27832.575	10.260
面積	41.0912640		
地積	41.09 m ²		

174

地番	松吾田二六ノ一四		
N O	X	Y	辺長
3848	-111352.656	-27828.624	
3847	-111353.254	-27832.575	3.996
2272	-111363.398	-27831.037	10.260
2273	-111362.799	-27827.086	3.996
2287	-111353.448	-27828.493	9.456
3848	-111352.656	-27828.624	0.803
面積	41.0527800		
地積	41.05 m ²		

175

地番	松吾田二六ノ二		
N O	X	Y	辺長
3849	-111346.703	-27829.527	
3850	-111347.307	-27833.476	3.995
3851	-111347.900	-27837.430	3.998
3852	-111348.499	-27841.386	4.001
3853	-111349.100	-27845.342	4.001
3854	-111349.689	-27849.297	3.999
3855	-111349.995	-27851.271	1.998
3856	-111347.461	-27854.694	4.259
3841	-111359.360	-27852.901	12.033
3842	-111355.933	-27850.370	4.260
3843	-111355.633	-27848.397	1.996
3844	-111355.037	-27844.445	3.997
3845	-111354.439	-27840.489	4.001
3846	-111353.846	-27836.533	4.000
3847	-111353.254	-27832.575	4.002
3848	-111352.656	-27828.624	3.996
3849	-111346.703	-27829.527	6.021
面積	159.3445440		
地積	159.34 m ²		

176

地番	松吾田二六ノ三		
N O	X	Y	辺長
3874	-111339.564	-27850.814	
3857	-111340.312	-27855.771	5.013
3856	-111347.461	-27854.694	7.230
3855	-111349.995	-27851.271	4.259
3854	-111349.689	-27849.297	1.998
3874	-111339.564	-27850.814	10.238
面積	46.7787460		
地積	46.77 m ²		

177

地番	松吾田二六ノ四		
N O	X	Y	辺長
3873	-111338.967	-27846.858	
3874	-111339.564	-27850.814	4.001
3854	-111349.689	-27849.297	10.238
3853	-111349.100	-27845.342	3.999
3873	-111338.967	-27846.858	10.246
面積	40.9645440		
地積	40.96 m ²		

178


地番	松吾田二六ノ五		
N O	X	Y	辺長
3872	-111338.373	-27842.905	
3873	-111338.967	-27846.858	3.997
3853	-111349.100	-27845.342	10.246
3852	-111348.499	-27841.386	4.001
3872	-111338.373	-27842.905	10.239
面積	40.9638140		
地積	40.96 m ²		

179

地番	松吾田二六ノ六		
N O	X	Y	辺長
3871	-111337.779	-27838.948	
3872	-111338.373	-27842.905	4.001
3852	-111348.499	-27841.386	10.239
3851	-111347.900	-27837.430	4.001
3871	-111337.779	-27838.948	10.234
面積	40.9594130		
地積	40.95 m ²		

180

地番	松吾田二六ノ七		
N O	X	Y	辺長
3870	-111337.177	-27834.989	

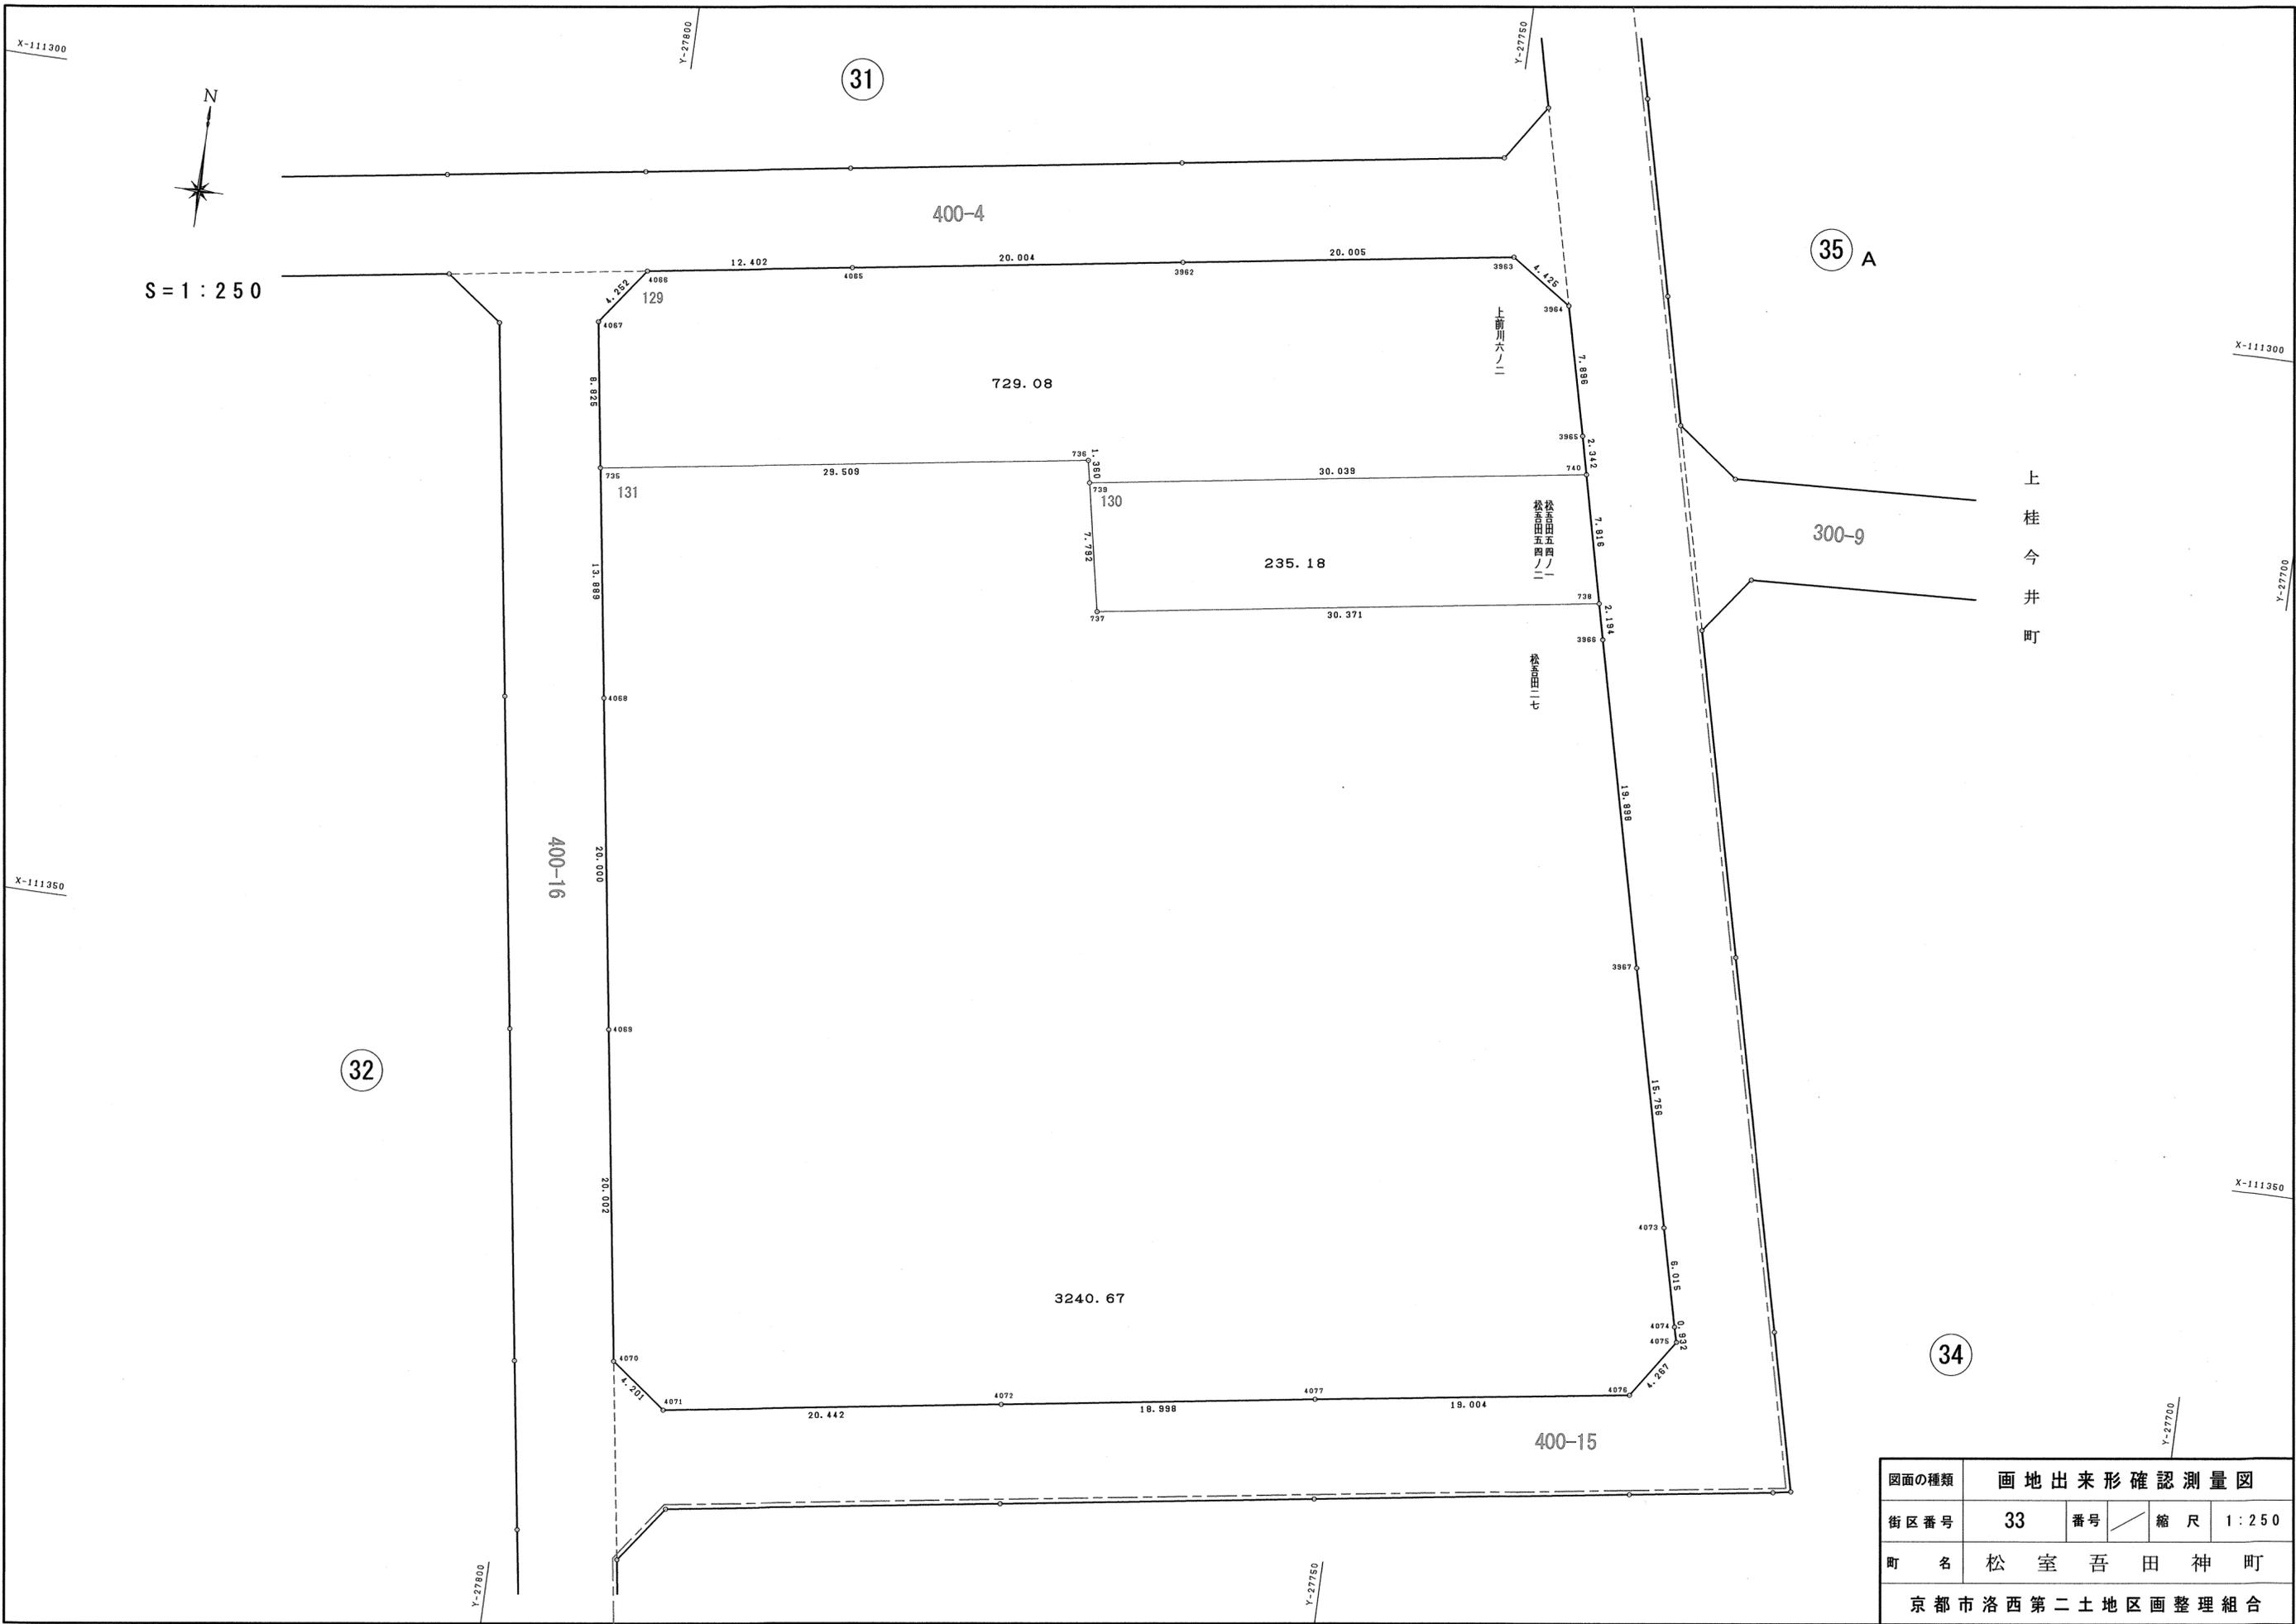

S = 1 : 250



図面の種類	画地出来形確認測量図			
街区番号	33	番号	縮尺	1 : 250
町名	松室吾田神町			
京都市洛西第二土地区画整理組合				

129

地番	上前川六ノ二		
N O	X	Y	辺長
3964	-111302.534	-27745.466	
3963	-111300.078	-27749.147	4.425
3962	-111303.076	-27768.926	20.005
4065	-111306.062	-27788.706	20.004
4066	-111307.912	-27800.969	12.402
4067	-111311.331	-27803.496	4.252
735	-111320.057	-27802.180	8.825
736	-111315.657	-27773.001	29.509
739	-111316.992	-27772.740	1.360
740	-111312.481	-27743.042	30.039
3965	-111310.204	-27743.589	2.342
3964	-111302.534	-27745.466	7.896
面積	729.0802175		
地積	729.08 m ²		

130

地番	松吾田五四ノ一, 松吾田五四ノ二		
N O	X	Y	辺長
740	-111312.481	-27743.042	
739	-111316.992	-27772.740	30.039
737	-111324.639	-27771.242	7.792
738	-111320.080	-27741.215	30.371
740	-111312.481	-27743.042	7.816
面積	235.1812750		
地積	235.18 m ²		

131

地番	松吾田二七		
N O	X	Y	辺長
738	-111320.080	-27741.215	
737	-111324.639	-27771.242	30.371
739	-111316.992	-27772.740	7.792
736	-111315.657	-27773.001	1.360
735	-111320.057	-27802.180	29.509
4068	-111333.791	-27800.109	13.889
4069	-111353.567	-27797.125	20.000
4070	-111373.346	-27794.145	20.002
4071	-111375.865	-27790.783	4.201
4072	-111372.797	-27770.573	20.442
4077	-111369.956	-27751.789	18.998
4076	-111367.144	-27732.994	19.004
4075	-111363.602	-27730.615	4.267
4074	-111362.701	-27730.855	0.932
4073	-111356.861	-27732.294	6.015
3967	-111341.548	-27736.004	15.756
3966	-111322.213	-27740.702	19.898
738	-111320.080	-27741.215	2.194
面積	3240.6740235		
地積	3240.67 m ²		

図面の種類	画地面積求積表		
街区番号	33	番号	/
町名	松室吾田神町		
京都市洛西第二土地区画整理組合			

178

地番 上今井二五ノ三			
NO	X	Y	辺長
4098	-111317.432	-27732.312	
4097	-111320.845	-27734.846	4.251
743	-111327.697	-27733.186	7.050
742	-111322.027	-27709.781	24.082
741	-111316.433	-27711.137	5.756
4099	-111316.490	-27712.337	1.201
4098	-111317.432	-27732.312	19.997
面積	189.0623560		
地積	189.06 m ²		

179

地番 上今井二七, 上今井四三ノ一			
NO	X	Y	辺長
743	-111327.697	-27733.186	
4096	-111340.125	-27730.174	12.788
4105	-111362.194	-27724.816	22.710
4106	-111371.586	-27722.535	9.665
4107	-111371.777	-27723.592	1.074
744	-111371.850	-27724.076	0.489
745	-111405.658	-27715.899	34.783
746	-111393.854	-27667.124	50.183
4080	-111388.910	-27667.122	4.944
4079	-111386.038	-27667.814	2.954
4078	-111363.392	-27673.293	23.299
4088	-111351.152	-27676.260	12.594
4089	-111333.178	-27680.608	18.492
4090	-111318.106	-27684.268	15.510
4091	-111315.329	-27687.980	4.636
741	-111316.433	-27711.137	23.183
742	-111322.027	-27709.781	5.756
743	-111327.697	-27733.186	24.082
面積	4107.1911015		
地積	4107.19 m ²		

180

地番 上今井四三ノ二			
NO	X	Y	辺長
745	-111405.658	-27715.899	
747	-111418.870	-27712.703	13.593
4113	-111418.987	-27711.642	1.067
4112	-111418.889	-27708.628	3.016
4085	-111417.742	-27702.365	6.367
4084	-111420.706	-27701.815	3.015
4082	-111420.675	-27667.111	34.704
4081	-111410.724	-27667.130	9.951
746	-111393.854	-27667.124	16.870
745	-111405.658	-27715.899	50.183
面積	971.3008465		
地積	971.30 m ²		

181

地番 上今井四五, 上今井四七			
NO	X	Y	辺長
4082	-111420.675	-27667.111	
4084	-111420.706	-27701.815	34.704
4155	-111443.669	-27697.549	23.356
4154	-111447.490	-27697.491	3.821
4134	-111447.471	-27667.073	30.418
4083	-111432.568	-27667.089	14.903
4082	-111420.675	-27667.111	11.893
面積	864.9482380		
地積	864.94 m ²		

182

地番 上今井二四ノ二			
NO	X	Y	辺長
4134	-111447.471	-27667.073	
4154	-111447.490	-27697.491	30.418
4145	-111457.992	-27697.341	10.503
4144	-111457.813	-27695.399	1.950
4143	-111457.706	-27694.025	1.378
4150	-111455.215	-27691.949	3.243
4151	-111454.946	-27685.926	6.029
4152	-111454.830	-27679.904	6.023
4153	-111454.899	-27673.862	6.042
4137	-111455.095	-27668.203	5.662
4136	-111455.129	-27667.802	0.402
4135	-111454.392	-27667.066	1.042
4134	-111447.471	-27667.073	6.921
面積	239.7213460		
地積	239.72 m ²		

183

地番 松吾田三五ノ四			
NO	X	Y	辺長
4085	-111417.742	-27702.365	
4112	-111418.889	-27708.628	6.367
4113	-111418.987	-27711.642	3.016
747	-111418.870	-27712.703	1.067
4087	-111418.276	-27718.112	5.442
4086	-111420.675	-27727.755	9.937
4114	-111425.704	-27729.532	5.334
4130	-111439.696	-27731.402	14.116
4131	-111448.976	-27732.636	9.362
4132	-111462.477	-27730.386	13.687
4133	-111462.420	-27729.996	0.394
4149	-111459.101	-27707.282	22.955
4147	-111458.360	-27701.347	5.981
4145	-111457.992	-27697.341	4.023
4154	-111447.490	-27697.491	10.503
4155	-111443.669	-27697.549	3.821
4084	-111420.706	-27701.815	23.356
4085	-111417.742	-27702.365	3.015
面積	1315.8290585		
地積	1315.82 m ²		

184

地番 松吾田三五ノ九			
NO	X	Y	辺長
9496	-111441.357	-27742.719	
12750	-111448.978	-27741.603	7.702
12751	-111448.857	-27740.796	0.816
12748	-111448.123	-27735.774	5.075
12747	-111462.903	-27733.305	14.985
4132	-111462.477	-27730.386	2.950
4131	-111448.976	-27732.636	13.687
4130	-111439.696	-27731.402	9.362
9496	-111441.357	-27742.719	11.438
面積	124.1414380		
地積	124.14 m ²		

185

地番 松吾田三五ノ七			
NO	X	Y	辺長
12751	-111448.857	-27740.796	
12746	-111463.637	-27738.334	14.984
12747	-111462.903	-27733.305	5.082
12748	-111448.123	-27735.774	14.985
12751	-111448.857	-27740.796	5.075
面積	76.0865670		
地積	76.08 m ²		

186

地番 松吾田三五ノ一			
NO	X	Y	辺長
12749	-111449.587	-27745.796	
12745	-111464.366	-27743.330	14.983
12746	-111463.637	-27738.334	5.049
12751	-111448.857	-27740.796	14.984
12750	-111448.978	-27741.603	0.816
12749	-111449.587	-27745.796	4.237
面積	75.6574840		
地積	75.65 m ²		

187

地番 松吾田三五ノ一〇			
NO	X	Y	辺長
12744	-111450.141	-27749.585	
12743	-111462.027	-27750.116	11.898
12742	-111465.417	-27750.520	3.414
4127	-111465.309	-27749.787	0.741
12745	-111464.366	-27743.330	6.525
12749	-111449.587	-27745.796	14.983
12744	-111450.141	-27749.585	3.829
面積	81.6037795		
地積	81.60 m ²		

188

地番 松吾田三五ノ八			
NO	X	Y	辺長
4129	-111442.751	-27752.217	
748	-111453.033	-27752.671	10.292
4128	-111461.789	-27753.058	8.765
4126	-111465.861	-27753.546	4.101
12742	-111465.417	-27750.520	3.058
12743	-111462.027	-27750.116	3.414
12744	-111450.141	-27749.585	11.898
12749	-111449.587	-27745.796	3.829
12750	-111448.978	-27741.603	4.237
9496	-111441.357	-27742.719	7.702
4129	-111442.751	-27752.217	9.600
面積	124.7806775		
地積	124.78 m ²		

189

地番 松吾田三八ノ四			
NO	X	Y	辺長
4124	-111465.765	-27773.356	
4125	-111468.214	-27769.566	4.512
4126	-111465.861	-27753.546	16.192
4128	-111461.789	-27753.058	4.101
748	-111453.033	-27752.671	8.765
749	-111456.446	-27775.997	23.574
4124	-111465.765	-27773.356	9.686
面積	265.7216605		
地積	265.72 m ²		

190

地番 松吾田三七, 松吾田三八ノ一〇			
NO	X	Y	辺長
751	-111415.467	-27787.581	
4119	-111419.325	-27786.489	4.010
4201	-111433.270	-27782.549	14.491
4202	-111452.523	-27777.109	20.007
749	-111456.446	-27775.997	4.078
748	-111453.033	-27752.671	23.574
4129	-111442.751	-27752.217	10.292
4123	-111425.814	-27751.414	16.903
4122	-111427.893	-27765.472	14.203
752	-111412.451	-27767.630	15.592
751	-111415.467	-27787.581	20.178
面積	1042.7927530		
地積	1042.79 m ²		

191

地番 松吾田三八ノ五			
NO	X	Y	辺長
4118	-111381.762	-27789.840	
4117	-111385.177	-27792.351	4.239
4116	-111395.858	-27790.736	10.802
4115	-111413.988	-27787.999	18.335
751	-111415.467	-27787.581	1.537
752	-111412.451	-27767.630	20.178
4121	-111409.880	-27767.989	2.596
4120	-111410.067	-27768.994	1.022
9264	-111391.805	-27771.629	18.451
4111	-111379.291	-27773.435	12.644
4118	-111381.762	-27789.840	16.590
面積	653.3851405		
地積	653.38 m ²		

192

地番 松吾田三八ノ一			
NO	X	Y	辺長
4111	-111379.291	-27773.435	
9264	-111391.805	-27771.629	12.644
9265	-111391.263	-27768.031	3.639
4110	-111378.749	-27769.837	12.644
4111	-111379.291	-27773.435	3.639
面積	46.0042240		
地積	46.00 m ²		

193


地番 松吾田三四, 三五ノ六, 三八ノ三, 三八ノ六, 三八ノ八, 三八ノ九			
NO	X	Y	辺長
744	-111371.850	-27724.076	
4108	-111373.070	-27732.194	8.209
4109	-111375.922	-27751.029	19.050
4110	-111378.749	-27769.837	19.019
9265	-111391.263	-27768.031	12.644
9264	-111391.805	-27771.629	3.639
4120	-111410.067	-27768.994	18.451
4121	-111409.880	-27767.989	1.022
752	-111412.451	-27767.630	2.596
4122	-111427.893	-27765.472	15.592
4123	-111425.867	-27751.414	14.203
4129	-111442.751	-27752.217	16.903
9496	-111441.357	-27742.719	9.600
4130	-111439.696	-27731.402	11.438
4114	-111425.704	-27729.532	14.116
4086	-111420.675	-27727.755	5.334
4087	-111418.276	-27718.112	9.937
747	-111418.870	-27712.703	5.442
745	-111405.658	-27715.899	13.593
744	-111371.850	-27724.076	34.783
面積	2845.4016465		
地積	2845.40 m ²		

地番	上今井一七, 一八, 一九, 二三ノ一, 二四ノ四 二八, 三五ノ一, 上北ノ口二		
NO	X	Y	辺長
4156	-111241.417	-27702.850	
4157	-111239.991	-27705.178	2.730
4158	-111240.073	-27705.584	0.414
4161	-111242.402	-27716.800	11.455
4163	-111246.507	-27737.148	20.758
4165	-111248.369	-27745.558	8.614
4185	-111248.754	-27749.708	4.168
4186	-111248.801	-27750.071	0.366
4187	-111251.095	-27751.776	2.858
4188	-111270.085	-27747.151	19.545
4104	-111289.528	-27742.440	20.006
4103	-111301.151	-27739.617	11.961
4102	-111308.776	-27737.783	7.842
4101	-111311.530	-27734.085	4.611
4100	-111310.512	-27712.623	21.486
4092	-111309.417	-27689.715	22.934
4093	-111306.014	-27687.210	4.226
4094	-111284.489	-27692.413	22.145
4095	-111262.966	-27697.633	22.147
4156	-111241.417	-27702.850	22.172
面積	3362.6388210		
地積	3362.63 m ²		


図面の種類	画地面積求積表			
街区番号	35A	番号	/	
町名	上桂今井町			
京都市洛西第二土地区画整理組合				

地番	上前川六ノ四, 七ノ一 上今井一六, 二四ノ一, 二四ノ三		
NO	X	Y	辺長
4197	-111252.370	-27631.628	
4198	-111248.871	-27635.285	5.061
4199	-111245.966	-27650.266	15.260
4200	-111244.616	-27658.359	8.205
4180	-111244.870	-27663.369	5.016
4177	-111241.630	-27682.729	19.629
4175	-111239.203	-27692.213	9.790
4172	-111238.910	-27694.494	2.300
4171	-111238.869	-27694.845	0.353
4170	-111241.036	-27696.786	2.909
4169	-111261.625	-27691.768	21.192
4189	-111283.160	-27686.561	22.156
4190	-111304.496	-27681.398	21.952
4191	-111306.708	-27677.788	4.234
4192	-111301.968	-27658.340	20.017
4193	-111297.249	-27638.903	20.002
4194	-111293.798	-27624.644	14.671
4195	-111290.169	-27622.466	4.232
4196	-111271.268	-27627.054	19.450
4197	-111252.370	-27631.628	19.444
面積	3487.6360950		
地積	3487.63 m ²		

図面の種類	画地面積求積表		
街区番号	35B	番号	／
町名	上桂今井町		
京都市洛西第二土地区画整理組合			

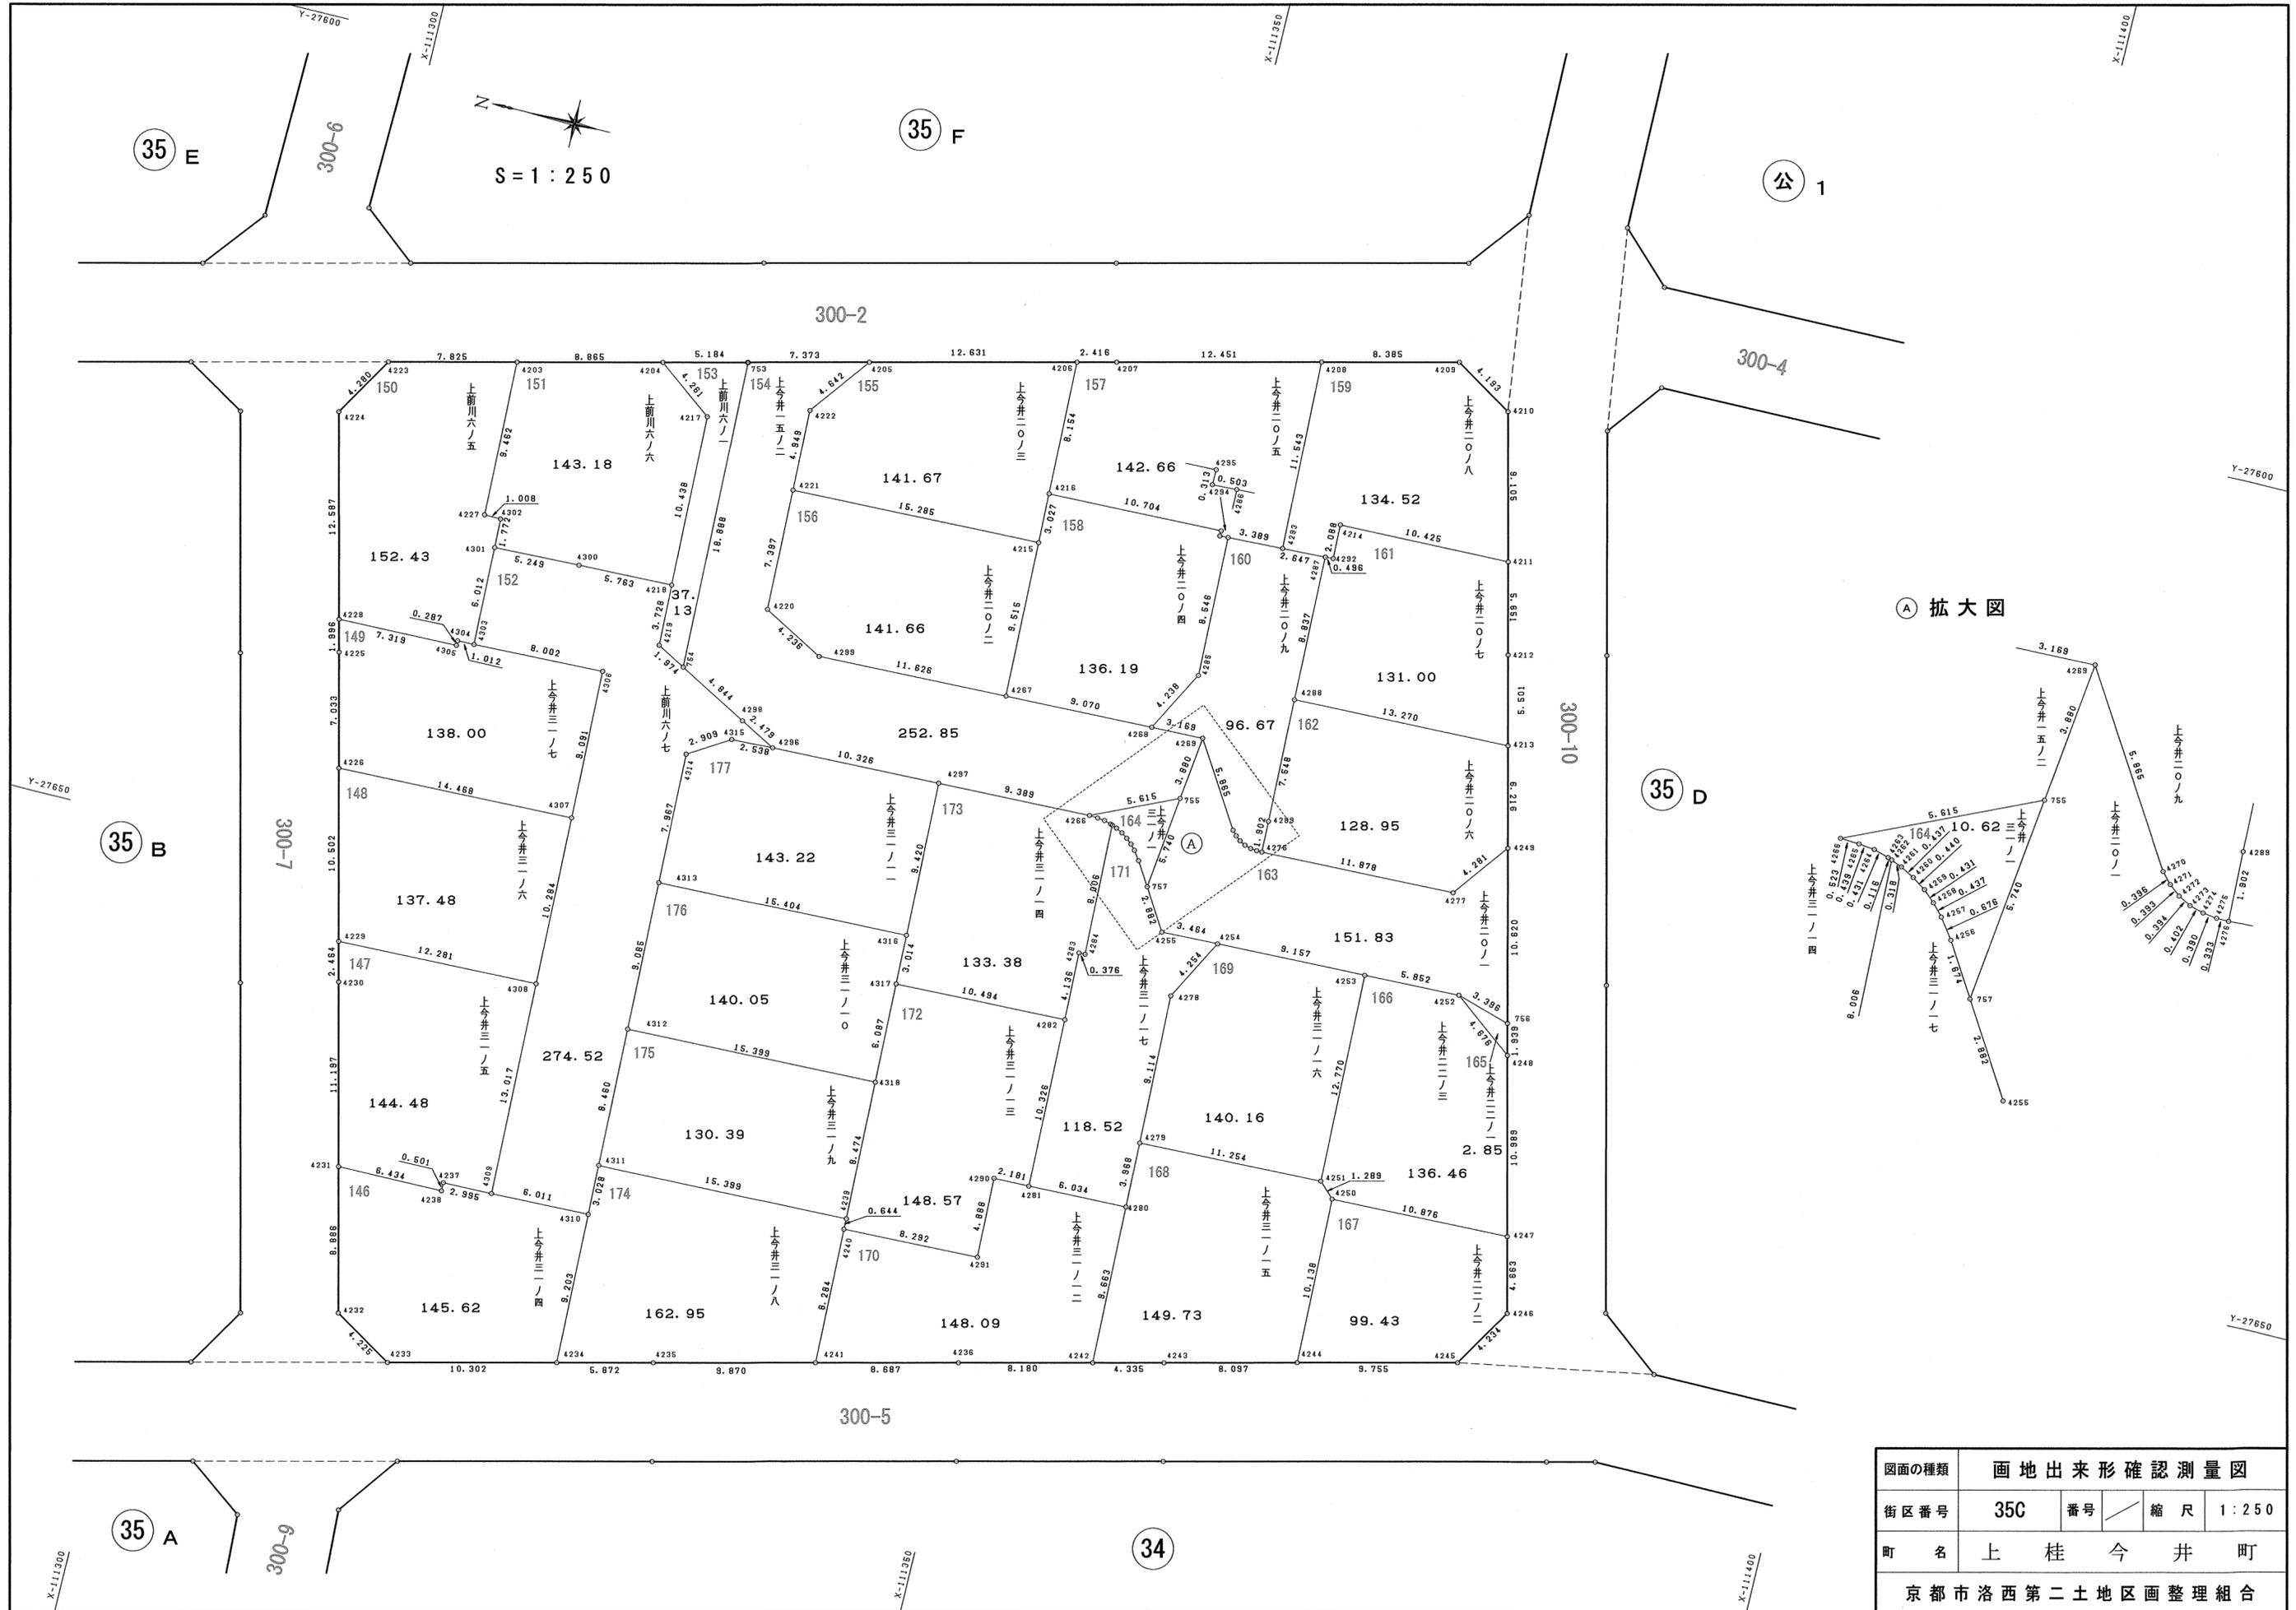

Ⓐ 拡大図

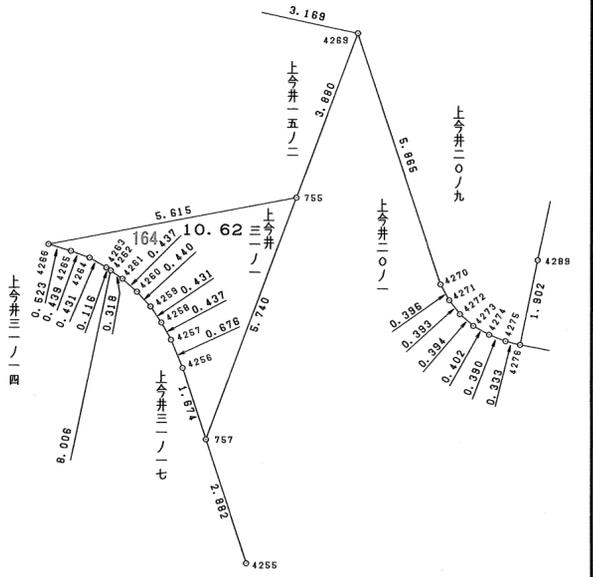

図面の種類	画地出来形確認測量図		
街区番号	35C	番号	縮尺 1:250
町名	上桂今井町		
京都市洛西第二土地区画整理組合			

146

地番 上今井三一ノ四				
NO	X	Y	辺長	
4231	-111310.414	-27667.754		
4232	-111312.503	-27676.391	8.886	
4233	-111316.111	-27678.590	4.225	
4234	-111326.124	-27676.166	10.302	
4310	-111325.852	-27666.967	9.203	
4309	-111319.843	-27667.140	6.011	
4237	-111316.849	-27667.197	2.995	
4238	-111316.848	-27667.698	0.501	
4231	-111310.414	-27667.754	6.434	
面積	145.6215005			
地積	145.62 m ²			

147

地番 上今井三一ノ五				
NO	X	Y	辺長	
4229	-111307.202	-27654.476		
4230	-111307.781	-27656.871	2.464	
4231	-111310.414	-27667.754	11.197	
4238	-111316.848	-27667.698	6.434	
4237	-111316.849	-27667.197	0.501	
4309	-111319.843	-27667.140	2.995	
4308	-111319.478	-27654.128	13.017	
4229	-111307.202	-27654.476	12.281	
面積	144.4800275			
地積	144.48 m ²			

148

地番 上今井三一ノ六				
NO	X	Y	辺長	
4226	-111304.733	-27644.268		
4229	-111307.202	-27654.476	10.502	
4308	-111319.478	-27654.128	12.281	
4307	-111319.195	-27643.848	10.284	
4226	-111304.733	-27644.268	14.468	
面積	137.4804200			
地積	137.48 m ²			

149

地番 上今井三一ノ七				
NO	X	Y	辺長	
4228	-111302.605	-27635.493		
4225	-111303.079	-27637.432	1.996	
4226	-111304.733	-27644.268	7.033	
4307	-111319.195	-27643.848	14.468	
4306	-111318.936	-27634.761	9.091	
4303	-111310.939	-27635.032	8.002	
4304	-111309.927	-27635.049	1.012	
4305	-111309.922	-27635.336	0.287	
4228	-111302.605	-27635.493	7.319	
面積	138.0039000			
地積	138.00 m ²			

150

地番 上前川六ノ五				
NO	X	Y	辺長	
4223	-111301.844	-27619.612		
4224	-111299.616	-27623.266	4.280	
4228	-111302.605	-27635.493	12.587	
4305	-111309.922	-27635.336	7.319	
4304	-111309.927	-27635.049	0.287	
4303	-111310.939	-27635.032	1.012	
4301	-111310.769	-27629.022	6.012	
4302	-111310.715	-27627.251	1.772	
4227	-111309.707	-27627.229	1.008	
4203	-111309.449	-27617.771	9.462	
4223	-111301.844	-27619.612	7.825	
面積	152.4383400			
地積	152.43 m ²			

151

地番 上前川六ノ六				
NO	X	Y	辺長	
4203	-111309.449	-27617.771		
4227	-111309.707	-27627.229	9.462	
4302	-111310.715	-27627.251	1.008	
4301	-111310.769	-27629.022	1.772	
4300	-111316.015	-27628.846	5.249	
4218	-111321.776	-27628.682	5.763	
4217	-111321.469	-27618.249	10.438	
4204	-111318.065	-27615.686	4.261	
4203	-111309.449	-27617.771	8.865	
面積	143.1854245			
地積	143.18 m ²			

152

地番 上前川六ノ七				
NO	X	Y	辺長	
4301	-111310.769	-27629.022		
4303	-111310.939	-27635.032	6.012	
4306	-111318.936	-27634.761	8.002	
4307	-111319.195	-27634.848	9.091	
4308	-111319.478	-27654.128	10.284	
4309	-111319.843	-27667.140	13.017	
4310	-111325.852	-27666.967	6.011	
4311	-111325.780	-27663.940	3.028	
4312	-111325.538	-27655.483	8.460	
4313	-111325.273	-27646.402	9.085	
4314	-111325.061	-27638.438	7.967	
4315	-111327.539	-27636.915	2.909	
4296	-111330.076	-27636.835	2.538	
4298	-111327.896	-27635.654	2.479	
754	-111323.636	-27633.348	4.844	
4219	-111321.900	-27632.408	1.974	
4218	-111321.776	-27628.682	3.728	
4300	-111316.015	-27628.846	5.763	
4301	-111310.769	-27629.022	5.249	
面積	274.5216400			
地積	274.52 m ²			

153

地番 上前川六ノ一				
NO	X	Y	辺長	
4204	-111318.065	-27615.686		
4217	-111321.469	-27618.249	4.261	
4218	-111321.776	-27628.682	10.438	
4219	-111321.900	-27632.408	3.728	
754	-111323.636	-27633.348	1.974	
753	-111323.104	-27614.467	18.888	
4204	-111318.065	-27615.686	5.184	
面積	37.1357930			
地積	37.13 m ²			

154

地番 上今井一五ノ二				
NO	X	Y	辺長	
753	-111323.104	-27614.467		
754	-111323.636	-27633.348	18.888	
4298	-111327.896	-27635.654	4.844	
4296	-111330.076	-27636.835	2.479	
4297	-111340.398	-27636.552	10.326	
4266	-111349.783	-27636.281	9.389	
755	-111354.899	-27633.967	5.615	
4269	-111355.365	-27630.115	3.880	
4268	-111352.197	-27630.195	3.169	
4267	-111343.130	-27630.445	9.070	
4299	-111331.509	-27630.784	11.626	
4220	-111327.788	-27628.759	4.236	
4221	-111327.586	-27621.365	7.397	
4222	-111327.446	-27616.418	4.949	
4205	-111330.270	-27612.734	4.642	
753	-111323.104	-27614.467	7.373	
面積	252.8514805			
地積	252.85 m ²			

155

地番 上今井二〇ノ三				
NO	X	Y	辺長	
4205	-111330.270	-27612.734		
4222	-111327.446	-27616.418	4.642	
4221	-111327.586	-27621.365	4.949	
4215	-111342.865	-27620.934	15.285	
4216	-111342.778	-27617.908	3.027	
4206	-111342.545	-27609.757	8.154	
4205	-111330.270	-27612.734	12.631	
面積	141.6742845			
地積	141.67 m ²			

156

地番 上今井二〇ノ二				
NO	X	Y	辺長	
4221	-111327.586	-27621.365		
4220	-111327.788	-27628.759	7.397	
4299	-111331.509	-27630.784	4.236	
4267	-111343.130	-27630.445	11.626	
4215	-111342.865	-27620.934	9.515	
4221	-111327.586	-27621.365	15.285	
面積	141.6624520			
地積	141.66 m ²			

157

地番 上今井二〇ノ五				
NO	X	Y	辺長	
4206	-111342.545	-27609.757		
4216	-111342.778	-27617.908	8.154	
4295	-111353.478	-27617.631	10.704	
4294	-111353.475	-27617.944	0.313	
4286	-111353.978	-27617.923	0.503	
4293	-111357.365	-27617.794	3.389	
4208	-111356.994	-27606.257	11.543	
4207	-111344.893	-27609.187	12.451	
4206	-111342.545	-27609.757	2.416	
面積	142.6649115			
地積	142.66 m ²			

158

地番 上今井二〇ノ四				
NO	X	Y	辺長	
4216	-111342.778	-27617.908		
4215	-111342.865	-27620.934	3.027	
4267	-111343.130	-27630.445	9.515	
4268	-111352.197	-27630.195	9.070	
4285	-111354.211	-27626.466	4.238	
4286	-111353.978	-27617.923	8.546	
4294	-111353.475	-27617.944	0.503	
4295	-111353.478	-27617.631	0.313	
4216	-111342.778	-27617.908	10.704	
面積	136.1942550			
地積	136.19 m ²			

159

地番 上今井二〇ノ八				
NO	X	Y	辺長	
4208	-111356.994	-27606.257		
4293	-111357.365	-27617.794	11.543	
4287	-111360.010	-27617.695	2.647	
4292	-111360.505	-27617.667	0.496	
4214	-111360.440	-27615.580	2.088	
4211	-111370.862	-27615.339	10.425	
4210	-111368.709	-27606.492	9.105	
4209	-111365.144	-27604.284	4.193	
4208	-111356.994	-27606.257	8.385	
面積	134.5222730			
地積	134.52 m ²			

160

地番 上今井二〇ノ九				
NO	X	Y	辺長	
4286	-111353.978	-27617.923		
4285	-111354.211	-27626.466	8.546	
4268	-111352.197	-27630.195	4.238	
4269	-111355.365	-27630.115	3.169	
4270	-111358.469	-27635.091	5.865	
4271	-111358.737	-27635.383	0.396	
4272	-111359.046	-27635.626	0.393	
4273	-111359.396	-27635.808	0.394	
4274	-111359.782	-27635.919	0.402	
4275	-111360.169	-27635.971	0.390	
4276	-111360.502	-27635.975	0.333	
4289	-111360.441	-27634.074	1.902	
4288	-111360.230	-27626.529	7.548	
4287	-111360.010	-27617.695	8.837	
4293	-111357.365	-27617.794	2.647	
4286	-111353.978	-27617.923	3.389	
面積	96.6771420			
地積	96.67 m ²			

161

地番 上今井二〇ノ七				
NO	X	Y	辺長	
4214	-111360.440	-27615.580		
4292	-111360.505	-27617.667	2.088	
4287	-111360.010	-27617.695	0.496	
4288	-111360.230	-27626.529	8.837	
4213	-111373.495	-27626.176	13.270	
4212	-111372.199	-27620.830	5.501	
4211	-111370.862	-27615.339	5.651	
4214	-111360.440	-27615.580	10.425	
面積	131.0012115			
地積	131.00 m ²			

162

地番 上今井二〇ノ六				
NO	X	Y	辺長	
4288	-111360.230	-27626.529		
4289	-111360.441	-27634.074	7.548	
42				

170

地番 上今井三ノ一			
NO	X	Y	辺長
4240	-111341.185	-27664.181	
4241	-111341.424	-27672.462	8.284
4236	-111349.867	-27670.419	8.687
4242	-111357.817	-27668.491	8.180
4280	-111357.545	-27658.832	9.663
4281	-111351.513	-27658.992	6.034
4290	-111349.332	-27659.037	2.181
4291	-111349.473	-27663.923	4.888
4240	-111341.185	-27664.181	8.292
面積	148.0901975		
地積	148.09 m ²		

171

地番 上今井三ノ一七			
NO	X	Y	辺長
4262	-111351.265	-27636.521	
4284	-111351.505	-27644.523	8.006
4283	-111351.129	-27644.535	0.376
4282	-111351.247	-27648.669	4.136
4281	-111351.513	-27658.992	10.326
4280	-111357.545	-27658.832	6.034
4279	-111357.444	-27654.865	3.968
4278	-111357.174	-27645.755	9.114
4254	-111359.188	-27642.008	4.254
4255	-111355.726	-27642.117	3.464
757	-111354.210	-27639.666	2.882
4256	-111353.330	-27638.242	1.674
4257	-111352.932	-27637.695	0.676
4258	-111352.635	-27637.375	0.437
4259	-111352.313	-27637.089	0.431
4260	-111351.947	-27636.844	0.440
4261	-111351.560	-27636.641	0.437
4262	-111351.265	-27636.521	0.318
面積	118.5294990		
地積	118.52 m ²		

172

地番 上今井三ノ一三			
NO	X	Y	辺長
4317	-111340.758	-27648.981	
4318	-111340.931	-27655.066	6.087
4239	-111341.174	-27663.537	8.474
4240	-111341.185	-27664.181	0.644
4291	-111349.473	-27663.923	8.292
4290	-111349.332	-27659.037	4.888
4281	-111351.513	-27658.992	2.181
4282	-111351.247	-27648.669	10.326
4317	-111340.758	-27648.981	10.494
面積	148.5733615		
地積	148.57 m ²		

173

地番 上今井三ノ一四			
NO	X	Y	辺長
4297	-111340.398	-27636.552	
4316	-111340.671	-27645.968	9.420
4317	-111340.758	-27648.981	3.014
4282	-111351.247	-27648.669	10.494
4283	-111351.129	-27644.535	4.136
4284	-111351.505	-27644.523	0.376
4262	-111351.265	-27636.521	8.006
4263	-111351.155	-27636.483	0.116
4264	-111350.741	-27636.362	0.431
4265	-111350.305	-27636.310	0.439
4266	-111349.783	-27636.281	0.523
4297	-111340.398	-27636.552	9.389
面積	133.3865400		
地積	133.38 m ²		

174

地番 上今井三ノ一八			
NO	X	Y	辺長
4311	-111325.780	-27663.940	
4310	-111325.852	-27666.967	3.028
4234	-111326.124	-27676.166	9.203
4235	-111331.831	-27674.784	5.872
4241	-111341.424	-27672.462	9.870
4240	-111341.185	-27664.181	8.284
4239	-111341.174	-27663.537	0.644
4311	-111325.780	-27663.940	15.399
面積	162.9582475		
地積	162.95 m ²		

175

地番 上今井三ノ一九			
NO	X	Y	辺長
4312	-111325.538	-27655.483	
4311	-111325.780	-27663.940	8.460
4239	-111341.174	-27663.537	15.399
4318	-111340.931	-27655.066	8.474
4312	-111325.538	-27655.483	15.399
面積	130.3900090		
地積	130.39 m ²		


176

地番 上今井三ノ一〇			
NO	X	Y	辺長
4313	-111325.273	-27646.402	
4312	-111325.538	-27655.483	9.085
4318	-111340.931	-27655.066	15.399
4317	-111340.758	-27648.981	6.087
4316	-111340.671	-27645.968	3.014
4313	-111325.273	-27646.402	15.404
面積	140.0531640		
地積	140.05 m ²		

177

地番 上今井三ノ一一			
NO	X	Y	辺長
4315	-111327.539	-27636.915	
4314	-111325.061	-27638.438	2.909
4313	-111325.273	-27646.402	7.967
4316	-111340.671	-27645.968	15.404
4297	-111340.398	-27636.552	9.420
4296	-111330.076	-27636.835	10.326
4315	-111327.539	-27636.915	2.538
面積	143.2211410		
地積	143.22 m ²		

図面の種類	画地面積求積表		
街区番号	35C	番号	2/2
町名	上桂今井町		
京都市洛西第二土地区画整理組合			

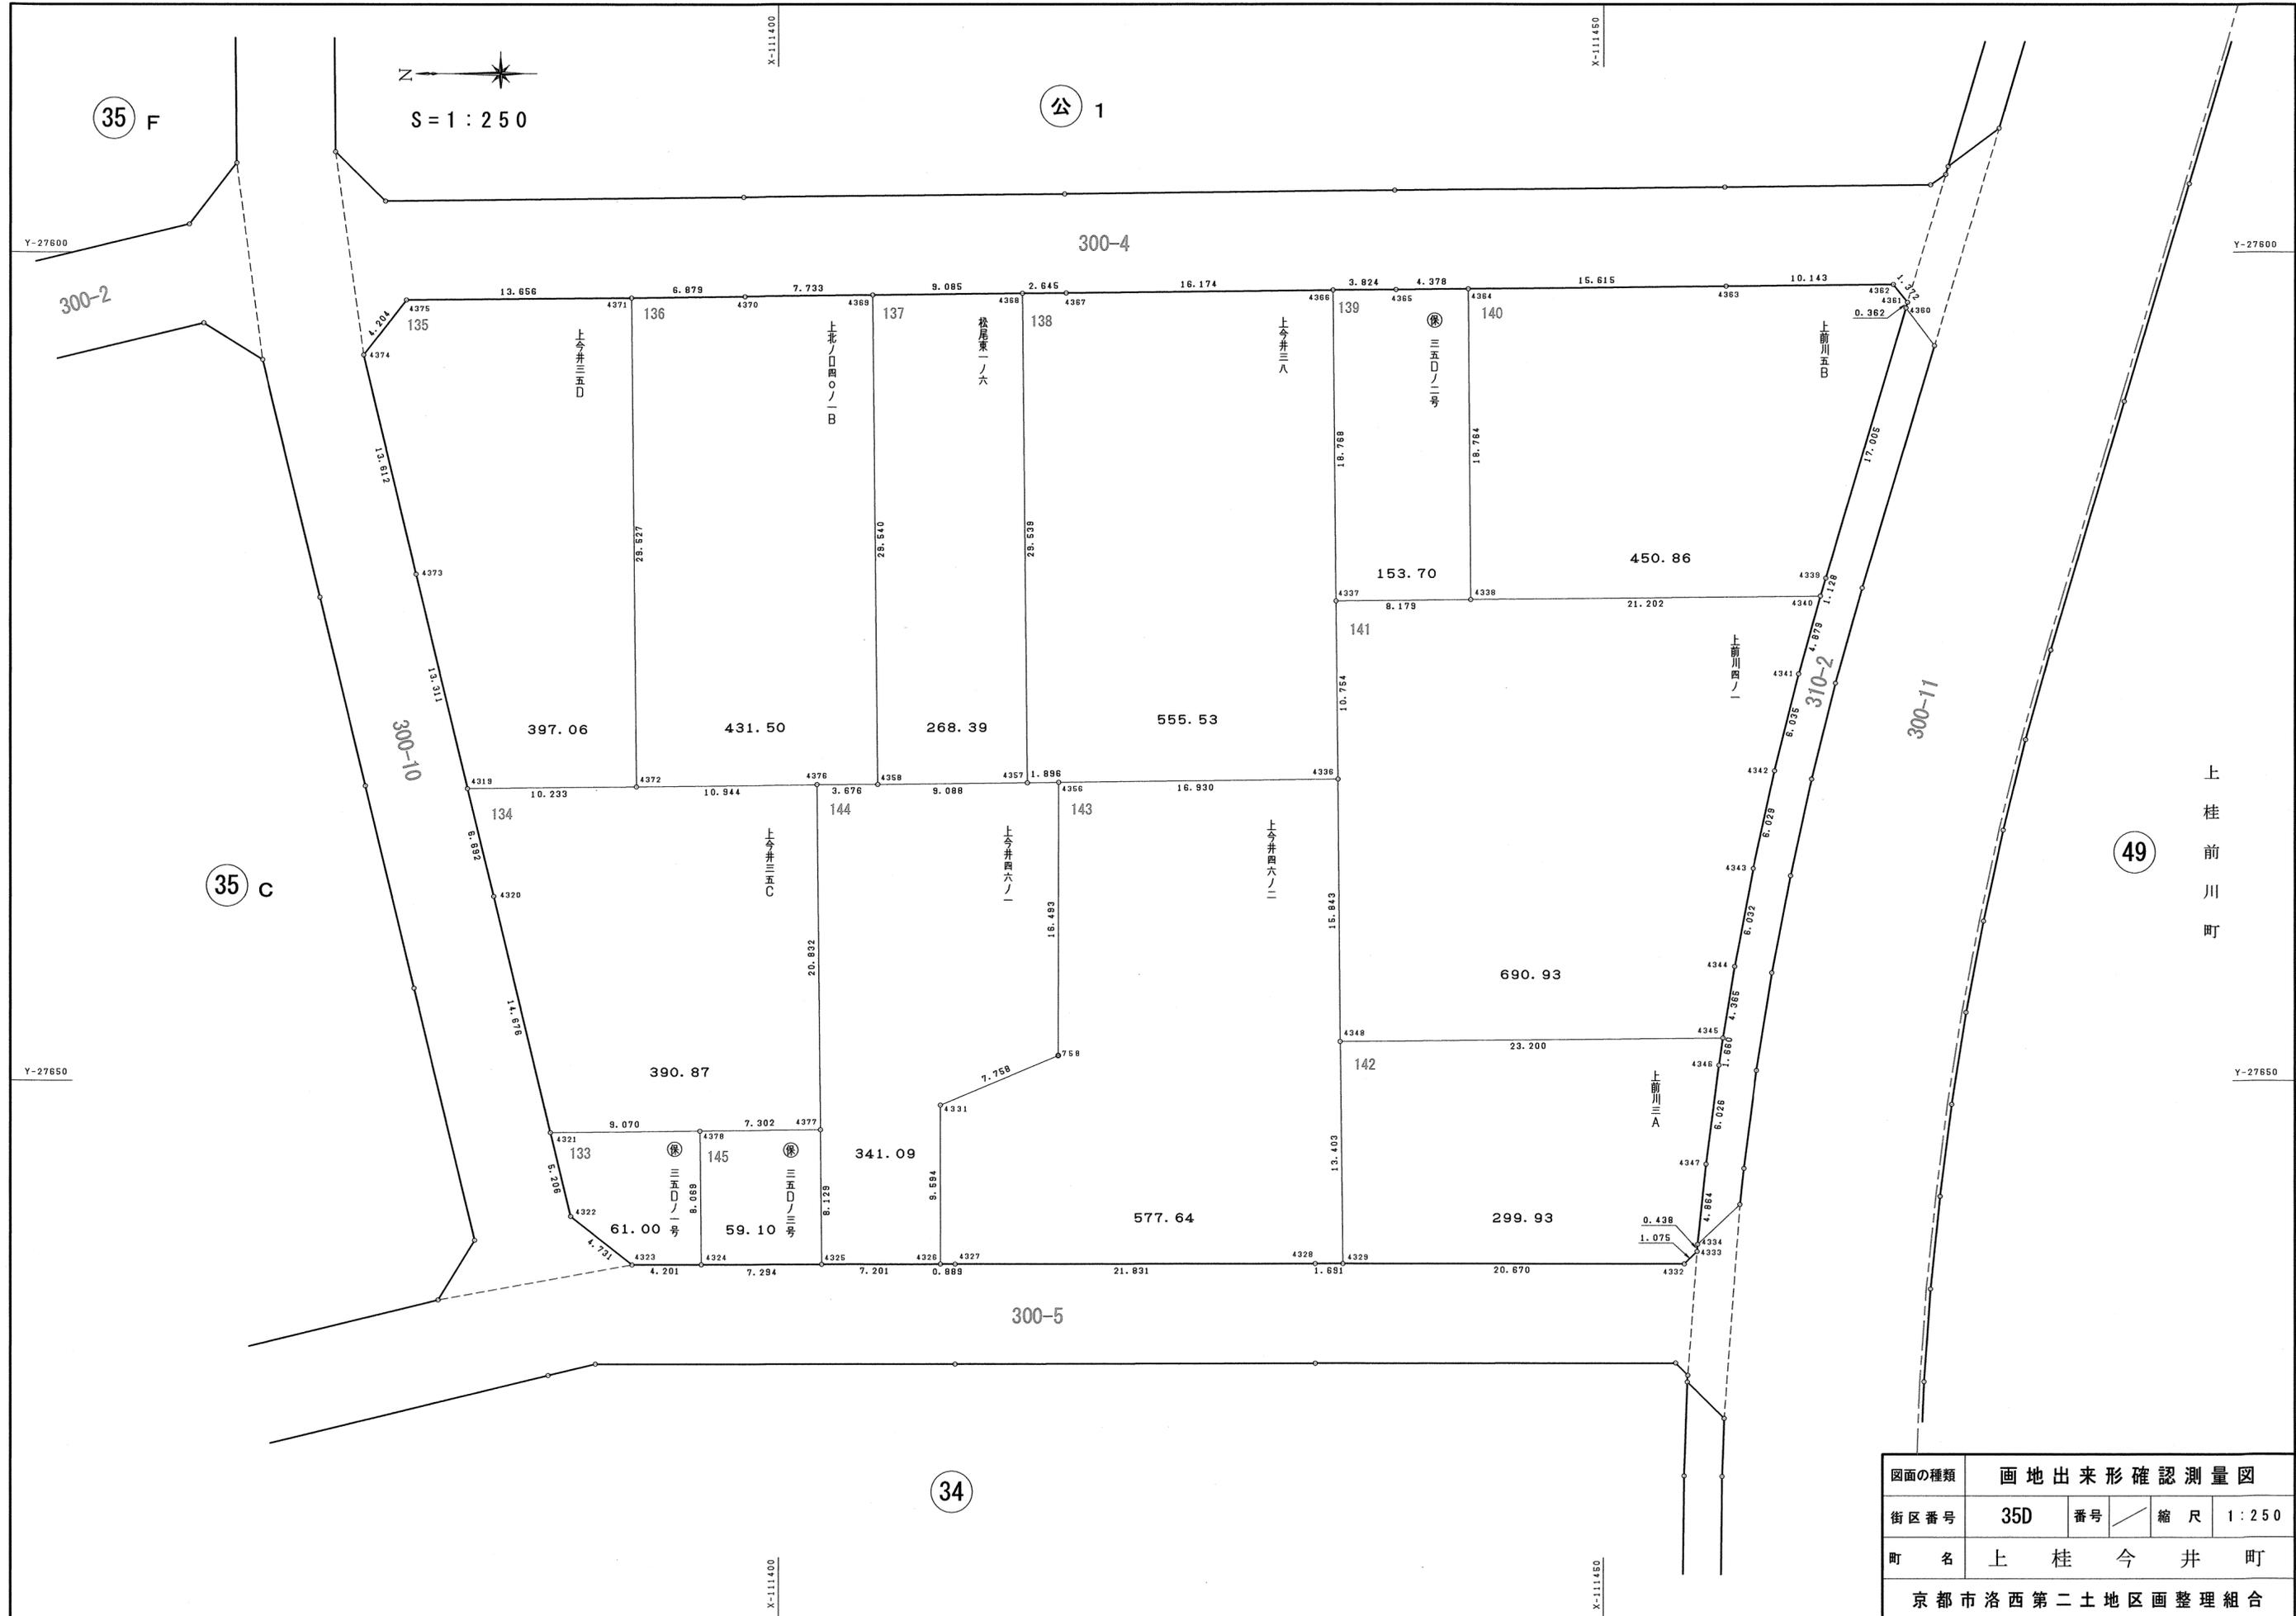

図面の種類	画地出来形確認測量図		
街区番号	35D	番号	縮尺 1:250
町名	上桂今井町		
京都市洛西第二土地区画整理組合			

133

地番 保 三五Dノ一			
NO	X	Y	辺長
4321	-111386.185	-27653.147	
4322	-111387.407	-27658.208	5.206
4323	-111391.134	-27661.122	4.731
4324	-111395.335	-27661.116	4.201
4378	-111395.254	-27653.047	8.069
4321	-111386.185	-27653.147	8.070
面積	61.0099845		
地積	61.00 m ²		

134

地番 上今井三五C			
NO	X	Y	辺長
4319	-111381.167	-27632.376	
4320	-111382.740	-27638.881	6.692
4321	-111386.185	-27653.147	14.676
4378	-111395.254	-27653.047	9.070
4377	-111402.556	-27652.977	7.302
4376	-111402.342	-27632.146	20.832
4372	-111391.399	-27632.273	10.944
4319	-111381.167	-27632.376	10.233
面積	390.8711740		
地積	390.87 m ²		

135

地番 上今井三五D			
NO	X	Y	辺長
4375	-111377.441	-27602.890	
4374	-111374.854	-27606.204	4.204
4373	-111378.038	-27619.438	13.612
4319	-111381.167	-27632.376	13.311
4372	-111391.399	-27632.273	10.233
4371	-111391.096	-27602.748	29.527
4375	-111377.441	-27602.890	13.656
面積	397.0671355		
地積	397.06 m ²		

136

地番 上北ノ口四〇ノ一B			
NO	X	Y	辺長
4371	-111391.096	-27602.748	
4372	-111391.399	-27632.273	29.527
4376	-111402.342	-27632.146	10.944
4358	-111406.018	-27632.133	3.676
4369	-111405.708	-27602.595	29.540
4370	-111397.975	-27602.676	7.733
4371	-111391.096	-27602.748	6.879
面積	431.5000325		
地積	431.50 m ²		

137

地番 松尾東一ノ六			
NO	X	Y	辺長
4369	-111405.708	-27602.595	
4358	-111406.018	-27632.133	29.540
4357	-111415.105	-27632.036	9.088
4368	-111414.792	-27602.499	29.539
4369	-111405.708	-27602.595	9.085
面積	268.3930160		
地積	268.39 m ²		

138

地番 上今井三八			
NO	X	Y	辺長
4368	-111414.792	-27602.499	
4357	-111415.105	-27632.036	29.539
4356	-111417.001	-27632.008	1.896
4336	-111433.930	-27631.826	16.930
4337	-111433.797	-27621.073	10.754
4366	-111433.610	-27602.306	18.768
4367	-111417.437	-27602.471	16.174
4368	-111414.792	-27602.499	2.645
面積	555.5355770		
地積	555.53 m ²		

139

地番 保 三五Dノ二			
NO	X	Y	辺長
4366	-111433.610	-27602.306	
4337	-111433.797	-27621.073	18.768
4338	-111441.976	-27620.985	8.179
4364	-111441.812	-27602.222	18.764
4365	-111437.434	-27602.267	4.378
4366	-111433.610	-27602.306	3.824
面積	153.7091565		
地積	153.70 m ²		

140

地番 上今井三五B			
NO	X	Y	辺長
4364	-111441.812	-27602.222	
4338	-111441.976	-27620.985	18.764
4340	-111463.177	-27620.762	21.202
4339	-111463.484	-27619.677	1.128
4360	-111468.330	-27603.377	17.005
4361	-111468.427	-27603.028	0.362
4362	-111467.568	-27601.958	1.372
4363	-111457.426	-27602.061	10.143
4364	-111441.812	-27602.222	15.615
面積	450.8607015		
地積	450.86 m ²		

141

地番 上今井四ノ一			
NO	X	Y	辺長
4337	-111433.797	-27621.073	
4336	-111433.930	-27631.826	10.754
4348	-111434.071	-27647.668	15.843
4345	-111457.270	-27647.435	23.200
4344	-111457.960	-27643.125	4.365
4343	-111459.090	-27637.200	6.032
4342	-111460.381	-27631.311	6.029
4341	-111461.848	-27625.457	6.035
4340	-111463.177	-27620.762	4.879
4338	-111441.976	-27620.985	21.202
4337	-111433.797	-27621.073	8.179
面積	690.9366235		
地積	690.93 m ²		

142

地番 上今井三A			
NO	X	Y	辺長
4348	-111434.071	-27647.668	
4329	-111434.241	-27661.070	13.403
4332	-111454.911	-27661.071	20.670
4333	-111455.683	-27660.323	1.075
4334	-111455.720	-27659.887	0.438
4347	-111456.227	-27655.049	4.864
4346	-111457.007	-27649.074	6.026
4345	-111457.270	-27647.435	1.660
4348	-111434.071	-27647.668	23.200
面積	299.9398650		
地積	299.93 m ²		

143

地番 上今井四六ノ二			
NO	X	Y	辺長
4356	-111417.001	-27632.008	
758	-111416.975	-27648.501	16.493
4331	-111409.821	-27651.501	7.598
4326	-111409.830	-27661.095	9.594
4327	-111410.719	-27661.094	0.889
4328	-111432.550	-27661.070	21.831
4329	-111434.241	-27661.070	1.691
4348	-111434.071	-27647.668	13.403
4336	-111433.930	-27631.826	15.843
4356	-111417.001	-27632.008	16.930
面積	577.6464835		
地積	577.64 m ²		

144

地番 上今井四六ノ一			
NO	X	Y	辺長
4376	-111402.342	-27632.146	
4377	-111402.556	-27652.977	20.832
4325	-111402.629	-27661.106	8.129
4326	-111409.830	-27661.095	7.201
4331	-111409.821	-27651.501	9.594
758	-111416.975	-27648.501	7.758
4356	-111417.001	-27632.008	16.493
4357	-111415.105	-27632.036	1.896
4358	-111406.018	-27632.133	9.088
4376	-111402.342	-27632.146	3.676
面積	341.0936145		
地積	341.09 m ²		

145

地番 保 三五Dノ三			
NO	X	Y	辺長
4378	-111395.254	-27653.047	
4324	-111395.335	-27661.116	8.069
4325	-111402.629	-27661.106	7.294
4377	-111402.556	-27652.977	8.129
4378	-111395.254	-27653.047	7.302
面積	59.1095820		
地積	59.10 m ²		

図面の種類	画地面積求積表			
街区番号	35D	番号	/	
町名	上桂今井町			
京都市洛西第二土地区画整理組合				



S = 1 : 250

桂上野今井町

36 A

210-1

200-5

37

400-11

38


桂上野西町

35 B

35 C

35 F

図面の種類	画地出来形確認測量図			
街区番号	35E	番号	縮尺	1 : 250
町名	上桂今井町			
京都市洛西第二土地区画整理組合				

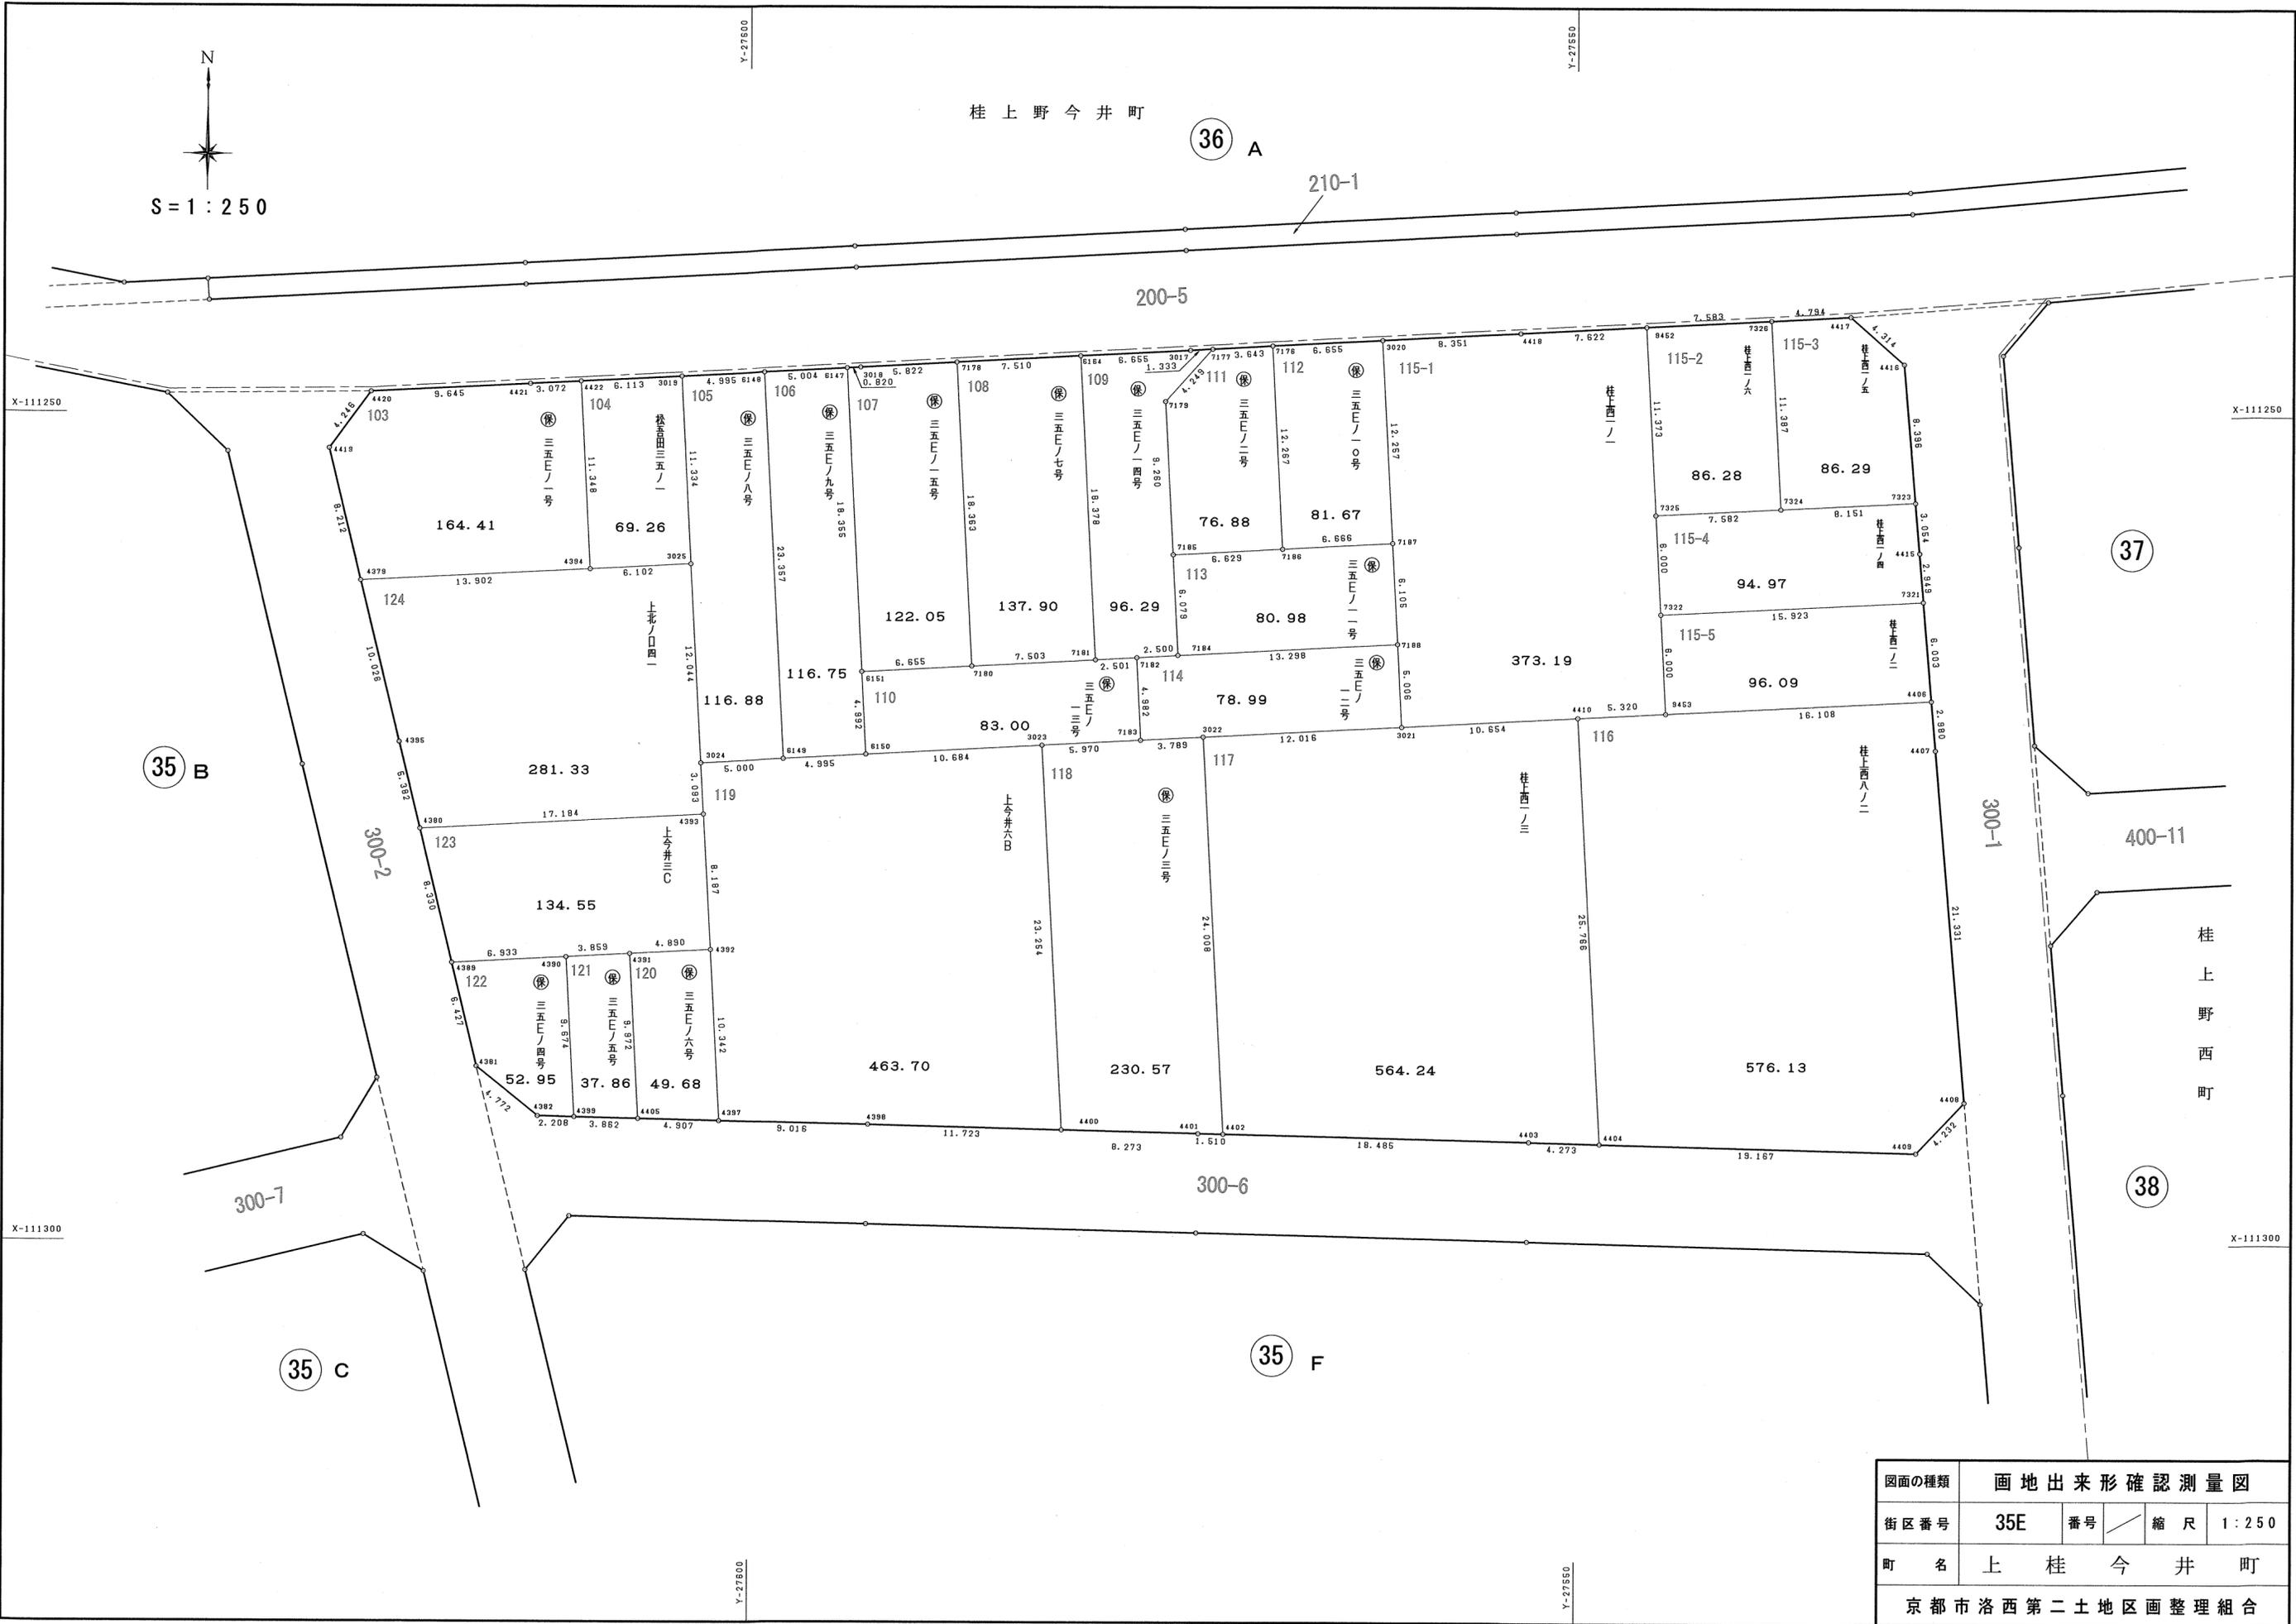

103

Table with columns: 地番, 保三五Eノ一, NO, X, Y, 辺長, 面積, 地積. Includes data for parcels 4420, 4419, 4379, 4394, 4422, 4421, 4420.

104

Table with columns: 地番, 保三五Eノ一, NO, X, Y, 辺長, 面積, 地積. Includes data for parcels 4422, 4394, 3025, 3019, 4422.

105

Table with columns: 地番, 保三五Eノ八, NO, X, Y, 辺長, 面積, 地積. Includes data for parcels 3019, 3025, 3024, 6149, 6148, 3019.

106

Table with columns: 地番, 保三五Eノ九, NO, X, Y, 辺長, 面積, 地積. Includes data for parcels 6148, 6149, 6150, 6151, 6147, 6148.

107

Table with columns: 地番, 保三五Eノ一五, NO, X, Y, 辺長, 面積, 地積. Includes data for parcels 6147, 6151, 7180, 7178, 3018, 6147.

108

Table with columns: 地番, 保三五Eノ七, NO, X, Y, 辺長, 面積, 地積. Includes data for parcels 7178, 7180, 7181, 6164, 7178.

109

Table with columns: 地番, 保三五Eノ一四, NO, X, Y, 辺長, 面積, 地積. Includes data for parcels 6164, 7181, 7182, 7184, 7185, 7179, 7177, 3017, 6164.

110

Table with columns: 地番, 保三五Eノ一三, NO, X, Y, 辺長, 面積, 地積. Includes data for parcels 6151, 6150, 3023, 7183, 7182, 7181, 7180, 6151.

111

Table with columns: 地番, 保三五Eノ二, NO, X, Y, 辺長, 面積, 地積. Includes data for parcels 7177, 7179, 7185, 7186, 7176, 7177.

112

Table with columns: 地番, 保三五Eノ一〇, NO, X, Y, 辺長, 面積, 地積. Includes data for parcels 7176, 7186, 7187, 3020, 7176.

113

Table with columns: 地番, 保三五Eノ一一, NO, X, Y, 辺長, 面積, 地積. Includes data for parcels 7185, 7184, 7188, 7187, 7186, 7185.

114

Table with columns: 地番, 保三五Eノ一二, NO, X, Y, 辺長, 面積, 地積. Includes data for parcels 7182, 7183, 3022, 3021, 7188, 7184, 7182.

115-1

Table with columns: 地番, 桂上西一ノ一, NO, X, Y, 辺長, 面積, 地積. Includes data for parcels 3020, 7187, 7188, 3021, 4410, 9453, 7322, 7325, 9452, 4418, 3020.

115-2

Table with columns: 地番, 桂上西一ノ六, NO, X, Y, 辺長, 面積, 地積. Includes data for parcels 9452, 7325, 7324, 7326, 9452.

115-3

Table with columns: 地番, 桂上西一ノ五, NO, X, Y, 辺長, 面積, 地積. Includes data for parcels 7326, 7324, 7323, 4416, 4417, 7326.

115-4

Table with columns: 地番, 桂上西一ノ四, NO, X, Y, 辺長, 面積, 地積. Includes data for parcels 7325, 7322, 7321, 4415, 7323, 7324, 7325.

115-5

Table with columns: 地番, 桂上西一ノ二, NO, X, Y, 辺長, 面積, 地積. Includes data for parcels 7322, 9453, 4406, 7321, 7322.

116

Table with columns: 地番, 桂上西八ノ二, NO, X, Y, 辺長, 面積, 地積. Includes data for parcels 4410, 4404, 4409, 4408, 4407, 4406, 9453, 4410.

117

Table with columns: 地番, 桂上西一ノ三, NO, X, Y, 辺長, 面積, 地積. Includes data for parcels 3022, 4402, 4403, 4404, 4410, 3021, 3022.

118

Table with columns: 地番, 保三五Eノ三, NO, X, Y, 辺長, 面積, 地積. Includes data for parcels 3023, 4400, 4401, 4402, 3022, 7183, 3023.

119

Table with columns: 地番, 上今井六B, NO, X, Y, 辺長, 面積, 地積. Includes data for parcels 3024, 4393, 4392, 4397, 4398, 4400, 3023, 6150, 6149, 3024.

120

Table with columns: 地番, 保三五Eノ六, NO, X, Y, 辺長, 面積, 地積. Includes data for parcels 4391, 4405, 4397, 4392, 4391, 4391.

121

Table with columns: 地番, 保三五Eノ五, NO, X, Y, 辺長, 面積, 地積. Includes data for parcels 4390, 4399, 4405, 4391, 4390.

122

Table with columns: 地番, 保三五Eノ四, NO, X, Y, 辺長, 面積, 地積. Includes data for parcels 4389, 4381, 4382, 4399, 4390, 4389.


123

Table with columns: 地番, 上今井三C, NO, X, Y, 辺長, 面積, 地積. Includes data for parcels 4380, 4389, 4390, 4391, 4392, 4393, 4380.

124

Table with columns: 地番, 上北ノ口四一, NO, X, Y, 辺長, 面積, 地積. Includes data for parcels 4379, 4395, 4380, 4393, 3024, 4394, 4379.

Summary table with columns: 図面の種類, 画地面積求積表, 街区番号, 35E, 番号, 町名, 上桂今井町, 京都市洛西第二土地区画整理組合.

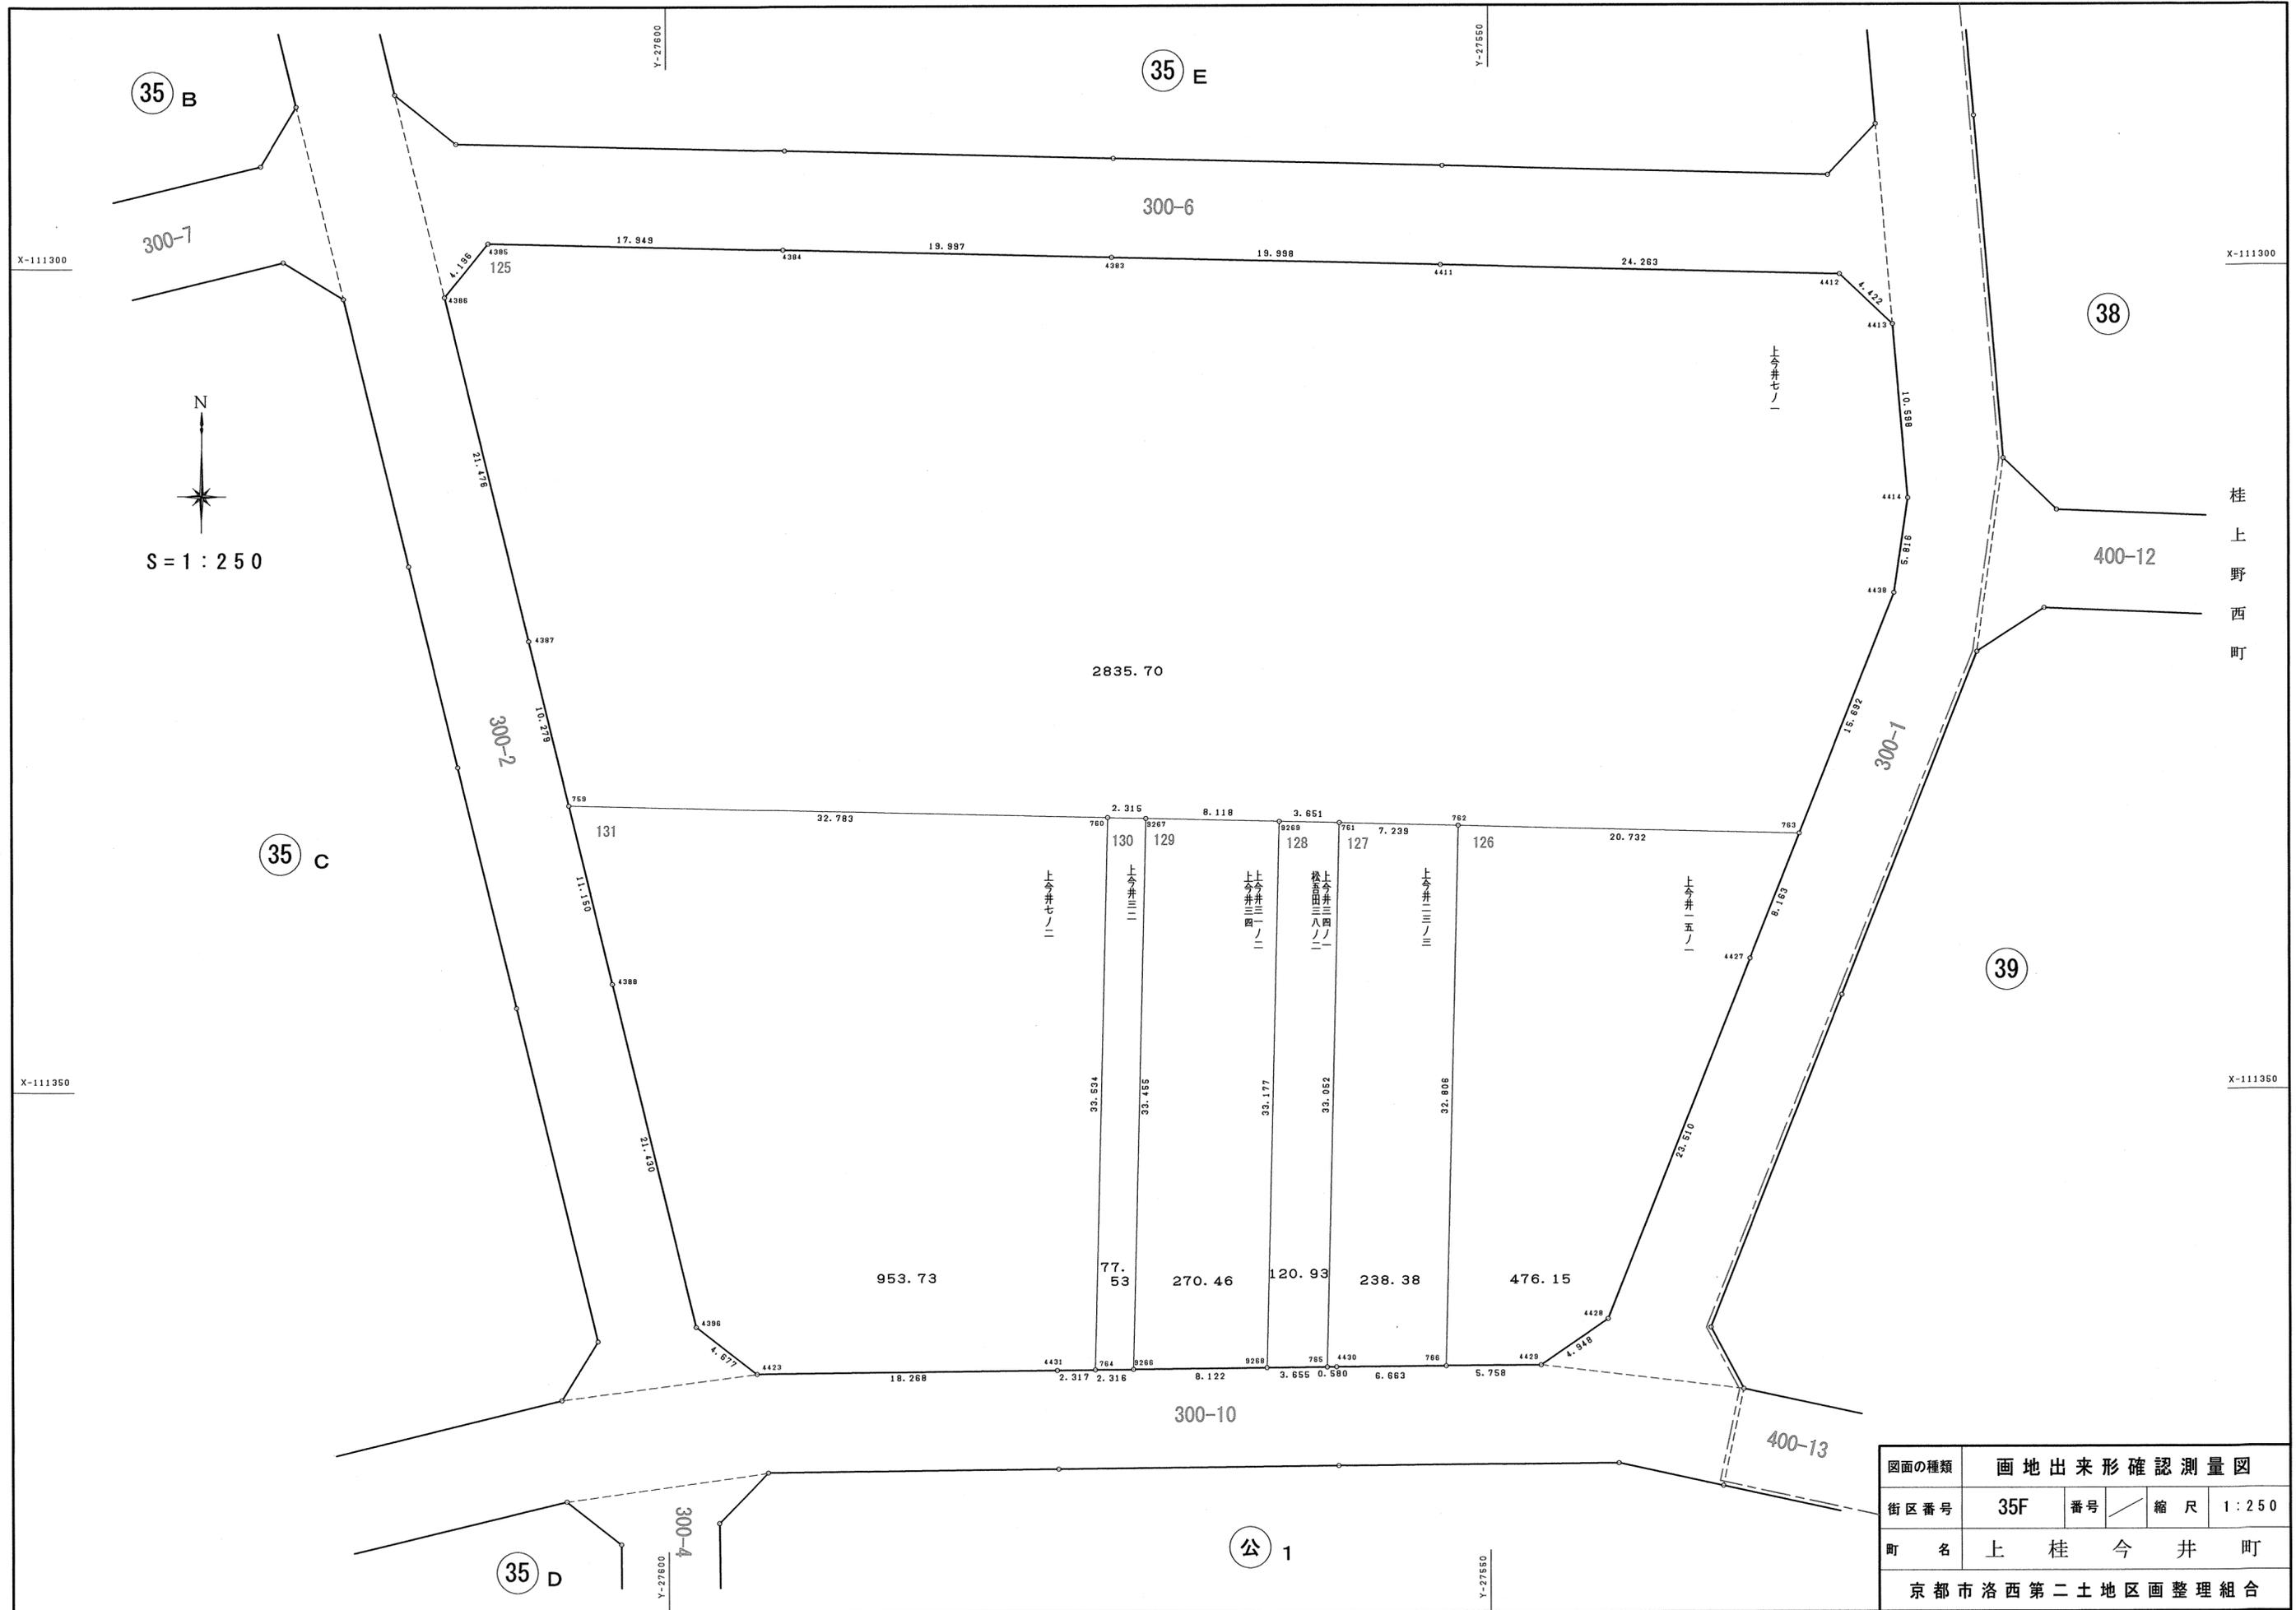

35 B

35 E

38

35 C

39

35 D



桂
上
野
西
町

図面の種類	画地出来形確認測量図			
街区番号	35F	番号	縮尺	1:250
町名	上桂今井町			
京都市洛西第二土地区画整理組合				

125

地番 上今井七ノ一			
NO	X	Y	辺長
4385	-111298.484	-27610.819	
4386	-111301.745	-27613.460	4.196
4387	-111322.615	-27608.394	21.476
759	-111332.606	-27605.976	10.279
760	-111333.416	-27573.203	32.783
9267	-111333.473	-27570.889	2.315
9269	-111333.674	-27562.773	8.118
761	-111333.764	-27559.123	3.651
762	-111333.943	-27551.886	7.239
763	-111334.454	-27531.160	20.732
4438	-111319.871	-27525.366	15.692
4414	-111314.117	-27524.519	5.816
4413	-111303.558	-27525.429	10.598
4412	-111300.515	-27528.637	4.422
4411	-111299.905	-27552.892	24.263
4383	-111299.417	-27572.884	19.998
4384	-111298.913	-27592.875	19.997
4385	-111298.484	-27610.819	17.949
面積	2835.7050820		
地積	2835.70 m ²		

126

地番 上今井一五ノ一			
NO	X	Y	辺長
763	-111334.454	-27531.160	
762	-111333.943	-27551.886	20.732
766	-111366.739	-27552.696	32.806
4429	-111366.686	-27546.938	5.758
4428	-111363.888	-27542.857	4.948
4427	-111342.040	-27534.174	23.510
763	-111334.454	-27531.160	8.163
面積	476.1553710		
地積	476.15 m ²		

127

地番 上今井二三ノ三			
NO	X	Y	辺長
766	-111366.739	-27552.696	
762	-111333.943	-27551.886	32.806
761	-111333.764	-27559.123	7.239
765	-111366.806	-27559.939	33.052
4430	-111366.801	-27559.359	0.580
766	-111366.739	-27552.696	6.663
面積	238.3804105		
地積	238.38 m ²		

128

地番 上今井三四ノ一, 松吾田三八ノ二			
NO	X	Y	辺長
9268	-111366.841	-27563.594	
765	-111366.806	-27559.939	3.655
761	-111333.764	-27559.123	33.052
9269	-111333.674	-27562.773	3.651
9268	-111366.841	-27563.594	33.177
面積	120.9366950		
地積	120.93 m ²		

129

地番 上今井三一ノ二, 三四			
NO	X	Y	辺長
9267	-111333.473	-27570.889	
9266	-111366.918	-27571.716	33.455
9268	-111366.841	-27563.594	8.122
9269	-111333.674	-27562.773	33.177
9267	-111333.473	-27570.889	8.118
面積	270.4625020		
地積	270.46 m ²		

130

地番 上今井三二			
NO	X	Y	辺長
760	-111333.416	-27573.203	
764	-111366.940	-27574.032	33.534
9266	-111366.918	-27571.716	2.316
9267	-111333.473	-27570.889	33.455
760	-111333.416	-27573.203	2.315
面積	77.5311075		
地積	77.53 m ²		

131

地番 上今井七ノ二			
NO	X	Y	辺長
760	-111333.416	-27573.203	
759	-111332.606	-27605.976	32.783
4388	-111343.443	-27603.353	11.150
4396	-111364.271	-27598.311	21.430
4423	-111367.139	-27594.616	4.677
4431	-111366.962	-27576.349	18.268
764	-111366.940	-27574.032	2.317
760	-111333.416	-27573.203	33.534
面積	953.7302420		
地積	953.73 m ²		

図面の種類	画地面積求積表		
街区番号	35F	番号	/
町名	上桂今井町		
京都市洛西第二土地区画整理組合			

地番 公1			
NO	X	Y	辺長
4424	-111373.135	-27593.941	
4425	-111376.168	-27596.916	4.248
4426	-111397.888	-27596.677	21.721
4442	-111417.348	-27596.500	19.461
4441	-111437.343	-27596.283	19.996
4440	-111457.342	-27596.084	20.000
4443	-111469.824	-27595.940	12.483
4444	-111470.743	-27595.313	1.113
4445	-111470.881	-27594.832	0.500
4446	-111477.454	-27572.750	23.040
4447	-111483.148	-27553.567	20.010
4454	-111488.860	-27534.459	19.943
4453	-111494.578	-27515.305	19.989
4457	-111500.305	-27496.093	20.047
4458	-111506.000	-27476.932	19.989
4459	-111509.410	-27465.430	11.997
4460	-111515.441	-27445.163	21.145
4464	-111521.868	-27423.687	22.417
4465	-111521.967	-27423.333	0.368
4466	-111521.709	-27423.082	0.360
4467	-111507.767	-27426.451	14.343
4468	-111488.327	-27431.156	20.001
4481	-111468.900	-27435.833	19.982
4482	-111449.457	-27440.517	19.999
4483	-111430.020	-27445.201	19.993
4484	-111410.580	-27449.884	19.996
4490	-111391.144	-27454.596	19.999
4491	-111388.045	-27458.277	4.812
4436	-111386.748	-27477.421	19.188
4435	-111382.522	-27496.787	19.822
4437	-111378.266	-27516.325	19.996
4434	-111374.018	-27535.871	20.002
4433	-111372.636	-27542.217	6.495
4432	-111372.792	-27559.231	17.015
4439	-111372.958	-27576.271	17.041
4424	-111373.135	-27593.941	17.671
面積	17963.0257690		
地積	17963.02 m ²		

図面の種類	画地面積求積表			
街区番号	公1	番号	/	
町名	上桂今井町			
京都市洛西第二土地区画整理組合				

S = 1 : 250

上桂樋ノ口町

上桂今井町

35 B

35 E



図面の種類	画地出来形確認測量図		
街区番号	36A	1/2	縮尺 1:250
町名	桂上野今井町		
京都市洛西第二土地区画整理組合			



S = 1 : 2 5 0



図面の種類	画地出来形確認測量図			
街区番号	36A	2/2	番号	縮尺 1 : 2 5 0
町名	桂上野今井町			
京都市洛西第二土地区画整理組合				

桂上野西町

37

35 E

40

36 B

101 地番 桂上今井五二ノ一

102 地番 桂上今井五二ノ三

103 地番 桂上今井五二ノ二

104 地番 上樋ノ口一, 上樋ノ口二

105 地番 桂上今井三二ノ八, 三二ノ一〇, 三二ノ一一

106 地番 桂上今井三二ノ三

107 地番 桂上今井三二ノ二

108 地番 上樋ノ口一ノ二, 桂上今井二七ノ一

109 地番 桂上今井三〇

110 地番 桂上今井二五ノ五

111 地番 桂上今井二四ノ一, 桂上今井三二ノ四

112 地番 桂上北三ノ一五

113 地番 桂上西二五

114 地番 桂上今井二〇ノ七

115 地番 桂上今井二〇ノ八

116 地番 桂上今井二〇ノ九

117 地番 桂上今井二一

118 地番 桂上今井三二ノ六

119 地番 桂上今井二一ノ六

120 地番 桂上今井二一ノ五

121 地番 桂上今井三二ノ一六

122 地番 桂上今井三二ノ一, 桂上今井三二ノ一七

123 地番 桂上今井二〇ノ五, 桂上今井二一ノ七

図面の種類 画地面積求積表
街区番号 36A
町名 桂上野今井町
京都市洛西第二土地区画整理組合




S = 1 : 2 5 0

Y-27400

Y-27350

Y-27400

Y-27350

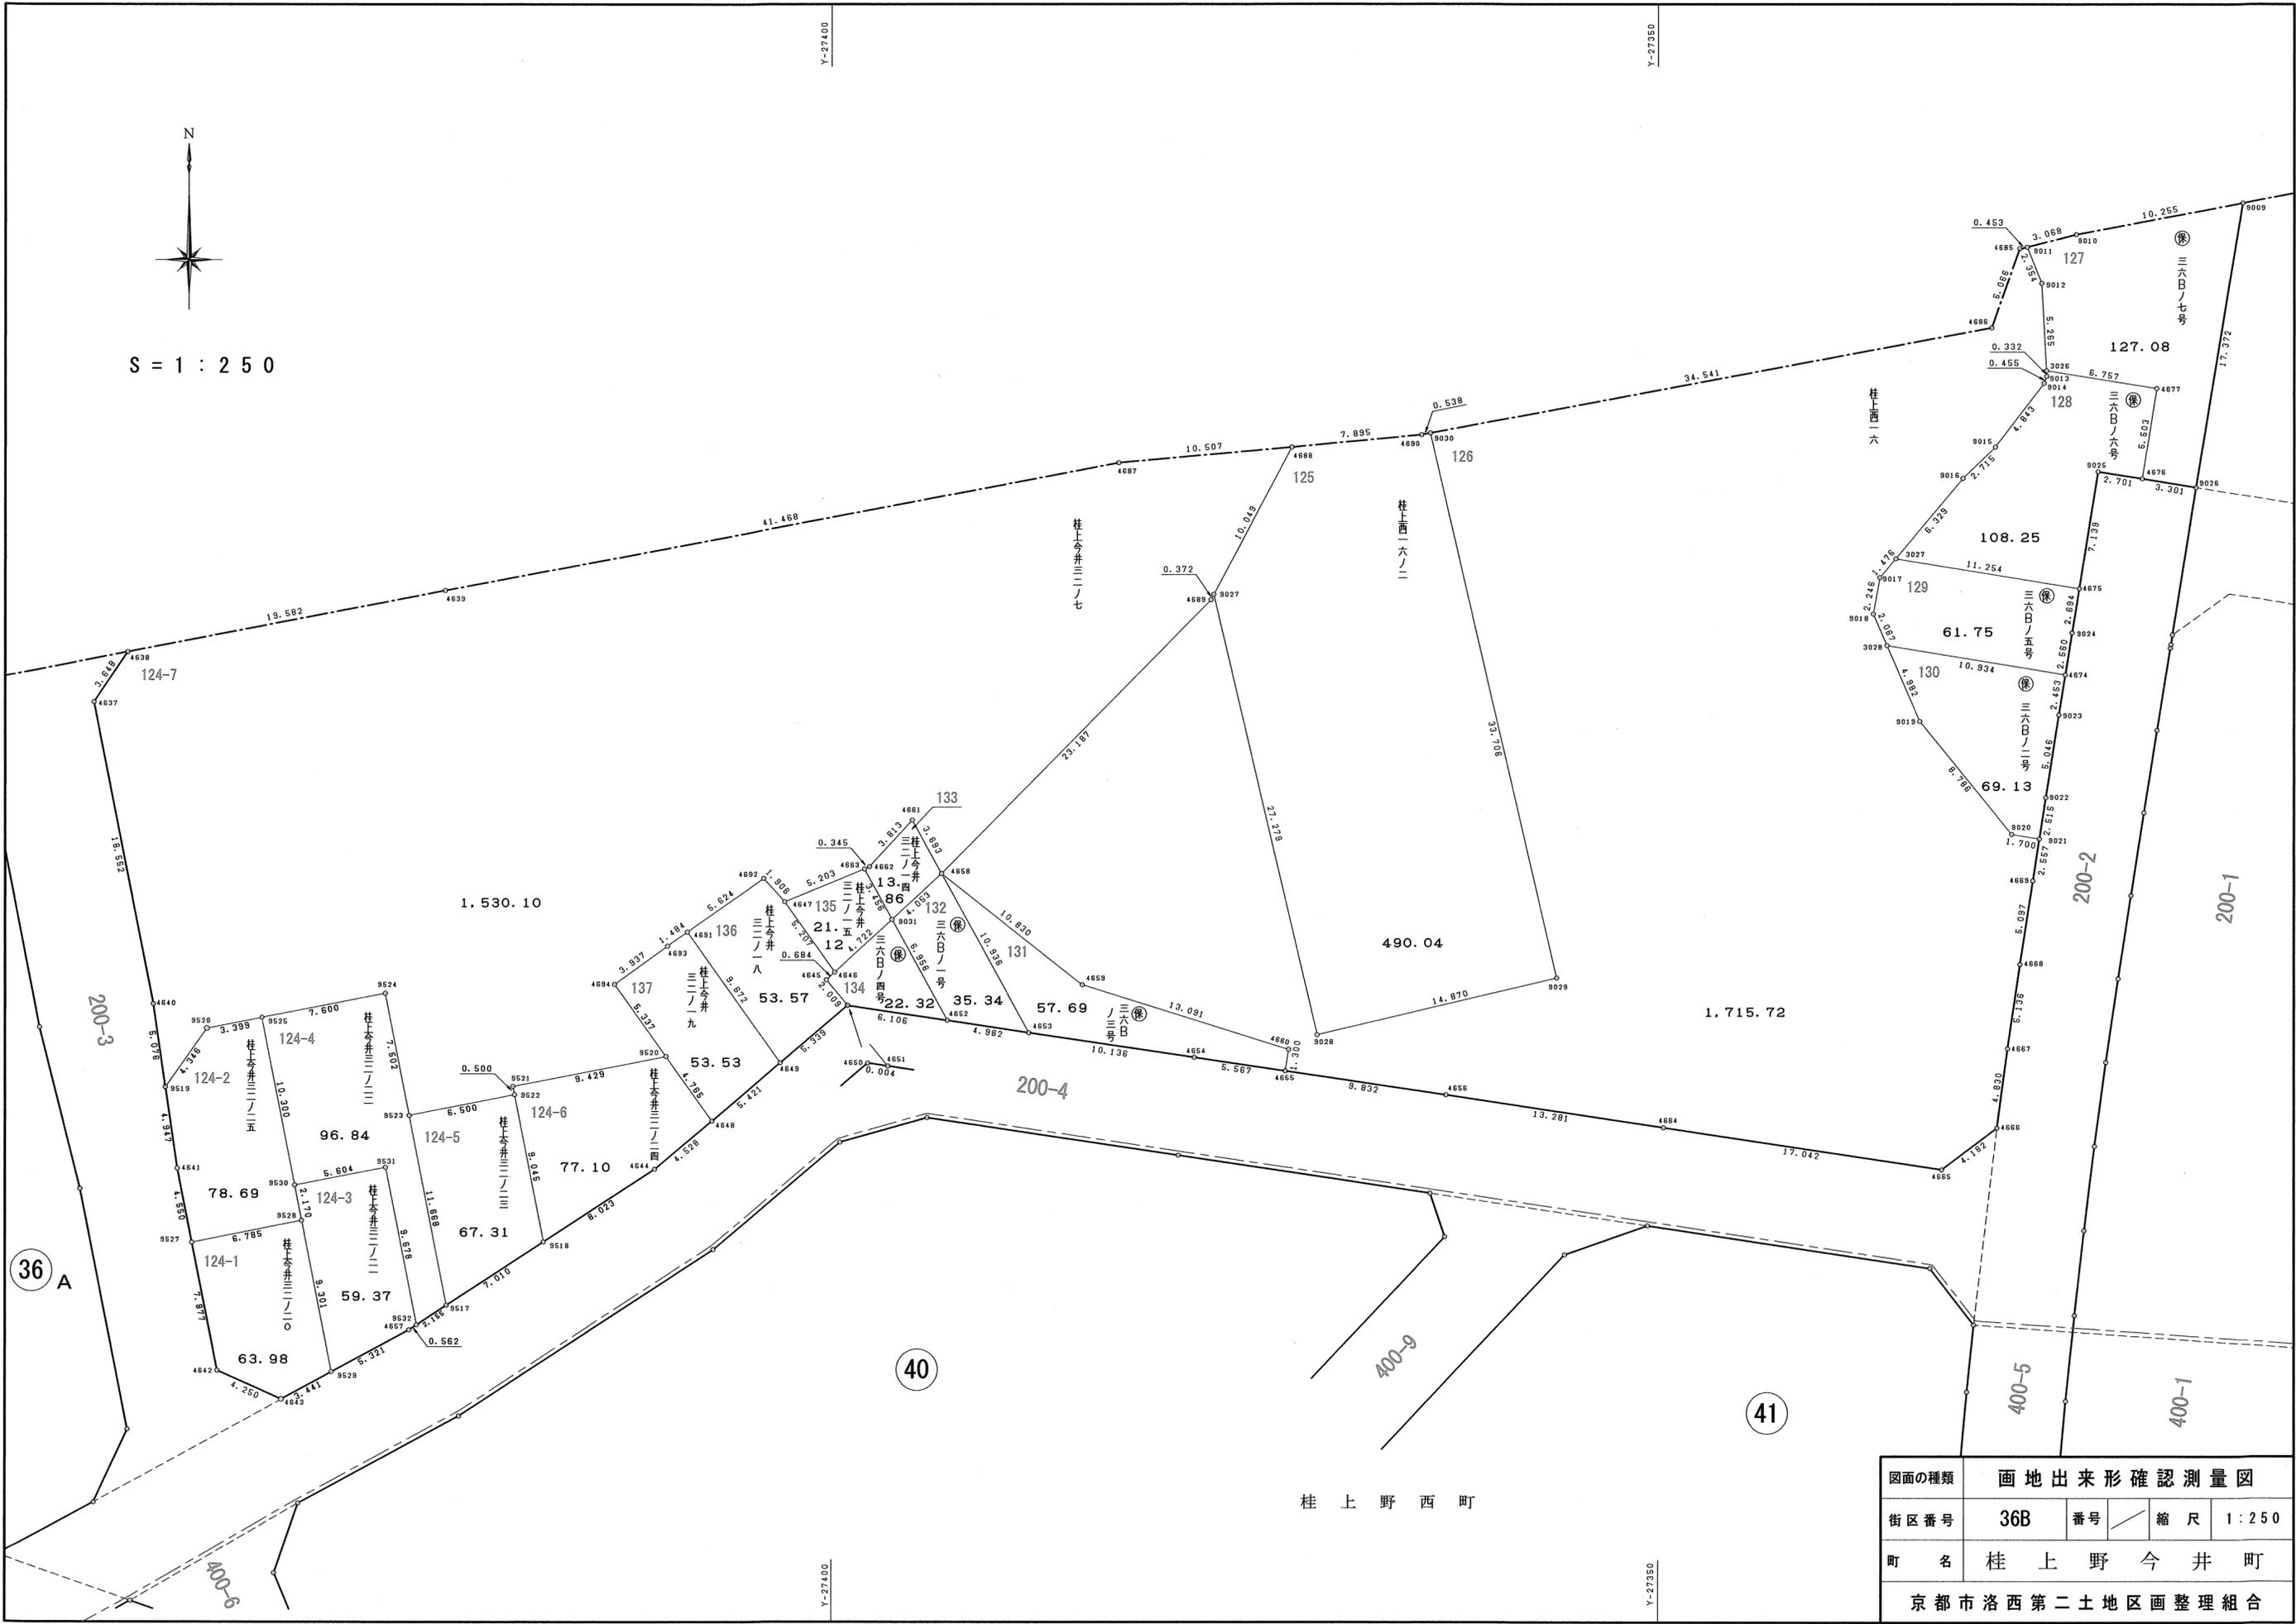

図面の種類	画地出来形確認測量図			
街区番号	36B	番号	縮尺	1 : 250
町名	桂上野今井町			
京都市洛西第二土地区画整理組合				

124-1

地番	桂上今井三二ノ二〇		
N O	X	Y	辺長
9527	-111206.715	-27438.696	
4642	-111214.441	-27437.159	7.877
4643	-111216.152	-27433.269	4.250
9528	-111214.515	-27430.242	3.441
9528	-111205.390	-27432.042	9.301
9527	-111206.715	-27438.696	6.785
面積	63.9884405		
地積	63.98 m ²		

124-2

地番	桂上今井三二ノ二五		
N O	X	Y	辺長
9527	-111206.715	-27438.696	
9528	-111205.390	-27432.042	6.785
9530	-111203.261	-27432.462	2.170
9525	-111193.155	-27434.452	10.300
9526	-111193.810	-27437.787	3.399
9519	-111197.357	-27440.298	4.346
4641	-111202.252	-27439.584	4.947
9527	-111206.715	-27438.696	4.550
面積	78.6901600		
地積	78.69 m ²		

124-3

地番	桂上今井三二ノ二一		
N O	X	Y	辺長
9530	-111203.261	-27432.462	
9528	-111205.390	-27432.042	2.170
9529	-111214.515	-27430.242	9.301
4657	-111211.984	-27425.561	5.321
9532	-111211.677	-27425.090	0.562
9531	-111202.182	-27426.963	9.678
9530	-111203.261	-27432.462	5.604
面積	59.3798030		
地積	59.37 m ²		

124-4

地番	桂上今井三二ノ二二		
N O	X	Y	辺長
9525	-111193.155	-27434.452	
9530	-111203.261	-27432.462	10.300
9531	-111202.182	-27426.963	5.604
9532	-111211.677	-27425.090	9.678
9517	-111210.499	-27423.285	2.155
9523	-111199.051	-27425.542	11.668
9524	-111191.691	-27426.994	7.502
9525	-111193.155	-27434.452	7.600
面積	96.8456410		
地積	96.84 m ²		

124-5

地番	桂上今井三二ノ二三		
N O	X	Y	辺長
9523	-111199.051	-27425.542	
9517	-111210.499	-27423.285	11.668
9518	-111206.668	-27417.415	7.010
9522	-111197.794	-27419.165	9.045
9523	-111199.051	-27425.542	6.500
面積	67.3177875		
地積	67.31 m ²		

124-6

地番	桂上今井三二ノ二四		
N O	X	Y	辺長
9521	-111197.303	-27419.262	
9522	-111197.794	-27419.165	0.500
9518	-111206.668	-27417.415	9.045
4644	-111202.284	-27410.696	8.023
4648	-111199.358	-27407.240	4.528
9520	-111195.481	-27410.011	4.765
9521	-111197.303	-27419.262	9.429
面積	77.1062480		
地積	77.10 m ²		

124-7

地番	桂上今井三二ノ七		
N O	X	Y	辺長
4638	-111171.111	-27442.591	
4637	-111174.135	-27444.632	3.648
4640	-111192.334	-27441.031	18.552
9519	-111197.357	-27440.298	5.076
9526	-111193.810	-27437.787	4.346
9525	-111193.155	-27434.452	3.399
9524	-111191.691	-27426.994	7.600
9523	-111199.051	-27425.542	7.502
9522	-111197.794	-27419.165	6.500
9521	-111197.303	-27419.262	0.500
9520	-111195.481	-27410.011	9.429
4694	-111191.139	-27413.114	5.337
4693	-111188.833	-27409.923	3.937
4691	-111187.975	-27408.712	1.484
4692	-111184.750	-27404.105	5.624
4647	-111186.161	-27402.823	1.906
4663	-111184.188	-27398.009	5.203
4662	-111184.042	-27397.696	0.345
4661	-111181.232	-27395.119	3.813
4658	-111184.467	-27393.338	3.693
4689	-111167.972	-27377.042	23.187
9027	-111167.643	-27376.868	0.372
4688	-111158.770	-27372.151	10.049
4687	-111159.703	-27382.616	10.507
4639	-111167.408	-27423.362	41.468
4638	-111171.111	-27442.591	19.582
面積	1530.1092565		
地積	1530.10 m ²		

125

地番	桂上西一六ノ二		
N O	X	Y	辺長
4688	-111158.770	-27372.151	
9027	-111167.643	-27376.868	10.049
9028	-111194.192	-27370.601	27.279
9029	-111190.751	-27356.135	14.870
9030	-111157.919	-27363.763	33.706
4690	-111158.018	-27364.292	0.538
4688	-111158.770	-27372.151	7.895
面積	490.0464685		
地積	490.04 m ²		

126

地番	桂上西一六		
N O	X	Y	辺長
9027	-111167.643	-27376.868	
4689	-111167.972	-27377.042	0.372
4658	-111184.467	-27393.338	23.187
4659	-111191.159	-27384.823	10.830
4660	-111195.073	-27372.331	13.091
4655	-111196.358	-27372.527	1.300
4656	-111197.802	-27362.802	9.832
4664	-111199.775	-27349.668	13.281
4665	-111202.303	-27332.815	17.042
4666	-111199.787	-27329.475	4.182
4667	-111195.000	-27328.830	4.830
4668	-111189.919	-27328.080	5.136
4669	-111184.882	-27327.300	5.097
9021	-111182.355	-27326.907	2.557
9020	-111182.081	-27328.585	1.700
9019	-111175.281	-27334.148	8.786
3028	-111170.713	-27336.136	4.982
9018	-111168.820	-27336.966	2.067
9017	-111166.611	-27336.560	2.246
3027	-111165.480	-27335.611	1.476
9016	-111160.632	-27331.542	6.329
9015	-111158.748	-27329.587	2.715
9014	-111154.908	-27326.636	4.843
9013	-111154.482	-27326.477	0.455
3026	-111154.150	-27326.489	0.332
9012	-111148.893	-27326.781	5.265
9011	-111146.709	-27327.660	2.354
4685	-111146.796	-27328.105	0.453
4686	-111151.566	-27329.811	5.066
9030	-111157.919	-27363.763	34.541
9029	-111190.751	-27356.135	33.706
9028	-111194.192	-27370.601	14.870
9027	-111167.643	-27376.868	27.279
面積	1715.7231835		
地積	1715.72 m ²		

127

地番	保 三六Bノ七号		
N O	X	Y	辺長
9009	-111144.042	-27314.612	
9010	-111145.953	-27324.687	10.255
9011	-111146.709	-27327.660	3.068
9012	-111148.893	-27326.781	2.354
3026	-111154.150	-27326.489	5.265
4677	-111155.227	-27319.818	6.757
4676	-111160.659	-27320.697	5.503
9026	-111161.183	-27317.438	3.301
9009	-111144.042	-27314.612	17.372
面積	127.0890320		
地積	127.08 m ²		

128

地番	保 三六Bノ六号		
N O	X	Y	辺長
3026	-111154.150	-27326.489	
9013	-111154.482	-27326.477	0.332
9014	-111154.908	-27326.636	0.455
9015	-111158.748	-27329.587	4.843
9016	-111160.632	-27331.542	2.715
3027	-111165.480	-27335.611	6.329
4675	-111167.278	-27324.502	11.254
9025	-111160.230	-27323.364	7.139
4676	-111160.659	-27320.697	2.701
4677	-111155.227	-27319.818	5.503
3026	-111154.150	-27326.489	6.757
面積	108.2538030		
地積	108.25 m ²		

129

地番	保 三六Bノ五号		
N O	X	Y	辺長
3027	-111165.480	-27335.611	
9017	-111166.611	-27336.560	1.476
9018	-111168.820	-27336.966	2.246
3028	-111170.713	-27336.136	2.067
4674	-111172.464	-27325.343	10.934
9024	-111169.937	-27324.932	2.560
4675	-111167.278	-27324.502	2.694
3027	-111165.480	-27335.611	11.254
面積	61.7515225		
地積	61.75 m ²		

130

地番	保 三六Bノ二号		
N O	X	Y	辺長
3028	-111170.713	-27336.136	
9019	-111175.281	-27334.148	4.982
9020	-111182.081	-27328.585	8.786
9021	-111182.355	-27326.907	1.700
9022	-111179.870	-27326.521	2.515
9023	-111174.885	-27325.736	5.046
4674	-111172.464	-27325.343	2.453
3028	-111170.713	-27336.136	10.934
面積	69.1324035		
地積	69.13 m ²		

131

地番	保 三六Bノ三号		
N O	X	Y	辺長
4658	-111184.467	-27393.338	
4653	-111194.044	-27388.059	10.936
4654	-111195.541	-27378.034	10.136
4655	-111196.358	-27372.527	5.567
4660	-111195.073	-27372.331	1.300
4659	-111191.159	-27384.823	13.091
4658	-111184.467	-27393.338	10.830
面積	57.6959645		
地積	57.69 m ²		

132

地番	保 三六Bノ一号		
N O	X	Y	辺長
9031	-111187.206	-27396.326	
4652	-111193.308	-27392.986	6.956
4653	-111194.044	-27388.059	4.982
4658	-111184.467	-27393.338	10.936
9031	-111187.206	-27396.326	4.053
面積	35.3407855		
地積	35.34 m ²		

133

地番	桂上今井三二ノ一四		
N O	X	Y	辺長
4663	-111184.188	-27398.009	
9031	-111187.206	-27396.326	3.456
4658	-111184.467	-27393.338	4.053
4661	-111181.232	-27395.119	3.693
4662	-111184.042	-27397.696	3.813
4663	-111184.188	-27398.009	0.345
面積	13.8690095		
地積	13.86 m ²		

134

地番	保 三六Bノ四号		
N O	X	Y	辺長
4645	-111190.861	-27400.309	
4651	-111192.406	-27399.025	2.009
4652	-111193.308	-27392.986	6.106
9031	-111187.206	-27396.326	6.956
4646	-111190.402	-27399.802	4.722
4645	-111190		