

S = 1 : 250

桂上野今井町

36 A

36 B

40

41

38

35 E

上桂今井町

X-111250

X-111250

X-111300

X-111300

Y-27500

Y-27450

Y-27500

Y-27450

図面の種類		画地出来形確認測量図			
街区番号		37	番号	縮尺	1 : 250
町名	桂上野西町				
京都市洛西第二土地区画整理組合					

101			
地番	桂上西二B		
N O	X	Y	辺長
4753	-111243.067	-27521.519	
4752	-111246.308	-27524.230	4.225
4751	-111256.891	-27523.327	10.621
9038	-111256.009	-27507.832	15.520
4755	-111241.841	-27508.645	14.191
4754	-111242.092	-27511.278	2.645
4753	-111243.067	-27521.519	10.287
面積	213.8088070		
地積	213.80㎡		

102			
地番	桂上西四		
N O	X	Y	辺長
4755	-111241.841	-27508.645	
9038	-111256.009	-27507.832	14.191
4756	-111255.968	-27507.115	0.718
9039	-111255.695	-27502.348	4.775
4757	-111254.912	-27488.656	13.714
4738	-111240.008	-27489.513	14.929
4737	-111240.501	-27494.611	5.122
4755	-111241.841	-27508.645	14.098
面積	279.5995870		
地積	279.59㎡		

103			
地番	桂上西三ノ一		
N O	X	Y	辺長
4738	-111240.008	-27489.513	
4757	-111254.912	-27488.656	14.929
4758	-111254.642	-27483.824	4.840
4759	-111254.551	-27482.035	1.791
4739	-111239.370	-27482.899	15.206
4738	-111240.008	-27489.513	6.645
面積	99.9519045		
地積	99.95㎡		

104			
地番	桂上西三ノ三		
N O	X	Y	辺長
4739	-111239.370	-27482.899	
4759	-111254.551	-27482.035	15.206
4760	-111254.345	-27478.442	3.599
4740	-111239.024	-27479.318	15.346
4739	-111239.370	-27482.899	3.598
面積	54.9454570		
地積	54.94㎡		

105			
地番	桂上西三ノ四		
N O	X	Y	辺長
4740	-111239.024	-27479.318	
4760	-111254.345	-27478.442	15.346
4761	-111254.200	-27475.834	2.612
4762	-111254.152	-27474.947	0.888
4742	-111238.688	-27475.830	15.489
4741	-111238.864	-27477.666	1.844
4740	-111239.024	-27479.318	1.660
面積	53.9753300		
地積	53.97㎡		

106			
地番	桂上西三ノ五		
N O	X	Y	辺長
4742	-111238.688	-27475.830	
4762	-111254.152	-27474.947	15.489
4763	-111253.950	-27471.443	3.510
4743	-111238.354	-27472.345	15.622
4742	-111238.688	-27475.830	3.501
面積	54.5087750		
地積	54.50㎡		

107			
地番	桂上西三ノ六		
N O	X	Y	辺長
4743	-111238.354	-27472.345	
4763	-111253.950	-27471.443	15.622
4772	-111253.849	-27469.582	1.864
4773	-111253.755	-27467.948	1.637
4744	-111238.020	-27468.857	15.761
4743	-111238.354	-27472.345	3.504
面積	54.9405480		
地積	54.94㎡		

108			
地番	桂上西三ノ二		
N O	X	Y	辺長
4744	-111238.020	-27468.857	
4773	-111253.755	-27467.948	15.761
4774	-111253.552	-27464.353	3.601
4745	-111237.677	-27465.279	15.902
4744	-111238.020	-27468.857	3.594
面積	56.9351100		
地積	56.93㎡		

109			
地番	保三七ノ一号		
N O	X	Y	辺長
4745	-111237.677	-27465.279	
4774	-111253.552	-27464.353	15.902
4775	-111253.326	-27460.508	3.852
4776	-111253.316	-27460.374	0.134
4746	-111237.294	-27461.287	16.048
4745	-111237.677	-27465.279	4.010
面積	63.8514150		
地積	63.85㎡		

110			
地番	保三七ノ三号		
N O	X	Y	辺長
4746	-111237.294	-27461.287	
4776	-111253.316	-27460.374	16.048
4721	-111252.856	-27452.793	7.595
4748	-111234.180	-27453.868	18.707
4747	-111237.108	-27459.348	6.213
4746	-111237.294	-27461.287	1.948
面積	129.5647220		
地積	129.56㎡		

111			
地番	桂上西五ノ二		
N O	X	Y	辺長
4748	-111234.180	-27453.868	
4721	-111252.856	-27452.793	18.707
4720	-111252.662	-27449.537	3.262
4719	-111252.040	-27438.550	11.005
4724	-111251.654	-27431.740	6.821
4723	-111244.389	-27434.808	7.886
4726	-111231.031	-27440.435	14.495
4728	-111229.540	-27444.665	4.485
4749	-111229.436	-27444.990	0.341
4748	-111234.180	-27453.868	10.066
面積	367.2168400		
地積	367.21㎡		

112			
地番	桂上西二七ノ一一		
N O	X	Y	辺長
4719	-111252.040	-27438.550	
4695	-111256.532	-27438.293	4.499
4716	-111259.012	-27438.166	2.483
4715	-111258.760	-27433.676	4.497
4711	-111258.488	-27428.854	4.830
4712	-111258.428	-27428.879	0.065
4724	-111251.654	-27431.740	7.353
4719	-111252.040	-27438.550	6.821
面積	56.3597930		
地積	56.35㎡		

113			
地番	桂上西二七ノ一〇		
N O	X	Y	辺長
4715	-111258.760	-27433.676	
4705	-111267.752	-27433.185	9.005
4706	-111267.351	-27426.107	7.089
4707	-111266.393	-27425.526	1.120
4708	-111266.057	-27425.666	0.364
4711	-111258.488	-27428.854	8.213
4715	-111258.760	-27433.676	4.830
面積	57.5596870		
地積	57.55㎡		

114			
地番	桂上西二七ノ九		
N O	X	Y	辺長
4716	-111259.012	-27438.166	
4704	-111268.006	-27437.667	9.008
4705	-111267.752	-27433.185	4.489
4715	-111258.760	-27433.676	9.005
4716	-111259.012	-27438.166	4.497
面積	40.4678330		
地積	40.46㎡		

115			
地番	桂上西二七ノ八		
N O	X	Y	辺長
9037	-111256.792	-27442.798	
4703	-111268.261	-27442.167	11.486
4704	-111268.006	-27437.667	4.507
4716	-111259.012	-27438.166	9.008
4695	-111256.532	-27438.293	2.483
9037	-111256.792	-27442.798	4.512
面積	51.7646265		
地積	51.76㎡		

116			
地番	桂上西二七ノ七		
N O	X	Y	辺長
4714	-111257.051	-27447.295	
4701	-111268.520	-27446.663	11.486
4702	-111268.295	-27442.775	3.895
4703	-111268.261	-27442.167	0.609
9037	-111256.792	-27442.798	11.486
4714	-111257.051	-27447.295	4.504
面積	51.7316130		
地積	51.73㎡		

117			
地番	桂上西二七ノ四		
N O	X	Y	辺長
4713	-111257.286	-27451.280	
4700	-111268.751	-27450.662	11.482
4701	-111268.520	-27446.663	4.006
4714	-111257.051	-27447.295	11.486
4717	-111257.168	-27449.290	1.998
4713	-111257.286	-27451.280	1.993
面積	45.9231790		
地積	45.92㎡		


118			
地番	桂上西二七ノ一二		
N O	X	Y	辺長
4720	-111252.662	-27449.537	
4717	-111257.168	-27449.290	4.513
4714	-111257.051	-27447.295	1.998
9037	-111256.792	-27442.798	4.504
4695	-111256.532	-27438.293	4.512
4719	-111252.040	-27438.550	4.499
4720	-111252.662	-27449.537	11.005
面積	49.6038140		
地積	49.60㎡		

119			
地番	桂上西二七ノ六		
N O	X	Y	辺長
4718	-111257.548	-27455.787	
4699	-111269.010	-27455.156	11.479
4700	-111268.751	-27450.662	4.501
4713	-111257.286	-27451.280	11.482
4718	-111257.548	-27455.787	4.515
面積	51.7541640		
地積	51.75㎡		

120			
地番	桂上西二七ノ五		
N O	X	Y	辺長
4777	-111257.823	-27460.279	
4697	-111269.269	-27459.649	11.463
4698	-111269.223	-27458.838	0.812
4699	-111269.010	-27455.156	3.688
4718	-111257.548	-27455.787	11.479
4777	-111257.823	-27460.279	4.500
面積	51.6271240		
地積	51.62㎡		

121			
地番	桂上西二七ノ一三		
N O	X	Y	辺長
4775	-111253.326	-27460.508	
4777	-111257.823	-27460.279	4.503
4718	-111257.548	-27455.787	4.500
4713	-111257.286	-27451.280	4.515
4717	-111257.168	-27449.290	1.993
4720	-111252.662	-27449.537	4.513
4721	-111252.856	-27452.793	3.262
4776	-111253.316	-27460.374	7.595
4775	-111253.326	-27460.508	0.134
面積	49.5726865		
地積	49.57㎡		

122			
地番	桂上西七ノ一B		
N O	X	Y	辺長
4772	-111253.849	-27469.582	
4696	-111269.782	-27468.674	15.959
4697	-111269.269	-27459.649	9.040
4777	-111257.823	-27460.279	11.463
4775	-111253.326	-27460.508	4.503
4774	-111253.552	-27464.353	3.852
4773	-111253.755	-27467.948	3.601
4772	-111253.849	-27469.582	1.637
面積	144.5658155		
地積	144.56 ㎡		

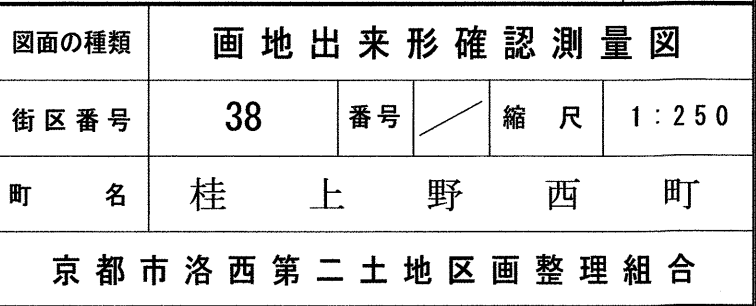

299			
地番	桂上西八ノ一		
N O	X	Y	辺長
4873	-111278.647	-27518.439	
4872	-111281.882	-27521.241	4.280
4871	-111290.914	-27520.473	9.065
4784	-111298.736	-27519.808	7.850
4883	-111298.167	-27509.910	9.914
4882	-111298.017	-27507.405	2.509
4881	-111298.012	-27507.296	0.109
4874	-111278.087	-27508.431	19.957
4873	-111278.647	-27518.439	10.024
面積	251.1550290		
地積	251.15㎡		

300			
地番	桂上西七A		
N O	X	Y	辺長
4874	-111278.087	-27508.431	
4881	-111298.012	-27507.296	19.957
4880	-111297.379	-27496.172	11.142
4879	-111296.783	-27485.627	10.562
4878	-111296.667	-27483.627	2.003
4877	-111296.555	-27481.630	2.000
4884	-111296.235	-27475.863	5.776
4869	-111276.294	-27477.015	19.974
4876	-111276.495	-27480.507	3.498
4875	-111277.585	-27499.474	18.998
4874	-111278.087	-27508.431	8.971
面積	628.1711715		
地積	628.17㎡		

301			
地番	桂上西一〇		
N O	X	Y	辺長
4869	-111276.294	-27477.015	
4884	-111296.235	-27475.863	19.974
4822	-111295.967	-27471.138	4.733
9047	-111295.933	-27470.593	0.546
4870	-111275.991	-27471.748	19.975
4869	-111276.294	-27477.015	5.276
面積	105.4180215		
地積	105.41㎡		

302			
地番	桂上西一一B		
N O	X	Y	辺長
4870	-111275.991	-27471.748	
9047	-111295.933	-27470.593	19.975
4821	-111295.535	-27464.262	6.343
4868	-111275.628	-27465.427	19.941
4870	-111275.991	-27471.748	6.331
面積	126.4837670		
地積	126.48㎡		

303			
地番	桂上西七ノ一A		
N O	X	Y	辺長
4868	-111275.628	-27465.427	
4821	-111295.535	-27464.262	19.941
4820	-111295.006	-27454.784	9.493
4866	-111275.083	-27455.943	19.957
4867	-111275.232	-27458.547	2.608
4868	-111275.628	-27465.427	6.891
面積	189.4411410		
地積	189.44㎡		

304			
地番	桂上西一二C		
N O	X	Y	辺長
4866	-111275.083	-27455.943	
4820	-111295.006	-27454.784	19.957
9048	-111294.538	-27446.702	8.096
4865	-111274.622	-27447.855	19.949
4866	-111275.083	-27455.943	8.101
面積	161.5861195		
地積	161.58㎡		

305			
地番	桂上西二七ノ一		
N O	X	Y	辺長
4865	-111274.622	-27447.855	
9048	-111294.538	-27446.702	19.949
4819	-111294.518	-27446.348	0.355
4836	-111292.698	-27414.437	31.963
4837	-111290.668	-27415.291	2.202
4838	-111274.462	-27422.122	17.587
4839	-111274.014	-27422.304	0.484
4840	-111273.210	-27423.519	1.457
4864	-111274.321	-27442.575	19.088
4865	-111274.622	-27447.855	5.289
面積	573.9749590		
地積	573.97㎡		

306			
地番	桂上西一二B		
N O	X	Y	辺長
4819	-111294.518	-27446.348	
4818	-111316.626	-27445.089	22.144
4817	-111312.923	-27428.582	16.917
4825	-111308.531	-27408.909	20.157
4826	-111307.305	-27408.299	1.369
4827	-111306.948	-27408.443	0.385
4836	-111292.698	-27414.437	15.459
4819	-111294.518	-27446.348	31.963
面積	670.7699045		
地積	670.76㎡		

307			
地番	桂上西一一A		
N O	X	Y	辺長
4822	-111295.967	-27471.138	
4823	-111299.708	-27470.920	3.747
4824	-111303.102	-27470.727	3.399
4814	-111316.795	-27469.939	13.716
4815	-111316.802	-27469.785	0.154
4816	-111317.685	-27449.812	19.993
4818	-111316.626	-27445.089	4.840
4819	-111294.518	-27446.348	22.144
9048	-111294.538	-27446.702	0.355
4820	-111295.006	-27454.784	8.096
4821	-111295.535	-27464.262	9.493
9047	-111295.933	-27470.593	6.343
4822	-111295.967	-27471.138	0.546
面積	546.8721120		
地積	546.87㎡		

308			
地番	桂上西九ノ一		
N O	X	Y	辺長
4810	-111303.688	-27481.220	
4811	-111314.331	-27480.606	10.661
4801	-111316.399	-27478.986	2.627
4814	-111316.795	-27469.939	9.056
4824	-111303.102	-27470.727	13.716
4810	-111303.688	-27481.220	10.509
面積	137.1130390		
地積	137.11㎡		

309			
地番	桂上西九ノ二		
N O	X	Y	辺長
4809	-111300.290	-27481.402	
4810	-111303.688	-27481.220	3.403
4824	-111303.102	-27470.727	10.509
4823	-111299.708	-27470.920	3.399
4809	-111300.290	-27481.402	10.498
面積	35.7250500		
地積	35.72㎡		

310			
地番	桂上西九ノ三		
N O	X	Y	辺長
4877	-111296.555	-27481.630	
4809	-111300.290	-27481.402	3.742
4823	-111299.708	-27470.920	10.498
4822	-111295.967	-27471.138	3.747
4884	-111296.235	-27475.863	4.733
4877	-111296.555	-27481.630	5.776
面積	39.3140830		
地積	39.31㎡		

311			
地番	桂上西九ノ四		
N O	X	Y	辺長
4878	-111296.667	-27483.627	
4800	-111316.246	-27482.482	19.612
4801	-111316.399	-27478.986	3.499
4811	-111314.331	-27480.606	2.627
4810	-111303.688	-27481.220	10.661
4809	-111300.290	-27481.402	3.403
4877	-111296.555	-27481.630	3.742
4878	-111296.667	-27483.627	2.000
面積	40.7985245		
地積	40.79㎡		

312			
地番	桂上西九ノ五		
N O	X	Y	辺長
4879	-111296.783	-27485.627	
4808	-111300.523	-27485.403	3.747
4807	-111303.930	-27485.209	3.413
4806	-111314.154	-27484.619	10.241
4799	-111316.093	-27485.987	2.373
4800	-111316.246	-27482.482	3.508
4878	-111296.667	-27483.627	19.612
4879	-111296.783	-27485.627	2.003
面積	40.6074500		
地積	40.60㎡		

313			
地番	桂上西九ノ八		
N O	X	Y	辺長
9046	-111304.128	-27488.774	
4798	-111316.001	-27488.089	11.893
4799	-111316.093	-27485.987	2.104
4806	-111314.154	-27484.619	2.373
4807	-111303.930	-27485.209	10.241
9046	-111304.128	-27488.774	3.570
面積	41.6157595		
地積	41.61㎡		


314			
地番	桂上西九ノ九		
N O	X	Y	辺長
9045	-111304.323	-27492.270	
4796	-111315.848	-27491.609	11.544
4797	-111315.885	-27490.727	0.883
4798	-111316.001	-27488.089	2.641
9046	-111304.128	-27488.774	11.893
9045	-111304.323	-27492.270	3.501
面積	41.0518720		
地積	41.05㎡		

315			
地番	桂上西九ノ一〇		
N O	X	Y	辺長
4812	-111304.518	-27495.766	
4795	-111315.699	-27495.120	11.200
4796	-111315.848	-27491.609	3.514
9045	-111304.323	-27492.270	11.544
4812	-111304.518	-27495.766	3.501
面積	39.7902660		
地積	39.79㎡		


316			
地番	桂上西九ノ七		
N O	X	Y	辺長
9043	-111301.126	-27495.959	
9042	-111304.169	-27495.786	3.048
4812	-111304.518	-27495.766	0.350
9045	-111304.323	-27492.270	3.501
9046	-111304.128	-27488.774	3.501
4807	-111303.930	-27485.209	3.570
4808	-111300.523	-27485.403	3.413
9043	-111301.126	-27495.959	10.573
面積	35.9993255		
地積	35.99㎡		

317			
地番	桂上西九ノ六		
N O	X	Y	辺長
4880	-111297.379	-27496.172	
9044	-111300.777	-27495.979	3.403
9043	-111301.126	-27495.959	0.350
4808	-111300.523	-27485.403	10.573
4879	-111296.783	-27485.627	3.747
4880	-111297.379	-27496.172	10.562
面積	39.6270890		
地積	39.62㎡		

318			
地番	桂上西九ノ一一		
N O	X	Y	辺長
9041	-111304.383	-27499.485	
4794	-111315.542	-27498.840	11.178
4795	-111315.699	-27495.120	3.723
4812	-111304.518	-27495.766	11.200
9042	-111304.169	-27495.786	0.350
9041	-111304.383	-27499.485	3.705
面積	42.1001875		
地積	42.10 m ²		

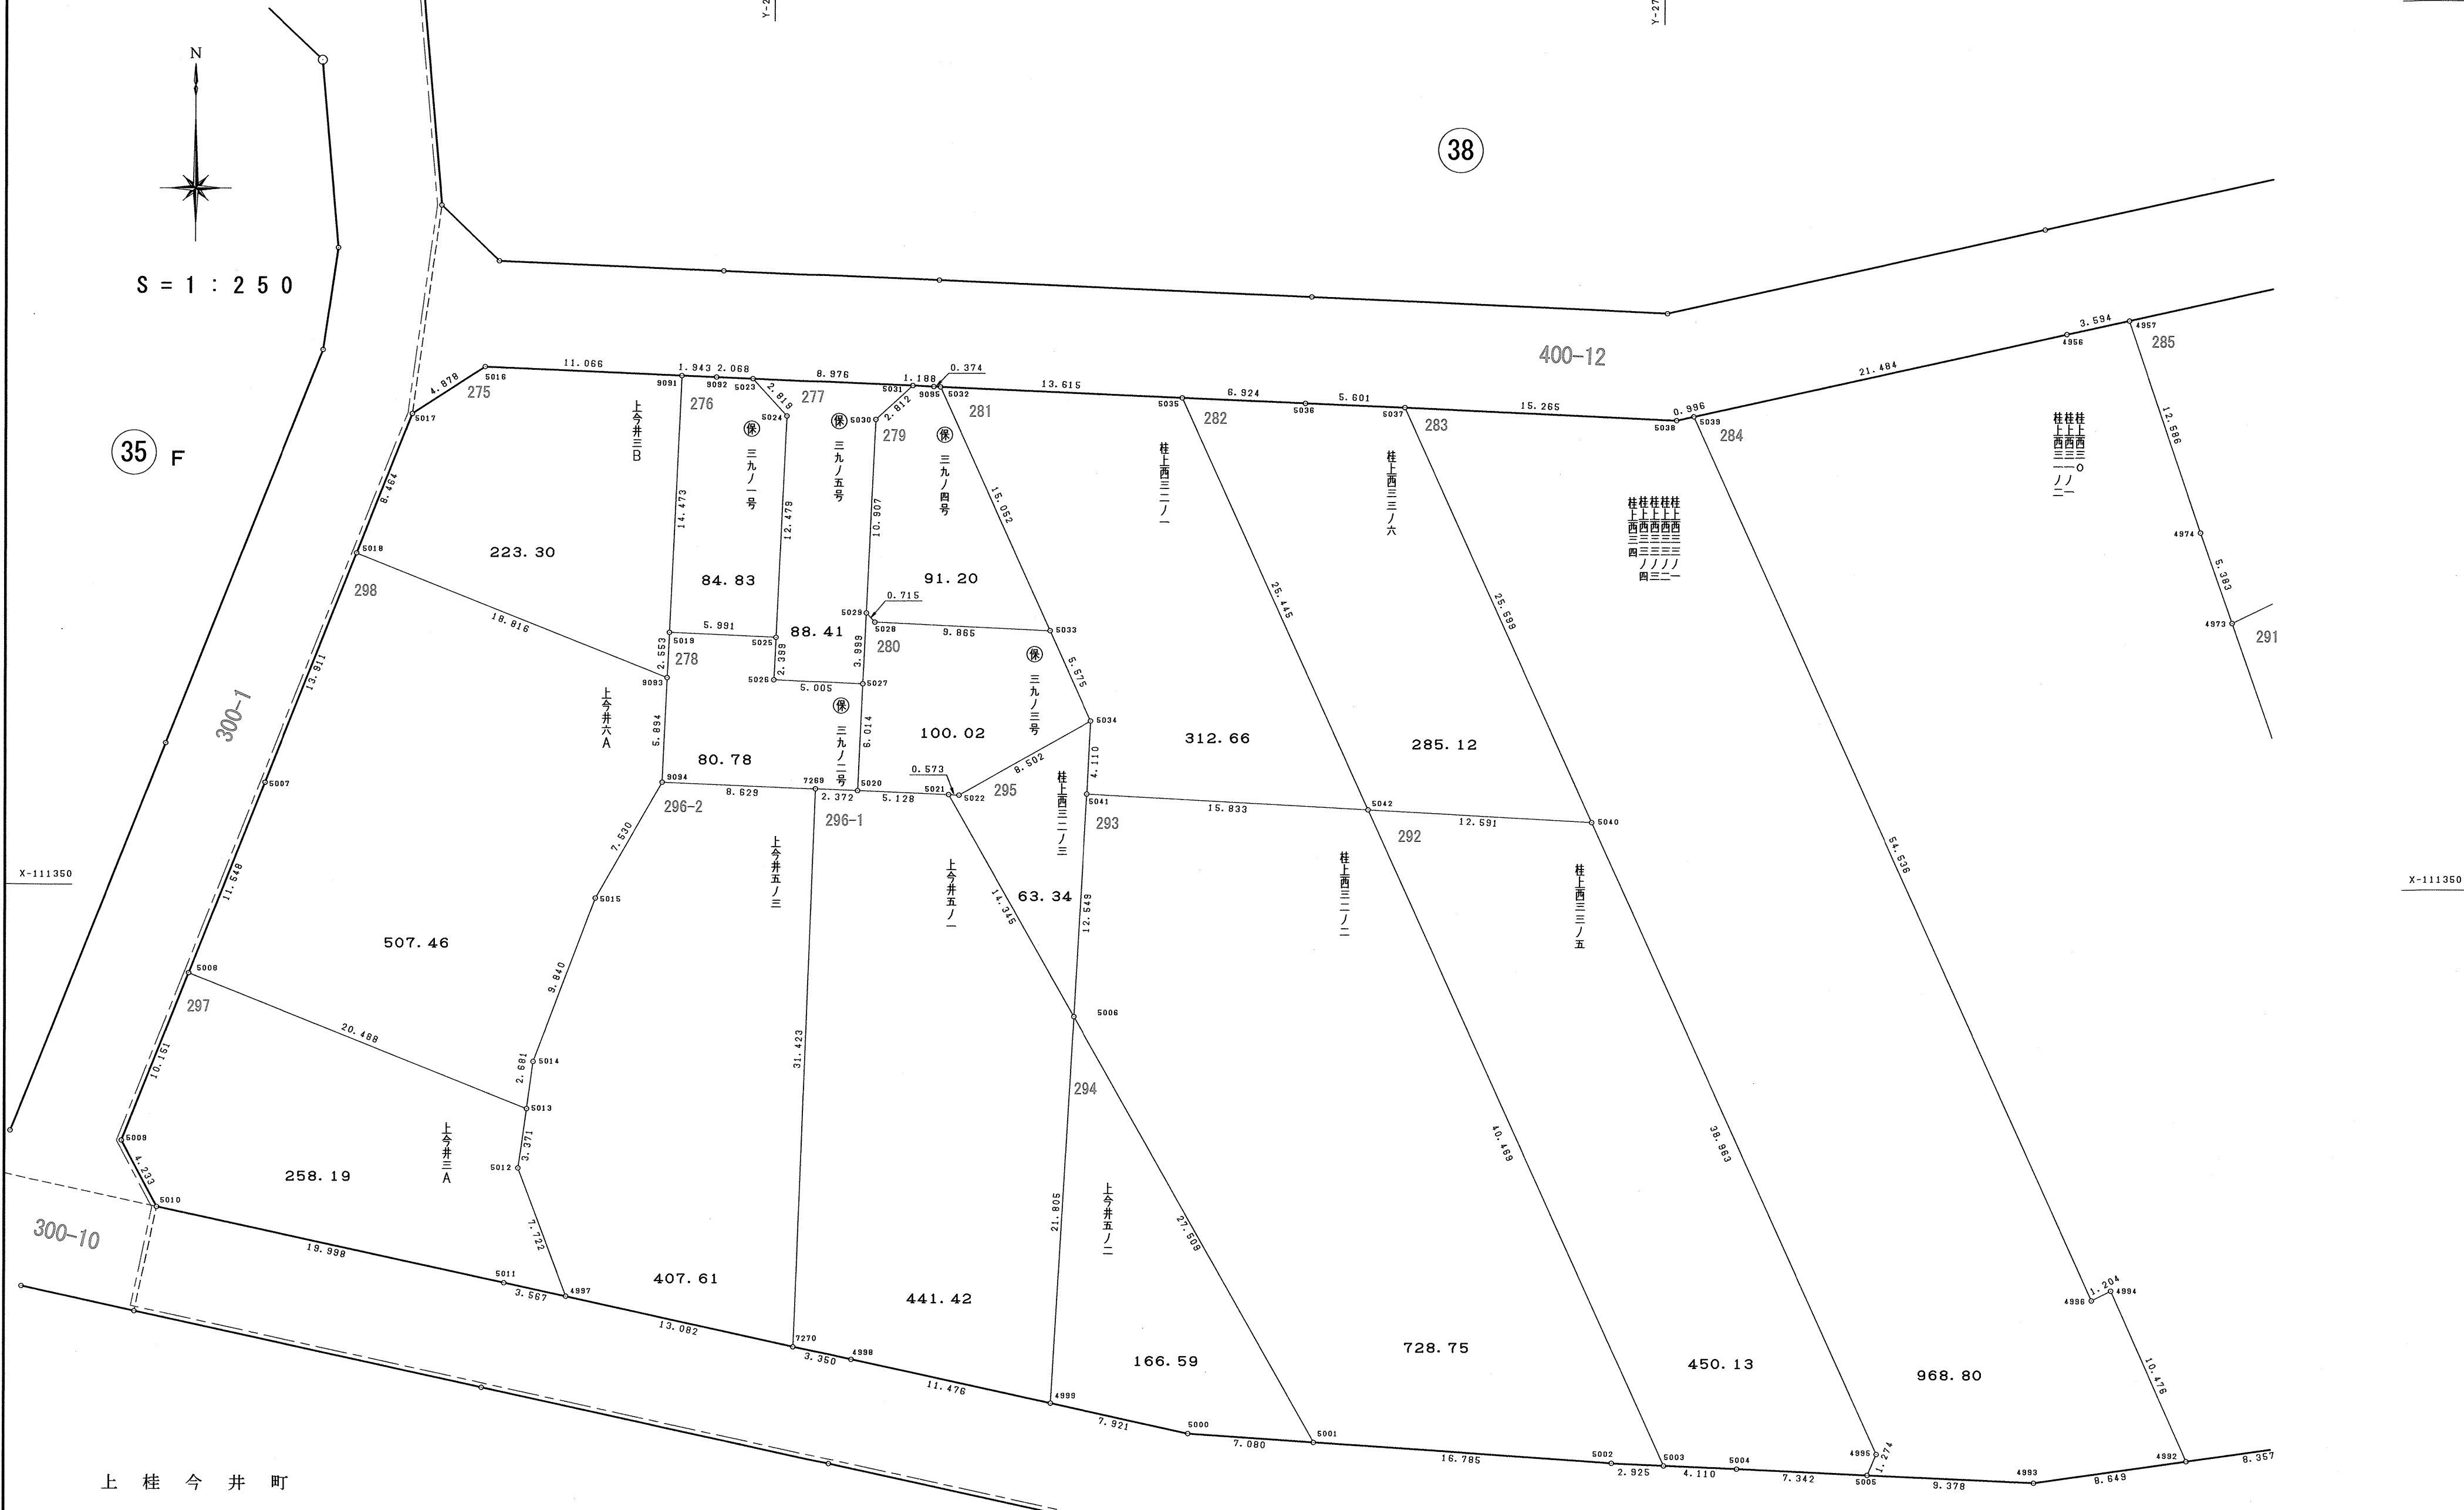

図面の種類	画地出来形確認測量図				
街区番号	39 1/2	番号		縮尺	1 : 2 5 0
町名	桂上野西町				
京都市洛西第二土地区画整理組合					

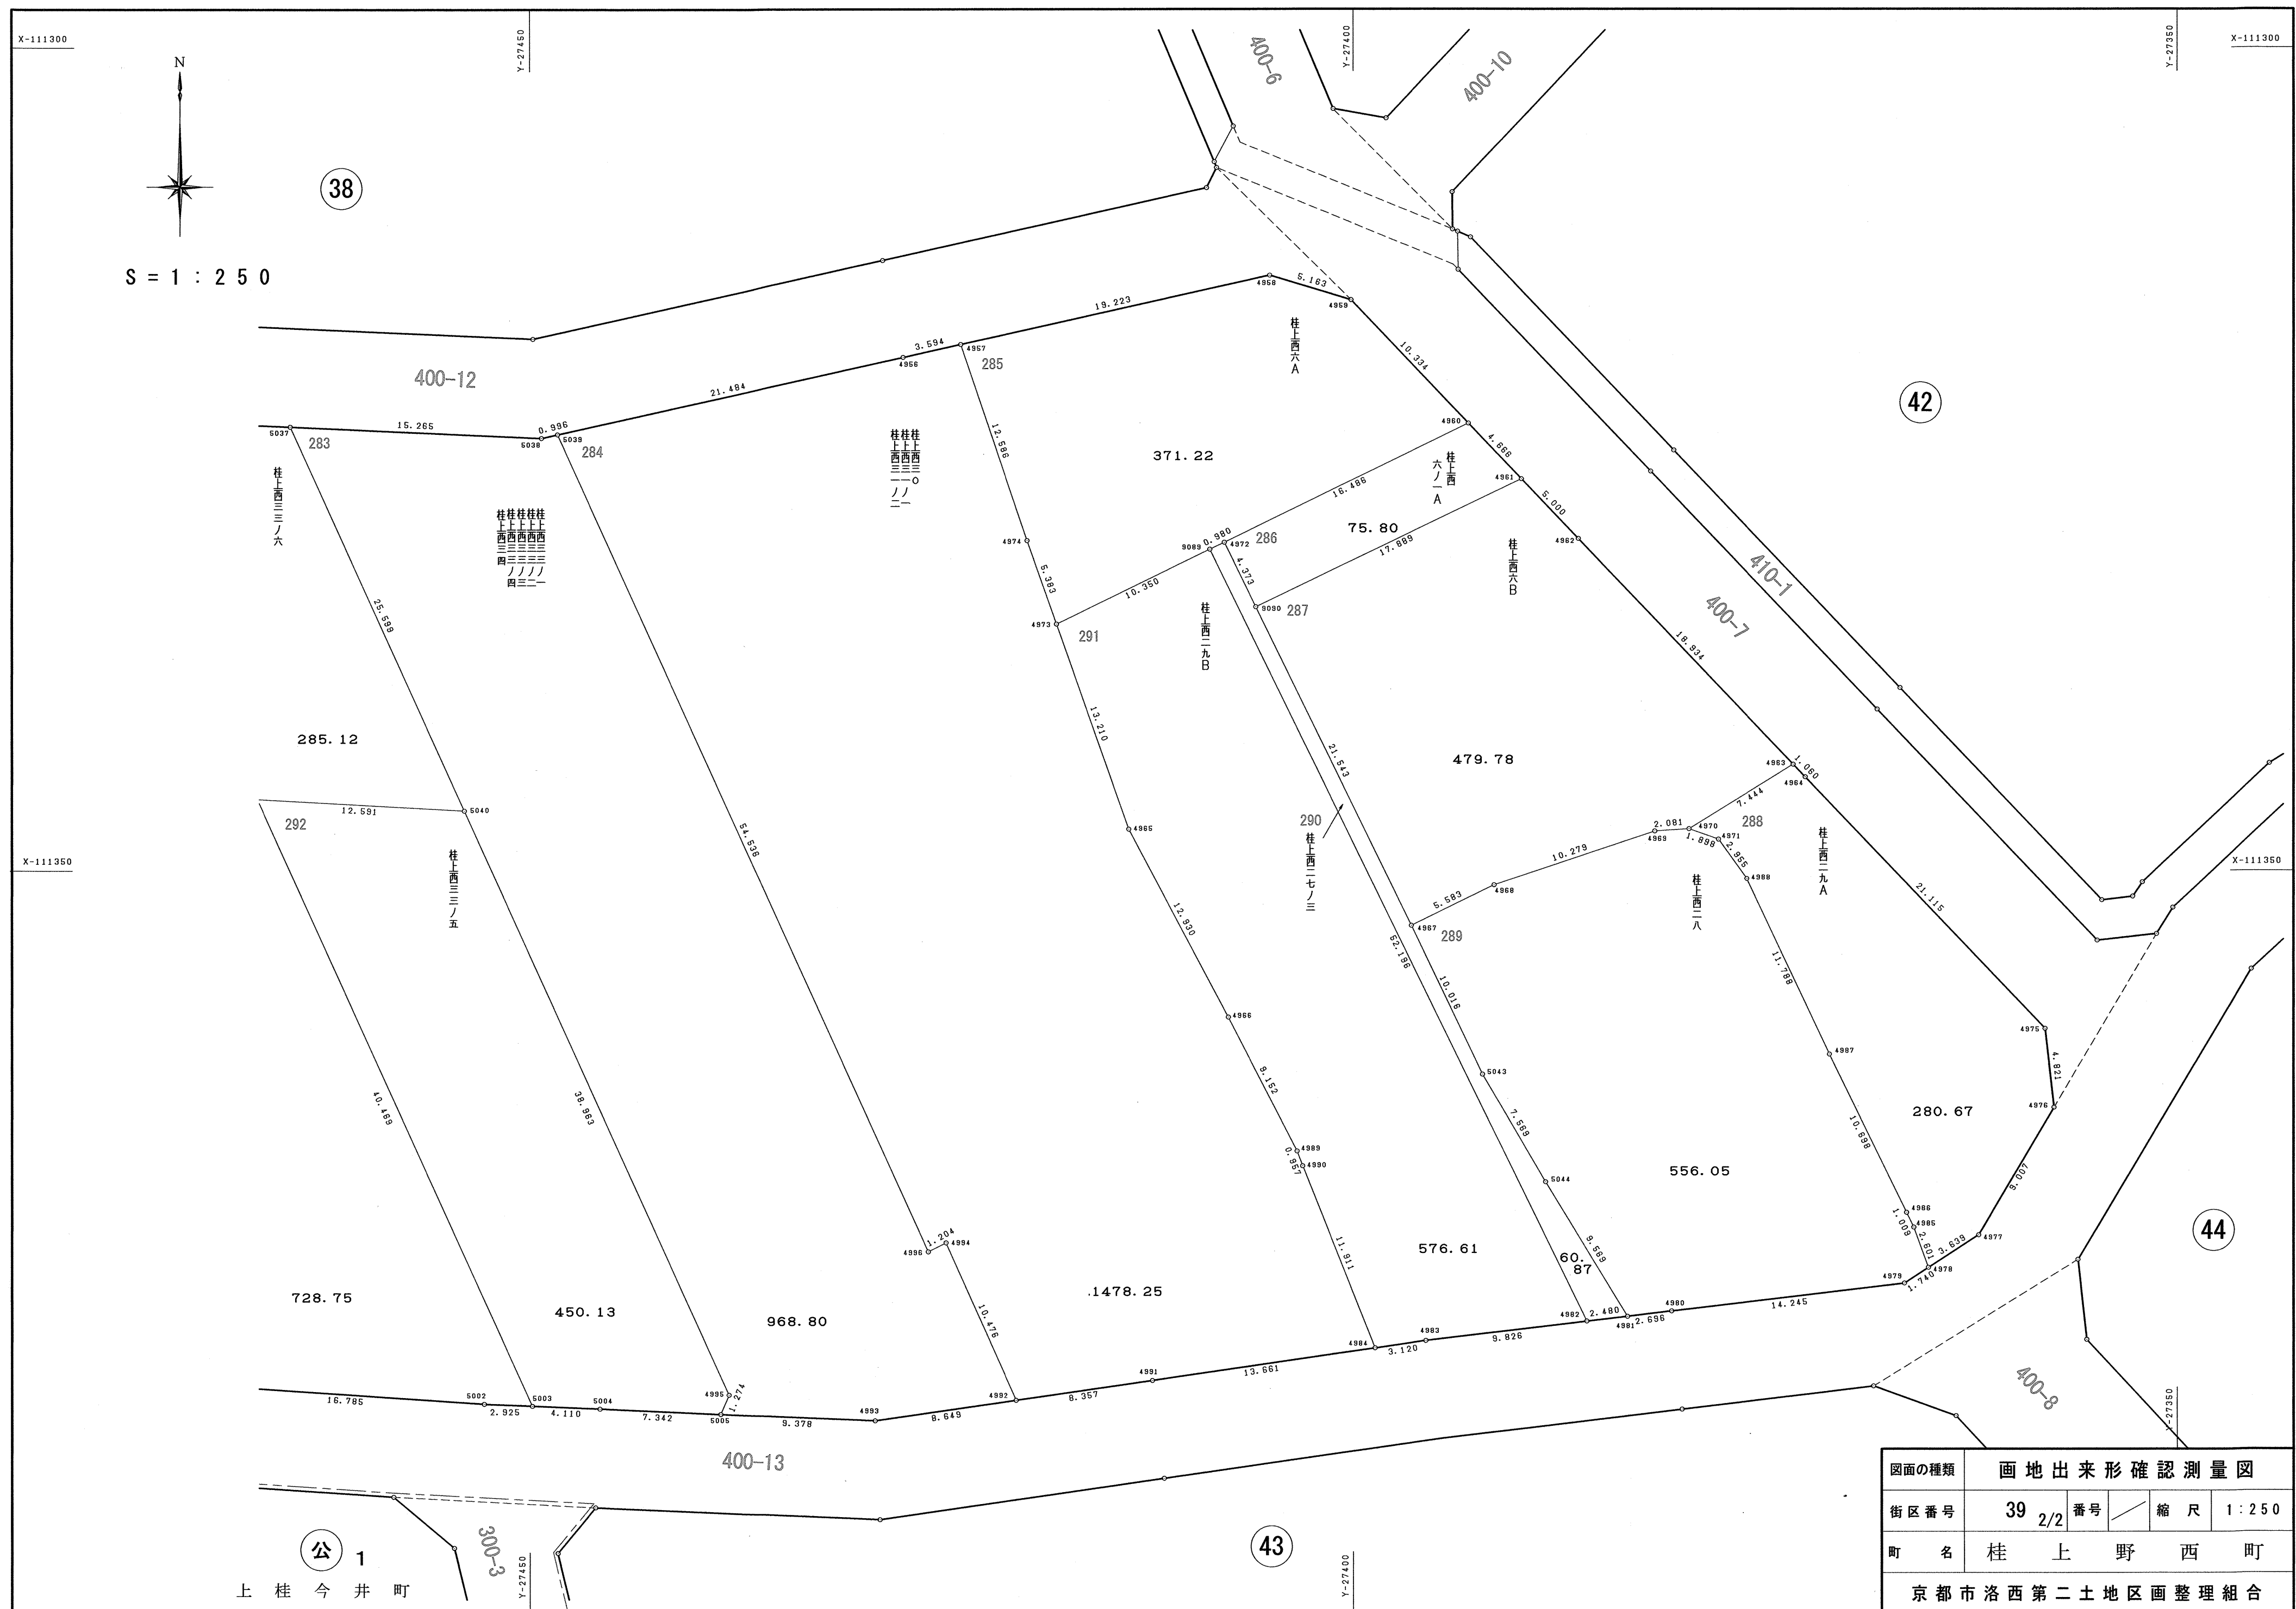

275

地番	上今井三B		
N O	X	Y	辺長
5016	-111320.802	-27516.242	
5017	-111323.452	-27520.337	4.878
5018	-111331.320	-27523.458	8.464
9093	-111338.280	-27505.977	18.816
5019	-111335.730	-27505.849	2.553
9091	-111321.272	-27505.186	14.473
5016	-111320.802	-27516.242	11.066
面積	223.3047600		
地積	223.30㎡		

276

地番	保 三九ノ一号		
N O	X	Y	辺長
9091	-111321.272	-27505.186	
5019	-111335.730	-27505.849	14.473
5025	-111335.990	-27499.864	5.991
5024	-111323.525	-27499.279	12.479
5023	-111321.443	-27501.179	2.819
9092	-111321.354	-27503.245	2.068
9091	-111321.272	-27505.186	1.943
面積	84.8366405		
地積	84.83㎡		

277

地番	保 三九ノ五号		
N O	X	Y	辺長
5023	-111321.443	-27501.179	
5024	-111323.525	-27499.279	2.819
5025	-111335.990	-27499.864	12.479
5026	-111338.386	-27499.977	2.399
5027	-111338.620	-27494.977	5.005
5029	-111334.625	-27494.790	3.999
5030	-111323.730	-27494.285	10.907
5031	-111321.831	-27492.211	2.812
5023	-111321.443	-27501.179	8.976
面積	88.4134045		
地積	88.41㎡		

278

地番	保 三九ノ二号		
N O	X	Y	辺長
5019	-111335.730	-27505.849	
9093	-111338.280	-27505.977	2.553
9094	-111344.168	-27506.248	5.894
7269	-111344.528	-27497.627	8.629
5020	-111344.627	-27495.257	2.372
5027	-111338.620	-27494.977	6.014
5026	-111338.386	-27499.977	5.005
5025	-111335.990	-27499.864	2.399
5019	-111335.730	-27505.849	5.991
面積	80.7841630		
地積	80.78㎡		

279

地番	保 三九ノ四号		
N O	X	Y	辺長
5031	-111321.831	-27492.211	
5030	-111323.730	-27494.285	2.812
5029	-111334.625	-27494.790	10.907
5028	-111335.152	-27494.307	0.715
5033	-111335.615	-27484.453	9.865
5032	-111321.898	-27490.650	15.052
9095	-111321.882	-27491.024	0.374
5031	-111321.831	-27492.211	1.188
面積	91.2042040		
地積	91.20㎡		

280

地番	保 三九ノ三号		
N O	X	Y	辺長
5029	-111334.625	-27494.790	
5027	-111338.620	-27494.977	3.999
5020	-111344.627	-27495.257	6.014
5021	-111344.845	-27490.134	5.128
5022	-111344.872	-27489.562	0.573
5034	-111340.695	-27482.157	8.502
5033	-111335.615	-27484.453	5.575
5028	-111335.152	-27494.307	9.865
5029	-111334.625	-27494.790	0.715
面積	100.0263855		
地積	100.02㎡		

281

地番	桂上西三二ノ一		
N O	X	Y	辺長
5032	-111321.898	-27490.650	
5033	-111335.615	-27484.453	15.052
5034	-111340.695	-27482.157	5.575
5041	-111344.800	-27482.359	4.110
5042	-111345.665	-27466.550	15.833
5035	-111322.487	-27477.048	25.445
5032	-111321.898	-27490.650	13.615
面積	312.6612750		
地積	312.66㎡		

282

地番	桂上西三三ノ六		
N O	X	Y	辺長
5035	-111322.487	-27477.048	
5042	-111345.665	-27466.550	25.445
5040	-111346.355	-27453.978	12.591
5037	-111323.034	-27464.534	25.599
5036	-111322.786	-27470.130	5.601
5035	-111322.487	-27477.048	6.924
面積	285.1287590		
地積	285.12㎡		

283

地番	桂上西三三ノ一, 三三ノ二, 三三ノ三 三三ノ四, 三四		
N O	X	Y	辺長
5037	-111323.034	-27464.534	
5040	-111346.355	-27453.978	25.599
4995	-111381.851	-27437.911	38.963
5005	-111383.023	-27438.411	1.274
4993	-111383.435	-27429.042	9.378
4992	-111382.200	-27420.482	8.649
4994	-111372.630	-27424.744	10.476
4996	-111373.175	-27425.818	1.204
5039	-111323.494	-27448.312	54.536
5038	-111323.711	-27449.284	0.996
5037	-111323.034	-27464.534	15.265
面積	968.8013310		
地積	968.80㎡		

284

地番	桂上西三〇, 三一ノ一, 三一ノ二		
N O	X	Y	辺長
5039	-111323.494	-27448.312	
4996	-111373.175	-27425.818	54.536
4994	-111372.630	-27424.744	1.204
4992	-111382.200	-27420.482	10.476
4991	-111381.006	-27412.211	8.357
4984	-111379.039	-27398.692	13.661
4990	-111367.967	-27403.082	11.911
4989	-111367.074	-27403.427	0.957
4966	-111358.928	-27407.598	9.152
4965	-111347.497	-27413.642	12.930
4973	-111335.034	-27418.021	13.210
4974	-111329.856	-27419.808	5.383
4957	-111318.032	-27423.836	12.586
4956	-111318.815	-27427.344	3.594
5039	-111323.494	-27448.312	21.484
面積	1478.2573695		
地積	1478.25㎡		

285

地番	桂上西六A		
N O	X	Y	辺長
4957	-111318.032	-27423.836	
4974	-111329.856	-27419.808	12.586
4973	-111335.034	-27418.021	5.383
9089	-111330.496	-27408.719	10.350
4972	-111330.066	-27407.838	0.980
4960	-111322.836	-27393.022	16.486
4959	-111315.338	-27400.133	10.334
4958	-111313.844	-27405.075	5.163
4957	-111318.032	-27423.836	19.223
面積	371.2228070		
地積	371.22㎡		

286

地番	桂上西六ノ一A		
N O	X	Y	辺長
4972	-111330.066	-27407.838	
9090	-111333.997	-27405.922	4.373
4961	-111326.222	-27389.811	17.889
4960	-111322.836	-27393.022	4.666
4972	-111330.066	-27407.838	16.486
面積	75.8058735		
地積	75.80㎡		

287

地番	桂上西六B		
N O	X	Y	辺長
9090	-111333.997	-27405.922	
4967	-111353.361	-27396.480	21.543
4968	-111350.891	-27391.473	5.583
4969	-111347.622	-27381.728	10.279
4970	-111347.487	-27379.651	2.081
4963	-111343.570	-27373.321	7.444
4962	-111329.850	-27386.370	18.934
4961	-111326.222	-27389.811	5.000
9090	-111333.997	-27405.922	17.889
面積	479.7878735		
地積	479.78㎡		

288

地番	桂上西二九A		
N O	X	Y	辺長
4970	-111347.487	-27379.651	
4971	-111348.116	-27377.860	1.898
4988	-111350.518	-27376.138	2.955
4987	-111361.185	-27371.121	11.788
4986	-111370.807	-27366.444	10.698
4985	-111371.709	-27365.992	1.009
4978	-111374.155	-27365.108	2.601
4977	-111372.171	-27362.058	3.639
4976	-111364.414	-27357.481	9.007
4975	-111359.623	-27358.022	4.821
4964	-111344.338	-27372.590	21.115
4963	-111343.570	-27373.321	1.060
4970	-111347.487	-27379.651	7.444
面積	280.6793430		
地積	280.67㎡		

289

地番	桂上西二八		
N O	X	Y	辺長
4967	-111353.361	-27396.480	
5043	-111362.402	-27392.170	10.016
5044	-111368.942	-27388.359	7.569
4981	-111377.118	-27383.387	9.569
4980	-111376.796	-27380.710	2.696
4979	-111375.104	-27366.566	14.245
4978	-111374.155	-27365.108	1.740
4985	-111371.709	-27365.992	2.601
4986	-111370.807	-27366.444	1.009
4987	-111361.185	-27371.121	10.698
4988	-111350.518	-27376.138	11.788
4971	-111348.116	-27377.860	2.955
4970	-111347.487	-27379.651	1.898
4969	-111347.622	-27381.728	2.081
4968	-111350.891	-27391.473	10.279
4967	-111353.361	-27396.480	5.583
面積	556.0536140		
地積	556.05㎡		

290

地番	桂上西二七ノ三		
N O	X	Y	辺長
9089	-111330.496	-27408.719	
4982	-111377.415	-27385.849	52.196
4981	-111377.118	-27383.387	2.480
5044	-111368.942	-27388.359	9.569
5043	-111362.402	-27392.170	7.569
4967	-111353.361	-27396.480	10.016
9090	-111333.997	-27405.922	21.543
4972	-111330.066	-27407.838	4.373
9089	-111330.496	-27408.719	0.980
面積	60.8749580		
地積	60.87㎡		

291

地番	桂上西二九B		
N O	X	Y	辺長
4973	-111335.034	-27418.021	
4965	-111347.497	-27413.642	13.210
4966	-111358.928	-27407.598	12.930
4989	-111367.074	-27403.427	9.152
4990	-111367.967	-27403.082	0.957
4984	-111379.039	-27398.692	11.911
4983	-111378.590	-27395.604	3.120
4982	-111377.415	-27385.849	9.826
9089	-111330.496	-27408.719	52.196
4973	-111335.034	-27418.021	10.350
面積	576.6191365		
地積	576.61㎡		

292

S = 1 : 250

36 A

36 B

桂上野今井町

41

図面の種類	画地出来形確認測量図				
街区番号	40	番号	／	縮尺	1 : 250
町名	桂上野西町				
京都市洛西第二土地区画整理組合					

128

地番	桂上西五ノ七		
N O	X	Y	辺 長
4730	-111222.422	-27432.250	
4731	-111226.626	-27433.706	4.449
4732	-111237.153	-27429.265	11.425
9049	-111230.693	-27423.170	8.881
4729	-111222.316	-27432.053	12.210
4730	-111222.422	-27432.250	0.224
面積	72.8288440		
地積	72.82 ㎡		

129

地番	桂上西五ノ一		
N O	X	Y	辺 長
4729	-111222.316	-27432.053	
9049	-111230.693	-27423.170	12.210
9051	-111227.537	-27420.193	4.339
9050	-111226.337	-27420.843	1.365
4952	-111219.938	-27427.652	9.344
4729	-111222.316	-27432.053	5.002
面積	54.0826140		
地積	54.08 m ²		

130

地 番	桂上西一四ノ一八		
N O	X	Y	辺 長
9050	-111226.337	-27420.843	
9051	-111227.537	-27420.193	1.365
9052	-111227.225	-27419.899	0.429
9050	-111226.337	-27420.843	1.296
面積	0.2778000		
地積	0.27 ㎡		

131

地番	桂上西五ノ六		
N O	X	Y	辺 長
4952	-111219.938	-27427.652	
9050	-111226.337	-27420.843	9.344
4951	-111218.541	-27425.065	8.866
4952	-111219.938	-27427.652	2.940
面積	13.0331930		
地積	13.03 ㎡		

132

地 番	桂上西一四ノ二二		
N O	X	Y	辺 長
4951	-111218.541	-27425.065	
9050	-111226.337	-27420.843	8.866
9052	-111227.225	-27419.899	1.296
9054	-111229.795	-27417.165	3.752
9056	-111232.262	-27414.540	3.602
9057	-111231.118	-27413.460	1.573
9075	-111233.726	-27410.694	3.802
9076	-111232.235	-27409.287	2.050
4950	-111218.106	-27424.260	20.587
4951	-111218.541	-27425.065	0.915
面積	58.0945760		
地積	58.09 ㎡		

133

地 番	桂上西一四ノ二三		
N O	X	Y	辺 長
4950	-111218.106	-27424.260	
9076	-111232.235	-27409.287	20.587
9064	-111232.217	-27409.270	0.025
9077	-111229.615	-27406.817	3.576
4948	-111216.200	-27421.040	19.551
4949	-111217.170	-27422.527	1.775
4950	-111218.106	-27424.260	1.970
面積	72.0720650		
地積	72.07 ㎡		

134

地番	桂上西一四ノ二四		
N O	X	Y	辺長
4948	-111216.200	-27421.040	
9077	-111229.615	-27406.817	19.551
9065	-111228.942	-27406.182	0.925
9078	-111226.995	-27404.346	2.676
4947	-111214.178	-27417.939	18.683
4948	-111216.200	-27421.040	3.702
面積	68.8220025		
地積	68.82 m ²		

135

地番	桂上西一四ノ二五		
N O	X	Y	辺長
4947	-111214.178	-27417.939	
9078	-111226.995	-27404.346	18.683
9066	-111225.668	-27403.094	1.824
9079	-111224.375	-27401.876	1.776
4946	-111212.156	-27414.841	17.816
4947	-111214.178	-27417.939	3.689
面積	65.6719460		
地積	65.67 m ²		

136

地番	桂上西一四ノ二六		
N O	X	Y	辺長
4946	-111212.156	-27414.841	
9079	-111224.375	-27401.876	17.816
9067	-111222.393	-27400.006	2.725
9080	-111221.756	-27399.405	0.876
4945	-111210.129	-27411.732	16.945
4946	-111212.156	-27414.841	3.711
面積	62.6418320		
地積	62.64 m ²		

137

地番	桂上西一四ノ二七		
N O	X	Y	辺 長
4945	-111210.129	-27411.732	
9080	-111221.756	-27399.405	16.945
9081	-111219.137	-27396.935	3.600
4944	-111208.107	-27408.632	16.077
4945	-111210.129	-27411.732	3.701
面積	59.4237185		
地積	59.42 m ²		

138

地 番	桂上西一四ノ二八		
N O	X	Y	辺 長
4944	-111208.107	-27408.632	
9081	-111219.137	-27396.935	16.077
9088	-111219.119	-27396.918	0.025
9082	-111216.517	-27394.464	3.577
4942	-111205.922	-27405.706	15.448
4943	-111207.127	-27407.130	1.865
4944	-111208.107	-27408.632	1.793
面積	56.5258410		
地積	56.52 ㎡		

139

地番	桂上西一四ノ二九		
N O	X	Y	辺 長
4942	-111205.922	-27405.706	
9082	-111216.517	-27394.464	15.448
9069	-111216.499	-27394.448	0.024
9083	-111213.897	-27391.994	3.577
4941	-111203.582	-27402.941	15.041
4942	-111205.922	-27405.706	3.622
面積	54.8790525		
地積	54.87 m ²		

140

地番	桂上西一四ノ三〇		
N O	X	Y	辺長
4941	-111203.582	-27402.941	
9083	-111213.897	-27391.994	15.041
9070	-111213.879	-27391.977	0.025
9071	-111211.260	-27389.507	3.600
9084	-111211.168	-27389.420	0.127
9087	-111207.874	-27392.917	4.804
4940	-111201.144	-27400.061	9.815
4941	-111203.582	-27402.941	3.773
面積	55.6170125		
地積	55.61 ㎡		

141

地番	桂上西一四ノ三一		
N O	X	Y	辺長
4940	-111201.144	-27400.061	
9087	-111207.874	-27392.917	9.815
4937	-111200.417	-27385.875	10.257
4938	-111199.170	-27394.212	8.430
4939	-111200.658	-27399.486	5.480
4940	-111201.144	-27400.061	0.753
面積	63.0619865		
地積	63.06 m ²		

142

地番	桂上西一四ノ一		
N O	X	Y	辺 長
9087	-111207.874	-27392.917	
9084	-111211.168	-27389.420	4.804
9072	-111208.640	-27387.036	3.475
9073	-111208.531	-27386.933	0.150
9074	-111205.911	-27384.463	3.601
4936	-111201.281	-27380.097	6.364
4937	-111200.417	-27385.875	5.842
9087	-111207.874	-27392.917	10.257
面積	57.2282525		
地積	57.22 ㎡		

143

地番	桂上西一五ノ二			
N O	X	Y	辺 長	
9074	-111205.911	-27384.463		
9085	-111210.512	-27379.583	6.707	
9086	-111205.780	-27375.124	6.502	
4934	-111202.487	-27372.020	4.525	
4935	-111201.445	-27378.997	7.054	
4936	-111201.281	-27380.097	1.112	
9074	-111205.911	-27384.463	6.364	
面積	58.3093000			
地積	58.30 ㎡			

144

地番	桂上西一五ノ七		
N O	X	Y	辺 長
9086	-111205.780	-27375.124	
4930	-111212.163	-27368.358	9.302
4931	-111206.357	-27362.880	7.982
4932	-111203.720	-27363.768	2.783
4934	-111202.487	-27372.020	8.344
9086	-111205.780	-27375.124	4.525
面積	68.5127950		
地積	68.51 m ²		

158

地番	桂上西一四ノ七		
N O	X	Y	辺長
9060	-111240.076	-27416.681	
4854	-111251.063	-27405.043	16.005
4855	-111248.444	-27402.570	3.602
9062	-111237.457	-27414.211	16.007
9061	-111237.868	-27414.599	0.565
9060	-111240.076	-27416.681	3.035
面積	57.6387220		
地積	57.63㎡		

159

地番	桂上西一四ノ六		
N O	X	Y	辺長
9059	-111242.695	-27419.151	
4853	-111253.677	-27407.512	16.002
4854	-111251.063	-27405.043	3.596
9060	-111240.076	-27416.681	16.005
9059	-111242.695	-27419.151	3.600
面積	57.5783580		
地積	57.57㎡		

160

地番	桂上西一四ノ五		
N O	X	Y	辺長
9058	-111245.424	-27421.724	
9088	-111251.603	-27415.174	9.005
4852	-111256.402	-27410.086	6.994
4853	-111253.677	-27407.512	3.748
9059	-111242.695	-27419.151	16.002
9058	-111245.424	-27421.724	3.751
面積	59.9978705		
地積	59.99㎡		

161

地番	桂上西一四ノ三		
N O	X	Y	辺長
4954	-111257.467	-27420.717	
4850	-111261.748	-27418.928	4.640
4851	-111262.324	-27415.679	3.300
4852	-111256.402	-27410.086	8.146
9088	-111251.603	-27415.174	6.994
4954	-111257.467	-27420.717	8.069
面積	63.1578155		
地積	63.15㎡		

162

地番	桂上西一四ノ四		
N O	X	Y	辺長
4736	-111248.397	-27424.528	
4953	-111255.287	-27421.628	7.475
4954	-111257.467	-27420.717	2.363
9088	-111251.603	-27415.174	8.069
9058	-111245.424	-27421.724	9.005
4736	-111248.397	-27424.528	4.087
面積	54.6882850		
地積	54.68㎡		

163

地番	桂上西五ノ三		
N O	X	Y	辺長
4735	-111244.564	-27426.141	
4736	-111248.397	-27424.528	4.159
9058	-111245.424	-27421.724	4.087
9059	-111242.695	-27419.151	3.751
9060	-111240.076	-27416.681	3.600
9061	-111237.868	-27414.599	3.035
9055	-111234.346	-27416.506	4.005
4735	-111244.564	-27426.141	14.044
面積	54.2320970		
地積	54.23㎡		

164

地番	桂上西一四ノ二一		
N O	X	Y	辺長
9055	-111234.346	-27416.506	
9061	-111237.868	-27414.599	4.005
9062	-111237.457	-27414.211	0.565
9063	-111234.837	-27411.741	3.601
9075	-111233.726	-27410.694	1.527
9057	-111231.118	-27413.460	3.802
9056	-111232.262	-27414.540	1.573
9055	-111234.346	-27416.506	2.865
面積	19.2648035		
地積	19.26㎡		

165

地番	桂上西五ノ四		
N O	X	Y	辺長
4733	-111240.930	-27427.671	
4734	-111241.364	-27427.488	0.471
4735	-111244.564	-27426.141	3.472
9055	-111234.346	-27416.506	14.044
9053	-111231.011	-27418.312	3.793
4733	-111240.930	-27427.671	13.637
面積	49.8860535		
地積	49.88㎡		

166

地番	桂上西一四ノ二〇		
N O	X	Y	辺長
9053	-111231.011	-27418.312	
9055	-111234.346	-27416.506	3.793
9056	-111232.262	-27414.540	2.865
9054	-111229.795	-27417.165	3.602
9053	-111231.011	-27418.312	1.672
面積	8.1709815		
地積	8.17㎡		


167

地番	桂上西五ノ五		
N O	X	Y	辺長
4732	-111237.153	-27429.265	
4733	-111240.930	-27427.671	4.100
9053	-111231.011	-27418.312	13.637
9051	-111227.537	-27420.193	3.951
9049	-111230.693	-27423.170	4.339
4732	-111237.153	-27429.265	8.881
面積	50.3796265		
地積	50.37㎡		

168

地番	桂上西一四ノ一九		
N O	X	Y	辺長
9051	-111227.537	-27420.193	
9053	-111231.011	-27418.312	3.951
9054	-111229.795	-27417.165	1.672
9052	-111227.225	-27419.899	3.752
9051	-111227.537	-27420.193	0.429
面積	3.9402810		
地積	3.94㎡		

図面の種類	画 地 面 積 求 積 表				
街区番号	40	番号	$\frac{2}{2}$		
町 名	桂 上 野 西 町				
京 都 市 洛 西 第 二 土 地 区 画 整 理 組 合					

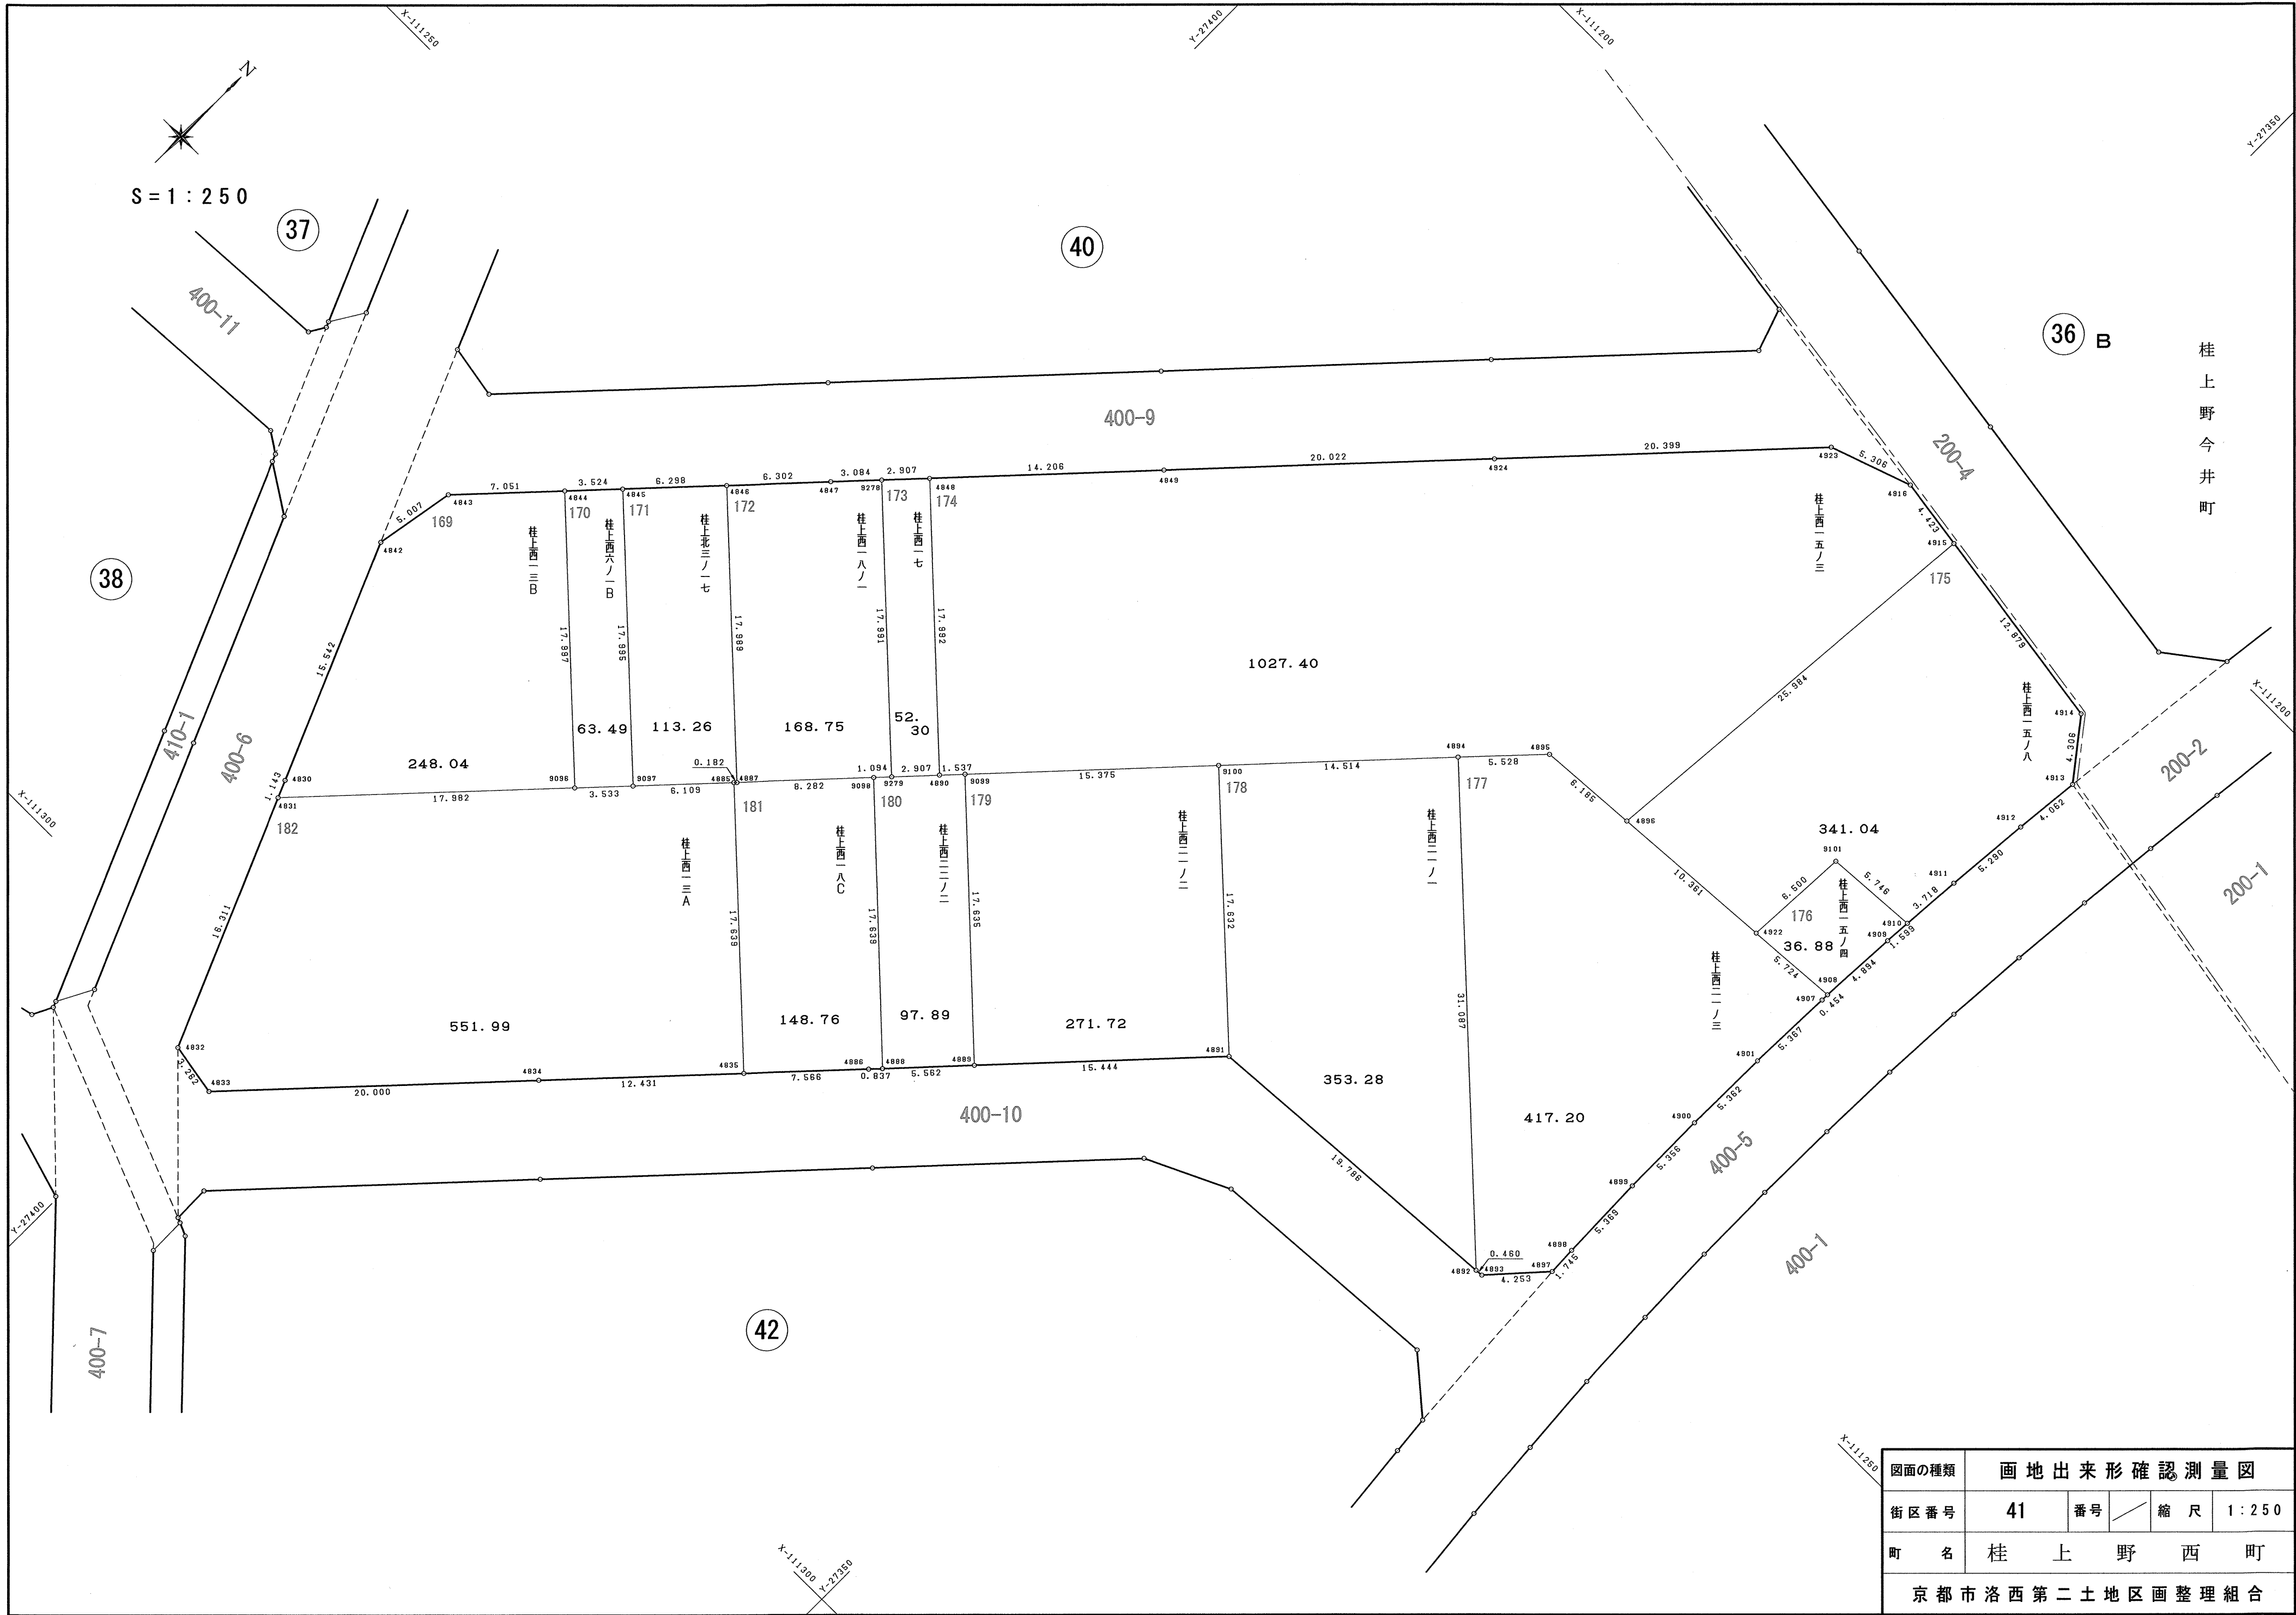

150

図面の種類	画地出来形確認測量図				
街区番号	41	番号	／	縮尺	1：250
町名	桂上野西町				
京都市洛西第二土地区画整理組合					

169

地番	桂上西一三B		
N O	X	Y	辺 長
4843	-111268.389	-27413.141	
4842	-111273.317	-27414.026	5.007
4830	-111287.639	-27407.990	15.542
4831	-111288.693	-27407.547	1.143
9096	-111275.610	-27395.210	17.982
4844	-111263.261	-27408.302	17.997
4843	-111268.389	-27413.141	7.051
面積	248.0441555		
地積	248.04㎡		

170

地番	桂上西六ノ一B		
N O	X	Y	辺 長
4844	-111263.261	-27408.302	
9096	-111275.610	-27395.210	17.997
9097	-111273.040	-27392.786	3.533
4845	-111260.699	-27405.883	17.995
4844	-111263.261	-27408.302	3.524
面積	63.4939045		
地積	63.49㎡		

171

地番	桂上北三ノ一七		
N O	X	Y	辺 長
4845	-111260.699	-27405.883	
9097	-111273.040	-27392.786	17.995
4885	-111268.595	-27388.595	6.109
4887	-111268.461	-27388.472	0.182
4846	-111256.119	-27401.560	17.989
4845	-111260.699	-27405.883	6.298
面積	113.2613010		
地積	113.26㎡		

172

地番	桂上西一八ノ一		
N O	X	Y	辺 長
9278	-111248.293	-27395.119	
4847	-111251.536	-27397.235	3.084
4846	-111256.119	-27401.560	6.302
4887	-111268.461	-27388.472	17.989
9098	-111262.439	-27382.787	8.282
9279	-111261.643	-27382.036	1.094
9278	-111248.293	-27395.119	17.991
面積	168.7586975		
地積	168.75㎡		

173

地番	桂上西一七		
N O	X	Y	辺 長
4890	-111259.529	-27380.040	
4848	-111247.179	-27393.124	17.992
9278	-111248.293	-27395.119	2.907
9279	-111261.643	-27382.036	17.991
4890	-111259.529	-27380.040	2.907
面積	52.3029440		
地積	52.30㎡		

174

地番	桂上西一五ノ三		
N O	X	Y	辺 長
4848	-111247.179	-27393.124	
4890	-111259.529	-27380.040	17.992
9099	-111258.411	-27378.986	1.537
9100	-111247.225	-27368.438	15.375
4894	-111236.665	-27358.481	14.514
4895	-111232.648	-27354.683	5.528
4896	-111232.233	-27348.512	6.185
4915	-111206.347	-27346.263	25.984
4916	-111205.692	-27350.637	4.423
4923	-111207.434	-27355.649	5.306
4924	-111222.282	-27369.636	20.399
4849	-111236.846	-27383.375	20.022
4848	-111247.179	-27393.124	14.206
面積	1027.4061140		
地積	1027.40㎡		

175

地番	桂上西一五ノ八		
N O	X	Y	辺 長
4896	-111232.233	-27348.512	
4922	-111231.540	-27338.174	10.361
9101	-111225.051	-27337.800	6.500
4910	-111224.673	-27332.066	5.746
4911	-111220.966	-27331.784	3.718
4912	-111215.698	-27331.307	5.290
4913	-111211.658	-27330.887	4.062
4914	-111208.256	-27333.526	4.306
4915	-111206.347	-27346.263	12.879
4896	-111232.233	-27348.512	25.984
面積	341.0491465		
地積	341.04㎡		

176

地番	桂上西一五ノ四		
N O	X	Y	辺 長
4922	-111231.540	-27338.174	
4908	-111231.153	-27332.463	5.724
4909	-111226.267	-27332.187	4.894
4910	-111224.673	-27332.066	1.599
9101	-111225.051	-27337.800	5.746
4922	-111231.540	-27338.174	6.500
面積	36.8844665		
地積	36.88㎡		

177

地番	桂上西二一ノ三		
N O	X	Y	辺 長
4894	-111236.665	-27358.481	
4892	-111257.975	-27335.847	31.087
4893	-111257.944	-27335.388	0.460
4897	-111254.798	-27332.526	4.253
4898	-111253.054	-27332.595	1.745
4899	-111247.687	-27332.736	5.369
4900	-111242.331	-27332.752	5.356
4901	-111236.970	-27332.674	5.362
4907	-111231.606	-27332.489	5.367
4908	-111231.153	-27332.463	0.454
4922	-111231.540	-27338.174	5.724
4896	-111232.233	-27348.512	10.361
4895	-111232.648	-27354.683	6.185
4894	-111236.665	-27358.481	5.528
面積	417.2084890		
地積	417.20㎡		

178

地番	桂上西二一ノ一		
N O	X	Y	辺 長
9100	-111247.225	-27368.438	
4891	-111259.299	-27355.589	17.632
4892	-111257.975	-27335.847	19.786
4894	-111236.665	-27358.481	31.087
9100	-111247.225	-27368.438	14.514
面積	353.2878470		
地積	353.28㎡		

179

地番	桂上西二一ノ二		
N O	X	Y	辺 長
9099	-111258.411	-27378.986	
4889	-111270.538	-27366.182	17.635
4891	-111259.299	-27355.589	15.444
9100	-111247.225	-27368.438	17.632
9099	-111258.411	-27378.986	15.375
面積	271.7254665		
地積	271.72㎡		

180

地番	桂上西二二ノ二		
N O	X	Y	辺 長
9098	-111262.439	-27382.787	
4888	-111274.586	-27369.997	17.639
4889	-111270.538	-27366.182	5.562
9099	-111258.411	-27378.986	17.635
4890	-111259.529	-27380.040	1.537
9279	-111261.643	-27382.036	2.907
9098	-111262.439	-27382.787	1.094
面積	97.8905800		
地積	97.89㎡		


181

地番	桂上西一八C		
N O	X	Y	辺 長
4885	-111268.595	-27388.595	
4835	-111280.698	-27375.763	17.639
4886	-111275.195	-27370.571	7.566
4888	-111274.586	-27369.997	0.837
9098	-111262.439	-27382.787	17.639
4887	-111268.461	-27388.472	8.282
4885	-111268.595	-27388.595	0.182
面積	148.7621940		
地積	148.76㎡		

182

地番	桂上西一三A		
N O	X	Y	辺 長
4831	-111288.693	-27407.547	
4832	-111303.729	-27401.224	16.311
4833	-111304.295	-27398.011	3.262
4834	-111289.740	-27384.294	20.000
4835	-111280.698	-27375.763	12.431
4885	-111268.595	-27388.595	17.639
9097	-111273.040	-27392.786	6.109
9096	-111275.610	-27395.210	3.533
4831	-111288.693	-27407.547	17.982
面積	551.9981595		
地積	551.99㎡		

図面の種類	画 地 面 積 求 積 表				
街区番号	41	番号	／		
町 名	桂 上 野 西 町				
京都市洛西第二土地区画整理組合					

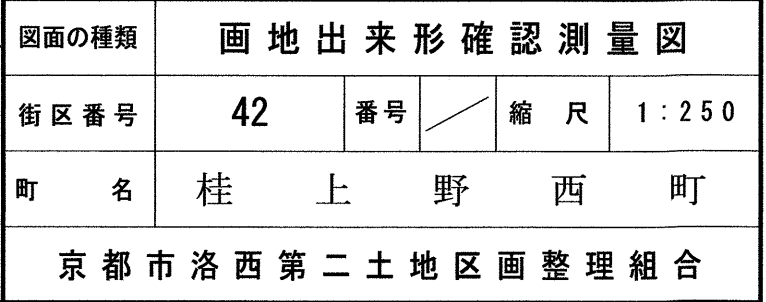

183

地番	桂上西二五ノ一，桂上西二六ノ一		
N O	X	Y	辺長
5095	-111308.788	-27393.997	
5096	-111311.047	-27393.972	2.259
5097	-111311.181	-27393.668	0.332
5098	-111311.529	-27392.882	0.860
5102	-111322.331	-27382.615	14.903
9102	-111309.851	-27369.524	18.087
5094	-111299.044	-27380.971	15.742
5068	-111299.301	-27385.068	4.105
5095	-111308.788	-27393.997	13.028
面積	313.3856090		
地積	313.38 m ²		

184				
地番	桂上西二六ノ二			
N O	X	Y	辺 長	
5068	-111299.301	-27385.068		
5094	-111299.044	-27380.971	4.105	
5067	-111297.122	-27383.017	2.807	
5068	-111299.301	-27385.068	2.992	
面積				4.2001280
地積				4.20 m ²

185

地番	桂上西二四ノ三		
N O	X	Y	辺 長
5067	-111297.122	-27383.017	
5094	-111299.044	-27380.971	2.807
5093	-111299.031	-27380.699	0.272
5067	-111297.122	-27383.017	3.003
面積	0.2746910		
地積	0.27 ㎡		

186			
地番	桂上西二四ノ四		
N O	X	Y	辺長
5067	-111297.122	-27383.017	
5093	-111299.031	-27380.699	3.003
5092	-111313.266	-27363.472	22.347
5088	-111308.619	-27359.657	6.012
5087	-111306.207	-27362.588	3.796
5086	-111303.784	-27365.521	3.804
5085	-111301.274	-27368.570	3.949
5084	-111294.647	-27376.564	10.384
5065	-111290.551	-27376.823	4.104
5066	-111293.930	-27380.013	4.647
5067	-111297.122	-27383.017	4.383
面積	155.5302715		
地積	155.53 ㎡		

187				
地番	桂上西二四ノ五			
N O	X	Y	辺長	
5092	-111313.266	-27363.472		
9103	-111317.548	-27358.290	6.722	
5122	-111317.043	-27357.810	0.697	
9108	-111313.180	-27354.148	5.323	
5090	-111312.526	-27354.937	1.025	
5089	-111311.042	-27356.726	2.324	
5088	-111308.619	-27359.657	3.803	
5092	-111313.266	-27363.472	6.012	
面積				41.6978010
地積				41.69 ㎡

188

地番	桂上西二四ノ八		
N O	X	Y	辺 長
5065	-111290.551	-27376.823	
5084	-111294.647	-27376.564	4.104
5085	-111301.274	-27368.570	10.384
9109	-111297.618	-27365.681	4.660
5064	-111288.721	-27375.096	12.954
5065	-111290.551	-27376.823	2.516
面積	62.3866575		
地積	62.38 ㎡		

189

地番	桂上西二四ノ七		
N O	X	Y	辺長
5064	-111288.721	-27375.096	
9109	-111297.618	-27365.681	12.954
9110	-111294.236	-27363.009	4.310
5063	-111285.596	-27372.145	12.574
5064	-111288.721	-27375.096	4.298
面積	54.8304770		
地積	54.83 ㎡		

190

地番	桂上西二四ノ六		
N O	X	Y	辺長
5063	-111285.596	-27372.145	
9110	-111294.236	-27363.009	12.574
5069	-111290.746	-27360.252	4.448
5062	-111282.384	-27369.112	12.183
5063	-111285.596	-27372.145	4.418
面積	54.7626930		
地積	54.76 ㎡		

191			
地番	桂上西二四ノ九		
N O	X	Y	辺長
5085	-111301.274	-27368.570	
5086	-111303.784	-27365.521	3.949
5070	-111293.473	-27357.389	13.132
5069	-111290.746	-27360.252	3.954
9110	-111294.236	-27363.009	4.448
9109	-111297.618	-27365.681	4.310
5085	-111301.274	-27368.570	4.660
面積	52.3342595		
地積	52.33 ㎡		

192			
地番	桂上西二四ノ一〇		
N O	X	Y	辺長
5086	-111303.784	-27365.521	
5087	-111306.207	-27362.588	3.804
5071	-111296.086	-27354.598	12.895
5070	-111293.473	-27357.389	3.823
5086	-111303.784	-27365.521	13.132
面積	49.5357900		
地積	49.53 m ²		

193

地 番	桂上西二四ノ一一		
N O	X	Y	辺 長
5087	-111306.207	-27362.588	
5088	-111308.619	-27359.657	3.796
5072	-111298.705	-27351.822	12.636
5071	-111296.086	-27354.598	3.816
5087	-111306.207	-27362.588	12.895
面積	48.4888300		
地積	48.48 m ²		

194

地番	桂上西二四ノ一二		
N O	X	Y	辺長
5088	-111308.619	-27359.657	
5089	-111311.042	-27356.726	3.803
5073	-111301.320	-27349.044	12.391
5072	-111298.705	-27351.822	3.815
5088	-111308.619	-27359.657	12.636
面積	47.5691425		
地積	47.56 m ²		

195			
地番	桂上西二四ノ一三		
N O	X	Y	辺長
5089	-111311.042	-27356.726	
5090	-111312.526	-27354.937	2.324
5091	-111312.760	-27353.750	1.210
5111	-111304.357	-27345.835	11.544
5073	-111301.320	-27349.044	4.418
5089	-111311.042	-27356.726	12.391
面積	47.2381560		
地積	47.23 m ²		

196			
地番	桂上西二二ノ三		
N O	X	Y	辺長
5062	-111282.384	-27369.112	
5069	-111290.746	-27360.252	12.183
5070	-111293.473	-27357.389	3.954
5071	-111296.086	-27354.598	3.823
5072	-111298.705	-27351.822	3.816
5073	-111301.320	-27349.044	3.815
5111	-111304.357	-27345.835	4.418
5075	-111299.327	-27341.102	6.907
5074	-111294.321	-27336.365	6.892
5060	-111272.356	-27359.657	32.015
5061	-111279.298	-27366.199	9.539
5062	-111282.384	-27369.112	4.244
面積	441.4214275		
地積	441.42㎡		

197			
地 番	桂上西二二ノ一		
N O	X	Y	辺 長
5060	-111272.356	-27359.657	
5074	-111294.321	-27336.365	32.015
5046	-111284.215	-27326.823	13.899
5047	-111279.780	-27330.332	5.655
5048	-111278.537	-27330.496	1.254
5049	-111277.050	-27330.684	1.499
5054	-111264.533	-27343.962	18.248
5055	-111264.930	-27349.849	5.900
5056	-111267.316	-27354.906	5.592
5060	-111272.356	-27359.657	6.926
面 積	490.3604740		
地 積	490.36 ㎡		

198

地番	桂上西二二ノ四		
N O	X	Y	辺 長
5054	-111264.533	-27343.962	
5049	-111277.050	-27330.684	18.248
5050	-111274.436	-27331.015	2.635
5051	-111269.090	-27331.545	5.372
5052	-111266.711	-27331.755	2.388
5053	-111263.928	-27334.990	4.267
5054	-111264.533	-27343.962	8.992
面積	75.0204805		
地積	75.02 m ²		

199			
地番	桂上北二ノ一		
N O	X	Y	辺長
5075	-111299.327	-27341.102	
5076	-111301.359	-27338.573	3.244
5077	-111303.645	-27335.665	3.699
5078	-111305.954	-27332.771	3.702
5079	-111308.267	-27329.885	3.699
5080	-111310.569	-27326.986	3.702
5081	-111312.813	-27324.172	3.599
5082	-111315.119	-27321.283	3.696
5083	-111317.528	-27318.272	3.856
5150	-111315.573	-27316.752	2.476
5151	-111314.926	-27316.941	0.674
5152	-111309.867	-27318.316	5.243
5153	-111304.771	-27319.564	5.247
5154	-111299.646	-27320.718	5.253
5155	-111294.498	-27321.778	5.256
5045	-111289.351	-27322.760	5.240
5046	-111284.215	-27326.823	6.549
5074	-111294.321	-27336.365	13.899
5075	-111289.327	-27341.102	6.892
面積	367.9836515		
地積	367.98 m ²		

212

地番	桂上西二三ノ一		
N O	X	Y	辺長
5091	-111312.760	-27353.750	
5112	-111312.982	-27352.621	1.151
5111	-111304.357	-27345.835	10.975
5091	-111312.760	-27353.750	11.544
面積	5.6220585		
地積	5.62㎡		

213

地番	桂上西二四ノ一		
N O	X	Y	辺長
5090	-111312.526	-27354.937	
9108	-111313.180	-27354.148	1.025
5091	-111312.760	-27353.750	0.579
5090	-111312.526	-27354.937	1.210
面積	0.2958360		
地積	0.29㎡		

214

地番	桂上西二三ノ一〇		
N O	X	Y	辺長
5119	-111319.500	-27348.465	
5118	-111321.302	-27346.171	2.917
5134	-111335.629	-27327.983	23.153
5130	-111333.357	-27321.567	6.806
5129	-111332.903	-27321.722	0.480
5128	-111328.705	-27327.082	6.808
5127	-111326.320	-27330.108	3.853
5126	-111324.033	-27333.012	3.696
5125	-111321.807	-27335.839	3.598
5124	-111319.520	-27338.749	3.701
5123	-111317.232	-27341.659	3.702
5117	-111314.942	-27344.564	3.699
5116	-111314.802	-27344.732	0.219
5115	-111315.110	-27344.983	0.397
5119	-111319.500	-27348.465	5.603
面積	167.5865430		
地積	167.58㎡		

215

地番	桂上西二三ノ一四		
N O	X	Y	辺長
5122	-111317.043	-27357.810	
5121	-111317.246	-27356.792	1.038
5120	-111318.667	-27349.511	7.418
5119	-111319.500	-27348.465	1.337
5115	-111315.110	-27344.983	5.603
5114	-111314.263	-27346.054	1.365
5113	-111313.807	-27348.368	2.359
5112	-111312.982	-27352.621	4.332
5091	-111312.760	-27353.750	1.151
9108	-111313.180	-27354.148	0.579
5122	-111317.043	-27357.810	5.323
面積	48.2069565		
地積	48.20㎡		

216

地番	桂上西二三ノ二		
N O	X	Y	辺長
9106	-111326.445	-27350.551	
5136	-111338.602	-27335.396	19.429
5135	-111337.199	-27332.417	3.293
5134	-111335.629	-27327.983	4.704
5118	-111321.302	-27346.171	23.153
9106	-111326.445	-27350.551	6.755
面積	144.9624640		
地積	144.96㎡		

217

地番	桂上西二三ノ一五		
N O	X	Y	辺長
9105	-111319.664	-27359.029	
9106	-111326.445	-27350.551	10.856
5118	-111321.302	-27346.171	6.755
5119	-111319.500	-27348.465	2.917
5120	-111318.667	-27349.511	1.337
5121	-111317.246	-27356.792	7.418
9105	-111319.664	-27359.029	3.294
面積	61.2356345		
地積	61.23㎡		

218

地番	桂上西二三ノ一六		
N O	X	Y	辺長
9104	-111319.082	-27359.746	
9105	-111319.664	-27359.029	0.923
5121	-111317.246	-27356.792	3.294
5122	-111317.043	-27357.810	1.038
9103	-111317.548	-27358.290	0.697
9104	-111319.082	-27359.746	2.115
面積	2.7526950		
地積	2.75㎡		

219

地番	桂上今井二〇ノ一		
N O	X	Y	辺長
5102	-111322.331	-27382.615	
5101	-111324.483	-27380.570	2.969
5104	-111338.921	-27366.833	19.929
5105	-111345.075	-27360.982	8.492
9107	-111336.583	-27352.080	12.303
5138	-111341.154	-27340.656	12.305
5137	-111340.847	-27340.164	0.580
5136	-111338.602	-27335.396	5.270
9106	-111326.445	-27350.551	19.429
9105	-111319.664	-27359.029	10.856
9104	-111319.082	-27359.746	0.923
9102	-111309.851	-27369.524	13.447
5102	-111322.331	-27382.615	18.087
面積	691.8192985		
地積	691.81㎡		


220

地番	桂上北三ノ一		
N O	X	Y	辺長
5105	-111345.075	-27360.982	
5106	-111351.815	-27354.575	9.299
5107	-111351.586	-27352.703	1.885
5140	-111350.728	-27352.121	1.045
5139	-111343.497	-27344.414	10.568
5138	-111341.154	-27340.656	4.429
9107	-111336.583	-27352.080	12.305
5105	-111345.075	-27360.982	12.303
面積	151.6178595		
地積	151.61㎡		

221

地番	桂上西二四ノ二		
N O	X	Y	辺長
5094	-111299.044	-27380.971	
9102	-111309.851	-27369.524	15.742
9104	-111319.082	-27359.746	13.447
9103	-111317.548	-27358.290	2.115
5092	-111313.266	-27363.472	6.722
5093	-111299.031	-27380.699	22.347
5094	-111299.044	-27380.971	0.272
面積	33.5331260		
地積	33.53㎡		

図面の種類	画 地 面 積 求 積 表			
街区 番号	42	番号	$\frac{2}{2}$	
町 名	桂 上 野 西 町			
京 都 市 洛 西 第 二 土 地 区 画 整 理 組 合				

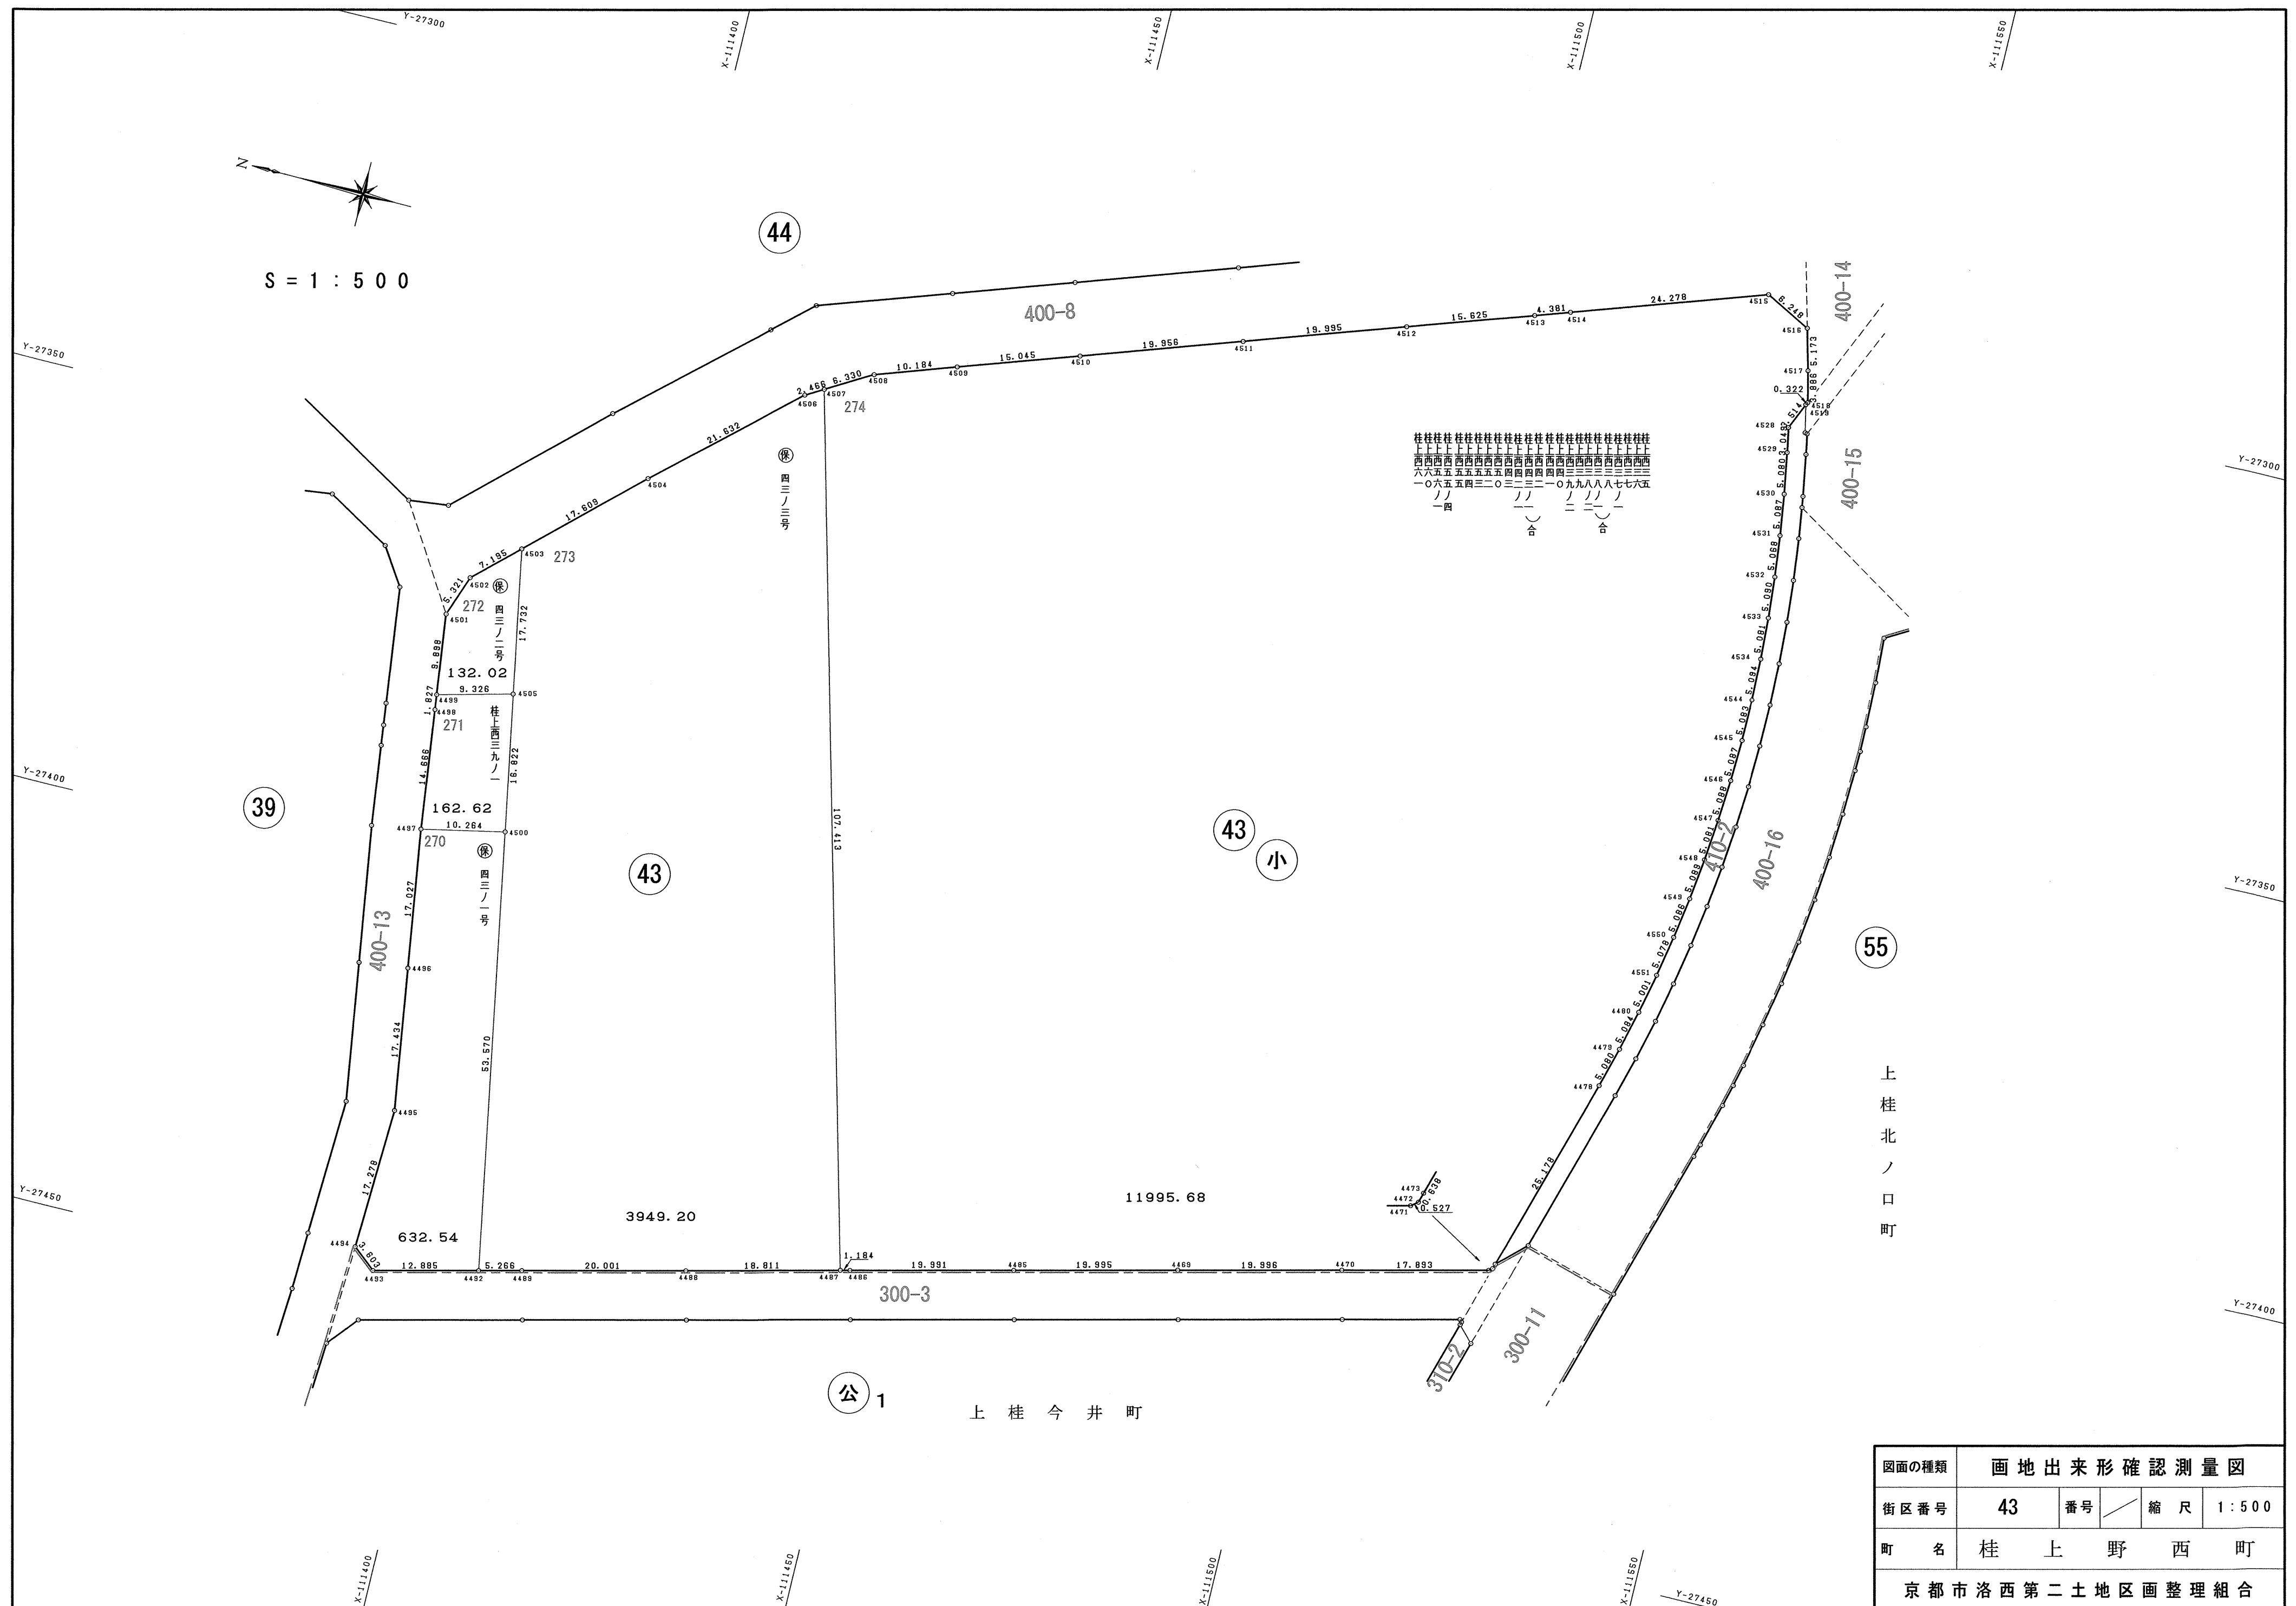

270

地番	保 四三ノ一号		
N O	X	Y	辺 長
4497	-111384.533	-27394.637	
4496	-111386.961	-27411.490	17.027
4495	-111389.448	-27428.746	17.434
4494	-111388.696	-27446.008	17.278
4493	-111391.465	-27448.313	3.603
4492	-111403.991	-27445.294	12.885
4500	-111394.584	-27392.556	53.570
4497	-111384.533	-27394.637	10.264
面積	632.5463090		
地積	632.54㎡		

271

地番	桂上西三九ノ一		
N O	X	Y	辺 長
4499	-111382.551	-27378.263	
4498	-111382.770	-27380.077	1.827
4497	-111384.533	-27394.637	14.666
4500	-111394.584	-27392.556	10.264
4505	-111391.599	-27376.001	16.822
4499	-111382.551	-27378.263	9.326
面積	162.6253840		
地積	162.62㎡		

272

地番	保 四三ノ二号		
N O	X	Y	辺 長
4502	-111383.176	-27363.432	
4501	-111381.366	-27368.436	5.321
4499	-111382.551	-27378.263	9.898
4505	-111391.599	-27376.001	9.326
4503	-111388.461	-27358.549	17.732
4502	-111383.176	-27363.432	7.195
面積	132.0252110		
地積	132.02㎡		


273

地番	保 四三ノ三号		
N O	X	Y	辺 長
4503	-111388.461	-27358.549	
4505	-111391.599	-27376.001	17.732
4500	-111394.584	-27392.556	16.822
4492	-111403.991	-27445.294	53.570
4489	-111409.110	-27444.060	5.266
4488	-111428.553	-27439.367	20.001
4487	-111446.840	-27434.956	18.811
4507	-111419.723	-27331.022	107.413
4506	-111417.589	-27332.258	2.466
4504	-111401.394	-27346.599	21.632
4503	-111388.461	-27358.549	17.609
面積	3949.2006690		
地積	3949.20㎡		


274

地番	桂上西三五, 三六, 三七, 三七ノ一, 三八ノ一合 三八ノ二, 三九, 三九ノ二, 四〇, 四一 四三ノ一合, 四二ノ一, 四三, 五〇, 五二 五三, 五四, 五五, 五五ノ四, 五六ノ一 六〇, 六一		
N O	X	Y	辺 長
4507	-111419.723	-27331.022	
4487	-111446.840	-27434.956	107.413
4486	-111447.991	-27434.678	1.184
4485	-111467.426	-27429.994	19.991
4469	-111486.863	-27425.302	19.995
4470	-111506.304	-27420.622	19.996
4471	-111523.700	-27416.434	17.893
4472	-111524.117	-27416.112	0.527
4473	-111524.304	-27415.502	0.638
4478	-111531.474	-27391.367	25.178
4479	-111532.843	-27386.475	5.080
4480	-111534.069	-27381.541	5.084
4551	-111535.129	-27376.654	5.001
4550	-111536.075	-27371.665	5.078
4549	-111536.861	-27366.640	5.086
4548	-111537.496	-27361.591	5.089
4547	-111537.981	-27356.533	5.081
4546	-111538.319	-27351.456	5.088
4545	-111538.520	-27346.373	5.087
4544	-111538.546	-27341.290	5.083
4534	-111538.421	-27336.198	5.094
4533	-111538.158	-27331.124	5.081
4532	-111537.734	-27326.052	5.090
4531	-111537.168	-27321.016	5.068
4530	-111536.462	-27315.978	5.087
4529	-111535.631	-27310.966	5.080
4528	-111535.060	-27307.971	3.049
4519	-111536.449	-27304.743	3.514
4518	-111536.626	-27304.474	0.322
4517	-111535.740	-27300.690	3.886
4516	-111534.434	-27295.685	5.173
4515	-111528.898	-27292.789	6.248
4514	-111505.900	-27300.569	24.278
4513	-111501.754	-27301.985	4.381
4512	-111486.949	-27306.979	15.625
4511	-111468.008	-27313.386	19.995
4510	-111449.099	-27319.766	19.956
4509	-111434.843	-27324.575	15.045
4508	-111425.200	-27327.849	10.184
4507	-111419.723	-27331.022	6.330
面積	11995.6859910		
地積	11995.68㎡		


図面の種類	画 地 面 積 求 積 表			
街区番号	43	番号	／	
町 名	桂	上	野	西 町
京都市洛西第二土地区画整理組合				

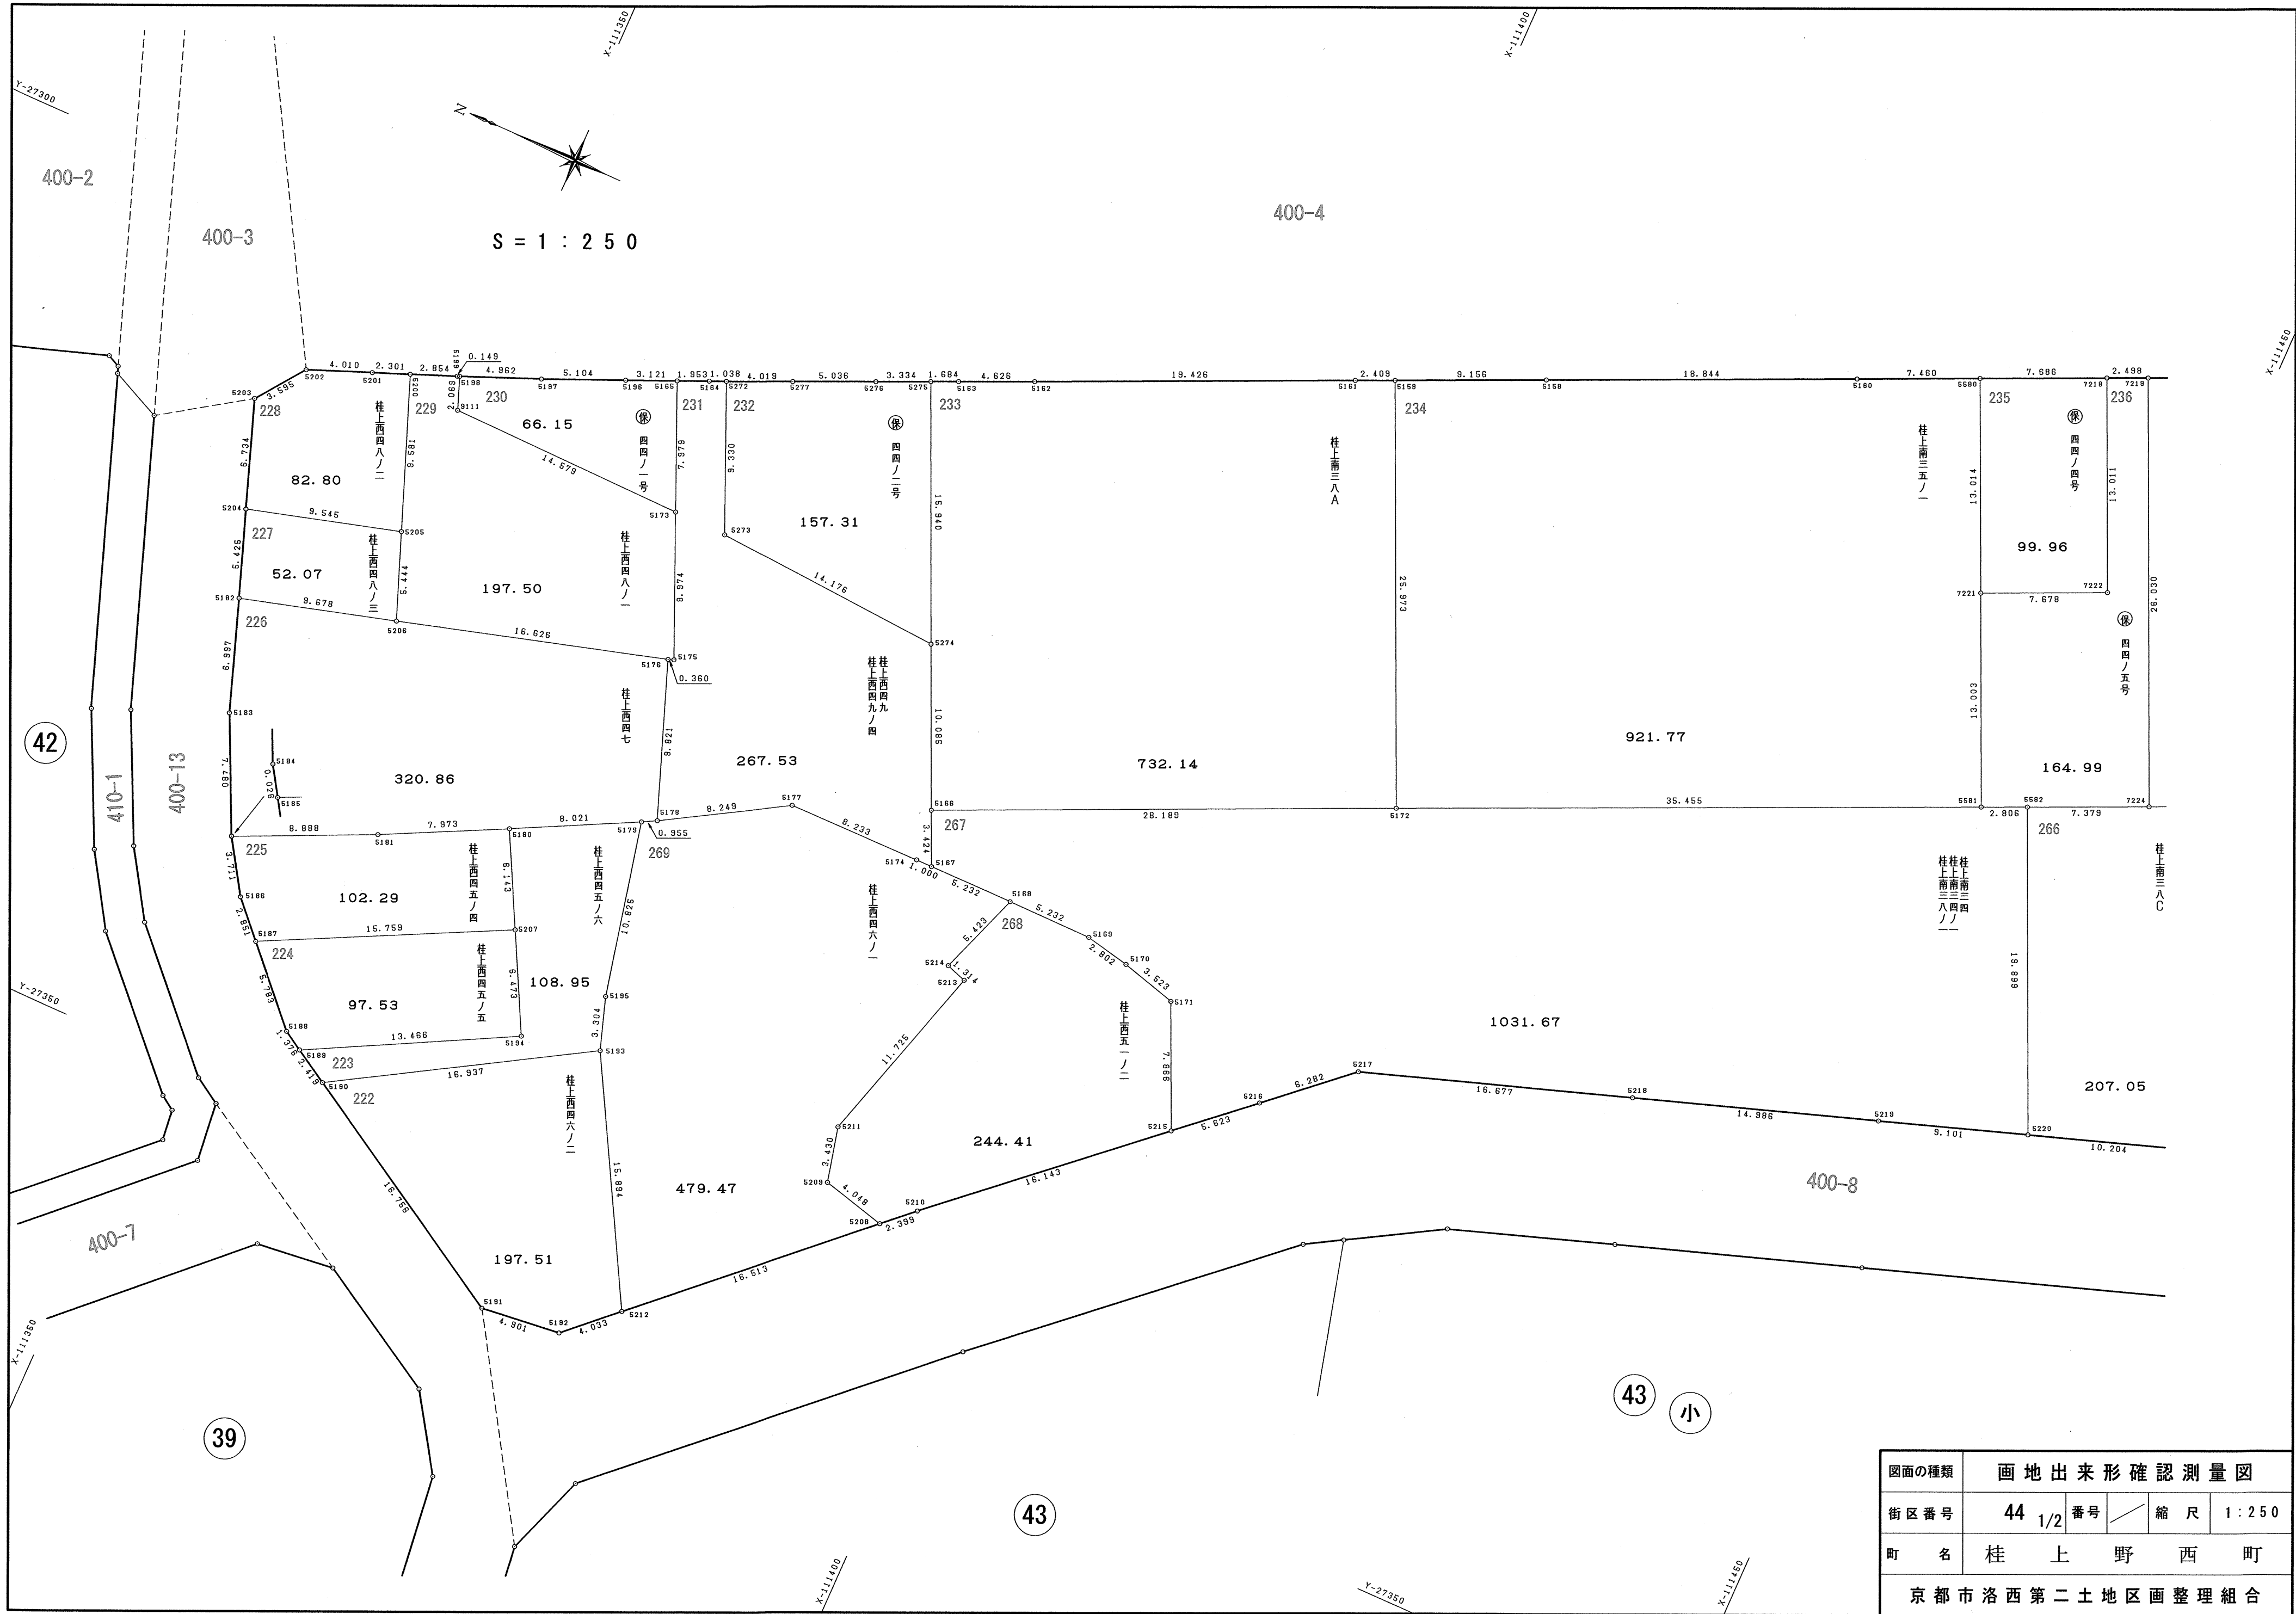

図面の種類	画地出来形確認測量図				
街区番号	44	1/2	番号	縮尺	1:250
町名	桂上野西町				
京都市洛西第二土地区画整理組合					

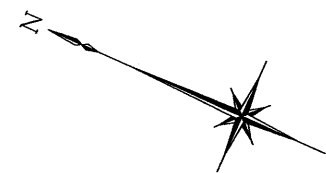

S = 1 : 2 5 0

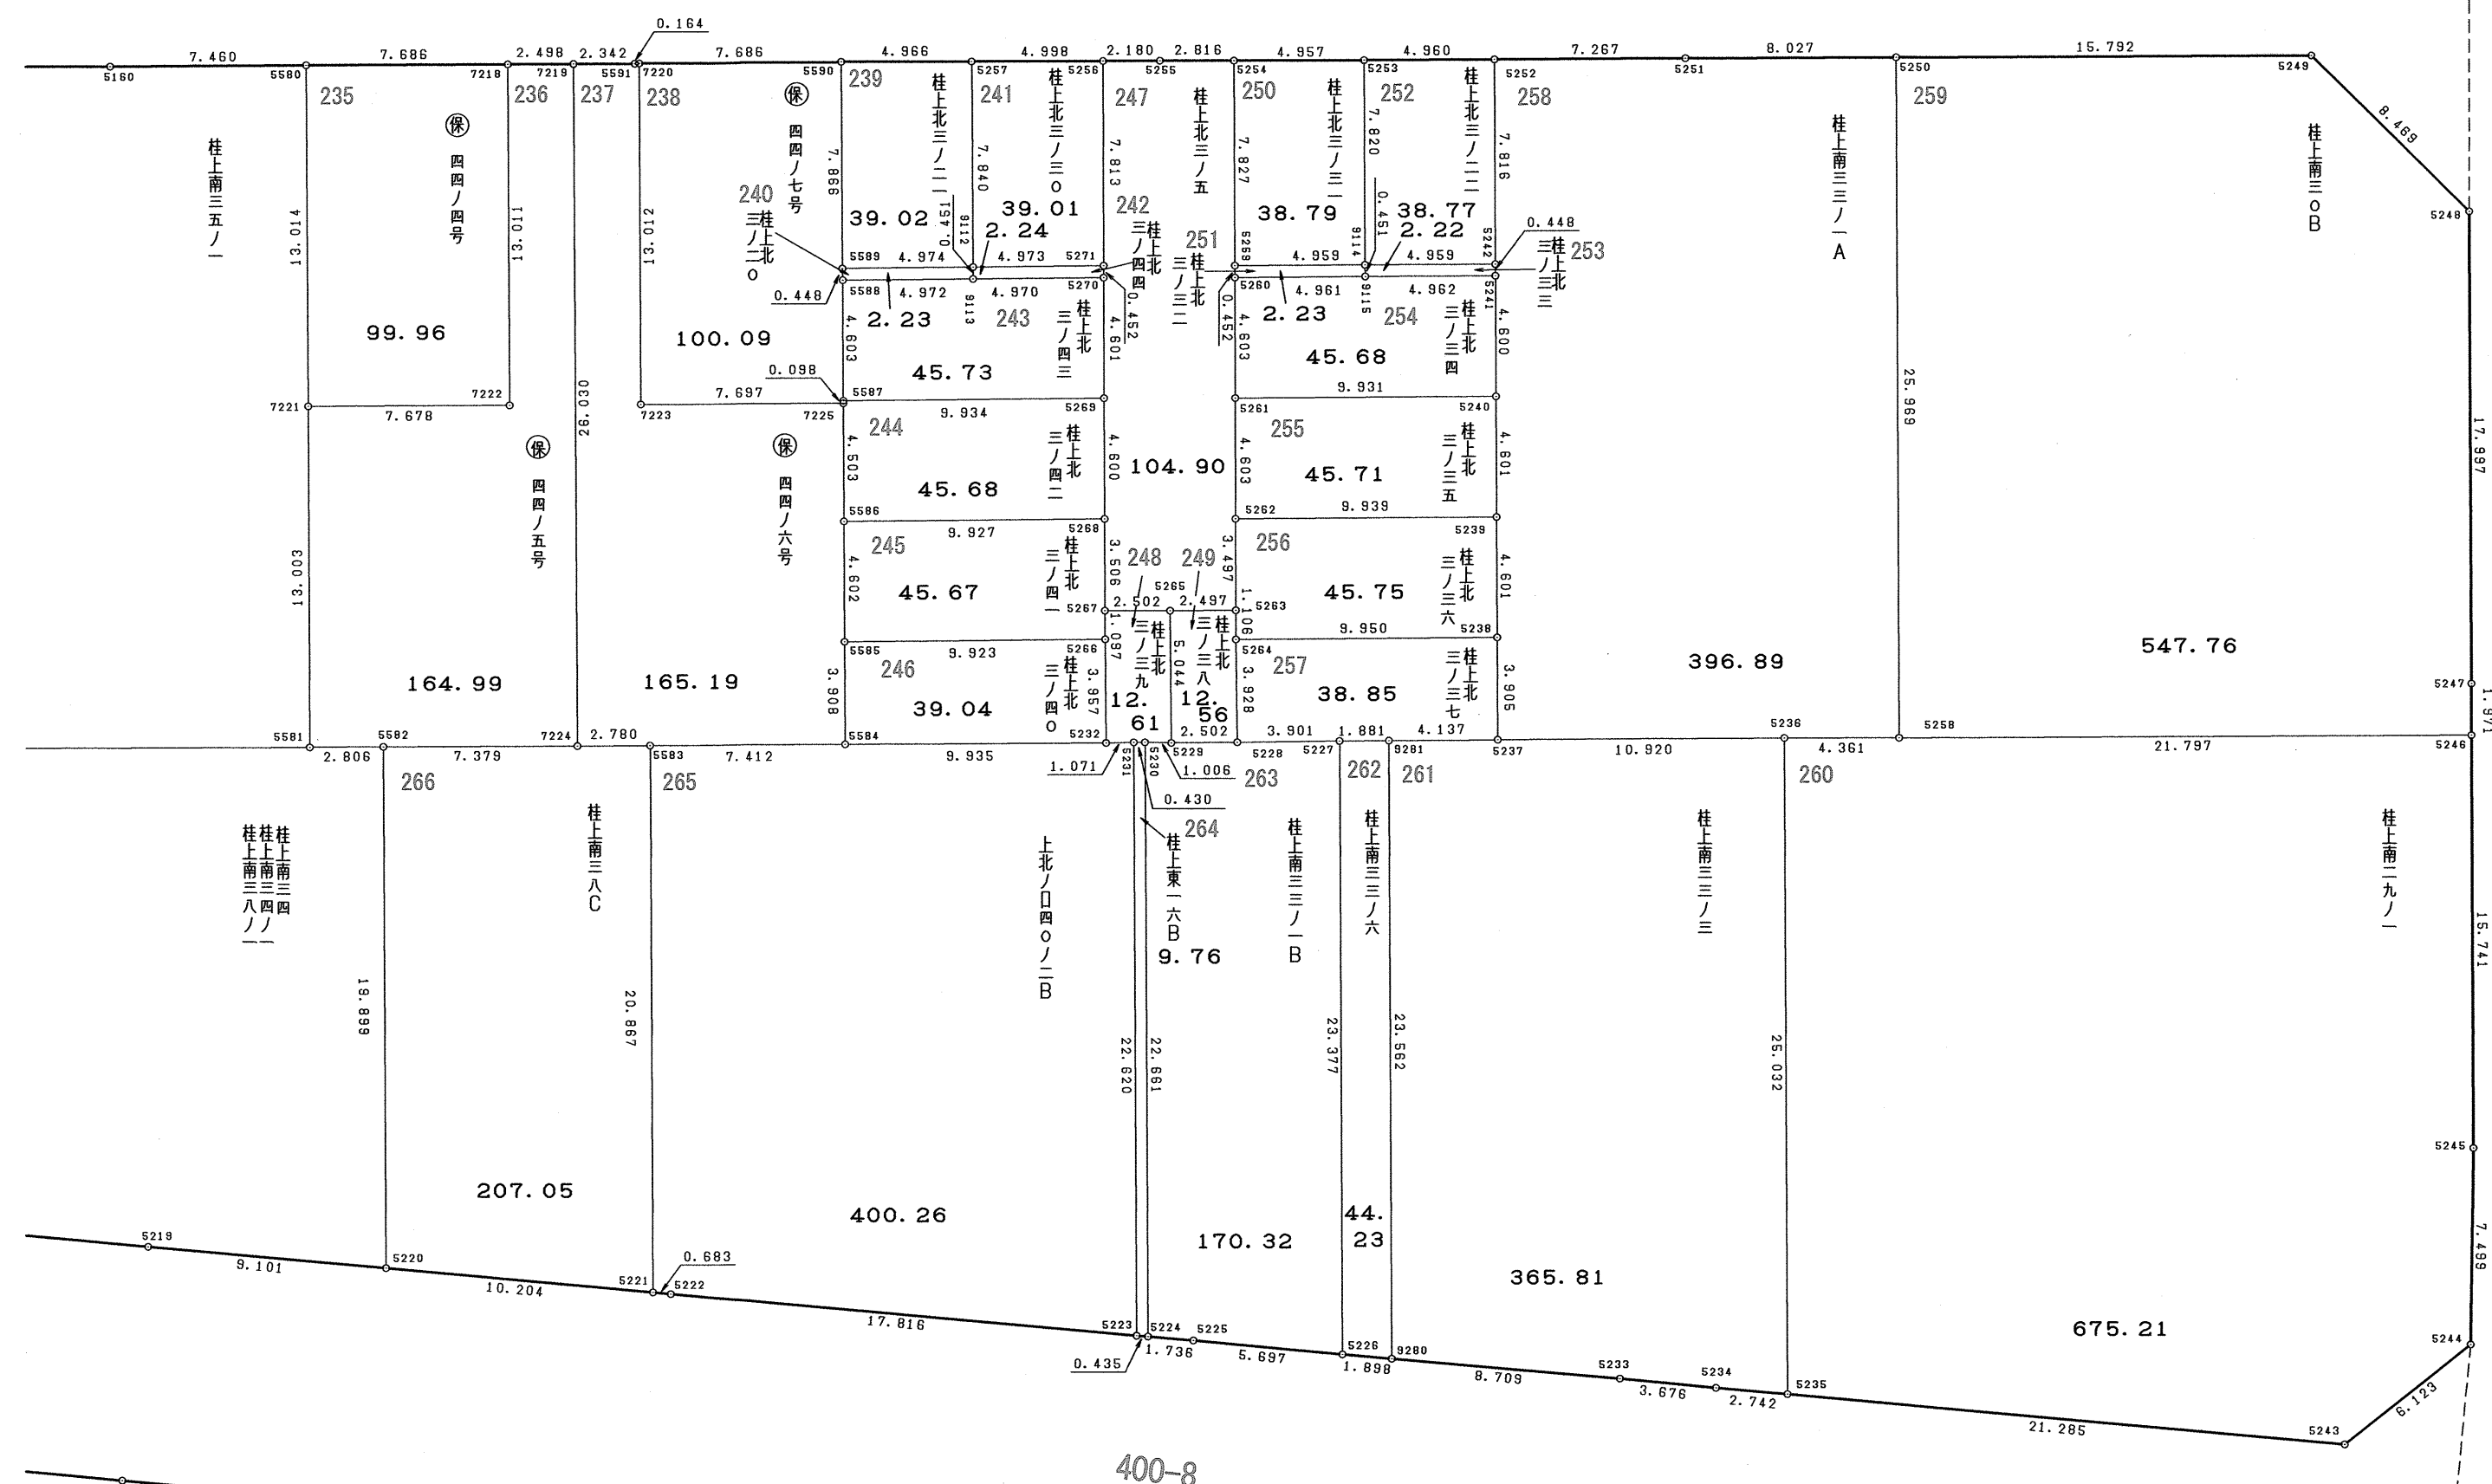

400-17

200-1

桂
上
野
南
町

69

400-14

200-3

210-1

43

小

図面の種類	画地出来形確認測量図				
街区番号	44	2/2	番号	縮尺	1 : 250
町名	桂上野西町				
京都市洛西第二土地区画整理組合					

222

地番	桂上西四六ノ二		
N O	X	Y	辺長
5190	-111359.268	-27347.448	
5191	-111373.663	-27356.024	16.756
5192	-111378.535	-27355.496	4.901
5212	-111381.495	-27352.757	4.033
5193	-111373.846	-27338.825	15.894
5190	-111359.268	-27347.448	16.937
面積	197.5176240		
地積	197.51 ㎡		

223

地番	桂上西四五ノ六		
N O	X	Y	辺長
5189	-111357.190	-27346.210	
5190	-111359.268	-27347.448	2.419
5193	-111373.846	-27338.825	16.937
5195	-111372.812	-27335.687	3.304
5179	-111370.477	-27325.117	10.825
5180	-111363.332	-27328.763	8.021
5207	-111366.154	-27334.220	6.143
5194	-111369.124	-27339.971	6.473
5189	-111357.190	-27346.210	13.466
面積	108.9575060		
地積	108.95 ㎡		

224

地番	桂上西四五ノ五		
N O	X	Y	辺長
5187	-111352.063	-27341.277	
5188	-111356.008	-27345.506	5.783
5189	-111357.190	-27346.210	1.376
5194	-111369.124	-27339.971	13.466
5207	-111366.154	-27334.220	6.473
5187	-111352.063	-27341.277	15.759
面積	97.5379020		
地積	97.53 ㎡		

225

地番	桂上西四五ノ四		
N O	X	Y	辺長
5185	-111348.133	-27336.057	
5186	-111350.118	-27339.192	3.711
5187	-111352.063	-27341.277	2.851
5207	-111366.154	-27334.220	15.759
5180	-111363.332	-27328.763	6.143
5181	-111356.201	-27332.329	7.973
5185	-111348.133	-27336.057	8.888
面積	102.2931855		
地積	102.29㎡		

226

地番	桂上西四七		
N O	X	Y	辺長
5182	-111342.634	-27322.656	
5183	-111344.962	-27329.254	6.997
5184	-111348.119	-27336.035	7.480
5185	-111348.133	-27336.057	0.026
5181	-111356.201	-27332.329	8.888
5180	-111363.332	-27328.763	7.973
5179	-111370.477	-27325.117	8.021
5178	-111371.317	-27324.662	0.955
5176	-111367.929	-27315.444	9.821
5206	-111351.949	-27320.032	16.626
5182	-111342.634	-27322.656	9.678
面積	320.8605365		
地積	320.86㎡		

227

地番	桂上西四八ノ三		
N O	X	Y	辺長
5204	-111340.829	-27317.540	
5182	-111342.634	-27322.656	5.425
5206	-111351.949	-27320.032	9.678
5205	-111350.014	-27314.943	5.444
5204	-111340.829	-27317.540	9.545
面積	52.0797600		
地積	52.07 ㎡		

228

地番	桂上西四八ノ二		
N O	X	Y	辺長
5202	-111340.741	-27308.309	
5203	-111338.589	-27311.189	3.595
5204	-111340.829	-27317.540	6.734
5205	-111350.014	-27314.943	9.545
5200	-111346.610	-27305.987	9.581
5201	-111344.470	-27306.833	2.301
5202	-111340.741	-27308.309	4.010
面積	82.8022905		
地積	82.80 ㎡		

229

地番	桂上西四八ノ一		
N O	X	Y	辺長
5200	-111346.610	-27305.987	
5205	-111350.014	-27314.943	9.581
5206	-111351.949	-27320.032	5.444
5176	-111367.929	-27315.444	16.626
5175	-111368.267	-27315.320	0.360
5173	-111364.709	-27307.082	8.974
9111	-111350.132	-27306.818	14.579
5198	-111349.402	-27304.882	2.069
5199	-111349.264	-27304.938	0.149
5200	-111346.610	-27305.987	2.854
面積	197.5046655		
地積	197.50 ㎡		

230

地番	保 四四ノ一号		
N O	X	Y	辺 長
5198	-111349.402	-27304.882	
9111	-111350.132	-27306.818	2.069
5173	-111364.709	-27307.082	14.579
5165	-111361.551	-27299.755	7.979
5196	-111358.689	-27301.001	3.121
5197	-111353.998	-27303.012	5.104
5198	-111349.402	-27304.882	4.962
面積	66.1502875		
地積	66.15 ㎡		

231

地番	桂上西四九, 桂上西四九ノ四		
N O	X	Y	辺長
5165	-111361.551	-27299.755	
5173	-111364.709	-27307.082	7.979
5175	-111368.267	-27315.320	8.974
5176	-111367.929	-27315.444	0.360
5178	-111371.317	-27324.662	9.821
5177	-111378.424	-27320.474	8.249
5174	-111386.657	-27320.458	8.233
5167	-111387.657	-27320.459	1.000
5166	-111386.248	-27317.338	3.424
5274	-111382.134	-27308.130	10.085
5273	-111367.993	-27307.136	14.176
5272	-111364.297	-27298.569	9.330
5164	-111363.345	-27298.982	1.038
5165	-111361.551	-27299.755	1.953
面積	267.5369625		
地積	267.53 ㎡		

232

地番	保 四四ノ二号		
N O	X	Y	辺 長
5272	-111364.297	-27298.569	
5273	-111367.993	-27307.136	9.330
5274	-111382.134	-27308.130	14.176
5275	-111375.634	-27293.575	15.940
5276	-111372.589	-27294.932	3.334
5277	-111367.983	-27296.968	5.036
5272	-111364.297	-27298.569	4.019
面積	157.3175445		
地積	157.31㎡		

233

地番	桂上南三八A		
N O	X	Y	辺長
5275	-111375.634	-27293.575	
5274	-111382.134	-27308.130	15.940
5166	-111386.248	-27317.338	10.085
5172	-111411.957	-27305.777	28.189
5159	-111401.325	-27282.080	25.973
5161	-111399.127	-27283.067	2.409
5162	-111381.399	-27291.009	19.426
5163	-111377.172	-27292.889	4.626
5275	-111375.634	-27293.575	1.684
面積	732.1474255		
地積	732.14㎡		

234

地番	桂上南三五ノ一		
N O	X	Y	辺長
5159	-111401.325	-27282.080	
5172	-111411.957	-27305.777	25.973
5581	-111444.316	-27291.287	35.455
7221	-111439.000	-27279.420	13.003
5580	-111433.670	-27267.547	13.014
5160	-111426.866	-27270.605	7.460
5158	-111409.677	-27278.328	18.844
5159	-111401.325	-27282.080	9.156
面積	921.7769585		
地積	921.77㎡		

235

地番	保 四四ノ四号		
N O	X	Y	辺 長
5580	-111433.670	-27267.547	
7221	-111439.000	-27279.420	13.014
7222	-111446.002	-27276.269	7.678
7218	-111440.680	-27264.396	13.011
5580	-111433.670	-27267.547	7.686
面積	99.9644640		
地積	99.96 ㎡		

236

地番	保 四四ノ五号		
N O	X	Y	辺 長
7221	-111439.000	-27279.420	
5581	-111444.316	-27291.287	13.003
5582	-111446.875	-27290.136	2.806
7224	-111453.611	-27287.123	7.379
7219	-111442.959	-27263.372	26.030
7218	-111440.680	-27264.396	2.498
7222	-111446.002	-27276.269	13.011
7221	-111439.000	-27279.420	7.678
面積	164.9926165		
地積	164.99 ㎡		

237			
地番	保 四四ノ六号		
N O	X	Y	辺長
7219	-111442.959	-27263.372	
7224	-111453.611	-27287.123	26.030
5583	-111456.147	-27285.984	2.780
5584	-111462.914	-27282.961	7.412
5585	-111461.314	-27279.396	3.908
5586	-111459.432	-27275.196	4.602
7225	-111457.590	-27271.087	4.503
7223	-111450.560	-27274.222	7.697
7220	-111445.245	-27262.345	13.012
5591	-111445.095	-27262.412	0.164
7219	-111442.959	-27263.372	2.342
面積	165.1961140		
地積	165.19 ㎡		

238

地番	保 四四ノ七号		
N O	X	Y	辺 長
7220	-111445.245	-27262.345	
7223	-111450.560	-27274.222	13.012
7225	-111457.590	-27271.087	7.697
5587	-111457.550	-27270.998	0.098
5588	-111455.670	-27266.796	4.603
5589	-111455.480	-27266.390	0.448
5590	-111452.262	-27259.212	7.866
7220	-111445.245	-27262.345	7.685
面積	100.0908550		
地積	100.09 ㎡		

239

地番	桂上北三ノ二一		
N O	X	Y	辺長
5590	-111452.262	-27259.212	
5589	-111455.480	-27266.390	7.866
9112	-111460.011	-27264.337	4.974
5257	-111456.796	-27257.187	7.840
5590	-111452.262	-27259.212	4.866
面積	39.0292735		
地積	39.02㎡		

240

地番	桂上北三ノ二〇		
N O	X	Y	辺長
5589	-111455.480	-27266.390	
5588	-111455.670	-27266.796	0.448
9113	-111460.200	-27264.746	4.972
9112	-111460.011	-27264.337	0.451
5589	-111455.480	-27266.390	4.974
面積	2.2349380		
地積	2.23 m ²		

249

地番	桂上北三ノ三八		
N O	X	Y	辺長
5265	-111472.191	-27273.290	
5229	-111474.272	-27277.885	5.044
5228	-111476.554	-27276.858	2.502
5264	-111474.919	-27273.286	3.928
5263	-111474.472	-27272.274	1.106
5265	-111472.191	-27273.290	2.497
面積	12.5682285		
地積	12.56㎡		

250

地番	桂上北三ノ三一		
N O	X	Y	辺長
5254	-111465.922	-27253.112	
5259	-111469.118	-27260.257	7.827
9114	-111473.644	-27258.230	4.959
5253	-111470.449	-27251.092	7.820
5254	-111465.922	-27253.112	4.957
面積	38.7920940		
地積	38.79㎡		

251

地番	桂上北三ノ三二		
N O	X	Y	辺長
5259	-111469.118	-27260.257	
5260	-111469.300	-27260.671	0.452
9115	-111473.827	-27258.642	4.961
9114	-111473.644	-27258.230	0.451
5259	-111469.118	-27260.257	4.959
面積	2.2395545		
地積	2.23㎡		

252

地番	桂上北三ノ二二		
N O	X	Y	辺長
5253	-111470.449	-27251.092	
9114	-111473.644	-27258.230	7.820
5242	-111478.170	-27256.204	4.959
5252	-111474.978	-27249.070	7.816
5253	-111470.449	-27251.092	4.960
面積	38.7718840		
地積	38.77㎡		

253

地番	桂上北三ノ三三		
N O	X	Y	辺長
9114	-111473.644	-27258.230	
9115	-111473.827	-27258.642	0.451
5241	-111478.355	-27256.612	4.962
5242	-111478.170	-27256.204	0.448
9114	-111473.644	-27258.230	4.959
面積	2.2292220		
地積	2.22㎡		

254

地番	桂上北三ノ三四		
N O	X	Y	辺長
5260	-111469.300	-27260.671	
5261	-111471.173	-27264.876	4.603
5240	-111480.234	-27260.811	9.931
5241	-111478.355	-27256.612	4.600
9115	-111473.827	-27258.642	4.962
5260	-111469.300	-27260.671	4.961
面積	45.6807790		
地積	45.68㎡		

255

地番	桂上北三ノ三五		
N O	X	Y	辺長
5261	-111471.173	-27264.876	
5262	-111473.047	-27269.080	4.603
5239	-111482.114	-27265.010	9.939
5240	-111480.234	-27260.811	4.601
5261	-111471.173	-27264.876	9.931
面積	45.7170935		
地積	45.71㎡		

256

地番	桂上北三ノ三六		
N O	X	Y	辺長
5262	-111473.047	-27269.080	
5263	-111474.472	-27272.274	3.497
5264	-111474.919	-27273.286	1.106
5238	-111483.995	-27269.209	9.950
5239	-111482.114	-27265.010	4.601
5262	-111473.047	-27269.080	9.939
面積	45.7597105		
地積	45.75㎡		

257

地番	桂上北三ノ三七		
N O	X	Y	辺長
5264	-111474.919	-27273.286	
5228	-111476.554	-27276.858	3.928
5227	-111480.104	-27275.242	3.901
9281	-111481.819	-27274.470	1.881
5237	-111485.592	-27272.773	4.137
5238	-111483.995	-27269.209	3.905
5264	-111474.919	-27273.286	9.950
面積	38.8572425		
地積	38.85㎡		

258

地番	桂上南三三ノ一A		
N O	X	Y	辺長
5252	-111474.978	-27249.070	
5242	-111478.170	-27256.204	7.816
5241	-111478.355	-27256.612	0.448
5240	-111480.234	-27260.811	4.600
5239	-111482.114	-27265.010	4.601
5238	-111483.995	-27269.209	4.601
5237	-111485.592	-27272.773	3.905
5236	-111495.554	-27268.301	10.920
5258	-111499.541	-27266.534	4.361
5250	-111488.940	-27242.827	25.969
5251	-111481.614	-27246.108	8.027
5252	-111474.978	-27249.070	7.267
面積	396.8947060		
地積	396.89㎡		

259

地番	桂上南三〇B		
N O	X	Y	辺長
5250	-111488.940	-27242.827	
5258	-111499.541	-27266.534	25.969
5246	-111519.428	-27257.612	21.797
5247	-111518.623	-27255.813	1.971
5248	-111511.265	-27239.389	17.997
5249	-111503.952	-27236.371	8.469
5250	-111488.940	-27242.827	15.792
面積	547.7667830		
地積	547.76㎡		

260

地番	桂上南二九ノ一		
N O	X	Y	辺長
5236	-111495.554	-27268.301	
5235	-111505.789	-27291.145	25.032
5243	-111525.946	-27284.308	21.285
5244	-111528.787	-27278.884	6.123
5245	-111525.854	-27271.982	7.499
5246	-111519.428	-27257.612	15.741
5258	-111499.541	-27266.534	21.797
5236	-111495.554	-27268.301	4.361
面積	675.2123670		
地積	675.21㎡		

261

地番	桂上南三三ノ三		
N O	X	Y	辺長
9280	-111491.453	-27295.972	
5233	-111499.704	-27293.186	8.709
5234	-111503.192	-27292.026	3.676
5235	-111505.789	-27291.145	2.742
5236	-111495.554	-27268.301	25.032
5237	-111485.592	-27272.773	10.920
9281	-111481.819	-27274.470	4.137
9280	-111491.453	-27295.972	23.562
面積	365.8192960		
地積	365.81㎡		

262

地番	桂上南三三ノ六		
N O	X	Y	辺長
5226	-111489.655	-27296.579	
9280	-111491.453	-27295.972	1.898
9281	-111481.819	-27274.470	23.562
5227	-111480.104	-27275.242	1.881
5226	-111489.655	-27296.579	23.377
面積	44.2373805		
地積	44.23㎡		

263

地番	桂上南三三ノ一B		
N O	X	Y	辺長
5230	-111473.346	-27278.277	
5224	-111482.612	-27298.957	22.661
5225	-111484.257	-27298.401	1.736
5226	-111489.655	-27296.579	5.697
5227	-111480.104	-27275.242	23.377
5228	-111476.554	-27276.858	3.901
5229	-111474.272	-27277.885	2.502
5230	-111473.346	-27278.277	1.006
面積	170.3296425		
地積	170.32㎡		

264

地番	桂上東一六B		
N O	X	Y	辺長
5231	-111472.954	-27278.453	
5223	-111482.200	-27299.097	22.620
5224	-111482.612	-27298.957	0.435
5230	-111473.346	-27278.277	22.661
5231	-111472.954	-27278.453	0.430
面積	9.7685720		
地積	9.76㎡		

265

地番	上北ノ口四〇ノ二B		
N O	X	Y	辺長
5583	-111456.147	-27285.984	
5221	-111464.678	-27305.028	20.867
5222	-111465.325	-27304.809	0.683
5223	-111482.200	-27299.097	17.816
5231	-111472.954	-27278.453	22.620
5232	-111471.985	-27278.908	1.071
5584	-111462.914	-27282.961	9.935
5583	-111456.147	-27285.984	7.412
面積	400.2635190		
地積	400.26㎡		

266

地番	桂上南三八C		
N O	X	Y	辺長
5582	-111446.875	-27290.136	
5220	-111455.011	-27308.296	19.899
5221	-111464.678	-27305.028	10.204
5583	-111456.147	-27285.984	20.867
7224	-111453.611	-27287.123	2.780
5582	-111446.875	-27290.136	7.379
面積	207.0532560		
地積	207.05㎡		

267


地番	桂上南三四，三四ノ一，三八ノ一		
N O	X	Y	辺長
5166	-111386.248	-27317.338	
5167	-111387.657	-27320.459	3.424
5168	-111392.889	-27320.462	5.232
5169	-111398.121	-27320.508	5.232
5170	-111400.861	-27321.094	2.802
5171	-111404.254	-27322.041	3.523
5215	-111407.470	-27329.219	7.866
5216	-111411.682	-27325.494	5.623
5217	-111416.387	-27321.332	6.282
5218	-111432.190	-27316.004	16.677
5219	-111446.389	-27311.211	14.986
5220	-111455.011	-27308.296	9.101
5582	-111446.875	-27290.136	19.899
5581	-111444.316	-27291.287	2.806
5172	-111411.957	-27305.777	35.455
5166	-111386.248	-27317.338	28.189
面積	1031.6750465		
地積	1031.67㎡		

268

地番	桂上西五一ノ二		
N O	X	Y	辺長
5168	-111392.889	-27320.462	
5214	-111391.028	-27325.556	5.423
5213	-111392.275	-27325.970	1.314
5211	-111388.908	-27337.201	11.725
5209	-111389.693	-27340.540	3.430
5208	-111393.615	-27341.541	4.048
5210	-111395.376	-27339.912	2.399
5215	-111407.470	-27329.219	16.143
5171	-111404.254	-27322.041	7.866
5170	-111400.861	-27321.094	3.523
5169	-111398.121	-27320.508	2.802
5168	-111392.889	-27320.462	5.232
面積	244.4101730		
地積	244.41㎡		

269

地番

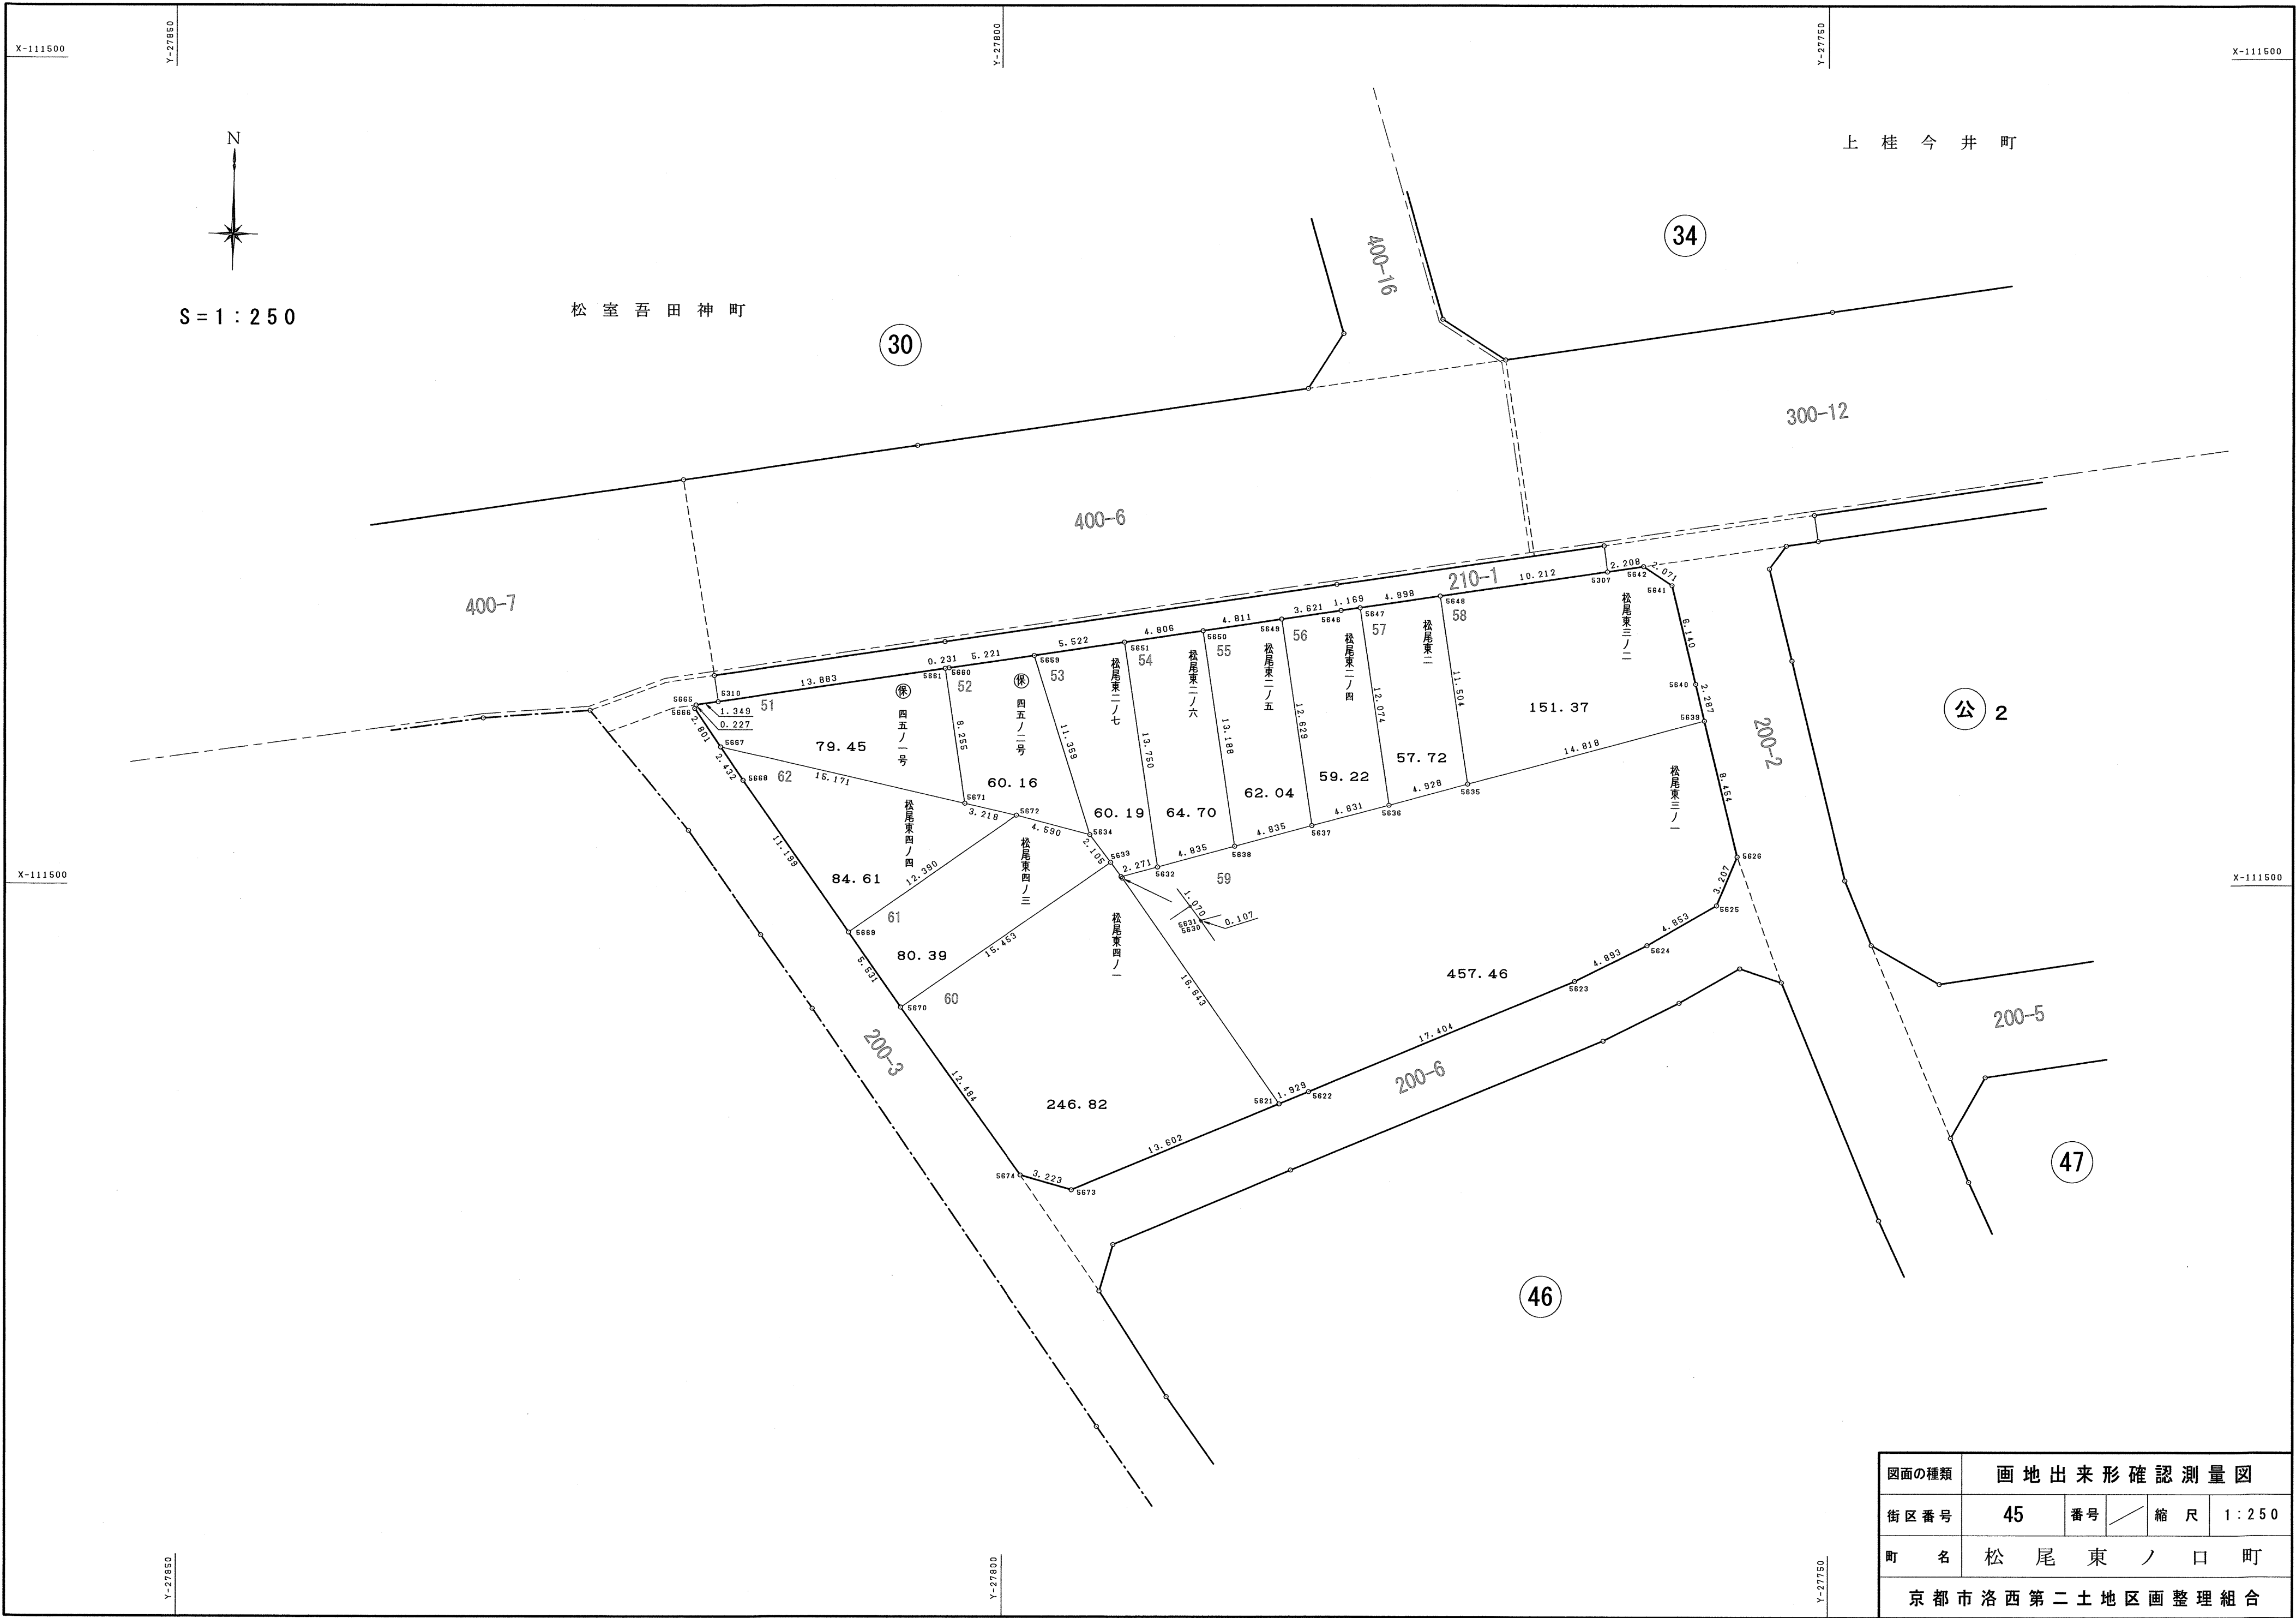

図面の種類	画 地 出 来 形 確 認 測 量 図				
街区 番号	45	番号		縮 尺	1 : 2 5 0
町 名	松 尾 東 ノ 口 町				
京 都 市 洛 西 第 二 土 地 区 画 整 理 組 合					

51			
地番	保 四五ノ一号		
N O	X	Y	辺 長
5665	-111489.121	-27818.523	
5666	-111489.333	-27818.603	0.227
5667	-111491.657	-27817.040	2.801
5671	-111495.075	-27802.259	15.171
5661	-111486.907	-27803.453	8.255
5310	-111488.909	-27817.191	13.883
5665	-111489.121	-27818.523	1.349
面積	79.4570330		
地積	79.45 m ²		

52			
地番	保 四五ノ二号		
N O	X	Y	辺 長
5661	-111486.907	-27803.453	
5671	-111495.075	-27802.259	8.255
5672	-111495.795	-27799.123	3.218
5634	-111496.963	-27794.684	4.590
5659	-111486.117	-27798.058	11.359
5660	-111486.874	-27803.224	5.221
5661	-111486.907	-27803.453	0.231
面積	60.1641575		
地積	60.16 m ²		

53			
地番	松尾東二ノ七		
N O	X	Y	辺 長
5659	-111486.117	-27798.058	
5634	-111496.963	-27794.684	11.359
5633	-111498.642	-27793.415	2.105
5631	-111499.505	-27792.783	1.070
5632	-111498.920	-27790.589	2.271
5651	-111485.317	-27792.594	13.750
5659	-111486.117	-27798.058	5.522
面積	60.1987290		
地積	60.19 m ²		

54			
地番	松尾東二ノ六		
N O	X	Y	辺 長
5651	-111485.317	-27792.594	
5632	-111498.920	-27790.589	13.750
5638	-111497.668	-27785.919	4.835
5650	-111484.621	-27787.839	13.188
5651	-111485.317	-27792.594	4.806
面積	64.7055375		
地積	64.70 m ²		

55			
地番	松尾東二ノ五		
N O	X	Y	辺 長
5650	-111484.621	-27787.839	
5638	-111497.668	-27785.919	13.188
5637	-111496.420	-27781.248	4.835
5649	-111483.924	-27783.079	12.629
5650	-111484.621	-27787.839	4.811
面積	62.0479320		
地積	62.04 m ²		

56			
地番	松尾東二ノ四		
N O	X	Y	辺 長
5649	-111483.924	-27783.079	
5637	-111496.420	-27781.248	12.629
5636	-111495.174	-27776.580	4.831
5647	-111483.229	-27778.339	12.074
5646	-111483.399	-27779.496	1.169
5649	-111483.924	-27783.079	3.621
面積	59.2264370		
地積	59.22 m ²		

57			
地番	松尾東二		
N O	X	Y	辺 長
5647	-111483.229	-27778.339	
5636	-111495.174	-27776.580	12.074
5635	-111493.897	-27771.820	4.928
5648	-111482.515	-27773.493	11.504
5647	-111483.229	-27778.339	4.898
面積	57.7280685		
地積	57.72 m ²		

58			
地番	松尾東三ノ二		
N O	X	Y	辺 長
5648	-111482.515	-27773.493	
5635	-111493.897	-27771.820	11.504
5639	-111490.058	-27757.508	14.818
5640	-111487.835	-27758.044	2.287
5641	-111481.865	-27759.480	6.140
5642	-111480.717	-27761.204	2.071
5307	-111481.026	-27763.390	2.208
5648	-111482.515	-27773.493	10.212
面積	151.3725495		
地積	151.37 m ²		


59			
地番	松尾東三ノ一		
N O	X	Y	辺 長
5631	-111499.505	-27792.783	
5630	-111499.587	-27792.714	0.107
5621	-111513.249	-27783.210	16.643
5622	-111512.510	-27781.428	1.929
5623	-111505.825	-27765.359	17.404
5624	-111503.647	-27760.977	4.893
5625	-111501.233	-27756.767	4.853
5626	-111498.276	-27755.525	3.207
5639	-111490.058	-27757.508	8.454
5635	-111493.897	-27771.820	14.818
5636	-111495.174	-27776.580	4.928
5637	-111496.420	-27781.248	4.831
5638	-111497.668	-27785.919	4.835
5632	-111498.920	-27790.589	4.835
5631	-111499.505	-27792.783	2.271
面積	457.4675675		
地積	457.46 m ²		

60			
地番	松尾東四ノ一		
N O	X	Y	辺 長
5670	-111507.414	-27806.137	
5674	-111517.569	-27798.875	12.484
5673	-111518.455	-27795.776	3.223
5621	-111513.249	-27783.210	13.602
5630	-111499.587	-27792.714	16.643
5631	-111499.505	-27792.783	0.107
5633	-111498.642	-27793.415	1.070
5670	-111507.414	-27806.137	15.453
面積	246.8266790		
地積	246.82 m ²		

61			
地番	松尾東四ノ三		
N O	X	Y	辺 長
5669	-111502.872	-27809.293	
5670	-111507.414	-27806.137	5.531
5633	-111498.642	-27793.415	15.453
5634	-111496.963	-27794.684	2.105
5672	-111495.795	-27799.123	4.590
5669	-111502.872	-27809.293	12.390
面積	80.3940755		
地積	80.39 m ²		

62			
地番	松尾東四ノ四		
N O	X	Y	辺 長
5667	-111491.657	-27817.040	
5668	-111493.675	-27815.683	2.432
5669	-111502.872	-27809.293	11.199
5672	-111495.795	-27799.123	12.390
5671	-111495.075	-27802.259	3.218
5667	-111491.657	-27817.040	15.171
面積	84.6101160		
地積	84.61 m ²		

図面の種類	画 地 面 積 求 積 表				
街区番号	45	番号	／		
町 名	松 尾 東 ノ 口 町				
京 都 市 洛 西 第 二 土 地 区 画 整 理 組 合					

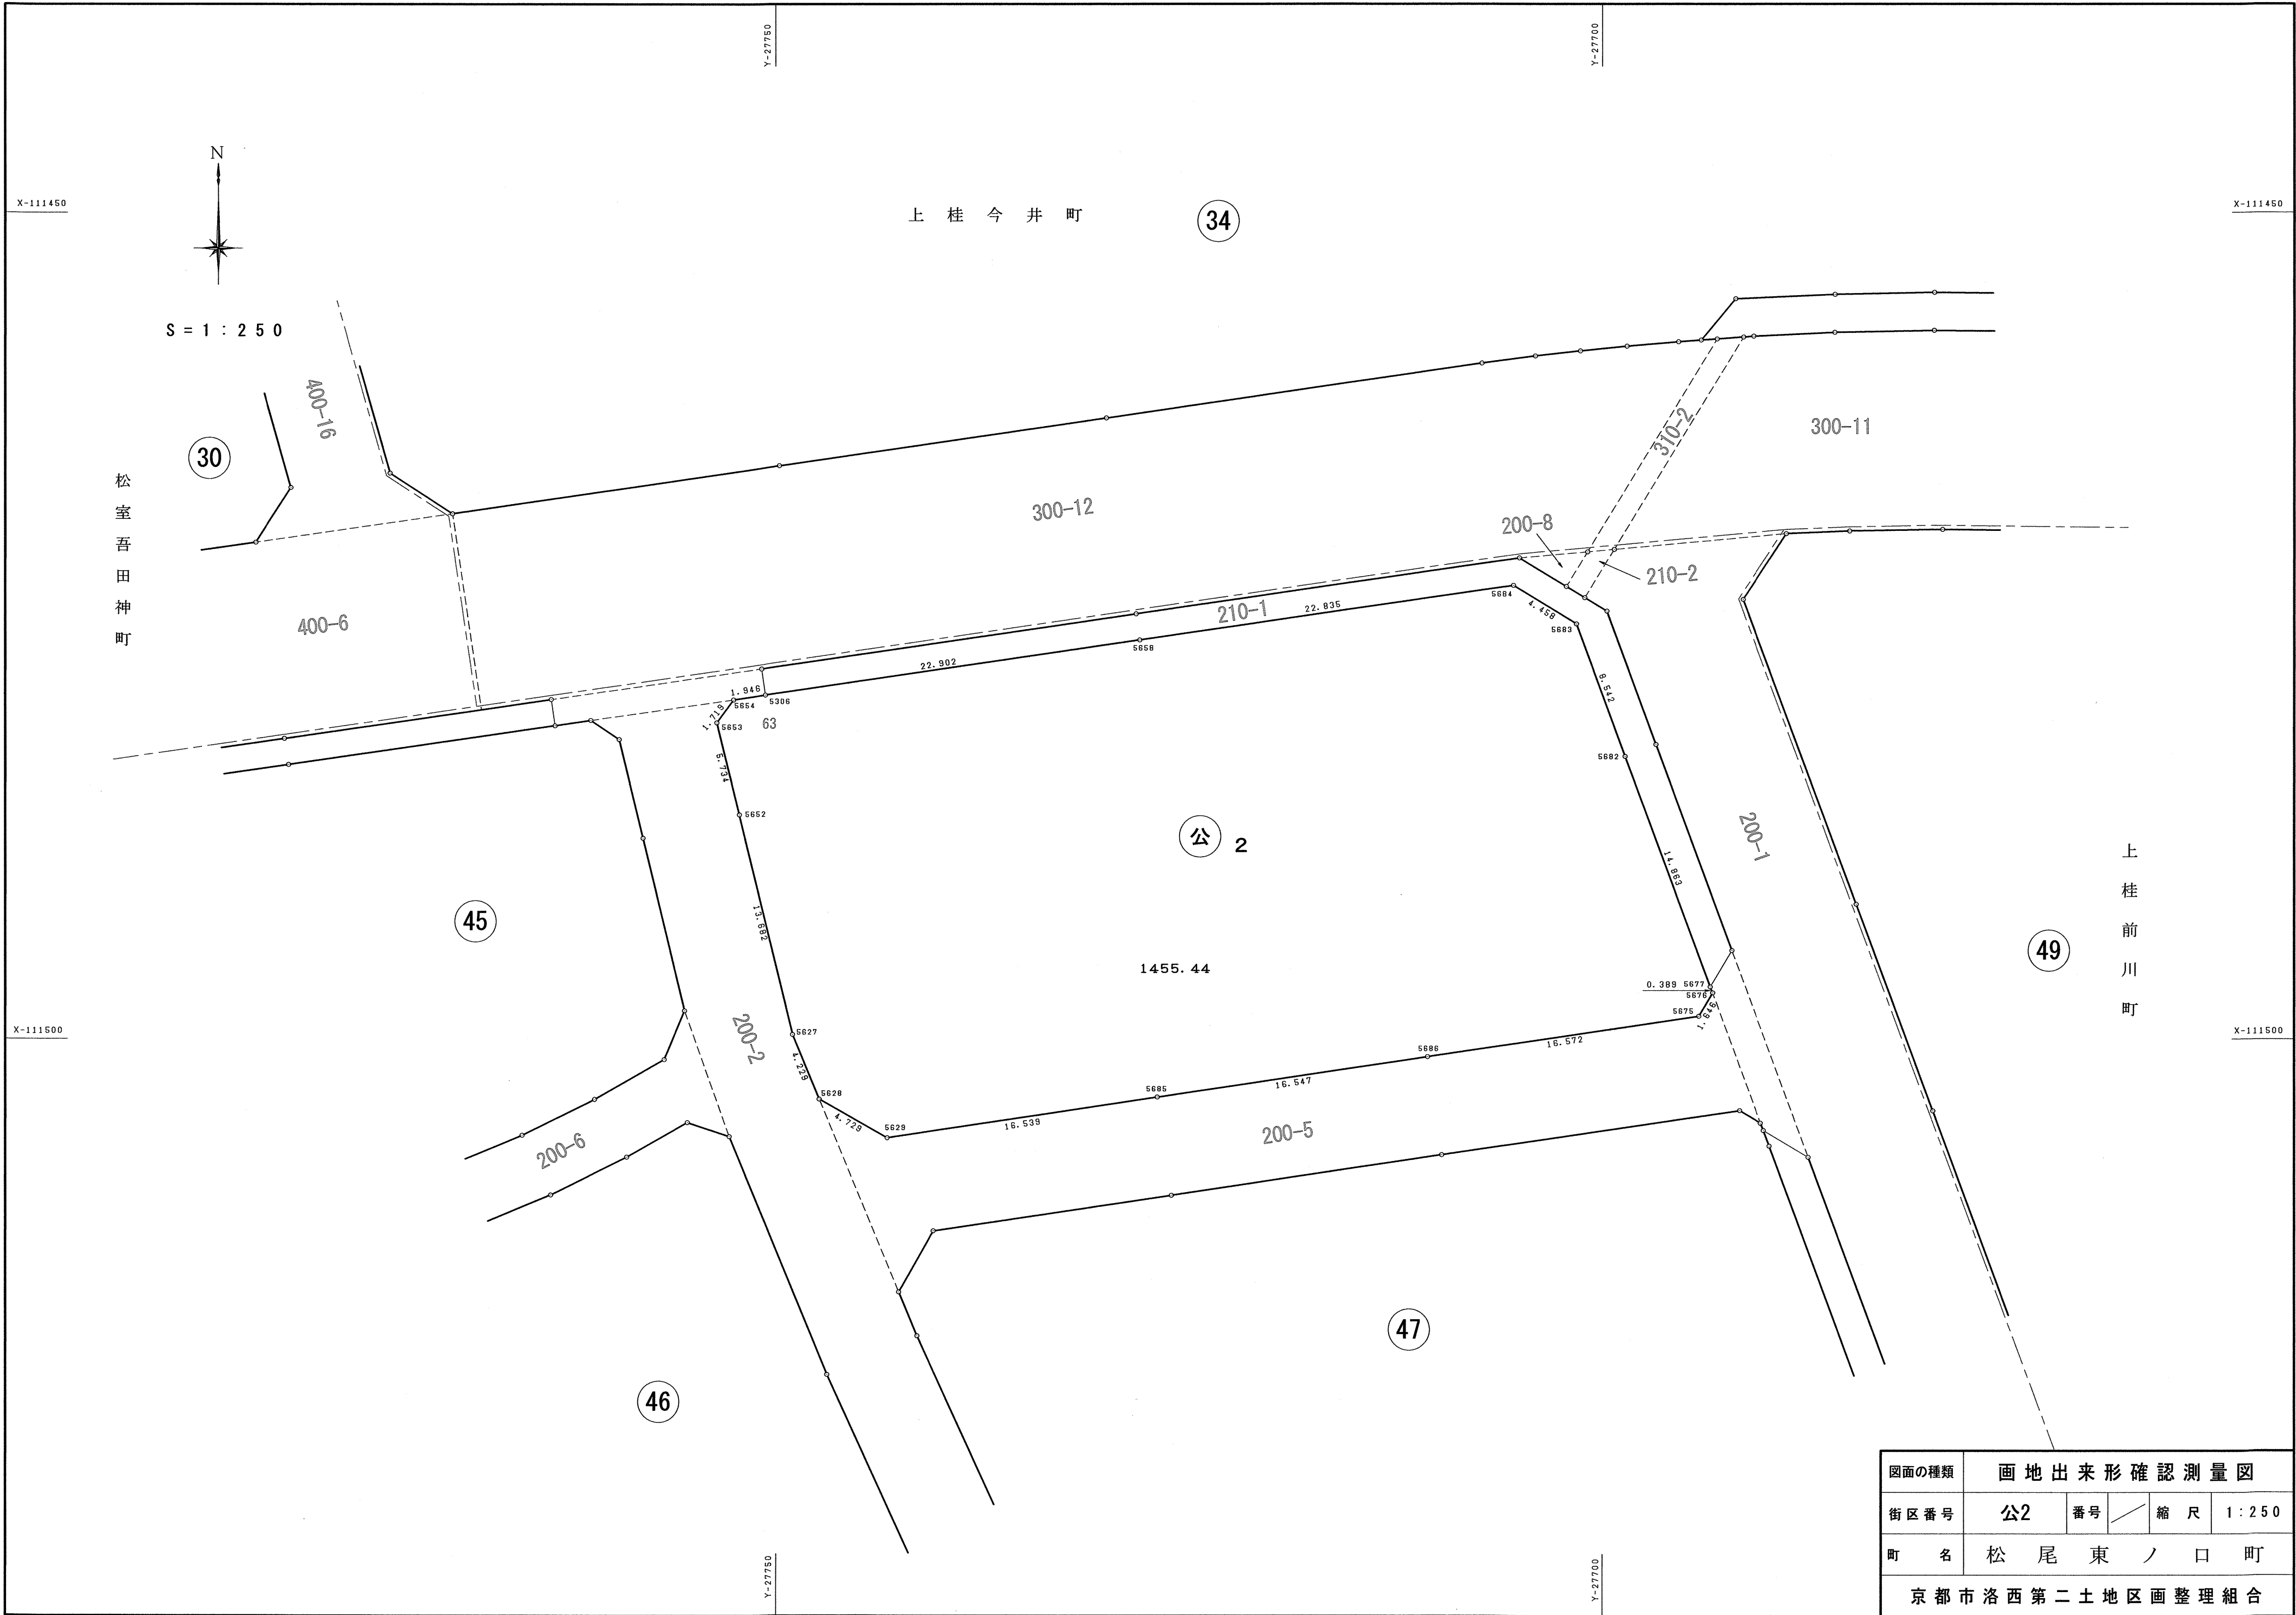

図面の種類	画 地 出 来 形 確 認 測 量 図				
街区 番号	公2	番号		縮 尺	1 : 2 5 0
町 名	松 尾 東 ノ 口 町				
京 都 市 洛 西 第 二 土 地 区 画 整 理 組 合					

地番	公2		
N O	X	Y	辺長
5654	-111479.461	-27752.565	
5653	-111480.848	-27753.580	1.719
5652	-111486.417	-27752.213	5.734
5627	-111499.714	-27748.991	13.682
5628	-111503.625	-27747.382	4.229
5629	-111505.970	-27743.275	4.729
5685	-111503.509	-27726.920	16.539
5686	-111501.061	-27710.555	16.547
5675	-111498.620	-27694.164	16.572
5676	-111497.198	-27693.335	1.646
5677	-111496.837	-27693.481	0.389
5682	-111482.896	-27698.635	14.863
5683	-111474.877	-27701.577	8.542
5684	-111472.558	-27705.384	4.458
5658	-111475.852	-27727.980	22.835
5306	-111479.174	-27750.640	22.902
5654	-111479.461	-27752.565	1.946
面積	1455.4461040		
地積	1455.44㎡		

図面の種類	画地面積求積表			
街区番号	公.2	番号	／	
町名	松	尾	東	ノ口町
京都市洛西第二土地区画整理組合				

122

地番	松尾東六ノ二		
N O	X	Y	辺 長
5701	-111517.529	-27783.127	
5703	-111521.764	-27793.249	10.972
5704	-111524.585	-27794.083	2.942
5705	-111530.973	-27790.021	7.570
5708	-111523.919	-27778.936	13.139
5710	-111522.651	-27776.925	2.377
5709	-111522.701	-27777.740	0.817
5707	-111521.814	-27779.812	2.254
5706	-111520.150	-27781.258	2.204
5701	-111517.529	-27783.127	3.219
面積	115.5644595		
地積	115.56㎡		

123

地 番	松尾東五ノ一		
N O	X	Y	辺 長
5699	-111512.380	-27770.732	
5700	-111517.271	-27782.510	12.753
5701	-111517.529	-27783.127	0.669
5706	-111520.150	-27781.258	3.219
5707	-111521.814	-27779.812	2.204
5709	-111522.701	-27777.740	2.254
5710	-111522.651	-27776.925	0.817
5711	-111522.578	-27775.298	1.629
5712	-111522.480	-27773.347	1.953
5713	-111522.730	-27769.184	4.170
5731	-111523.887	-27766.035	3.355
5699	-111512.380	-27770.732	12.429
面積	107.8768410		
地積	107.87 ㎡		

124

地番	松尾東五ノ三		
N O	X	Y	辺 長
5698	-111509.860	-27764.664	
5699	-111512.380	-27770.732	6.570
5731	-111523.887	-27766.035	12.429
5732	-111524.157	-27765.322	0.762
5733	-111525.631	-27763.705	2.188
5734	-111526.184	-27763.217	0.738
5693	-111524.136	-27758.755	4.910
5698	-111509.860	-27764.664	15.451
面積	99.5437715		
地積	99.54 ㎡		

125

地番	松尾東五ノ四		
N O	X	Y	辺 長
5696	-111507.131	-27759.027	
5697	-111509.429	-27763.626	5.141
5698	-111509.860	-27764.664	1.124
5693	-111524.136	-27758.755	15.451
5692	-111521.604	-27753.096	6.200
5702	-111514.590	-27755.976	7.582
5696	-111507.131	-27759.027	8.059
面積	96.5170555		
地積	96.51 ㎡		

126

地 番	松尾東五ノ五		
N O	X	Y	辺 長
5694	-111505.888	-27752.825	
5695	-111505.041	-27755.360	2.673
5696	-111507.131	-27759.027	4.221
5702	-111514.590	-27755.976	8.059
5687	-111512.178	-27750.245	6.218
5694	-111505.888	-27752.825	6.799
面積	50.3640800		
地積	50.36㎡		

127

地 番	松尾東五ノ九		
N O	X	Y	辺 長
5687	-111512.178	-27750.245	
5702	-111514.590	-27755.976	6.218
5692	-111521.604	-27753.096	7.582
5688	-111519.069	-27747.418	6.218
5687	-111512.178	-27750.245	7.448
面積	46.7186685		
地積	46.71 m ²		

128

地 番		松尾東五ノ六		
N O	X	Y	辺 長	
5688	-111519.069	-27747.418		
5692	-111521.604	-27753.096	6.218	
5693	-111524.136	-27758.755	6.200	
5734	-111526.184	-27763.217	4.910	
5723	-111527.059	-27762.433	1.175	
5724	-111527.419	-27762.112	0.482	
5725	-111528.366	-27761.395	1.188	
5735	-111530.376	-27759.857	2.531	
5736	-111531.085	-27759.356	0.868	
5690	-111524.583	-27744.962	15.794	
5689	-111520.286	-27746.919	4.722	
5688	-111519.069	-27747.418	1.315	
面積			99.9457860	
地積			99.94 ㎡	

129

地番	松尾東五ノ七			
N O	X	Y	辺 長	
5690	-111524.583	-27744.962		
5736	-111531.085	-27759.356	15.794	
5737	-111534.816	-27756.718	4.569	
5738	-111536.055	-27755.573	1.687	
5739	-111536.486	-27755.172	0.589	
5691	-111530.638	-27742.205	14.225	
5690	-111524.583	-27744.962	6.653	
面積	100.4752465			
地積	100.47㎡			

130

地番	松尾東五ノ八		
N O	X	Y	辺長
5691	-111530.638	-27742.205	
5739	-111536.486	-27755.172	14.225
5770	-111543.245	-27748.913	9.212
5800	-111539.932	-27743.975	5.946
5798	-111536.659	-27739.115	5.859
5799	-111533.363	-27740.964	3.779
5691	-111530.638	-27742.205	2.994
面積	101.3518940		
地積	101.35㎡		

131

地番	松尾東六ノ二八		
N O	X	Y	辺長
5798	-111536.659	-27739.115	
5800	-111539.932	-27743.975	5.859
5797	-111537.487	-27738.760	5.760
5804	-111537.114	-27738.936	0.412
5798	-111536.659	-27739.115	0.489
面積	2.5863410		
地積	2.58 ㎡		

132

地 番	松尾東六ノ一		
N O	X	Y	辺 長
5797	-111537.487	-27738.760	
5800	-111539.932	-27743.975	5.760
5770	-111543.245	-27748.913	5.946
5771	-111545.763	-27746.572	3.438
5796	-111541.265	-27736.981	10.593
5797	-111537.487	-27738.760	4.176
面積	44.2426785		
地積	44.24 ㎡		

133

地番	松尾東六ノ二六		
N O	X	Y	辺 長
5796	-111541.265	-27736.981	
5771	-111545.763	-27746.572	10.593
5811	-111546.344	-27747.314	0.942
5788	-111549.599	-27745.790	3.594
5795	-111544.704	-27735.361	11.521
5796	-111541.265	-27736.981	3.801
面積	43.7021985		
地積	43.70 ㎡		

134

地番	松尾東六ノ二七		
N O	X	Y	辺 長
5795	-111544.704	-27735.361	
5788	-111549.599	-27745.790	11.521
9116	-111551.603	-27744.836	2.219
5794	-111546.703	-27734.419	11.512
5795	-111544.704	-27735.361	2.210
面積	25.5044645		
地積	25.50 ㎡		

135

地 番	松尾東六ノ二五		
N O	X	Y	辺 長
5794	-111546.703	-27734.419	
9116	-111551.603	-27744.836	11.512
5787	-111553.030	-27744.157	1.580
5793	-111548.145	-27733.740	11.506
5794	-111546.703	-27734.419	1.594
面積	18.2651940		
地積	18.26 ㎡		

136

地番	松尾東六ノ四〇		
N O	X	Y	辺 長
5793	-111548.145	-27733.740	
5787	-111553.030	-27744.157	11.506
9120	-111557.926	-27741.827	5.422
5791	-111553.174	-27731.366	11.490
5792	-111550.800	-27732.489	2.626
5793	-111548.145	-27733.740	2.935
面積	63.1308040		
地積	63.13 m ²		

137

地 番	松尾東六ノ三七		
N O	X	Y	辺 長
5787	-111553.030	-27744.157	
5786	-111553.240	-27744.609	0.498
5785	-111558.178	-27742.382	5.417
9120	-111557.926	-27741.827	0.610
5787	-111553.030	-27744.157	5.422
面積	3.0020430		
地積	3.00 m ²		

138

151			
地番	松尾東六ノ三一		
N O	X	Y	辺長
9125	-111567.039	-27749.005	
5774	-111567.411	-27749.841	0.915
9124	-111567.429	-27749.833	0.020
9125	-111567.039	-27749.005	0.915
面積	0.0090120		
地積	0.00 m ²		

152			
地番	松尾東六ノ三〇		
N O	X	Y	辺長
9123	-111566.649	-27748.177	
9125	-111567.039	-27749.005	0.915
9122	-111566.667	-27748.169	0.915
9123	-111566.649	-27748.177	0.020
面積	0.0090120		
地積	0.00 m ²		

153

地番	松尾東六ノ三二		
N O	X	Y	辺長
9121	-111564.929	-27744.507	
9123	-111566.649	-27748.177	4.053
9122	-111566.667	-27748.169	0.020
5775	-111565.135	-27744.726	3.768
5776	-111565.020	-27744.466	0.284
9121	-111564.929	-27744.507	0.100
面積	0.2409725		
地積	0.24㎡		

154

地番	松尾東六ノ三九		
N O	X	Y	辺長
9118	-111562.934	-27740.267	
9121	-111564.929	-27744.507	4.686
5776	-111565.020	-27744.466	0.100
5784	-111563.107	-27740.189	4.685
9118	-111562.934	-27740.267	0.190
面積	0.6783850		
地積	0.67 ㎡		

155			
地番	松尾東六ノ三		
N O	X	Y	辺長
5777	-111560.897	-27746.313	
9136	-111562.948	-27750.869	4.996
5779	-111563.042	-27751.079	0.230
5780	-111565.650	-27756.911	6.389
5748	-111567.802	-27761.728	5.276
5747	-111566.996	-27764.727	3.105
5749	-111570.383	-27762.381	4.120
9138	-111572.689	-27760.974	2.701
9127	-111571.929	-27759.362	1.782
5772	-111571.635	-27759.264	0.310
5773	-111569.703	-27754.951	4.726
5774	-111567.411	-27749.841	5.600
9125	-111567.039	-27749.005	0.915
9123	-111566.649	-27748.177	0.915
9121	-111564.929	-27744.507	4.053
5777	-111560.897	-27746.313	4.418
面積	85.7243390		
地積	85.72㎡		

156			
地番	松尾東六ノ三六		
N O	X	Y	辺長
5811	-111546.344	-27747.314	
9128	-111547.720	-27749.056	2.220
9130	-111548.649	-27748.635	1.020
9129	-111549.730	-27750.944	2.550
5778	-111560.744	-27745.987	12.078
5777	-111560.897	-27746.313	0.360
9121	-111564.929	-27744.507	4.418
9118	-111562.934	-27740.267	4.686
5785	-111558.178	-27742.382	5.205
5786	-111553.240	-27744.609	5.417
5787	-111553.030	-27744.157	0.498
9116	-111551.603	-27744.836	1.580
5788	-111549.599	-27745.790	2.219
5811	-111546.344	-27747.314	3.594
面積	78.4224525		
地積	78.42㎡		

157

地番	松尾東六ノ四三		
N O	X	Y	辺長
9128	-111547.720	-27749.056	
5810	-111549.347	-27751.116	2.625
9129	-111549.730	-27750.944	0.420
9130	-111548.649	-27748.635	2.550
9128	-111547.720	-27749.056	1.020
面積	1.8344930		
地積	1.83㎡		

158			
地番	松尾東六ノ三三		
N O	X	Y	辺長
5805	-111556.962	-27760.831	
5745	-111562.521	-27767.868	8.968
5746	-111562.693	-27767.708	0.235
5747	-111566.996	-27764.727	5.235
5748	-111567.802	-27761.728	3.105
5780	-111565.650	-27756.911	5.276
5805	-111556.962	-27760.831	9.531
面積	66.1468620		
地積	66.14㎡		

159

地 番	松尾東六ノ三四		
N O	X	Y	辺 長
5807	-111552.887	-27755.658	
5806	-111554.450	-27757.656	2.537
5805	-111556.962	-27760.831	4.049
5780	-111565.650	-27756.911	9.531
5779	-111563.042	-27751.079	6.389
5807	-111552.887	-27755.658	11.140
面積	66.0697335		
地積	66.06 ㎡		

地番				松尾東六ノ四二	
N O		X	Y	辺長	
9131		-111552.739	-27755.469		
5807		-111552.887	-27755.658	0.240	
5779		-111563.042	-27751.079	11.140	
9136		-111562.948	-27750.869	0.230	
9131		-111552.739	-27755.469	11.197	
面積				2.5866385	
地積				2.58㎡	

161			
地番	松尾東六ノ三五		
N O	X	Y	辺長
5810	-111549.347	-27751.116	
5809	-111549.859	-27751.768	0.829
5808	-111552.130	-27754.688	3.699
9131	-111552.739	-27755.469	0.990
9136	-111562.948	-27750.869	11.197
5777	-111560.897	-27746.313	4.996
5778	-111560.744	-27745.987	0.360
9129	-111549.730	-27750.944	12.078
5810	-111549.347	-27751.116	0.420
面積	63.4996215		
地積	63.49 m ²		

162			
地番	松尾東六ノ二二		
N O	X	Y	辺長
9132	-111551.017	-27760.356	
5743	-111558.932	-27770.389	12.779
5744	-111562.505	-27767.883	4.364
5745	-111562.521	-27767.868	0.022
5805	-111556.962	-27760.831	8.968
5806	-111554.450	-27757.656	4.049
9132	-111551.017	-27760.356	4.368
面積	56.4261330		
地積	56.42 ㎡		

163

地番	松尾東六ノ二一			
N O	X	Y	辺長	
9117	-111548.134	-27762.623		
5742	-111555.882	-27772.528	12.575	
5743	-111558.932	-27770.389	3.725	
9132	-111551.017	-27760.356	12.779	
9117	-111548.134	-27762.623	3.668	
面積	46.8258330			
地積	46.82 m ²			

164			
地番	松尾東六ノ二三		
N O	X	Y	辺長
5761	-111545.823	-27764.437	
5741	-111553.473	-27774.218	12.417
5742	-111555.882	-27772.528	2.943
9117	-111548.134	-27762.623	12.575
5762	-111546.698	-27763.752	1.827
5761	-111545.823	-27764.437	1.111
面積	36.7160205		
地積	36.71 ㎡		

165			
地番	松尾東六ノ二〇		
N O	X	Y	辺長
5763	-111544.333	-27760.848	
5762	-111546.698	-27763.752	3.745
9117	-111548.134	-27762.623	1.827
9132	-111551.017	-27760.356	3.668
5806	-111554.450	-27757.656	4.368
5807	-111552.887	-27755.658	2.537
9131	-111552.739	-27755.469	0.240
5808	-111552.130	-27754.688	0.990
5763	-111544.333	-27760.848	9.937
面積	37.1803850		
地積	37.18 ㎡		

166			
地番	松尾東六ノ一九		
N O	X	Y	辺長
5764	-111542.010	-27757.908	
5763	-111544.333	-27760.848	3.747
5808	-111552.130	-27754.688	9.937
5809	-111549.859	-27751.768	3.699
5764	-111542.010	-27757.908	9.965
面積	37.0479400		
地積	37.04 m ²		


179

地 番	松尾東六ノ八		
N O	X	Y	辺 長
5711	-111522.578	-27775.298	
5710	-111522.651	-27776.925	1.629
5708	-111523.919	-27778.936	2.377
9134	-111526.918	-27776.629	3.784
9135	-111529.760	-27774.443	3.585
5720	-111532.721	-27772.166	3.735
5721	-111533.882	-27771.244	1.483
5722	-111531.587	-27768.208	3.806
5711	-111522.578	-27775.298	11.464
面 積	46.1752255		
地 積	46.17 m ²		

180

地 番	松尾東六ノ七		
N O	X	Y	辺 長
5723	-111527.059	-27762.433	
5734	-111526.184	-27763.217	1.175
5733	-111525.631	-27763.705	0.738
5732	-111524.157	-27765.322	2.188
5731	-111523.887	-27766.035	0.762
5713	-111522.730	-27769.184	3.355
5712	-111522.480	-27773.347	4.170
5711	-111522.578	-27775.298	1.953
5722	-111531.587	-27768.208	11.464
5723	-111527.059	-27762.433	7.338
面 積	59.0026895		
地 積	59.00 m ²		

図面の種類	画 地 面 積 求 積 表				
街区番号	46	番号	3 / 3		
町 名	松 尾 東 ノ 口 町				
京 都 市 洛 西 第 二 土 地 区 画 整 理 組 合					

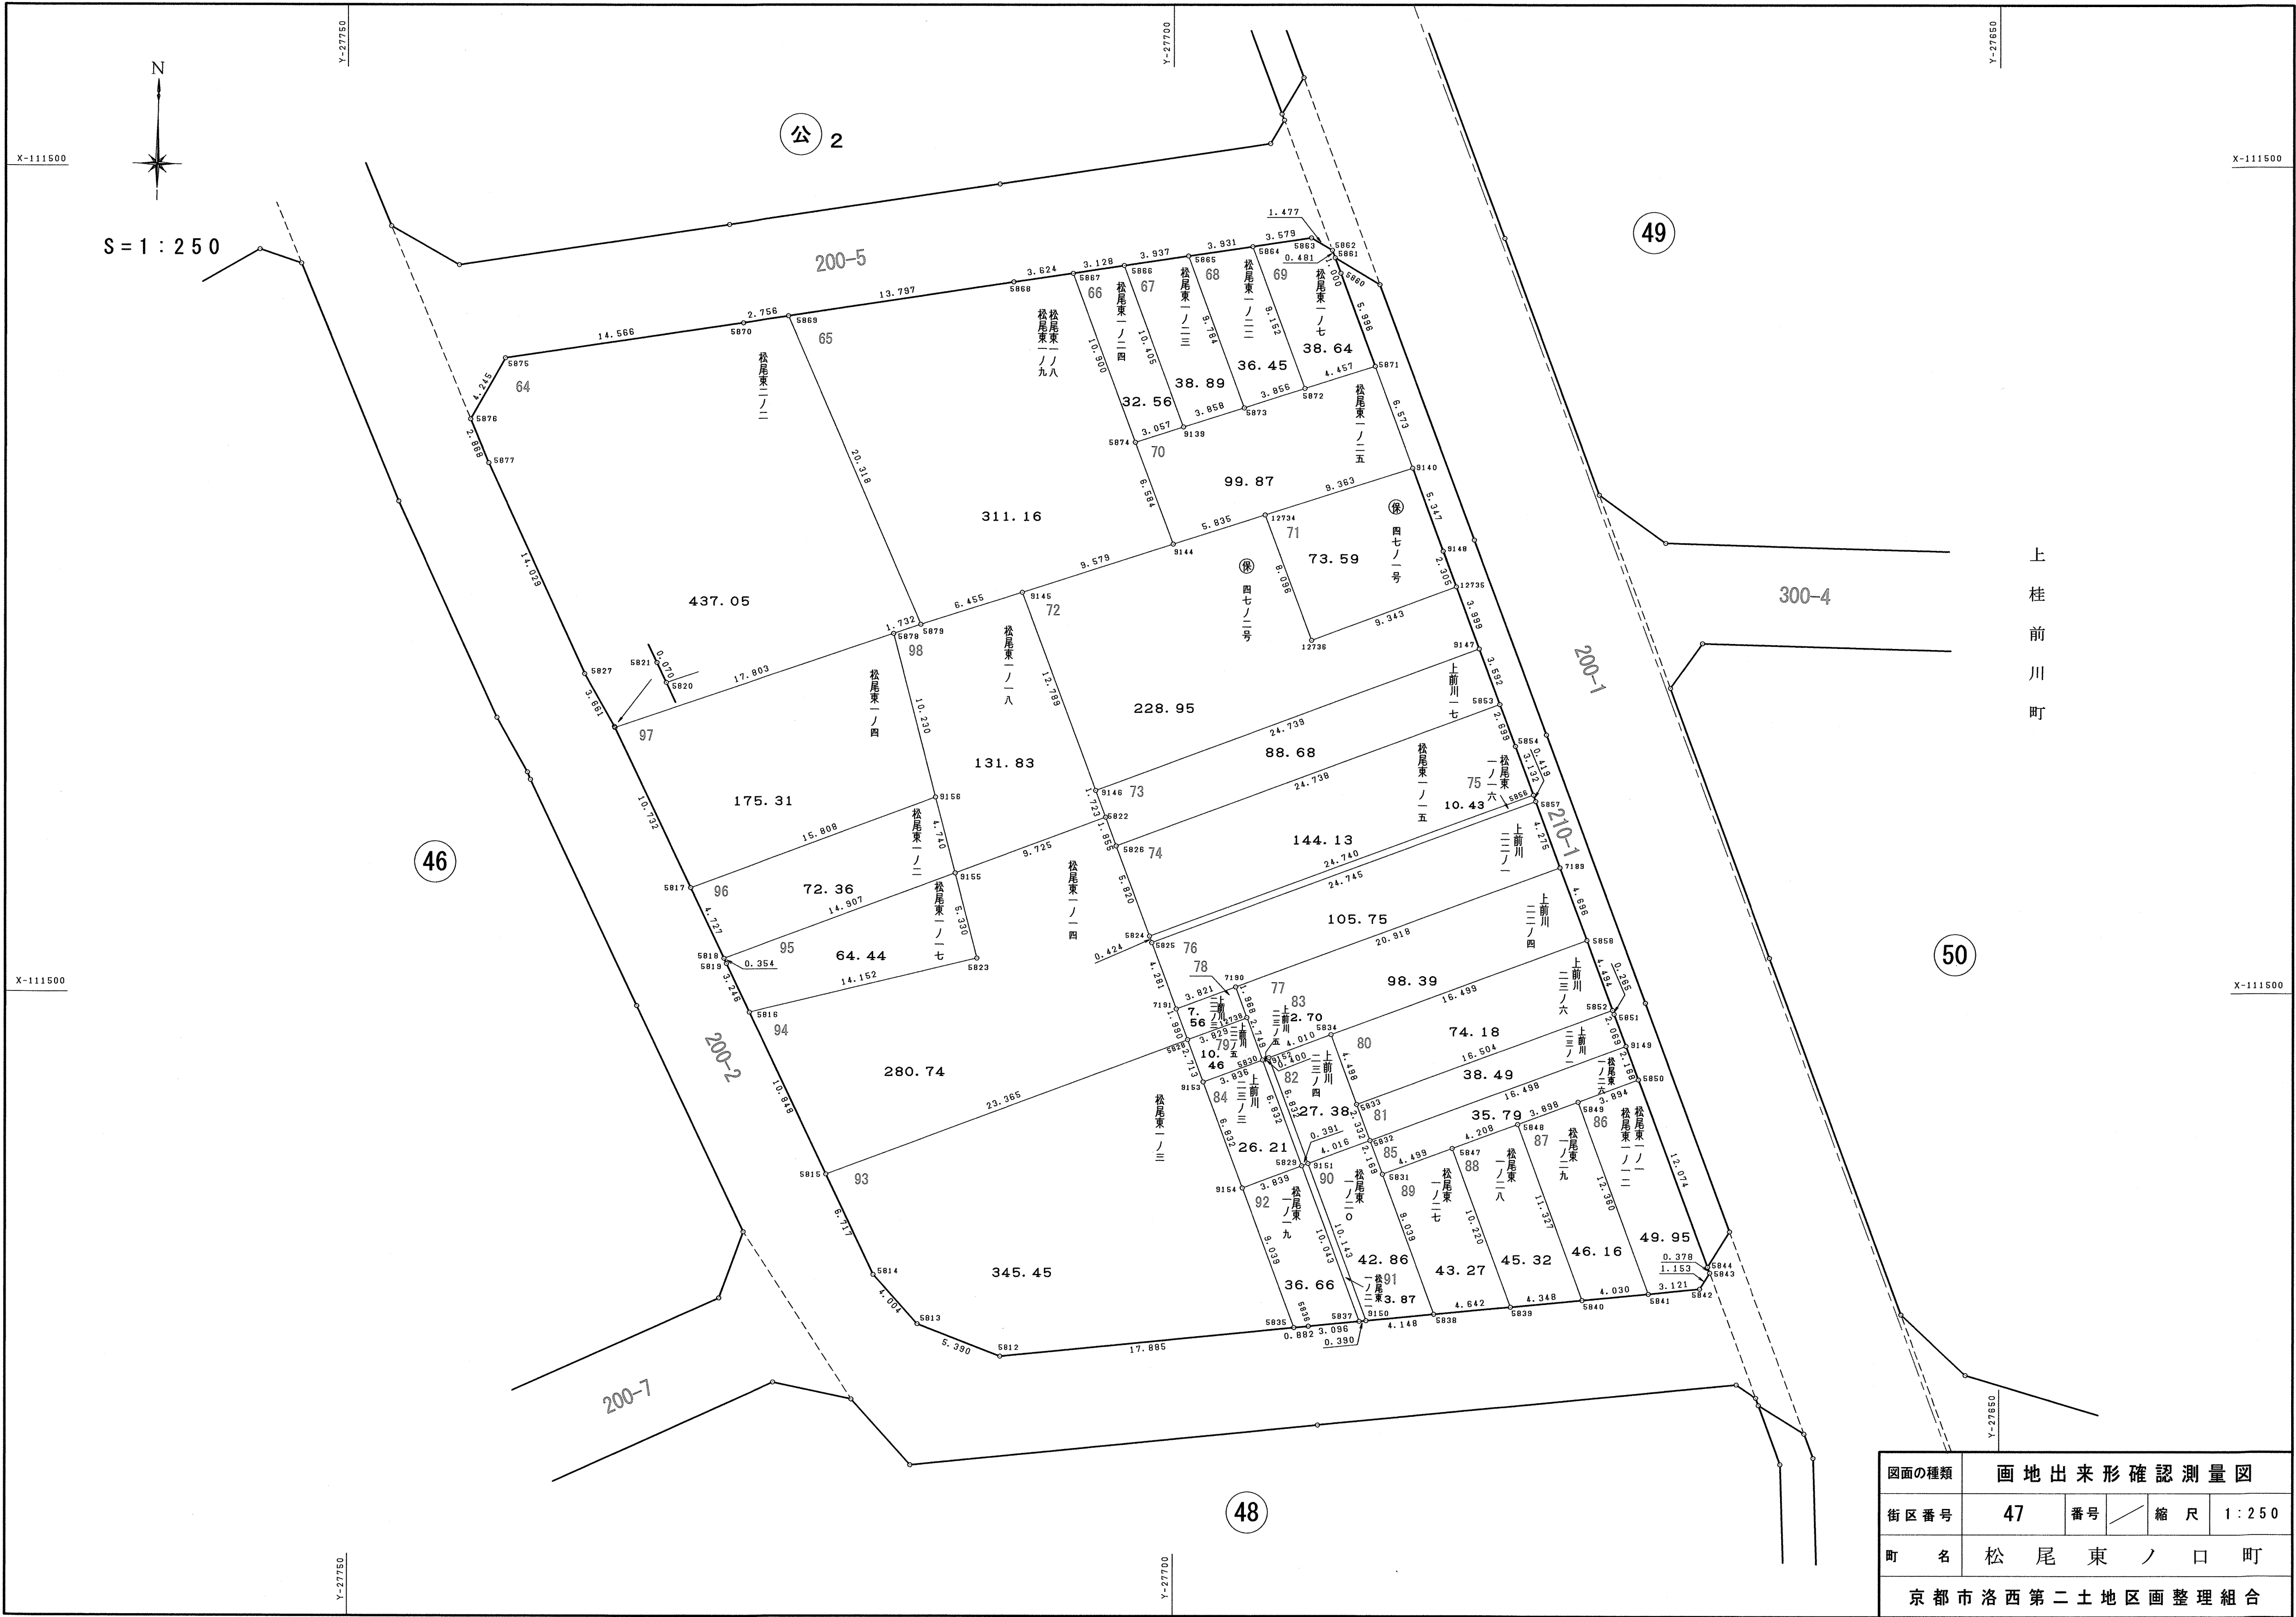

図面の種類	画地出来形確認測量図				
街区番号	47	番号		縮尺	1:250
町名	松尾東ノ口町				
京都市洛西第二土地区画整理組合					

64			
地番	松尾東二ノ二		
N O	X	Y	辺長
5869	-111509.043	-27723.343	
5870	-111509.452	-27726.068	2.756
5875	-111511.606	-27740.474	14.566
5876	-111515.298	-27742.570	4.245
5877	-111517.948	-27741.472	2.868
5827	-111530.710	-27735.647	14.029
5821	-111533.897	-27733.846	3.661
5820	-111533.960	-27733.816	0.070
5878	-111528.256	-27716.951	17.803
5879	-111527.705	-27715.309	1.732
5869	-111509.043	-27723.343	20.318
面積	437.0530190		
地積	437.05 ㎡		

65

地番	松尾東一ノ八, 松尾東一ノ九		
N O	X	Y	辺長
5867	-111506.461	-27706.114	
5868	-111506.993	-27709.699	3.624
5869	-111509.043	-27723.343	13.797
5879	-111527.705	-27715.309	20.318
9145	-111525.770	-27709.151	6.455
9144	-111522.851	-27700.028	9.579
5874	-111516.686	-27702.339	6.584
5867	-111506.461	-27706.114	10.900
面積	311.1620795		
地積	311.16 m ²		

66

地番	松尾東一ノ二四		
N O	X	Y	辺長
5866	-111506.002	-27703.020	
5867	-111506.461	-27706.114	3.128
5874	-111516.686	-27702.339	10.900
9139	-111515.766	-27699.424	3.057
5866	-111506.002	-27703.020	10.405
面積	32.5696275		
地積	32.56 m ²		

67

地番	松尾東一ノ二三		
N O	X	Y	辺長
5865	-111505.425	-27699.126	
5866	-111506.002	-27703.020	3.937
9139	-111515.766	-27699.424	10.405
5873	-111514.606	-27695.745	3.858
5865	-111505.425	-27699.126	9.784
面積	38.8973835		
地積	38.89 m ²		

68

地番	松尾東一ノ二二		
N O	X	Y	辺長
5864	-111504.848	-27695.238	
5865	-111505.425	-27699.126	3.931
5873	-111514.606	-27695.745	9.784
5872	-111513.435	-27692.071	3.856
5864	-111504.848	-27695.238	9.152
面積	36.4518800		
地積	36.45 m ²		

69

地番	松尾東一ノ七		
N O	X	Y	辺長
5862	-111505.078	-27690.428	
5863	-111504.323	-27691.698	1.477
5864	-111504.848	-27695.238	3.579
5872	-111513.435	-27692.071	9.152
5871	-111512.087	-27687.823	4.457
5860	-111506.463	-27689.902	5.996
5861	-111505.526	-27690.252	1.000
5862	-111505.078	-27690.428	0.481
面積	38.6436015		
地積	38.64 ㎡		

70

地番	松尾東一ノ二五		
N O	X	Y	辺長
5871	-111512.087	-27687.823	
5872	-111513.435	-27692.071	4.457
5873	-111514.606	-27695.745	3.856
9139	-111515.766	-27699.424	3.858
5874	-111516.686	-27702.339	3.057
9144	-111522.851	-27700.028	6.584
12734	-111521.082	-27694.468	5.835
9140	-111518.252	-27685.543	9.363
5871	-111512.087	-27687.823	6.573
面積	99.8721295		
地積	99.87 m ²		

71

地番	保 四七ノ一号		
N O	X	Y	辺 長
9140	-111518.252	-27685.543	
12734	-111521.082	-27694.468	9.363
12736	-111528.671	-27691.649	8.096
12735	-111525.428	-27682.887	9.343
9148	-111523.267	-27683.689	2.305
9140	-111518.252	-27685.543	5.347
面積	73.5917895		
地積	73.59 m ²		

72

地番	保 四七ノ二号		
N O	X	Y	辺 長
12734	-111521.082	-27694.468	
9144	-111522.851	-27700.028	5.835
9145	-111525.770	-27709.151	9.579
9146	-111537.760	-27704.702	12.789
9147	-111529.178	-27681.499	24.739
12735	-111525.428	-27682.887	3.999
12736	-111528.671	-27691.649	9.343
12734	-111521.082	-27694.468	8.096
面積	228.9541240		
地積	228.95 m ²		

73

地番	上前川一七		
N O	X	Y	辺長
9147	-111529.178	-27681.499	
9146	-111537.760	-27704.702	24.739
5822	-111539.375	-27704.101	1.723
5826	-111541.115	-27703.458	1.855
5853	-111532.546	-27680.251	24.738
9147	-111529.178	-27681.499	3.592
面積	88.6850330		
地積	88.68 m ²		

74

地番	松尾東一ノ一五		
N O	X	Y	辺長
5853	-111532.546	-27680.251	
5826	-111541.115	-27703.458	24.738
5824	-111546.574	-27701.439	5.820
5856	-111538.015	-27678.227	24.740
5854	-111535.077	-27679.313	3.132
5853	-111532.546	-27680.251	2.699
面積	144.1324230		
地積	144.13 m ²		

75

地番	松尾東一ノ一六		
N O	X	Y	辺長
5856	-111538.015	-27678.227	
5824	-111546.574	-27701.439	24.740
5825	-111546.974	-27701.297	0.424
5857	-111538.408	-27678.082	24.745
5858	-111538.015	-27678.227	0.419
面積	10.4328715		
地積	10.43 ㎡		

76				
地番	上前川二二ノ一			
N O	X	Y	辺長	
5857	-111538.408	-27678.082		
5825	-111546.974	-27701.297	24.745	
7191	-111550.987	-27699.807	4.281	
7190	-111549.657	-27696.225	3.821	
7189	-111542.418	-27676.600	20.918	
5857	-111538.408	-27678.082	4.275	
面積	105.7566555			
地積	105.75 m ²			

77

地番	上前川二二ノ四		
N O	X	Y	辺長
7190	-111549.657	-27696.225	
2738	-111551.503	-27695.542	1.968
5830	-111554.079	-27694.581	2.749
9152	-111553.940	-27694.206	0.400
5834	-111552.544	-27690.447	4.010
5858	-111546.823	-27674.972	16.499
7189	-111542.418	-27676.600	4.696
7190	-111549.657	-27696.225	20.918
面積	98.3925825		
地積	98.39㎡		

78				
地番	上前川二二ノ三			
N O	X	Y	辺長	
7191	-111550.987	-27699.807		
5828	-111552.856	-27699.124	1.990	
2738	-111551.503	-27695.542	3.829	
7190	-111549.657	-27696.225	1.968	
7191	-111550.987	-27699.807	3.821	
面積			7.5698095	
地積			7.56 m ²	

79

地番	上前川二二ノ五		
N O	X	Y	辺長
5828	-111552.856	-27699.124	
9153	-111555.400	-27698.182	2.713
5830	-111554.079	-27694.581	3.836
12738	-111551.503	-27695.542	2.749
5828	-111552.856	-27699.124	3.829
面積	10.4663955		
地積	10.46㎡		

80

地番	上前川二三ノ六		
N O	X	Y	辺長
5858	-111546.823	-27674.972	
5834	-111552.544	-27690.447	16.499
5833	-111556.765	-27688.893	4.498
5852	-111551.038	-27673.414	16.504
5858	-111546.823	-27674.972	4.494
面積	74.1885300		
地積	74.18 m ²		

94

地番	松尾東一ノ一四		
N O	X	Y	辺長
5822	-111539.375	-27704.101	
9155	-111542.753	-27713.220	9.725
5823	-111547.915	-27711.892	5.330
5816	-111551.186	-27725.661	14.152
5815	-111560.994	-27721.026	10.848
5828	-111552.856	-27699.124	23.365
7191	-111550.987	-27699.807	1.990
5825	-111546.974	-27701.297	4.281
5824	-111546.574	-27701.439	0.424
5826	-111541.115	-27703.458	5.820
5822	-111539.375	-27704.101	1.855
面積	280.7437835		
地積	280.74㎡		

95

地番	松尾東一ノ一七		
N O	X	Y	辺長
9155	-111542.753	-27713.220	
5818	-111547.931	-27727.199	14.907
5819	-111548.251	-27727.048	0.354
5816	-111551.186	-27725.661	3.246
5823	-111547.915	-27711.892	14.152
9155	-111542.753	-27713.220	5.330
面積	64.4427650		
地積	64.44㎡		

96

地番	松尾東一ノ二		
N O	X	Y	辺長
9156	-111538.163	-27714.401	
5817	-111543.659	-27729.223	15.808
5818	-111547.931	-27727.199	4.727
9155	-111542.753	-27713.220	14.907
9156	-111538.163	-27714.401	4.740
面積	72.3611580		
地積	72.36㎡		


97

地番	松尾東一ノ四		
N O	X	Y	辺長
5878	-111528.256	-27716.951	
5820	-111533.960	-27733.816	17.803
5817	-111543.659	-27729.223	10.732
9156	-111538.163	-27714.401	15.808
5878	-111528.256	-27716.951	10.230
面積	175.3142305		
地積	175.31㎡		


98

地番	松尾東一ノ一八		
N O	X	Y	辺長
9145	-111525.770	-27709.151	
5879	-111527.705	-27715.309	6.455
5878	-111528.256	-27716.951	1.732
9156	-111538.163	-27714.401	10.230
9155	-111542.753	-27713.220	4.740
5822	-111539.375	-27704.101	9.725
9146	-111537.760	-27704.702	1.723
9145	-111525.770	-27709.151	12.789
面積	131.8326805		
地積	131.83㎡		

図面の種類	画 地 面 積 求 積 表			
街 区 番 号	47	番 号	2 / 2	
町 名	松 尾 東 ノ 口 町			
京 都 市 洛 西 第 二 土 地 区 画 整 理 組 合				

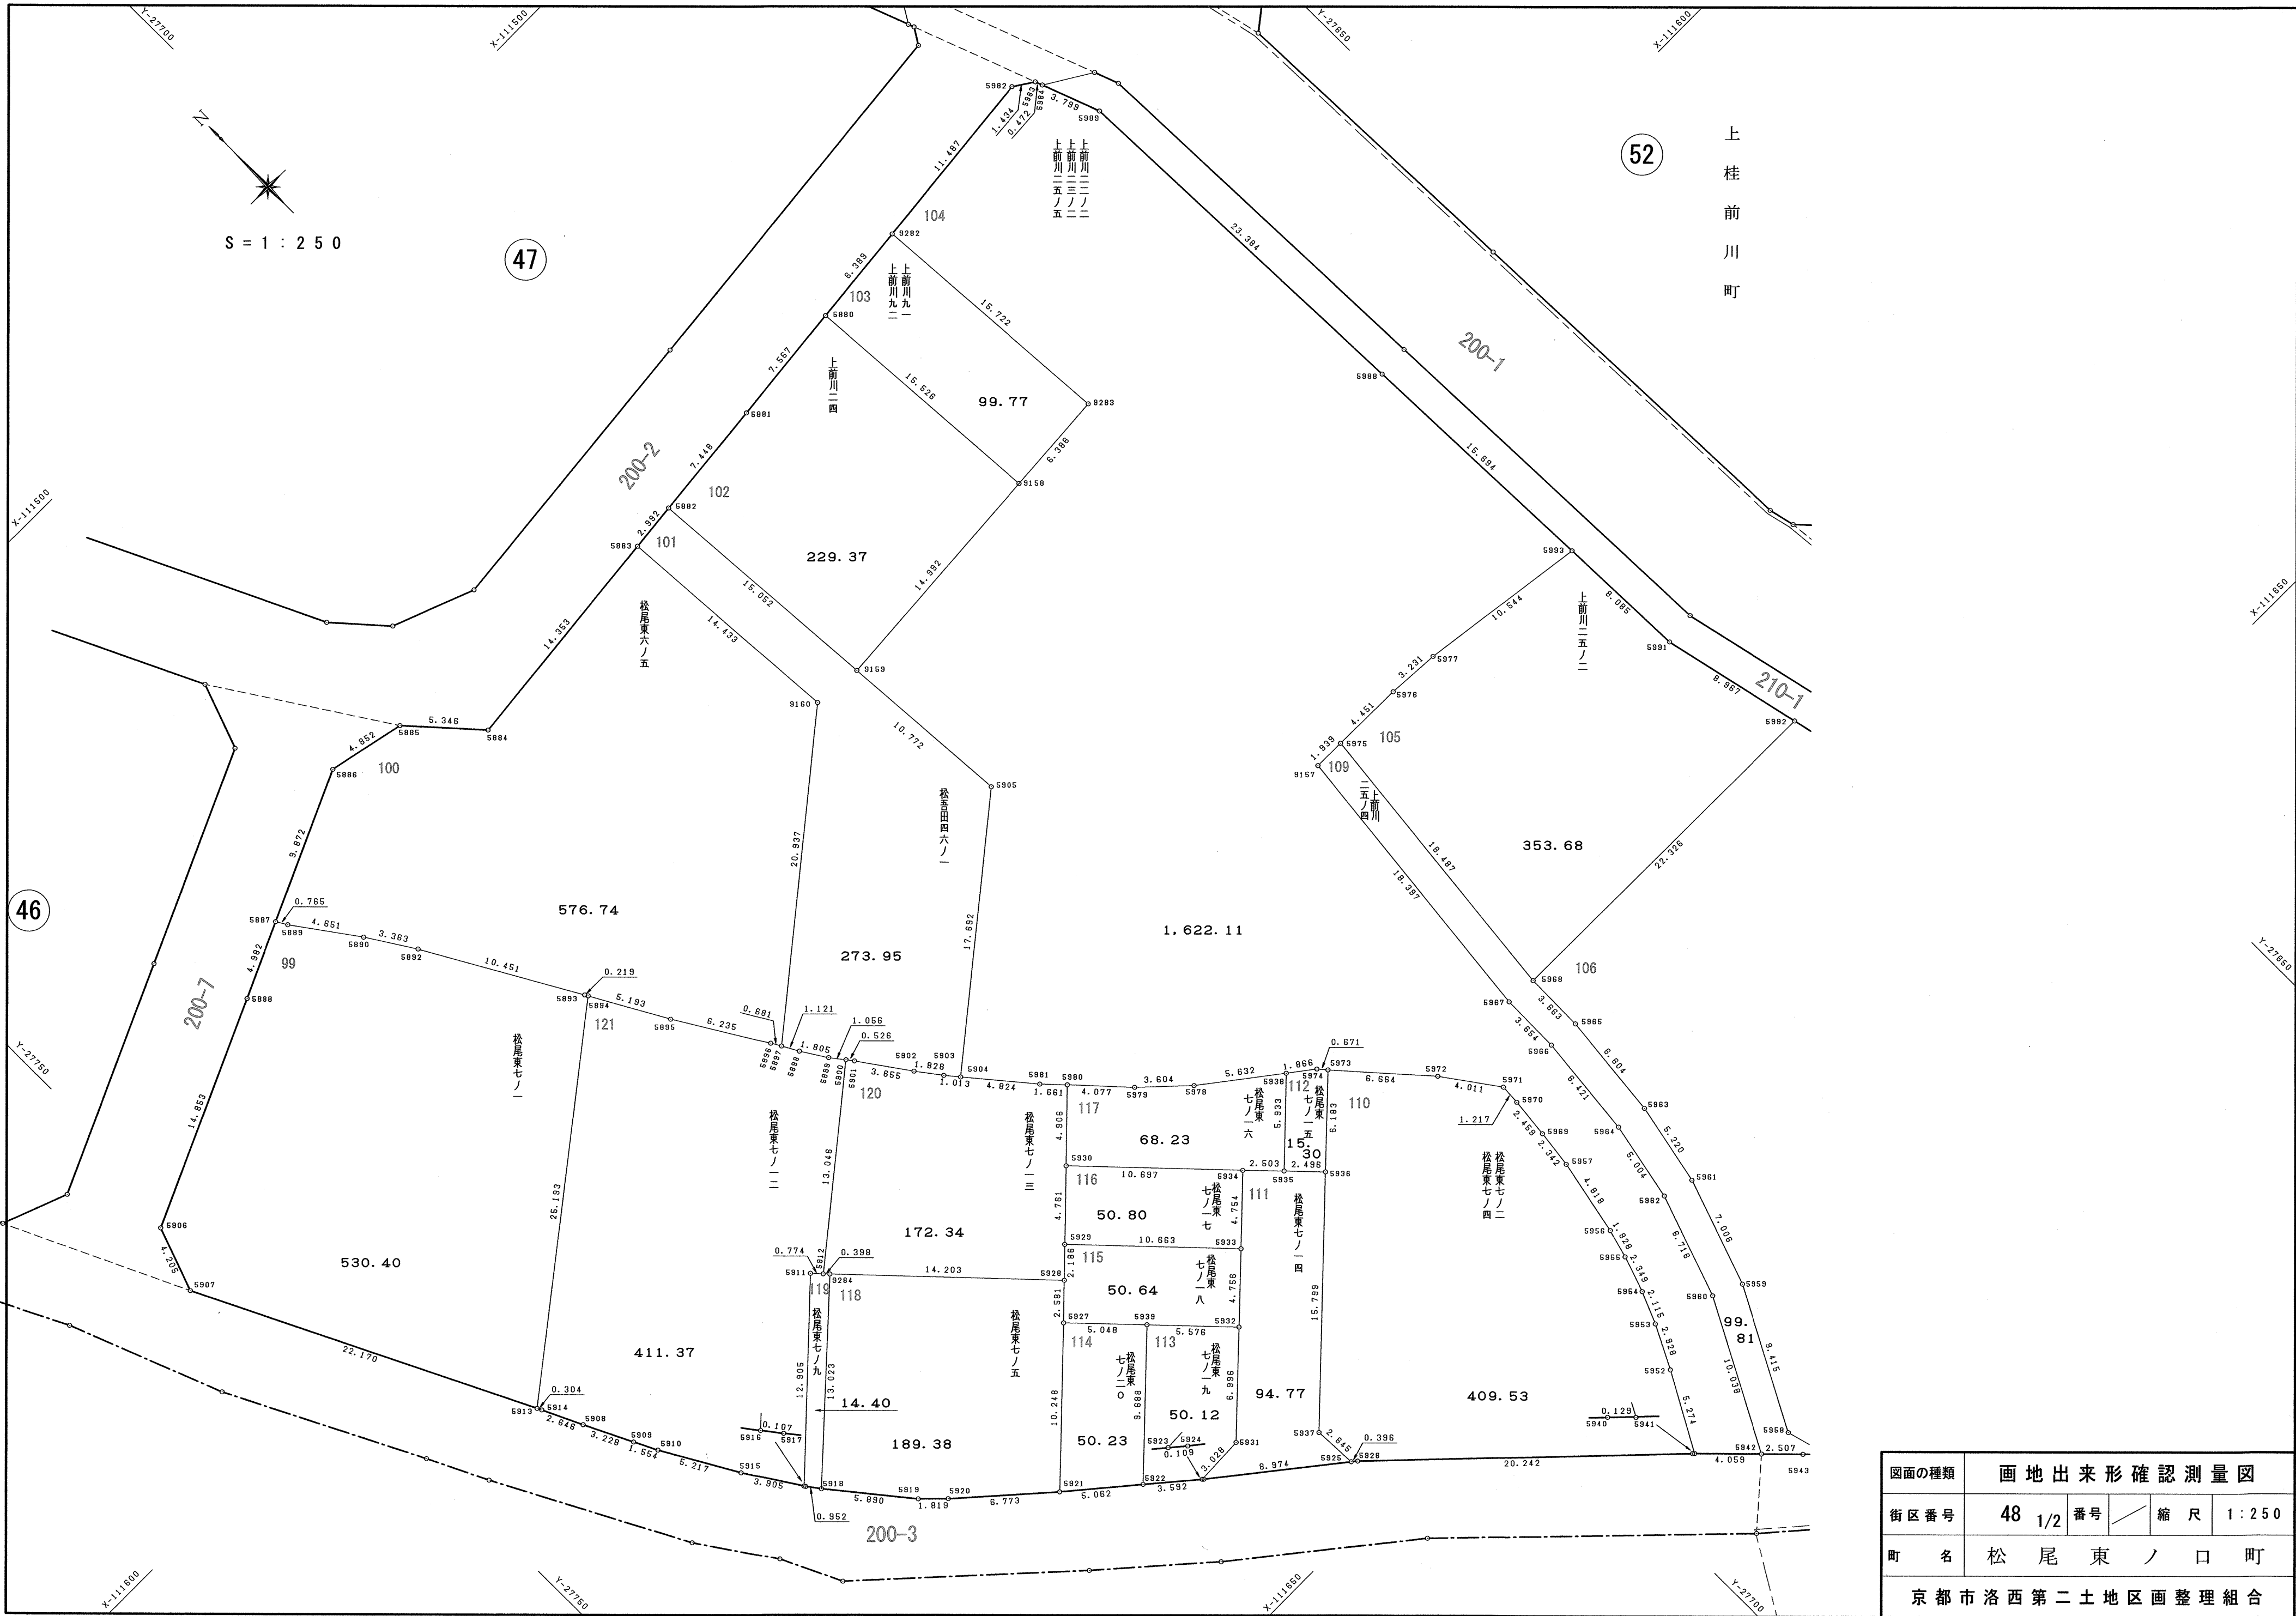

図面の種類	画地出来形確認測量図				
街区番号	48	1/2	番号	縮尺	1 : 250
町名	松尾東ノ口町				
京都市洛西第二土地区画整理組合					

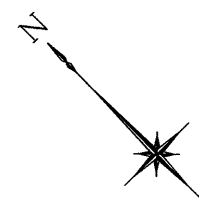


S = 1 : 2 5 0

上
桂
前
川
町

52

53

54

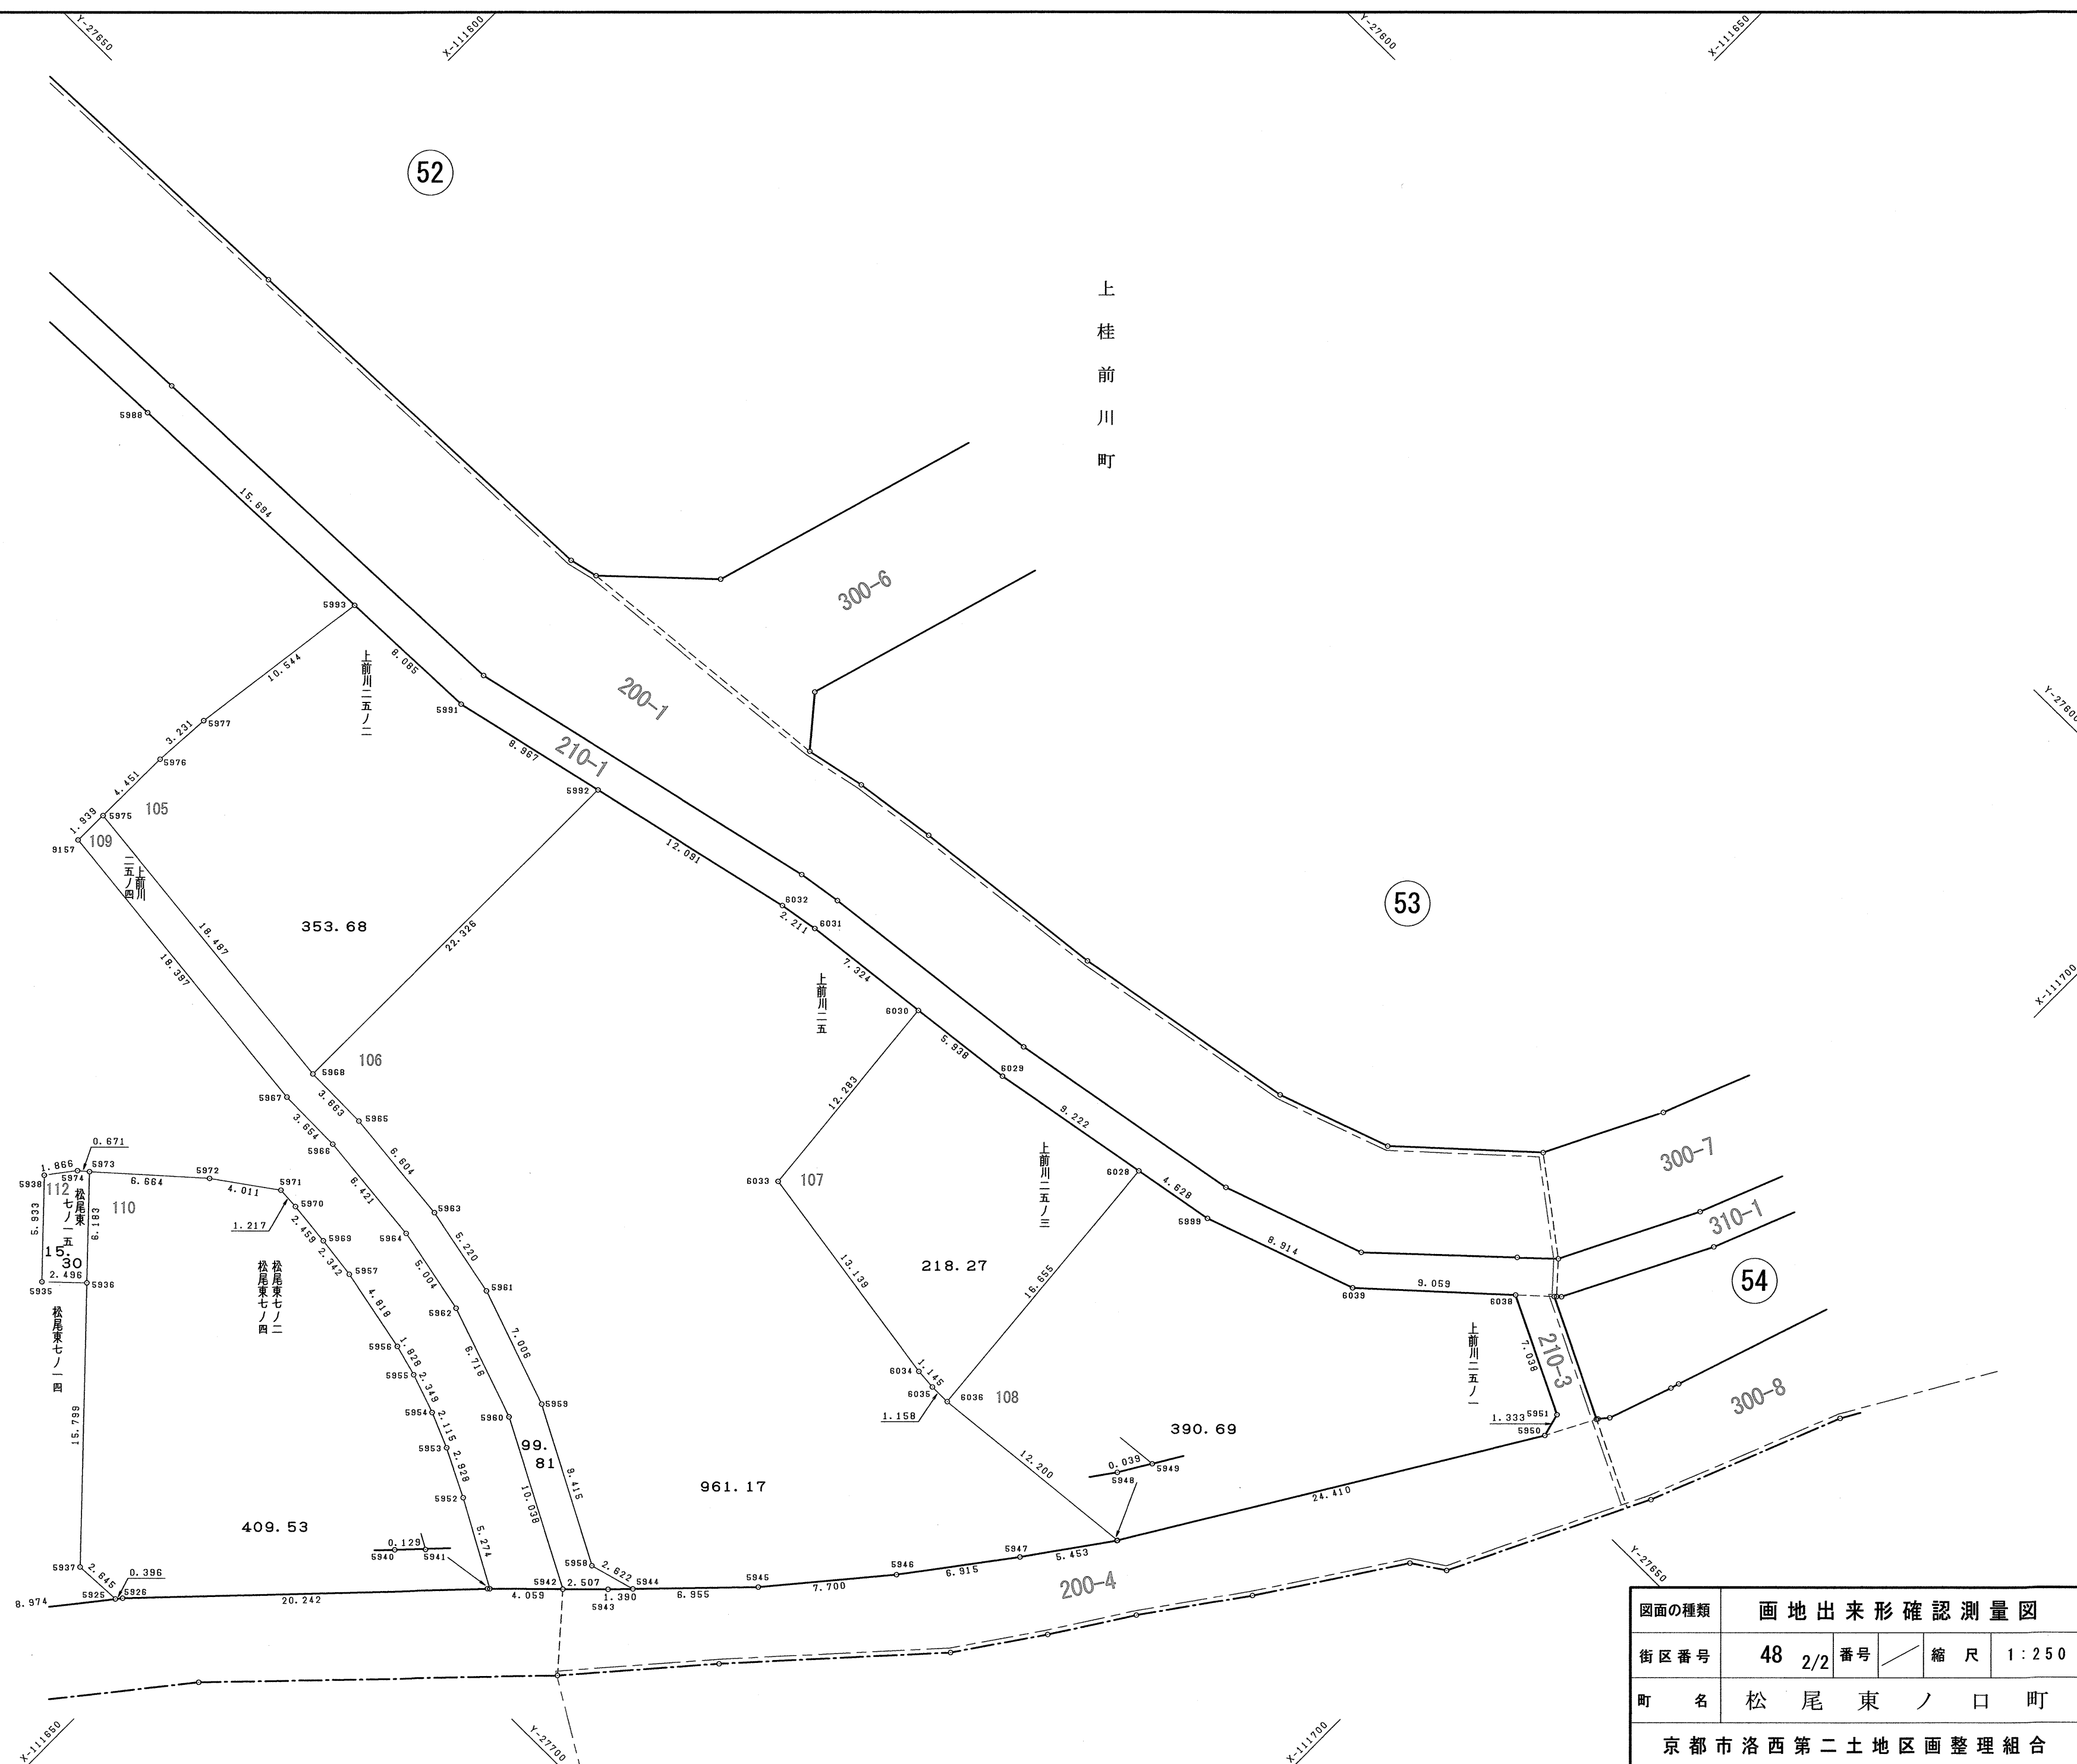

図面の種類	画地出来形確認測量図				
街区番号	48	2/2	番号	縮尺	1:250
町名	松尾東ノ口町				
京都市洛西第二土地区画整理組合					

99			
地番	松尾東七ノ一		
N O	X	Y	辺長
5887	-111577.644	-27733.225	
5888	-111579.688	-27737.768	4.982
5906	-111585.759	-27751.324	14.853
5907	-111589.712	-27752.758	4.205
5913	-111609.638	-27743.038	22.170
5894	-111594.232	-27723.105	25.193
5893	-111594.041	-27723.213	0.219
5892	-111584.929	-27728.332	10.451
5890	-111582.088	-27730.132	3.363
5889	-111578.298	-27732.828	4.651
5897	-111577.644	-27733.225	0.765
面積	530.4086720		
地積	530.40㎡		

100			
地番	松尾東六ノ五		
N O	X	Y	辺長
5883	-111577.191	-27701.632	
5884	-111578.599	-27715.916	14.353
5885	-111574.614	-27719.479	5.346
5886	-111573.593	-27724.222	4.852
5887	-111577.644	-27733.225	9.872
5889	-111578.298	-27732.828	0.765
5890	-111582.088	-27730.132	4.651
5892	-111584.929	-27728.332	3.363
5893	-111594.041	-27723.213	10.451
5894	-111594.232	-27723.105	0.219
5895	-111598.774	-27720.588	5.193
5896	-111604.114	-27717.369	6.235
5897	-111604.704	-27717.029	0.681
9160	-111591.594	-27700.705	20.937
5883	-111577.191	-27701.632	14.433
面積	576.7409520		
地積	576.74㎡		

101			
地番	松吾田四六ノ一		
N O	X	Y	辺長
5883	-111577.191	-27701.632	
9160	-111591.594	-27700.705	14.433
5897	-111604.704	-27717.029	20.937
5898	-111605.691	-27716.497	1.121
5899	-111607.218	-27715.535	1.805
5900	-111608.058	-27714.893	1.056
5901	-111608.473	-27714.572	0.526
5902	-111611.474	-27712.485	3.655
5903	-111612.936	-27711.388	1.828
5904	-111613.724	-27710.752	1.013
5905	-111602.665	-27696.943	17.692
9159	-111591.917	-27697.657	10.772
5882	-111576.898	-27698.654	15.052
5883	-111577.191	-27701.632	2.992
面積	273.9584665		
地積	273.95㎡		

102			
地番	上前川二四		
N O	X	Y	辺長
5882	-111576.898	-27698.654	
9159	-111591.917	-27697.657	15.052
9158	-111590.929	-27682.698	14.992
5880	-111575.436	-27683.710	15.526
5881	-111576.167	-27691.242	7.567
5882	-111576.898	-27698.654	7.448
面積	229.3744565		
地積	229.37㎡		

103			
地番	上前川九一，上前川九二		
N O	X	Y	辺長
5880	-111575.436	-27683.710	
9158	-111590.929	-27682.698	15.526
9283	-111590.508	-27676.326	6.386
9282	-111574.819	-27677.351	15.722
5880	-111575.436	-27683.710	6.389
面積	99.7731120		
地積	99.77㎡		

104			
地番	上前川二二ノ二，二三ノ二，二五ノ五		
N O	X	Y	辺長
9282	-111574.819	-27677.351	
9283	-111590.508	-27676.326	15.722
9158	-111590.929	-27682.698	6.386
9159	-111591.917	-27697.657	14.992
5905	-111602.665	-27696.943	10.772
5904	-111613.724	-27710.752	17.692
5981	-111617.439	-27707.674	4.824
5980	-111618.653	-27706.540	1.661
5979	-111621.658	-27703.785	4.077
5978	-111624.145	-27701.177	3.604
5938	-111627.588	-27696.720	5.632
5974	-111628.729	-27695.243	1.866
5973	-111629.242	-27694.811	0.671
5972	-111634.239	-27690.402	6.664
5971	-111637.509	-27688.079	4.011
5970	-111638.723	-27688.165	1.217
5969	-111641.168	-27688.426	2.459
5957	-111643.490	-27688.729	2.342
5956	-111648.207	-27689.711	4.818
5955	-111649.968	-27690.202	1.828
5954	-111652.185	-27690.977	2.349
5953	-111654.128	-27691.813	2.115
5952	-111656.736	-27693.143	2.928
5941	-111661.342	-27695.712	5.274
5942	-111664.245	-27692.875	4.059
5960	-111655.387	-27688.153	10.038
5962	-111649.052	-27685.922	6.716
5964	-111644.152	-27684.907	5.004

5966	-111637.766	-27684.233	6.421
5967	-111634.113	-27684.167	3.654
9157	-111615.828	-27682.142	18.397
5975	-111615.853	-27680.203	1.939
5976	-111615.911	-27675.752	4.451
5977	-111616.118	-27672.528	3.231
5993	-111617.570	-27662.084	10.544
5988	-111601.883	-27662.542	15.694
5989	-111578.510	-27663.245	23.384
5984	-111574.943	-27664.553	3.799
5983	-111574.502	-27664.722	0.472
5882	-111573.710	-27665.918	1.434
9282	-111574.819	-27677.351	11.487
面積	1622.1187360		
地積	1622.11㎡		

105			
地番	上前川二五ノ二		
N O	X	Y	辺長
5975	-111615.853	-27680.203	
5968	-111634.228	-27682.231	18.487
5992	-111634.406	-27659.906	22.326
5991	-111625.652	-27661.848	8.967
5993	-111617.570	-27662.084	8.085
5977	-111616.118	-27672.528	10.544
5976	-111615.911	-27675.752	3.231
5975	-111615.853	-27680.203	4.451
面積	353.6881110		
地積	353.68㎡		

106			
地番	上前川二五		
N O	X	Y	辺長
5968	-111634.228	-27682.231	
5965	-111637.890	-27682.297	3.663
5963	-111644.457	-27682.992	6.604
5961	-111649.568	-27684.054	5.220
5959	-111656.174	-27686.386	7.006
5958	-111664.481	-27690.817	9.415
5944	-111667.012	-27690.131	2.622
5945	-111671.886	-27685.169	6.955
5946	-111676.862	-27679.293	7.700
5947	-111681.053	-27673.793	6.915
5948	-111684.229	-27669.360	5.453
5949	-111684.249	-27669.327	0.039
6036	-111672.103	-27670.476	12.200
6035	-111670.945	-27670.477	1.158
6034	-111669.804	-27670.385	1.145
6033	-111656.824	-27668.350	13.139
6030	-111655.671	-27656.121	12.283
6031	-111648.392	-27656.932	7.324
6032	-111646.210	-27657.288	2.211
5992	-111634.406	-27659.906	12.091
5968	-111634.228	-27682.231	22.326
面積	961.1775770		
地積	961.17㎡		

107			
地番	上前川二五ノ三		
N O	X	Y	辺長
6033	-111656.824	-27668.350	
6034	-111669.804	-27670.385	13.139
6035	-111670.945	-27670.477	1.145
6036	-111672.103	-27670.476	1.158
6028	-111670.658	-27653.884	16.655
6029	-111661.572	-27655.463	9.222
6030	-111655.671	-27656.121	5.938
6033	-111656.824	-27668.350	12.283
面積	218.2791265		
地積	218.27㎡		

108			
地番	上前川二五ノ一		
N O	X	Y	辺長
6036	-111672.103	-27670.476	
5949	-111684.249	-27669.327	12.200
5950	-111696.896	-27648.510	24.410
5951	-111696.666	-27647.218	1.333
6038	-111690.358	-27644.096	7.038
6039	-111683.641	-27650.174	9.059
5999	-111675.218	-27653.091	8.914
6028	-111670.658	-27653.884	4.628
6036	-111672.103	-27670.476	16.655
面積	390.6990200		
地積	390.69㎡		

109			
地番	上前川二五ノ四		
N O	X	Y	辺長
9157	-111615.828	-27682.142	
5967	-111634.113	-27684.167	18.397
5966	-111637.766	-27684.233	3.654
5964	-111644.152	-27684.907	6.421
5962	-111649.052	-27685.922	5.004
5960	-111655.387	-27688.153	6.716
5942	-111664.245	-27692.875	10.038
5943	-111666.038	-27691.123	2.507
5944	-111667.012	-27690.131	1.390
5958	-111664.481	-27690.817	2.622
5959	-111656.174	-27686.386	9.415
5961	-111649.568	-27684.054	7.006
5963	-111644.457	-27682.992	5.220
5965	-111637.890	-27682.297	6.604
5968	-111634.228	-27682.231	3.663
5975	-111615.853	-27680.203	18.487
9157	-111615.828	-27682.142	1.939
面積	99.8175675		
地積	99.81㎡		

110			
地番	松尾東七ノ二，松尾東七ノ四		
N O	X	Y	辺長
5973	-111629.242	-27694.811	
5936	-111633.480	-27699.313	6.183
5937	-111644.321	-27710.806	15.799
5925	-111646.964	-27710.693	2.645
5926	-111647.211	-27710.384	0.396
5940	-111661.250	-27695.802	20.242
5941	-111661.342	-27695.712	0.129
5952	-111656.736	-27693.143	5.274
5953	-111654.128	-27691.813	2.928
5954	-111652.185	-27690.977	2.115
5955	-111649.968	-27690.202	2.349
5956	-111648.207	-27689.711	1.828
5957	-111643.490	-27688.729	4.818
5969	-111641.168	-27688.426	2.342
5970	-111638.723	-27688.165	2.459
5971	-111637.509	-27688.079	1.217
5972	-111634.239	-27690.402	4.011
5973	-111629.242	-27694.811	6.664
面積	409.5370965		
地積	409.53㎡		

地 番	松尾東七ノ一二		
N O	X	Y	辺 長
5894	-111594.232	-27723.105	
5913	-111609.638	-27743.038	25.193
5914	-111609.911	-27742.905	0.304
5908	-111612.310	-27741.788	2.646
5909	-111615.213	-27740.376	3.228
5910	-111616.609	-27739.694	1.554
5915	-111621.147	-27737.120	5.217
5916	-111624.444	-27735.028	3.905
5911	-111615.639	-27725.593	12.905
5912	-111616.213	-27725.074	0.774
5900	-111608.056	-27714.893	13.046
5899	-111607.218	-27715.535	1.056
5898	-111605.691	-27716.497	1.805
5897	-111604.704	-27717.029	1.121
5896	-111604.114	-27717.369	0.681
5895	-111598.774	-27720.588	6.235
5894	-111594.232	-27723.105	5.193
面 積	411.3786710		
地 積	411.37 m²		

図面の種類	画 地 面 積 求 積 表				
街区 番号	48	番号	2 / 2		
町 名	松 尾 東 ノ 口 町				
京 都 市 洛 西 第 二 土 地 区 画 整 理 組 合					