



図面の種類	画地出来形確認測量図				
街区番号	49	1/2	番号	縮尺	1：250
町名	上桂前川町				
京都市洛西第二土地区画整理組合					



S = 1 : 2 5 0

上 桂 今 井 町

公 1

310-2

300-11

X-111500

Y-27500
X-111500



55

X-111500

上 桂 北 ノ 口 町

300-3

56

51

X-111500

50

図面の種類	画 地 出 来 形 確 認 測 量 図					
街区 番号	49	2/2	番号		縮 尺	1 : 2 5 0
町 名	上 桂 前 川 町					
京 都 市 洛 西 第 二 土 地 区 画 整 理 組 合						

101			
地番	上前川一B		
N O	X	Y	辺長
6043	-111469.420	-27688.878	
6042	-111473.399	-27691.492	4.761
6041	-111491.838	-27684.639	19.671
6040	-111496.384	-27682.952	4.849
6049	-111496.843	-27666.929	16.030
6048	-111469.573	-27666.233	27.279
6047	-111469.458	-27668.185	1.955
6046	-111469.232	-27673.791	5.611
6045	-111469.163	-27679.416	5.625
6044	-111469.260	-27685.031	5.616
6043	-111469.420	-27688.878	3.850
面積	575.1844670		
地積	575.18㎡		

102			
地番	上前川二，上前川二ノ一		
N O	X	Y	辺長
6048	-111469.573	-27666.233	
6049	-111496.843	-27666.929	27.279
9174	-111497.073	-27659.282	7.650
7102	-111497.235	-27653.491	5.793
9173	-111497.373	-27648.347	5.146
6128	-111471.727	-27647.622	25.656
6129	-111471.129	-27651.429	3.854
6130	-111470.425	-27656.995	5.610
6131	-111469.854	-27662.580	5.614
6048	-111469.573	-27666.233	3.664
面積	495.7106970		
地積	495.71 m ²		

103			
地番	上前川四ノ二		
N O	X	Y	辺長
6128	-111471.727	-27647.622	
9173	-111497.373	-27648.347	25.656
9172	-111497.395	-27647.699	0.648
6055	-111497.639	-27639.743	7.960
6125	-111473.344	-27639.049	24.305
6126	-111473.056	-27640.369	1.351
6127	-111471.999	-27645.886	5.617
6128	-111471.727	-27647.622	1.757
面積	215.4700495		
地積	215.47 ㎡		

104

地番	上前川三B		
N O	X	Y	辺長
6125	-111473.344	-27639.049	
6055	-111497.639	-27639.743	24.305
9180	-111497.689	-27638.084	1.660
6056	-111497.741	-27636.361	1.724
9164	-111497.829	-27633.311	3.051
9163	-111476.128	-27627.560	22.450
6121	-111475.607	-27629.423	1.934
6124	-111474.256	-27634.877	5.619
6125	-111473.344	-27639.049	4.271
面積	211.6028700		
地積	211.60 ㎡		

105			
地番	保 四九ノ一号		
N O	X	Y	辺 長
9163	-111476.128	-27627.560	
9164	-111497.829	-27633.311	22.450
9165	-111500.411	-27624.633	9.054
9166	-111500.913	-27622.957	1.750
9161	-111479.352	-27616.518	22.502
9162	-111477.122	-27624.008	7.815
9163	-111476.128	-27627.560	3.688
面積	250.855560		
地積	250.85 ㎡		

106

地番	上前川九A		
N O	X	Y	辺長
9161	-111479.352	-27616.518	
9166	-111500.913	-27622.957	22.502
6123	-111503.170	-27615.339	7.945
6122	-111504.043	-27612.437	3.030
6119	-111482.482	-27606.013	22.498
6120	-111481.586	-27609.018	3.136
9161	-111479.352	-27616.518	7.826
面積	246.7436725		
地積	246.74 ㎡		

107

地 番	上前川五 A		
N O	X	Y	辺 長
6119	-111482.482	-27606.013	
6122	-111504.043	-27612.437	22.498
9169	-111507.462	-27600.957	11.978
9168	-111485.904	-27594.531	22.495
6118	-111485.504	-27595.876	1.403
6119	-111482.482	-27606.013	10.578
面積	269.4964370		
地積	269.49 m ²		

108

地番	保 四九ノ三号		
N O	X	Y	辺 長
9168	-111485.904	-27594.531	
9169	-111507.462	-27600.957	22.495
9170	-111510.651	-27590.292	11.132
9171	-111510.891	-27589.469	0.857
9167	-111489.324	-27583.041	22.505
9168	-111485.904	-27594.531	11.988
面積	269.7732975		
地積	269.77 m ²		

109

地番	上前川八A		
N O	X	Y	辺長
9167	-111489.324	-27583.041	
9171	-111510.891	-27589.469	22.505
6063	-111513.431	-27580.968	8.872
6064	-111514.027	-27578.939	2.115
6102	-111492.458	-27572.513	22.506
6103	-111491.188	-27576.778	4.450
9167	-111489.324	-27583.041	6.534
面積	247.2836740		
地積	247.28㎡		

110

地番	上前川七ノ六		
N O	X	Y	辺長
6102	-111492.458	-27572.513	
6064	-111514.027	-27578.939	22.506
9179	-111515.330	-27574.603	4.528
9178	-111493.752	-27568.169	22.517
6102	-111492.458	-27572.513	4.533
面積	101.9783450		
地積	101.97 ㎡		

111

地番	保三五Bノ二号		
N O	X	Y	辺長
9178	-111493.752	-27568.169	
9179	-111515.330	-27574.603	22.517
6072	-111515.416	-27574.318	0.298
6071	-111515.891	-27572.719	1.668
6101	-111494.312	-27566.287	22.517
9178	-111493.752	-27568.169	1.964
面積	44.2390815		
地積	44.23 ㎡		

112

地番	保 三五Bノ一号		
N O	X	Y	辺 長
6101	-111494.312	-27566.287	
6071	-111515.891	-27572.719	22.517
6104	-111517.744	-27566.489	6.500
6100	-111496.167	-27560.057	22.515
6101	-111494.312	-27566.287	6.500
面積	146.3558680		
地積	146.35 ㎡		

113

地番	上前川五五A		
N O	X	Y	辺長
6100	-111496.167	-27560.057	
6104	-111517.744	-27566.489	22.515
6105	-111518.383	-27564.325	2.256
9182	-111519.594	-27560.264	4.238
6106	-111520.874	-27555.974	4.477
6098	-111499.297	-27549.547	22.514
6099	-111496.891	-27557.626	8.430
6100	-111496.167	-27560.057	2.537
面積	246.9238800		
地積	246.92㎡		

114

地番	上前川五四A		
N O	X	Y	辺長
6098	-111499.297	-27549.547	
6106	-111520.874	-27555.974	22.514
6112	-111527.221	-27534.655	22.244
6096	-111505.642	-27528.239	22.513
6097	-111502.602	-27538.453	10.657
6098	-111499.297	-27549.547	11.576
面積	500.6377870		
地積	500.63 m ²		

115			
地番	上前川五六		
N O	X	Y	辺長
6096	-111505.642	-27528.239	
6112	-111527.221	-27534.655	22.513
6107	-111536.591	-27537.444	9.776
6108	-111536.255	-27535.914	1.566
6109	-111540.062	-27528.653	8.198
6110	-111543.676	-27522.429	7.197
6111	-111545.479	-27518.572	4.258
6094	-111511.537	-27508.442	35.421
6095	-111508.308	-27519.281	11.310
6096	-111505.642	-27528.239	9.346
面積	689.6678065		
地積	689.66 m ²		

128

地番	上前川五一ノ二		
N O	X	Y	辺 長
6063	-111513.431	-27580.968	
6065	-111534.976	-27587.399	22.484
6066	-111536.960	-27580.742	6.946
6072	-111515.416	-27574.318	22.481
9179	-111515.330	-27574.603	0.298
6064	-111514.027	-27578.939	4.528
6063	-111513.431	-27580.968	2.115
面積	156.1345575		
地積	156.13㎡		

129

地番	上前川八B		
N O	X	Y	辺 長
9170	-111510.651	-27590.292	
6061	-111532.200	-27596.713	22.485
6062	-111532.924	-27594.285	2.534
6065	-111534.976	-27587.399	7.185
6063	-111513.431	-27580.968	22.484
9171	-111510.891	-27589.469	8.872
9170	-111510.651	-27590.292	0.857
面積	218.6746150		
地積	218.67㎡		

130

地番	上前川九B		
N O	X	Y	辺 長
6123	-111503.170	-27615.339	
6059	-111524.762	-27621.760	22.527
6060	-111527.399	-27612.817	9.324
6061	-111532.200	-27596.713	16.804
9170	-111510.651	-27590.292	22.485
9169	-111507.462	-27600.957	11.132
6122	-111504.043	-27612.437	11.978
6123	-111503.170	-27615.339	3.030
面積	587.9341735		
地積	587.93㎡		

131

地番	保 四九ノ二号		
N O	X	Y	辺 長
9165	-111500.411	-27624.633	
6057	-111523.987	-27628.982	23.974
6058	-111524.137	-27623.881	5.103
6059	-111524.762	-27621.760	2.211
6123	-111503.170	-27615.339	22.527
9166	-111500.913	-27622.957	7.945
9165	-111500.411	-27624.633	1.750
面積	194.5582275		
地積	194.55㎡		

132

地番	上前川一〇ノ二		
N O	X	Y	辺 長
6056	-111497.741	-27636.361	
6051	-111523.700	-27638.722	26.066
6050	-111523.706	-27638.517	0.205
6057	-111523.987	-27628.982	9.539
9165	-111500.411	-27624.633	23.974
9164	-111497.829	-27633.311	9.054
6056	-111497.741	-27636.361	3.051
面積	274.3702330		
地積	274.37㎡		

133

地番	上前川一〇ノ一		
N O	X	Y	辺 長
9180	-111497.689	-27638.084	
9181	-111523.649	-27640.445	26.067
6051	-111523.700	-27638.722	1.724
6056	-111497.741	-27636.361	26.066
9180	-111497.689	-27638.084	1.724
面積	44.8498100		
地積	44.84㎡		

134

地番	上前川一四		
N O	X	Y	辺 長
9172	-111497.395	-27647.699	
9177	-111523.411	-27648.466	26.027
9181	-111523.649	-27640.445	8.025
9180	-111497.689	-27638.084	26.067
6055	-111497.639	-27639.743	1.660
9172	-111497.395	-27647.699	7.960
面積	229.5747100		
地積	229.57㎡		

135

地番	保 四九ノ五号		
N O	X	Y	辺 長
7102	-111497.235	-27653.491	
7101	-111523.240	-27654.258	26.016
9176	-111523.281	-27652.830	1.429
9177	-111523.411	-27648.466	4.366
9172	-111497.395	-27647.699	26.027
9173	-111497.373	-27648.347	0.648
7102	-111497.235	-27653.491	5.146
面積	150.7882685		
地積	150.78㎡		

136

地番	保 四九ノ四号		
N O	X	Y	辺 長
9174	-111497.073	-27659.282	
9175	-111523.073	-27660.051	26.011
7101	-111523.240	-27654.258	5.795
7102	-111497.235	-27653.491	26.016
9174	-111497.073	-27659.282	5.793
面積	150.7328160		
地積	150.73㎡		

137

地番	上前川一A		
N O	X	Y	辺 長
6040	-111496.384	-27682.952	
6054	-111504.337	-27680.001	8.483
6053	-111519.855	-27674.262	16.545
6052	-111522.779	-27670.242	4.971
9175	-111523.073	-27660.051	10.195
9174	-111497.073	-27659.282	26.011
6049	-111496.843	-27666.929	7.650
6040	-111496.384	-27682.952	16.030
面積	475.0861860		
地積	475.08㎡		

図面の種類	画 地 面 積 求 積 表			
街区 番号	49	番号	$\frac{2}{2}$	
町 名	上 桂 前 川 町			
京 都 市 洛 西 第 二 土 地 区 画 整 理 組 合				

S = 1 : 2 5 0

49

300-4

X-111560

300-3

X-111600

Y-27650

52

Y-27600

Y-27650

X-111600

48

47

松尾東ノ口町

200-1

200-2

210-1

図面の種類	画地出来形確認測量図				
街区番号	50	番号		縮尺	1:250
町名	上桂前川町				
京都市洛西第二土地区画整理組合					

160

地番	保 五〇ノ九号		
N O	X	Y	辺 長
6344	-111528.847	-27668.000	
6224	-111531.557	-27669.940	3.333
6223	-111532.442	-27669.613	0.943
6217	-111535.954	-27657.797	12.327
6202	-111529.199	-27655.781	7.049
6344	-111528.847	-27668.000	12.224
面積	66.9977115		
地積	66.99 m ²		

161			
地番	保 五〇ノ八号		
N O	X	Y	辺 長
6202	-111529.199	-27655.781	
6217	-111535.954	-27657.797	7.049
6216	-111540.753	-27659.229	5.008
6215	-111542.112	-27654.615	4.810
6204	-111529.345	-27650.816	13.320
6203	-111529.287	-27652.722	1.907
6202	-111529.199	-27655.781	3.060
面積	60.9750575		
地積	60.97 ㎡		

162

地番	上前川一五B		
N O	X	Y	辺 長
6204	-111529.345	-27650.816	
6215	-111542.112	-27654.615	13.320
6214	-111546.995	-27656.078	5.097
6213	-111547.714	-27653.641	2.541
6205	-111529.425	-27648.186	19.085
6204	-111529.345	-27650.816	2.631
面積	47.6026470		
地積	47.60 ㎡		

163			
地番	上前川五〇B		
N O	X	Y	辺長
6205	-111529.425	-27648.186	
6213	-111547.714	-27653.641	19.085
6167	-111550.233	-27645.200	8.809
9192	-111550.862	-27643.092	2.200
9193	-111552.683	-27636.990	6.368
6207	-111529.953	-27630.251	23.708
6206	-111529.712	-27638.786	8.538
6205	-111529.425	-27648.186	9.404
面積	371.3363305		
地積	371.33㎡		

164				
地番	上北ノロ一九ノ一			
N O	X	Y	辺長	
6207	-111529.953	-27630.251		
9193	-111552.683	-27636.990	23.708	
9194	-111553.318	-27634.861	2.222	
9195	-111553.621	-27633.846	1.059	
6162	-111559.686	-27613.517	21.214	
6163	-111559.739	-27613.364	0.162	
6210	-111535.652	-27606.198	25.130	
6209	-111532.946	-27615.259	9.456	
6208	-111530.105	-27624.850	10.003	
6207	-111529.953	-27630.251	5.403	
面積	615.9676335			
地積	615.96㎡			

165			
地番	保 五〇ノ六号		
N O	X	Y	辺 長
6210	-111535.652	-27606.198	
6163	-111559.739	-27613.364	25.130
6201	-111561.555	-27607.147	6.477
6200	-111561.682	-27606.739	0.427
6211	-111537.631	-27599.569	25.097
6210	-111535.652	-27606.198	6.918
面積	173.5373955		
地積	173.53 ㎡		

166			
地番	保五〇ノ二号		
N O	X	Y	辺長
6211	-111537.631	-27599.569	
6200	-111561.682	-27606.739	25.097
9191	-111563.456	-27600.798	6.200
9189	-111568.041	-27585.374	16.091
6199	-111562.402	-27579.973	7.808
6198	-111561.538	-27577.613	2.513
12741	-111558.248	-27587.469	10.391
12740	-111542.621	-27582.826	16.302
6212	-111538.669	-27596.094	13.844
6211	-111537.631	-27599.569	3.627
面積	500.3135750		
地積	500.31㎡		

167			
地番	保 五〇ノ一五号		
N O	X	Y	辺 長
12740	-111542.621	-27582.826	
12741	-111558.248	-27587.469	16.302
6198	-111561.538	-27577.613	10.391
6195	-111545.584	-27572.873	16.643
6196	-111544.378	-27576.929	4.231
12740	-111542.621	-27582.826	6.153
面積	171.0576770		
地積	171.05 m ²		

168

地番	保 五〇ノ三号		
N O	X	Y	辺 長
6195	-111545.584	-27572.873	
6198	-111561.538	-27577.613	16.643
6178	-111564.966	-27571.549	6.966
6183	-111568.450	-27565.480	6.998
6184	-111568.828	-27564.445	1.102
6185	-111557.906	-27561.222	11.388
6186	-111559.612	-27555.492	5.979
6193	-111551.479	-27553.057	8.490
6194	-111550.096	-27557.698	4.843
6195	-111545.584	-27572.873	15.832
面積	320.0706210		
地積	320.07 ㎡		

169

地 番	上前川四七ノ五		
N O	X	Y	辺 長
6198	-111561.538	-27577.613	
6199	-111562.402	-27579.973	2.513
9189	-111568.041	-27585.374	7.808
9196	-111568.936	-27584.095	1.561
6177	-111573.188	-27576.772	8.468
6178	-111564.966	-27571.549	9.741
6198	-111561.538	-27577.613	6.966
面積	86.7023390		
地積	86.70 m ²		

170

地番	上前川四五ノ三，上前川四七ノ六		
N O	X	Y	辺 長
6178	-111564.966	-27571.549	
6177	-111573.188	-27576.772	9.741
6176	-111579.418	-27580.722	7.377
6175	-111583.941	-27573.407	8.600
6182	-111573.776	-27567.371	11.822
6183	-111568.450	-27565.480	5.652
6178	-111564.966	-27571.549	6.998
面積	140.9132585		
地積	140.91 ㎡		

171

地番	上前川四九		
N O	X	Y	辺長
6193	-111551.479	-27553.057	
6186	-111559.612	-27555.492	8.490
6190	-111564.881	-27537.780	18.479
6191	-111559.502	-27536.563	5.515
6192	-111555.735	-27538.772	4.367
6193	-111551.479	-27553.057	14.906
面積	149.8885095		
地積	149.88 ㎡		

172

地番	上前川四八ノ二		
N O	X	Y	辺長
6185	-111557.906	-27561.222	
6184	-111568.828	-27564.445	11.388
6168	-111577.432	-27540.619	25.332
6190	-111564.881	-27537.780	12.868
6186	-111559.612	-27555.492	18.479
6185	-111557.906	-27561.222	5.979
面積	300.9777645		
地積	300.97 ㎡		

173			
地番	上前川四八ノ一		
N O	X	Y	辺長
6183	-111568.450	-27565.480	
6182	-111573.776	-27567.371	5.652
6181	-111577.407	-27568.012	3.687
6180	-111581.357	-27560.996	8.052
6179	-111586.816	-27550.817	11.550
6170	-111589.641	-27543.370	7.965
6169	-111581.161	-27541.462	8.692
6168	-111577.432	-27540.619	3.823
6184	-111568.828	-27564.445	25.332
6183	-111568.450	-27565.480	1.102
面積	303.3247130		
地積	303.32 m ²		

174

地番	上前川四四ノ一，四五ノ一，四六，四七ノ二 四七ノ四		
N O	X	Y	辺長
9189	-111568.041	-27585.374	
9188	-111568.863	-27586.290	1.231
9187	-111570.428	-27587.280	1.852
9186	-111571.383	-27585.660	1.881
7192	-111580.572	-27591.537	10.908
9185	-111589.447	-27597.230	10.544
6174	-111593.904	-27582.226	15.652
6173	-111599.630	-27563.062	20.001
6172	-111603.616	-27549.595	14.045
6171	-111601.555	-27546.050	4.101
6170	-111589.641	-27543.370	12.212
6179	-111586.816	-27550.817	7.965
6180	-111581.357	-27560.996	11.550
6181	-111577.407	-27568.012	8.052
6182	-111573.776	-27567.371	3.687
6175	-111583.941	-27573.407	11.822
6176	-111579.418	-27580.722	8.600
6177	-111573.188	-27576.772	7.377
9196	-111568.936	-27584.095	8.468
9189	-111568.041	-27585.374	1.561
面積	869.5976510		
地積	869.59 ㎡		

175			
地番	保 五〇ノ四号		
N O	X	Y	辺 長
7193	-111587.491	-27603.801	
9184	-111588.210	-27601.394	2.512
9185	-111589.447	-27597.230	4.344
7192	-111580.572	-27591.537	10.544
7194	-111577.753	-27600.883	9.782
7193	-111587.491	-27603.801	10.166
面積	84.3533900		
地積	84.35 ㎡		

176			
地番	保 五〇ノ一四号		
N O	X	Y	辺 長
9191	-111563.456	-27600.798	
9183	-111586.345	-27607.638	23.889
7193	-111587.491	-27603.801	4.004
7194	-111577.753	-27600.883	10.166
7192	-111580.572	-27591.537	9.762
9186	-111571.383	-27585.660	10.908
9187	-111570.428	-27587.280	1.881
9188	-111568.863	-27586.290	1.852
9189	-111568.041	-27585.374	1.231
9191	-111563.456	-27600.798	16.091
面積	251.3277375		
地積	251.32 ㎡		

177

地番	桂久方一五ノ二		
N O	X	Y	辺長
6201	-111561.555	-27607.147	
6161	-111584.449	-27613.988	23.894
9183	-111586.345	-27607.638	6.627
9191	-111563.456	-27600.798	23.889
6200	-111561.682	-27606.739	6.200
6201	-111561.555	-27607.147	0.427
面積	158.3209110		
地積	158.32 ㎡		

178				
地番	桂久方一五ノ一			
N O	X	Y	辺長	
6162	-111559.686	-27613.517		
6160	-111582.552	-27820.337	23.861	
6161	-111584.449	-27613.988	6.626	
6201	-111561.555	-27607.147	23.894	
6163	-111559.739	-27613.364	6.477	
6162	-111559.686	-27613.517	0.162	
面積	158.3413650			
地積	158.34 m ²			

地 番	保 五〇ノ一〇号		
N O	X	Y	辺 長
6223	-111532.442	-27669.613	
6222	-111538.300	-27667.451	6.244
6216	-111540.753	-27659.229	8.580
6217	-111535.954	-27657.797	5.008
6223	-111532.442	-27669.613	12.327
面積	52.2976290		
地 積	52.29 m ²		

図面の種類	画 地 面 積 求 積 表				
街区 番号	50	番号	2 2		
町 名	上 桂 前 川 町				
京 都 市 洛 西 第 二 土 地 区 画 整 理 組 合					

N
S = 1 : 250



図面の種類	画地出来形確認測量図				
街区番号	51	番号		縮尺	1 : 250
町名	上桂前川町				
京都市洛西第二土地区画整理組合					

138

地番	保 五一ノ一号		
N O	X	Y	辺 長
6234	-111559.154	-27527.300	
9197	-111559.293	-27527.531	0.270
9201	-111561.575	-27522.960	5.109
6235	-111560.522	-27522.723	1.079
6234	-111559.154	-27527.300	4.777
面積	3.1531540		
地積	3.15 m ²		

139

地番	上前川六四ノ二一		
N O	X	Y	辺 長
9197	-111559.293	-27527.531	
9198	-111561.116	-27530.567	3.541
9199	-111564.587	-27523.639	7.749
9201	-111561.575	-27522.960	3.088
9197	-111559.293	-27527.531	5.109
面積	19.2425150		
地積	19.24 m ²		

140

地番	上前川六四ノ六		
N O	X	Y	辺 長
6232	-111563.636	-27531.350	
6240	-111567.207	-27524.229	7.966
9199	-111564.587	-27523.639	2.686
9198	-111561.116	-27530.567	7.749
6233	-111561.265	-27530.815	0.289
6232	-111563.636	-27531.350	2.431
面積	20.7242780		
地積	20.72 m ²		

141

地番	保 五一ノ六号		
N O	X	Y	辺 長
6235	-111560.522	-27522.723	
9201	-111561.575	-27522.960	1.079
9202	-111562.995	-27520.117	3.178
9203	-111564.447	-27517.776	2.755
6236	-111562.155	-27517.263	2.349
6235	-111560.522	-27522.723	5.699
面積	9.3438245		
地積	9.34 m ²		

142

地番	上前川六四ノ二二		
N O	X	Y	辺長
9201	-111561.575	-27522.960	
9199	-111564.587	-27523.639	3.088
9200	-111567.213	-27518.396	5.864
9203	-111564.447	-27517.776	2.835
9202	-111562.995	-27520.117	2.755
9201	-111561.575	-27522.960	3.178
面積	17.2491850		
地積	17.24 m ²		

143

地番	上前川六四ノ二四		
N O	X	Y	辺 長
9199	-111564.587	-27523.639	
6240	-111567.207	-27524.229	2.686
6241	-111569.848	-27518.986	5.871
9200	-111567.213	-27518.396	2.700
9199	-111564.587	-27523.639	5.864
面積	15.3297475		
地積	15.32 ㎡		

144			
地番	保 五一ノ七号		
N O	X	Y	辺 長
6236	-111562.155	-27517.263	
9203	-111564.447	-27517.776	2.349
6244	-111567.170	-27513.388	5.164
6237	-111563.561	-27512.560	3.703
6236	-111562.155	-27517.263	4.909
面積	14.7957450		
地積	14.79 m ²		

145			
地 番	上前川六四ノ二三		
N O	X	Y	辺 長
9203	-111564.447	-27517.776	
9200	-111567.213	-27518.396	2.835
6245	-111569.472	-27513.887	5.043
6244	-111567.170	-27513.388	2.355
9203	-111564.447	-27517.776	5.164
面 積	12.6662135		
地 積	12.66 m ²		

146

地番	上前川六四ノ二五		
N O	X	Y	辺長
9200	-111567.213	-27518.396	
6241	-111569.848	-27518.986	2.700
6246	-111572.099	-27514.467	5.049
6245	-111569.472	-27513.887	2.690
9200	-111567.213	-27518.396	5.043
面積	13.1955090		
地積	13.19 m ²		

147			
地番	保 五一ノ二号		
N O	X	Y	辺 長
6237	-111563.561	-27512.560	
6244	-111567.170	-27513.388	3.703
6245	-111569.472	-27513.887	2.355
6246	-111572.099	-27514.467	2.690
6247	-111574.252	-27514.950	2.207
9204	-111580.345	-27506.108	10.738
9205	-111581.820	-27502.839	3.586
6258	-111577.463	-27500.891	4.773
6251	-111574.562	-27506.345	6.178
6243	-111571.214	-27506.256	3.349
6242	-111567.526	-27505.429	3.780
6239	-111565.802	-27505.048	1.766
6238	-111563.797	-27511.771	7.016
6237	-111563.561	-27512.560	0.824
面積	127.8525635		
地積	127.85 m ²		

148

地番	保 五一ノ三号		
N O	X	Y	辺 長
6239	-111565.802	-27505.048	
6242	-111567.526	-27505.429	1.766
6255	-111572.301	-27494.767	11.682
6256	-111571.987	-27494.613	0.350
6257	-111568.420	-27496.270	3.933
6239	-111565.802	-27505.048	9.160
面積	25.7013715		
地積	25.70 m ²		

149

地番	上前川六〇		
N O	X	Y	辺長
6242	-111567.526	-27505.429	
6243	-111571.214	-27506.256	3.780
6251	-111574.562	-27506.345	3.349
6258	-111577.463	-27500.891	6.178
6254	-111578.977	-27498.039	3.229
6255	-111572.301	-27494.767	7.435
6242	-111567.526	-27505.429	11.682
面積	75.8726640		
地積	75.87 m ²		

150

地 番	上前川六四ノ一, 上前川六四ノ二〇		
N O	X	Y	辺 長
6247	-111574.252	-27514.950	
6248	-111577.518	-27515.681	3.347
6249	-111581.688	-27516.614	4.273
6252	-111588.637	-27502.302	15.910
6253	-111583.161	-27500.089	5.906
6254	-111578.977	-27498.039	4.659
6258	-111577.463	-27500.891	3.229
9205	-111581.820	-27502.839	4.773
9204	-111580.345	-27506.108	3.586
6247	-111574.252	-27514.950	10.738
面積	118.6329915		
地積	118.63 m ²		

151

地番	上前川六四ノ一五, 上前川六四ノ一六		
N O	X	Y	辺長
6249	-111581.688	-27516.614	
6250	-111582.926	-27516.882	1.267
6144	-111588.405	-27518.115	5.616
6140	-111594.876	-27504.833	14.774
6141	-111594.694	-27504.751	0.200
6252	-111588.637	-27502.302	6.533
6249	-111581.688	-27516.614	15.910
面積	102.9007630		
地積	102.90 m ²		

152

地番	保 五一ノ四号		
N O	X	Y	辺 長
6140	-111594.876	-27504.833	
6144	-111588.405	-27518.115	14.774
6145	-111585.634	-27523.806	6.330
6142	-111593.511	-27526.155	8.220
6139	-111602.268	-27508.148	20.023
6140	-111594.876	-27504.833	8.101
面積	166.6595085		
地積	166.65 m ²		

153

地番	上前川六五B		
N O	X	Y	辺 長
6142	-111593.511	-27526.155	
6143	-111597.593	-27527.357	4.255
6136	-111609.217	-27530.817	12.128
6137	-111613.494	-27516.430	15.009
6138	-111611.614	-27512.339	4.502
6139	-111602.268	-27508.148	10.243
6142	-111593.511	-27526.155	20.023
面積	275.3886930		
地積	275.38 m ²		

154			
地番	保 五一ノ八号		
N O	X	Y	辺 長
6187	-111596.160	-27532.165	
6225	-111607.792	-27535.612	12.132
6136	-111609.217	-27530.817	5.002
6143	-111597.593	-27527.357	12.128
6187	-111596.160	-27532.165	5.017
面積	60.7668935		
地積	60.76 m ²		

155

地番	保 五一ノ五号		
N O	X	Y	辺 長
6228	-111594.336	-27538.274	
6227	-111603.288	-27540.294	9.177
6226	-111607.059	-27538.076	4.375
6225	-111607.792	-27535.612	2.571
6187	-111596.160	-27532.165	12.132
6228	-111594.336	-27538.274	6.375
面積	68.0122550		
地積	68.01 m ²		

156

地 番	上今井二		
N O	X	Y	辺 長
6229	-111582.599	-27535.625	
6228	-111594.336	-27538.274	12.032
6187	-111596.160	-27532.165	6.375
6143	-111597.593	-27527.357	5.017
6142	-111593.511	-27526.155	4.255
6145	-111585.634	-27523.806	8.220
6188	-111584.731	-27525.679	2.079
6189	-111583.244	-27529.875	4.452
6229	-111582.599	-27535.625	5.786
面積	149.8041455		
地積	149.80 m ²		


157

地番	上前川六四ノ九		
N O	X	Y	辺 長
6230	-111574.437	-27533.785	
6229	-111582.599	-27535.625	8.367
6189	-111583.244	-27529.875	5.786
6188	-111584.731	-27525.679	4.452
6145	-111585.634	-27523.806	2.079
6144	-111588.405	-27518.115	6.330
6250	-111582.926	-27516.882	5.616
6230	-111574.437	-27533.785	18.915
面積	115.1840190		
地積	115.18 m ²		


158

地番	上前川六四ノ八		
N O	X	Y	辺長
6231	-111569.031	-27532.566	
6230	-111574.437	-27533.785	5.542
6250	-111582.926	-27516.882	18.915
6249	-111581.688	-27516.614	1.267
6248	-111577.518	-27515.681	4.273
6231	-111569.031	-27532.566	18.898
面積	101.5975910		
地積	101.59 m ²		

159			
地番	上前川六四ノ七		
N O	X	Y	辺長
6232	-111563.636	-27531.350	
6231	-111569.031	-27532.566	5.530
6248	-111577.518	-27515.681	18.898
6247	-111574.252	-27514.950	3.347
6246	-111572.099	-27514.467	2.207
6241	-111569.848	-27518.986	5.049
6240	-111567.207	-27524.229	5.871
6232	-111563.636	-27531.350	7.966
面積	101.5086675		
地積	101.50 m ²		

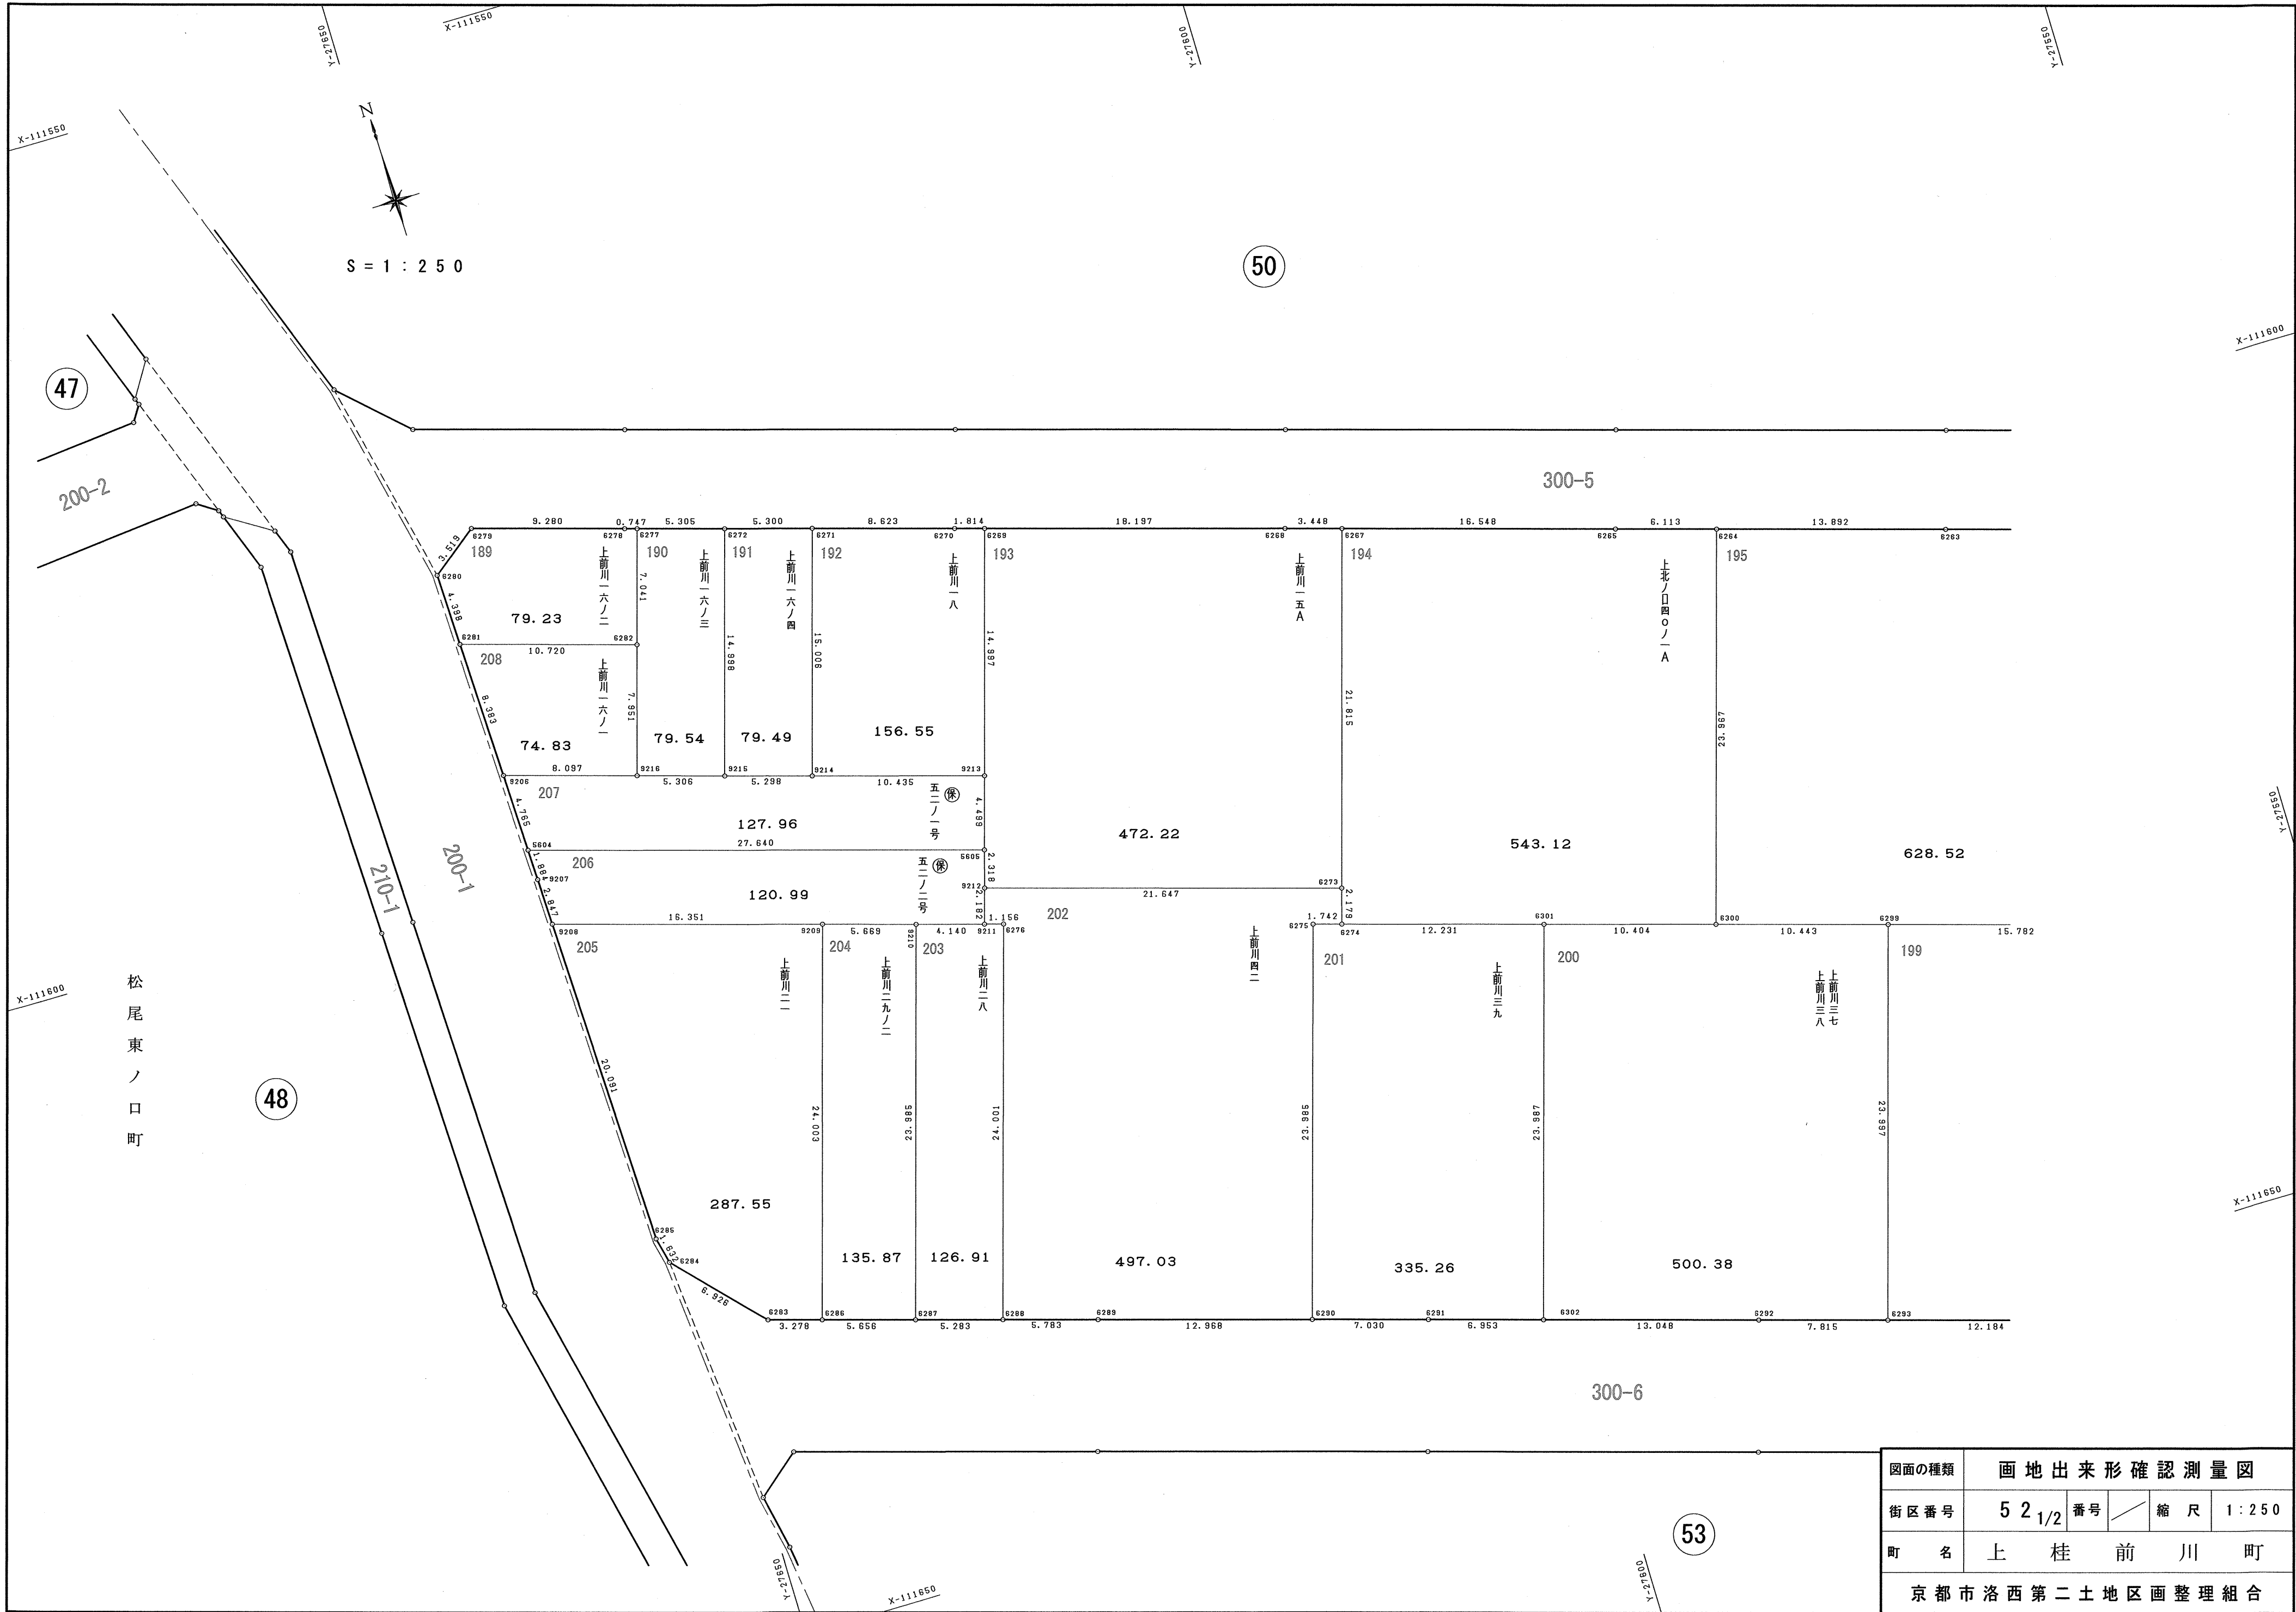

図面の種類	画地出来形確認測量図				
街区番号	52	1/2	番号	縮尺	1:250
町名	上桂前川町				
京都市洛西第二土地区画整理組合					

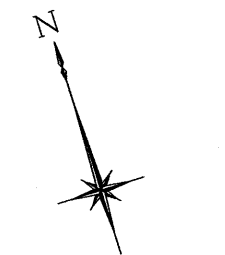

S = 1 : 2 5 0



図面の種類	画地出来形確認測量図				
街区番号	5 2	2/2	番号		縮 尺 1 : 2 5 0
町 名	上 桂 前 川 町				
京都市洛西第二土地区画整理組合					

189

地番	上前川一六ノ二		
N O	X	Y	辺長
6279	-111579.881	-27650.345	
6280	-111582.023	-27653.137	3.519
6281	-111586.419	-27653.007	4.398
6282	-111589.491	-27642.737	10.720
6277	-111582.741	-27640.734	7.041
6278	-111582.528	-27641.450	0.747
6279	-111579.881	-27650.345	9.280
面積	79.2386145		
地積	79.23㎡		

190

地番	上前川一六ノ三		
N O	X	Y	辺長
6277	-111582.741	-27640.734	
6282	-111589.491	-27642.737	7.041
9216	-111597.113	-27644.999	7.951
9215	-111598.634	-27639.916	5.306
6272	-111584.256	-27635.650	14.998
6277	-111582.741	-27640.734	5.305
面積	79.5495245		
地積	79.54㎡		

191

地番	上前川一六ノ四		
N O	X	Y	辺長
6272	-111584.256	-27635.650	
9215	-111598.634	-27639.916	14.998
9214	-111600.156	-27634.841	5.298
6271	-111585.770	-27630.571	15.006
6272	-111584.256	-27635.650	5.300
面積	79.4962380		
地積	79.49㎡		

192

地番	上前川一八		
N O	X	Y	辺長
6271	-111585.770	-27630.571	
9214	-111600.156	-27634.841	15.006
9213	-111603.127	-27624.838	10.435
6269	-111588.750	-27620.569	14.997
6270	-111588.232	-27622.307	1.814
6271	-111585.770	-27630.571	8.623
面積	156.5557490		
地積	156.55㎡		

193

地番	上前川一五A		
N O	X	Y	辺長
6269	-111588.750	-27620.569	
9213	-111603.127	-27624.838	14.997
5605	-111607.439	-27626.123	4.499
9212	-111609.662	-27626.781	2.318
6273	-111615.848	-27606.037	21.647
6267	-111594.936	-27599.826	21.815
6268	-111593.949	-27603.130	3.448
6269	-111588.750	-27620.569	18.197
面積	472.2211410		
地積	472.22㎡		

194

地番	上北ノ口四〇ノ一A		
N O	X	Y	辺長
6267	-111594.936	-27599.826	
6273	-111615.848	-27606.037	21.815
6274	-111617.938	-27606.655	2.179
6301	-111621.425	-27594.932	12.231
6300	-111624.386	-27584.958	10.404
6264	-111601.418	-27578.112	23.967
6265	-111599.673	-27583.971	6.113
6267	-111594.936	-27599.826	16.548
面積	543.1242555		
地積	543.12㎡		

195

地番	上前川四一ノ三		
N O	X	Y	辺長
6264	-111601.418	-27578.112	
6300	-111624.386	-27584.958	23.967
6299	-111627.366	-27574.949	10.443
6298	-111631.871	-27559.824	15.782
6262	-111608.892	-27552.980	23.977
6263	-111605.382	-27564.798	12.328
6264	-111601.418	-27578.112	13.892
面積	628.5239245		
地積	628.52㎡		

196

地番	上前川四一ノ二		
N O	X	Y	辺長
6262	-111608.892	-27552.980	
6298	-111631.871	-27559.824	23.977
6297	-111632.780	-27556.785	3.172
6266	-111637.293	-27541.701	15.745
6259	-111614.292	-27534.823	24.007
6260	-111612.799	-27539.822	5.217
6261	-111609.384	-27551.324	11.998
6262	-111608.892	-27552.980	1.728
面積	454.2166740		
地積	454.21㎡		

197

地番	上前川六七ノ一		
N O	X	Y	辺長
6259	-111614.292	-27534.823	
6266	-111637.293	-27541.701	24.007
6304	-111641.972	-27525.947	16.434
6303	-111640.815	-27525.431	1.267
6307	-111622.566	-27517.256	19.996
6308	-111619.036	-27518.932	3.908
6259	-111614.292	-27534.823	16.584
面積	427.7283735		
地積	427.72㎡		

198

地番	上前川六八		
N O	X	Y	辺長
6297	-111632.780	-27556.785	
6295	-111655.785	-27563.608	23.995
6296	-111659.555	-27550.949	13.208
6306	-111663.206	-27538.693	12.788
6305	-111661.335	-27534.578	4.520
6304	-111641.972	-27525.947	21.200
6266	-111637.293	-27541.701	16.434
6297	-111632.780	-27556.785	15.745
面積	729.3879355		
地積	729.38㎡		

199

地番	上前川四一ノ一		
N O	X	Y	辺長
6299	-111627.366	-27574.949	
6293	-111650.366	-27581.794	23.997
6294	-111653.846	-27570.118	12.184
6295	-111655.785	-27563.608	6.793
6297	-111632.780	-27556.785	23.995
6298	-111631.871	-27559.824	3.172
6299	-111627.366	-27574.949	15.782
面積	455.1232815		
地積	455.12㎡		

200

地番	上前川三七, 上前川三八		
N O	X	Y	辺長
6301	-111621.425	-27594.932	
6302	-111644.411	-27601.789	23.987
6292	-111648.134	-27589.283	13.048
6293	-111650.366	-27581.794	7.815
6299	-111627.366	-27574.949	23.997
6300	-111624.386	-27584.958	10.443
6301	-111621.425	-27594.932	10.404
面積	500.3838380		
地積	500.38㎡		

201

地番	上前川三九		
N O	X	Y	辺長
6275	-111617.440	-27608.324	
6290	-111640.421	-27615.191	23.985
6291	-111642.427	-27608.453	7.030
6302	-111644.411	-27601.789	6.953
6301	-111621.425	-27594.932	23.987
6274	-111617.938	-27606.655	12.231
6275	-111617.440	-27608.324	1.742
面積	335.2629450		
地積	335.26㎡		

202

地番	上前川四二		
N O	X	Y	辺長
9212	-111609.662	-27626.781	
9211	-111611.753	-27627.404	2.182
6276	-111612.077	-27626.294	1.156
6288	-111635.074	-27633.163	24.001
6289	-111636.721	-27627.620	5.783
6290	-111640.421	-27615.191	12.968
6275	-111617.440	-27608.324	23.985
6274	-111617.938	-27606.655	1.742
6273	-111615.848	-27606.037	2.179
9212	-111609.662	-27626.781	21.647
面積	497.0324080		
地積	497.03㎡		

203

地番	上前川二八		
N O	X	Y	辺長
9210	-111610.584	-27631.376	
6287	-111633.570	-27638.227	23.985
6288	-111635.074	-27633.163	5.283
6276	-111612.077	-27626.294	24.001
9211	-111611.753	-27627.404	1.156
9210	-111610.584	-27631.376	4.140
面積	126.9102585		
地積	126.91㎡		

204

地番	上前川二九ノ二		
N O	X	Y	辺長
9209	-111608.952	-27636.805	
6286	-111631.959	-27643.649	24.003
6287	-111633.570	-27638.227	5.656
9210	-111610.584	-27631.376	23.985
9209	-111608.952	-27636.805	5.669
面積	135.8707320		
地積	135.87㎡		

205

地番	上前川二一		
N O	X	Y	辺長
9208	-111604.290	-27652.477	
6285	-111624.372	-27651.882	20.091
6284	-111625.962	-27651.516	1.632
6283	-111631.026	-27646.791	8.926
6286	-111631.959	-27643.649	3.278
9209	-111608.952	-27636.805	24.003
9208	-111604.290	-27652.477	16.351
面積	287.5547820		
地積	287.55㎡		

206

地番	保 五二ノ二号		
N O	X	Y	辺長
5604	-111599.561	-27652.617	
9207	-111601.444	-27652.561	1.884
9208	-111604.290	-27652.477	2.847
9209	-111608.952	-27636.805	16.351
9210	-111610.584	-27631.376	5.669
9211	-111611.753	-27627.404	4.140
9212	-111609.662	-27626.781	2.182
5605	-111607.439	-27626.123	2.318
5604	-111599.561	-27652.617	27.640
面積	120.9930355		
地積	120.99㎡		


207

地番	保 五二ノ一号		
N O	X	Y	辺長
9206	-111594.798	-27652.758	
5604	-111599.561	-27652.617	4.765
5605	-111607.439	-27626.123	27.640
9213	-111603.127	-27624.838	4.499
9214	-111600.156	-27634.841	10.435
9215	-111598.634	-27639.916	5.298
9216	-111597.113	-27644.999	5.306
9206	-111594.798	-27652.758	8.097
面積	127.9606900		
地積	127.96㎡		

208

地番	上前川一六ノ一		
N O	X	Y	辺長
6281	-111586.419	-27653.007	
9206	-111594.798	-27652.758	8.383
9216	-111597.113	-27644.999	8.097
6282	-111589.491	-27642.737	7.951
6281	-111586.419	-27653.007	10.720
面積	74.8315150		
地積	74.83㎡		

図面の種類	画 地 面 積 求 積 表			
街区番号	52	番号	／	
町 名	上	桂	前	川 町
京都市洛西第二土地区画整理組合				

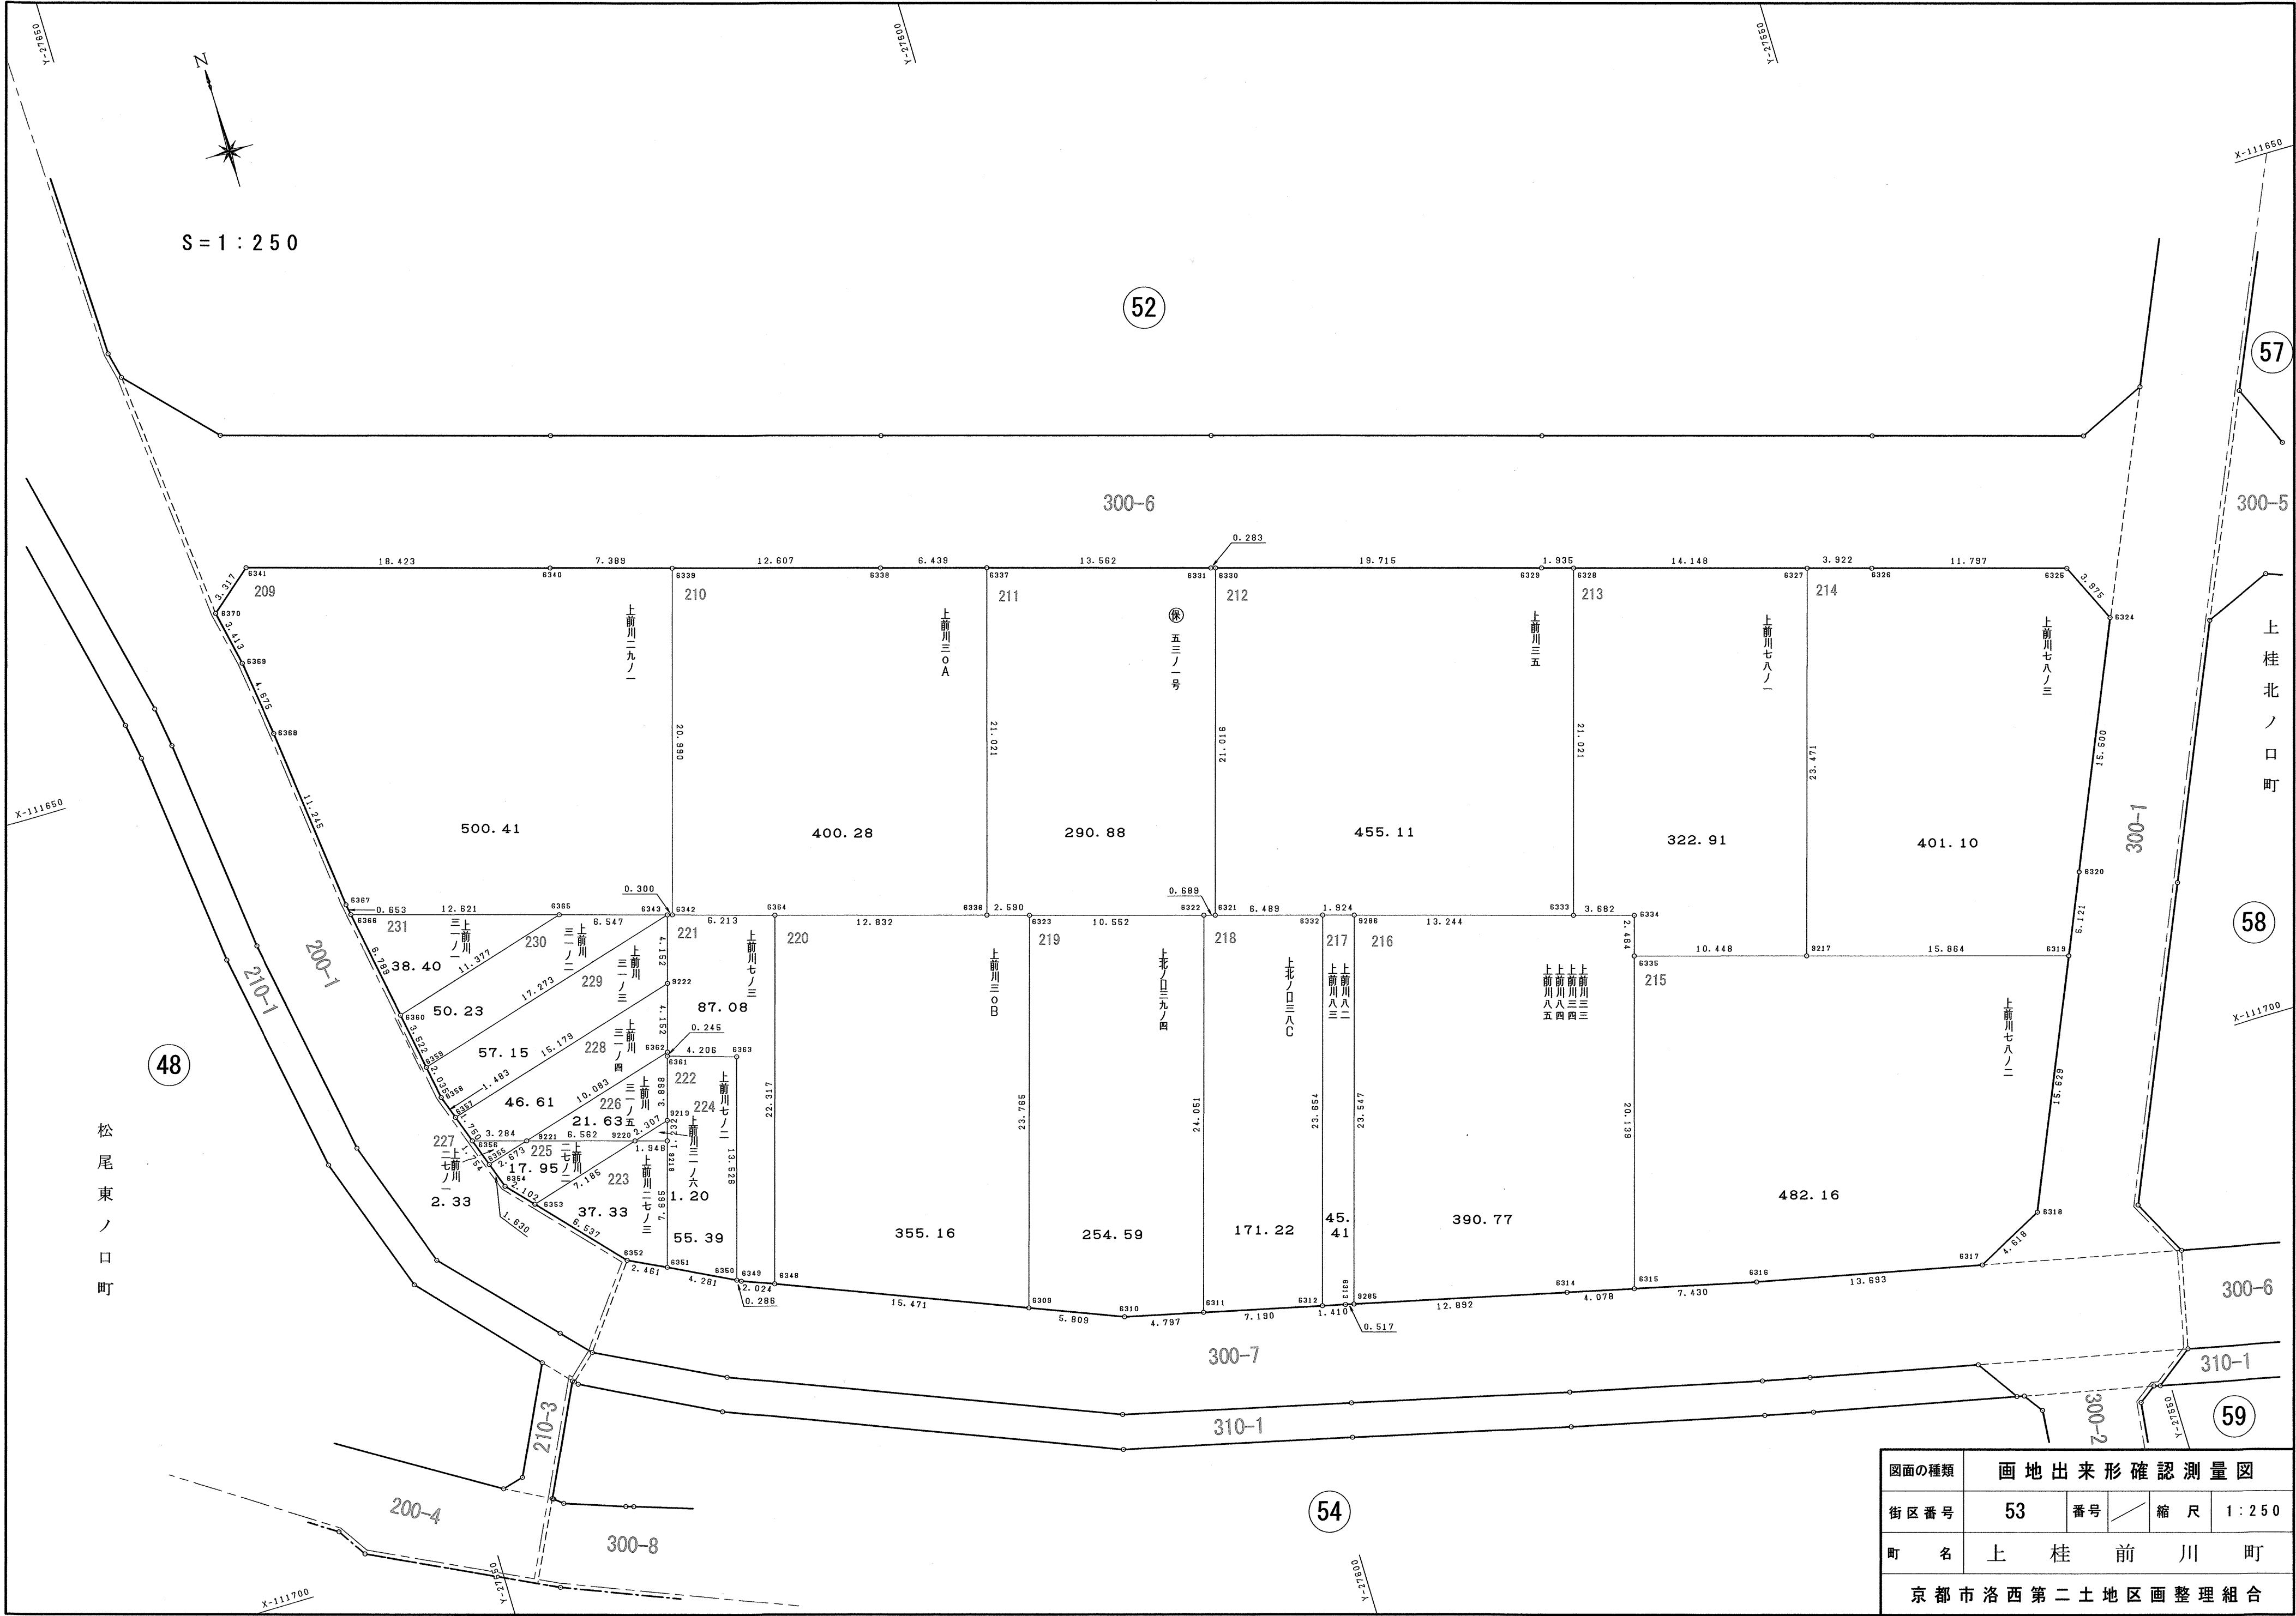

図面の種類	画地出来形確認測量図			
街区番号	53	番号	縮尺	1:250
町名	上桂前川町			
京都市洛西第二土地区画整理組合				

209

地番	上前川二九ノ一		
N O	X	Y	辺長
6341	-111639.147	-27647.577	
6370	-111641.268	-27650.127	3.317
6369	-111644.612	-27649.446	3.413
6368	-111649.244	-27648.814	4.675
6367	-111660.422	-27647.586	11.245
6366	-111661.066	-27647.475	0.653
6365	-111664.656	-27635.375	12.621
6343	-111666.530	-27629.102	6.547
6342	-111666.617	-27628.815	0.300
6339	-111646.497	-27622.834	20.990
6340	-111644.389	-27629.916	7.389
6341	-111639.147	-27647.577	18.423
面積	500.4140455		
地積	500.41	㎡	

210

地番	上前川三〇A		
N O	X	Y	辺長
6339	-111646.497	-27622.834	
6342	-111666.617	-27628.815	20.990
6364	-111668.422	-27622.870	6.213
6336	-111672.084	-27610.572	12.832
6337	-111651.935	-27604.581	21.021
6338	-111650.095	-27610.751	6.439
6339	-111646.497	-27622.834	12.607
面積	400.2832010		
地積	400.28	㎡	

211

地番	保 五三ノ一号		
N O	X	Y	辺長
6337	-111651.935	-27604.581	
6336	-111672.084	-27610.572	21.021
6323	-111672.829	-27608.091	2.590
6322	-111675.836	-27597.977	10.552
6321	-111676.033	-27597.317	0.689
6330	-111655.893	-27591.314	21.016
6331	-111655.812	-27591.585	0.283
6337	-111651.935	-27604.581	13.562
面積	290.8811925		
地積	290.88	㎡	

212

地番	上前川三五		
N O	X	Y	辺長
6330	-111655.893	-27591.314	
6321	-111676.033	-27597.317	21.016
6332	-111677.885	-27591.098	6.489
9286	-111678.434	-27589.254	1.924
6333	-111682.215	-27576.561	13.244
6328	-111662.068	-27570.564	21.021
6329	-111661.515	-27572.418	1.935
6330	-111655.893	-27591.314	19.715
面積	455.1174790		
地積	455.11	㎡	

213

地番	上前川七八ノ一		
N O	X	Y	辺長
6328	-111662.068	-27570.564	
6333	-111682.215	-27576.561	21.021
6334	-111683.267	-27573.033	3.682
6335	-111685.629	-27573.734	2.464
9217	-111688.602	-27563.718	10.448
6327	-111666.111	-27557.006	23.471
6328	-111662.068	-27570.564	14.148
面積	322.9198595		
地積	322.91	㎡	

214

地番	上前川七八ノ三		
N O	X	Y	辺長
6327	-111666.111	-27557.006	
9217	-111688.602	-27563.718	23.471
6319	-111693.116	-27548.510	15.864
6320	-111688.422	-27546.464	5.121
6324	-111674.210	-27540.278	15.500
6325	-111670.600	-27541.942	3.975
6326	-111667.232	-27553.248	11.797
6327	-111666.111	-27557.006	3.922
面積	401.1032810		
地積	401.10	㎡	

215

地番	上前川七八ノ二		
N O	X	Y	辺長
6335	-111685.629	-27573.734	
6315	-111704.933	-27579.472	20.139
6316	-111706.658	-27572.245	7.430
6317	-111709.556	-27558.862	13.693
6318	-111707.443	-27554.756	4.618
6319	-111693.116	-27548.510	15.629
9217	-111688.602	-27563.718	15.864
6335	-111685.629	-27573.734	10.448
面積	482.1698655		
地積	482.16	㎡	

216

地番	上前川三三, 三四, 八四, 八五		
N O	X	Y	辺長
9285	-111701.000	-27595.980	
6314	-111703.986	-27583.439	12.892
6315	-111704.933	-27579.472	4.078
6335	-111685.629	-27573.734	20.139
6334	-111683.267	-27573.033	2.464
6333	-111682.215	-27576.561	3.682
9286	-111678.434	-27589.254	13.244
9285	-111701.000	-27595.980	23.547
面積	390.7703070		
地積	390.77	㎡	

217

地番	上前川八二, 上前川八三		
N O	X	Y	辺長
6312	-111700.553	-27597.855	
6313	-111700.880	-27596.483	1.410
9285	-111701.000	-27595.980	0.517
9286	-111678.434	-27589.254	23.547
6332	-111677.885	-27591.098	1.924
6312	-111700.553	-27597.855	23.654
面積	45.4134990		
地積	45.41	㎡	

218

地番	上北ノ口三八C		
N O	X	Y	辺長
6322	-111675.836	-27597.977	
6311	-111698.884	-27604.849	24.051
6312	-111700.553	-27597.855	7.190
6332	-111677.885	-27591.098	23.654
6321	-111676.033	-27597.317	6.489
6322	-111675.836	-27597.977	0.689
面積	171.2212610		
地積	171.22	㎡	

219

地番	上北ノ口三九ノ四		
N O	X	Y	辺長
6323	-111672.829	-27608.091	
6309	-111695.597	-27614.902	23.765
6310	-111697.770	-27609.515	5.809
6311	-111698.884	-27604.849	4.797
6322	-111675.836	-27597.977	24.051
6323	-111672.829	-27608.091	10.552
面積	254.5920685		
地積	254.59	㎡	

220

地番	上前川三〇B		
N O	X	Y	辺長
6364	-111668.422	-27622.870	
6348	-111689.808	-27629.249	22.317
6309	-111695.597	-27614.902	15.471
6323	-111672.829	-27608.091	23.765
6336	-111672.084	-27610.572	2.590
6364	-111668.422	-27622.870	12.832
面積	355.1669550		
地積	355.16	㎡	

221

地番	上前川七ノ三		
N O	X	Y	辺長
6343	-111666.530	-27629.102	
9222	-111670.511	-27630.282	4.152
6362	-111674.492	-27631.462	4.152
6361	-111674.723	-27631.545	0.245
6363	-111675.958	-27627.524	4.206
6350	-111688.922	-27631.381	13.526
6349	-111689.051	-27631.126	0.286
6348	-111689.808	-27629.249	2.024
6364	-111668.422	-27622.870	22.317
6342	-111666.617	-27628.815	6.213
6343	-111666.530	-27629.102	0.300
面積	87.0899800		
地積	87.08	㎡	

222

地番	上前川七ノ二		
N O	X	Y	辺長
6361	-111674.723	-27631.545	
9219	-111678.459	-27632.658	3.898
9218	-111679.640	-27633.010	1.232
6351	-111686.986	-27635.199	7.665
6350	-111688.922	-27631.381	4.281
6363	-111675.958	-27627.524	13.526
6361	-111674.723	-27631.545	4.206
面積	55.3919375		
地積	55.39	㎡	

223

地番	上前川二七ノ三		
N O	X	Y	辺長
6353	-111681.038	-27641.793	
6352	-111685.874	-27637.394	6.537
6351	-111686.986	-27635.199	2.461
9218	-111679.640	-27633.010	7.665
9220	-111679.086	-27634.878	1.948
6353	-111681.038	-27641.793	7.185
面積	37.3301370		
地積	37.33	㎡	

224

地番	上前川三一ノ六		
N O	X	Y	辺長
9220	-111679.086	-27634.878	
9218	-111679.640	-27633.010	1.948
9219	-111678.459	-27632.658	1.232
9220	-111679.086	-27634.878	2.307
面積	1.2005580		
地積	1.20	㎡	

225

地番	上前川二七ノ二		
N O	X	Y	辺長
6355	-111677.943	-27643.742	
6354	-111679.483	-27643.207	1.630
6353	-111681.038	-27641.793	2.102
9220	-111679.086	-27634.878	7.185
9221	-111677.220	-27641.169	6.562
6355	-111677.943	-27643.742	2.673
面積	17.9508095		
地積	17.95	㎡	

226

地番	上前川三一ノ五		
N O	X	Y	辺長
9221	-111677.220	-27641.169	
9220	-111679.086	-27634.878	6.562
9219	-111678.459	-27632.658	2.307
6361	-111674.723	-27631.545	3.898
6362	-111674.492	-27631.462	0.245
9221	-111677.220	-27641.169	10.083
面積	21.6394865		
地積	21.63	㎡	

227

地番	上前川二七ノ一		
N O	X	Y	辺長
6356	-111676.286	-27644.317	
6355	-111677.943	-27643.742	1.754
9221	-111677.220	-27641.169	2.673
6356	-111676.286	-27644.317	3.284
面積	2.3395930		
地積	2.33	㎡	

228

地番	上前川三一ノ四		
N O	X	Y	辺長
6357	-111674.633	-27644.891	
6356	-111676.286	-27644.317	1.750
9221	-111677.220	-27641.169	3.284
6362	-111674.492	-27631.462	10.083
9222	-111670.511	-27630.282	4.152
6357	-111674.633	-27644.891	15.179
面積	46.6138110		
地積	46.61	㎡	

229


地番	上前川三一ノ三		
N O	X	Y	辺長
6359	-111671.227	-27645.724	
6358	-111673.232	-27645.378	2.035
6357	-111674.633	-27644.891	1.483
9222	-111670.511	-27630.282	15.179
6343	-111666.530	-27629.102	4.152
6359	-111671.227	-27645.724	17.273
面積	57.1566455		
地積	57.15	㎡	

230

地番	上前川三一ノ二	
----	---------	--



S = 1 : 250

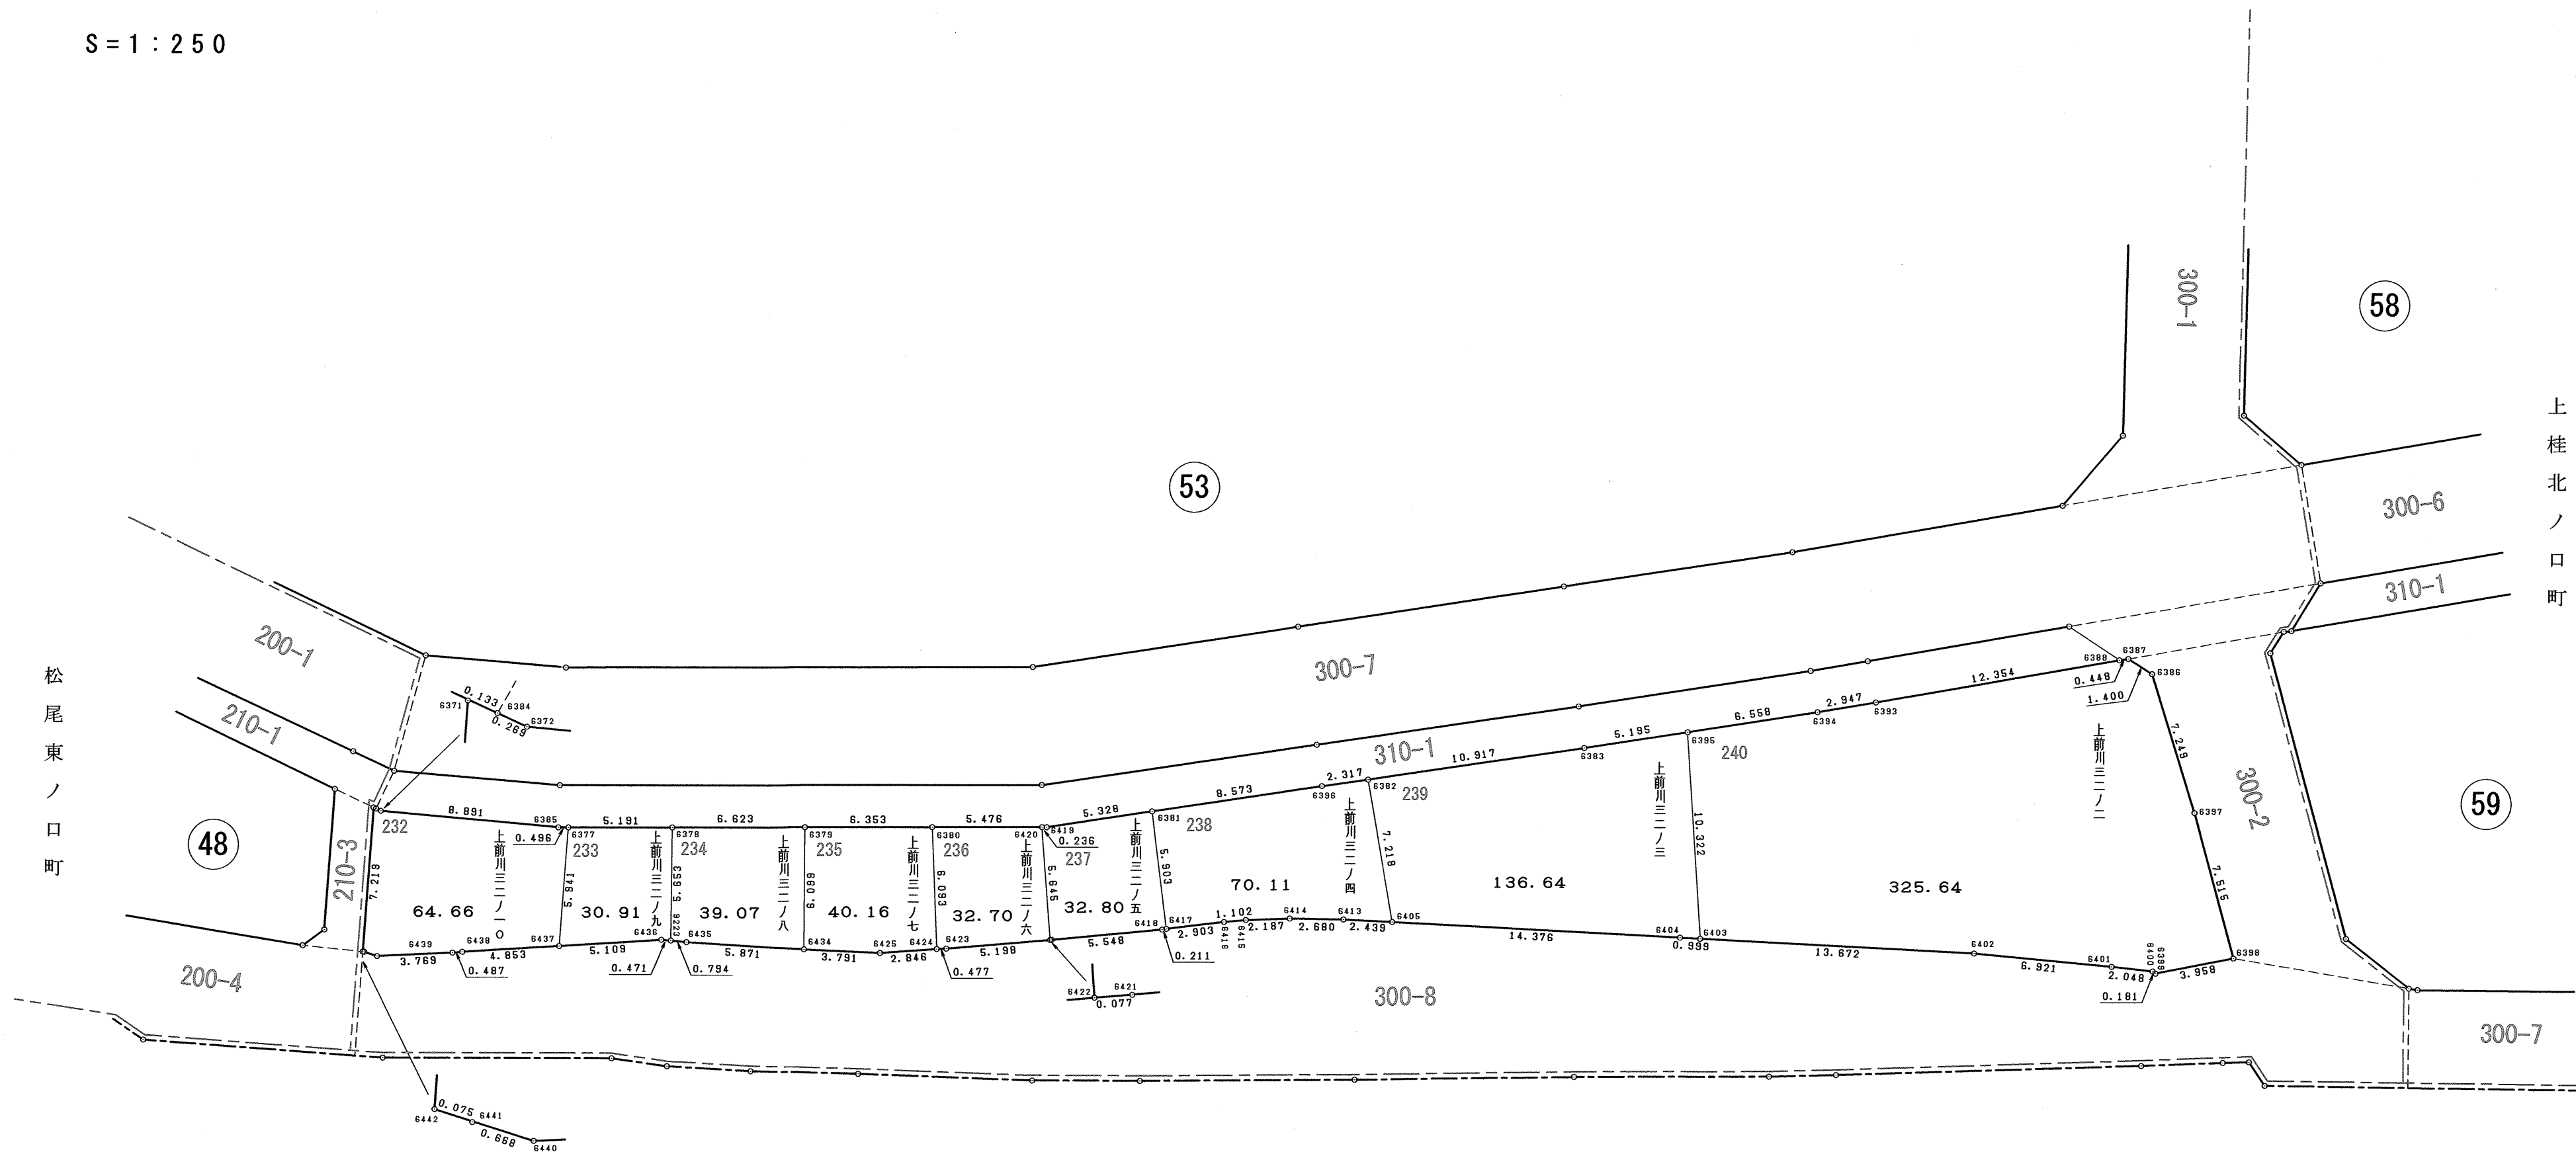

図面の種類	画地出来形確認測量図				
街区番号	54	番号	縮尺	1:250	
町名	上桂前川町				
京都市洛西第二土地区画整理組合					

232

地 番	上前川三二ノ一〇		
N O	X	Y	辺 長
6371	-111691.938	-27642.652	
6442	-111698.408	-27645.853	7.219
6441	-111698.448	-27645.789	0.075
6440	-111698.875	-27645.275	0.668
6439	-111700.126	-27641.720	3.769
6438	-111700.270	-27641.255	0.487
6437	-111701.810	-27636.653	4.853
6377	-111696.488	-27634.013	5.941
6385	-111696.302	-27634.473	0.496
6372	-111692.232	-27642.378	8.891
6384	-111692.036	-27642.562	0.269
6371	-111691.938	-27642.652	0.133
面積	64.6645965		
地積	64.66㎡		

233

地 番	上前川三二ノ九		
N O	X	Y	辺 長
6377	-111696.488	-27634.013	
6437	-111701.810	-27636.653	5.941
6436	-111703.432	-27631.808	5.109
9223	-111703.648	-27631.390	0.471
6378	-111698.436	-27629.201	5.653
6377	-111696.488	-27634.013	5.191
面積	30.9188990		
地積	30.91㎡		

234

地 番	上前川三二ノ八		
N O	X	Y	辺 長
6378	-111698.436	-27629.201	
9223	-111703.648	-27631.390	5.653
6435	-111704.012	-27630.684	0.794
6434	-111706.556	-27625.393	5.871
6379	-111700.920	-27623.062	6.099
6378	-111698.436	-27629.201	6.623
面積	39.0707220		
地積	39.07㎡		

235

地 番	上前川三二ノ七		
N O	X	Y	辺 長
6379	-111700.920	-27623.062	
6434	-111706.556	-27625.393	6.099
6425	-111708.144	-27621.951	3.791
6424	-111709.032	-27619.247	2.846
6380	-111703.303	-27617.173	6.093
6379	-111700.920	-27623.062	6.353
面積	40.1641455		
地積	40.16㎡		

236

地 番	上前川三二ノ六		
N O	X	Y	辺 長
6380	-111703.303	-27617.173	
6424	-111709.032	-27619.247	6.093
6423	-111709.181	-27618.794	0.477
6422	-111710.729	-27613.832	5.198
6420	-111705.357	-27612.097	5.645
6380	-111703.303	-27617.173	5.476
面積	32.7060845		
地積	32.70㎡		

237

地 番	上前川三二ノ五		
N O	X	Y	辺 長
6420	-111705.357	-27612.097	
6422	-111710.729	-27613.832	5.645
6421	-111710.752	-27613.759	0.077
6418	-111712.340	-27608.443	5.548
6417	-111712.395	-27608.239	0.211
6381	-111706.696	-27606.699	5.903
6419	-111705.446	-27611.878	5.328
6420	-111705.357	-27612.097	0.236
面積	32.8063900		
地積	32.80㎡		

238

地 番	上前川三二ノ四		
N O	X	Y	辺 長
6381	-111706.696	-27606.699	
6417	-111712.395	-27608.239	5.903
6416	-111713.149	-27605.436	2.903
6415	-111713.476	-27604.384	1.102
6414	-111714.229	-27602.331	2.187
6413	-111715.278	-27599.865	2.680
6405	-111716.313	-27597.656	2.439
6382	-111709.261	-27596.115	7.218
6396	-111708.708	-27598.365	2.317
6381	-111706.696	-27606.699	8.573
面積	70.1193430		
地積	70.11㎡		

239

地 番	上前川三二ノ三		
N O	X	Y	辺 長
6382	-111709.261	-27596.115	
6405	-111716.313	-27597.656	7.218
6404	-111722.410	-27584.637	14.376
6403	-111722.833	-27583.732	0.999
6395	-111713.045	-27580.454	10.322
6383	-111711.864	-27585.513	5.195
6382	-111709.261	-27596.115	10.917
面積	136.6481605		
地積	136.64㎡		


240

地 番	上前川三二ノ二		
N O	X	Y	辺 長
6395	-111713.045	-27580.454	
6403	-111722.833	-27583.732	10.322
6402	-111728.622	-27571.346	13.672
6401	-111731.820	-27565.208	6.921
6400	-111732.797	-27563.408	2.048
6399	-111732.950	-27563.312	0.181
6398	-111733.706	-27559.427	3.958
6397	-111726.248	-27558.502	7.515
6386	-111719.027	-27557.868	7.249
6387	-111717.886	-27558.680	1.400
6388	-111717.781	-27559.116	0.448
6393	-111715.181	-27571.193	12.354
6394	-111714.535	-27574.068	2.947
6395	-111713.045	-27580.454	6.558
面積	325.6417960		
地積	325.64㎡		

図面の種類	画 地 面 積 求 積 表			
街区番号	54	番号	／	
町 名	上	桂	前	川 町
京 都 市 洛 西 第 二 土 地 区 画 整 理 組 合				



図面の種類	画地出来形確認測量図				
街区番号	55	1/2	番号	縮尺	1:250
町名	上桂北ノ口町				
京都市洛西第二土地区画整理組合					

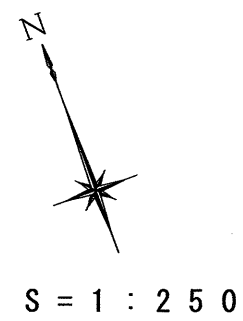

桂 上 野 西 町

43 小

400-15

410-2

400-16

X-111550

0.551

0.371

上北ノ口三ノ二

上北ノ口二八

上北ノ口三三ノ二

上北ノ口二九ノ三

400.64

266.68

660.07

573.88

67

桂
上
野
南
町

X-111550

12.114

6459

6458

12.101

2.235

6457

14.618

72.82

9299

10.395

60

5.980

13.056

6473

7.923

6466

上北ノ口二〇ノ一

上北ノ口二〇ノ二

上北ノ口二〇ノ三

上北ノ口二〇ノ七

上北ノ口二九ノ二

上北ノ口二九ノ一

上北ノ口二九ノ五

125.02

277.83

326.64

225.52

377.24

98.50

8.032

6452

5.448

6451

7.758

6450

4.348

6449

14.593

6471

5.019

6470

5.983

6461

18.584

300-3

300-8

60 A

56

X-111600

図面の種類	画地出来形確認測量図			
街区番号	5 5 _{2/2}	番号	縮 尺	1 : 2 5 0
町 名	上 桂 北 ノ 口 町			
京都市洛西第二土地区画整理組合				

X-111600

X-111600

51			
地番	保 五五ノ一号		
N O	X	Y	辺 長
6500	-111523.040	-27469.732	
6501	-111525.051	-27473.497	4.268
6502	-111543.286	-27478.937	19.029
6509	-111547.281	-27465.614	13.909
6523	-111553.786	-27443.718	22.842
6522	-111559.795	-27423.426	21.163
6495	-111538.722	-27417.165	21.983
6496	-111535.209	-27428.936	12.284
6497	-111532.112	-27439.402	10.915
6498	-111529.123	-27449.321	10.360
6500	-111523.040	-27469.732	21.298
面積	1270.7297610		
地積	1270.72㎡		

52			
地番	上北ノ口二八		
N O	X	Y	辺 長
6495	-111538.722	-27417.165	
6522	-111559.795	-27423.426	21.983
6521	-111559.999	-27422.783	0.675
6459	-111563.455	-27411.172	12.114
6458	-111565.008	-27405.975	5.424
6493	-111543.923	-27399.704	21.998
6494	-111539.171	-27415.661	16.650
6495	-111538.722	-27417.165	1.570
面積	400.6417405		
地積	400.64㎡		

53			
地番	上北ノ口三三ノ二		
N O	X	Y	辺 長
6493	-111543.923	-27399.704	
6458	-111565.008	-27405.975	21.998
6457	-111568.445	-27394.372	12.101
9293	-111566.303	-27393.735	2.235
6489	-111547.213	-27388.059	19.916
6490	-111546.653	-27390.188	2.201
6491	-111545.169	-27395.483	5.499
6492	-111544.717	-27397.039	1.620
6493	-111543.923	-27399.704	2.781
面積	266.6868650		
地積	266.68㎡		

54			
地番	上北ノ口二九ノ三		
N O	X	Y	辺 長
6489	-111547.213	-27388.059	
9293	-111566.303	-27393.735	19.916
9294	-111572.145	-27369.365	25.060
9295	-111575.580	-27370.398	3.587
6472	-111577.286	-27364.667	5.980
9296	-111569.712	-27362.445	7.893
6481	-111552.271	-27357.325	18.177
6482	-111552.247	-27357.695	0.371
6483	-111551.723	-27363.173	5.503
6484	-111551.028	-27368.633	5.504
6485	-111550.186	-27374.067	5.499
6486	-111549.155	-27379.469	5.500
6487	-111547.993	-27384.847	5.502
6488	-111547.353	-27387.526	2.754
6489	-111547.213	-27388.059	0.551
面積	660.0721435		
地積	660.07㎡		

55			
地番	上北ノ口二九ノ四		
N O	X	Y	辺 長
9293	-111566.303	-27393.735	
6457	-111568.445	-27394.372	2.235
9299	-111572.615	-27380.361	14.618
9295	-111575.580	-27370.398	10.395
9294	-111572.145	-27369.365	3.587
9293	-111566.303	-27393.735	25.060
面積	72.8230670		
地積	72.82㎡		

56			
地番	上北ノ口三一ノ一		
N O	X	Y	辺 長
6481	-111552.271	-27357.325	
9296	-111569.712	-27362.445	18.177
6469	-111576.321	-27340.252	23.156
6474	-111556.408	-27327.909	23.428
6475	-111552.442	-27330.170	4.565
6476	-111552.719	-27335.711	5.548
6477	-111552.850	-27341.201	5.492
6478	-111552.867	-27344.286	3.085
6479	-111552.806	-27346.702	2.417
6480	-111552.605	-27352.202	5.504
6481	-111552.271	-27357.325	5.134
面積	573.8837670		
地積	573.88㎡		

57			
地番	上北ノ口三二ノ一		
N O	X	Y	辺 長
9296	-111569.712	-27362.445	
6472	-111577.286	-27364.667	7.893
6473	-111581.029	-27352.159	13.056
6466	-111583.292	-27344.566	7.923
6468	-111576.806	-27340.553	7.627
6469	-111576.321	-27340.252	0.571
9296	-111569.712	-27362.445	23.156
面積	174.4589745		
地積	174.45㎡		

58			
地番	上北ノ口二九ノ五		
N O	X	Y	辺 長
6473	-111581.029	-27352.159	
9297	-111592.696	-27357.872	12.991
6465	-111596.044	-27352.455	6.368
6466	-111583.292	-27344.566	14.995
6473	-111581.029	-27352.159	7.923
面積	98.5030030		
地積	98.50㎡		

59			
地番	上北ノ口二九ノ六		
N O	X	Y	辺 長
9297	-111592.696	-27357.872	
9298	-111596.135	-27359.556	3.829
6462	-111598.963	-27354.994	5.367
6463	-111598.549	-27353.999	1.078
6464	-111596.261	-27352.589	2.688
6465	-111596.044	-27352.455	0.255
9297	-111592.696	-27357.872	6.368
面積	23.3082510		
地積	23.30㎡		

60			
地番	上北ノ口二九ノ一		
N O	X	Y	辺 長
9295	-111575.580	-27370.398	
6461	-111596.096	-27376.566	21.423
6460	-111600.418	-27358.492	18.584
6462	-111598.963	-27354.994	3.789
9298	-111596.135	-27359.556	5.367
9297	-111592.696	-27357.872	3.829
6473	-111581.029	-27352.159	12.991
6472	-111577.286	-27364.667	13.056
9295	-111575.580	-27370.398	5.980
面積	377.2486965		
地積	377.24㎡		

61			
地番	上北ノ口二九ノ二		
N O	X	Y	辺 長
9299	-111572.615	-27380.361	
6471	-111593.674	-27386.682	21.987
6470	-111594.844	-27381.801	5.019
6461	-111596.096	-27376.566	5.383
9295	-111575.580	-27370.398	21.423
9299	-111572.615	-27380.361	10.395
面積	225.5226360		
地積	225.52㎡		

62			
地番	上北ノ口二七, 上北ノ口三〇		
N O	X	Y	辺 長
6457	-111568.445	-27394.372	
6449	-111590.273	-27400.873	22.776
6471	-111593.674	-27386.682	14.593
9299	-111572.615	-27380.361	21.987
6457	-111568.445	-27394.372	14.618
面積	326.6436340		
地積	326.64㎡		

63			
地番	上北ノ口二〇ノ三		
N O	X	Y	辺 長
6458	-111565.008	-27405.975	
6451	-111587.048	-27412.537	22.996
6450	-111589.260	-27405.101	7.758
6449	-111590.273	-27400.873	4.348
6457	-111568.445	-27394.372	22.776
6458	-111565.008	-27405.975	12.101
面積	277.8354495		
地積	277.83㎡		

64			
地番	上北ノ口二〇ノ二		
N O	X	Y	辺 長
6459	-111563.455	-27411.172	
6452	-111585.495	-27417.759	23.003
6451	-111587.048	-27412.537	5.448
6458	-111565.008	-27405.975	22.996
6459	-111563.455	-27411.172	5.424
面積	125.0275785		
地積	125.02㎡		

65			
地番	上北ノ口二〇ノ一		
N O	X	Y	辺 長
6521	-111559.999	-27422.783	
6454	-111582.043	-27429.356	23.003
6453	-111583.205	-27425.458	4.068
6452	-111585.495	-27417.759	8.032
6459	-111563.455	-27411.172	23.003
6521	-111559.999	-27422.783	12.114
面積	278.5125970		
地積	278.51㎡		


66			
地番	桂上北三ノ一九		
N O	X	Y	辺 長
6523	-111553.786	-27443.718	
6456	-111575.799	-27450.293	22.974
6455	-111577.483	-27444.645	5.894
6454	-111582.043	-27429.356	15.955
6521	-111559.999	-27422.783	23.003
6522	-111559.795	-27423.426	0.675
6523	-111553.786	-27443.718	21.163
面積	502.2686235		
地積	502.26㎡		

67			
地番	保 五五ノ二号		
N O	X	Y	辺 長
6509	-111547.281	-27465.614	
6520	-111550.735	-27466.645	3.605
6519	-111554.176	-27467.668	3.590
9301	-111555.176	-27467.965	1.043
6518	-111557.623	-27468.691	2.552
6514	-111569.272	-27472.166	12.156
6515	-111571.765	-27463.818	8.712
6456	-111575.799	-27450.293	14.114
6523	-111553.786	-27443.718	22.974
6509	-111547.281	-27465.614	22.842
面積	524.2650635		
地積	524.26㎡		


68			
地番	上前川二〇ノ一四		
N O	X	Y	辺 長
6516	-111556.600	-27472.146	
6517	-111560.178	-27473.203	3.731
6513	-111568.240	-27475.618	8.416
6514	-111569.272	-27472.166	3.603
6518	-111557.623	-27468.691	12.156
6516	-111556.600	-27472.146	3.603
面積	43.7236340		
地積	43.72㎡		

69			
地番	上前川二〇ノ一五		
N O	X	Y	辺 長
9300	-111558.817	-27477.754	
6512	-111566.880	-27480.173	8.418
6513	-111568.240	-27475.618	4.754
6517	-111560.178	-27473.203	8.416
9300	-111558.817	-27477.754	4.750
面積	39.9968910		
地積	39.99㎡		

70			
地番	上前川二〇ノ一六		
N O	X	Y	辺長
6508	-111557.220	-27483.092	
6510	-111562.402	-27484.637	5.407
6511	-111566.144	-27482.637	4.243
6512	-111566.880	-27480.173	2.572
9300	-111558.817	-27477.754	8.418
6508	-111557.220	-27483.092	5.572
面積	42.3513415		
地積	42.35 m ²		

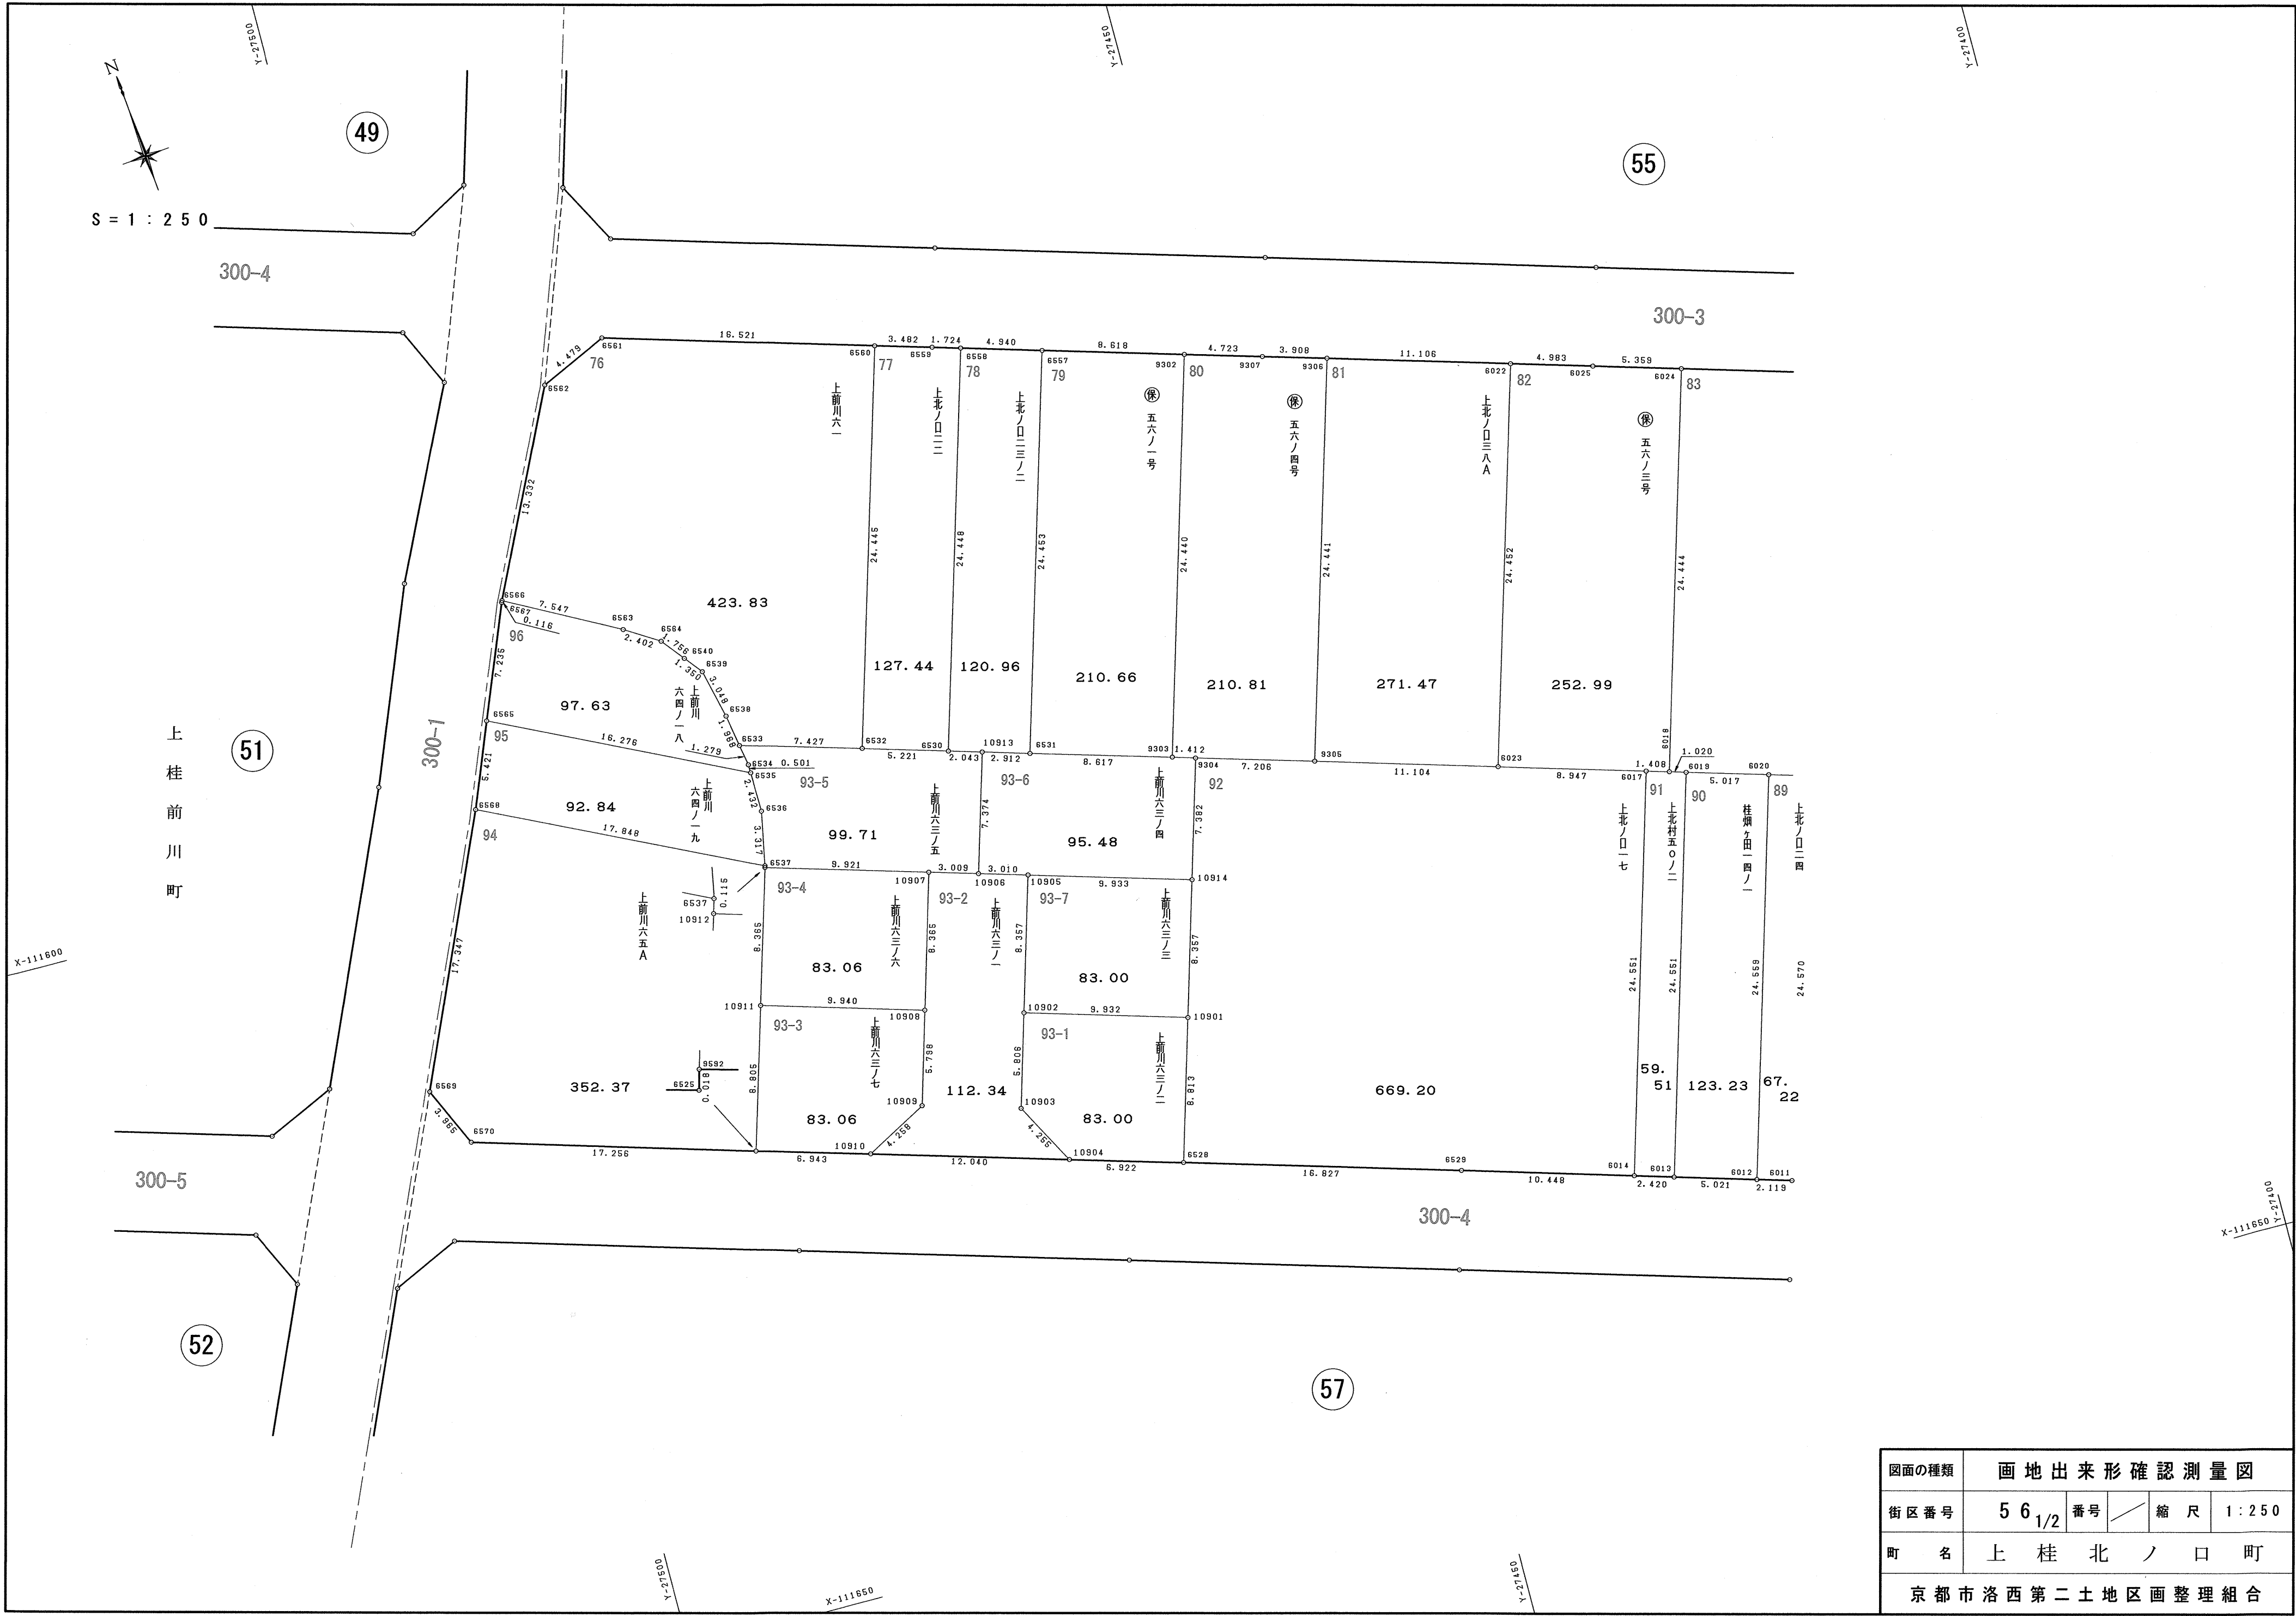

図面の種類	画地出来形確認測量図				
街区番号	5 6 1/2	番号		縮尺	1 : 250
町名	上 桂 北 ノ 口 町				
京都市洛西第二土地区画整理組合					

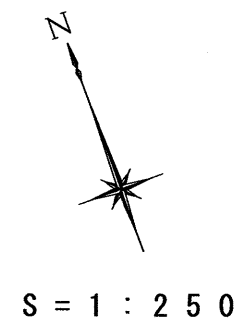

桂
上
野
南
町



図面の種類	画地出来形確認測量図				
街区番号	56	2/2	番号	縮尺	1:250
町名	上桂北ノ口町				
京都市洛西第二土地区画整理組合					

76			
地番	上前川六一		
N O	X	Y	辺長
6561	-111571.821	-27484.699	
6562	-111573.695	-27488.767	4.479
6566	-111585.664	-27494.640	13.332
6563	-111589.236	-27487.992	7.547
6564	-111590.513	-27485.958	2.402
6540	-111591.887	-27484.864	1.756
6539	-111592.941	-27484.020	1.350
6538	-111595.909	-27483.327	3.048
6533	-111597.849	-27482.999	1.968
6532	-111599.953	-27475.876	7.427
6560	-111576.535	-27468.865	24.445
6561	-111571.821	-27484.699	16.521
面積	423.8341935		
地積	423.83㎡		

77			
地番	上北ノ口二二		
N O	X	Y	辺長
6560	-111576.535	-27468.865	
6532	-111599.953	-27475.876	24.445
6530	-111601.446	-27470.873	5.221
6558	-111578.021	-27463.876	24.448
6559	-111577.529	-27465.528	1.724
6560	-111576.535	-27468.865	3.482
面積	127.4461300		
地積	127.44㎡		

78			
地番	上北ノ口二三ノ二		
N O	X	Y	辺長
6558	-111578.021	-27463.876	
6530	-111601.446	-27470.873	24.448
10913	-111602.031	-27468.916	2.043
6531	-111602.864	-27466.126	2.912
6557	-111579.430	-27459.141	24.453
6558	-111578.021	-27463.876	4.940
面積	120.9620225		
地積	120.96㎡		

79			
地番	保五六ノ一号		
N O	X	Y	辺長
6557	-111579.430	-27459.141	
6531	-111602.864	-27466.126	24.453
9303	-111605.309	-27457.863	8.617
9302	-111581.888	-27450.881	24.440
6557	-111579.430	-27459.141	8.618
面積	210.6663415		
地積	210.66㎡		

80			
地番	保五六ノ四号		
N O	X	Y	辺長
9302	-111581.888	-27450.881	
9303	-111605.309	-27457.863	24.440
9304	-111605.716	-27456.511	1.412
9305	-111607.768	-27449.603	7.206
9306	-111584.349	-27442.608	24.441
9307	-111583.235	-27446.354	3.908
9302	-111581.888	-27450.881	4.723
面積	210.8103740		
地積	210.81㎡		

81			
地番	上北ノ口三八A		
N O	X	Y	辺長
9306	-111584.349	-27442.608	
9305	-111607.768	-27449.603	24.441
6023	-111610.944	-27438.963	11.104
6022	-111587.515	-27431.963	24.452
9306	-111584.349	-27442.608	11.106
面積	271.4789925		
地積	271.47㎡		

82			
地番	保五六ノ三号		
N O	X	Y	辺長
6022	-111587.515	-27431.963	
6023	-111610.944	-27438.963	24.452
6017	-111613.487	-27430.385	8.947
6018	-111613.890	-27429.036	1.408
6024	-111590.465	-27422.051	24.444
6025	-111588.935	-27427.187	5.359
6022	-111587.515	-27431.963	4.983
面積	252.9918830		
地積	252.99㎡		

83			
地番	上北ノ口三三ノ一		
N O	X	Y	辺長
6024	-111590.465	-27422.051	
6018	-111613.890	-27429.036	24.444
6019	-111614.182	-27428.059	1.020
6020	-111615.610	-27423.250	5.017
6021	-111616.383	-27420.623	2.738
6027	-111618.937	-27412.035	8.960
6556	-111619.452	-27410.353	1.759
6554	-111595.854	-27403.331	24.621
6555	-111595.080	-27406.565	3.325
6024	-111590.465	-27422.051	16.159
面積	476.4343860		
地積	476.43㎡		

84			
地番	上北ノ口一八		
N O	X	Y	辺長
6554	-111595.854	-27403.331	
6556	-111619.452	-27410.353	24.621
6549	-111623.801	-27395.766	15.222
6548	-111626.063	-27388.152	7.943
6552	-111601.254	-27380.769	25.884
6553	-111600.688	-27383.137	2.435
6554	-111595.854	-27403.331	20.765
面積	585.0154410		
地積	585.01㎡		

85			
地番	上北ノ口二五A		
N O	X	Y	辺長
6552	-111601.254	-27380.769	
6548	-111626.063	-27388.152	25.884
6546	-111630.383	-27373.650	15.132
6547	-111617.515	-27365.728	15.111
6550	-111609.000	-27360.474	10.005
6551	-111605.797	-27361.771	3.456
6552	-111601.254	-27380.769	19.534
面積	491.2548200		
地積	491.25㎡		

86			
地番	上北ノ口一ノ二		
N O	X	Y	辺長
6549	-111623.801	-27395.766	
6542	-111647.334	-27402.778	24.555
6543	-111651.174	-27389.886	13.452
6544	-111649.484	-27385.427	4.769
6545	-111634.546	-27376.213	17.551
6546	-111630.383	-27373.650	4.889
6548	-111626.063	-27388.152	15.132
6549	-111623.801	-27395.766	7.943
面積	481.2107985		
地積	481.21㎡		

87			
地番	上北ノ口二三ノ一		
N O	X	Y	辺長
6027	-111618.937	-27412.035	
6026	-111642.492	-27419.035	24.573
6541	-111645.464	-27409.057	10.411
6542	-111647.334	-27402.778	6.552
6549	-111623.801	-27395.766	24.555
6556	-111619.452	-27410.353	15.222
6027	-111618.937	-27412.035	1.759
面積	416.7987105		
地積	416.79㎡		

88			
地番	保五六ノ二号		
N O	X	Y	辺長
6010	-111639.935	-27427.621	
6026	-111642.492	-27419.035	8.959
6027	-111618.937	-27412.035	24.573
6021	-111616.383	-27420.623	8.960
6010	-111639.935	-27427.621	24.570
面積	220.1398490		
地積	220.13㎡		

89			
地番	上北ノ口二四		
N O	X	Y	辺長
6020	-111615.610	-27423.250	
6012	-111639.153	-27430.242	24.559
6011	-111639.759	-27428.212	2.119
6010	-111639.935	-27427.621	0.617
6021	-111616.383	-27420.623	24.570
6020	-111615.610	-27423.250	2.738
面積	67.2276855		
地積	67.22㎡		

90			
地番	桂畑ヶ田一四ノ一		
N O	X	Y	辺長
6019	-111614.182	-27428.059	
6013	-111637.716	-27435.053	24.551
6012	-111639.153	-27430.242	5.021
6020	-111615.610	-27423.250	24.559
6019	-111614.182	-27428.059	5.017
面積	123.2376575		
地積	123.23㎡		


91			
地番	上北村五〇ノ二		
N O	X	Y	辺長
6017	-111613.487	-27430.385	
6014	-111637.023	-27437.372	24.551
6013	-111637.716	-27435.053	2.420
6019	-111614.182	-27428.059	24.551
6018	-111613.890	-27429.036	1.020
6017	-111613.487	-27430.385	1.408
面積	59.5115330		
地積	59.51㎡		

92			
地番	上北ノ口一七		
N O	X	Y	辺長
9304	-111605.716	-27456.511	
10914	-111612.791	-27458.617	7.382
10901	-111620.801	-27461.001	8.357
6528	-111629.248	-27463.515	8.813
6529	-111634.033	-27447.383	16.827
6014	-111637.023	-27437.372	10.448
6017	-111613.487	-27430.385	24.551
6023	-111610.944	-27438.963	8.947
9305	-111607.768	-27449.603	11.104
9304	-111605.716	-27456.511	7.206
面積	669.2047760		
地積	669.20㎡		

93-1			
地番	上前川六三ノ二		
N O	X	Y	辺長
6528	-111629.248	-27463.515	
10901	-111620.801	-27461.001	8.813
10902	-111617.966	-27470.520	9.932
10903	-111623.531	-27472.175	5.806
10904	-111627.273	-27470.149	4.255
6528	-111629.248	-27463.515	6.922
面積	83.0058980		
地積	83.00㎡		

93-2			
地番	上前川六三ノ一		
N O	X	Y	辺長
10903	-111623.531	-27472.175	
10902	-111617.966	-27470.520	5.806
10905	-111609.956	-27468.137	8.357
10906	-111609.098	-27471.022	3.010
10907	-111608.240	-27473.906	3.009
10908	-111616.259	-27476.288	8.365
10909	-111621.817	-27477.939	5.798
10910	-111623.836	-27481.688	4.258
10904	-111627.273	-27470.149	12.040
10903	-111623.531	-27472.175	4.255
面積	112.3433675		
地積	112.34㎡		

93-3			
地番	上前川六三ノ七		
N O	X	Y	辺長
10909	-111621.817	-27477.939	
10908	-111616.259	-27476.288	5.798
10911	-111613.421	-27485.814	9.940
9592	-111621.855	-27488.342	8.805
10910	-111623.836	-27481.688	6.943
10909	-111621.817	-27477.939	4.258
面積	83.0675395		
地積	83.06㎡		

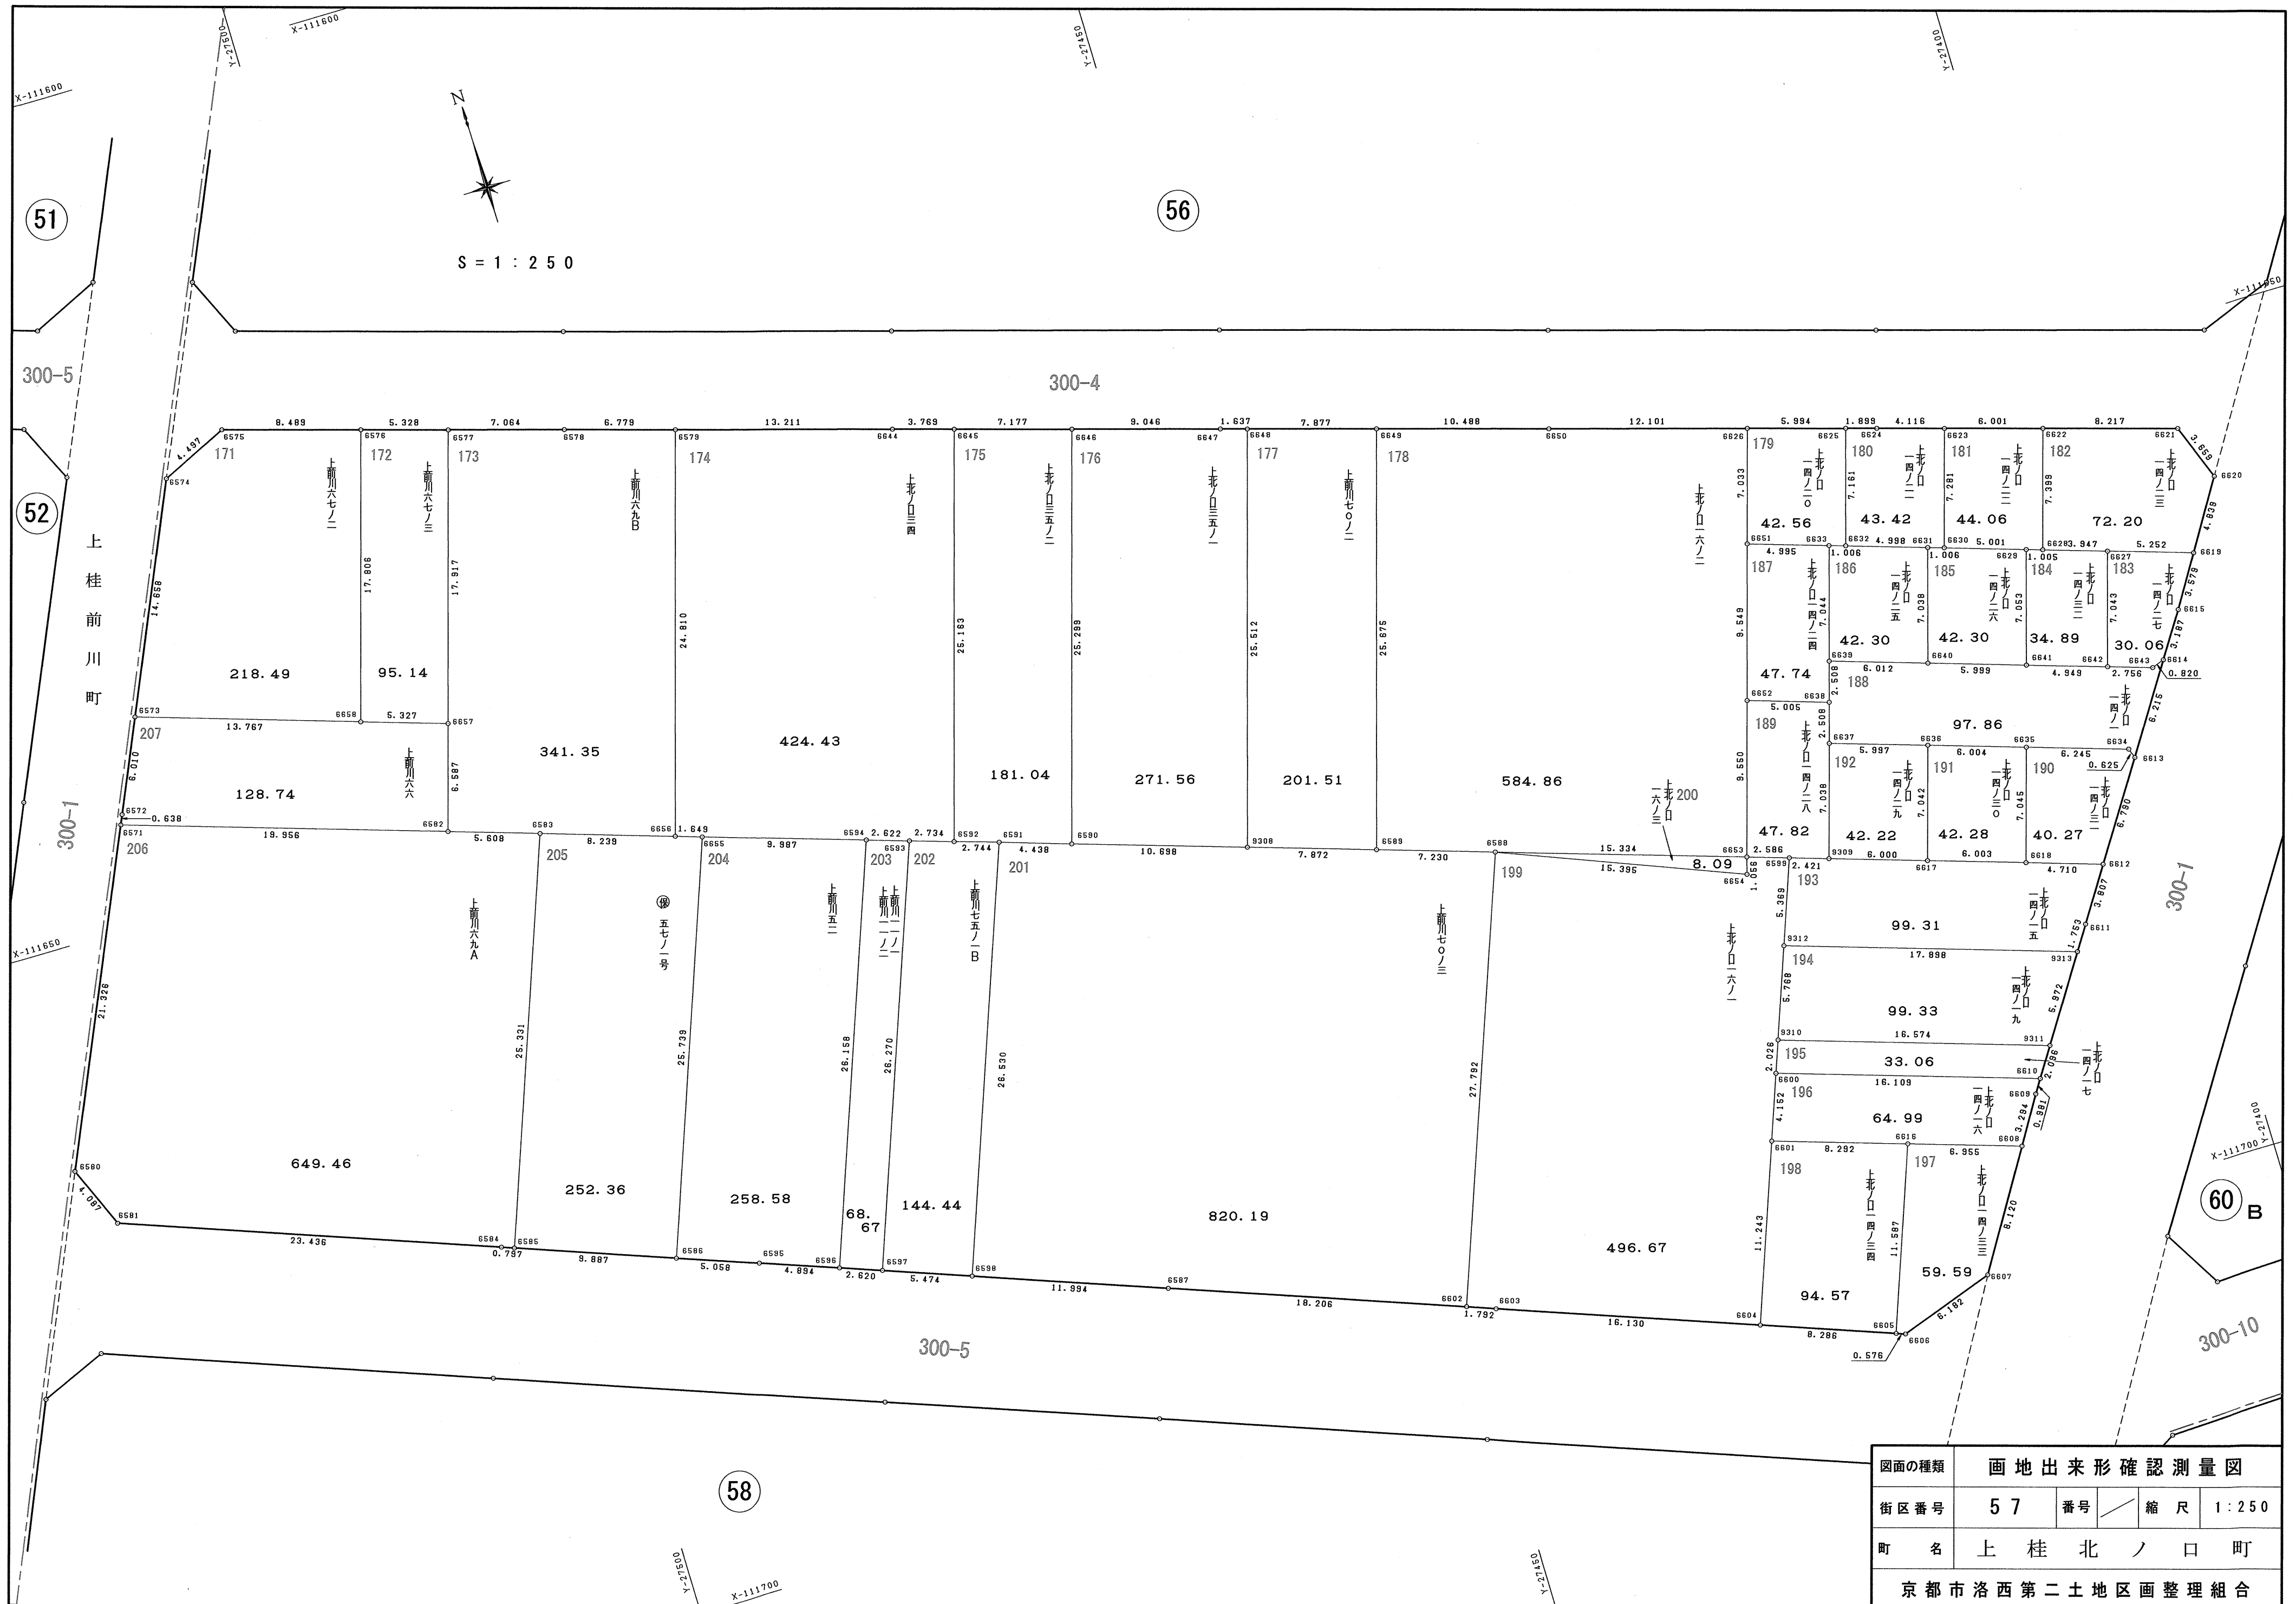

図面の種類	画地出来形確認測量図				
街区番号	57	番号	／	縮尺	1:250
町名	上桂北ノ口町				
京都市洛西第二土地区画整理組合					

171

地番	上前川六七ノ二		
N O	X	Y	辺長
6575	-111622.467	-27507.387	
6574	-111624.355	-27511.468	4.497
6573	-111637.739	-27517.446	14.658
6658	-111641.944	-27504.337	13.767
6576	-111624.881	-27499.248	17.806
6575	-111622.467	-27507.387	8.489
面積	218.4964930		
地積	218.49 ㎡		

172

地番	上前川六七ノ三		
N O	X	Y	辺長
6576	-111624.881	-27499.248	
6658	-111641.944	-27504.337	17.806
6657	-111643.565	-27499.263	5.327
6577	-111626.396	-27494.140	17.917
6576	-111624.881	-27499.248	5.328
面積	95.1437640		
地積	95.14 ㎡		

173

地番	上前川六九B		
N O	X	Y	辺長
6577	-111626.396	-27494.140	
6657	-111643.565	-27499.263	17.917
6582	-111649.877	-27501.147	6.587
6583	-111651.594	-27495.808	5.608
6656	-111654.113	-27487.964	8.239
6579	-111630.339	-27480.871	24.810
6578	-111628.405	-27487.368	6.779
6577	-111626.396	-27494.140	7.064
面積	341.3551710		
地積	341.35㎡		

174

地番	上北ノ口三四		
N O	X	Y	辺長
6579	-111630.339	-27480.871	
6656	-111654.113	-27487.964	24.810
6655	-111654.618	-27486.394	1.649
6594	-111657.669	-27476.884	9.987
6593	-111658.469	-27474.387	2.622
6592	-111659.301	-27471.783	2.734
6645	-111635.186	-27464.598	25.163
6644	-111634.107	-27468.209	3.769
6579	-111630.339	-27480.871	13.211
面積	424.4327450		
地積	424.43㎡		

175

地番	上北ノ口三五ノ二		
N O	X	Y	辺長
6645	-111635.186	-27464.598	
6592	-111659.301	-27471.783	25.163
6591	-111660.114	-27469.162	2.744
6590	-111661.487	-27464.942	4.438
6646	-111637.240	-27457.721	25.299
6645	-111635.186	-27464.598	7.177
面積	181.0439525		
地積	181.04㎡		

176			
地番	上北ノ口三五ノ一		
N O	X	Y	辺長
6646	-111637.240	-27457.721	
6590	-111661.487	-27464.942	25.299
9308	-111664.750	-27454.754	10.698
6648	-111640.296	-27447.484	25.512
6647	-111639.829	-27449.053	1.637
6646	-111637.240	-27457.721	9.046
面積	271.5645460		
地積	271.56㎡		

177

地番	上前川七〇ノ二		
N O	X	Y	辺長
6648	-111640.296	-27447.484	
9308	-111664.750	-27454.754	25.512
6589	-111667.151	-27447.257	7.872
6649	-111642.543	-27439.934	25.675
6648	-111640.296	-27447.484	7.877
面積	201.5160445		
地積	201.51 m ²		

178

地番	上北ノ口一六ノ二		
N O	X	Y	辺長
6649	-111642.543	-27439.934	
6589	-111667.151	-27447.257	25.675
6588	-111669.359	-27440.372	7.230
6653	-111674.015	-27425.762	15.334
6652	-111664.867	-27423.020	9.550
6651	-111655.715	-27420.296	9.549
6626	-111648.977	-27418.281	7.033
6650	-111645.534	-27429.882	12.101
6649	-111642.543	-27439.934	10.488
面積	584.8692025		
地積	584.86㎡		

179

地番	上北ノ口一四ノ二〇		
N O	X	Y	辺長
6626	-111648.977	-27418.281	
6651	-111655.715	-27420.296	7.033
6633	-111657.241	-27415.540	4.995
6632	-111657.545	-27414.581	1.006
6625	-111650.683	-27412.535	7.161
6626	-111648.977	-27418.281	5.994
面積	42.5661290		
地積	42.56㎡		

180

地 番	上北ノ口一四ノ二一		
N O	X	Y	辺 長
6625	-111650.683	-27412.535	
6632	-111657.545	-27414.581	7.161
6631	-111659.076	-27409.823	4.998
6630	-111659.374	-27408.862	1.006
6623	-111652.400	-27406.770	7.281
6624	-111651.223	-27410.714	4.116
6625	-111650.683	-27412.535	1.899
面積	43.4249750		
地積	43.42㎡		

181

地番	上北ノ口一四ノ二二		
N O	X	Y	辺長
6623	-111652.400	-27406.770	
6630	-111659.374	-27408.862	7.281
6629	-111660.901	-27404.100	5.001
6628	-111661.205	-27403.142	1.005
6622	-111654.117	-27401.020	7.399
6623	-111652.400	-27406.770	6.001
面積	44.0682120		
地積	44.06㎡		

182

地 番	上北ノ口一四ノ二三		
N O	X	Y	辺 長
6622	-111654.117	-27401.020	
6628	-111661.205	-27403.142	7.399
6627	-111662.412	-27399.384	3.947
6619	-111664.010	-27394.381	5.252
6620	-111659.888	-27391.846	4.839
6621	-111656.468	-27393.146	3.659
6622	-111654.117	-27401.020	8.217
面 積	72.2005040		
地 積	72.20 ㎡		

183

地 番	上北ノ口一四ノ二七		
N O	X	Y	辺 長
6627	-111662.412	-27399.384	
6642	-111669.164	-27401.389	7.043
6643	-111670.007	-27398.765	2.756
6614	-111669.732	-27397.992	0.820
6615	-111667.059	-27396.256	3.187
6619	-111664.010	-27394.381	3.579
6627	-111662.412	-27399.384	5.252
面 積	30.0636780		
地 積	30.06 ㎡		

184

地番	上北ノ口一四ノ三二		
N O	X	Y	辺長
6629	-111660.901	-27404.100	
6641	-111667.663	-27406.105	7.053
6642	-111669.164	-27401.389	4.949
6627	-111662.412	-27399.384	7.043
6628	-111661.205	-27403.142	3.947
6629	-111660.901	-27404.100	1.005
面積	34.8924790		
地積	34.89㎡		

185

地番	上北ノ口一四ノ二六		
N O	X	Y	辺長
6631	-111659.076	-27409.823	
6640	-111665.826	-27411.816	7.038
6641	-111667.663	-27406.105	5.999
6629	-111660.901	-27404.100	7.053
6630	-111659.374	-27408.862	5.001
6631	-111659.076	-27409.823	1.006
面積	42.3084065		
地積	42.30㎡		

186			
地番	上北ノ口一四ノ二五		
N O	X	Y	辺長
6633	-111657.241	-27415.540	
6639	-111663.995	-27417.542	7.044
6640	-111665.826	-27411.816	6.012
6631	-111659.076	-27409.823	7.038
6632	-111657.545	-27414.581	4.998
6633	-111657.241	-27415.540	1.006
面積	42.3038840		
地積	42.30 m ²		

187			
地番	上北ノ口一四ノ二四		
N O	X	Y	辺長
6651	-111655.715	-27420.296	
6652	-111664.867	-27423.020	9.549
6638	-111666.399	-27418.255	5.005
6639	-111663.995	-27417.542	2.508
6633	-111657.241	-27415.540	7.044
6651	-111655.715	-27420.296	4.995
面積	47.7418900		
地積	47.74 ㎡		

188			
地番	上北ノ口一四ノ一		
N O	X	Y	辺長
6639	-111663.995	-27417.542	
6638	-111666.399	-27418.255	2.508
6637	-111668.803	-27418.968	2.508
6636	-111670.628	-27413.255	5.997
6635	-111672.454	-27407.535	6.004
6634	-111674.355	-27401.586	6.245
6613	-111674.944	-27401.378	0.625
6614	-111669.732	-27397.992	6.215
6643	-111670.007	-27398.765	0.820
6642	-111669.164	-27401.389	2.756
6641	-111667.663	-27406.105	4.949
6640	-111665.826	-27411.816	5.999
6639	-111663.995	-27417.542	6.012
面積	97.8662280		
地積	97.86㎡		

189

地番	上北ノ口一四ノ二八		
N O	X	Y	辺長
6652	-111664.867	-27423.020	
6653	-111674.015	-27425.762	9.550
6599	-111674.805	-27423.300	2.586
9309	-111675.543	-27420.994	2.421
6637	-111668.803	-27418.968	7.038
6638	-111666.399	-27418.255	2.508
6652	-111664.867	-27423.020	5.005
面積	47.8222080		
地積	47.82㎡		

190

地番	上北ノ口一四ノ三一		
N O	X	Y	辺長
6635	-111672.454	-27407.535	
6618	-111679.201	-27409.562	7.045
6612	-111680.638	-27405.077	4.710
6613	-111674.944	-27401.378	6.790
6634	-111674.355	-27401.586	0.625
6635	-111672.454	-27407.535	6.245
面積	40.2750575		
地積	40.27㎡		

191			
地番	上北ノ口一四ノ三〇		
N O	X	Y	辺長
6636	-111670.628	-27413.255	
6617	-111677.373	-27415.280	7.042
6618	-111679.201	-27409.562	6.003
6635	-111672.454	-27407.535	7.045
6636	-111670.628	-27413.255	6.004
面積	42.2818760		
地積	42.28 m ²		

200

地番	上北ノロ一六ノ三		
N O	X	Y	辺長
6588	-111669.359	-27440.372	
6654	-111675.028	-27426.059	15.395
6653	-111674.015	-27425.762	1.056
6588	-111669.359	-27440.372	15.334
面積	8.0913810		
地積	8.09㎡		

201

地番	上前川七〇ノ三		
N O	X	Y	辺長
6591	-111660.114	-27469.162	
6598	-111685.016	-27478.313	26.530
6587	-111689.157	-27467.057	11.994
6602	-111695.441	-27449.970	18.206
6588	-111669.359	-27440.372	27.792
6589	-111667.151	-27447.257	7.230
9308	-111664.750	-27454.754	7.872
6590	-111661.487	-27464.942	10.698
6591	-111660.114	-27469.162	4.438
面積	820.1955805		
地積	820.19㎡		

202

地番	上前川七五ノ一B		
N O	X	Y	辺長
6593	-111658.469	-27474.387	
6597	-111683.126	-27483.450	26.270
6598	-111685.016	-27478.313	5.474
6591	-111660.114	-27469.162	26.530
6592	-111659.301	-27471.783	2.744
6593	-111658.469	-27474.387	2.734
面積	144.4474020		
地積	144.44㎡		

203

地番	上前川一一ノ一，上前川一一ノ二		
N O	X	Y	辺長
6594	-111657.669	-27476.884	
6596	-111682.221	-27485.909	26.158
6597	-111683.126	-27483.450	2.620
6593	-111658.469	-27474.387	26.270
6594	-111657.669	-27476.884	2.622
面積	68.6799610		
地積	68.67㎡		

204

地番	上前川五二		
N O	X	Y	辺長
6655	-111654.618	-27486.394	
6586	-111678.786	-27495.249	25.739
6595	-111680.531	-27490.502	5.058
6596	-111682.221	-27485.909	4.894
6594	-111657.669	-27476.884	26.158
6655	-111654.618	-27486.394	9.987
面積	258.5815975		
地積	258.58㎡		

205

地番	保五七ノ一号		
N O	X	Y	辺長
6583	-111651.594	-27495.808	
6585	-111675.376	-27504.529	25.331
6586	-111678.786	-27495.249	9.887
6655	-111654.618	-27486.394	25.739
6656	-111654.113	-27487.964	1.649
6583	-111651.594	-27495.808	8.239
面積	252.3685160		
地積	252.36㎡		

206

地番	上前川六九A		
N O	X	Y	辺長
6571	-111643.808	-27520.158	
6580	-111663.271	-27528.876	21.326
6581	-111667.034	-27527.281	4.087
6584	-111675.101	-27505.277	23.436
6585	-111675.376	-27504.529	0.797
6583	-111651.594	-27495.808	25.331
6582	-111649.877	-27501.147	5.608
6571	-111643.808	-27520.158	19.956
面積	649.4616275		
地積	649.46㎡		




207

地番	上前川六六		
N O	X	Y	辺長
6573	-111637.739	-27517.446	
6572	-111643.226	-27519.897	6.010
6571	-111643.808	-27520.158	0.638
6582	-111649.877	-27501.147	19.956
6657	-111643.565	-27499.263	6.587
6658	-111641.944	-27504.337	5.327
6573	-111637.739	-27517.446	13.767
面積	128.7460305		
地積	128.74㎡		

図面の種類	画 地 面 積 求 積 表			
街 区 番 号	57	番 号	$\frac{2}{2}$	
町 名	上 桂 北 ノ 口 町			
京 都 市 洛 西 第 二 土 地 区 画 整 理 組 合				



図面の種類	画地出来形確認測量図				
街区番号	58	1/2	番号		縮尺 1:250
町名	上桂北ノ口町				
京都市洛西第二土地区画整理組合					

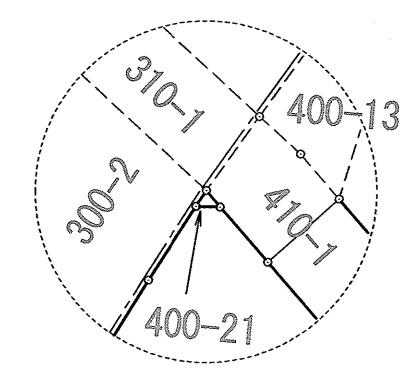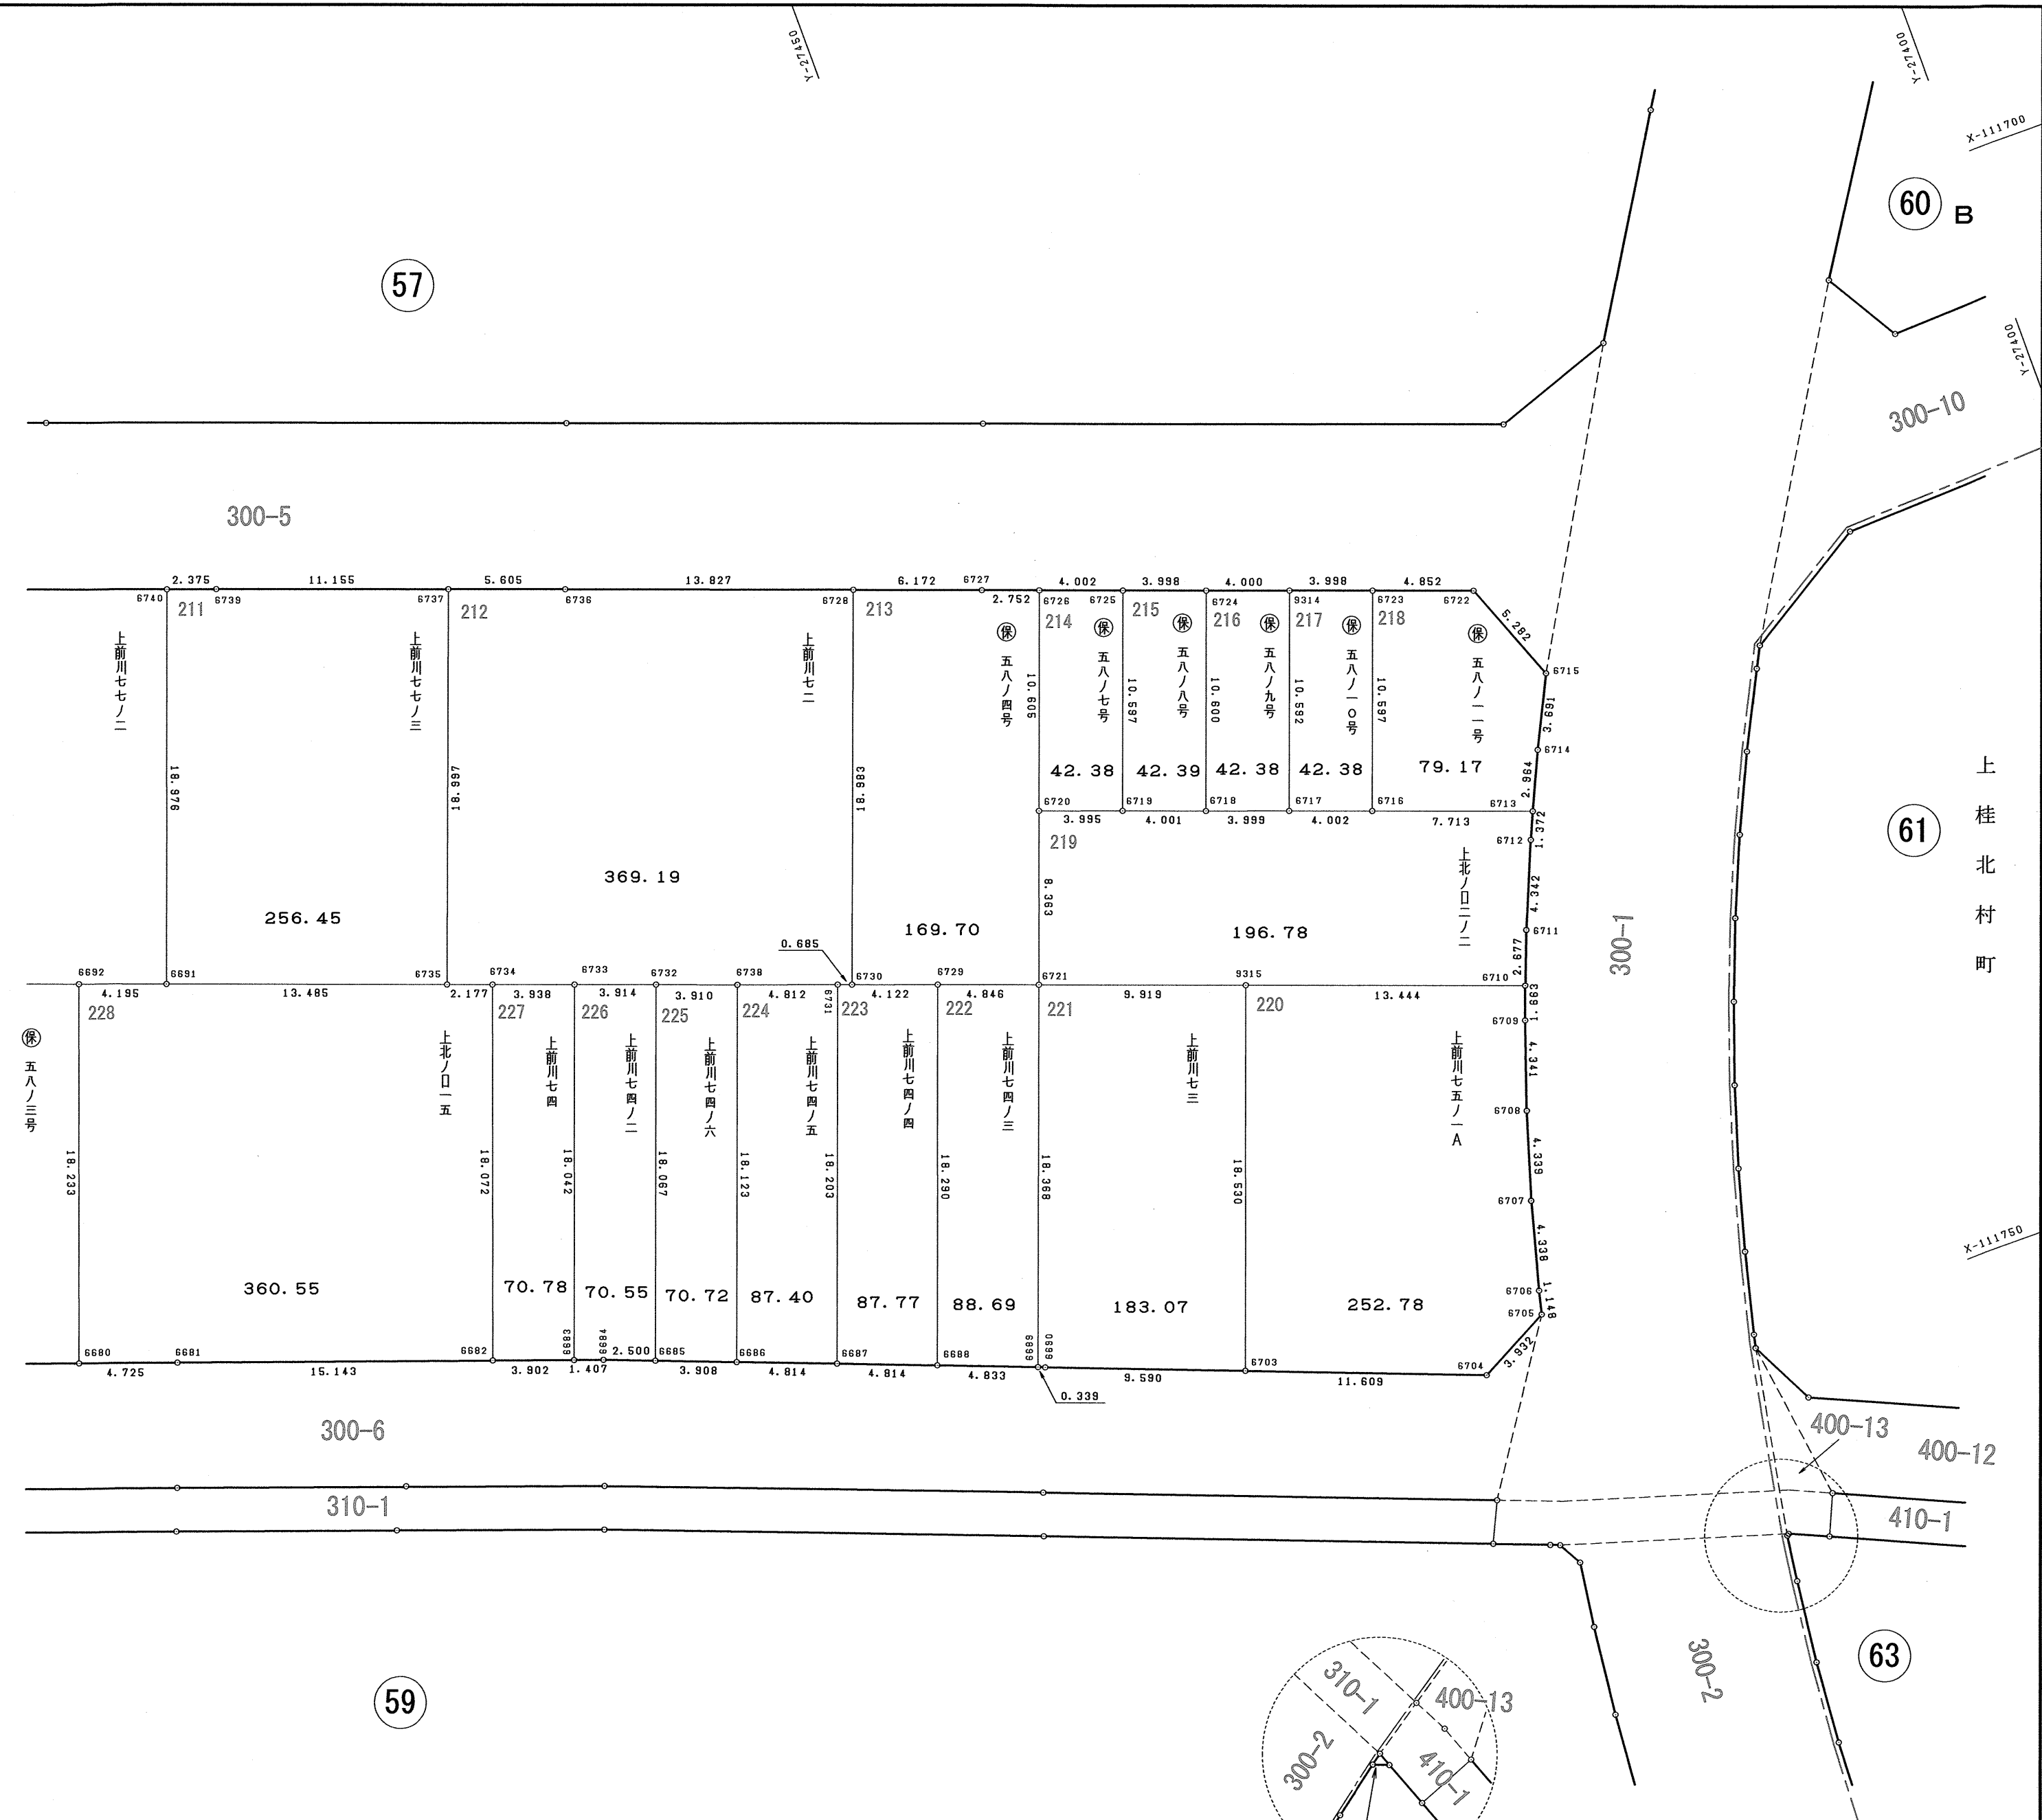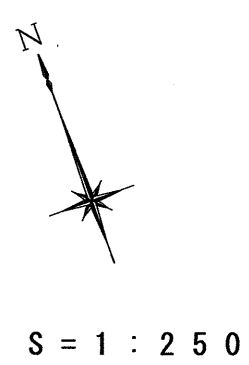

図面の種類	画地出来形確認測量図				
街区番号	58	2/2	番号	縮尺	1 : 250
町名	上桂北ノ口町				
京都市洛西第二土地区画整理組合					

208

地番	保 五八ノ一号		
N O	X	Y	辺 長
6662	-111674.370	-27530.512	
6663	-111676.083	-27534.540	4.377
6664	-111681.984	-27537.113	6.438
6700	-111685.233	-27528.347	9.349
6661	-111676.360	-27525.097	9.449
6662	-111674.370	-27530.512	5.769
面積	81.0337235		
地積	81.03 ㎡		

209

地番	上前川七七ノ一		
N O	X	Y	辺 長
6661	-111676.360	-27525.097	
6700	-111685.233	-27528.347	9.449
6701	-111689.778	-27530.015	4.841
6702	-111694.196	-27531.633	4.705
6695	-111694.756	-27530.041	1.688
6696	-111697.532	-27522.503	8.033
6697	-111699.015	-27518.467	4.300
6660	-111681.202	-27511.923	18.977
6661	-111676.360	-27525.097	14.036
面積	266.1974750		
地積	266.19 ㎡		

210

地番	上前川七七ノ二		
N O	X	Y	辺 長
6660	-111681.202	-27511.923	
6697	-111699.015	-27518.467	18.977
6698	-111699.557	-27516.986	1.577
6699	-111703.665	-27505.770	11.945
6692	-111706.414	-27498.279	7.979
6691	-111707.864	-27494.343	4.195
6740	-111690.047	-27487.814	18.976
6659	-111682.629	-27508.041	21.544
6660	-111681.202	-27511.923	4.136
面積	487.3172790		
地積	487.31㎡		

211

地 番	上前川七七ノ三		
N O	X	Y	辺 長
6740	-111690.047	-27487.814	
6691	-111707.864	-27494.343	18.976
6735	-111712.524	-27481.689	13.485
6737	-111694.703	-27475.110	18.997
6739	-111690.865	-27485.584	11.155
6740	-111690.047	-27487.814	2.375
面 積	256.4511370		
地 積	256.45 ㎡		

212			
地番	上前川七二		
N O	X	Y	辺長
6737	-111694.703	-27475.110	
6735	-111712.524	-27481.689	18.997
6734	-111713.275	-27479.646	2.177
6733	-111714.633	-27475.950	3.938
6732	-111715.985	-27472.277	3.914
6738	-111717.338	-27468.609	3.910
6731	-111718.993	-27464.091	4.812
6730	-111719.224	-27463.446	0.685
6728	-111701.415	-27456.874	18.983
6736	-111696.631	-27469.847	13.827
6737	-111694.703	-27475.110	5.605
面積	369.1944505		
地積	369.19 ㎡		

213			
地番	保 五八ノ四号		
N O	X	Y	辺 長
6728	-111701.415	-27456.874	
6730	-111719.224	-27463.446	18.983
6729	-111720.639	-27459.575	4.122
6721	-111722.308	-27455.025	4.846
6720	-111714.455	-27452.150	8.363
6726	-111704.498	-27448.499	10.605
6727	-111703.551	-27451.083	2.752
6728	-111701.415	-27456.874	6.172
面積	169.7066605		
地積	169.70 ㎡		

214

地番	保 五八ノ七号		
N O	X	Y	辺 長
6726	-111704.498	-27448.499	
6720	-111714.455	-27452.150	10.605
6719	-111715.823	-27448.397	3.995
6725	-111705.876	-27444.742	10.597
6726	-111704.498	-27448.499	4.002
面積	42.3853290		
地積	42.38 ㎡		

215

地番	保 五八ノ八号		
N O	X	Y	辺 長
6725	-111705.876	-27444.742	
6719	-111715.823	-27448.397	10.597
6718	-111717.203	-27444.641	4.001
6724	-111707.252	-27440.988	10.600
6725	-111705.876	-27444.742	3.998
面積	42.3937070		
地積	42.39 ㎡		

216

地番	保 五八ノ九号		
N O	X	Y	辺 長
6724	-111707.252	-27440.988	
6718	-111717.203	-27444.641	10.600
6717	-111718.572	-27440.884	3.999
9314	-111708.629	-27437.232	10.592
6724	-111707.252	-27440.988	4.000
面積	42.3807880		
地積	42.38 ㎡		

217

地番	保 五八ノ一〇号		
N O	X	Y	辺 長
9314	-111708.629	-27437.232	
6717	-111718.572	-27440.884	10.592
6716	-111719.954	-27437.128	4.002
6723	-111710.005	-27433.478	10.597
9314	-111708.629	-27437.232	3.998
面積	42.3819590		
地積	42.38 ㎡		

218			
地番	保 五八ノ一 一 号		
N O	X	Y	辺 長
6723	-111710.005	-27433.478	
6716	-111719.954	-27437.128	10.597
6713	-111722.611	-27429.887	7.713
6714	-111719.913	-27428.659	2.964
6715	-111716.604	-27427.023	3.691
6722	-111711.675	-27428.922	5.282
6723	-111710.005	-27433.478	4.852
面積	79.1740990		
地積	79.17 ㎡		

219

地 番	上北ノ口二ノ二		
N O	X	Y	辺 長
6720	-111714.455	-27452.150	
6721	-111722.308	-27455.025	8.363
9315	-111725.728	-27445.714	9.919
6710	-111730.363	-27433.094	13.444
6711	-111727.864	-27432.135	2.677
6712	-111723.860	-27430.455	4.342
6713	-111722.611	-27429.887	1.372
6716	-111719.954	-27437.128	7.713
6717	-111718.572	-27440.884	4.002
6718	-111717.203	-27444.641	3.999
6719	-111715.823	-27448.397	4.001
6720	-111714.455	-27452.150	3.995
面積	196.7835230		
地積	196.78 ㎡		

220

地 番	上前川七五ノ一A		
N O	X	Y	辺 長
9315	-111725.728	-27445.714	
6703	-111743.122	-27452.101	18.530
6704	-111747.302	-27441.271	11.609
6705	-111745.469	-27437.792	3.932
6706	-111744.353	-27437.521	1.148
6707	-111740.167	-27436.382	4.338
6708	-111736.020	-27435.106	4.339
6709	-111731.916	-27433.690	4.341
6710	-111730.363	-27433.094	1.663
9315	-111725.728	-27445.714	13.444
面積	252.7845865		
地積	252.78 ㎡		

221

地番	上前川七三		
N O	X	Y	辺長
6721	-111722.308	-27455.025	
6689	-111739.547	-27461.364	18.368
6690	-111739.669	-27461.048	0.339
6703	-111743.122	-27452.101	9.590
9315	-111725.728	-27445.714	18.530
6721	-111722.308	-27455.025	9.919
面積	183.0731210		
地積	183.07 ㎡		

222			
地番	上前川七四ノ三		
N O	X	Y	辺長
6729	-111720.639	-27459.575	
6688	-111737.810	-27465.874	18.290
6689	-111739.547	-27461.364	4.833
6721	-111722.308	-27455.025	18.368
6729	-111720.639	-27459.575	4.846
面積	88.6999070		
地積	88.69 ㎡		

223			
地番	上前川七四ノ四		
N O	X	Y	辺長
6731	-111718.993	-27464.091	
6687	-111736.080	-27470.366	18.203
6688	-111737.810	-27465.874	4.814
6729	-111720.639	-27459.575	18.290
6730	-111719.224	-27463.446	4.122
6731	-111718.993	-27464.091	0.685
面積	87.7707090		
地積	87.77 ㎡		

224			
地番	上前川七四ノ五		
N O	X	Y	辺長
6738	-111717.338	-27468.609	
6686	-111734.350	-27474.858	18.123
6687	-111736.080	-27470.366	4.814
6731	-111718.993	-27464.091	18.203
6738	-111717.338	-27468.609	4.812
面積	87.4064325		
地積	87.40 ㎡		

225

地番	上前川七四ノ六		
N O	X	Y	辺長
6732	-111715.985	-27472.277	
6685	-111732.945	-27478.505	18.067
6686	-111734.350	-27474.858	3.908
6738	-111717.338	-27468.609	18.123
6732	-111715.985	-27472.277	3.910
面積	70.7291865		
地積	70.72 ㎡		

226

地番	上前川七四ノ二		
N O	X	Y	辺長
6733	-111714.633	-27475.950	
6683	-111731.572	-27482.162	18.042
6684	-111732.047	-27480.838	1.407
6685	-111732.945	-27478.505	2.500
6732	-111715.985	-27472.277	18.067
6733	-111714.633	-27475.950	3.914
面積	70.5542790		
地積	70.55 ㎡		

227

地番	上前川七四		
N O	X	Y	辺 長
6734	-111713.275	-27479.646	
6682	-111730.254	-27485.835	18.072
6683	-111731.572	-27482.162	3.902
6733	-111714.633	-27475.950	18.042
6734	-111713.275	-27479.646	3.938
面積	70.7817045		
地積	70.78 ㎡		

228			
地番	上北ノ口一五		
N O	X	Y	辺 長
6692	-111706.414	-27498.279	
6680	-111723.541	-27504.534	18.233
6681	-111725.140	-27500.088	4.725
6682	-111730.254	-27485.835	15.143
6734	-111713.275	-27479.646	18.072
6735	-111712.524	-27481.689	2.177
6691	-111707.864	-27494.343	13.485
6692	-111708.414	-27498.279	4.195
面積	360.5517735		
地積	360.55		m ²

235

地番	上前川七九ノ六		
N O	X	Y	辺長
6668	-111704.396	-27546.882	
6669	-111708.774	-27548.790	4.776
6670	-111712.150	-27547.049	3.798
6673	-111713.210	-27542.201	4.963
9316	-111708.174	-27540.345	5.367
6671	-111706.959	-27539.897	1.295
6668	-111704.396	-27546.882	7.440
面積	50.6996085		
地積	50.69㎡		

236

地番	上前川七九ノ一		
N O	X	Y	辺長
6667	-111697.510	-27543.880	
6668	-111704.396	-27546.882	7.512
6671	-111706.959	-27539.897	7.440
6672	-111699.919	-27537.309	7.501
6667	-111697.510	-27543.880	6.999
面積	54.1435840		
地積	54.14㎡		

237

地番	保 五八ノ二号		
N O	X	Y	辺長
6666	-111690.752	-27540.935	
6667	-111697.510	-27543.880	7.372
6672	-111699.919	-27537.309	6.999
6694	-111701.657	-27532.584	5.035
6695	-111694.756	-27530.041	7.355
6702	-111694.196	-27531.633	1.688
6666	-111690.752	-27540.935	9.919
面積	86.8006740		
地積	86.80㎡		


238

地番	保 五八ノ六号		
N O	X	Y	辺長
6665	-111686.433	-27539.052	
6666	-111690.752	-27540.935	4.712
6702	-111694.196	-27531.633	9.919
6701	-111689.778	-27530.015	4.705
6665	-111686.433	-27539.052	9.636
面積	45.9990330		
地積	45.99㎡		


239

地番	保 五八ノ五号		
N O	X	Y	辺長
6664	-111681.984	-27537.113	
6665	-111686.433	-27539.052	4.853
6701	-111689.778	-27530.015	9.636
6700	-111685.233	-27528.347	4.841
6664	-111681.984	-27537.113	9.349
面積	45.9761850		
地積	45.97㎡		

図面の種類	画 地 面 積 求 積 表			
街区 番号	58	番号	$\frac{2}{2}$	
町 名	上 桂 北 ノ 口 町			
京 都 市 洛 西 第 二 土 地 区 画 整 理 組 合				

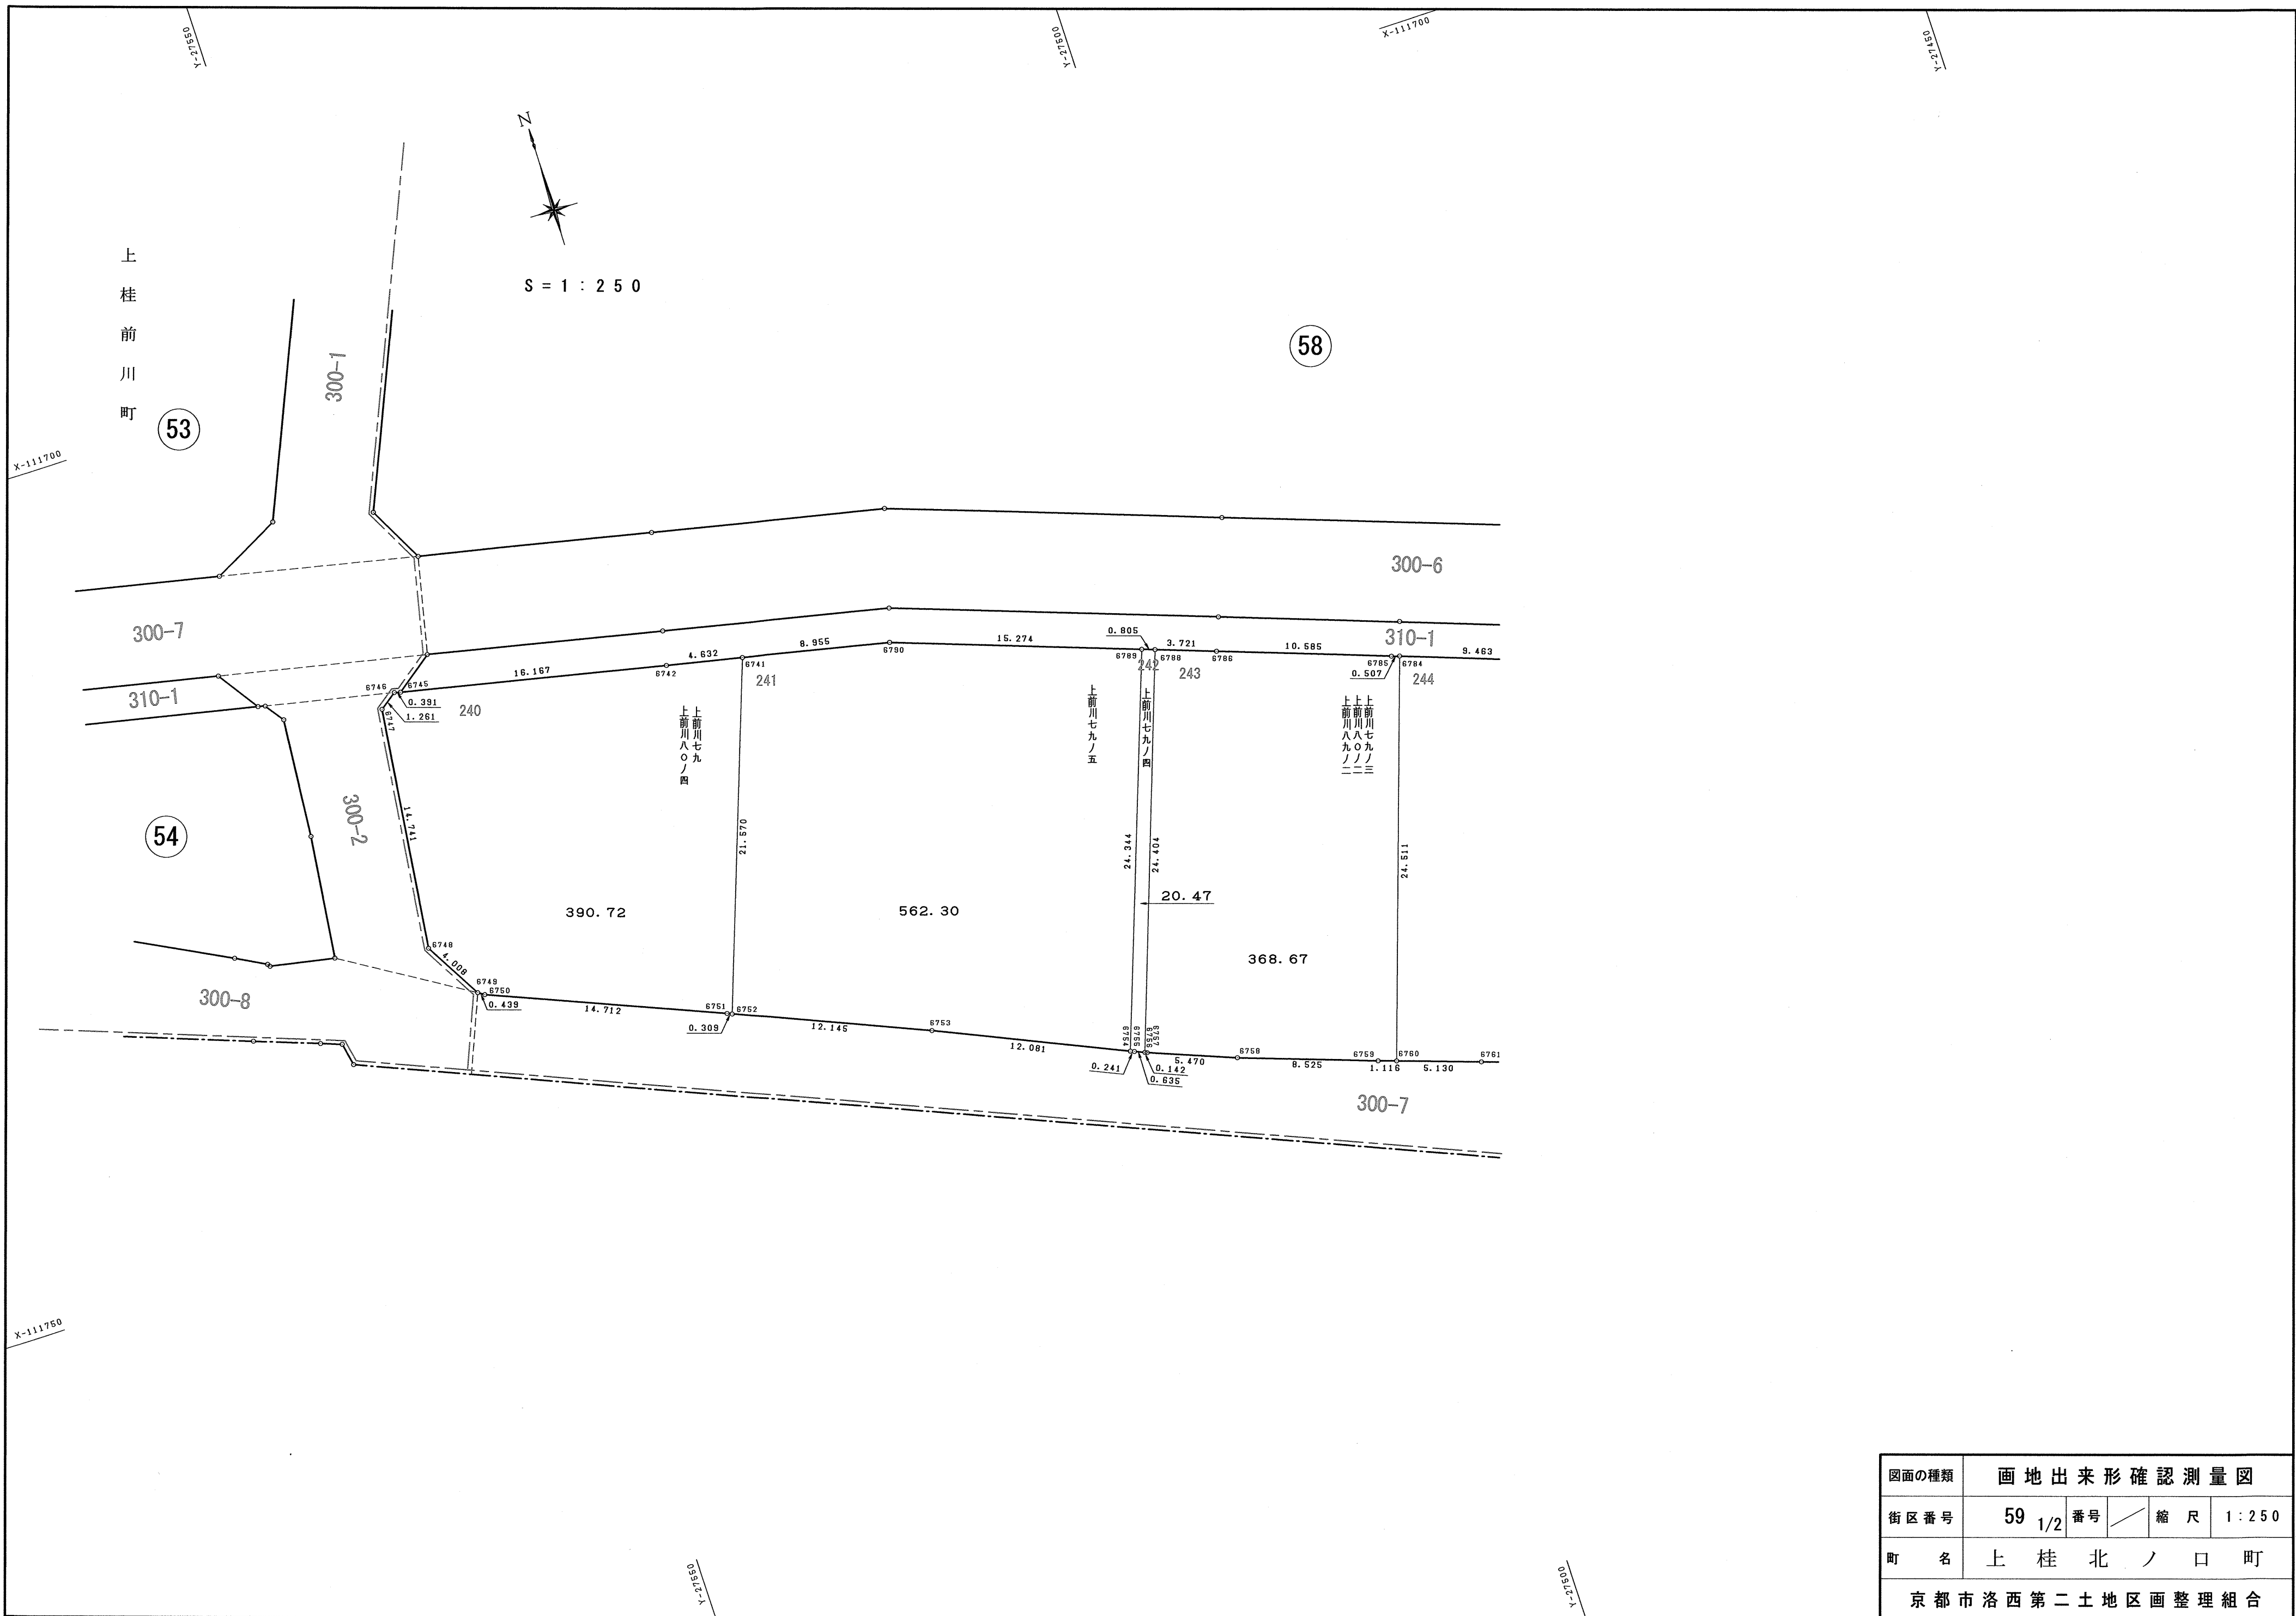

図面の種類	画地出来形確認測量図				
街区番号	59	1/2	番号	縮尺	1：250
町名	上桂北ノ口町				
京都市洛西第二土地区画整理組合					

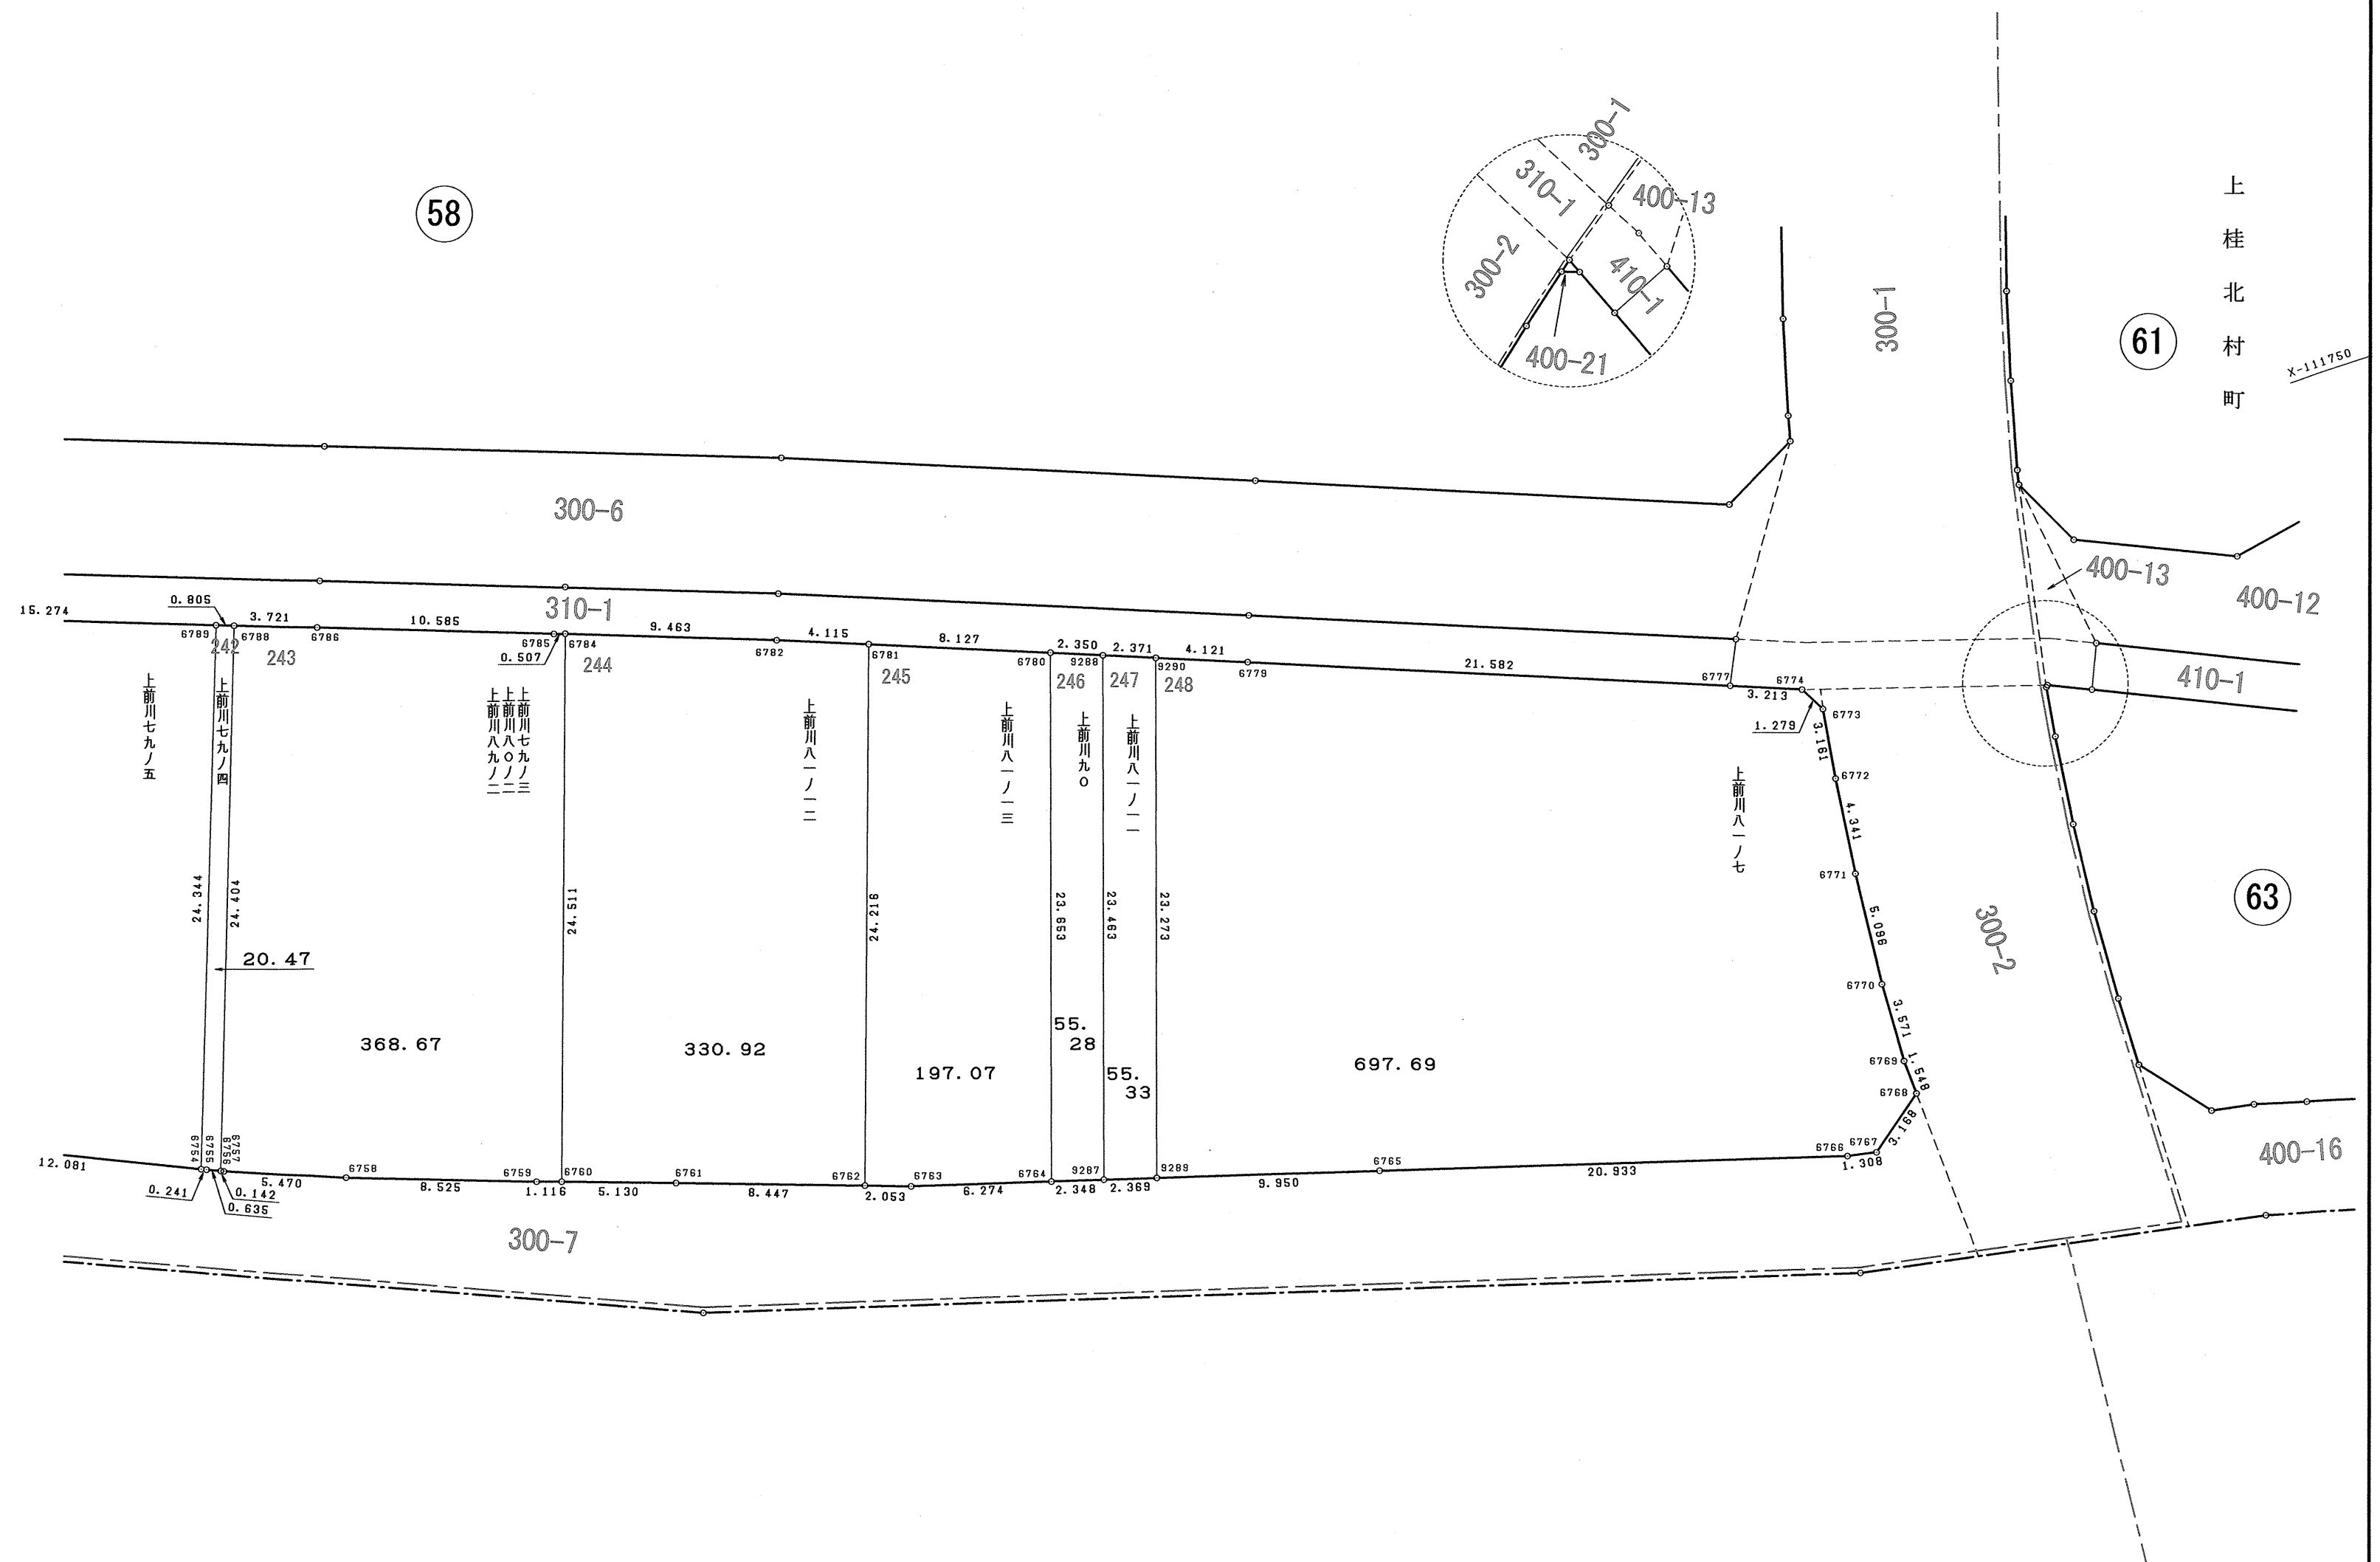

図面の種類	画地出来形確認測量図				
街区番号	59	2/2	番号	縮尺	1:250
町名	上桂北ノ口町				
京都市洛西第二土地区画整理組合					

240

地番	上前川七九，上前川八〇ノ四		
N O	X	Y	辺長
6745	-111719.642	-27550.616	
6746	-111719.536	-27550.992	0.391
6747	-111720.275	-27552.014	1.261
6748	-111734.902	-27553.847	14.741
6749	-111738.382	-27551.859	4.008
6750	-111738.622	-27551.491	0.439
6751	-111744.280	-27537.910	14.712
6752	-111744.401	-27537.626	0.309
6741	-111724.112	-27530.303	21.570
6742	-111723.119	-27534.827	4.632
6745	-111719.642	-27550.616	16.167
面積	390.7202725		
地積	390.72㎡		

241

地番	上前川七九ノ五		
N O	X	Y	辺長
6741	-111724.112	-27530.303	
6752	-111744.401	-27537.626	21.570
6753	-111749.174	-27526.458	12.145
6754	-111754.111	-27515.432	12.081
6789	-111731.206	-27507.185	24.344
6790	-111726.031	-27521.556	15.274
6741	-111724.112	-27530.303	8.955
面積	562.3004310		
地積	562.30㎡		

242

地番	上前川七九ノ四		
N O	X	Y	辺長
6789	-111731.206	-27507.185	
6754	-111754.111	-27515.432	24.344
6755	-111754.210	-27515.212	0.241
6756	-111754.462	-27514.629	0.635
6788	-111731.478	-27506.427	24.404
6789	-111731.206	-27507.185	0.805
面積	20.4712525		
地積	20.47㎡		

243

地番	上前川七九ノ三，八〇ノ二，八九ノ二		
N O	X	Y	辺長
6788	-111731.478	-27506.427	
6756	-111754.462	-27514.629	24.404
6757	-111754.518	-27514.499	0.142
6758	-111756.524	-27509.410	5.470
6759	-111759.373	-27501.375	8.525
6760	-111759.732	-27500.318	1.116
6784	-111736.504	-27492.492	24.511
6785	-111736.331	-27492.969	0.507
6786	-111732.739	-27502.926	10.585
6788	-111731.478	-27506.427	3.721
面積	368.6767860		
地積	368.67㎡		

244

地番	上前川八一ノ一二		
N O	X	Y	辺長
6784	-111736.504	-27492.492	
6760	-111759.732	-27500.318	24.511
6761	-111761.379	-27495.461	5.129
6762	-111764.145	-27487.480	8.447
6781	-111741.196	-27479.751	24.216
6782	-111739.723	-27483.593	4.115
6784	-111736.504	-27492.492	9.463
面積	330.9229765		
地積	330.92㎡		

245

地番	上前川八一ノ一三		
N O	X	Y	辺長
6781	-111741.196	-27479.751	
6762	-111764.145	-27487.480	24.216
6763	-111764.817	-27485.540	2.053
6764	-111766.584	-27479.520	6.274
6780	-111744.105	-27472.162	23.653
6781	-111741.196	-27479.751	8.127
面積	197.0700420		
地積	197.07㎡		

246

地番	上前川九〇		
N O	X	Y	辺長
6780	-111744.105	-27472.162	
6764	-111766.584	-27479.520	23.653
9287	-111767.245	-27477.267	2.348
9288	-111744.946	-27469.968	23.463
6780	-111744.105	-27472.162	2.350
面積	55.2856450		
地積	55.28㎡		

247

地番	上前川八一ノ一一		
N O	X	Y	辺長
9288	-111744.946	-27469.968	
9287	-111767.245	-27477.267	23.463
9289	-111767.912	-27474.994	2.369
9290	-111745.794	-27467.754	23.273
9288	-111744.946	-27469.968	2.371
面積	55.3314160		
地積	55.33㎡		

248

地番	上前川八一ノ七		
N O	X	Y	辺長
9289	-111767.912	-27474.994	
6765	-111770.715	-27465.447	9.950
6766	-111776.637	-27445.369	20.933
6767	-111776.883	-27444.084	1.308
6768	-111774.943	-27441.579	3.168
6769	-111773.396	-27441.642	1.548
6770	-111769.828	-27441.494	3.571
6771	-111764.749	-27441.077	5.096
6772	-111760.436	-27440.589	4.341
6773	-111757.305	-27440.153	3.161
6774	-111756.184	-27440.769	1.279
6777	-111755.020	-27443.764	3.213
6779	-111747.269	-27463.906	21.582
9290	-111745.794	-27467.754	4.121
9289	-111767.912	-27474.994	23.273
面積	697.6952045		
地積	697.69㎡		

図面の種類	画 地 面 積 求 積 表			
街区番号	59	番号	／	
町 名	上 桂 北 ノ 口 町			
京 都 市 洛 西 第 二 土 地 区 画 整 理 組 合				