

京都都市計画（京都国際文化観光都市建設計画）
 都市建設事業洛西第二地区土地区画整理事業

画地出来形確認測量図


3 / 5

60街区～89街区
 平成17年9月2日現在

洛西第二土地区画整理組合
 第一測量設計株式会社

洛西第二土地区画整理事業画地出来形測量図

嵐山	嵐山宮ノ前町	1		
桂	桂池尻町			5
	桂上野今井町	2		
	桂上野北町		3	
	桂上野中町		3	
	桂上野西町	2		
	桂上野東町		3	4
	桂上野南町		3	
	桂河田町		4	5
	桂清水町			5
	桂徳大寺町		4	
	桂徳大寺北町		4	5
	桂徳大寺東町		4	
	桂徳大寺南町			5
	桂畑ヶ田町		4	
	桂久方町			5
上桂	上桂今井町	2		
	上桂北ノ口町	2	3	
	上桂北村町		3	
	上桂東ノ口町			5
	上桂前川町	2		
松室	松室吾田神町	1	2	
	松室荒堀町	1		
	松室河原町	1		
	松室北河原町	1		
	松室中溝町	1		
	松尾東ノ口町		2	

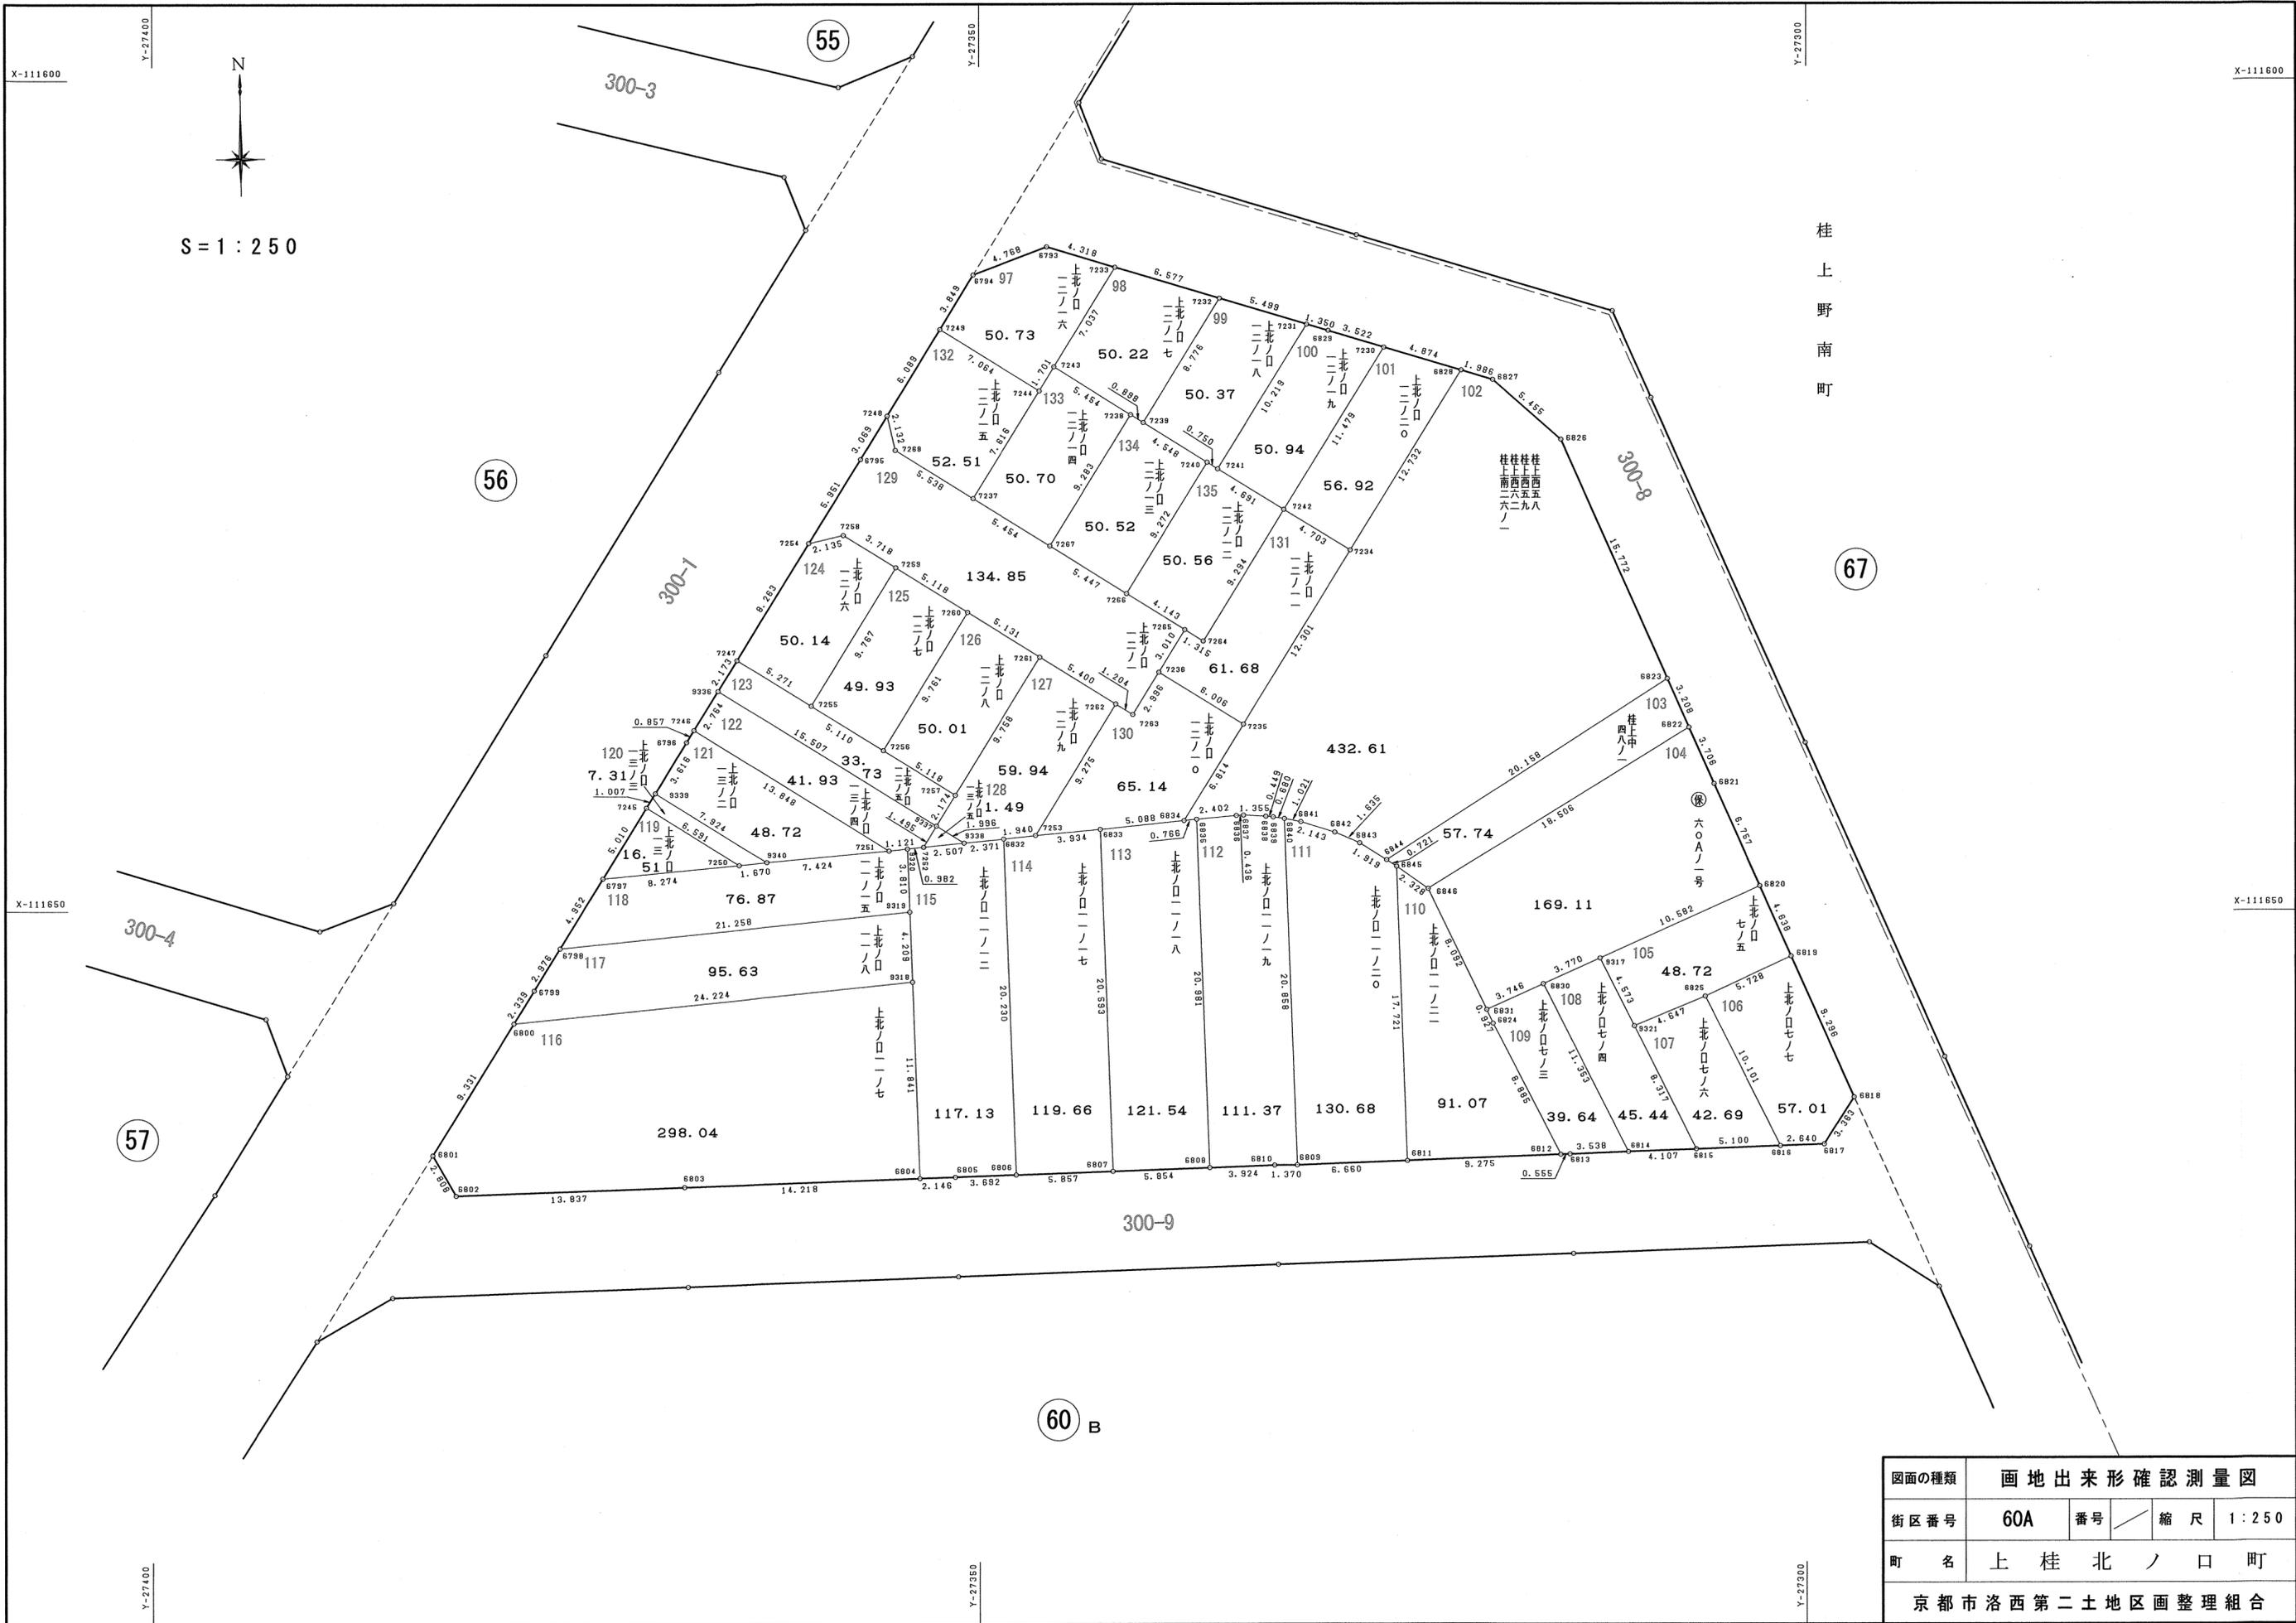

桂
上
野
南
町

図面の種類	画地出来形確認測量図		
街区番号	60A	番号	縮尺 1:250
町名	上桂北ノ口町		
京都市洛西第二土地区画整理組合			

97

Table with 4 columns: NO, X, Y, 辺長. Contains data for parcel 97.

98

Table with 4 columns: NO, X, Y, 辺長. Contains data for parcel 98.

99

Table with 4 columns: NO, X, Y, 辺長. Contains data for parcel 99.

100

Table with 4 columns: NO, X, Y, 辺長. Contains data for parcel 100.

101

Table with 4 columns: NO, X, Y, 辺長. Contains data for parcel 101.

102

Table with 4 columns: NO, X, Y, 辺長. Contains data for parcel 102.

103

Table with 4 columns: NO, X, Y, 辺長. Contains data for parcel 103.

104

Table with 4 columns: NO, X, Y, 辺長. Contains data for parcel 104.

105

Table with 4 columns: NO, X, Y, 辺長. Contains data for parcel 105.

106

Table with 4 columns: NO, X, Y, 辺長. Contains data for parcel 106.

107

Table with 4 columns: NO, X, Y, 辺長. Contains data for parcel 107.

108

Table with 4 columns: NO, X, Y, 辺長. Contains data for parcel 108.

109

Table with 4 columns: NO, X, Y, 辺長. Contains data for parcel 109.

110

Table with 4 columns: NO, X, Y, 辺長. Contains data for parcel 110.

111

Table with 4 columns: NO, X, Y, 辺長. Contains data for parcel 111.

112

Table with 4 columns: NO, X, Y, 辺長. Contains data for parcel 112.

113

Table with 4 columns: NO, X, Y, 辺長. Contains data for parcel 113.

114

Table with 4 columns: NO, X, Y, 辺長. Contains data for parcel 114.

115

Table with 4 columns: NO, X, Y, 辺長. Contains data for parcel 115.

116

Table with 4 columns: NO, X, Y, 辺長. Contains data for parcel 116.

117

Table with 4 columns: NO, X, Y, 辺長. Contains data for parcel 117.

118

Table with 4 columns: NO, X, Y, 辺長. Contains data for parcel 118.

119

Table with 4 columns: NO, X, Y, 辺長. Contains data for parcel 119.

120

Table with 4 columns: NO, X, Y, 辺長. Contains data for parcel 120.

121

Table with 4 columns: NO, X, Y, 辺長. Contains data for parcel 121.

122

Table with 4 columns: NO, X, Y, 辺長. Contains data for parcel 122.

123

Table with 4 columns: NO, X, Y, 辺長. Contains data for parcel 123.

Summary table with columns: 図面の種類, 画地面積求積表, 街区番号, 番号, 町名, 京都市洛西第二土地画整理組合.

124

地番 上北ノ口一ニノ六			
NO	X	Y	辺長
7254	-111627.844	-27360.300	
7247	-111634.870	-27364.649	8.263
7255	-111637.632	-27360.160	5.271
7259	-111629.306	-27355.053	9.767
7258	-111627.360	-27358.221	3.718
7254	-111627.844	-27360.300	2.135
面積	50.1418270		
地積	50.14 m ²		

125

地番 上北ノ口一ニノ七			
NO	X	Y	辺長
7259	-111629.306	-27355.053	
7255	-111637.632	-27360.160	9.767
7256	-111640.311	-27355.808	5.110
7260	-111631.994	-27350.698	9.761
7259	-111629.306	-27355.053	5.118
面積	49.9363100		
地積	49.93 m ²		

126

地番 上北ノ口一ニノ八			
NO	X	Y	辺長
7260	-111631.994	-27350.698	
7256	-111640.311	-27355.808	9.761
7257	-111643.000	-27351.453	5.118
7261	-111634.693	-27346.334	9.758
7260	-111631.994	-27350.698	5.131
面積	50.0146270		
地積	50.01 m ²		

127

地番 上北ノ口一ニノ九			
NO	X	Y	辺長
7261	-111634.693	-27346.334	
7257	-111643.000	-27351.453	9.758
9337	-111644.852	-27352.591	2.174
9338	-111645.878	-27350.879	1.996
6832	-111645.643	-27348.520	2.371
7253	-111645.430	-27346.592	1.940
7262	-111637.527	-27341.737	9.275
7261	-111634.693	-27346.334	5.400
面積	59.9456975		
地積	59.94 m ²		

128

地番 上北ノ口一三ノ五			
NO	X	Y	辺長
9337	-111644.852	-27352.591	
7252	-111646.126	-27353.374	1.495
9338	-111645.878	-27350.879	2.507
9337	-111644.852	-27352.591	1.996
面積	1.4922230		
地積	1.49 m ²		

129

地番 上北ノ口一ニノ一			
NO	X	Y	辺長
7248	-111620.169	-27355.561	
6795	-111622.784	-27357.168	3.069
7254	-111627.844	-27360.300	5.951
7258	-111627.360	-27358.221	2.135
7259	-111629.306	-27355.053	3.718
7260	-111631.994	-27350.698	5.118
7261	-111634.693	-27346.334	5.131
7262	-111637.527	-27341.737	5.400
7263	-111638.163	-27340.715	1.204
7236	-111635.614	-27339.140	2.996
7265	-111633.053	-27337.558	3.010
7266	-111630.875	-27341.082	4.143
7267	-111628.012	-27345.716	5.447
7237	-111625.153	-27350.361	5.454
7268	-111622.245	-27355.074	5.538
7248	-111620.169	-27355.561	2.132
面積	134.8501235		
地積	134.85 m ²		

130

地番 上北ノ口一ニノ一〇			
NO	X	Y	辺長
7262	-111637.527	-27341.737	
7253	-111645.430	-27346.592	9.275
6833	-111645.066	-27342.675	3.934
6834	-111644.545	-27337.614	5.088
7235	-111638.755	-27334.021	6.814
7236	-111635.614	-27339.140	6.006
7263	-111638.163	-27340.715	2.996
7262	-111637.527	-27341.737	1.204
面積	65.1429510		
地積	65.14 m ²		

131

地番 上北ノ口一ニノ一一			
NO	X	Y	辺長
7242	-111625.836	-27331.572	
7264	-111633.751	-27336.444	9.294
7265	-111633.053	-27337.558	1.315
7236	-111635.614	-27339.140	3.010
7235	-111638.755	-27334.021	6.006
7234	-111628.288	-27327.559	12.301
7242	-111625.836	-27331.572	4.703
面積	61.6842255		
地積	61.68 m ²		

132

地番 上北ノ口一ニノ一五			
NO	X	Y	辺長
7249	-111614.981	-27352.373	
7248	-111620.169	-27355.561	6.089
7268	-111622.245	-27355.074	2.132
7237	-111625.153	-27350.361	5.538
7244	-111618.677	-27346.353	7.616
7249	-111614.981	-27352.373	7.064
面積	52.5168360		
地積	52.51 m ²		

133

地番 上北ノ口一ニノ一四			
NO	X	Y	辺長
7243	-111617.228	-27345.462	
7244	-111618.677	-27346.353	1.701
7237	-111625.153	-27350.361	7.616
7267	-111628.012	-27345.716	5.454
7238	-111620.116	-27340.835	9.283
7243	-111617.228	-27345.462	5.454
面積	50.7057550		
地積	50.70 m ²		

134

地番 上北ノ口一ニノ一三			
NO	X	Y	辺長
7238	-111620.116	-27340.835	
7267	-111628.012	-27345.716	9.283
7266	-111630.875	-27341.082	5.447
7240	-111622.987	-27336.208	9.272
7239	-111620.589	-27340.072	4.548
7238	-111620.116	-27340.835	0.898
面積	50.5286995		
地積	50.52 m ²		

135

地番 上北ノ口一ニノ一二			
NO	X	Y	辺長
7240	-111622.987	-27336.208	
7266	-111630.875	-27341.082	9.272
7265	-111633.053	-27337.558	4.143
7264	-111633.751	-27336.444	1.315
7242	-111625.836	-27331.572	9.294
7241	-111623.382	-27335.570	4.691
7240	-111622.987	-27336.208	0.750
面積	50.5647090		
地積	50.56 m ²		

図面の種類	画地面積求積表		
街区番号	60A	番号	2/2
町名	上桂北ノ口町		
京都市洛西第二土地区画整理組合			

X-111650

Y-27300




X-111700

X-111700

Y-27400

Y-27350

Y-27300

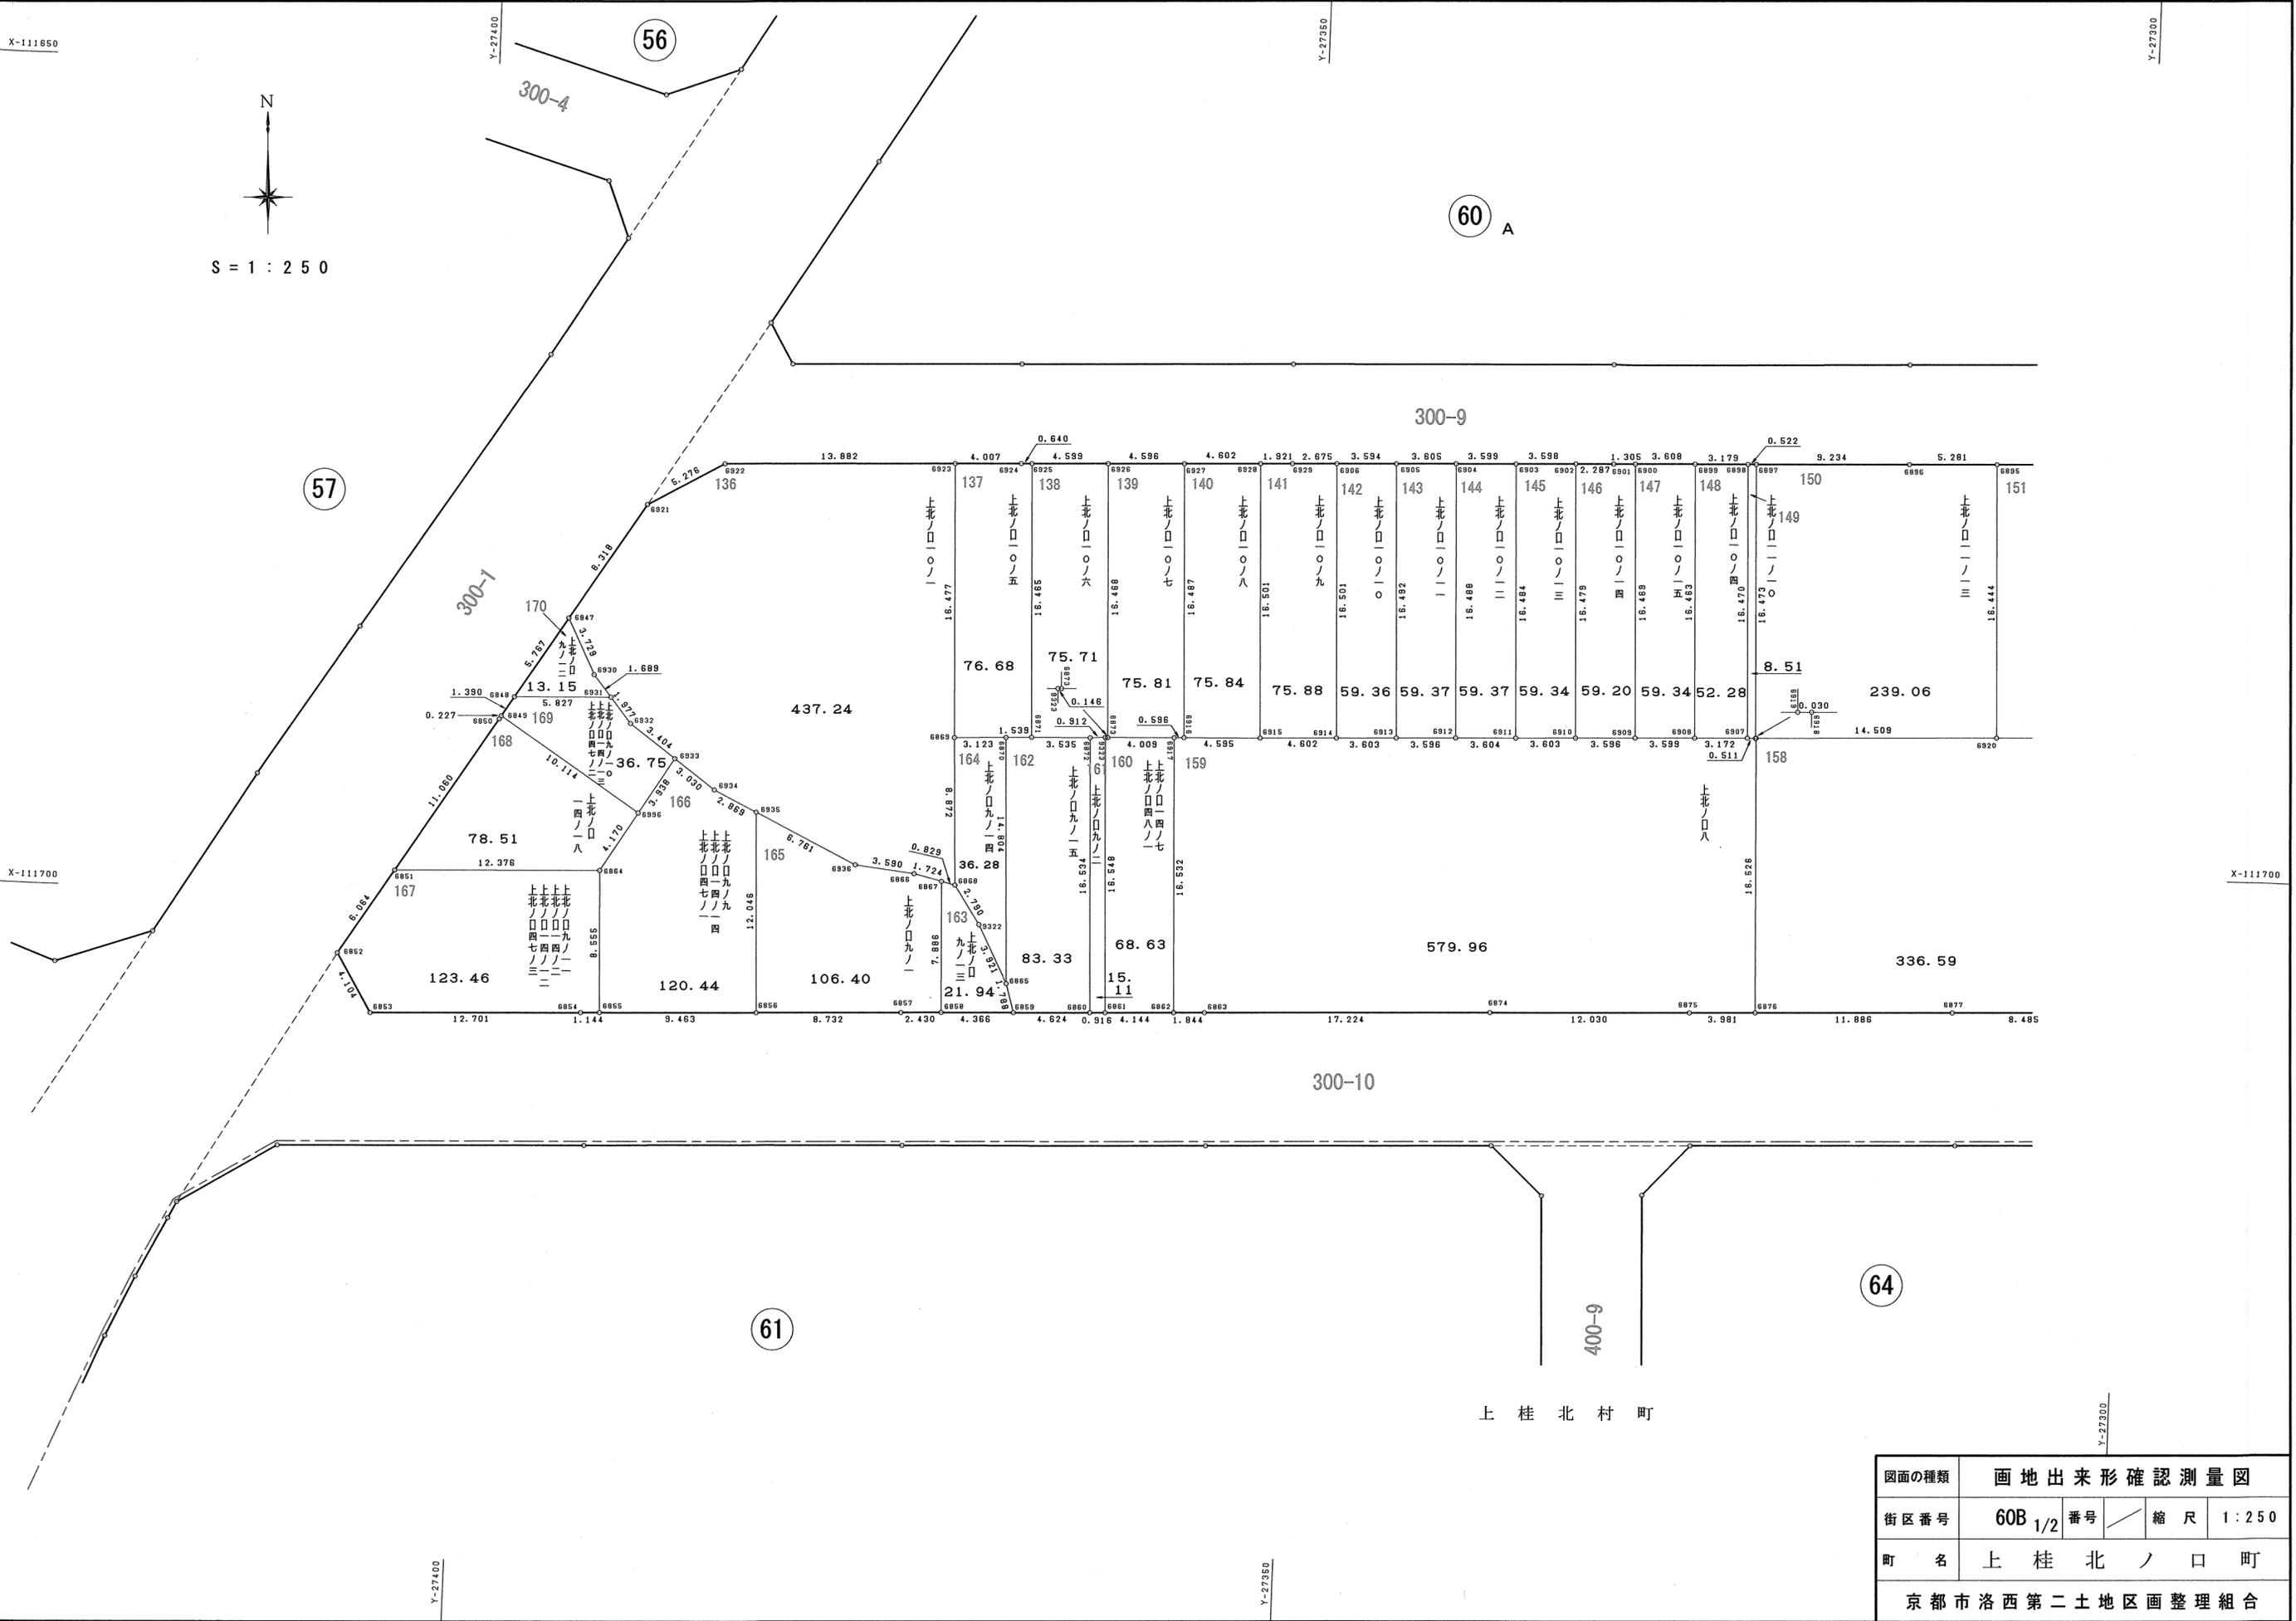

60 A

57

56

61

64

上桂北村町

図面の種類	画地出来形確認測量図			
街区番号	60B 1/2	番号	縮尺	1 : 250
町名	上桂北ノ口町			
京都市洛西第二土地区画整理組合				

X-111650

X-111650




S = 1 : 2 5 0

Y-27300

Y-27300

60 A

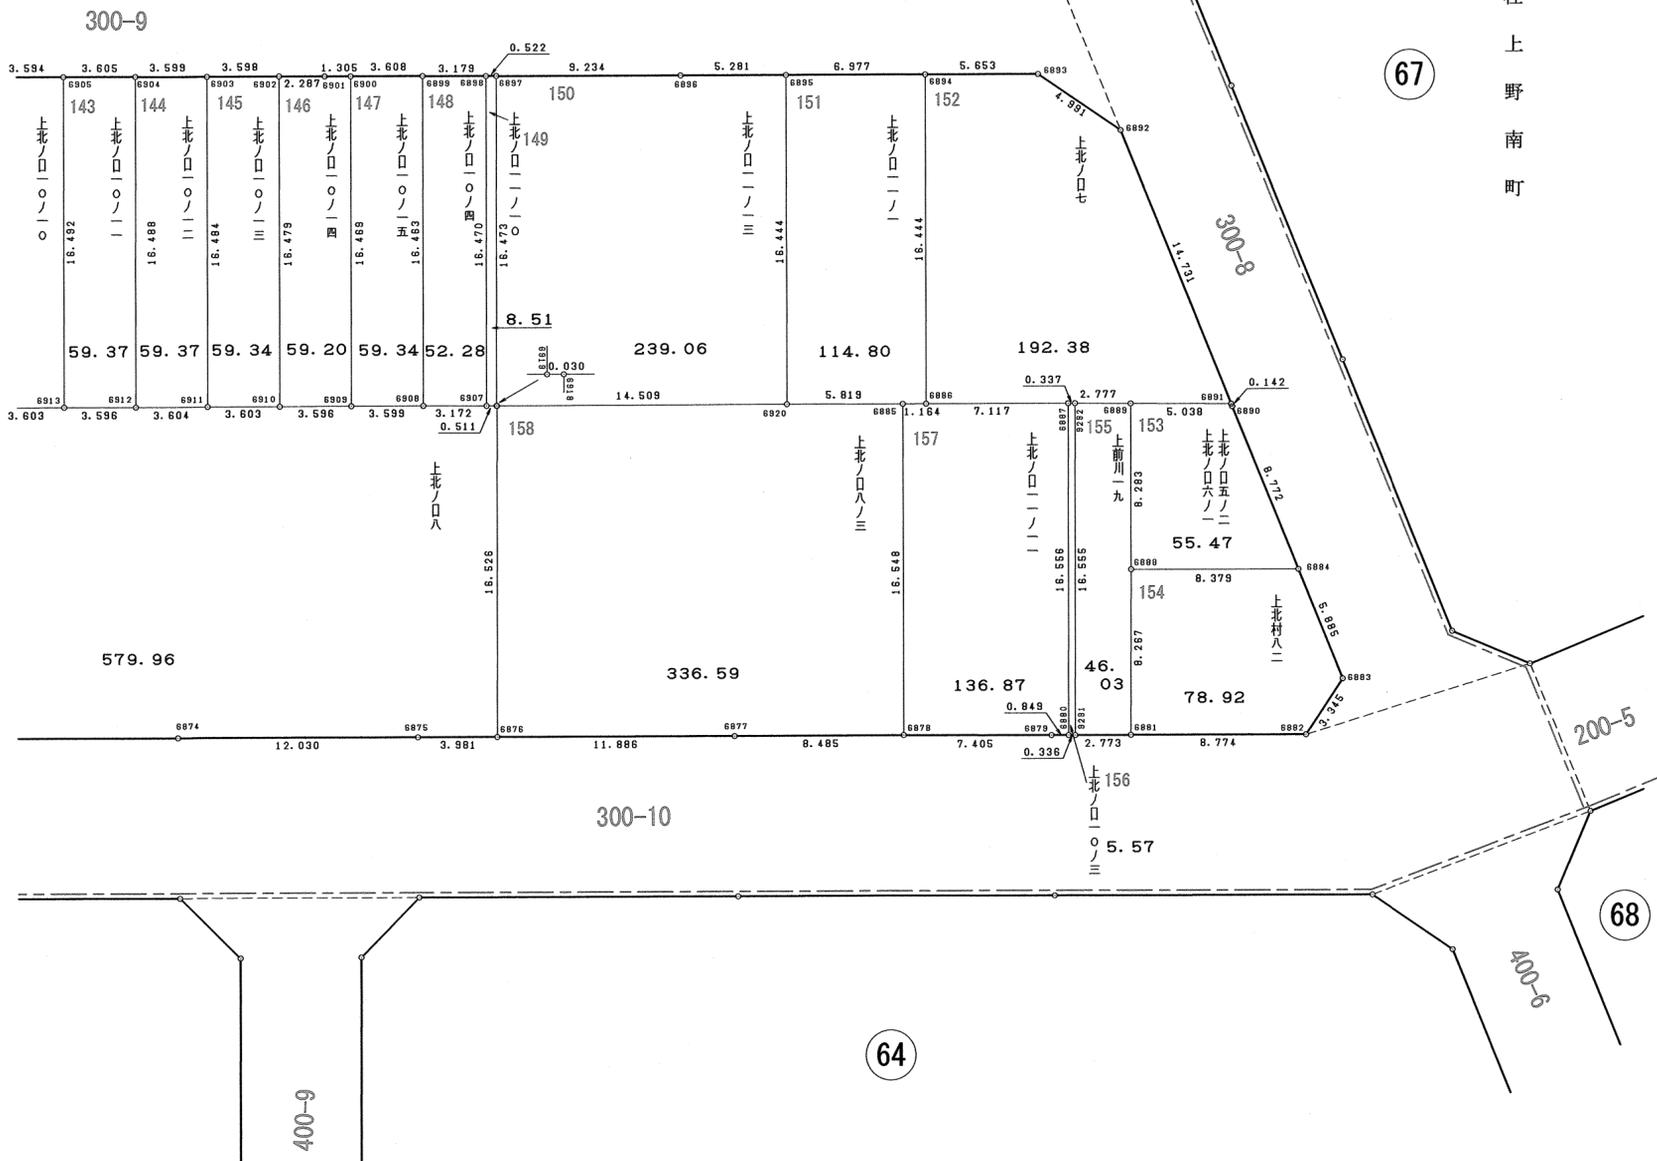

桂
上
野
南
町

X-111700

X-111700

Y-27300

Y-27300

上 桂 北 村 町

図面の種類	画地出来形確認測量図		
街区番号	60B 2/2	番号	縮尺 1:250
町名	上 桂 北 ノ 口 町		
京都市洛西第二土地区画整理組合			

136

地番 上北ノロ一〇ノ一			
NO	X	Y	辺長
6922	-111673.239	-27385.513	
6921	-111675.871	-27390.086	5.276
6847	-111682.876	-27394.572	8.318
6930	-111686.217	-27392.916	3.729
6931	-111687.533	-27391.858	1.689
6932	-111689.072	-27390.617	1.977
6933	-111691.078	-27387.867	3.404
6934	-111692.864	-27385.419	3.030
6935	-111694.120	-27382.839	2.869
6936	-111697.070	-27376.755	6.761
6866	-111697.465	-27373.187	3.590
6867	-111697.863	-27371.510	1.724
6868	-111698.059	-27370.704	0.829
6869	-111698.194	-27371.054	8.872
6923	-111672.727	-27371.640	16.477
6922	-111673.239	-27385.513	13.882
面積	437.2414655		
地積	437.24 m ²		

137

地番 上北ノロ一〇ノ五			
NO	X	Y	辺長
6923	-111672.727	-27371.640	
6869	-111689.194	-27371.054	16.477
6870	-111689.075	-27367.933	3.123
6871	-111689.010	-27366.395	1.539
6925	-111672.556	-27366.996	16.465
6924	-111672.579	-27367.636	0.640
6923	-111672.727	-27371.640	4.007
面積	76.6825975		
地積	76.68 m ²		

138

地番 上北ノロ一〇ノ六			
NO	X	Y	辺長
6925	-111672.556	-27366.996	
6871	-111689.010	-27366.395	16.465
6872	-111688.900	-27362.862	3.535
9323	-111688.853	-27361.951	0.912
6873	-111688.846	-27361.805	0.146
6926	-111672.389	-27362.400	16.468
6925	-111672.556	-27366.996	4.599
面積	75.7160940		
地積	75.71 m ²		

139

地番 上北ノロ一〇ノ七			
NO	X	Y	辺長
6926	-111672.389	-27362.400	
6873	-111688.846	-27361.805	16.468
6917	-111688.721	-27357.798	4.009
6916	-111688.698	-27357.202	0.596
6927	-111672.222	-27357.807	16.487
6926	-111672.389	-27362.400	4.596
面積	75.8162975		
地積	75.81 m ²		

140

地番 上北ノロ一〇ノ八			
NO	X	Y	辺長
6927	-111672.222	-27357.807	
6916	-111688.698	-27357.202	16.487
6915	-111688.545	-27352.610	4.595
6928	-111672.055	-27353.208	16.501
6927	-111672.222	-27357.807	4.602
面積	75.8438665		
地積	75.84 m ²		

141

地番 上北ノロ一〇ノ九			
NO	X	Y	辺長
6928	-111672.055	-27353.208	
6915	-111688.545	-27352.610	16.501
6914	-111688.377	-27348.011	4.602
6906	-111671.887	-27348.615	16.501
6929	-111671.985	-27351.288	2.675
6928	-111672.055	-27353.208	1.921
面積	75.8884830		
地積	75.88 m ²		

142

地番 上北ノロ一〇ノ一〇			
NO	X	Y	辺長
6906	-111671.887	-27348.615	
6914	-111688.377	-27348.011	16.501
6913	-111688.236	-27344.411	3.603
6905	-111671.755	-27345.023	16.492
6906	-111671.887	-27348.615	3.594
面積	59.3648500		
地積	59.36 m ²		

143

地番 上北ノロ一〇ノ一一			
NO	X	Y	辺長
6905	-111671.755	-27345.023	
6913	-111688.236	-27344.411	16.492
6912	-111688.100	-27340.818	3.596
6904	-111671.623	-27341.420	16.488
6905	-111671.755	-27345.023	3.605
面積	59.3727800		
地積	59.37 m ²		

144

地番 上北ノロ一〇ノ一二			
NO	X	Y	辺長
6904	-111671.623	-27341.420	
6912	-111688.100	-27340.818	16.488
6911	-111687.965	-27337.217	3.604
6903	-111671.492	-27337.823	16.484
6904	-111671.623	-27341.420	3.599
面積	59.3738570		
地積	59.37 m ²		

145

地番 上北ノロ一〇ノ一三			
NO	X	Y	辺長
6903	-111671.492	-27337.823	
6911	-111687.965	-27337.217	16.484
6910	-111687.828	-27333.617	3.603
6902	-111671.360	-27334.227	16.479
6903	-111671.492	-27337.823	3.598
面積	59.3426350		
地積	59.34 m ²		

146

地番 上北ノロ一〇ノ一四			
NO	X	Y	辺長
6902	-111671.360	-27334.227	
6910	-111687.828	-27333.617	16.479
6909	-111687.687	-27330.024	3.596
6900	-111671.229	-27330.638	16.469
6901	-111671.276	-27331.942	1.305
6902	-111671.360	-27334.227	2.287
面積	59.2029355		
地積	59.20 m ²		

147

地番 上北ノロ一〇ノ一五			
NO	X	Y	辺長
6900	-111671.229	-27330.638	
6909	-111687.687	-27330.024	16.469
6908	-111687.553	-27326.427	3.599
6899	-111671.101	-27327.032	16.463
6900	-111671.229	-27330.638	3.608
面積	59.3425270		
地積	59.34 m ²		

148

地番 上北ノロ一〇ノ一六			
NO	X	Y	辺長
6899	-111671.101	-27327.032	
6908	-111687.553	-27326.427	16.463
6907	-111687.446	-27323.257	3.172
6898	-111670.987	-27323.855	16.470
6899	-111671.101	-27327.032	3.179
面積	52.2879950		
地積	52.28 m ²		

149

地番 上北ノロ一〇ノ一七			
NO	X	Y	辺長
6898	-111670.987	-27323.855	
6907	-111687.446	-27323.257	16.470
6919	-111687.432	-27322.746	0.511
6897	-111670.969	-27323.333	16.473
6898	-111670.987	-27323.855	0.522
面積	8.5115865		
地積	8.51 m ²		

150

地番 上北ノロ一〇ノ一八			
NO	X	Y	辺長
6897	-111670.969	-27323.333	
6919	-111687.432	-27322.746	16.473
6918	-111687.432	-27322.716	0.030
6920	-111686.875	-27308.218	14.509
6895	-111670.442	-27308.828	16.444
6896	-111670.639	-27314.105	5.281
6897	-111670.969	-27323.333	9.234
面積	239.0618810		
地積	239.06 m ²		

151

地番 上北ノロ一〇ノ一九			
NO	X	Y	辺長
6895	-111670.442	-27308.828	
6920	-111686.875	-27308.218	16.444
6885	-111686.664	-27302.403	5.819
6886	-111686.613	-27301.240	1.164
6894	-111670.181	-27301.856	16.444
6895	-111670.442	-27308.828	6.977
面積	114.8025730		
地積	114.80 m ²		

152

地番 上北ノロ一〇ノ二〇			
NO	X	Y	辺長
6894	-111670.181	-27301.856	
6886	-111686.613	-27301.240	16.444
6887	-111686.353	-27294.128	7.117
9292	-111686.341	-27293.791	0.337
6889	-111686.243	-27291.016	2.777
6891	-111686.084	-27285.981	5.038
6892	-111672.633	-27291.986	14.731
6893	-111669.970	-27296.207	4.991
6894	-111670.181	-27301.856	5.653
面積	192.3841860		
地積	192.38 m ²		

153

地番 上北ノロ一〇ノ二一			
NO	X	Y	辺長
6889	-111686.243	-27291.016	
6888	-111694.520	-27290.711	8.283
6884	-111694.220	-27282.337	8.379
6890	-111686.214	-27285.923	8.772
6891	-111686.084	-27285.981	0.142
6889	-111686.243	-27291.016	5.038
面積	55.4727110		
地積	55.47 m ²		

154

地番 上北村八二			
NO	X	Y	辺長
6888	-111694.520	-27290.711	
6881	-111702.782	-27290.433	8.267
6882	-111702.452	-27281.665	8.774
6883	-111699.591	-27279.932	3.345
6884	-111694.220	-27282.337	5.885
6888	-111694.520	-27290.711	8.379
面積	78.9289860		
地積	78.92 m ²		

155

地番 上前川一九			
NO	X	Y	辺長
9291	-111702.886	-27293.204	
6881	-111702.782	-27290.433	2.773
6888	-111694.520	-27290.711	8.267
6889	-111686.243	-27291.016	8.283
9292	-111686.341	-27293.791	2.777
9291	-111702.886	-27293.204	16.555
面積	46.0395030		
地積	46.03 m ²		

156

地番 上北ノロ一〇ノ二二			
NO	X	Y	辺長
6887	-111686.353	-27294.128	
6880	-111702.899	-27293.540	16.556
9291	-111702.886	-27293.204	0.336
9292	-111686.341	-27293.791	16.555
6887	-111686.353	-27294.128	0.337
面積	5.5749045		
地積	5.57 m ²		

157

地番 上北ノロ一〇ノ二三			
NO	X	Y	辺長
6885	-111686.664	-27302.403	
6878	-111703.201	-27301.788	16.548
6879	-111702.931	-27294.388	7.405
6880	-111702.899	-27293.540	0.849
6887	-111686.353	-27294.128	16.556
6886	-111686.613	-27301.240	7.117
6885	-111686.664	-27302.403	1.164
面積	136.8760480		
地積	136.87 m ²		

158

地番 上北ノロ一〇ノ二四			
NO	X	Y	辺長
6918	-111687.432	-27322.716	
6876	-111703.948	-27322.145	16.526
6877	-111703.511	-27310.267	11.886
6878	-111703.201	-27301.788	8.485
6885	-111686.664	-27302.403	16.548

165

地番 上北ノ口九ノ一			
NO	X	Y	辺長
6935	-111694.120	-27382.839	
6856	-111706.158	-27382.394	12.046
6857	-111705.831	-27373.667	8.733
6858	-111705.744	-27371.240	2.429
6867	-111697.863	-27371.510	7.886
6866	-111697.465	-27373.187	1.724
6936	-111697.070	-27376.755	3.590
6935	-111694.120	-27382.839	6.761
面積	106.4022260		
地積	106.40 m ²		

166

地番 上北ノ口九ノ九, 一四ノ一四, 四七ノ一			
NO	X	Y	辺長
6933	-111691.078	-27387.867	
6996	-111694.418	-27389.953	3.938
6864	-111697.963	-27392.148	4.170
6855	-111706.513	-27391.850	8.555
6856	-111706.158	-27382.394	9.463
6935	-111694.120	-27382.839	12.046
6934	-111692.864	-27385.419	2.869
6933	-111691.078	-27387.867	3.030
面積	120.4487135		
地積	120.44 m ²		

167

地番 上北ノ口九ノ一一, 一四ノ二 一四ノ二, 四七ノ三			
NO	X	Y	辺長
6851	-111698.409	-27404.516	
6852	-111703.516	-27407.785	6.064
6853	-111707.042	-27405.685	4.104
6854	-111706.556	-27392.993	12.701
6855	-111706.513	-27391.850	1.144
6864	-111697.963	-27392.148	8.555
6851	-111698.409	-27404.516	12.376
面積	123.4699570		
地積	123.46 m ²		

168

地番 上北ノ口一四ノ一八			
NO	X	Y	辺長
6849	-111688.903	-27398.431	
6850	-111689.094	-27398.554	0.227
6851	-111698.409	-27404.516	11.060
6864	-111697.963	-27392.148	12.376
6996	-111694.418	-27389.953	4.170
6849	-111688.903	-27398.431	10.114
面積	78.5116180		
地積	78.51 m ²		

169

地番 上北ノ口九ノ一〇, 一四ノ一三 四七ノ二			
NO	X	Y	辺長
6848	-111687.732	-27397.682	
6849	-111688.903	-27398.431	1.390
6996	-111694.418	-27389.953	10.114
6933	-111691.078	-27387.867	3.938
6932	-111689.072	-27390.617	3.404
6931	-111687.533	-27391.858	1.977
6848	-111687.732	-27397.682	5.827
面積	36.7589070		
地積	36.75 m ²		


170

地番 上北ノ口九ノ一二			
NO	X	Y	辺長
6847	-111682.876	-27394.572	
6848	-111687.732	-27397.682	5.767
6931	-111687.533	-27391.858	5.827
6930	-111686.217	-27392.916	1.689
6847	-111682.876	-27394.572	3.729
面積	13.1534860		
地積	13.15 m ²		

図面の種類	画地面積求積表		
街区番号	60B	番号	$\frac{2}{2}$
町名	上桂北ノ口町		
京都市洛西第二土地区画整理組合			



上桂北ノ口町

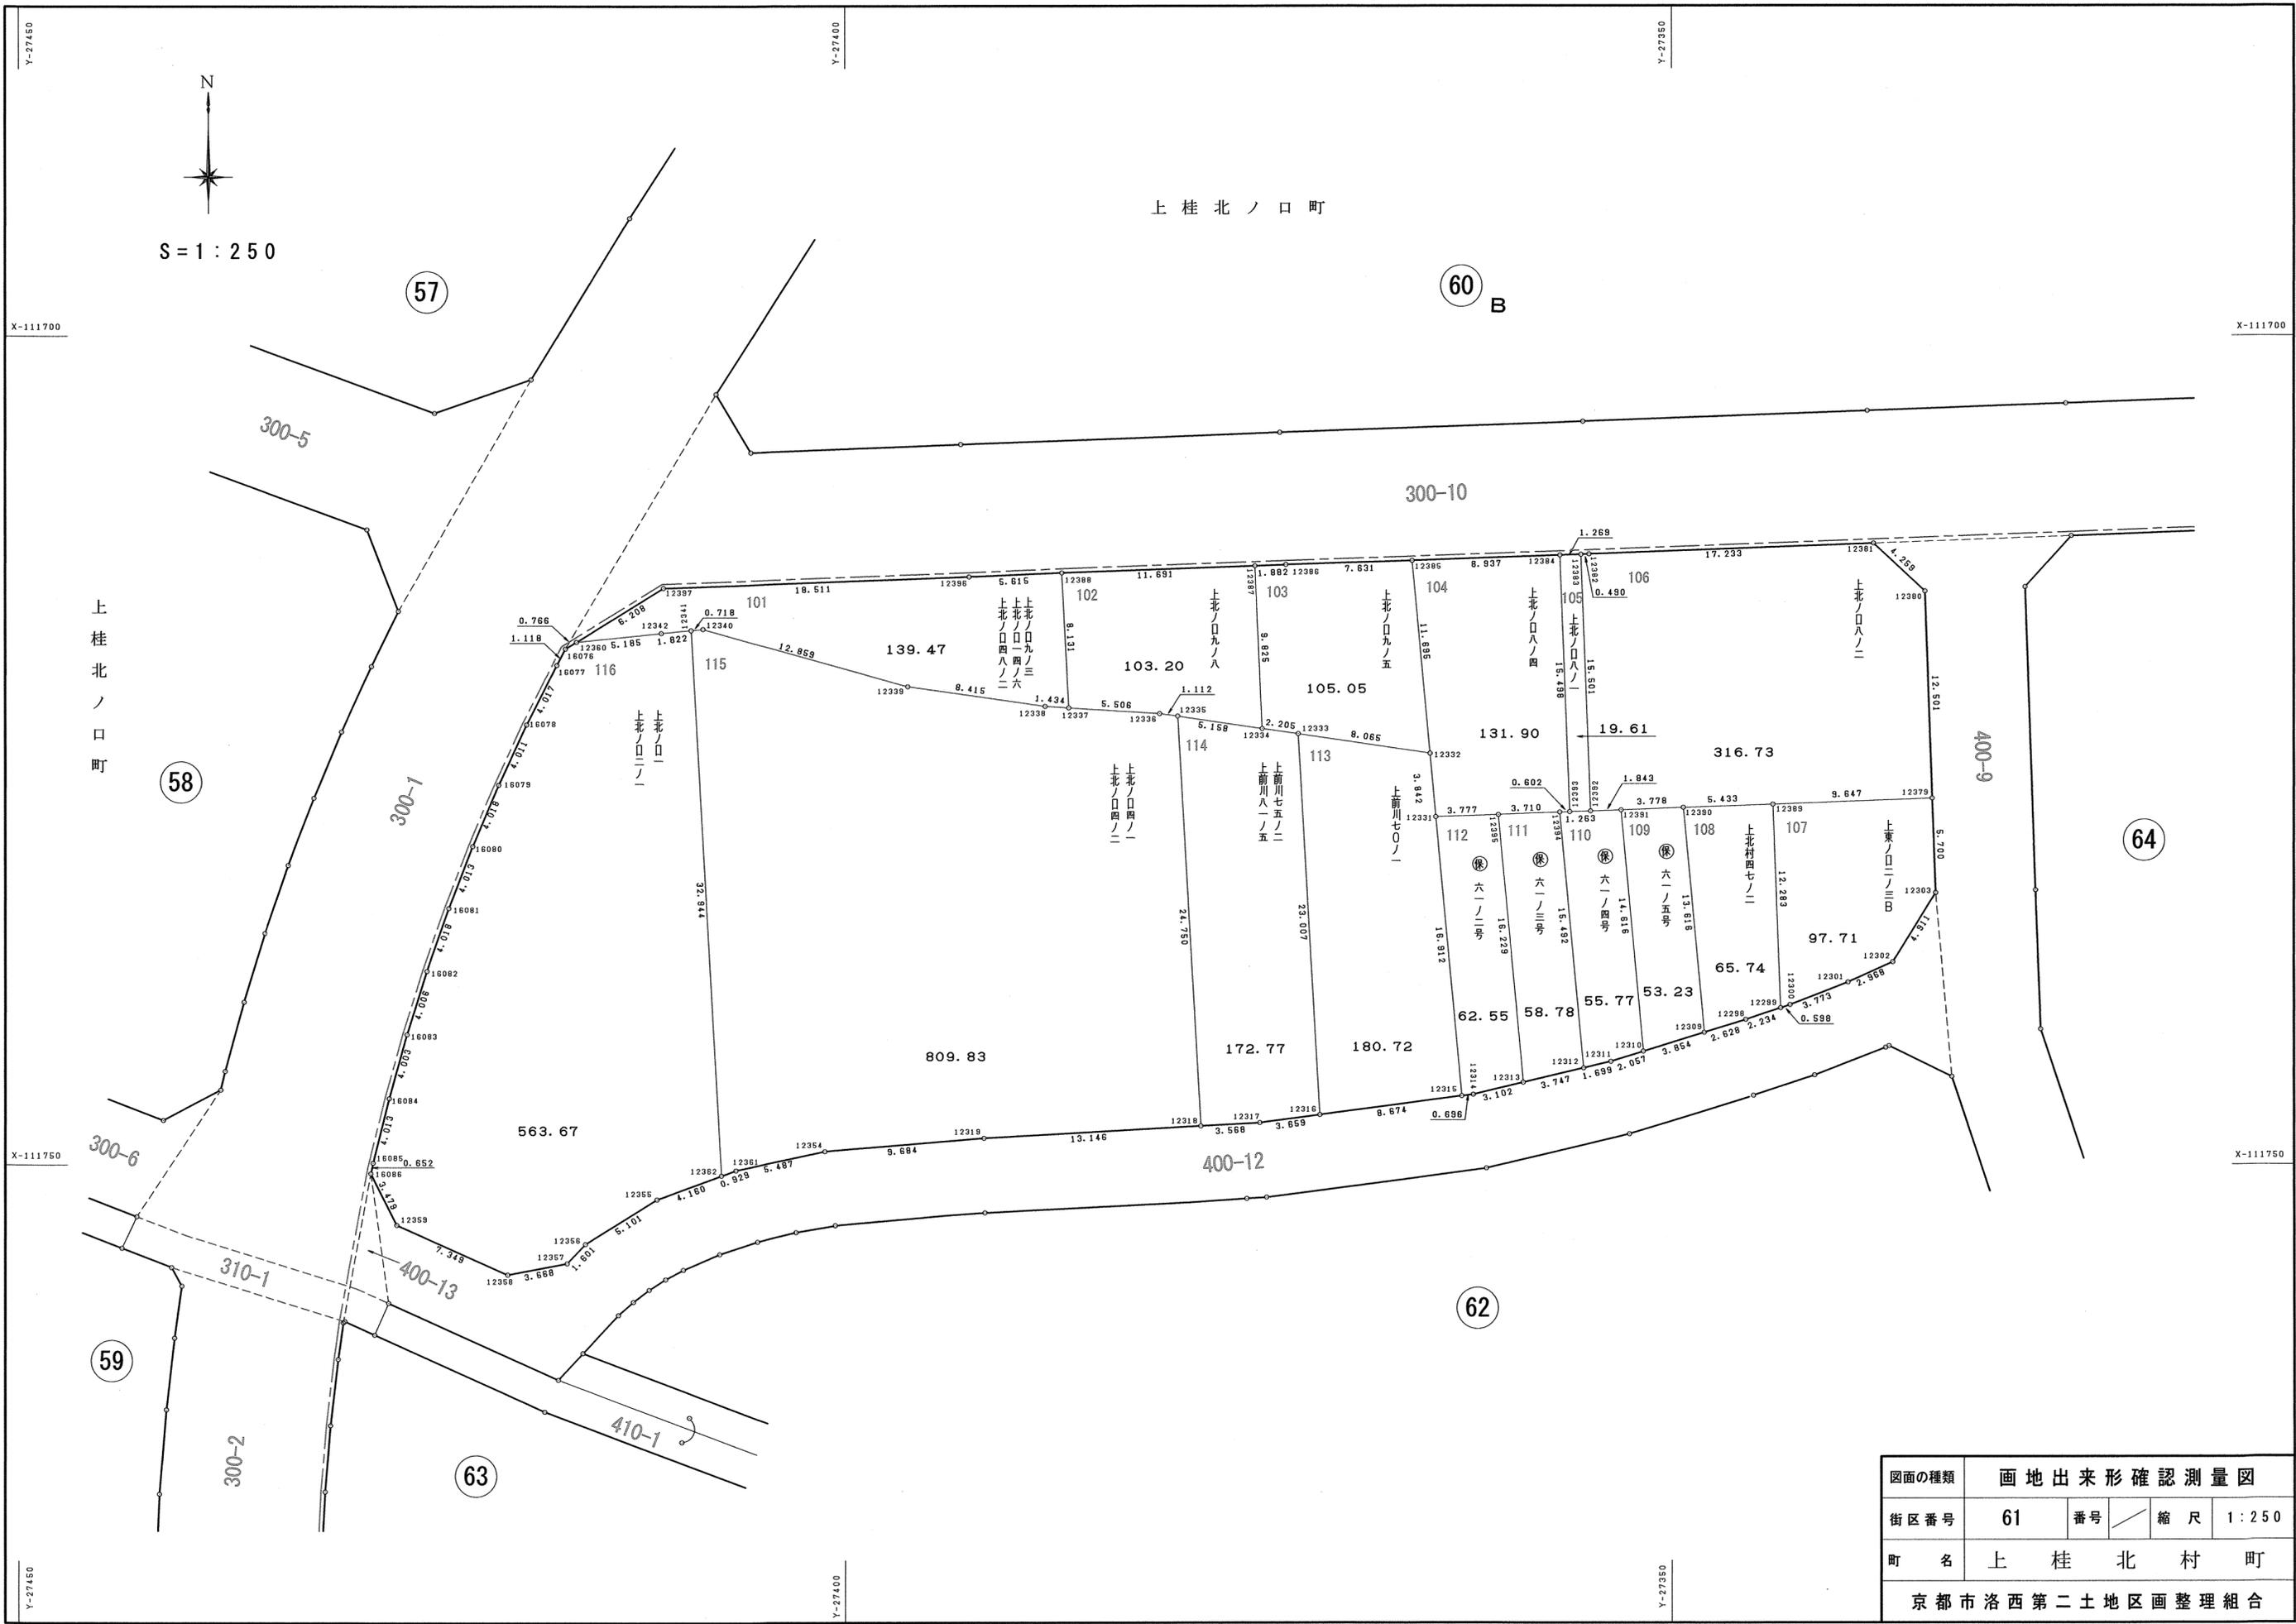

図面の種類	画地出来形確認測量図		
街区番号	61	番号	縮尺 1:250
町名	上桂北村町		
京都市洛西第二土地区画整理組合			

101

地番 上北ノ口九ノ三、一四ノ六、四八ノ二			
N O	X	Y	辺長
12388	-111714.329	-27386.869	
12396	-111714.540	-27392.480	5.615
12397	-111715.215	-27410.979	18.511
12360	-111718.463	-27416.269	6.208
12342	-111717.928	-27411.112	5.185
12341	-111717.754	-27409.298	1.822
12340	-111717.688	-27408.583	0.718
12339	-111721.157	-27396.201	12.859
12338	-111722.357	-27387.872	8.415
12337	-111722.449	-27386.441	1.434
12388	-111714.329	-27386.869	8.131
面積	139.4707695		
地積	139.47 m ²		

102

地番 上北ノ口九ノ八			
N O	X	Y	辺長
12387	-111713.889	-27375.186	
12388	-111714.329	-27386.869	11.691
12337	-111722.449	-27386.441	8.131
12336	-111722.791	-27380.946	5.506
12335	-111722.950	-27379.845	1.112
12334	-111723.704	-27374.742	5.158
12387	-111713.889	-27375.186	9.825
面積	103.2044005		
地積	103.20 m ²		

103

地番 上北ノ口九ノ五			
N O	X	Y	辺長
12385	-111713.551	-27365.679	
12386	-111713.818	-27373.305	7.631
12387	-111713.889	-27375.186	1.882
12334	-111723.704	-27374.742	9.825
12333	-111724.017	-27372.559	2.205
12332	-111725.194	-27364.580	8.065
12385	-111713.551	-27365.679	11.695
面積	105.0535940		
地積	105.05 m ²		

104

地番 上北ノ口八ノ四			
N O	X	Y	辺長
12384	-111713.238	-27356.747	
12385	-111713.551	-27365.679	8.937
12332	-111725.194	-27364.580	11.695
12331	-111729.021	-27364.236	3.842
12395	-111728.886	-27360.461	3.777
12394	-111728.745	-27356.754	3.710
12393	-111728.725	-27356.152	0.602
12384	-111713.238	-27356.747	15.498
面積	131.9086820		
地積	131.90 m ²		

105

地番 上北ノ口八ノ一			
N O	X	Y	辺長
12383	-111713.193	-27355.479	
12384	-111713.238	-27356.747	1.269
12393	-111728.725	-27356.152	15.498
12392	-111728.683	-27354.890	1.263
12383	-111713.193	-27355.479	15.501
面積	19.6187045		
地積	19.61 m ²		

106

地番 上北ノ口八ノ二			
N O	X	Y	辺長
12381	-111712.534	-27337.768	
12382	-111713.176	-27354.989	17.233
12383	-111713.193	-27355.479	0.490
12392	-111728.683	-27354.890	15.501
12391	-111728.613	-27353.048	1.843
12390	-111728.471	-27349.273	3.778
12389	-111728.276	-27343.844	5.433
12379	-111727.916	-27334.204	9.647
12380	-111715.423	-27334.639	12.501
12381	-111712.534	-27337.768	4.259
面積	316.7320005		
地積	316.73 m ²		

107

地番 上東ノ口二ノ三B			
N O	X	Y	辺長
12379	-111727.916	-27334.204	
12389	-111728.276	-27343.844	9.647
12299	-111740.551	-27343.390	12.283
12300	-111740.363	-27342.822	0.598
12301	-111739.004	-27339.302	3.773
12302	-111737.786	-27336.595	2.968
12303	-111733.613	-27334.005	4.911
12379	-111727.916	-27334.204	5.700
面積	97.7186195		
地積	97.71 m ²		

108

地番 上北村四七ノ二			
N O	X	Y	辺長
12389	-111728.276	-27343.844	
12390	-111728.471	-27349.273	5.433
12309	-111742.029	-27348.022	13.616
12298	-111741.253	-27345.511	2.628
12299	-111740.551	-27343.390	2.234
12389	-111728.276	-27343.844	12.283
面積	65.7479825		
地積	65.74 m ²		

109

地番 保 六一ノ五号			
N O	X	Y	辺長
12390	-111728.471	-27349.273	
12391	-111728.613	-27353.048	3.778
12310	-111743.167	-27351.704	14.616
12309	-111742.029	-27348.022	3.854
12390	-111728.471	-27349.273	13.616
面積	53.2381960		
地積	53.23 m ²		

110

地番 保 六一ノ四号			
N O	X	Y	辺長
12391	-111728.613	-27353.048	
12392	-111728.683	-27354.890	1.843
12393	-111728.725	-27356.152	1.263
12394	-111728.745	-27356.754	0.602
12312	-111744.171	-27355.321	15.492
12311	-111743.774	-27353.669	1.699
12310	-111743.167	-27351.704	2.057
12391	-111728.613	-27353.048	14.616
面積	55.7777225		
地積	55.77 m ²		

111

地番 保 六一ノ三号			
N O	X	Y	辺長
12394	-111728.745	-27356.754	
12395	-111728.886	-27360.461	3.710
12313	-111745.046	-27358.964	16.229
12312	-111744.171	-27355.321	3.747
12394	-111728.745	-27356.754	15.492
面積	58.7834950		
地積	58.78 m ²		

112

地番 保 六一ノ二号			
N O	X	Y	辺長
12395	-111728.886	-27360.461	
12331	-111729.021	-27364.236	3.777
12315	-111745.860	-27362.670	16.912
12314	-111745.770	-27361.980	0.696
12313	-111745.046	-27358.964	3.102
12395	-111728.886	-27360.461	16.229
面積	62.5571365		
地積	62.55 m ²		

113

地番 上前川七〇ノ一			
N O	X	Y	辺長
12332	-111725.194	-27364.580	
12333	-111724.017	-27372.559	8.065
12316	-111746.988	-27371.270	23.007
12315	-111745.860	-27362.670	8.674
12331	-111729.021	-27364.236	16.912
12332	-111725.194	-27364.580	3.842
面積	180.7250350		
地積	180.72 m ²		

114

地番 上前川七五ノ二、上前川八一ノ五			
N O	X	Y	辺長
12333	-111724.017	-27372.559	
12334	-111723.704	-27374.742	2.205
12335	-111722.950	-27379.845	5.158
12318	-111747.661	-27378.461	24.750
12317	-111747.463	-27374.898	3.568
12316	-111746.988	-27371.270	3.659
12333	-111724.017	-27372.559	23.007
面積	172.7724570		
地積	172.77 m ²		

115

地番 上北ノ口四ノ一、上北ノ口四ノ二			
N O	X	Y	辺長
12335	-111722.950	-27379.845	
12336	-111722.791	-27380.946	1.112
12337	-111722.449	-27386.441	5.506
12338	-111722.357	-27387.872	1.434
12339	-111721.157	-27396.201	8.415
12340	-111717.688	-27408.583	12.859
12341	-111717.754	-27409.298	0.718
12362	-111750.648	-27407.477	32.944
12361	-111750.328	-27406.605	0.929
12354	-111749.186	-27401.238	5.487
12319	-111748.392	-27391.587	9.684
12318	-111747.661	-27378.461	13.146
12335	-111722.950	-27379.845	24.750
面積	809.8370655		
地積	809.83 m ²		

116

地番 上北ノ口一、上北ノ口二ノ一			
N O	X	Y	辺長
12341	-111717.754	-27409.298	
12342	-111717.928	-27411.112	1.822
12360	-111718.463	-27416.269	5.185
16076	-111718.864	-27416.922	0.766
16077	-111719.855	-27417.440	1.118
16078	-111723.439	-27419.254	4.017
16079	-111727.074	-27420.949	4.011
16080	-111730.772	-27422.521	4.018
16081	-111734.515	-27423.968	4.013
16082	-111738.304	-27425.305	4.018
16083	-111742.126	-27426.506	4.006
16084	-111745.981	-27427.583	4.003
16085	-111749.875	-27428.554	4.013
16086	-111750.512	-27428.693	0.652
12359	-111753.621	-27427.131	3.479
12358	-111756.620	-27420.422	7.349
12357	-111755.934	-27416.819	3.668
12356	-111754.776	-27415.713	1.601
12355	-111752.079	-27411.383	5.101
12362	-111750.648	-27407.477	4.160
12341	-111717.754	-27409.298	32.944
面積	563.6757530		
地積	563.67 m ²		

図面の種類	画地面積求積表		
街区番号	61	番号	縮尺
町名	上桂北村町		
京都市洛西第二土地区画整理組合			



S = 1 : 250

上桂北ノ口町

X-111750

X-111750

Y-27400

Y-27350

Y-27300

Y-27400

Y-27350

Y-27300

X-111800

X-111800

61

64

63

65 A

400-12


400-13

400-9

410-1

400-10

400-14

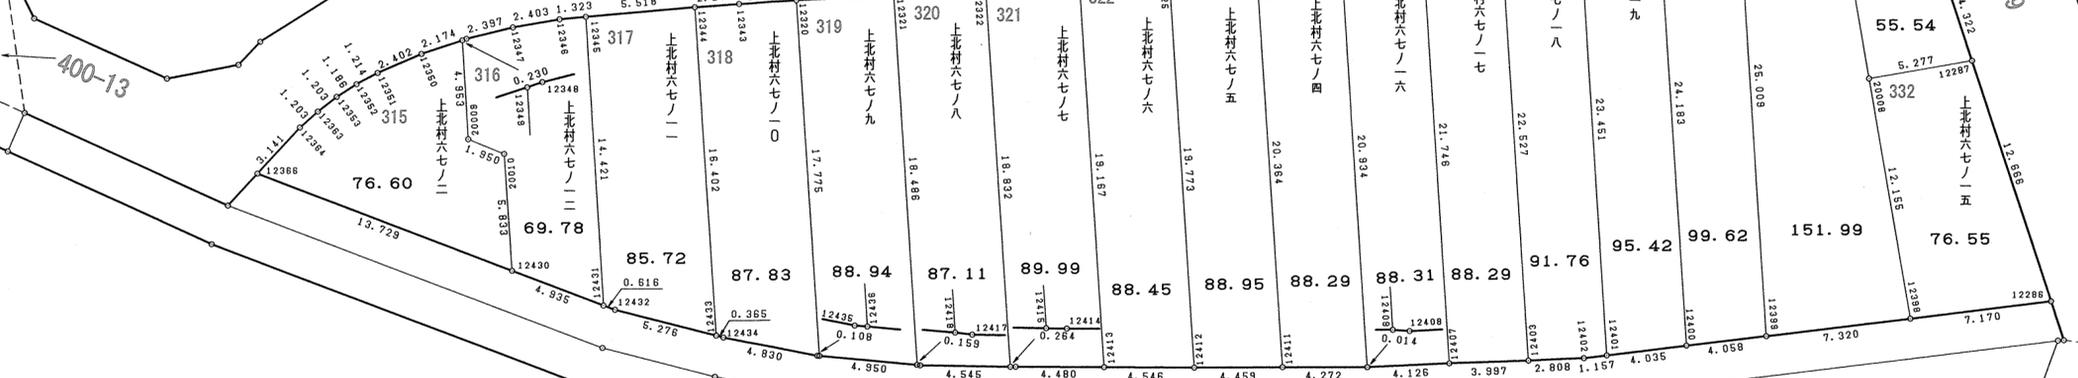

図面の種類	画地出来形確認測量図		
街区番号	62	番号	縮尺 1:250
町名	上桂北村町		
京都市洛西第二土地区画整理組合			

315

地番 上北村六七ノ二			
NO	X	Y	辺長
12349	-111754.704	-27405.514	
12350	-111755.385	-27407.579	2.174
12351	-111756.335	-27409.785	2.402
12352	-111756.896	-27410.862	1.214
12353	-111757.533	-27411.862	1.186
12363	-111758.264	-27412.817	1.203
12364	-111759.061	-27413.718	1.203
12366	-111761.357	-27415.862	3.141
12430	-111766.199	-27403.015	13.729
20010	-111760.379	-27403.410	5.833
20009	-111759.648	-27405.218	1.950
12349	-111754.704	-27405.514	4.953
面積	76.6087850		
地積	76.60 m ²		

316

地番 上北村六七ノ一二			
NO	X	Y	辺長
12345	-111753.546	-27399.281	
12346	-111753.657	-27400.599	1.323
12347	-111754.060	-27402.968	2.403
12348	-111754.632	-27405.296	2.397
12349	-111754.704	-27405.514	0.230
20009	-111759.648	-27405.218	4.953
20010	-111760.379	-27403.410	1.950
12430	-111766.199	-27403.015	5.833
12431	-111767.940	-27398.397	4.935
12345	-111753.546	-27399.281	14.421
面積	69.7851225		
地積	69.78 m ²		

317

地番 上北村六七ノ一一			
NO	X	Y	辺長
12344	-111753.083	-27393.782	
12345	-111753.546	-27399.281	5.518
12431	-111767.940	-27398.397	14.421
12432	-111768.157	-27397.821	0.616
12433	-111769.450	-27392.706	5.276
12344	-111753.083	-27393.782	16.402
面積	85.7234610		
地積	85.72 m ²		

318

地番 上北村六七ノ一〇			
NO	X	Y	辺長
12320	-111752.746	-27388.657	
12343	-111752.895	-27391.543	2.890
12344	-111753.083	-27393.782	2.247
12433	-111769.450	-27392.706	16.402
12434	-111769.539	-27392.352	0.365
12435	-111770.474	-27387.613	4.830
12436	-111770.484	-27387.505	0.108
12320	-111752.746	-27388.657	17.775
面積	87.8335285		
地積	87.83 m ²		

319

地番 上北村六七ノ九			
NO	X	Y	辺長
12321	-111752.491	-27383.741	
12320	-111752.746	-27388.657	4.923
12436	-111770.484	-27387.505	17.775
12418	-111770.940	-27382.576	4.950
12321	-111752.491	-27383.741	18.486
面積	88.9488245		
地積	88.94 m ²		

320

地番 上北村六七ノ八			
NO	X	Y	辺長
12322	-111752.251	-27379.098	
12321	-111752.491	-27383.741	4.649
12418	-111770.940	-27382.576	18.486
12417	-111770.955	-27382.418	0.159
12415	-111771.043	-27377.874	4.545
12322	-111752.251	-27379.098	18.832
面積	87.1132375		
地積	87.11 m ²		

321

地番 上北村六七ノ七			
NO	X	Y	辺長
12324	-111751.932	-27374.356	
12323	-111751.947	-27374.470	0.115
16378	-111752.074	-27375.689	1.226
12322	-111752.251	-27379.098	3.414
12415	-111771.043	-27377.874	18.832
12414	-111771.048	-27377.610	0.264
12413	-111771.060	-27373.130	4.480
12324	-111751.932	-27374.356	19.167
面積	89.9958990		
地積	89.99 m ²		

322

地番 上北村六七ノ六			
NO	X	Y	辺長
12325	-111751.338	-27369.834	
12324	-111751.932	-27374.356	4.561
12413	-111771.060	-27373.130	19.167
12412	-111771.071	-27368.584	4.546
12325	-111751.338	-27369.834	19.773
面積	88.4587640		
地積	88.45 m ²		

323

地番 上北村六七ノ五			
NO	X	Y	辺長
12326	-111750.762	-27365.446	
12325	-111751.338	-27369.834	4.426
12412	-111771.071	-27368.584	19.773
12411	-111771.083	-27364.125	4.459
12326	-111750.762	-27365.446	20.364
面積	88.9519455		
地積	88.95 m ²		

324

地番 上北村六七ノ四			
NO	X	Y	辺長
12327	-111750.202	-27361.184	
12326	-111750.762	-27365.446	4.299
12411	-111771.083	-27364.125	20.364
12409	-111771.094	-27359.853	4.272
12327	-111750.202	-27361.184	20.934
面積	88.2919225		
地積	88.29 m ²		

325

地番 上北村六七ノ一六			
NO	X	Y	辺長
12328	-111749.229	-27357.100	
12327	-111750.202	-27361.184	4.198
12409	-111771.094	-27359.853	20.934
12408	-111771.094	-27359.839	0.014
12407	-111770.931	-27355.716	4.126
12328	-111749.229	-27357.100	21.746
面積	88.3135195		
地積	88.31 m ²		

326

地番 上北村六七ノ一七			
NO	X	Y	辺長
12329	-111748.293	-27353.170	
12328	-111749.229	-27357.100	4.040
12407	-111770.931	-27355.716	21.746
12403	-111770.773	-27351.722	3.997
12329	-111748.293	-27353.170	22.527
面積	88.2990940		
地積	88.29 m ²		

327

地番 上北村六七ノ一八			
NO	X	Y	辺長
12297	-111747.119	-27349.220	
12330	-111748.144	-27352.544	3.478
12329	-111748.293	-27353.170	0.643
12403	-111770.773	-27351.722	22.527
12402	-111770.662	-27348.916	2.808
12401	-111770.525	-27347.767	1.157
12297	-111747.119	-27349.220	23.451
面積	91.7687675		
地積	91.76 m ²		

328

地番 上北村六七ノ一九			
NO	X	Y	辺長
12296	-111745.912	-27345.303	
12297	-111747.119	-27349.220	4.099
12401	-111770.525	-27347.767	23.451
12400	-111770.046	-27343.761	4.035
12296	-111745.912	-27345.303	24.183
面積	95.4272475		
地積	95.42 m ²		

329

地番 上北村六七ノ二〇			
NO	X	Y	辺長
12293	-111744.607	-27341.328	
12294	-111744.616	-27341.351	0.025
12295	-111745.831	-27345.040	3.884
12296	-111745.912	-27345.303	0.275
12400	-111770.046	-27343.761	24.183
12399	-111769.565	-27339.732	4.058
12293	-111744.607	-27341.328	25.009
面積	99.6209610		
地積	99.62 m ²		

330

地番 上北村六七ノ一			
NO	X	Y	辺長
12291	-111742.891	-27336.925	
12292	-111742.943	-27337.032	0.119
12293	-111744.607	-27341.328	4.607
12399	-111769.565	-27339.732	25.009
12398	-111768.697	-27332.464	7.320
20008	-111756.720	-27334.535	12.155
12291	-111742.891	-27336.925	14.034
面積	151.9993965		
地積	151.99 m ²		

331


地番 上北村六七ノ二一			
NO	X	Y	辺長
12290	-111742.843	-27336.827	
12291	-111742.891	-27336.925	0.109
20008	-111756.720	-27334.535	14.034
12287	-111755.826	-27329.334	5.277
12288	-111751.724	-27330.695	4.322
12289	-111744.701	-27333.029	7.401
12290	-111742.843	-27336.827	4.228
面積	55.5482460		
地積	55.54 m ²		

332

地番 上北村六七ノ一五			
NO	X	Y	辺長
12287	-111755.826	-27329.334	
20008	-111756.720	-27334.535	5.277
12398	-111768.697	-27332.464	12.155
12286	-111767.847	-27325.345	7.170
12287	-111755.826	-27329.334	12.666
面積	76.5560000		
地積	76.55 m ²		

図面の種類	画地面積求積表		
街区番号	62	番号	縮尺
町名	上桂北村町		
京都市洛西第二土地区画整理組合			

N
S = 1 : 250

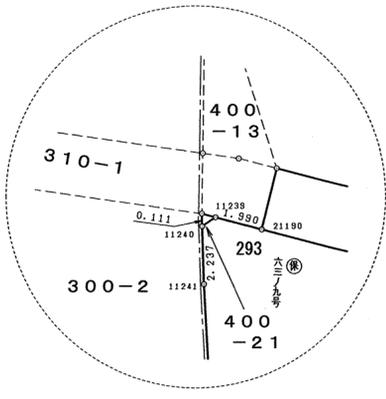

図面の種類	画地出来形確認測量図			
街区番号	63	番号	縮尺	1 : 250
町名	上桂北村町			
京都市洛西第二土地区画整理組合				

293

地番 保 六三ノ九号			
N O	X	Y	辺長
11239	-111759.435	-27430.277	
11240	-111759.501	-27430.366	0.111
11241	-111761.717	-27430.675	2.237
11242	-111765.701	-27431.140	4.011
16379	-111767.132	-27431.258	1.436
16381	-111767.889	-27422.090	9.199
11248	-111766.044	-27420.599	2.372
11238	-111764.459	-27419.107	2.177
21190	-111760.241	-27428.458	10.258
11239	-111759.435	-27430.277	1.990
面積	62.7757165		
地積	62.77 m ²		

294

地番 保 六三ノ三号			
N O	X	Y	辺長
16379	-111767.132	-27431.258	
11243	-111769.692	-27431.470	2.569
11244	-111773.739	-27431.663	4.052
11245	-111776.844	-27431.722	3.106
11246	-111778.481	-27430.372	2.122
11247	-111775.830	-27428.531	3.228
16381	-111767.889	-27422.090	10.225
16379	-111767.132	-27431.258	9.199
面積	58.0117920		
地積	58.01 m ²		

295

地番 上北村八一ノ二、上北村九三ノ一			
N O	X	Y	辺長
12428	-111767.325	-27411.665	
12429	-111764.878	-27418.176	6.956
11238	-111764.459	-27419.107	1.021
11248	-111766.044	-27420.599	2.177
16381	-111767.889	-27422.090	2.372
11247	-111775.830	-27428.531	10.225
11246	-111778.481	-27430.372	3.228
12440	-111779.810	-27429.276	1.723
12441	-111780.135	-27427.389	1.915
12442	-111780.778	-27425.116	2.362
12443	-111783.094	-27416.553	8.871
12428	-111767.325	-27411.665	16.509
面積	197.0853595		
地積	197.08 m ²		

296

地番 上北村六八ノ一			
N O	X	Y	辺長
12427	-111769.348	-27406.279	
12428	-111767.325	-27411.665	5.753
12443	-111783.094	-27416.553	16.509
12446	-111784.606	-27410.963	5.791
12427	-111769.348	-27406.279	15.961
面積	93.5973430		
地積	93.59 m ²		

297

地番 上北村六八ノ二			
N O	X	Y	辺長
12426	-111771.146	-27401.495	
12427	-111769.348	-27406.279	5.111
12446	-111784.606	-27410.963	15.961
12447	-111785.377	-27408.114	2.951
12448	-111785.941	-27406.046	2.144
12426	-111771.146	-27401.495	15.479
面積	80.1131480		
地積	80.11 m ²		

298

地番 上北村六八ノ三			
N O	X	Y	辺長
12424	-111772.572	-27397.020	
12425	-111772.045	-27399.103	2.149
12426	-111771.146	-27401.495	2.555
12448	-111785.941	-27406.046	15.479
12449	-111787.177	-27401.512	4.699
12424	-111772.572	-27397.020	15.280
面積	71.9282500		
地積	71.92 m ²		

299

地番 上北村六八ノ四			
N O	X	Y	辺長
12422	-111773.696	-27392.366	
12423	-111773.525	-27393.249	0.899
12424	-111772.572	-27397.020	3.890
12449	-111787.177	-27401.512	15.280
12450	-111788.562	-27396.429	5.268
12422	-111773.696	-27392.366	15.411
面積	77.0075765		
地積	77.00 m ²		

300

地番 上北村九五			
N O	X	Y	辺長
12450	-111788.562	-27396.429	
12451	-111788.716	-27395.865	0.585
21113	-111788.792	-27395.604	0.272
21114	-111773.859	-27391.523	15.481
12422	-111773.696	-27392.366	0.859
12450	-111788.562	-27396.429	15.411
面積	13.2249960		
地積	13.22 m ²		

301

地番 上北村八〇ノ二			
N O	X	Y	辺長
21113	-111788.792	-27395.604	
12452	-111791.741	-27385.485	10.540
11229	-111792.009	-27384.567	0.956
16348	-111786.423	-27383.255	5.738
21111	-111781.119	-27382.005	5.449
11228	-111775.074	-27380.580	6.211
11240	-111775.028	-27382.634	2.055
12421	-111774.501	-27388.201	5.592
21114	-111773.859	-27391.523	3.383
21113	-111788.792	-27395.604	15.481
面積	182.1165670		
地積	182.11 m ²		

302

地番 保 六三ノ六号			
N O	X	Y	辺長
11228	-111775.074	-27380.580	
21111	-111781.119	-27382.005	6.211
16353	-111781.138	-27372.748	9.257
16351	-111781.157	-27370.291	2.457
16352	-111775.153	-27370.276	6.004
11227	-111775.132	-27377.977	7.701
11228	-111775.074	-27380.580	2.604
面積	66.1052430		
地積	66.10 m ²		

303

地番 保 六三ノ五号			
N O	X	Y	辺長
21111	-111781.119	-27382.005	
16348	-111786.423	-27383.255	5.449
16354	-111786.446	-27373.144	10.111
16353	-111781.138	-27372.748	5.323
21111	-111781.119	-27382.005	9.257
面積	51.4005870		
地積	51.40 m ²		

304

地番 保 六三ノ四号			
N O	X	Y	辺長
16348	-111786.423	-27383.255	
11229	-111792.009	-27384.567	5.738
11230	-111792.772	-27381.950	2.726
16346	-111795.179	-27374.983	7.371
16347	-111793.163	-27372.483	3.212
16355	-111787.114	-27373.194	6.091
16354	-111786.446	-27373.144	0.670
16348	-111786.423	-27383.255	10.111
面積	81.2006520		
地積	81.20 m ²		

305

地番 保 六三ノ七号			
N O	X	Y	辺長
16352	-111775.153	-27370.276	
16351	-111781.157	-27370.291	6.004
16350	-111781.166	-27367.836	2.455
21112	-111781.185	-27358.531	9.305
11225	-111775.122	-27358.305	6.067
11226	-111775.181	-27359.828	1.524
16352	-111775.153	-27370.276	10.448
面積	71.2793255		
地積	71.27 m ²		

306

地番 保 六三ノ八号			
N O	X	Y	辺長
16350	-111781.166	-27367.836	
16349	-111787.010	-27368.260	5.859
11234	-111787.022	-27368.154	0.107
11235	-111787.057	-27368.898	1.256
11236	-111788.239	-27360.297	6.706
11237	-111788.505	-27358.803	1.517
21112	-111781.185	-27358.531	7.325
16350	-111781.166	-27367.836	9.305
面積	61.2240245		
地積	61.22 m ²		

307

地番 保 六三ノ一号			
N O	X	Y	辺長
16353	-111781.138	-27372.748	
16354	-111786.446	-27373.144	5.323
16355	-111787.114	-27373.194	0.670
16347	-111793.163	-27372.483	6.091
16346	-111795.179	-27374.983	3.212
11231	-111796.893	-27370.023	5.248
11232	-111797.800	-27367.376	2.798
11233	-111797.959	-27366.880	0.521
11234	-111787.022	-27368.154	11.011
16349	-111787.010	-27368.260	0.107
16350	-111781.166	-27367.836	5.859
16351	-111781.157	-27370.291	2.455
16353	-111781.138	-27372.748	2.457
面積	83.6691480		
地積	83.66 m ²		

308

地番 保 六三ノ二号			
N O	X	Y	辺長
12405	-111774.150	-27343.604	
12406	-111774.747	-27348.619	5.050
11225	-111775.122	-27358.305	9.693
21112	-111781.185	-27358.531	6.067
11237	-111788.505	-27358.803	7.325
13301	-111789.410	-27353.830	5.055
12483	-111790.396	-27348.436	5.483
12467	-111793.544	-27333.595	15.171
12468	-111791.005	-27332.641	2.712
12484	-111788.520	-27344.132	11.757
12485	-111781.348	-27343.859	7.177
12405	-111774.150	-27343.604	7.203
面積	251.9158365		
地積	251.91 m ²		

309

地番 上北村六九ノ二			
N O	X	Y	辺長
12529	-111772.001	-27325.504	
12530	-111772.035	-27325.836	0.334
12405	-111774.150	-27343.604	17.893
12485	-111781.348	-27343.859	7.203
12470	-111784.286	-27330.116	14.054
12529	-111772.001	-27325.504	13.122
面積	156.1083420		
地積	156.10 m ²		

310

地番 上北村六九ノ一			
N O	X	Y	辺長
12470	-111784.286	-27330.116	
12485	-111781.348	-27343.859	14.054
12484	-111788.520	-27344.132	7.177
12468	-111791.005	-27332.641	11.757
12469	-111786.462	-27330.933	4.853
12470	-111784.286	-27330.116	2.324
面積	91.4272505		
地積	91.42 m ²		

311

地番 上北村七九ノ二			
N O	X	Y	辺長
12467	-111793.544	-27333.595	
12483	-111790.396	-27348.436	15.171
12463	-111802.807	-27350.800	12.634
12464	-111805.537	-27343.875	7.444
12465	-111806.595	-27341.969	2.180
12466	-111805.183	-27337.971	4.240
12467	-111793.544	-27333.595	12.434
面積	188.4190780		
地積	188.41 m ²		

312

地番 上北村七九ノ四			
N O	X	Y	辺長
12483	-111790.396	-27348.436	
13301	-111789.410	-27353.830	5.483
12460	-111801.304	-27356.142	12.117
12461	-111801.313	-27356.110	0.033
12462	-111801.828	-27354.286	1.895
12463	-111802.807	-27350.800	3.621
12483	-111790.396	-27348.436	

S = 1 : 250



図面の種類	画地出来形確認測量図			
街区番号	64 1/2	番号	縮尺	1 : 250
町名	上桂北村町			
京都市洛西第二土地区画整理組合				

S = 1 : 250


68

公 5

66

65 B

65 A

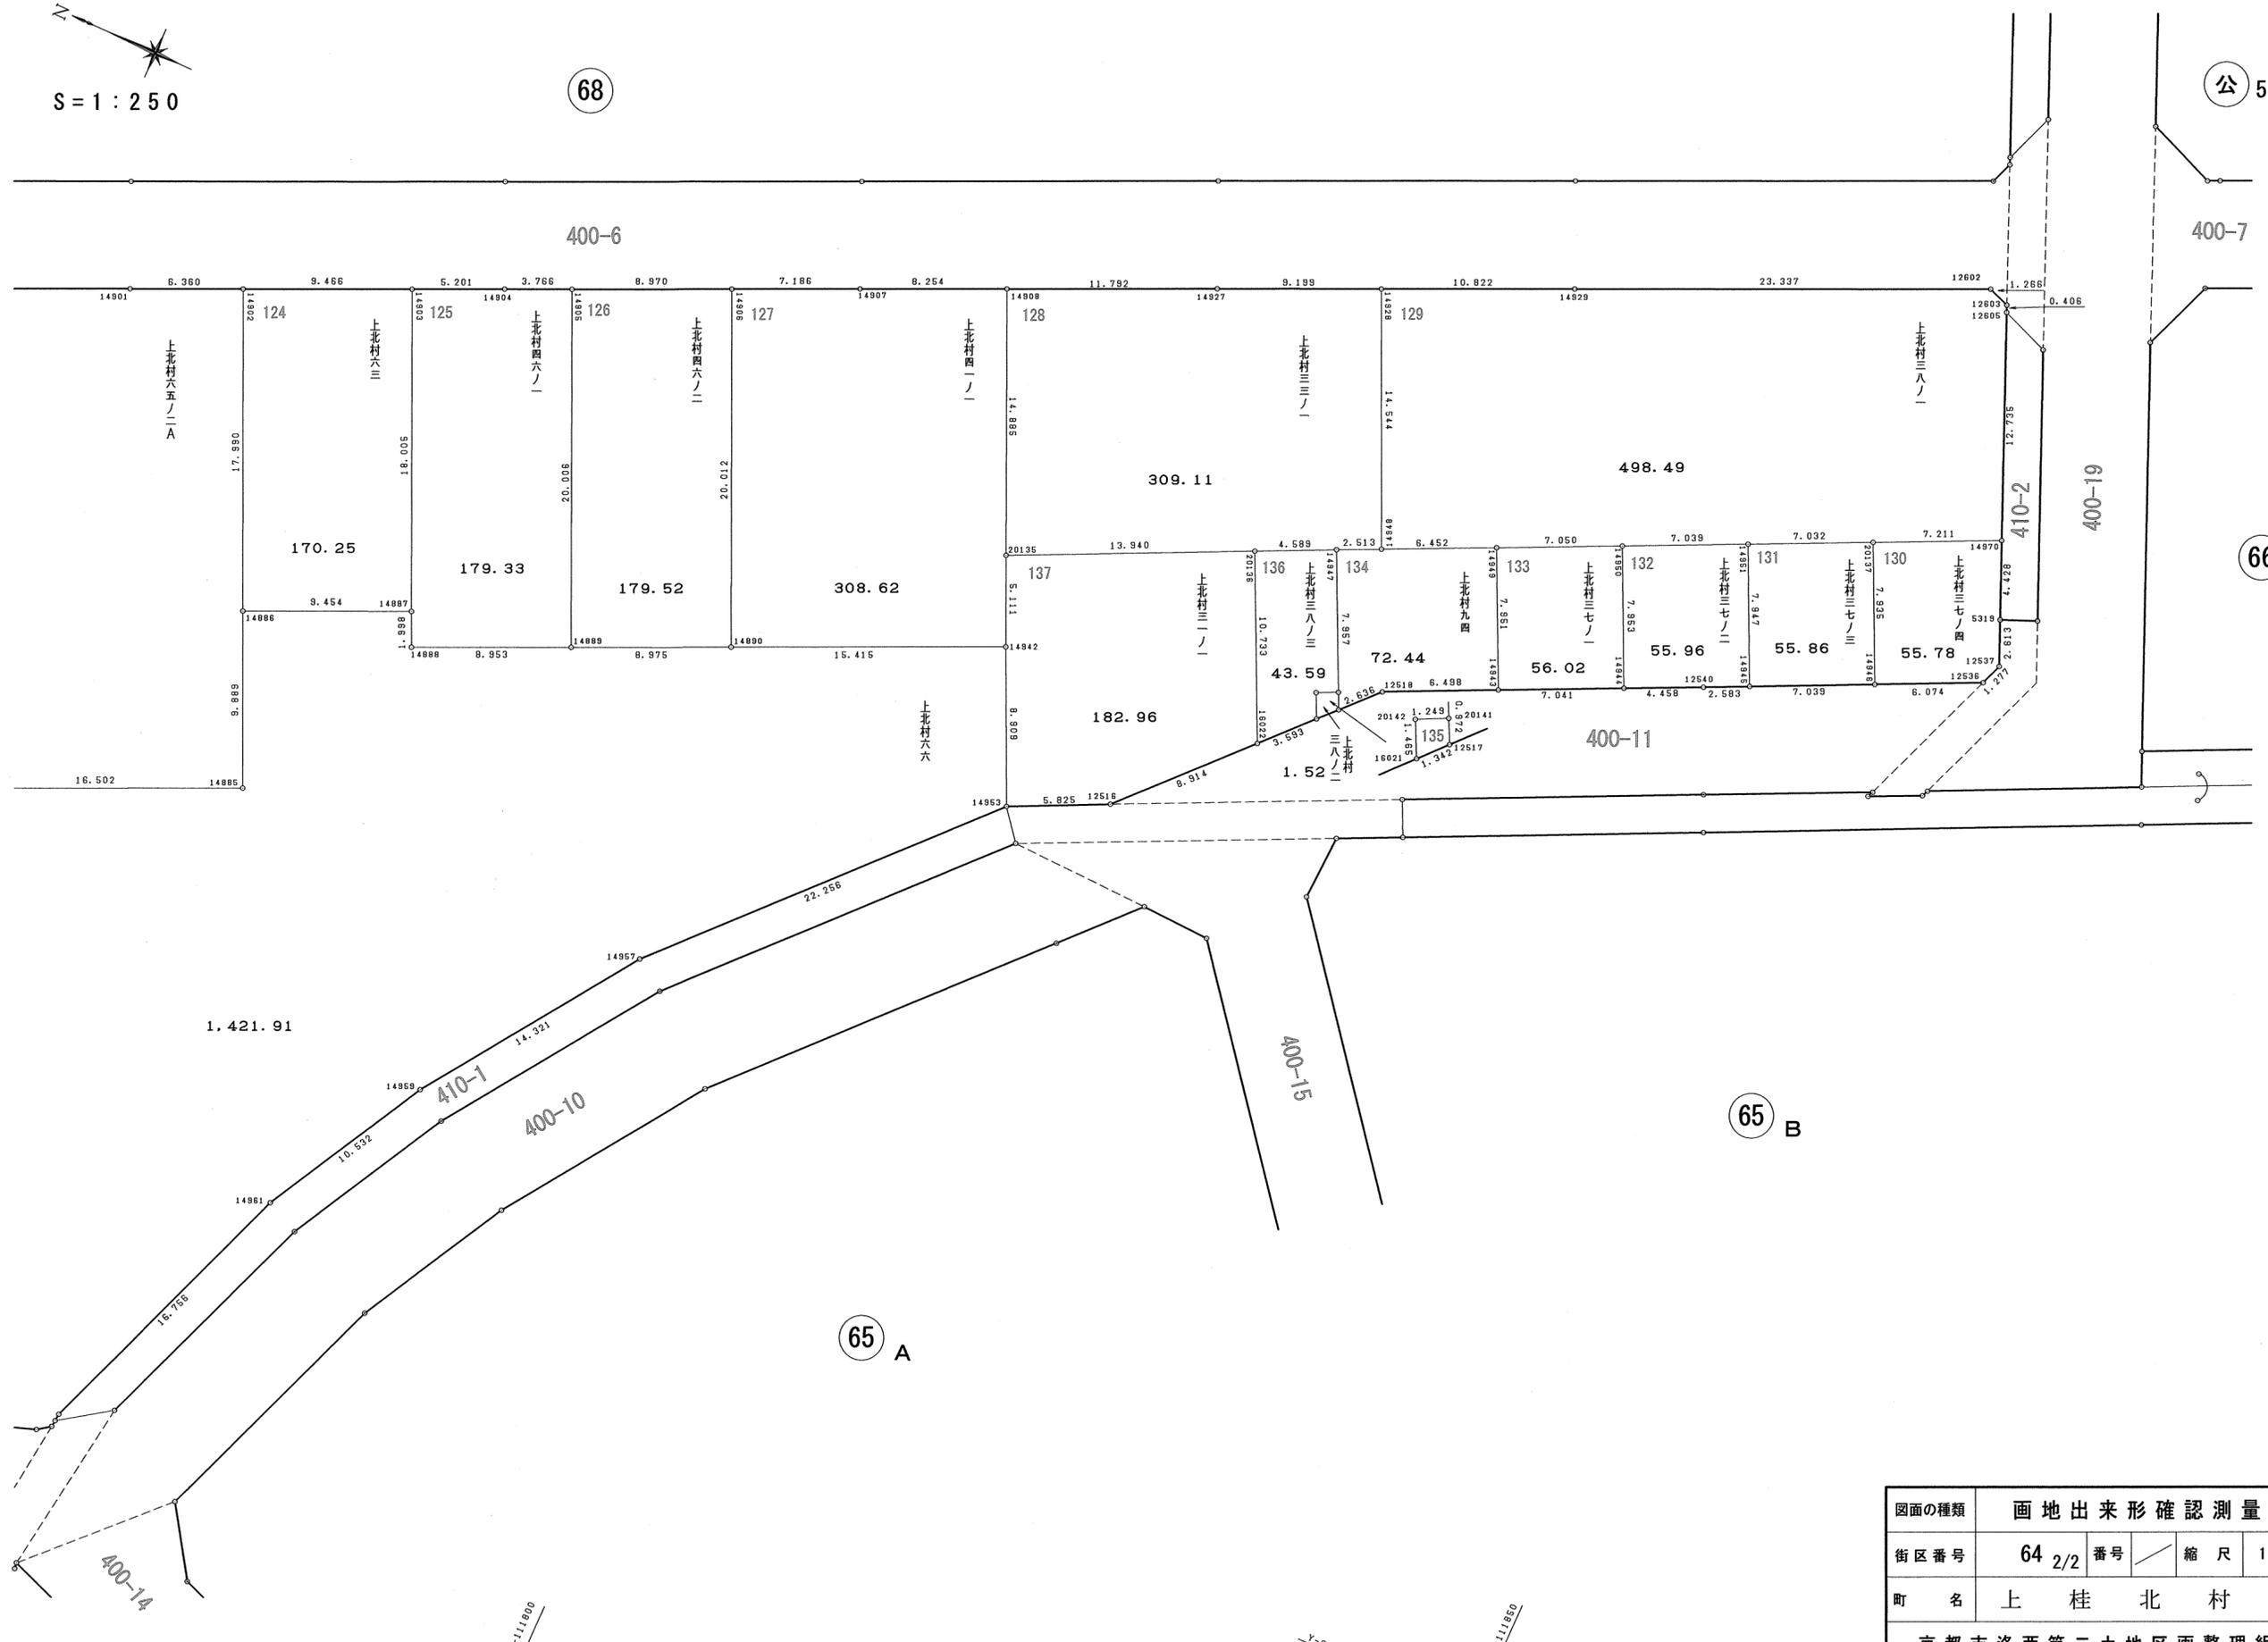

図面の種類	画地出来形確認測量図			
街区番号	64	2/2	番号	縮尺 1 : 250
町名	上 桂 北 村 町			
京都市洛西第二土地区画整理組合				

117

Table with 4 columns: NO, X, Y, 辺長. Includes area and ground area calculations.

118

Table with 4 columns: NO, X, Y, 辺長. Includes area and ground area calculations.

119

Table with 4 columns: NO, X, Y, 辺長. Includes area and ground area calculations.

Summary table with columns: 図面の種類, 画地面積, 求積表, 街区番号, 番号, 縮尺, 町名, 京都市洛西第二土地区画整理組合.

275

地番 上北村七七ノ二、七七ノ三、七八ノ一、七八ノ三			
NO	X	Y	辺長
12522	-111819.155	-27301.380	
11252	-111816.247	-27303.943	3.876
11251	-111812.373	-27307.296	5.124
16288	-111810.700	-27307.914	1.783
16302	-111803.705	-27310.515	7.463
11250	-111799.008	-27312.255	5.009
16301	-111800.494	-27316.214	4.229
12472	-111806.428	-27332.036	16.898
12473	-111808.689	-27332.890	2.417
12474	-111813.120	-27331.410	4.672
12475	-111814.456	-27329.370	2.439
12476	-111822.524	-27320.385	12.076
12477	-111827.931	-27314.305	8.136
12486	-111830.352	-27311.584	3.642
12522	-111819.155	-27301.380	15.149
面積	513.8589930		
地積	513.85 m ²		

276

地番 上北村六九ノ一二			
NO	X	Y	辺長
16300	-111795.903	-27328.061	
12472	-111806.428	-27332.036	11.251
16301	-111800.494	-27316.214	16.898
16300	-111795.903	-27328.061	12.705
面積	71.4694500		
地積	71.46 m ²		

277

地番 上北村六九ノ一			
NO	X	Y	辺長
16296	-111791.411	-27326.364	
16300	-111795.903	-27328.061	4.802
16301	-111800.494	-27316.214	12.705
11250	-111799.008	-27312.255	4.229
16293	-111797.470	-27310.662	2.214
16294	-111796.450	-27313.313	2.840
16296	-111791.411	-27326.364	13.990
面積	72.9027210		
地積	72.90 m ²		

278

地番 上北村六九ノ一〇			
NO	X	Y	辺長
16297	-111786.913	-27324.669	
12471	-111788.644	-27325.319	1.849
16296	-111791.411	-27326.364	2.958
16294	-111796.450	-27313.313	13.990
21106	-111791.965	-27311.624	4.792
16297	-111786.913	-27324.669	13.989
面積	67.1369055		
地積	67.13 m ²		

279

地番 上北村六九ノ九			
NO	X	Y	辺長
16298	-111782.420	-27322.983	
16297	-111786.913	-27324.669	4.799
21106	-111791.965	-27311.624	13.989
21105	-111787.477	-27309.933	4.796
16298	-111782.420	-27322.983	13.996
面積	67.1243220		
地積	67.12 m ²		

280

地番 上北村六九ノ八			
NO	X	Y	辺長
12532	-111778.713	-27318.732	
16283	-111781.168	-27322.513	4.508
16298	-111782.420	-27322.983	1.337
21105	-111787.477	-27309.933	13.996
16292	-111782.792	-27308.168	5.006
12532	-111778.713	-27318.732	11.324
面積	65.0726970		
地積	65.07 m ²		

281

地番 上北村六九			
NO	X	Y	辺長
16292	-111782.792	-27308.168	
21105	-111787.477	-27309.933	5.006
21106	-111791.965	-27311.624	4.796
16294	-111796.450	-27313.313	4.792
16293	-111797.470	-27310.662	2.840
11249	-111786.933	-27299.659	15.235
12531	-111784.102	-27304.776	5.848
16292	-111782.792	-27308.168	3.636
面積	89.7917220		
地積	89.79 m ²		

282

地番 保 六五Aノ三号			
NO	X	Y	辺長
11249	-111786.933	-27299.659	
11293	-111797.470	-27310.662	15.235
11250	-111799.008	-27312.255	2.214
16302	-111803.705	-27310.515	5.009
16291	-111799.345	-27306.384	6.006
16286	-111788.772	-27296.346	14.579
11255	-111788.746	-27296.382	0.044
11249	-111786.933	-27299.659	3.745
面積	77.8861110		
地積	77.88 m ²		

283

地番 保 六五Aノ四号			
NO	X	Y	辺長
16286	-111788.772	-27296.346	
16291	-111799.345	-27306.384	14.579
16290	-111802.590	-27302.982	4.701
16285	-111791.510	-27292.460	15.280
16286	-111788.772	-27296.346	4.754
面積	70.2043860		
地積	70.20 m ²		

284

地番 保 六五Aノ五号			
NO	X	Y	辺長
16285	-111791.510	-27292.460	
16290	-111802.590	-27302.982	15.280
16291	-111799.345	-27306.384	4.701
16302	-111803.705	-27310.515	6.006
16288	-111810.700	-27307.914	7.463
16284	-111792.675	-27290.808	24.850
16285	-111791.510	-27292.460	2.021
面積	82.1119575		
地積	82.11 m ²		

285

地番 保 六五Aノ六号			
NO	X	Y	辺長
16284	-111792.675	-27290.808	
16288	-111810.700	-27307.914	24.850
11251	-111812.373	-27307.296	1.783
11252	-111816.247	-27303.943	5.124
16287	-111809.887	-27297.899	8.774
16289	-111806.648	-27301.313	4.706
16283	-111793.838	-27289.157	17.660
16284	-111792.675	-27290.808	2.019
面積	91.0837415		
地積	91.08 m ²		

286

地番 保 六五Aノ七号			
NO	X	Y	辺長
16283	-111793.838	-27289.157	
16289	-111806.648	-27301.313	17.660
16287	-111809.887	-27297.899	4.706
11253	-111796.606	-27285.307	18.301
11254	-111796.395	-27285.529	0.306
16283	-111793.838	-27289.157	4.439
面積	84.6454920		
地積	84.64 m ²		

287

地番 上北村四二C			
NO	X	Y	辺長
12498	-111805.177	-27276.254	
11253	-111796.606	-27285.307	12.467
16287	-111809.887	-27297.899	18.301
11252	-111816.247	-27303.943	8.774
12522	-111819.155	-27301.380	3.876
12523	-111824.694	-27295.917	7.780
12524	-111821.872	-27293.079	4.002
12525	-111817.787	-27288.975	5.791
12526	-111813.581	-27284.741	5.968
12498	-111805.177	-27276.254	11.944
面積	330.6766320		
地積	330.67 m ²		

288

地番 上北村七三ノ二			
NO	X	Y	辺長
12501	-111818.630	-27266.362	
12500	-111814.728	-27266.181	3.906
12499	-111811.054	-27270.048	5.334
12498	-111805.177	-27276.254	8.547
12526	-111813.581	-27284.741	11.944
12502	-111824.227	-27273.523	15.465
12501	-111818.630	-27266.362	9.089
面積	188.7195965		
地積	188.71 m ²		

289

地番 上北村七一ノ乙、上北村七二			
NO	X	Y	辺長
12502	-111824.227	-27273.523	
12526	-111813.581	-27284.741	15.465
12525	-111817.787	-27288.975	5.968
12503	-111827.940	-27278.272	14.753
12502	-111824.227	-27273.523	6.028
面積	90.1074540		
地積	90.10 m ²		

290

地番 保 六五Aノ二号			
NO	X	Y	辺長
12503	-111827.940	-27278.272	
12525	-111817.787	-27288.975	14.753
12524	-111821.872	-27293.079	5.791
12505	-111831.814	-27283.229	13.995
12504	-111829.046	-27279.687	4.495
12503	-111827.940	-27278.272	1.796
面積	86.4158965		
地積	86.41 m ²		


291

地番 上北村六一			
NO	X	Y	辺長
12505	-111831.814	-27283.229	
12524	-111821.872	-27293.079	13.995
12523	-111824.694	-27295.917	4.002
12519	-111834.294	-27286.402	13.516
12505	-111831.814	-27283.229	4.027
面積	55.0350480		
地積	55.03 m ²		

292

地番 上北村七七ノ一			
NO	X	Y	辺長
12519	-111834.294	-27286.402	
12523	-111824.694	-27295.917	13.516
12522	-111819.155	-27301.380	7.780
12486	-111830.352	-27311.584	15.149
12487	-111841.277	-27299.307	16.434
12488	-111841.361	-27295.445	3.863
12519	-111834.294	-27286.402	11.477
面積	288.3490095		
地積	288.34 m ²		

図面の種類	画 地 面 積 求 積 表		
街区番号	65A	番号	縮尺
町 名	上 桂 北 村 町		
京都市洛西第二土地区画整理組合			

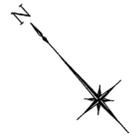

S = 1 : 250

64

400-10

400-11

400-19

410-2

410-1

66

65 A

400-15

766.60

400-19

71 A

400-5

198.56

267

377.16

274

273

272

271

54.82

57.92

59.75

450.21

400-17

400-18

400-16

上北村七四
上北村七三
上北村七二
上北村七一

上北村七六

上北村七五ノ五
上北村七五ノ六
上北村七五ノ七

上北村七五ノ一

268

269

270

20.71

270

271

271

図面の種類	画地出来形確認測量図			
街区番号	65B	番号	縮尺	1 : 250
町名	上桂北村町			
京都市洛西第二土地区画整理組合				

267

地番 上北村七六			
NO	X	Y	辺長
12557	-111861.678	-27257.262	
12558	-111859.661	-27259.284	2.856
12559	-111856.471	-27262.866	4.797
12555	-111852.179	-27268.380	6.988
12520	-111840.461	-27284.569	19.985
12489	-111844.523	-27289.771	6.600
12490	-111848.088	-27289.908	3.568
12569	-111861.050	-27275.390	19.462
12570	-111864.264	-27271.692	4.899
12564	-111870.276	-27264.999	8.997
12557	-111861.678	-27257.262	11.567
面積	377.1645785		
地積	377.16 m ²		

268

地番 上北村七三ノ一、上北村七四			
NO	X	Y	辺長
12506	-111822.814	-27261.965	
12521	-111833.776	-27276.007	17.814
12520	-111840.461	-27284.569	10.863
12555	-111852.179	-27268.380	19.985
12559	-111856.471	-27262.866	6.988
12558	-111859.661	-27259.284	4.797
12557	-111861.678	-27257.262	2.856
12564	-111870.276	-27264.999	11.567
12565	-111870.928	-27264.274	0.975
12560	-111860.743	-27255.158	13.669
20198	-111853.106	-27248.260	10.291
12556	-111850.317	-27251.442	4.231
12513	-111845.999	-27247.547	5.815
12512	-111841.635	-27249.592	4.819
5320	-111826.384	-27256.712	16.831
12507	-111823.001	-27258.307	3.740
12506	-111822.814	-27261.965	3.663
面積	766.6015435		
地積	766.60 m ²		

269

地番 上北村九六ノ一			
NO	X	Y	辺長
12513	-111845.999	-27247.547	
12556	-111850.317	-27251.442	5.815
20198	-111853.106	-27248.260	4.231
12514	-111850.160	-27245.598	3.971
12513	-111845.999	-27247.547	4.595
面積	20.7106835		
地積	20.71 m ²		

270

地番 上北村七五ノ二			
NO	X	Y	辺長
12514	-111850.160	-27245.598	
20198	-111853.106	-27248.260	3.971
12560	-111860.743	-27255.158	10.291
20193	-111864.422	-27252.834	4.352
20194	-111868.764	-27250.092	5.135
12553	-111873.915	-27246.838	6.093
20195	-111864.967	-27238.660	12.122
12534	-111863.890	-27239.166	1.190
12514	-111850.160	-27245.598	15.162
面積	198.5690990		
地積	198.56 m ²		

271

地番 上北村七五ノ一			
NO	X	Y	辺長
20195	-111864.967	-27238.660	
12553	-111873.915	-27246.838	12.122
12568	-111880.856	-27253.181	9.403
12576	-111887.420	-27245.805	9.874
12577	-111889.937	-27243.197	3.624
12578	-111893.822	-27238.592	6.025
12579	-111895.807	-27236.332	3.008
12580	-111897.839	-27233.331	3.624
12581	-111899.075	-27230.606	2.992
12582	-111900.143	-27228.144	2.684
12583	-111899.897	-27227.948	0.315
12545	-111896.053	-27225.218	4.715
12546	-111892.659	-27226.510	3.632
12547	-111883.505	-27229.948	9.778
20195	-111864.967	-27238.660	20.483
面積	450.2128350		
地積	450.21 m ²		

272

地番 上北村七五ノ七			
NO	X	Y	辺長
20194	-111868.764	-27250.092	
12567	-111877.003	-27257.511	11.087
12568	-111880.856	-27253.181	5.796
12553	-111873.915	-27246.838	9.403
20194	-111868.764	-27250.092	6.093
面積	59.7595420		
地積	59.75 m ²		

273

地番 上北村七五ノ六			
NO	X	Y	辺長
20193	-111864.422	-27252.834	
12566	-111873.735	-27261.149	12.485
12567	-111877.003	-27257.511	4.890
20194	-111868.764	-27250.092	11.087
20193	-111864.422	-27252.834	5.135
面積	57.9293750		
地積	57.92 m ²		


274

地番 上北村七五ノ五			
NO	X	Y	辺長
12560	-111860.743	-27255.158	
12565	-111870.928	-27264.274	13.669
12566	-111873.735	-27261.149	4.201
20193	-111864.422	-27252.834	12.485
12560	-111860.743	-27255.158	4.352
面積	54.8255170		
地積	54.82 m ²		

図面の種類	画地面積求積表		
街区番号	65B	番号	縮尺
町名	上桂北村町		
京都市洛西第二土地区画整理組合			



S = 1 : 250

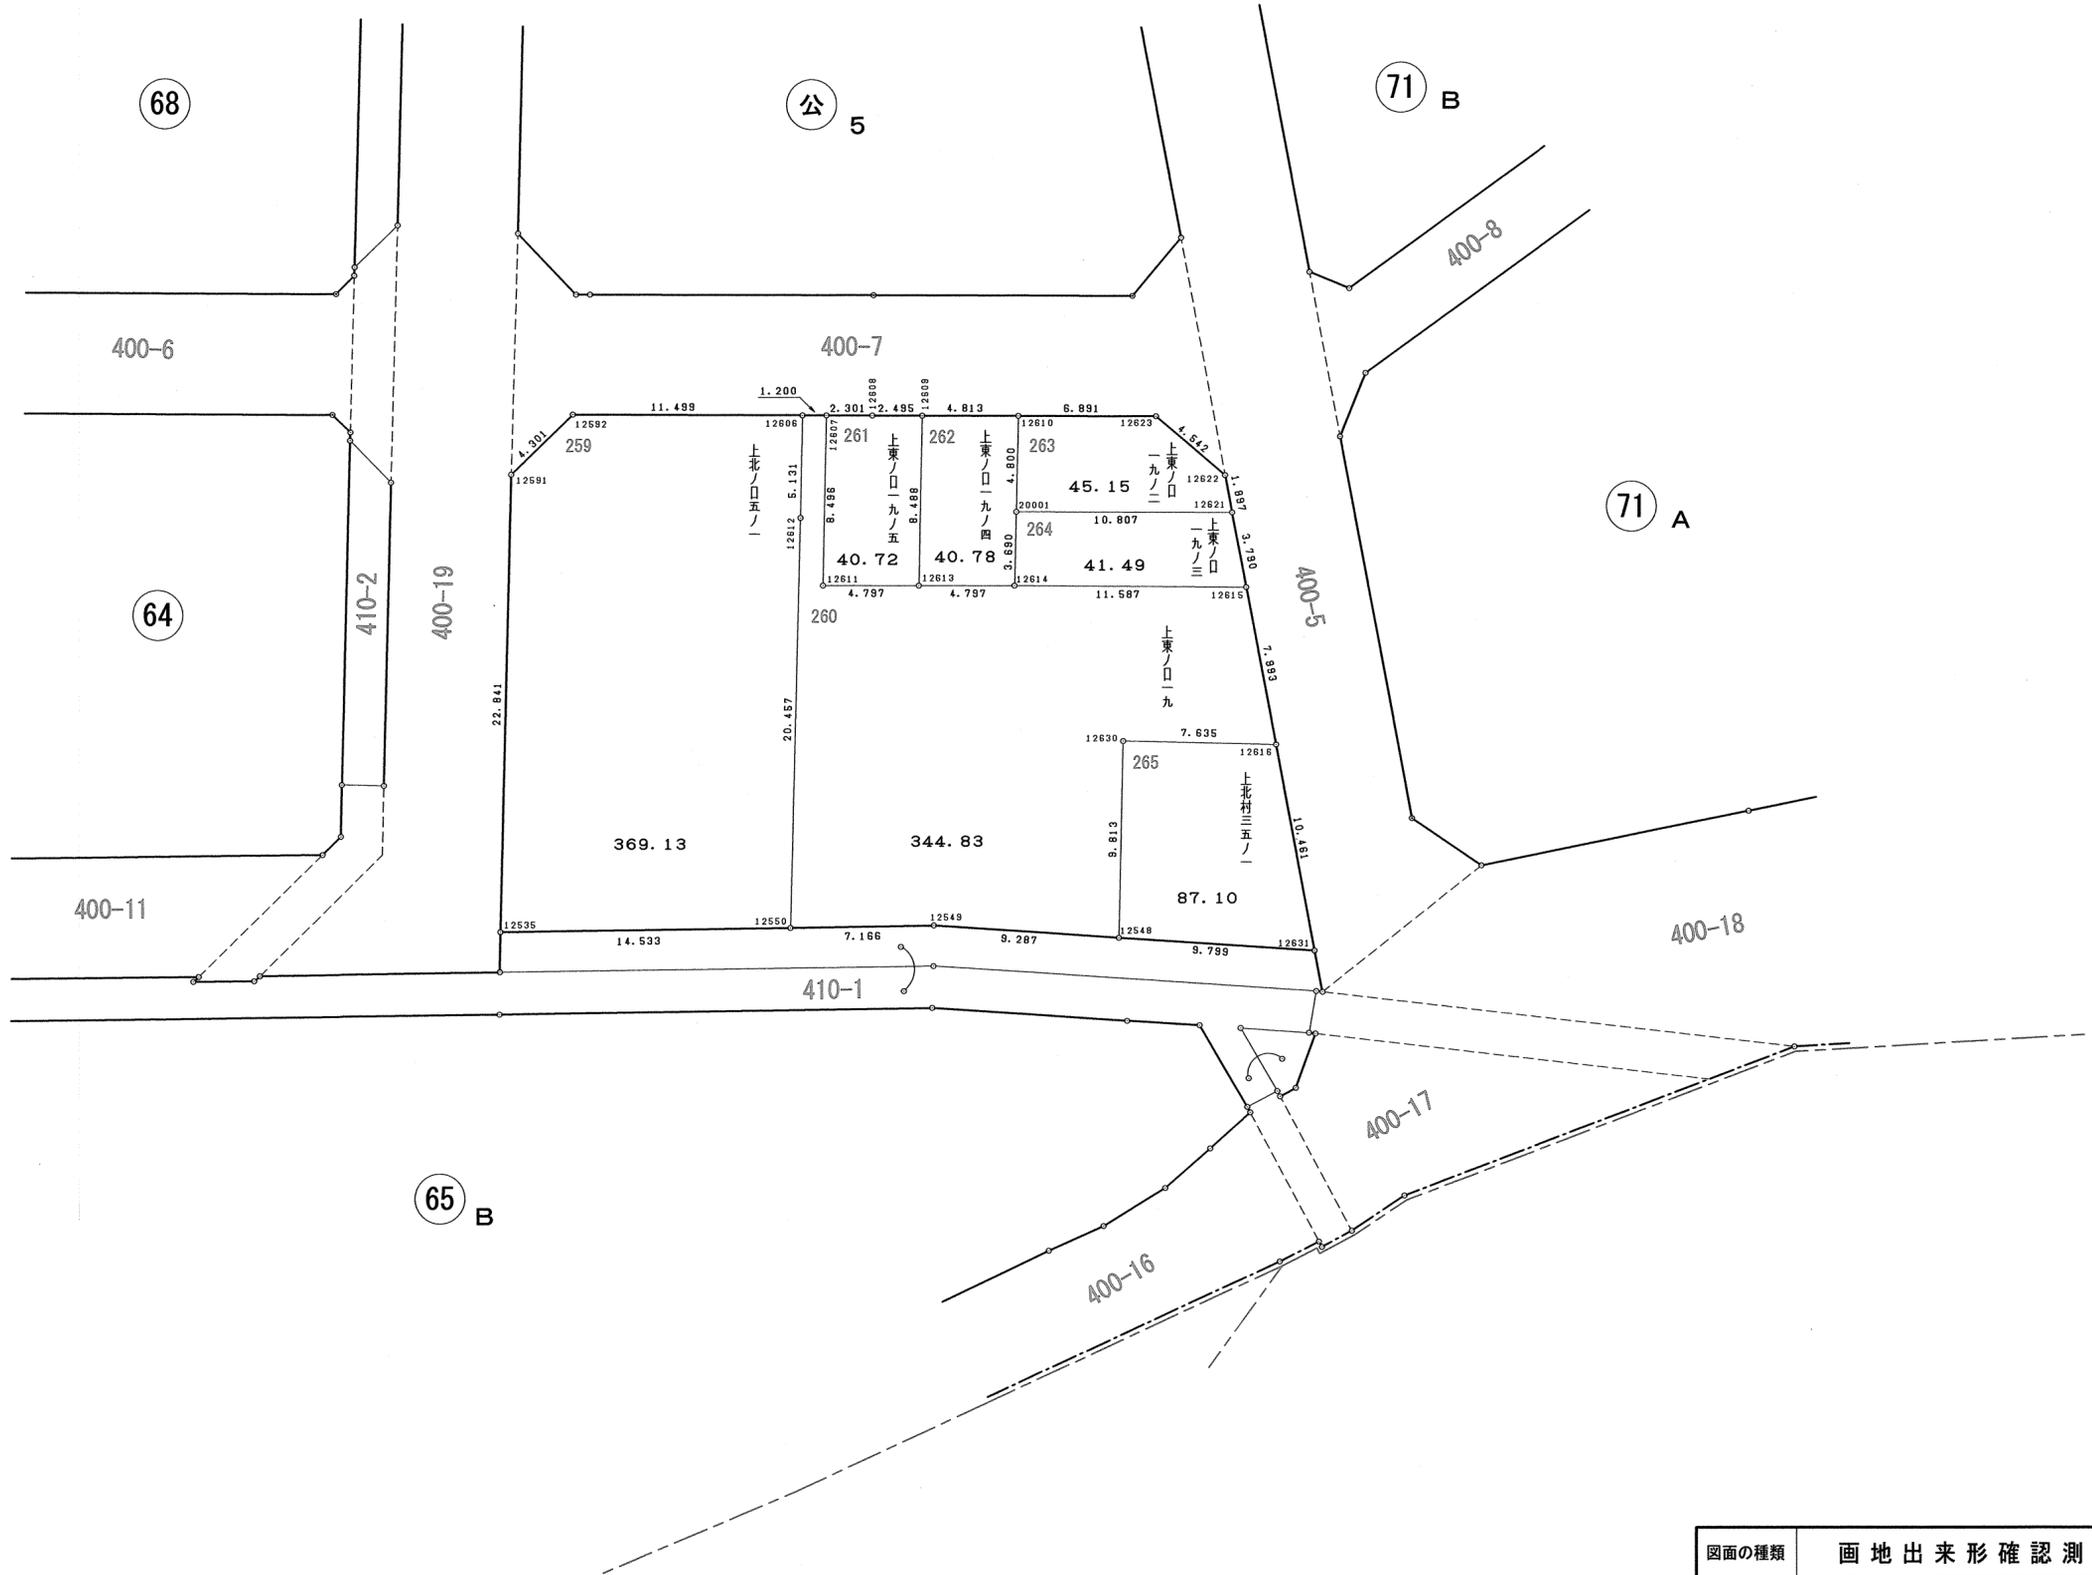

図面の種類	画地出来形確認測量図		
街区番号	66	番号	縮尺 1:250
町名	上桂北村町		
京都市洛西第二土地区画整理組合			

259

地番 上北ノ口五ノ一			
NO	X	Y	辺長
12592	-111854.887	-27210.376	
12591	-111853.308	-27214.377	4.301
12535	-111862.239	-27235.400	22.841
12550	-111875.391	-27229.217	14.533
12612	-111867.407	-27210.382	20.457
12606	-111865.378	-27205.669	5.131
12592	-111854.887	-27210.376	11.499
面積	369.1310970		
地積	369.13 m ²		

260

地番 上東ノ口一九			
NO	X	Y	辺長
12606	-111865.378	-27205.669	
12612	-111867.407	-27210.382	5.131
12550	-111875.391	-27229.217	20.457
12549	-111881.876	-27226.168	7.166
12548	-111890.568	-27222.898	9.287
12630	-111886.715	-27213.873	9.813
12616	-111893.739	-27210.880	7.635
12615	-111889.154	-27204.333	7.993
12614	-111878.572	-27209.053	11.587
12613	-111874.195	-27211.015	4.797
12611	-111869.822	-27212.986	4.797
12607	-111866.473	-27205.178	8.496
12606	-111865.378	-27205.669	1.200
面積	344.8303670		
地積	344.83 m ²		

261

地番 上東ノ口一九ノ五			
NO	X	Y	辺長
12607	-111866.473	-27205.178	
12611	-111869.822	-27212.986	8.496
12613	-111874.195	-27211.015	4.797
12609	-111870.848	-27203.215	8.488
12608	-111868.572	-27204.236	2.495
12607	-111866.473	-27205.178	2.301
面積	40.7206685		
地積	40.72 m ²		

262

地番 上東ノ口一九ノ四			
NO	X	Y	辺長
12609	-111870.848	-27203.215	
12613	-111874.195	-27211.015	8.488
12614	-111878.572	-27209.053	4.797
20001	-111877.123	-27205.659	3.690
12610	-111875.239	-27201.244	4.800
12609	-111870.848	-27203.215	4.813
面積	40.7815185		
地積	40.78 m ²		

263

地番 上東ノ口一九ノ二			
NO	X	Y	辺長
12610	-111875.239	-27201.244	
20001	-111877.123	-27205.659	4.800
12621	-111886.980	-27201.229	10.807
12622	-111885.892	-27199.675	1.897
12623	-111881.526	-27198.423	4.542
12610	-111875.239	-27201.244	6.891
面積	45.1572095		
地積	45.15 m ²		


264

地番 上東ノ口一九ノ三			
NO	X	Y	辺長
20001	-111877.123	-27205.659	
12614	-111878.572	-27209.053	3.690
12615	-111889.154	-27204.333	11.587
12621	-111886.980	-27201.229	3.790
20001	-111877.123	-27205.659	10.807
面積	41.4907680		
地積	41.49 m ²		

265

地番 上北村三五ノ一			
NO	X	Y	辺長
12630	-111886.715	-27213.873	
12548	-111890.568	-27222.898	9.813
12631	-111899.740	-27219.448	9.799
12616	-111893.739	-27210.880	10.461
12630	-111886.715	-27213.873	7.635
面積	87.1063875		
地積	87.10 m ²		


図面の種類	画地面積求積表			
街区番号	66	番号	縮尺	
町名	上桂北村町			
京都市洛西第二土地区画整理組合				

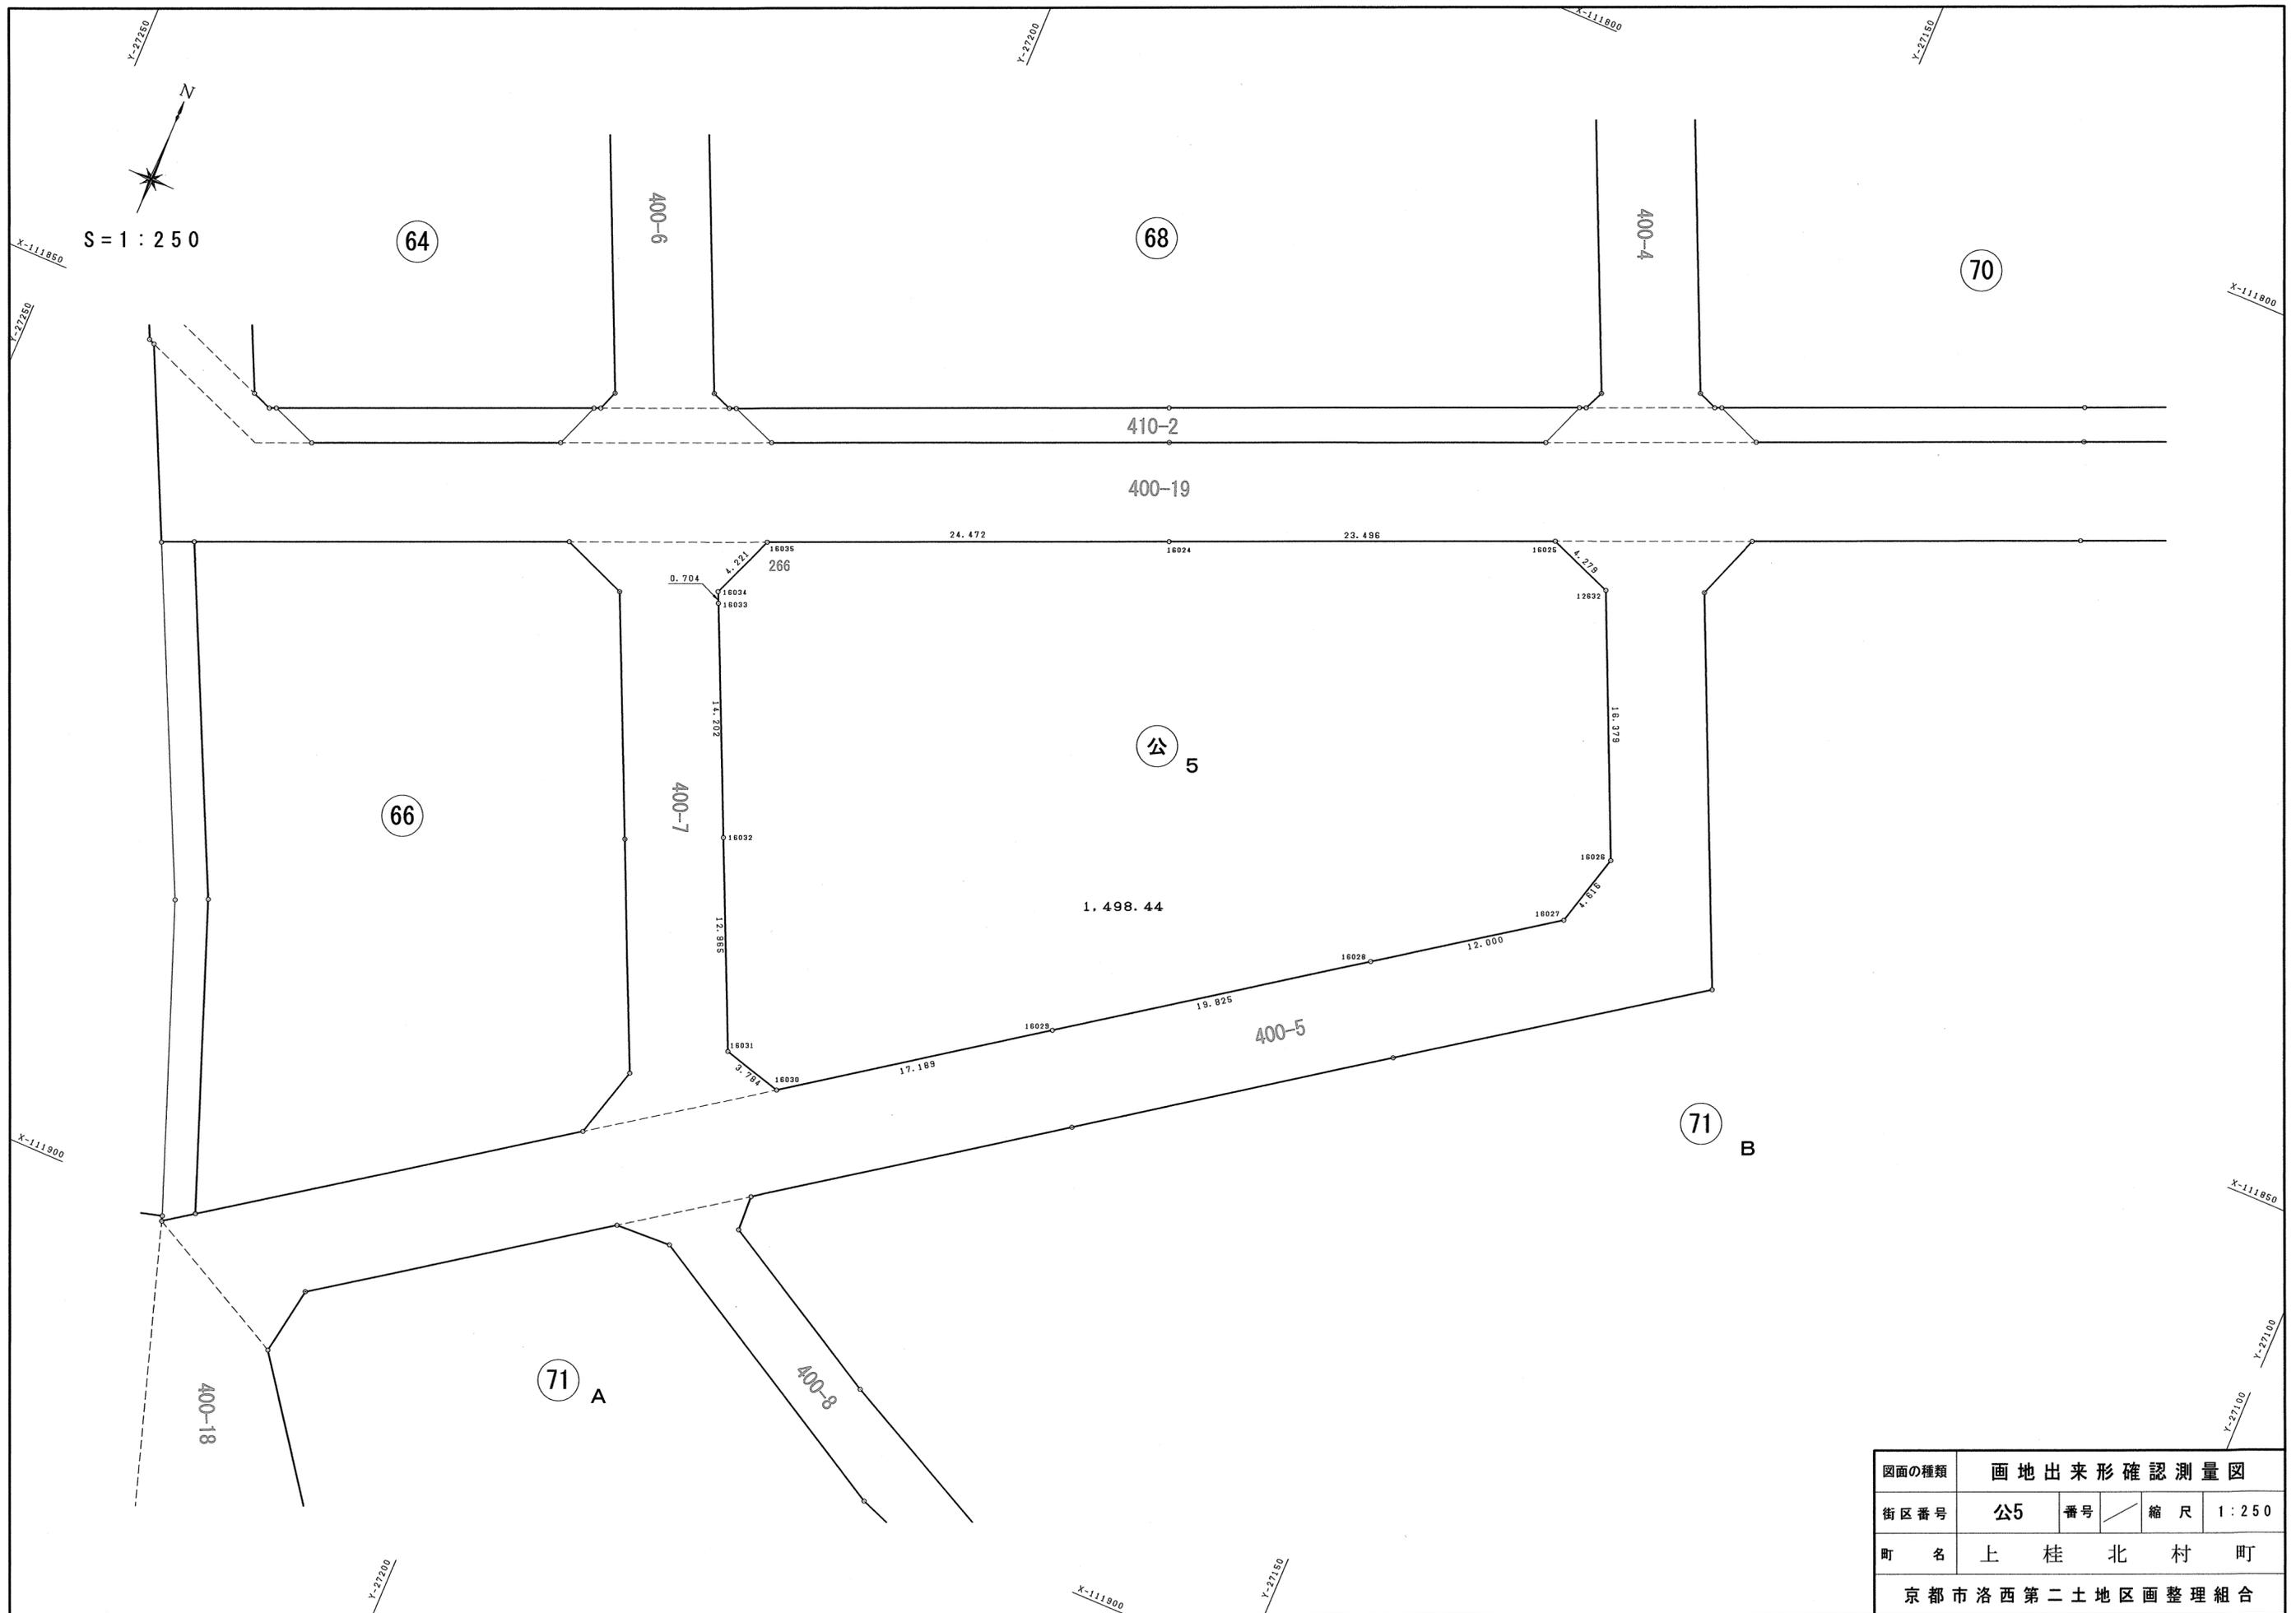

図面の種類	画地出来形確認測量図		
街区番号	公5	番号	縮尺 1:250
町名	上桂北村町		
京都市洛西第二土地区画整理組合			



地番		公園5	
NO	X	Y	辺長
16025	-111829.893	-27159.113	
16024	-111839.077	-27180.740	23.496
16035	-111848.640	-27203.266	24.472
16034	-111852.551	-27204.853	4.221
16033	-111853.191	-27204.559	0.704
16032	-111866.148	-27198.743	14.202
16031	-111877.977	-27193.435	12.965
16030	-111878.990	-27189.789	3.784
16029	-111869.101	-27175.730	17.189
16028	-111857.724	-27159.495	19.825
16027	-111850.835	-27149.669	12.000
16026	-111846.384	-27148.445	4.616
12632	-111831.426	-27155.118	16.379
16025	-111829.893	-27159.113	4.279
面積	1498.440020		
地積	1498.44 m ²		

図面の種類	画地面積求積表			
街区番号	公5	番号	縮尺	
町名	上	桂	北	村町
京都市洛西第二土地区画整理組合				

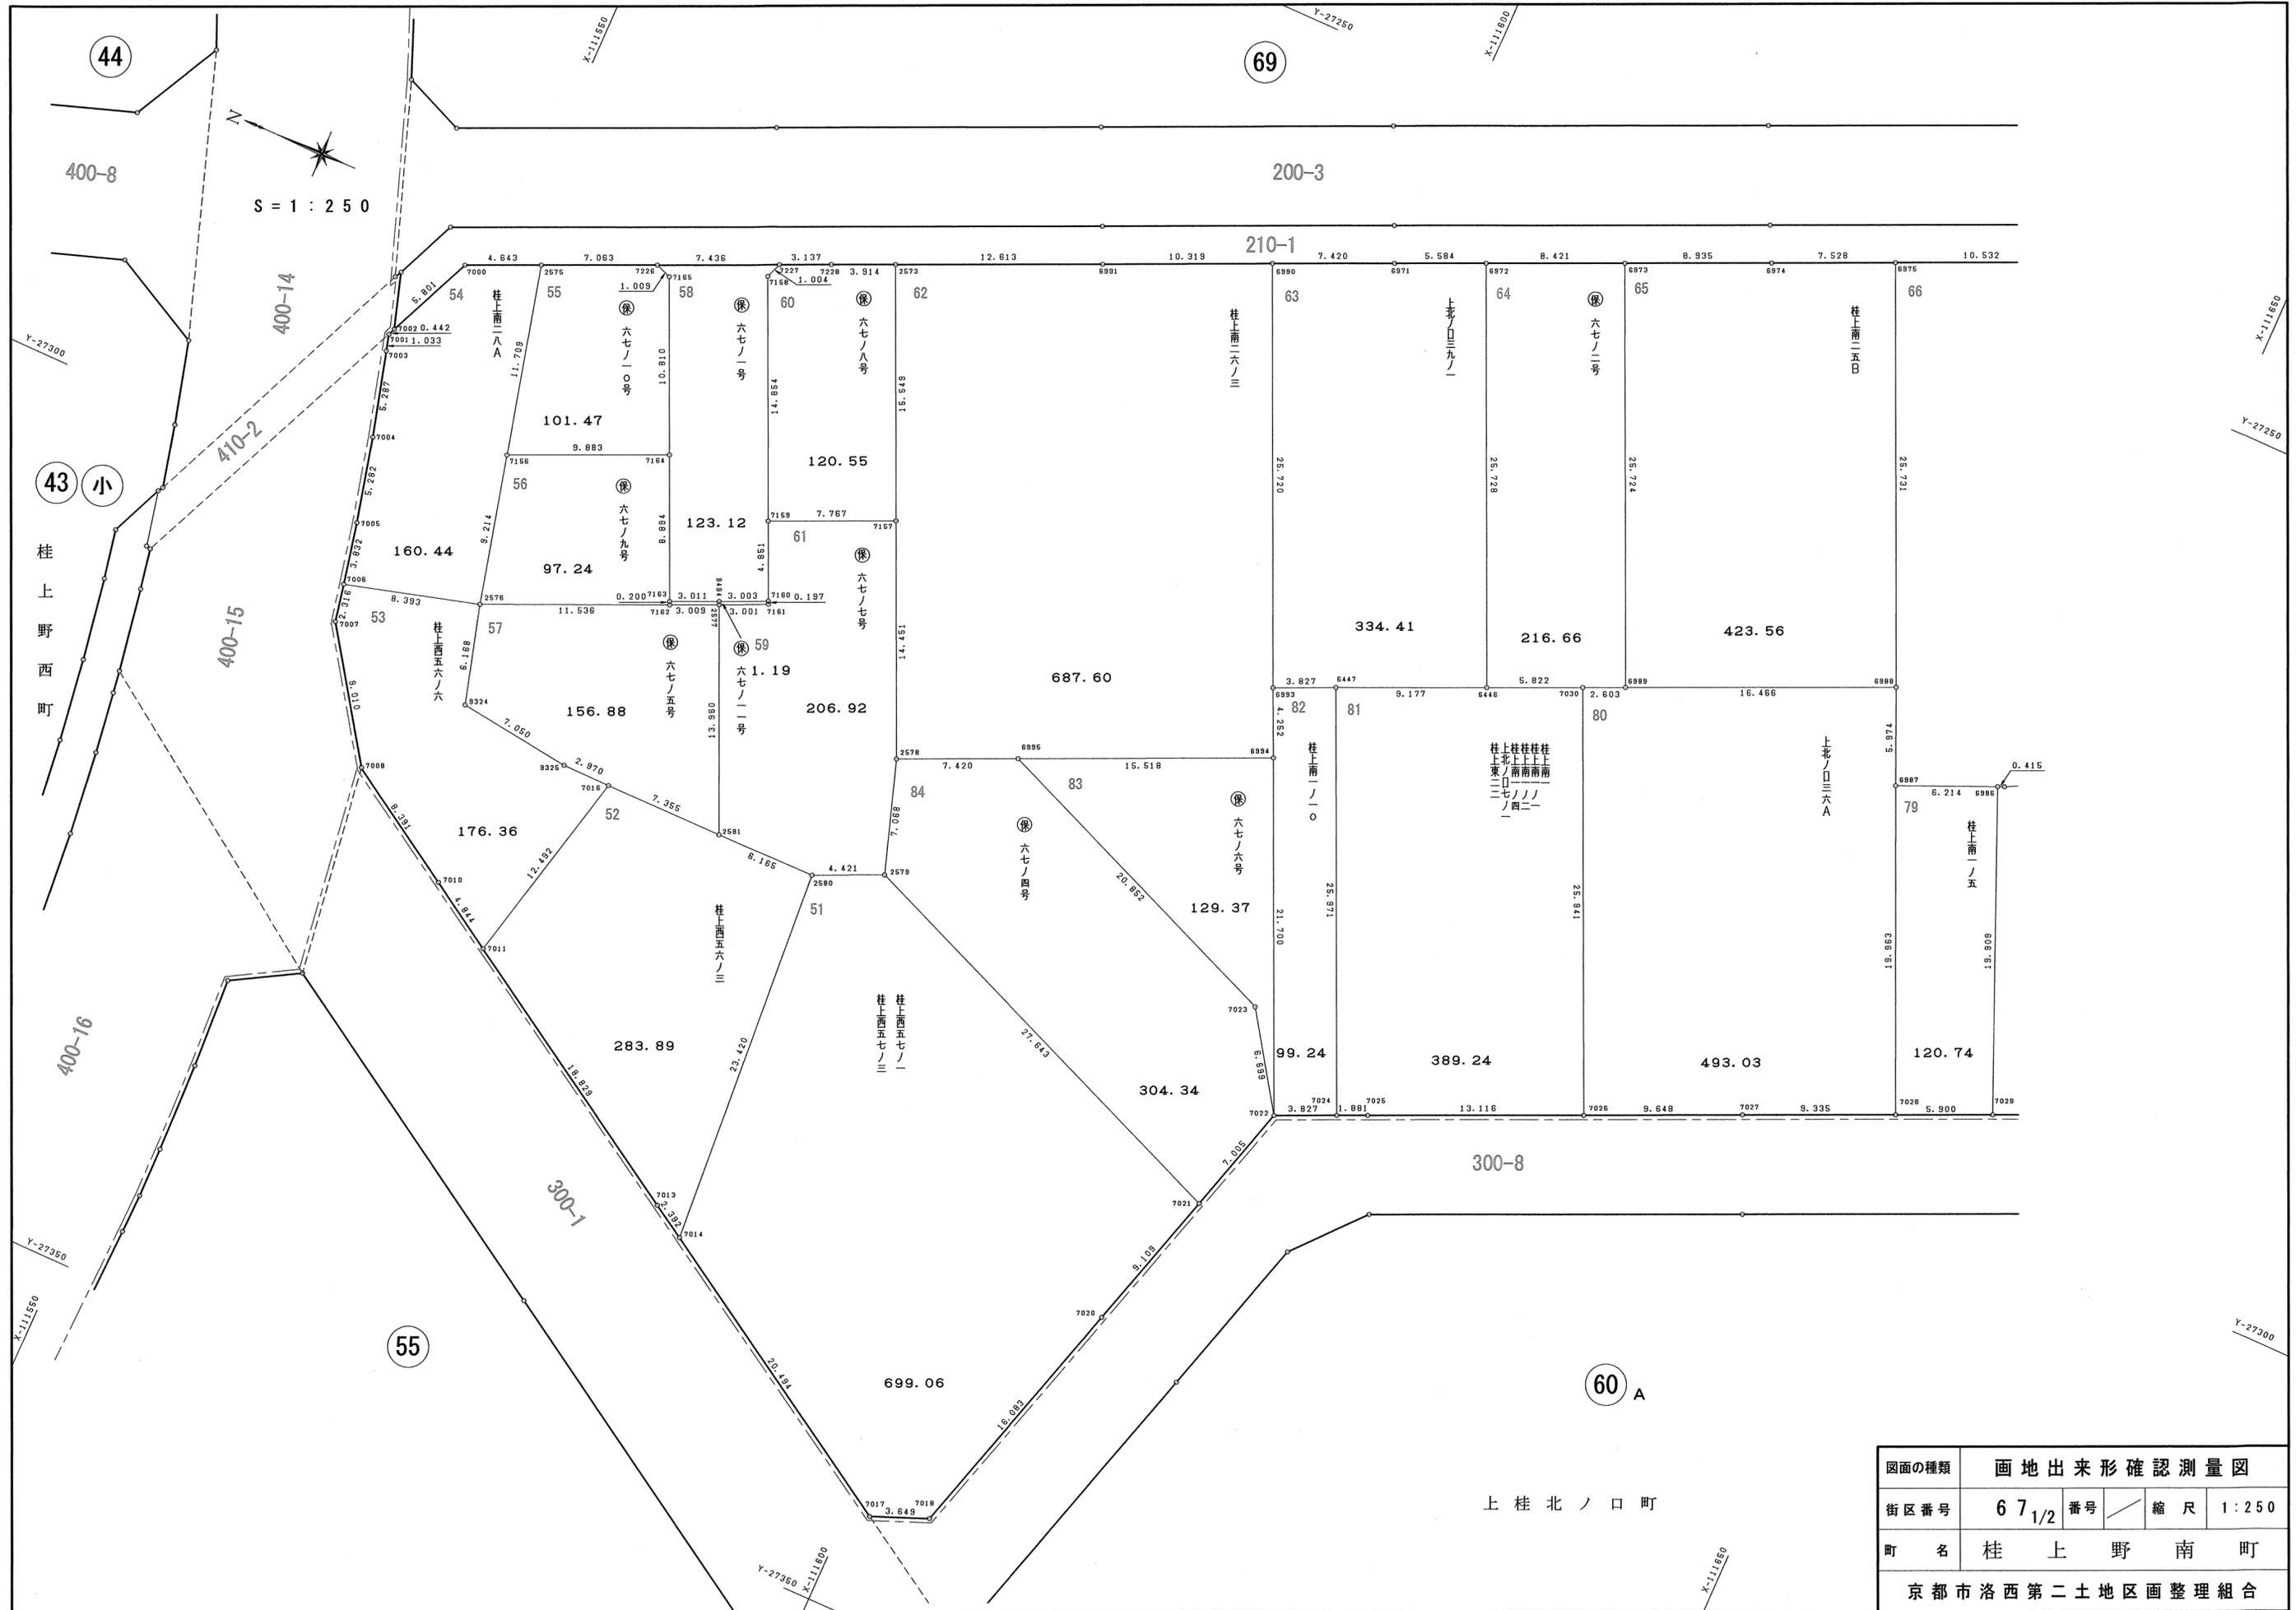

図面の種類	画地出来形確認測量図		
街区番号	67 ¹ / ₂	番号	縮尺 1:250
町名	桂上野南町		
京都市洛西第二土地区画整理組合			

上桂北ノ口町

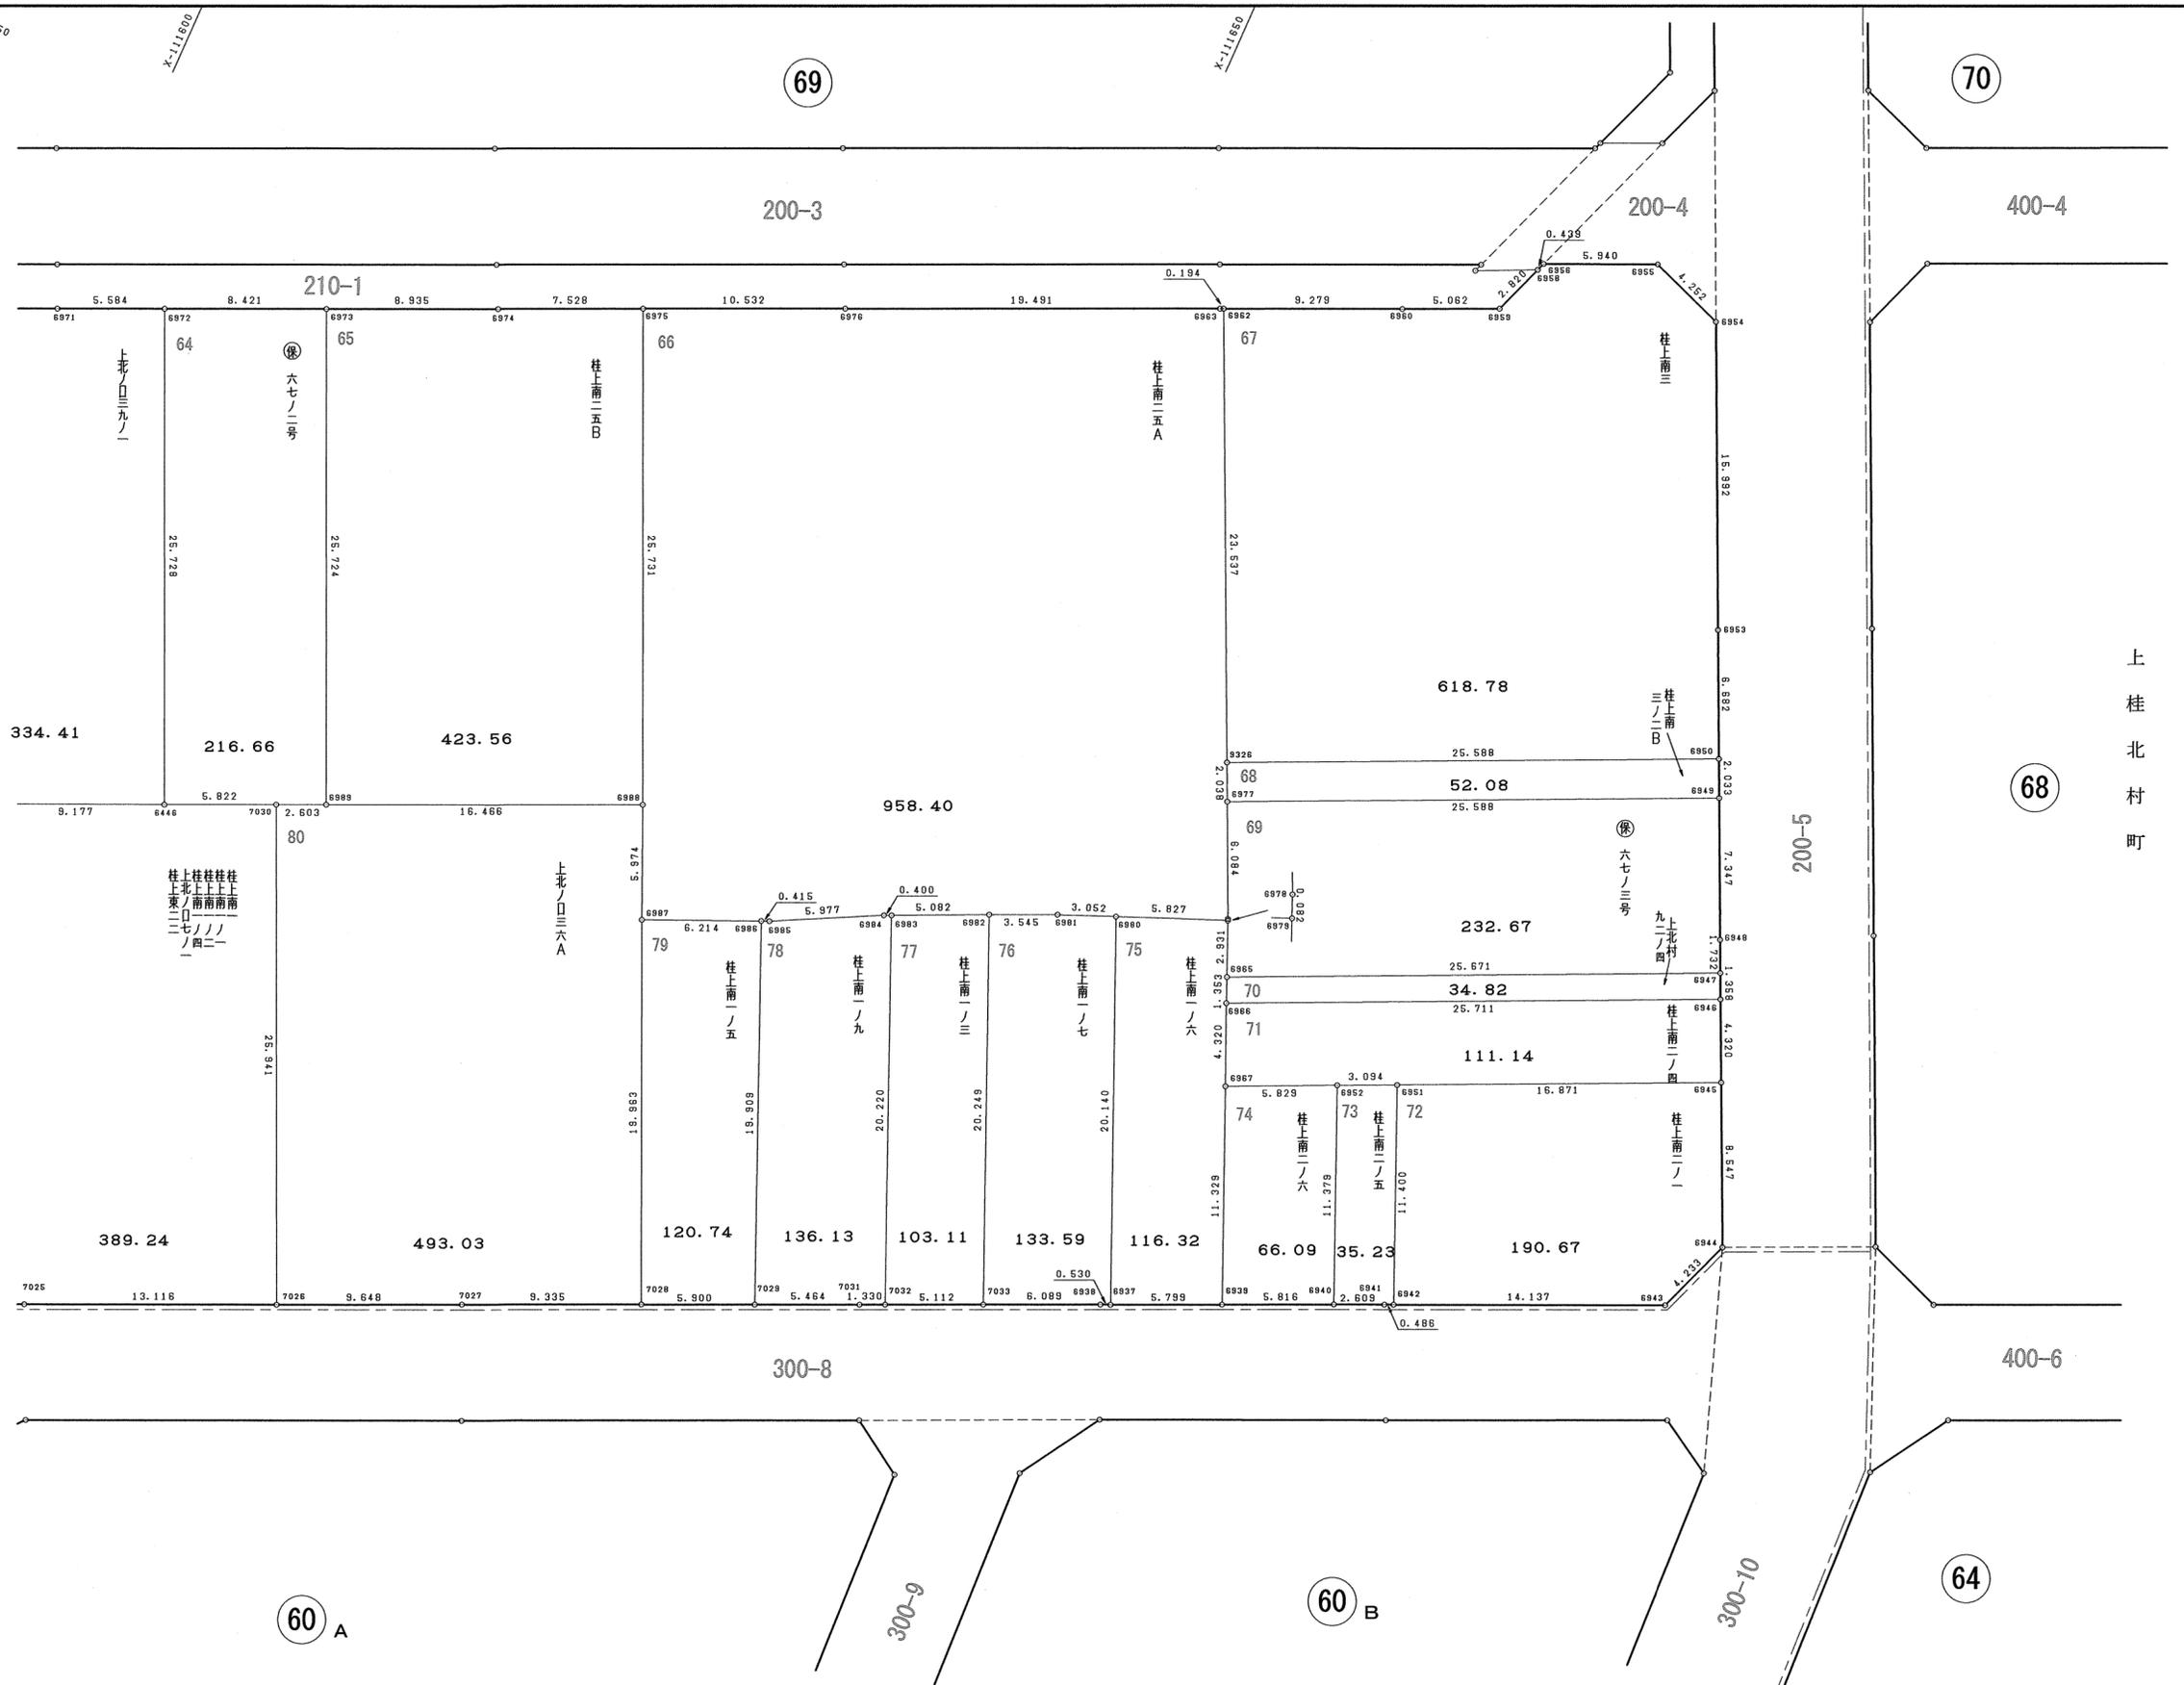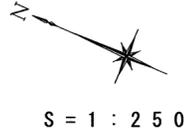

上桂北村町

上桂北ノ口町

図面の種類	画地出来形確認測量図			
街区番号	67 _{2/2}	番号	縮尺	1 : 250
町名	桂上野南町			
京都市洛西第二土地区画整理組合				

51

Table with 4 columns: NO, X, Y, 辺長. Includes area and total area (699.06 m²).

52

Table with 4 columns: NO, X, Y, 辺長. Includes area and total area (283.89 m²).

53

Table with 4 columns: NO, X, Y, 辺長. Includes area and total area (176.36 m²).

54

Table with 4 columns: NO, X, Y, 辺長. Includes area and total area (160.44 m²).

55

Table with 4 columns: NO, X, Y, 辺長. Includes area and total area (101.47 m²).

56

Table with 4 columns: NO, X, Y, 辺長. Includes area and total area (97.24 m²).

57

Table with 4 columns: NO, X, Y, 辺長. Includes area and total area (156.88 m²).

58

Table with 4 columns: NO, X, Y, 辺長. Includes area and total area (123.12 m²).

59

Table with 4 columns: NO, X, Y, 辺長. Includes area and total area (1.19 m²).

60

Table with 4 columns: NO, X, Y, 辺長. Includes area and total area (120.55 m²).

61

Table with 4 columns: NO, X, Y, 辺長. Includes area and total area (206.92 m²).

62

Table with 4 columns: NO, X, Y, 辺長. Includes area and total area (687.60 m²).

63

Table with 4 columns: NO, X, Y, 辺長. Includes area and total area (334.41 m²).

64

Table with 4 columns: NO, X, Y, 辺長. Includes area and total area (216.66 m²).

65

Table with 4 columns: NO, X, Y, 辺長. Includes area and total area (423.56 m²).

66

Table with 4 columns: NO, X, Y, 辺長. Includes area and total area (958.40 m²).

67

Table with 4 columns: NO, X, Y, 辺長. Includes area and total area (618.78 m²).

68

Table with 4 columns: NO, X, Y, 辺長. Includes area and total area (52.08 m²).

69

Table with 4 columns: NO, X, Y, 辺長. Includes area and total area (232.67 m²).

70

Table with 4 columns: NO, X, Y, 辺長. Includes area and total area (34.82 m²).

71

Table with 4 columns: NO, X, Y, 辺長. Includes area and total area (111.14 m²).

72

Table with 4 columns: NO, X, Y, 辺長. Includes area and total area (190.67 m²).

73

Table with 4 columns: NO, X, Y, 辺長. Includes area and total area (35.23 m²).

74

Table with 4 columns: NO, X, Y, 辺長. Includes area and total area (66.09 m²).

75

Table with 4 columns: NO, X, Y, 辺長. Includes area and total area (116.32 m²).

76

Table with 4 columns: NO, X, Y, 辺長. Includes area and total area (133.59 m²).

77

Table with 4 columns: NO, X, Y, 辺長. Includes area and total area (103.11 m²).

Summary table with columns: 図面の種類, 画地面積, 求積表, 街区番号, 町名, 京都市洛西第二土地区画整理組合.

78

地番 桂上南一ノ九			
NO	X	Y	辺長
6986	-111645.974	-27275.559	
7029	-111653.800	-27293.865	19.909
7031	-111658.790	-27291.640	5.464
7032	-111660.004	-27291.097	1.330
6983	-111652.042	-27272.511	20.220
6984	-111651.677	-27272.674	0.400
6985	-111646.354	-27275.393	5.977
6986	-111645.974	-27275.559	0.415
面積	136.1315350		
地積	136.13 m ²		

79

地番 桂上南一ノ五			
NO	X	Y	辺長
6987	-111640.276	-27278.038	
7028	-111648.411	-27296.268	19.963
7029	-111653.800	-27293.865	5.900
6986	-111645.974	-27275.559	19.909
6987	-111640.276	-27278.038	6.214
面積	120.7490585		
地積	120.74 m ²		

80

地番 上北ノ口三六A			
NO	X	Y	辺長
7030	-111620.464	-27280.353	
7026	-111631.084	-27304.021	25.941
7027	-111639.885	-27300.069	9.648
7028	-111648.411	-27296.268	9.335
6987	-111640.276	-27278.038	19.963
6988	-111637.872	-27272.569	5.974
6989	-111622.841	-27279.293	16.466
7030	-111620.464	-27280.353	2.603
面積	493.0312150		
地積	493.03 m ²		

81

地番 桂上南一、一ノ一、一ノ二、一ノ四 上北ノ口七ノ一、桂上東二二			
NO	X	Y	辺長
6447	-111606.767	-27286.466	
7024	-111617.401	-27310.160	25.971
7025	-111619.119	-27309.394	1.881
7026	-111631.084	-27304.021	13.116
7030	-111620.464	-27280.353	25.941
6446	-111615.152	-27282.736	5.822
6447	-111606.767	-27286.466	9.177
面積	389.2428565		
地積	389.24 m ²		

82

地番 桂上南一ノ一〇			
NO	X	Y	辺長
6993	-111603.280	-27288.042	
6994	-111605.028	-27291.918	4.252
7022	-111613.906	-27311.719	21.700
7024	-111617.401	-27310.160	3.827
6447	-111606.767	-27286.466	25.971
6993	-111603.280	-27288.042	3.827
面積	99.2480955		
地積	99.24 m ²		


83

地番 保六七ノ六号			
NO	X	Y	辺長
6995	-111590.870	-27298.272	
7023	-111610.175	-27306.155	20.852
7022	-111613.906	-27311.719	6.699
6994	-111605.028	-27291.918	21.700
6995	-111590.870	-27298.272	15.518
面積	129.3759115		
地積	129.37 m ²		


84

地番 保六七ノ四号			
NO	X	Y	辺長
2578	-111584.098	-27301.304	
2579	-111586.309	-27308.017	7.068
7021	-111611.914	-27318.435	27.643
7022	-111613.906	-27311.719	7.005
7023	-111610.175	-27306.155	6.699
6995	-111590.870	-27298.272	20.852
2578	-111584.098	-27301.304	7.420
面積	304.3495790		
地積	304.34 m ²		

図面の種類	画地面積求積表		
街区番号	67	番号	2/2
町名	桂上野南町		
京都市洛西第二土地区画整理組合			

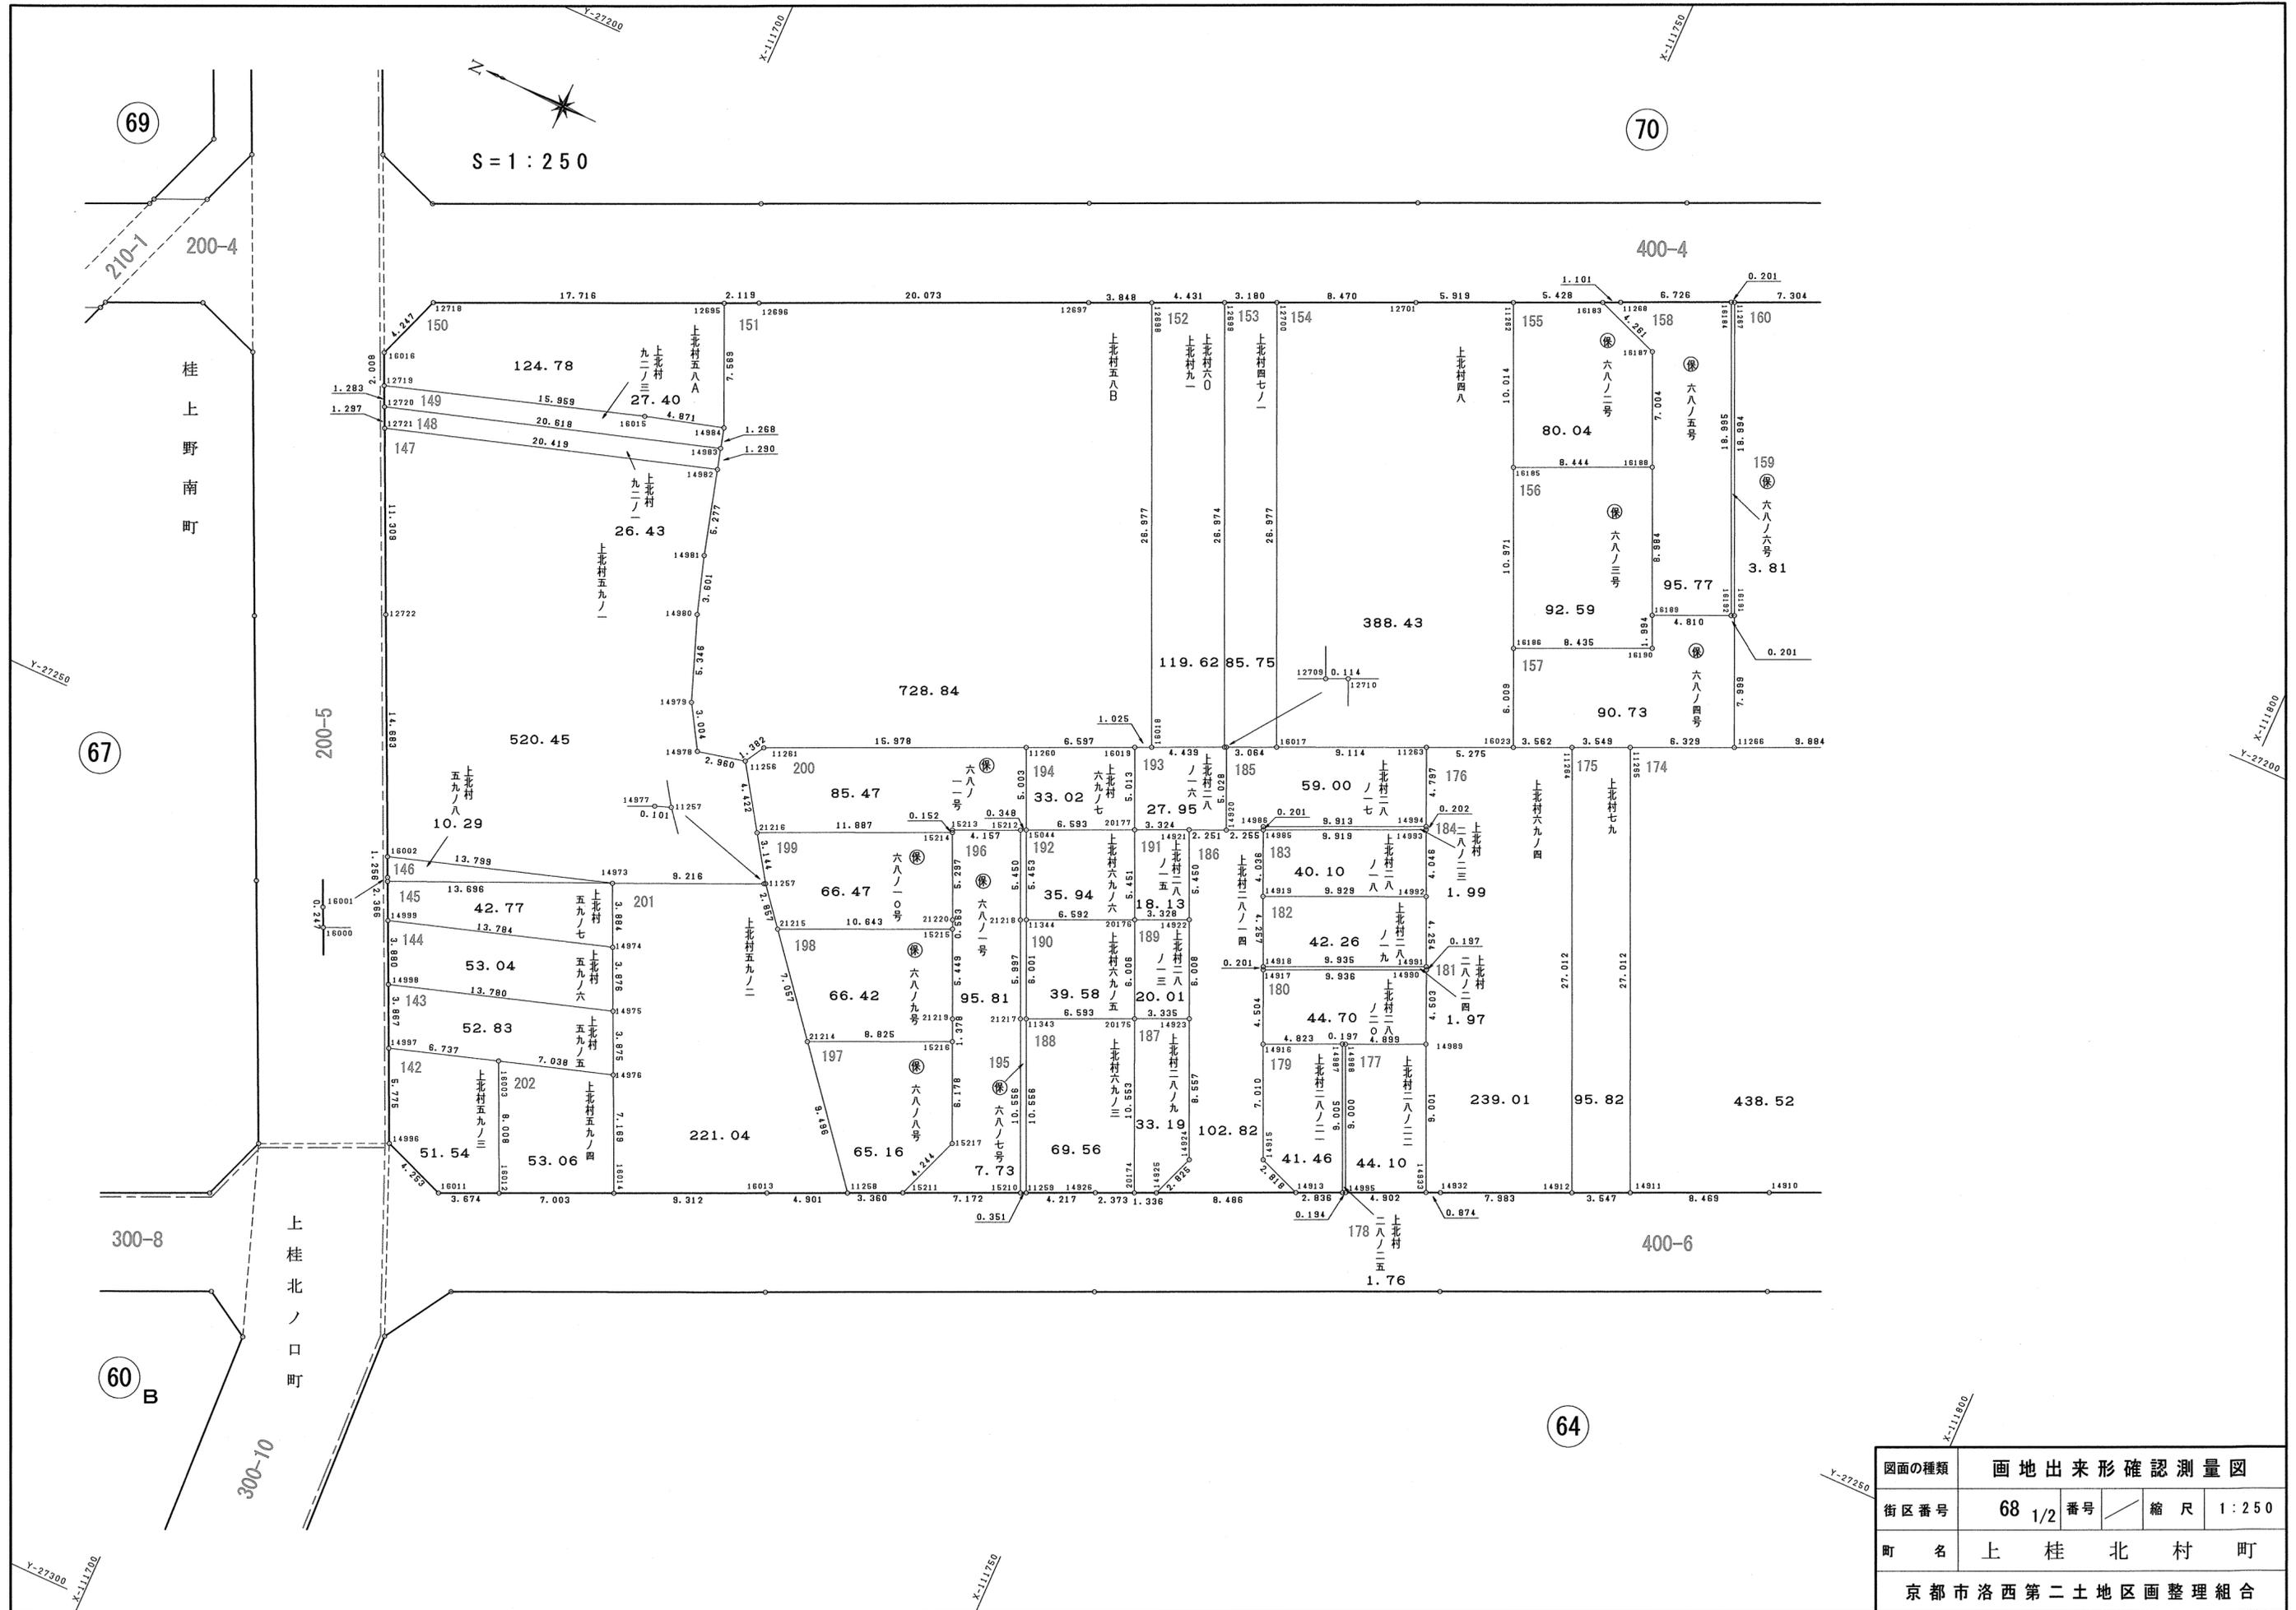


図面の種類	画地出来形確認測量図		
街区番号	68 1/2	番号	縮尺 1:250
町名	上桂北ノ口町		
京都市洛西第二土地区画整理組合			

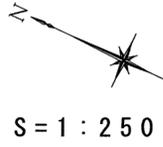

S = 1 : 250

70

71 B

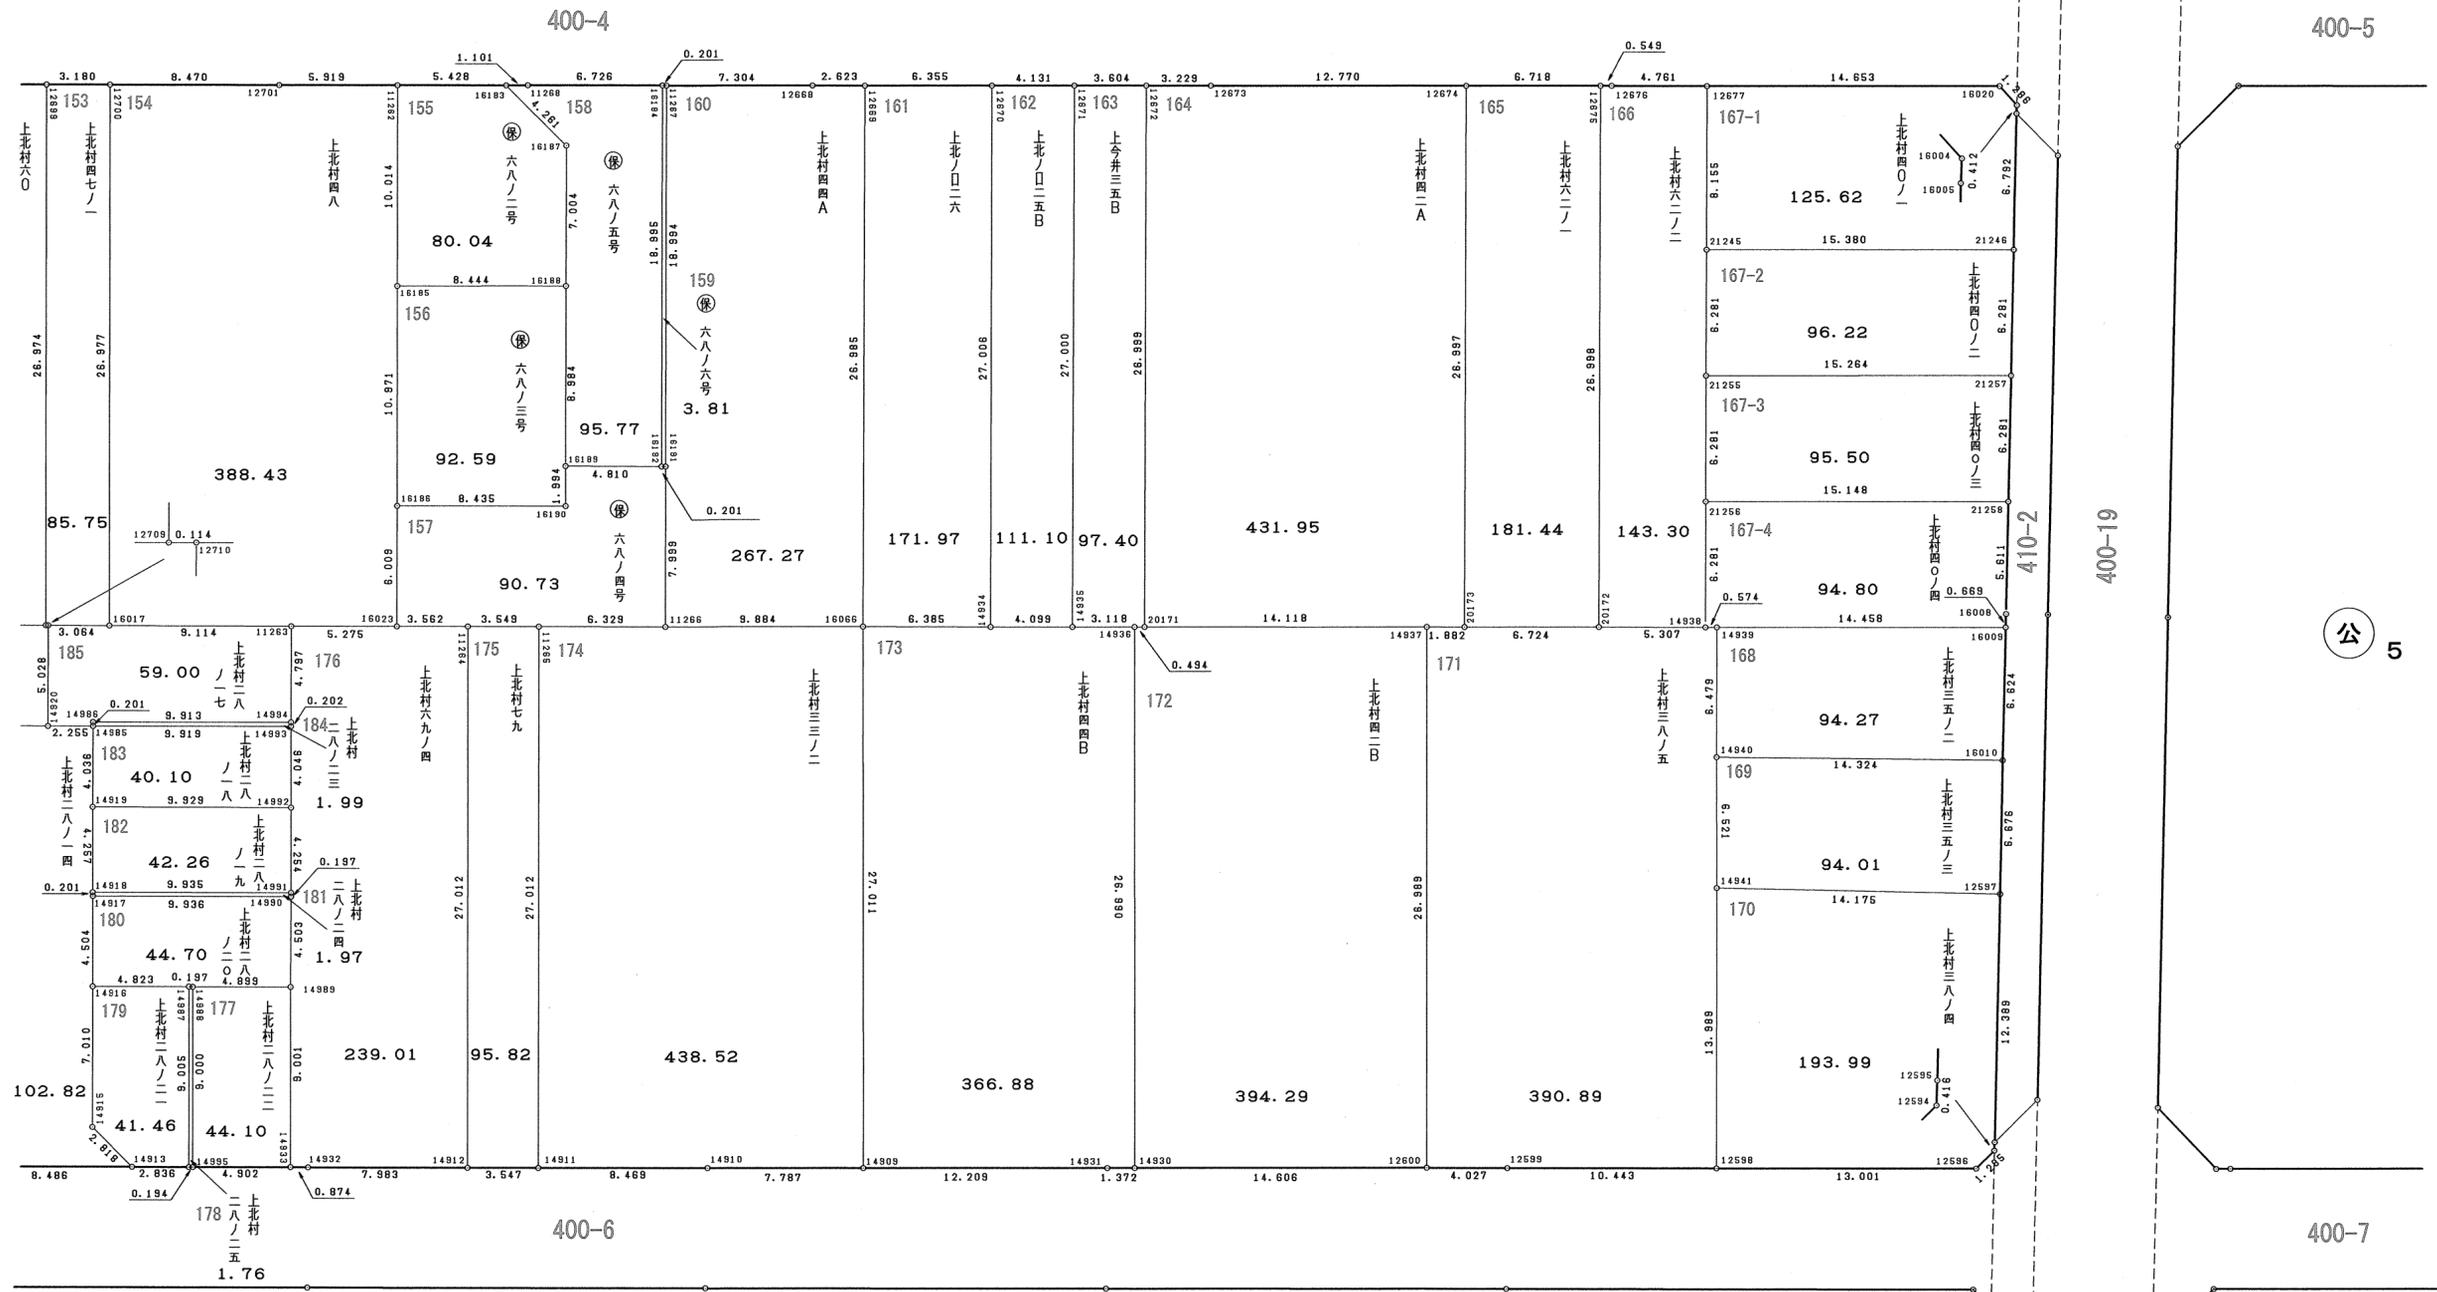

64

66

図面の種類	画地出来形確認測量図		
街区番号	68 2/2	番号	縮尺 1:250
町名	上桂北村町		
京都市洛西第二土地区画整理組合			

142

Table with 4 columns: NO, X, Y, 辺長. Includes area and ground area calculations.

143

Table with 4 columns: NO, X, Y, 辺長. Includes area and ground area calculations.

144

Table with 4 columns: NO, X, Y, 辺長. Includes area and ground area calculations.

167-1

Table with 4 columns: NO, X, Y, 辺長. Includes area and ground area calculations.

167-2

Table with 4 columns: NO, X, Y, 辺長. Includes area and ground area calculations.

167-3

Table with 4 columns: NO, X, Y, 辺長. Includes area and ground area calculations.

Summary table with columns: 図面の種類, 画地, 面積, 求積表, 街区番号, 町名, 京都市洛西第二土地区画整理組合.

167-4 table with columns: 地番, 上北村四〇ノ四, NO, X, Y, 辺長, 面積, 地積

168 table with columns: 地番, 上北村三五ノ二, NO, X, Y, 辺長, 面積, 地積

169 table with columns: 地番, 上北村三五ノ三, NO, X, Y, 辺長, 面積, 地積

170 table with columns: 地番, 上北村三八ノ四, NO, X, Y, 辺長, 面積, 地積

171 table with columns: 地番, 上北村三八ノ五, NO, X, Y, 辺長, 面積, 地積

172 table with columns: 地番, 上北村四二B, NO, X, Y, 辺長, 面積, 地積

173 table with columns: 地番, 上北村四四B, NO, X, Y, 辺長, 面積, 地積

174 table with columns: 地番, 上北村三三ノ二, NO, X, Y, 辺長, 面積, 地積

175 table with columns: 地番, 上北村七九, NO, X, Y, 辺長, 面積, 地積

176 table with columns: 地番, 上北村六九ノ四, NO, X, Y, 辺長, 面積, 地積

177 table with columns: 地番, 上北村二八ノ二二, NO, X, Y, 辺長, 面積, 地積

178 table with columns: 地番, 上北二八ノ二五, NO, X, Y, 辺長, 面積, 地積

179 table with columns: 地番, 上北村二八ノ二一, NO, X, Y, 辺長, 面積, 地積

180 table with columns: 地番, 上北村二八ノ二〇, NO, X, Y, 辺長, 面積, 地積

181 table with columns: 地番, 上北村二八ノ二四, NO, X, Y, 辺長, 面積, 地積

182 table with columns: 地番, 上北村二八ノ一九, NO, X, Y, 辺長, 面積, 地積

Summary table with columns: 図面の種類, 画地, 面積, 求積表, 街区番号, 町名, 京都市洛西第二土地区画整理組合

197

地番 保 六八ノ八号			
NO	X	Y	辺長
11258	-111732.484	-27258.625	
15211	-111735.548	-27257.247	3.360
15217	-111737.075	-27253.287	4.244
15216	-111734.563	-27247.643	6.178
21214	-111726.507	-27251.246	8.825
11258	-111732.484	-27258.625	9.496
面積	65.1651245		
地積	65.16 m ²		

198

地番 保 六八ノ九号			
NO	X	Y	辺長
21214	-111726.507	-27251.246	
15216	-111734.563	-27247.643	8.825
21219	-111734.001	-27246.385	1.378
15215	-111731.777	-27241.410	5.449
21215	-111722.065	-27245.762	10.643
21214	-111726.507	-27251.246	7.057
面積	66.4225200		
地積	66.42 m ²		

199

地番 保 六八ノ一〇号			
NO	X	Y	辺長
21215	-111722.065	-27245.762	
15215	-111731.777	-27241.410	10.643
21220	-111731.554	-27240.893	0.563
15214	-111729.378	-27236.064	5.297
21216	-111718.529	-27240.922	11.887
11257	-111720.267	-27243.542	3.144
21215	-111722.065	-27245.762	2.857
面積	66.4741865		
地積	66.47 m ²		

200

地番 保 六八ノ一一号			
NO	X	Y	辺長
21216	-111718.529	-27240.922	
15214	-111729.378	-27236.064	11.887
15213	-111729.314	-27235.926	0.152
15212	-111733.111	-27234.234	4.157
15044	-111733.426	-27234.085	0.348
11260	-111731.381	-27229.519	5.003
11261	-111716.801	-27236.055	15.978
11256	-111716.084	-27237.237	1.382
21216	-111718.529	-27240.922	4.422
面積	85.4705250		
地積	85.47 m ²		

201

地番 上北村五九ノ二			
NO	X	Y	辺長
14973	-111711.746	-27247.311	
14974	-111713.341	-27250.852	3.884
14975	-111714.945	-27254.381	3.876
14976	-111716.546	-27257.910	3.875
16014	-111719.513	-27264.436	7.169
16013	-111728.011	-27260.629	9.312
11258	-111732.484	-27258.625	4.901
21214	-111726.507	-27251.246	9.496
21215	-111722.065	-27245.762	7.057
11257	-111720.267	-27243.542	2.857
14977	-111720.172	-27243.577	0.101
14973	-111711.746	-27247.311	9.216
面積	221.0460070		
地積	221.04 m ²		

202

地番 上北村五九ノ四			
NO	X	Y	辺長
16003	-111709.826	-27260.001	
16012	-111713.122	-27267.299	8.008
16014	-111719.513	-27264.436	7.003
14976	-111716.546	-27257.910	7.169
16003	-111709.826	-27260.001	7.038
面積	53.0683415		
地積	53.06 m ²		

図面の種類				画地面積求積表			
街区番号	68		番号	$\frac{3}{3}$	縮尺		
町名	上 桂 北 村 町						
京都市洛西第二土地区画整理組合							




S = 1 : 2 5 0

400-4

400-17

200-1

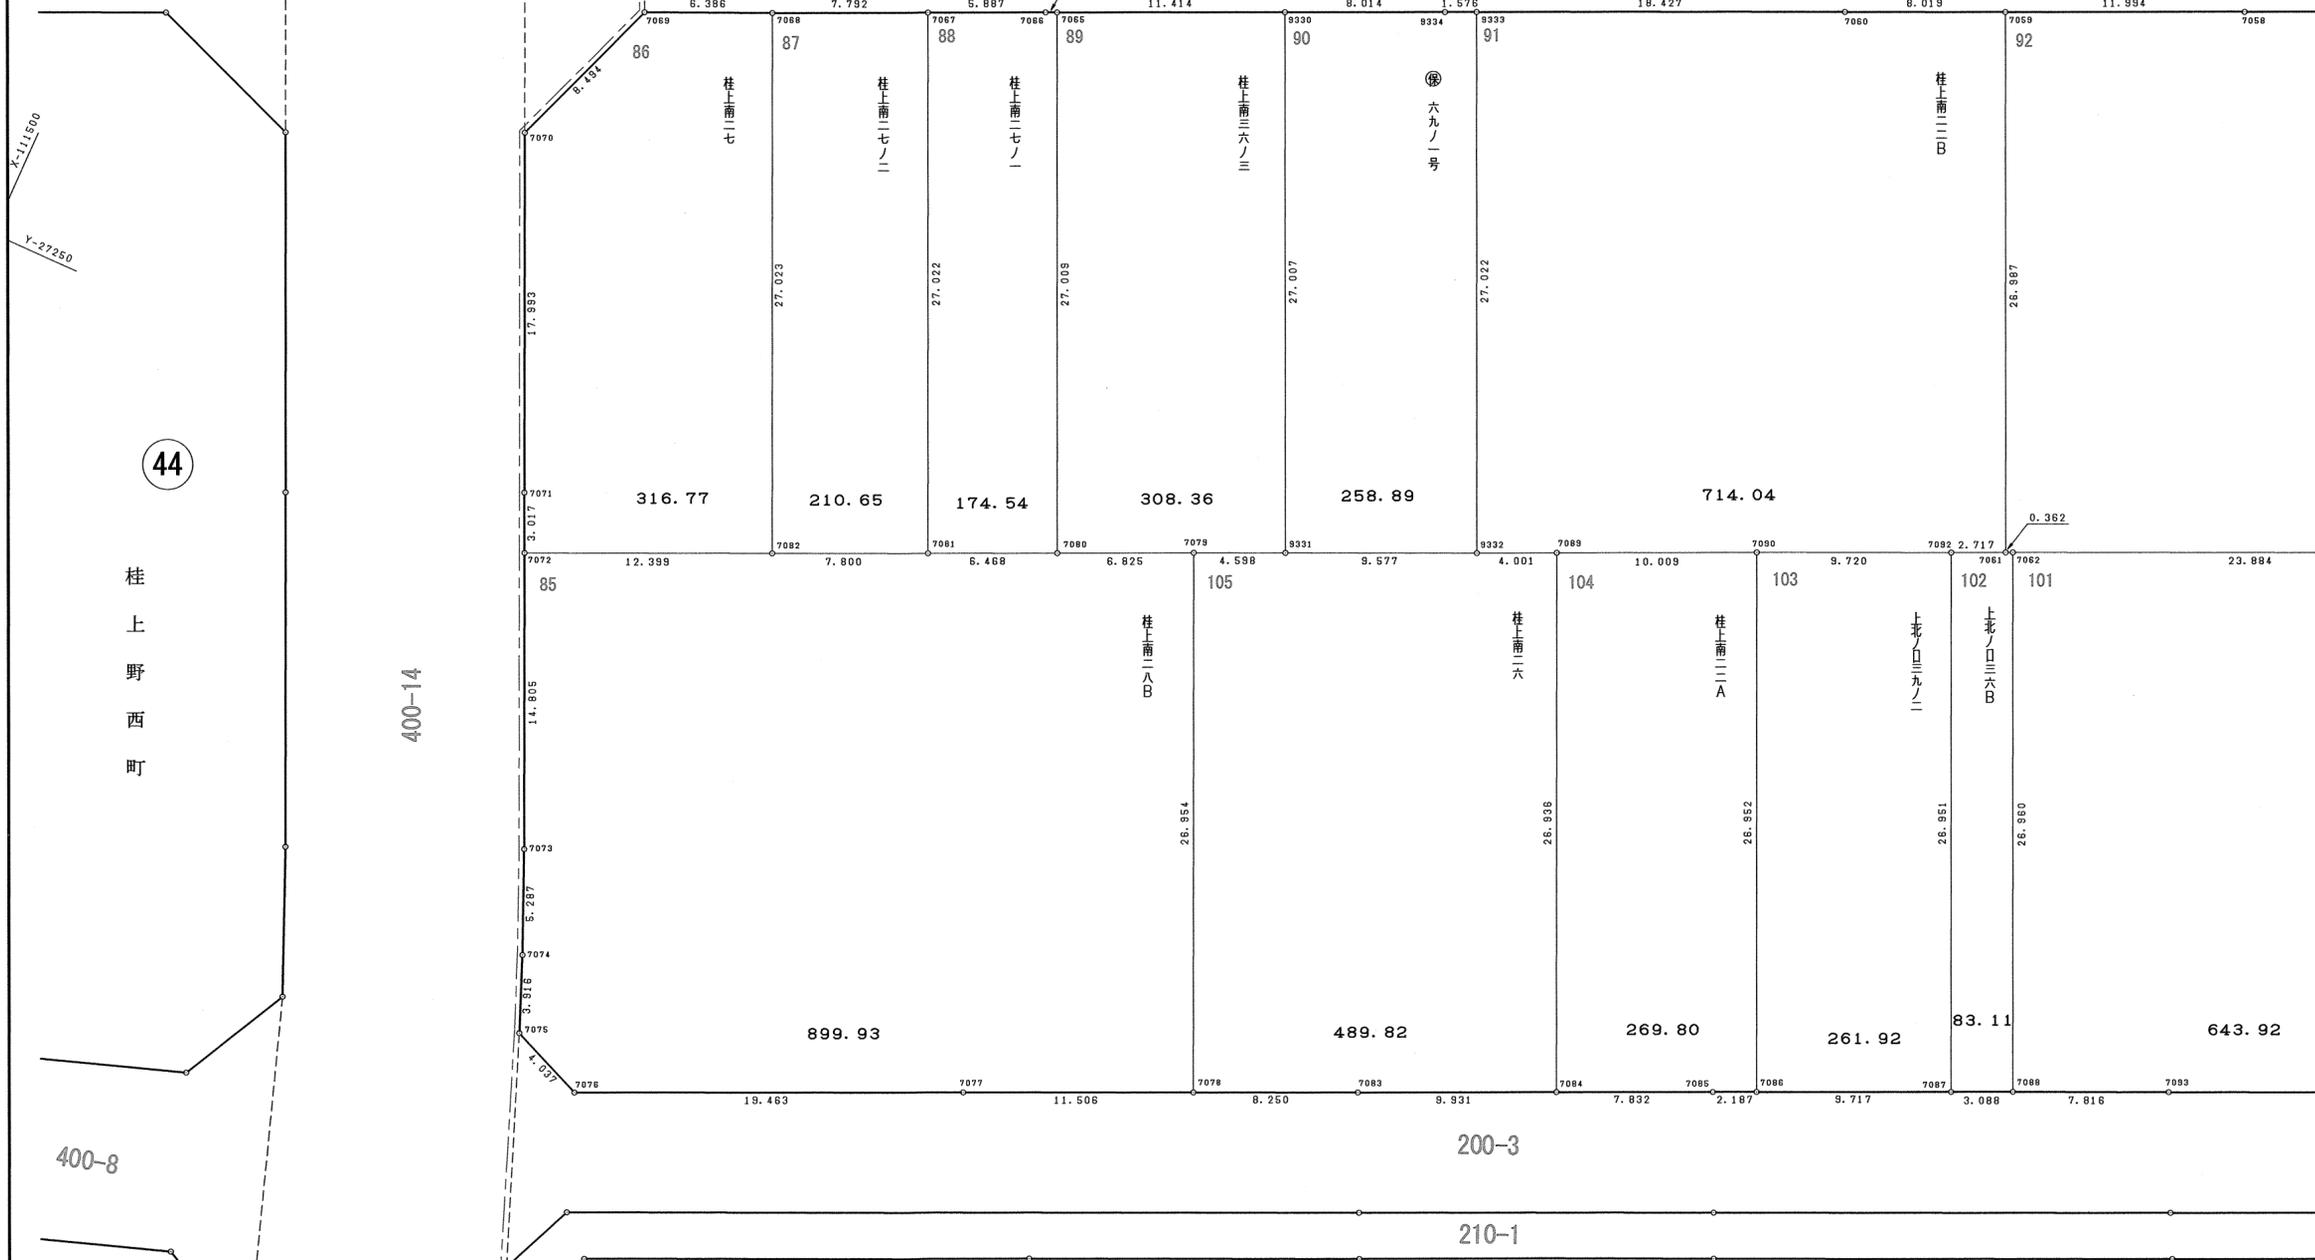

44

桂上野西町

400-14

400-8

43 小

200-3

210-1

67

図面の種類	画地出来形確認測量図			
街区番号	69	1/2	番号	縮尺 1:250
町名	桂上野南町			
京都市洛西第二土地区画整理組合				

85

Table with 4 columns: NO, X, Y, 辺長. Includes area and ground area calculations.

86

Table with 4 columns: NO, X, Y, 辺長. Includes area and ground area calculations.

87

Table with 4 columns: NO, X, Y, 辺長. Includes area and ground area calculations.



105

Table with 4 columns: NO, X, Y, 辺長. Includes area and ground area calculations.

Summary table with columns: 図面の種類, 画地面積求積表, 街区番号, 69, 町名, 桂上野南町, 京都市洛西第二土地区画整理組合.

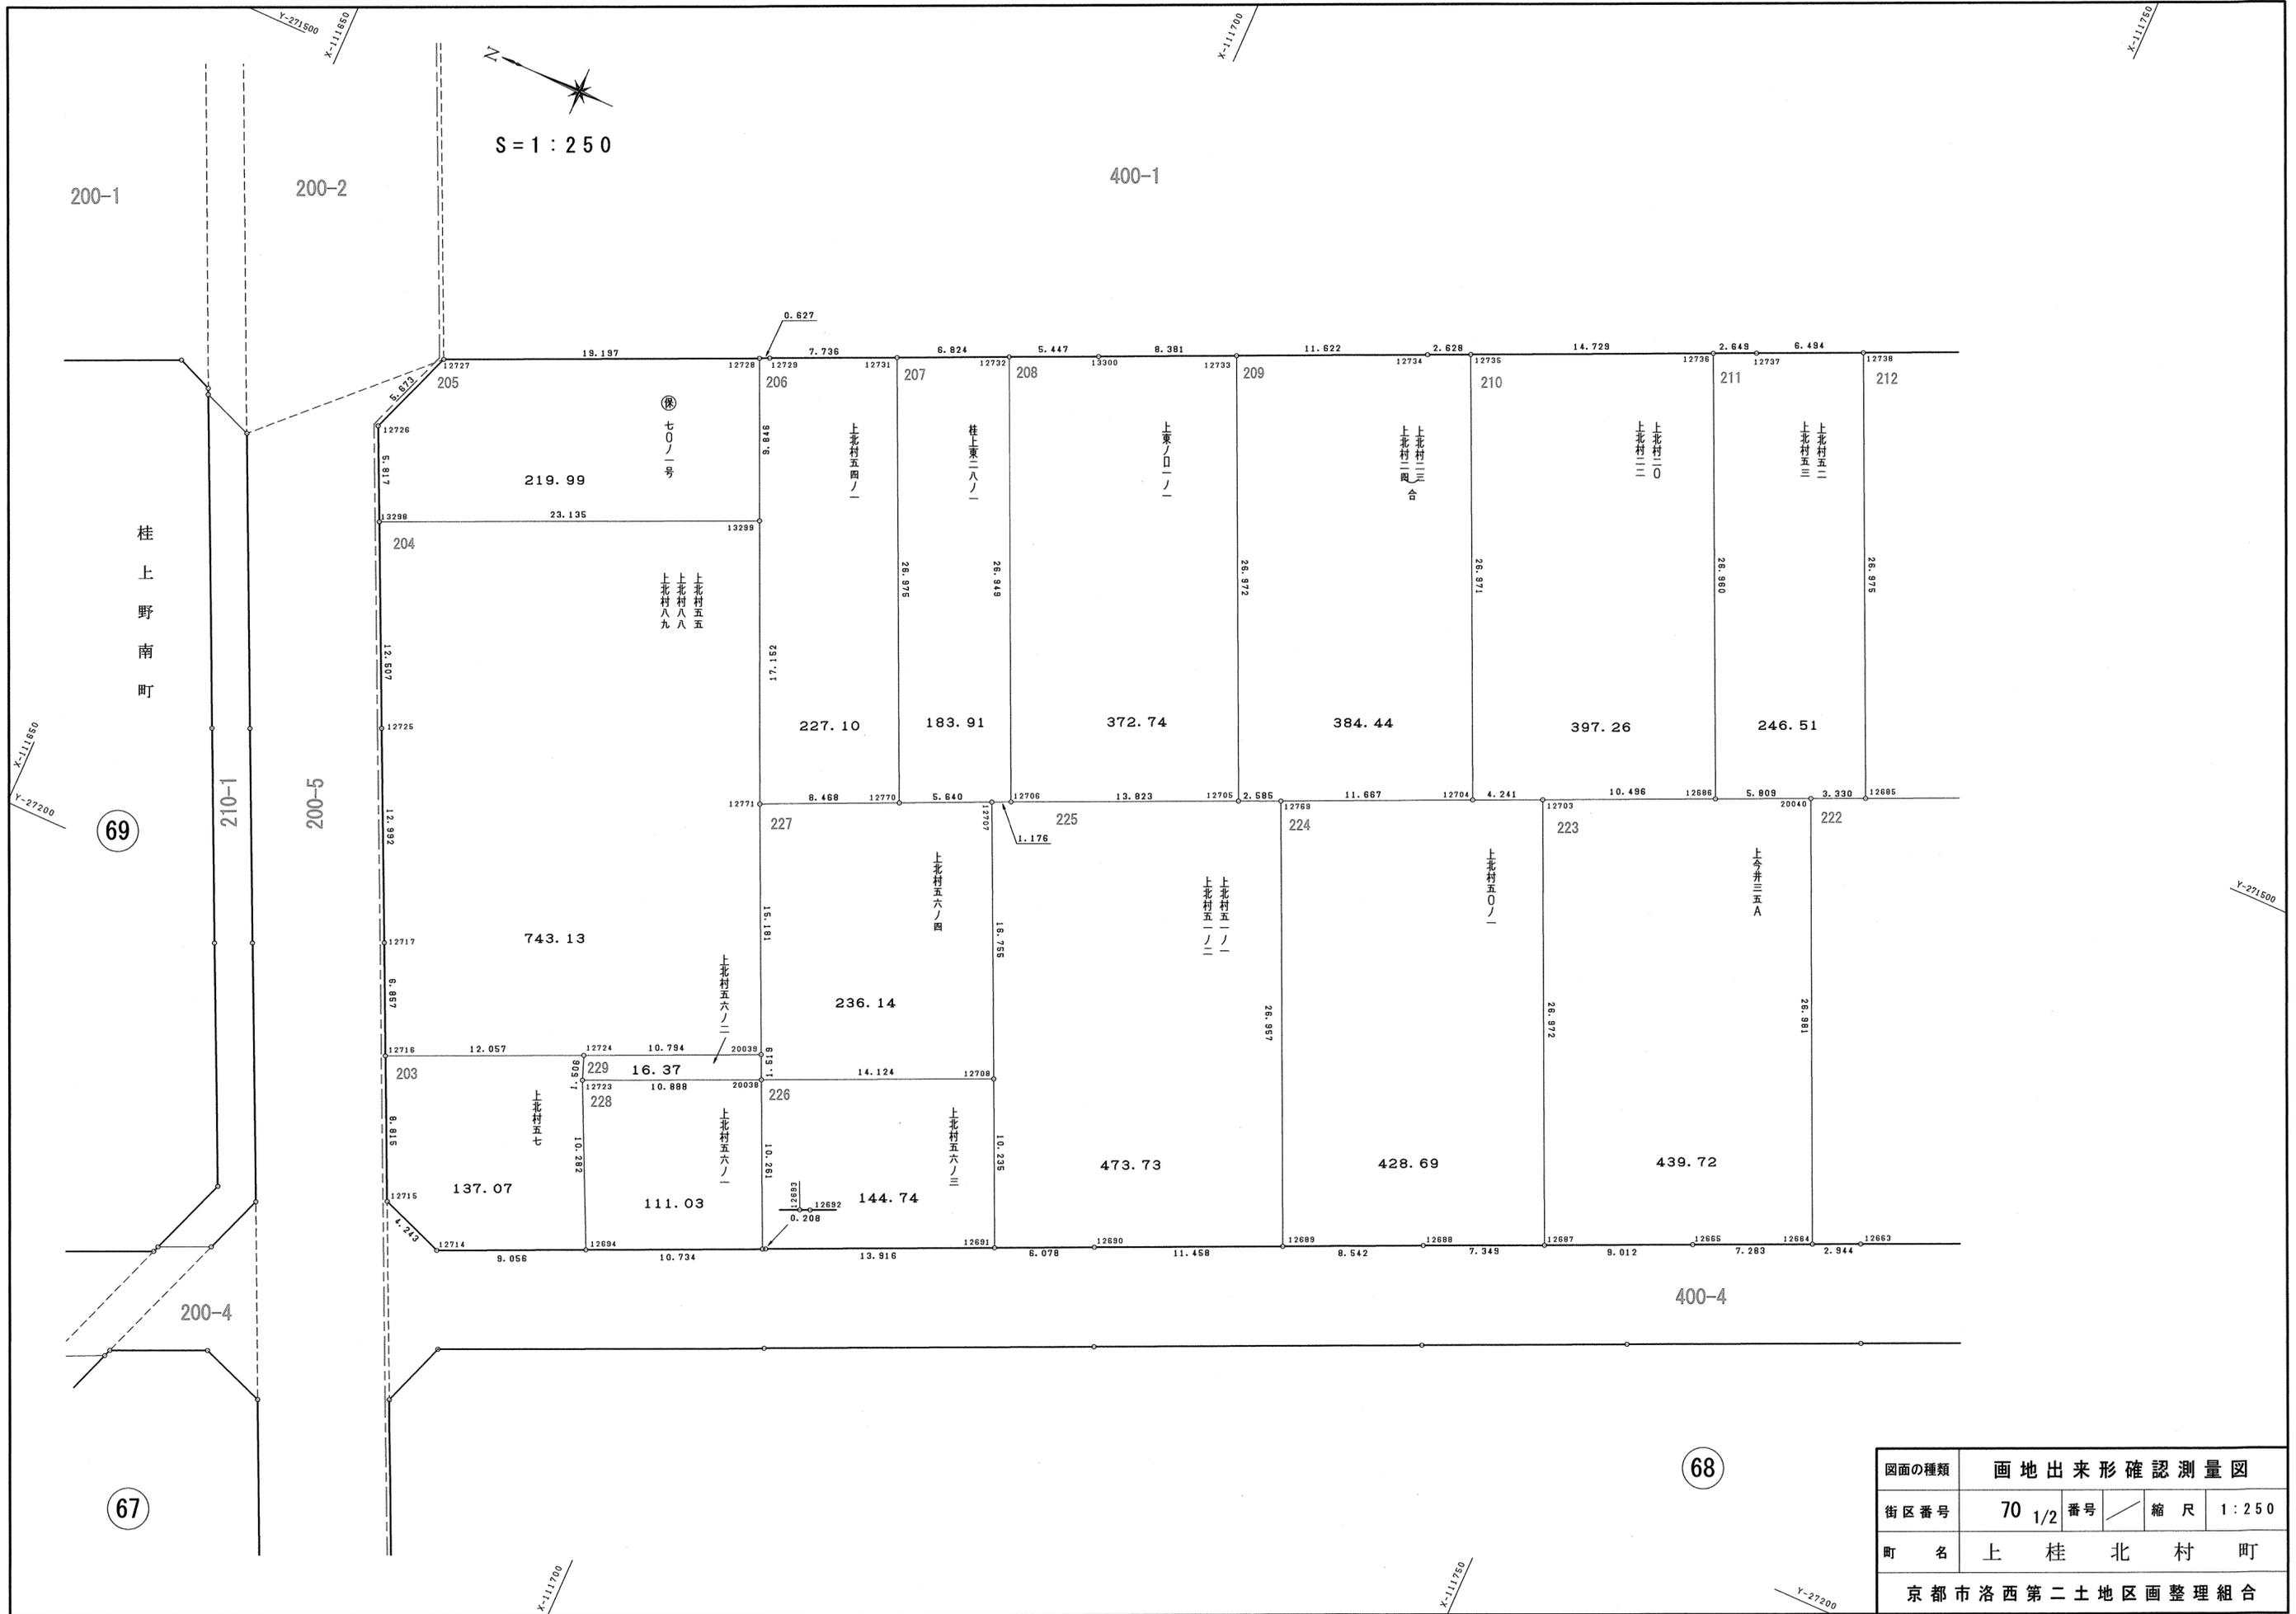

図面の種類	画地出来形確認測量図		
街区番号	70 1/2	番号	縮尺 1:250
町名	上桂北村町		
京都市洛西第二土地区画整理組合			

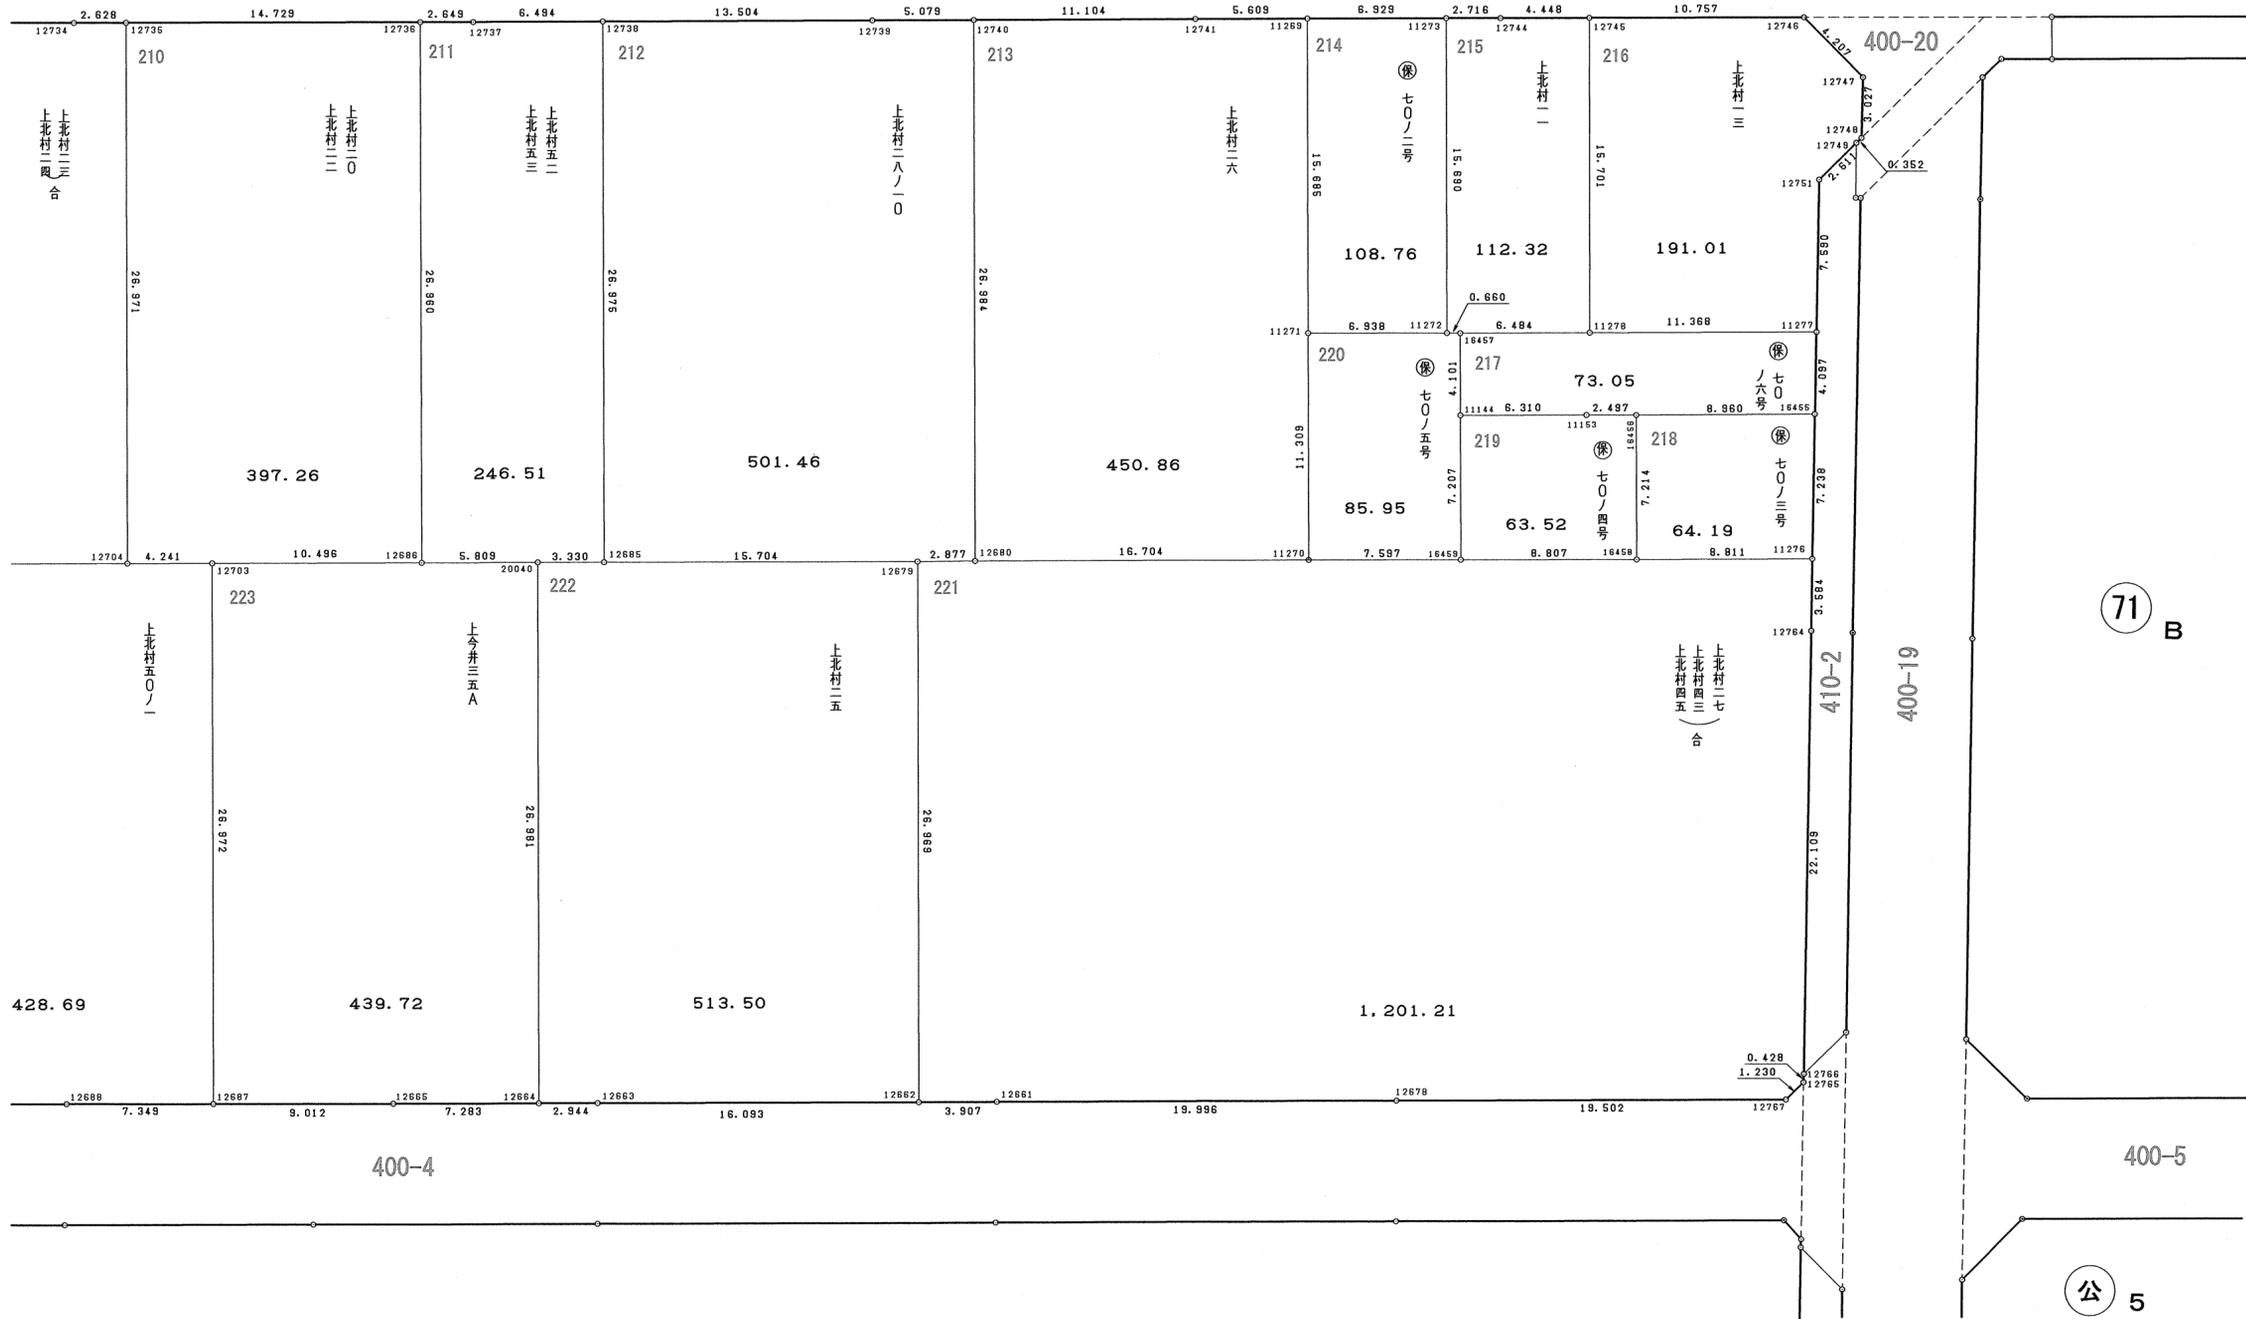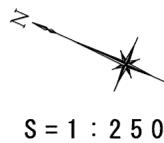

68

図面の種類	画地出来形確認測量図		
街区番号	70 2/2	番号	縮尺 1:250
町名	上桂北村町		
京都市洛西第二土地区画整理組合			

203

地番 上北村五七				
NO	X	Y	辺長	
12716	-111677.245	-27204.693		
12715	-111680.903	-27212.713	8.815	
12714	-111684.877	-27214.199	4.243	
12694	-111693.140	-27210.493	9.056	
12723	-111688.783	-27201.180	10.282	
12724	-111688.252	-27199.771	1.506	
12716	-111677.245	-27204.693	12.057	
面積				137.0749710
地積				137.07 m ²

204

地番 上北村五五、八八、八九				
NO	X	Y	辺長	
13298	-111663.785	-27175.269		
12725	-111668.986	-27186.643	12.507	
12717	-111674.399	-27198.454	12.992	
12716	-111677.245	-27204.693	6.857	
12724	-111688.252	-27199.771	12.057	
20039	-111698.102	-27195.357	10.794	
12771	-111691.876	-27181.511	15.181	
13299	-111684.910	-27165.837	17.152	
13298	-111663.785	-27175.269	23.135	
面積				743.1330985
地積				743.13 m ²

205

地番 保七〇ノ一号				
NO	X	Y	辺長	
12727	-111663.389	-27164.679		
12726	-111661.366	-27169.979	5.673	
13298	-111663.785	-27175.269	5.817	
13299	-111684.910	-27165.837	23.135	
12728	-111680.912	-27156.839	9.846	
12727	-111663.389	-27164.679	19.197	
面積				219.9937330
地積				219.99 m ²

206

地番 上北村五四ノ一				
NO	X	Y	辺長	
12728	-111680.912	-27156.839		
13299	-111684.910	-27165.837	9.846	
12771	-111691.876	-27181.511	17.152	
12770	-111699.595	-27178.028	8.468	
12731	-111688.544	-27163.421	26.975	
12729	-111681.484	-27156.583	7.736	
12728	-111680.912	-27156.839	0.627	
面積				227.1089170
地積				227.10 m ²

207

地番 桂上東二八ノ一				
NO	X	Y	辺長	
12731	-111688.544	-27153.421		
12770	-111699.595	-27178.028	26.975	
12707	-111704.737	-27175.710	5.640	
12706	-111705.806	-27175.219	1.176	
12732	-111694.772	-27150.632	26.949	
12731	-111688.544	-27153.421	6.824	
面積				183.9123890
地積				183.91 m ²

208

地番 上東ノローノ一				
NO	X	Y	辺長	
12732	-111694.772	-27150.632		
12706	-111705.806	-27175.219	26.949	
12705	-111718.431	-27169.590	13.823	
12733	-111707.392	-27144.980	26.972	
13300	-111699.743	-27148.406	8.381	
12732	-111694.772	-27150.632	5.447	
面積				372.7439585
地積				372.74 m ²

209

地番 上北村二三 上北村二四)合地				
NO	X	Y	辺長	
12733	-111707.392	-27144.980		
12705	-111718.431	-27169.590	26.972	
12769	-111720.795	-27168.544	2.585	
12704	-111731.437	-27163.763	11.667	
12735	-111720.397	-27139.155	26.971	
12734	-111717.999	-27140.230	2.628	
12733	-111707.392	-27144.980	11.622	
面積				384.4478400
地積				384.44 m ²

210

地番 上北村二〇、二二				
NO	X	Y	辺長	
12735	-111720.397	-27139.155		
12704	-111731.437	-27163.763	26.971	
12703	-111735.305	-27162.024	4.241	
12686	-111744.880	-27157.725	10.496	
12736	-111733.837	-27133.130	26.960	
12735	-111720.397	-27139.155	14.729	
面積				397.2666730
地積				397.26 m ²

211

地番 上北村五二、上北村五三				
NO	X	Y	辺長	
12736	-111733.837	-27133.130		
12686	-111744.880	-27157.725	26.960	
20040	-111750.184	-27155.357	5.809	
12685	-111753.225	-27153.999	3.330	
12738	-111742.180	-27129.389	26.975	
12737	-111736.254	-27132.046	6.494	
12736	-111733.837	-27133.130	2.649	
面積				246.5178135
地積				246.51 m ²

212

地番 上北村二八ノ一〇				
NO	X	Y	辺長	
12738	-111742.180	-27129.389		
12685	-111753.225	-27153.999	26.975	
12679	-111767.564	-27147.594	15.704	
12680	-111770.184	-27146.406	2.877	
12740	-111759.138	-27121.787	26.984	
12739	-111754.503	-27123.865	5.079	
12738	-111742.180	-27129.389	13.504	
面積				501.4682735
地積				501.46 m ²

213

地番 上北村二六				
NO	X	Y	辺長	
12740	-111759.138	-27121.787		
12680	-111770.184	-27146.406	26.984	
11270	-111785.430	-27139.580	16.704	
11271	-111780.799	-27129.263	11.309	
11269	-111774.387	-27114.948	15.685	
12741	-111769.270	-27117.244	5.609	
12740	-111759.138	-27121.787	11.104	
面積				450.8605065
地積				450.86 m ²

214

地番 保七〇ノ二号				
NO	X	Y	辺長	
11269	-111774.387	-27114.948		
11271	-111780.799	-27129.263	15.685	
11272	-111787.131	-27126.427	6.938	
11273	-111780.709	-27112.112	15.690	
11269	-111774.387	-27114.948	6.929	
面積				108.7696170
地積				108.76 m ²

215

地番 上北村一一				
NO	X	Y	辺長	
11273	-111780.709	-27112.112		
11272	-111787.131	-27126.427	15.690	
16457	-111787.738	-27126.167	0.660	
11278	-111793.655	-27123.515	6.484	
12745	-111787.246	-27109.182	15.701	
12744	-111783.187	-27111.000	4.448	
11273	-111780.709	-27112.112	2.716	
面積				112.3225315
地積				112.32 m ²

216

地番 上北村一三				
NO	X	Y	辺長	
12745	-111787.246	-27109.182		
11278	-111793.655	-27123.515	15.701	
11277	-111804.025	-27118.857	11.368	
12751	-111801.061	-27111.870	7.590	
12749	-111802.009	-27109.437	2.611	
12748	-111802.144	-27109.112	0.352	
12747	-111800.981	-27106.317	3.027	
12746	-111797.063	-27104.784	4.207	
12745	-111787.246	-27109.182	10.757	
面積				191.0195845
地積				191.01 m ²

217

地番 保七〇ノ六号				
NO	X	Y	辺長	
11144	-111789.417	-27129.909		
11153	-111795.175	-27127.327	6.310	
16456	-111797.456	-27126.310	2.497	
16455	-111805.625	-27122.629	8.960	
11277	-111804.025	-27118.857	4.097	
11278	-111793.655	-27123.515	11.368	
16457	-111787.738	-27126.167	6.484	
11144	-111789.417	-27129.909	4.101	
面積				73.0507730
地積				73.05 m ²

218

地番 保七〇ノ三号				
NO	X	Y	辺長	
16458	-111800.409	-27132.892		
11276	-111808.451	-27129.292	8.811	
16455	-111805.625	-27122.629	7.238	
16456	-111797.456	-27126.310	8.960	
16458	-111800.409	-27132.892	7.214	
面積				64.1978985
地積				64.19 m ²

219

地番 保七〇ノ四号				
NO	X	Y	辺長	
16459	-111792.368	-27136.484		
16458	-111800.409	-27132.892	8.807	
16456	-111797.456	-27126.310	7.214	
11153	-111795.175	-27127.327	2.497	
11144	-111789.417	-27129.909	6.310	
16459	-111792.368	-27136.484	7.207	
面積				63.5218840
地積				63.52 m ²

220

地番 保七〇ノ五号				
NO	X	Y	辺長	
11270	-111785.430	-27139.580		
16459	-111792.368	-27136.484	7.597	
11144	-111789.417	-27129.909	7.207	
16457	-111787.738	-27126.167	4.101	
11272	-111787.131	-27126.427	0.660	
11271	-111780.799	-27129.263	6.938	
11270	-111785.430	-27139.580	11.309	
面積				85.9564900
地積				85.95 m ²


221

地番 上北村二七、四三、四五 合地				
NO	X	Y	辺長	
12679	-111767.564	-27147.594		
12662	-111778.573	-27172.214	26.969	
12661	-111782.139	-27170.618	3.907	
12678	-111800.399	-27162.450	19.996	
12767	-111818.181	-27154.477	19.502	
12765	-111818.652	-27153.338	1.230	
12766	-111818.492	-27152.941	0.428	
12764	-111809.851	-27132.591	22.109	
11276	-111808.451	-27129.292	3.584	
16458	-111800.409	-27132.892	8.811	
16459	-111792.368	-27136.484	8.807	
11270	-111785.430	-27139.580	7.597	
12680	-111770.184	-27146.406	16.704	
12679	-111767.564	-27147.594	2.877	
面積				1201.2169135
地積				1201.21 m ²

222

地番 上北村二五				
NO	X	Y	辺長	
20040	-111750.184	-27155.357		
12664	-111761.196	-27179.988	26.981	
12663	-111763.884	-27178.788	2.944	
12662	-111778.573	-2717		

S = 1 : 250

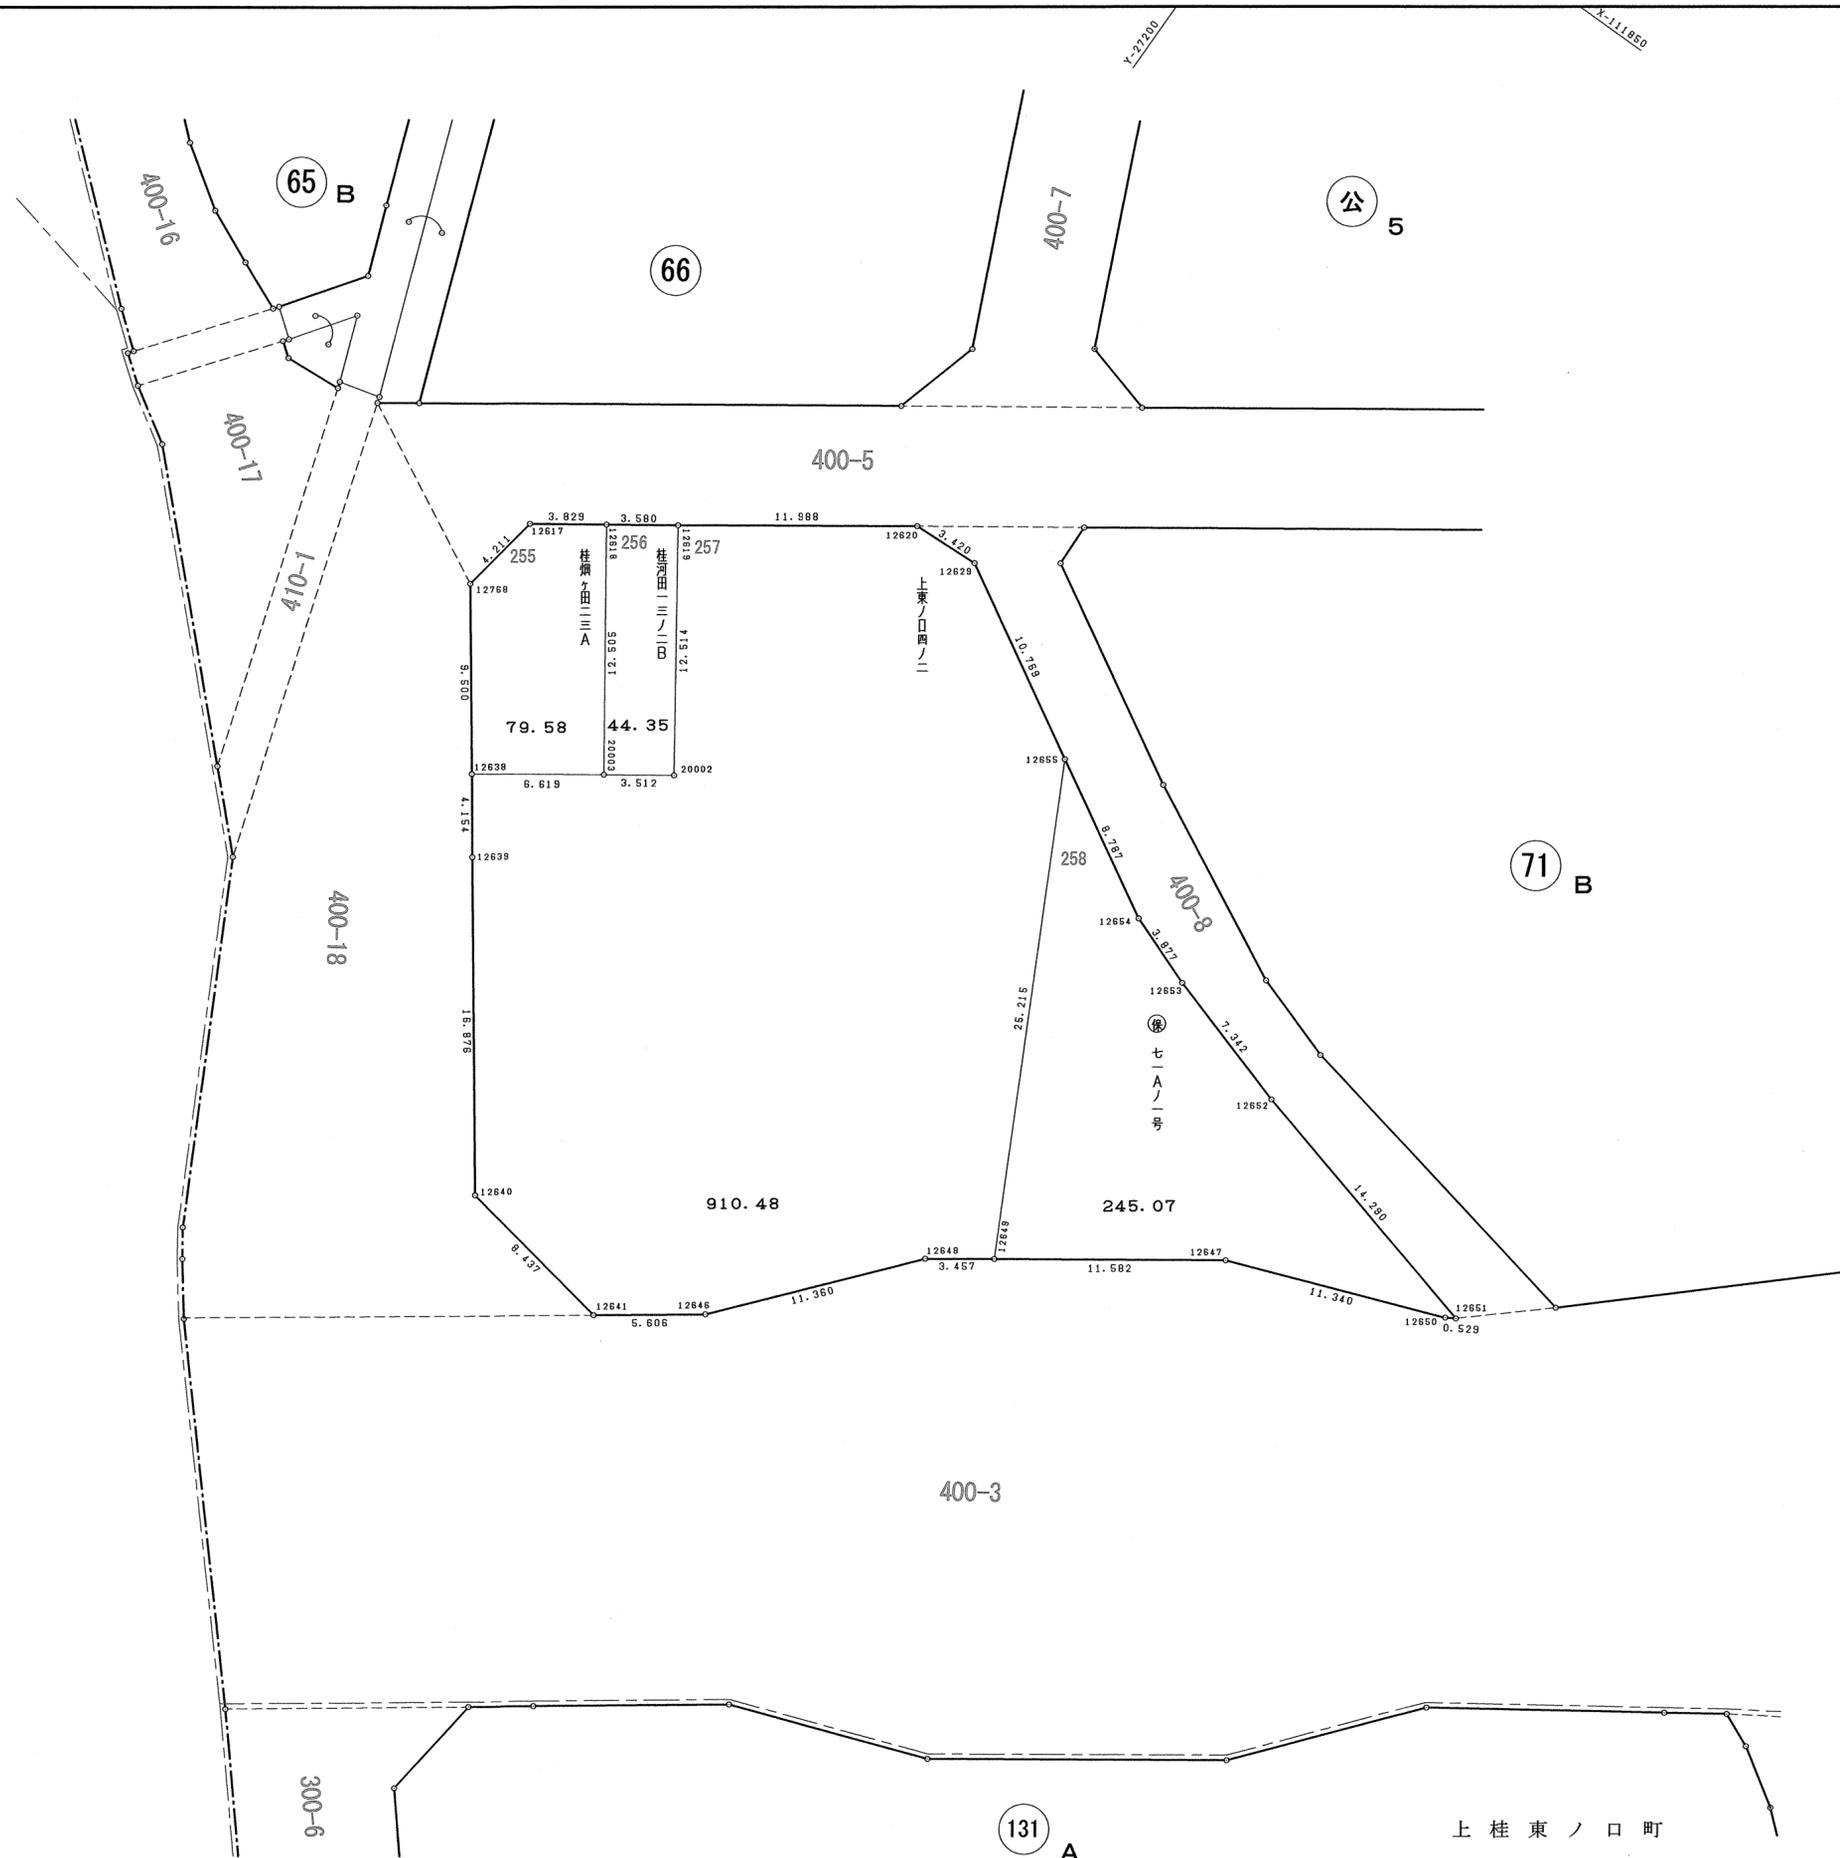

図面の種類	画地出来形確認測量図		
街区番号	71A	番号	縮尺 1:250
町名	上桂北村町		
京都市洛西第二土地区画整理組合			

255

地番 桂畑ヶ田二三A			
NO	X	Y	辺長
12617	-111901.459	-27211.425	
12768	-111905.609	-27212.137	4.211
12638	-111913.307	-27206.570	9.500
20003	-111909.520	-27201.141	6.619
12618	-111899.260	-27208.290	12.505
12617	-111901.459	-27211.425	3.829
面積	79.5892270		
地積	79.58 m ²		

256

地番 桂河田一三ノ二B			
NO	X	Y	辺長
12618	-111899.260	-27208.290	
20003	-111909.520	-27201.141	12.505
20002	-111907.510	-27198.261	3.512
12619	-111897.204	-27205.359	12.514
12618	-111899.260	-27208.290	3.580
面積	44.3593320		
地積	44.35 m ²		


257

地番 上東ノ口四ノ二			
NO	X	Y	辺長
12629	-111890.170	-27192.128	
12620	-111890.319	-27195.545	3.420
12619	-111897.204	-27205.359	11.988
20002	-111907.510	-27198.261	12.514
20003	-111909.520	-27201.141	3.512
12638	-111913.307	-27206.570	6.619
12639	-111916.673	-27204.135	4.154
12640	-111930.347	-27194.245	16.876
12641	-111931.810	-27185.936	8.437
12646	-111928.533	-27181.387	5.606
12648	-111919.890	-27174.015	11.360
12649	-111917.903	-27171.186	3.457
12655	-111895.509	-27182.776	25.215
12629	-111890.170	-27192.128	10.769
面積	910.4858695		
地積	910.48 m ²		

258

地番 保 七-Aノ一号			
NO	X	Y	辺長
12655	-111895.509	-27182.776	
12649	-111917.903	-27171.186	25.215
12647	-111911.246	-27161.708	11.582
12650	-111907.225	-27151.105	11.340
12651	-111906.944	-27150.657	0.529
12652	-111903.380	-27164.495	14.290
12653	-111901.219	-27171.512	7.342
12654	-111899.865	-27175.145	3.877
12655	-111895.509	-27182.776	8.787
面積	245.0715830		
地積	245.07 m ²		

図面の種類	画地面積求積表			
街区番号	71A	番号	縮尺	
町名	上桂北村町			
京都市洛西第二土地区画整理組合				

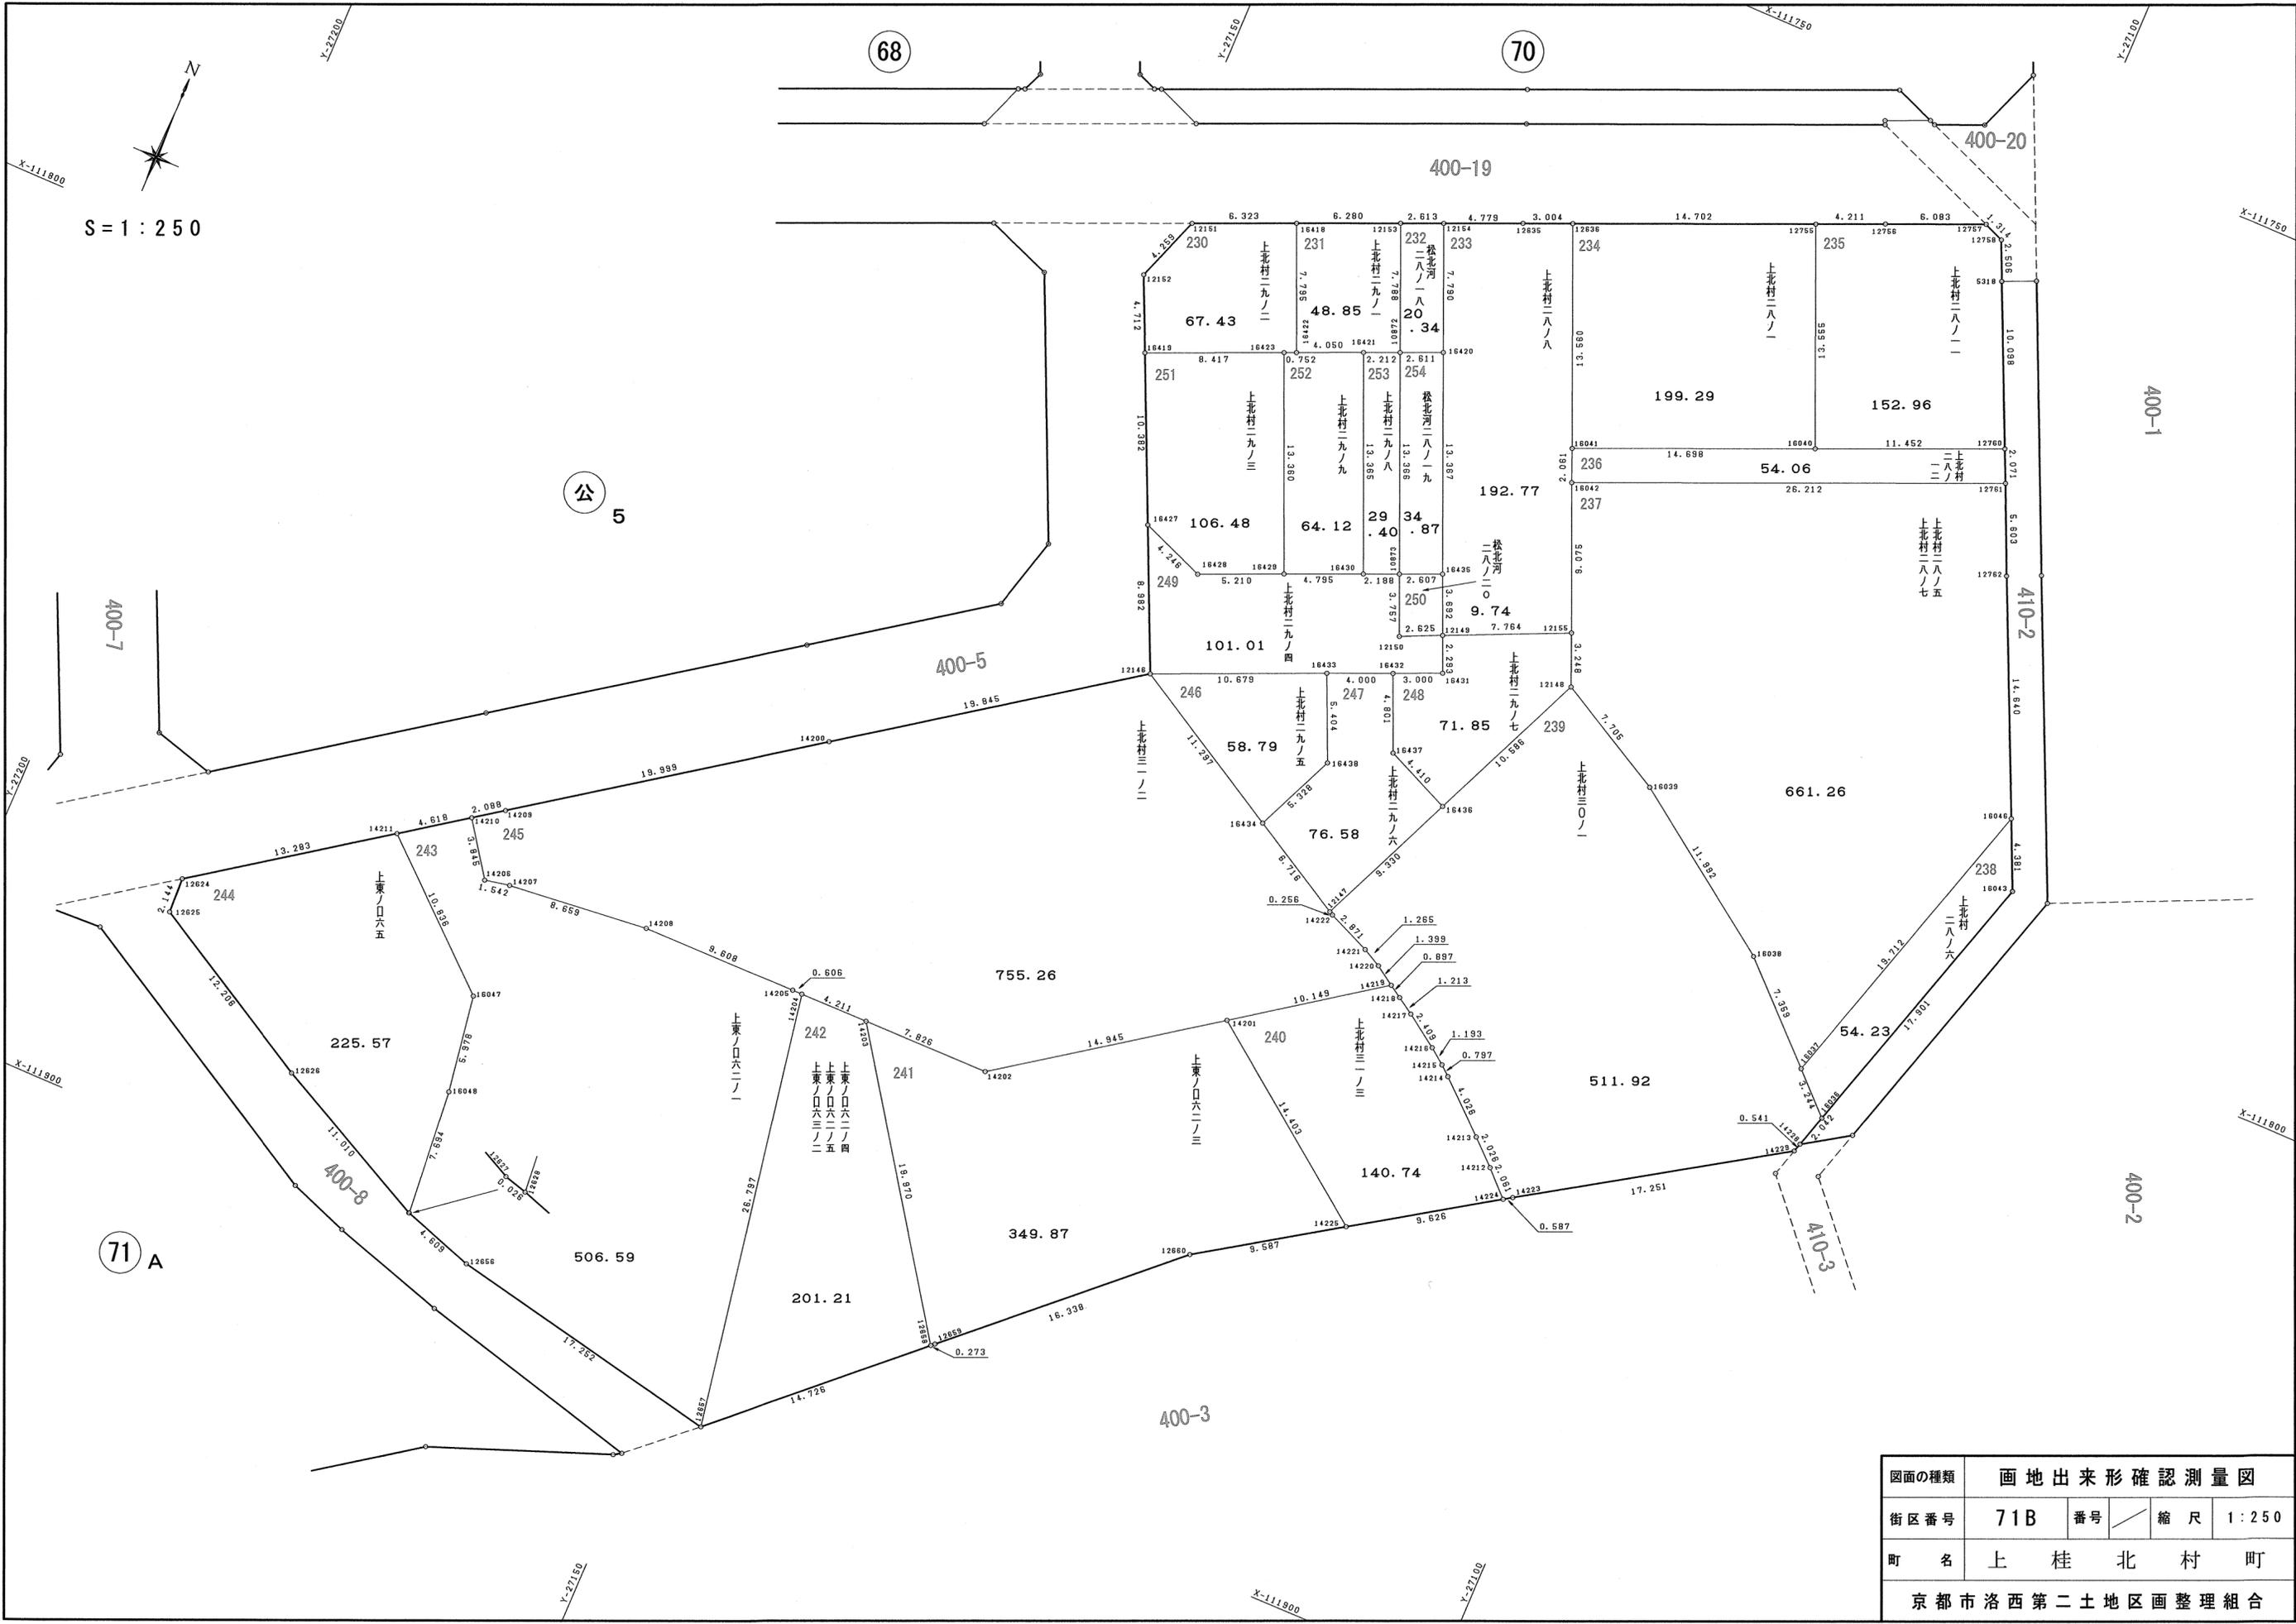

S = 1 : 250

公 5

71 A

図面の種類	画地出来形確認測量図		
街区番号	71B	番号	縮尺 1:250
町名	上桂北村町		
京都市洛西第二土地区画整理組合			

230

地番 上北村二九ノ二				
NO	X	Y	辺長	
12151	-111825.218	-27148.060		
12152	-111829.213	-27149.537	4.259	
16419	-111833.514	-27147.613	4.712	
16423	-111830.204	-27139.874	8.417	
16422	-111829.909	-27139.182	0.752	
16418	-111822.740	-27142.243	7.795	
12151	-111825.218	-27148.060	6.323	
面積	67.4368420			
地積	67.43 m ²			

231

地番 上北村二九ノ一				
NO	X	Y	辺長	
16418	-111822.740	-27142.243		
16422	-111829.909	-27139.182	7.795	
16421	-111828.315	-27135.459	4.050	
10872	-111827.449	-27133.424	2.212	
12153	-111820.279	-27136.465	7.788	
16418	-111822.740	-27142.243	6.280	
面積	48.8508255			
地積	48.85 m ²			

232

地番 松北河二八ノ一八				
NO	X	Y	辺長	
12154	-111819.255	-27134.061		
12153	-111820.279	-27136.465	2.613	
10872	-111827.449	-27133.424	7.788	
16420	-111826.427	-27131.021	2.611	
12154	-111819.255	-27134.061	7.790	
面積	20.3459300			
地積	20.34 m ²			

233

地番 上北村二八ノ八				
NO	X	Y	辺長	
12636	-111816.208	-27126.899		
12635	-111817.392	-27129.664	3.004	
12154	-111819.255	-27134.061	4.779	
16420	-111826.427	-27131.021	7.790	
16435	-111838.734	-27125.805	13.367	
12149	-111842.126	-27124.348	3.692	
12155	-111838.947	-27117.265	7.764	
16042	-111830.595	-27120.814	9.075	
16041	-111828.689	-27121.598	2.061	
12636	-111816.208	-27126.899	13.560	
面積	192.7773425			
地積	192.77 m ²			

234

地番 上北村二八ノ一				
NO	X	Y	辺長	
12755	-111810.464	-27113.366		
12636	-111816.208	-27126.899	14.702	
16041	-111828.689	-27121.598	13.560	
16040	-111822.942	-27108.070	14.698	
12755	-111810.464	-27113.366	13.555	
面積	199.2964065			
地積	199.29 m ²			

235

地番 上北村二八ノ一				
NO	X	Y	辺長	
12757	-111806.459	-27103.884		
12756	-111808.819	-27109.490	6.083	
12755	-111810.464	-27113.366	4.211	
16040	-111822.942	-27108.070	13.555	
12760	-111818.462	-27097.531	11.452	
5318	-111809.244	-27101.654	10.098	
12758	-111806.951	-27102.666	2.506	
12757	-111806.459	-27103.884	1.314	
面積	152.9654990			
地積	152.96 m ²			

236

地番 上北村二八ノ二				
NO	X	Y	辺長	
12760	-111818.462	-27097.531		
16040	-111822.942	-27108.070	11.452	
16041	-111828.689	-27121.598	14.698	
16042	-111830.595	-27120.814	2.061	
12761	-111820.353	-27096.686	26.212	
12760	-111818.462	-27097.531	2.071	
面積	54.0662005			
地積	54.06 m ²			

237

地番 上北村二八ノ五、上北村二八ノ七				
NO	X	Y	辺長	
12761	-111820.353	-27096.686		
16042	-111830.595	-27120.814	26.212	
12155	-111838.947	-27117.265	9.075	
12148	-111841.942	-27116.007	3.248	
16039	-111845.651	-27109.253	7.705	
16038	-111852.572	-27099.460	11.992	
16037	-111857.675	-27094.158	7.359	
16046	-111838.823	-27088.399	19.712	
12762	-111825.468	-27094.398	14.640	
12761	-111820.353	-27096.686	5.603	
面積	661.2659780			
地積	661.26 m ²			

238

地番 上北村二八ノ六				
NO	X	Y	辺長	
16046	-111838.823	-27088.399		
16037	-111857.675	-27094.158	19.712	
16036	-111859.939	-27091.834	3.244	
16043	-111842.819	-27086.604	17.901	
16046	-111838.823	-27088.399	4.381	
面積	54.2399520			
地積	54.23 m ²			

239

地番 上北村三〇ノ一				
NO	X	Y	辺長	
12148	-111841.942	-27116.007		
16436	-111851.621	-27120.295	10.586	
12147	-111860.149	-27124.080	9.330	
14222	-111860.267	-27123.853	0.256	
14221	-111861.401	-27121.215	2.871	
14220	-111861.988	-27120.095	1.265	
14219	-111862.760	-27118.928	1.399	
14218	-111863.245	-27118.173	0.897	
14217	-111863.895	-27117.149	1.213	
14216	-111865.259	-27115.163	2.409	
14215	-111865.976	-27114.209	1.193	
14214	-111866.490	-27113.600	0.797	
14213	-111869.168	-27110.594	4.026	
14212	-111870.543	-27109.106	2.026	
14224	-111871.990	-27107.639	2.061	
14223	-111871.669	-27107.147	0.587	
14229	-111862.408	-27092.592	17.251	
14228	-111861.892	-27092.431	0.541	
16036	-111859.939	-27091.834	2.042	
16037	-111857.675	-27094.158	3.244	
16038	-111852.572	-27099.460	7.359	
16039	-111845.651	-27109.253	11.992	
12148	-111841.942	-27116.007	7.705	
面積	511.9216435			
地積	511.92 m ²			

240

地番 上北村三一ノ三				
NO	X	Y	辺長	
14219	-111862.760	-27118.928		
14201	-111868.600	-27127.228	10.149	
14225	-111877.242	-27115.706	14.403	
14224	-111871.990	-27107.639	9.626	
14212	-111870.543	-27109.106	2.061	
14213	-111869.168	-27110.594	2.026	
14214	-111866.490	-27113.600	4.026	
14215	-111865.976	-27114.209	0.797	
14216	-111865.259	-27115.163	1.193	
14217	-111863.895	-27117.149	2.409	
14218	-111863.245	-27118.173	1.213	
14219	-111862.760	-27118.928	0.897	
面積	140.7446390			
地積	140.74 m ²			

241

地番 上東ノ口六二ノ三				
NO	X	Y	辺長	
14201	-111868.600	-27127.228		
14202	-111877.176	-27139.468	14.945	
14203	-111877.198	-27147.294	7.826	
12658	-111893.673	-27136.008	19.970	
12659	-111893.489	-27135.807	0.273	
12660	-111892.474	-27123.740	16.338	
14225	-111877.242	-27115.706	9.587	
14201	-111868.600	-27127.228	14.403	
面積	349.8764225			
地積	349.87 m ²			

242

地番 上東ノ口六二ノ四、六二ノ五、六三ノ二				
NO	X	Y	辺長	
14203	-111877.198	-27147.294		
14204	-111877.211	-27151.505	4.211	
12657	-111903.606	-27146.880	26.797	
12658	-111893.673	-27136.008	14.726	
14203	-111877.198	-27147.294	19.970	
面積	201.2147540			
地積	201.21 m ²			

243

地番 上東ノ口六二ノ一				
NO	X	Y	辺長	
14204	-111877.211	-27151.505		
14205	-111877.217	-27152.111	0.606	
14208	-111877.249	-27161.719	9.608	
14207	-111878.116	-27170.334	8.659	
14206	-111878.410	-27171.848	1.542	
14210	-111875.256	-27174.048	3.845	
14211	-111877.909	-27177.828	4.618	
16047	-111885.112	-27169.732	10.836	
16048	-111891.019	-27168.815	5.978	
12628	-111898.685	-27168.154	7.694	
12656	-111900.138	-27163.780	4.609	
12657	-111903.606	-27146.880	17.252	
14204	-111877.211	-27151.505	26.797	
面積	506.5999145			
地積	506.59 m ²			

244

地番 上東ノ口六五				
NO	X	Y	辺長	
14211	-111877.909	-27177.828		
12624	-111895.541	-27188.699	13.283	
12625	-111887.683	-27188.618	2.144	
12626	-111893.720	-27178.010	12.206	
12627	-111898.677	-27168.179	11.010	
12628	-111898.685	-27168.154	0.026	
16048	-111891.019	-27168.815	7.694	
16047	-111885.112	-27169.732	5.978	
14211	-111877.909	-27177.828	10.836	
面積	225.5768440			
地積	225.57 m ²			

245


地番 上北村三一ノ二				
NO	X	Y	辺長	
12146	-111851.191	-27139.708		
14200	-111862.567	-27155.969	19.845	
14209	-111874.056	-27172.339	19.999	
14210	-111875.256	-27174.048	2.088	
14206	-111878.410	-27171.848	3.845	
14207	-111878.116	-27170.334	1.542	
14208	-111877.249	-27161.719	8.659	
14205	-111877.217	-27152.111	9.608	
14204	-111877.211	-27151.505	0.606	
14203	-111877.198	-27147.294	4.211	
14202	-111877.176	-27139.468	7.826	
14201	-111868.600	-27127.228	14.945	
14219	-111862.760	-27118.928	10.149	
14220	-111861.988	-27120.095	1.399	
14221	-111861.401	-27121.215	1.265	
14222	-111860.267	-27123.853	2.871	
12147	-111860.149	-27124.080	0.256	
16434	-111856.809	-27129.907	6.716	
12146	-111851.191	-27139.708	11.297	
面積	755.2680820			
地積	755.26 m ²			

246

地番 上北村二九ノ五				
NO	X	Y	辺長	
12146	-111851.191	-27139.708		
16434	-111856.809	-27129.907	11.297	



S = 1 : 250

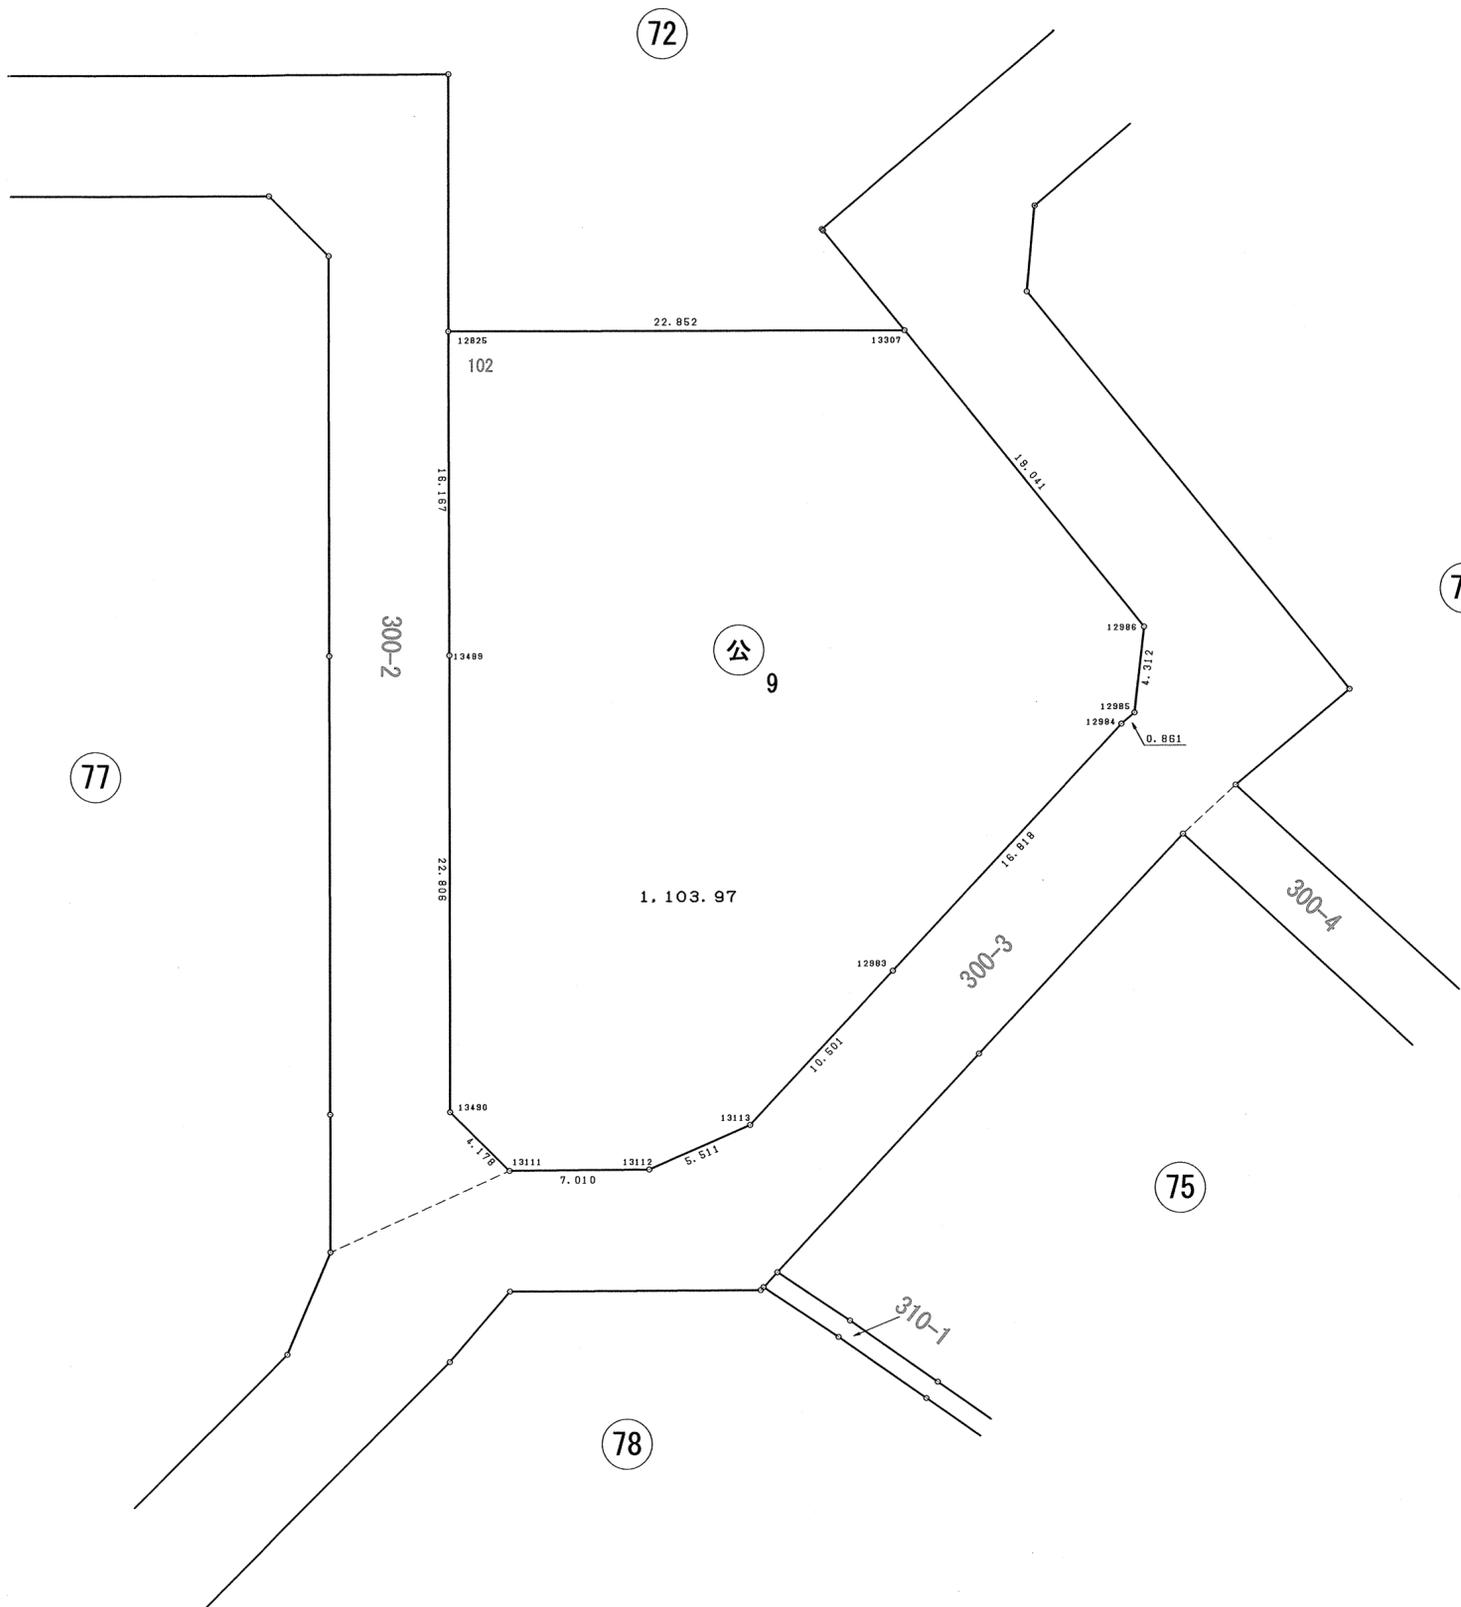

X-111200

77

72

73

75

78

X-111200

Y-27150

X-111250

図面の種類	画地出来形確認測量図			
街区番号	公9	番号	縮尺	1 : 250
町名	桂上野北町			
京都市洛西第二土地区画整理組合				

X-111250

Y-27250

Y-27250

地番		公9	
NO	X	Y	辺長
13307	-111191.973	-27207.794	
12825	-111188.297	-27230.348	22.852
13489	-111204.259	-27232.916	16.167
13490	-111226.767	-27236.591	22.806
13111	-111230.145	-27234.133	4.178
13112	-111231.216	-27227.205	7.010
13113	-111229.841	-27221.868	5.511
12983	-111223.417	-27213.561	10.501
12984	-111213.110	-27200.272	16.818
12985	-111212.666	-27199.534	0.861
12986	-111208.515	-27198.365	4.312
13307	-111191.973	-27207.794	19.041
面積	1103.9747045		
地積	1103.97 m ²		

図面の種類	画地面積求積表		
街区番号	公9	番号	縮尺
町名	桂上野北町		
京都市洛西第二土地区画整理組合			