
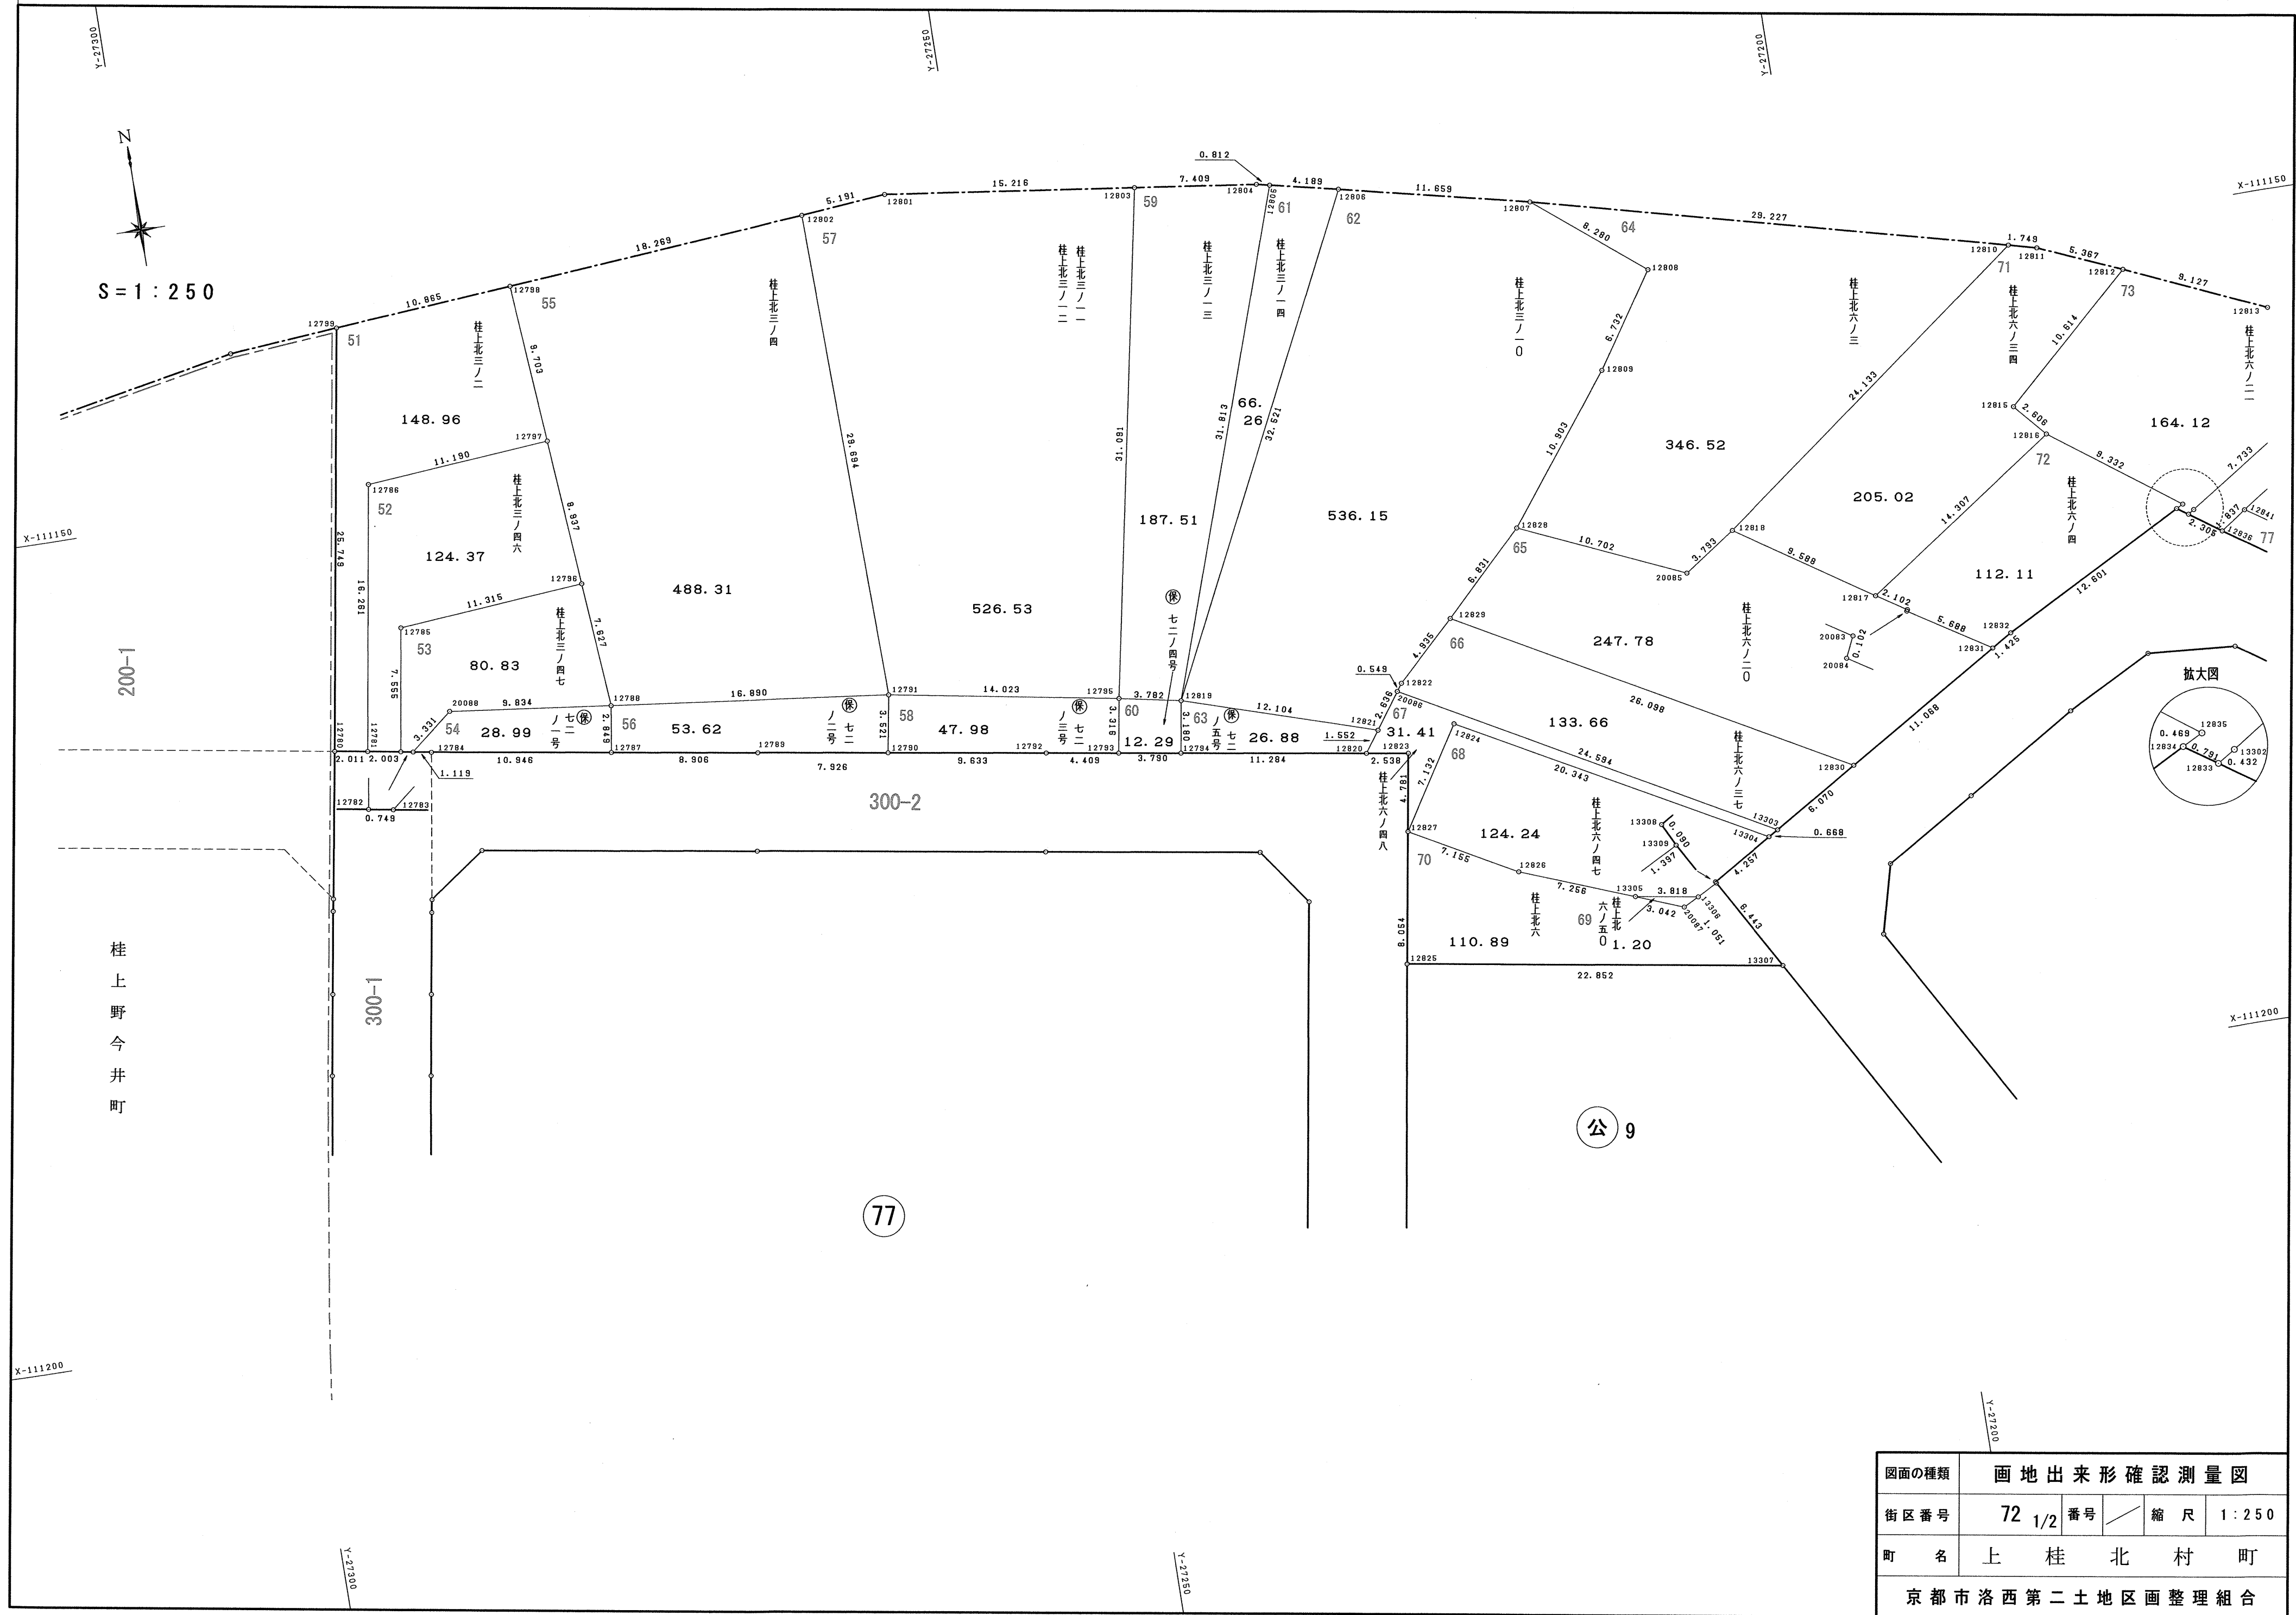


図面の種類	画地出来形確認測量図			
街区番号	72 1/2	番号	縮尺	1:250
町名	上桂北村町			
京都市洛西第二土地区画整理組合				

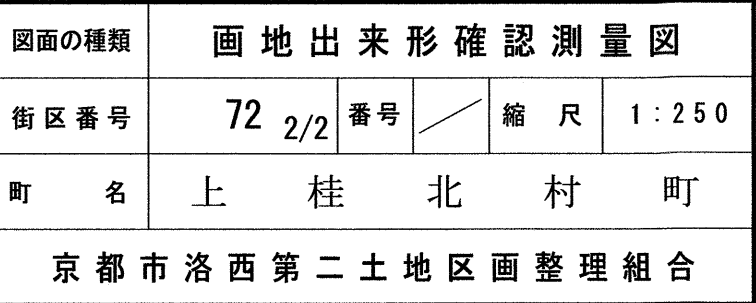

地番	桂上北三ノ二		
N O	X	Y	辺 長
12798	-111138.933	-27277.768	
12799	-111139.818	-27288.597	10.865
12780	-111165.232	-27292.736	25.749
12781	-111165.564	-27290.753	2.011
12786	-111149.512	-27288.157	16.261
12797	-111148.606	-27277.004	11.190
12798	-111138.933	-27277.768	9.703
面積	148.9697465		
地積	148.96㎡		

地番	桂上北三ノ四六		
N O	X	Y	辺 長
12797	-111148.606	-27277.004	
12786	-111149.512	-27288.157	11.190
12781	-111165.564	-27280.753	16.261
12782	-111165.894	-27288.777	2.003
12785	-111158.435	-27287.578	7.555
12796	-111157.515	-27276.300	11.315
12797	-111148.606	-27277.004	8.937
面積	124.3795225		
地積	124.37㎡		

地番	桂上北三ノ四七		
N O	X	Y	辺 長
12796	-111157.515	-27276.300	
12785	-111158.435	-27287.578	11.315
12782	-111165.894	-27288.777	7.555
12783	-111166.017	-27288.038	0.749
20088	-111163.923	-27285.447	3.331
12788	-111165.117	-27275.686	9.834
12796	-111157.515	-27276.300	7.627
面積	80.8327950		
地積	80.83㎡		

地番	保 七二ノ一号		
N O	X	Y	辺 長
12787	-111167.932	-27276.126	
12788	-111165.117	-27275.686	2.849
20088	-111163.923	-27285.447	9.834
12783	-111166.017	-27288.038	3.331
12784	-111166.202	-27286.934	1.119
12787	-111167.932	-27276.126	10.946
面積	28.9988140		
地積	28.99㎡		

地番	桂上北三ノ四		
N O	X	Y	辺 長
12802	-111137.446	-27259.560	
12798	-111138.933	-27277.768	18.269
12797	-111148.606	-27277.004	9.703
12796	-111157.515	-27276.300	8.937
12788	-111165.117	-27275.686	7.627
12791	-111167.133	-27258.917	16.890
12802	-111137.446	-27259.560	29.694
面積	488.3160745		
地積	488.31㎡		

地番	保 七二ノ二号		
N O	X	Y	辺 長
12791	-111167.133	-27258.917	
12788	-111165.117	-27275.686	16.890
12787	-111167.932	-27276.126	2.849
12789	-111169.340	-27267.332	8.906
12790	-111170.604	-27259.507	7.926
12791	-111167.133	-27258.917	3.521
面積	53.6273940		
地積	53.62㎡		

地番	桂上北三ノ一ー、桂上北三ノ一二		
N O	X	Y	辺 長
12803	-111139.024	-27239.302	
12801	-111137.023	-27254.386	15.216
12802	-111137.446	-27259.560	5.191
12791	-111167.133	-27258.917	29.694
12795	-111169.568	-27245.107	14.023
12803	-111139.024	-27239.302	31.091
面積	526.6330565		
地積	526.53㎡		

地番	保 七二ノ三号		
N O	X	Y	辺 長
12795	-111169.568	-27245.107	
12791	-111167.133	-27258.917	14.023
12790	-111170.604	-27259.507	3.521
12792	-111172.140	-27249.997	9.633
12793	-111172.840	-27245.644	4.409
12795	-111169.568	-27245.107	3.316
面積	47.9804180		
地積	47.98㎡		

地番	桂上北三ノ一三		
N O	X	Y	辺 長
12805	-111140.178	-27231.165	
12804	-111139.999	-27231.957	0.812
12803	-111139.024	-27239.302	7.409
12795	-111169.568	-27245.107	31.091
12819	-111170.301	-27241.397	3.782
12805	-111140.178	-27231.165	31.813
面積	187.5172195		
地積	187.51㎡		

地番	保 七二ノ四号		
N O	X	Y	辺 長
12819	-111170.301	-27241.397	
12795	-111169.568	-27245.107	3.782
12793	-111172.840	-27245.644	3.316
12794	-111173.441	-27241.902	3.790
12819	-111170.301	-27241.397	3.180
面積	12.2930630		
地積	12.29㎡		

地番	桂上北三ノ一四		
N O	X	Y	辺 長
12806	-111141.101	-27227.079	
12805	-111140.178	-27231.165	4.189
12819	-111170.301	-27241.397	31.813
12806	-111141.101	-27227.079	32.521
面積	66.2633570		
地積	66.26㎡		

地番	桂上北三ノ一〇		
N O	X	Y	辺 長
12807	-111143.670	-27215.707	
12806	-111141.101	-27227.079	11.659
12819	-111170.301	-27241.397	32.521
12821	-111173.966	-27229.861	12.104
20086	-111171.819	-27228.331	2.636
12822	-111171.372	-27228.012	0.549
12829	-111167.955	-27224.451	4.935
12828	-111163.139	-27219.606	6.831
12809	-111154.477	-27212.984	10.903
12808	-111148.868	-27209.262	6.732
12807	-111143.670	-27215.707	8.280
面積	536.1565760		
地積	536.15㎡		

地番	保 七二ノ五号		
N O	X	Y	辺 長
12821	-111173.966	-27229.861	
12819	-111170.301	-27241.397	12.104
12794	-111173.441	-27241.902	3.180
12820	-111175.231	-27230.761	11.284
12821	-111173.966	-27229.861	1.552
面積	26.8891150		
地積	26.88㎡		

地番	桂上北六ノ三		
N O	X	Y	辺 長
12810	-111150.871	-27187.381	
12807	-111143.670	-27215.707	29.227
12808	-111148.868	-27209.262	8.280
12809	-111154.477	-27212.984	6.732
12828	-111163.139	-27219.606	10.903
20085	-111167.482	-27209.825	10.702
12818	-111165.348	-27206.689	3.793
12810	-111150.871	-27187.381	24.133
面積	346.5255675		
地積	346.52㎡		

地番	桂上北六ノ二〇		
N O	X	Y	辺 長
12831	-111174.906	-27192.159	
20084	-111171.868	-27196.968	5.688
20083	-111171.775	-27196.925	0.102
12817	-111170.648	-27198.699	2.102
12818	-111165.348	-27206.689	9.588
20085	-111167.482	-27209.825	3.793
12828	-111163.139	-27219.606	10.702
12829	-111167.955	-27224.451	6.831
12830	-111180.625	-27201.635	26.098
12831	-111174.906	-27192.159	11.068
面積	247.7888830		
地積	247.78㎡		

地番	桂上北六ノ三七		
N O	X	Y	辺 長
12830	-111180.625	-27201.635	
12829	-111167.955	-27224.451	26.098
12822	-111171.372	-27228.012	4.935
20086	-111171.819	-27228.331	0.549
13303	-111183.762	-27206.831	24.594
12830	-111180.625	-27201.635	6.070
面積	133.6618480		
地積	133.66㎡		

地番	桂上北六ノ四八		
N O	X	Y	辺 長
13303	-111183.762	-27206.831	
20086	-111171.819	-27228.331	24.594
12821	-111173.966	-27229.861	2.636
12820	-111175.231	-27230.761	1.552
12823	-111175.634	-27228.255	2.538
12827	-111180.351	-27229.035	4.781
12824	-111174.316	-27225.235	7.132
13304	-111184.107	-27207.403	20.343
13303	-111183.762	-27206.831	0.668
面積	31.4170720		
地積	31.41㎡		

地番	桂上北六ノ四七		
N O	X	Y	辺 長
13304	-111184.107	-27207.403	
12824	-111174.316	-27225.235	20.343
12827	-111180.351	-27229.035	7.132
12826	-111183.816	-27222.775	7.155
13305	-111186.425	-27216.004	7.256
13306	-111187.039	-27212.236	3.818
13309	-111186.385	-27211.002	1.397
13308	-111186.307	-27211.047	0.090
13304	-111184.107	-27207.403	4.257
面積	124.2443695		
地積	124.24㎡		

地番	桂上北六ノ五〇		
N O	X	Y	辺 長
13306	-111187.039	-27212.236	
13305	-111186.425	-27216.004	3.818
20087	-111187.525	-27213.168	3.042
13306	-111187.039	-27212.236	1.051
面積	1.2017480		
地積	1.20㎡		

地番	桂上北六		
N O	X	Y	辺 長
13309	-111186.385	-27211.002	
13306	-111187.039	-27212.236	1.397
20087	-111187.525	-27213.168	1.051
13305	-111186.425	-27216.004	3.042
12826	-111183.816	-27222.775	7.256
12827	-111180.351	-27229.035	7.155
12825	-111188.297	-27230.748	8.054
13307	-111191.973	-27207.794	22.852
13309	-111186.385	-27211.002	6.443
面積	110.8969985		
地積	110.89㎡		

地番	桂上北六ノ三四		
N O	X	Y	辺 長
12812	-111153.455	-27180.770	
12811	-111151.302	-27185.686	5.36

80

地番	桂上北六ノ四六		
N O	X	Y	辺 長
12883	-111165.977	-27151.601	
20079	-111164.437	-27155.196	3.911
20081	-111177.155	-27163.536	15.209
20082	-111179.290	-27160.330	3.852
12883	-111165.977	-27151.601	15.920
面積	59.9413515		
地積	59.94㎡		

81

地番	保 七二ノ一二号		
N O	X	Y	辺 長
20082	-111179.290	-27160.330	
20081	-111177.155	-27163.536	3.852
12839	-111178.815	-27164.624	1.985
12840	-111181.008	-27161.456	3.853
20082	-111179.290	-27160.330	2.054
面積	7.7783910		
地積	7.77㎡		

82

地番	桂上北六ノ四三		
N O	X	Y	辺 長
12846	-111168.424	-27147.601	
12884	-111166.101	-27151.312	4.378
12883	-111165.977	-27151.601	0.314
20082	-111179.290	-27160.330	15.920
12864	-111183.041	-27154.700	6.765
12848	-111176.349	-27150.098	8.122
12854	-111175.119	-27151.930	2.207
12846	-111168.424	-27147.601	7.973
面積	92.9580605		
地積	92.95㎡		

83

地番	保 七二ノ一一号		
N O	X	Y	辺 長
12864	-111183.041	-27154.700	
20082	-111179.290	-27160.330	6.765
12840	-111181.008	-27161.456	2.054
12861	-111184.829	-27155.936	6.713
12864	-111183.041	-27154.700	2.174
面積	14.2442410		
地積	14.24㎡		

84

地番	桂上北六ノ三五		
N O	X	Y	辺 長
12885	-111171.309	-27142.992	
12846	-111168.424	-27147.601	5.437
12854	-111175.119	-27151.930	7.973
12848	-111176.349	-27150.098	2.207
12849	-111176.920	-27149.271	1.005
12850	-111178.152	-27147.390	2.249
12885	-111171.309	-27142.992	8.134
面積	43.9178525		
地積	43.91㎡		

85

地番	保 七二ノ八号		
N O	X	Y	辺 長
12849	-111176.920	-27149.271	
12848	-111176.349	-27150.098	1.005
12864	-111183.041	-27154.700	8.122
12861	-111184.829	-27155.936	2.174
12862	-111185.396	-27155.116	0.997
12849	-111176.920	-27149.271	10.296
面積	10.2839785		
地積	10.28㎡		

86

地番	保 七二ノ九号		
N O	X	Y	辺 長
12850	-111178.152	-27147.390	
12849	-111176.920	-27149.271	2.249
12862	-111185.396	-27155.116	10.296
12863	-111186.676	-27153.267	2.249
12851	-111178.706	-27147.778	9.677
12850	-111178.152	-27147.390	0.676
面積	23.1881890		
地積	23.18㎡		

87

地番	桂上北六ノ二八、桂上北六ノ三六		
N O	X	Y	辺 長
12857	-111176.853	-27134.137	
12885	-111171.309	-27142.992	10.447
12850	-111178.152	-27147.390	8.134
12853	-111180.785	-27143.396	4.784
12856	-111183.863	-27138.743	5.579
12857	-111176.853	-27134.137	8.388
面積	85.9277150		
地積	85.92㎡		

88

地番	保 七二ノ一〇号		
N O	X	Y	辺 長
12853	-111180.785	-27143.396	
12850	-111178.152	-27147.390	4.784
12851	-111178.706	-27147.778	0.676
12852	-111181.393	-27143.817	4.786
12853	-111180.785	-27143.396	0.740
面積	3.9868975		
地積	3.98㎡		

89

地番	桂上北六ノ四四		
N O	X	Y	辺 長
12856	-111183.863	-27138.743	
12853	-111180.785	-27143.396	5.579
12852	-111181.393	-27143.817	0.740
12855	-111184.537	-27139.029	5.728
12856	-111183.863	-27138.743	0.732
面積	4.1255790		
地積	4.12㎡		

90

地番	保 七二ノ七号		
N O	X	Y	辺 長
12852	-111181.393	-27143.817	
12851	-111178.706	-27147.778	4.786
12863	-111186.676	-27153.267	9.677
12865	-111189.381	-27149.358	4.754
12852	-111181.393	-27143.817	9.722
面積	46.2658050		
地積	46.26㎡		

91

地番	桂上北六ノ二九		
N O	X	Y	辺 長
12881	-111181.541	-27126.650	
12857	-111176.853	-27134.137	8.834
12856	-111183.863	-27138.743	8.388
12858	-111188.241	-27132.121	7.938
12859	-111188.551	-27131.606	0.601
12881	-111181.541	-27126.650	8.585
面積	73.7713730		
地積	73.77㎡		

92

地番	桂上北六ノ三一、桂上北六ノ三二		
N O	X	Y	辺 長
12858	-111188.241	-27132.121	
12856	-111183.863	-27138.743	7.938
12855	-111184.537	-27139.029	0.732
12852	-111181.393	-27143.817	5.728
12865	-111189.381	-27149.358	9.722
12860	-111191.085	-27146.897	2.993
12866	-111196.632	-27138.891	9.740
12858	-111188.241	-27132.121	10.782
面積	135.0063380		
地積	135.00㎡		

93

地番	桂上北六ノ四五		
N O	X	Y	辺 長
12859	-111188.551	-27131.606	
12858	-111188.241	-27132.121	0.601
12866	-111196.632	-27138.891	10.782
12867	-111196.955	-27138.424	0.568
12868	-111195.073	-27136.881	2.434
12859	-111188.551	-27131.606	8.388
面積	6.3414215		
地積	6.34㎡		

94

地番	桂上北三二ノ一		
N O	X	Y	辺 長
12878	-111199.622	-27098.262	
12880	-111182.273	-27125.480	32.277
12881	-111181.541	-27126.650	1.380
12859	-111188.551	-27131.606	8.585
12868	-111195.073	-27136.881	8.388
12867	-111196.955	-27138.424	2.434
12869	-111202.472	-27130.462	9.687
12870	-111210.724	-27118.427	14.592
12871	-111215.292	-27114.666	5.917
12875	-111209.476	-27108.490	8.483
12876	-111204.990	-27103.830	6.468
12877	-111204.213	-27103.024	1.120
12878	-111199.622	-27098.262	6.615
面積	640.0920900		
地積	640.09㎡		

95

地番	桂上北三三ノ三		
N O	X	Y	辺 長
20074	-111204.585	-27090.476	
12878	-111199.622	-27098.262	9.233
12877	-111204.213	-27103.024	6.615
20078	-111211.371	-27097.473	9.058
20074	-111204.585	-27090.476	9.747
面積	73.5664720		
地積	73.56㎡		

96

地番	桂上北三三ノ四		
N O	X	Y	辺 長
16054	-111211.583	-27079.810	
12879	-111210.462	-27081.255	1.829
20074	-111204.585	-27090.476	10.935
20078	-111211.371	-27097.473	9.747
12874	-111219.560	-27091.124	10.362
16054	-111211.583	-27079.810	13.843
面積	133.2426385		
地積	133.24㎡		

97

地番	桂上北三三ノ一〇		
N O	X	Y	辺 長
12874	-111219.560	-27091.124	
20078	-111211.371	-27097.473	10.362
20077	-111212.151	-27098.277	1.120
20076	-111220.202	-27092.034	10.188
12874	-111219.560	-27091.124	1.114
面積	11.4352960		
地積	11.43㎡		

98

地番	桂上北三三ノ九		
N O	X	Y	辺 長
20078	-111211.371	-27097.473	
12877	-111204.213	-27103.024	9.058
12876	-111204.990	-27103.830	1.120
20077	-111212.151	-27098.277	9.062
20078	-111211.371	-27097.473	1.120
面積	10.0856295		
地積	10.08㎡		

99


地番	桂上北三三ノ七		
N O	X	Y	辺 長
20077	-111212.151	-27098.277	
12876	-111204.990	-27103.830	9.062
12875	-111209.476	-27108.490	6.468
20075	-111216.669	-27102.935	9.088
20077	-111212.151	-27098.277	6.489
面積	58.4417510		
地積	58.44㎡		

100



地番	桂上北三三ノ八		
N O	X	Y	辺 長
20076	-111220.202	-27092.034	
20077	-111212.151	-27098.277	10.188
20075	-111216.669	-27102.935	6.489
12873	-111223.928	-27097.329	9.172
13050	-111222.134	-27094.774	3.122
20076	-111220.202	-27092.034	3.353
面積	62.5262465		
地積	62.52㎡		

101

地番	桂上北三三ノ五、桂上北三三ノ六		
N O	X	Y	辺 長
2873	-111223.928	-27097.329	
20075	-111216.669	-27102.935	9.172
2875	-111209.476	-27108.490	9.088
2871	-111215.292	-27114.666	8.483
2872	-111226.140	-27105.736	14.051
3051	-111226.756	-27101.355	4.424
2873	-111223.928	-27097.329	4.920
面積	139.9947475		
地積	139.99 m ²		

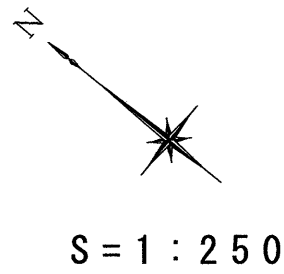

72

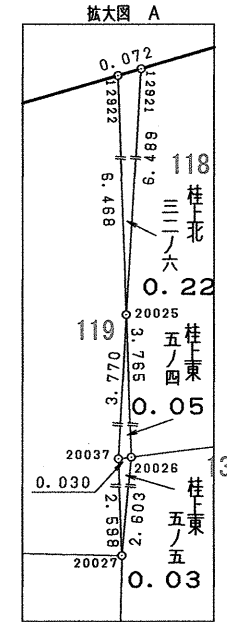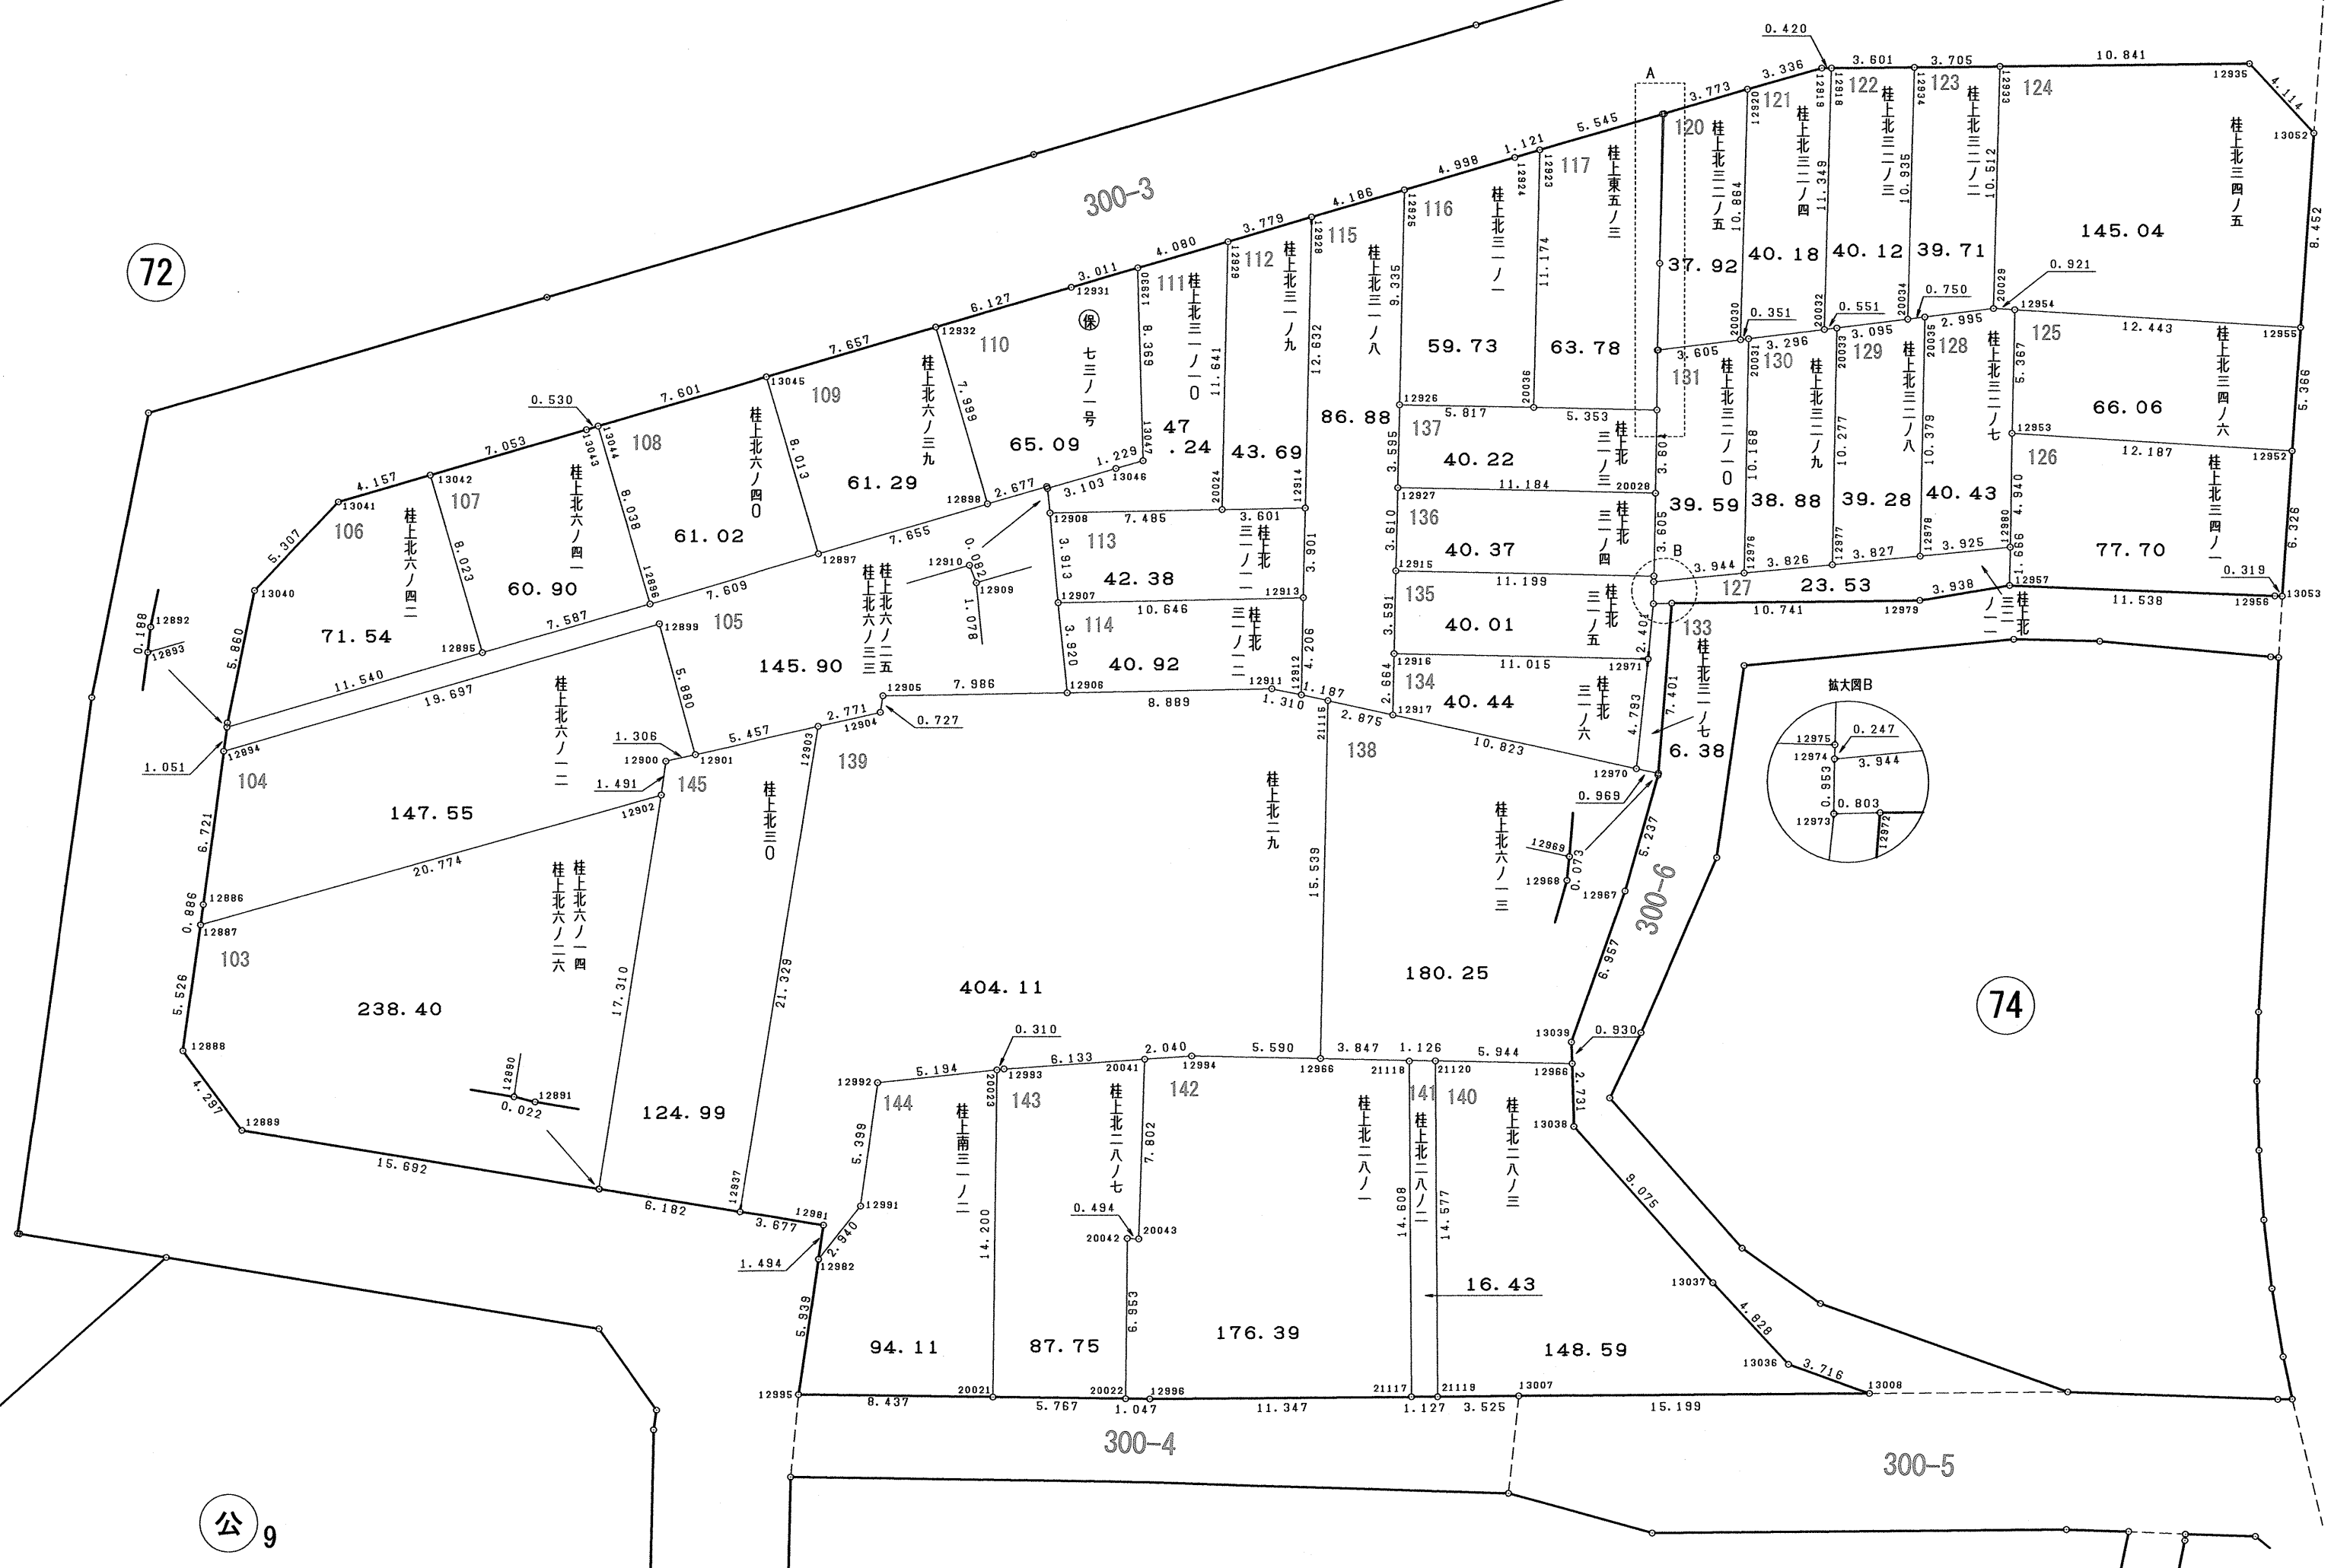

81

82

83

桂上野中町

公 9

75

74

図面の種類	画地出来形確認測量図			
街区番号	73	番号	縮尺	1:250
町名	桂上野北町			
京都市洛西第二土地区画整理組合				

103

地 番	桂上北六ノ一四、桂上北六ノ二六		
N O	X	Y	辺 長
12902	-111196.016	-27178.653	
12887	-111184.041	-27195.628	20.774
12888	-111186.891	-27200.362	5.526
12889	-111191.051	-27201.437	4.297
12890	-111204.671	-27193.644	15.692
12902	-111196.016	-27178.653	17.310
面 積	238.4065250		
地 積	238.40 m ²		

104

地番	桂上北六ノ一二		
N O	X	Y	辺長
12899	-111191.280	-27172.932	
12894	-111180.079	-27189.134	19.697
12886	-111183.584	-27194.869	6.721
12887	-111184.041	-27195.628	0.886
12902	-111196.016	-27178.653	20.774
12900	-111195.247	-27177.376	1.491
12901	-111196.061	-27176.355	1.306
12899	-111191.280	-27172.932	5.880
面積	147.5554695		
地積	147.55 m ²		

105			
地番	桂上北六ノ二五、桂上北六ノ三三		
N O	X	Y	辺長
12910	-111200.606	-27157.742	
12898	-111199.082	-27159.943	2.677
12897	-111194.736	-27166.245	7.655
12896	-111190.427	-27172.516	7.609
12895	-111186.092	-27178.743	7.587
12893	-111179.531	-27188.237	11.540
12894	-111180.079	-27189.134	1.051
12899	-111191.280	-27172.932	19.697
12901	-111196.061	-27176.355	5.880
12903	-111199.438	-27172.068	5.457
12904	-111201.158	-27169.895	2.771
12905	-111200.796	-27169.264	0.727
12906	-111206.921	-27164.140	7.986
12907	-111204.163	-27161.355	3.920
12908	-111201.434	-27158.551	3.913
12909	-111200.677	-27157.783	1.078
12910	-111200.606	-27157.742	0.082
面積	145.9055075		
地積	145.90㎡		

106

地番	桂上北六ノ四二		
N O	X	Y	辺長
13042	-111179.499	-27174.172	
13041	-111177.131	-27177.589	4.157
13040	-111176.725	-27182.880	5.307
12892	-111179.433	-27188.077	5.860
12893	-111179.531	-27188.237	0.188
12895	-111186.092	-27178.743	11.540
13042	-111179.499	-27174.172	8.023
面積	71.5485255		
地積	71.54 m ²		

107

地番	桂上北六ノ四一		
N O	X	Y	辺長
13044	-111183.819	-27167.940	
13043	-111183.517	-27168.376	0.530
13042	-111179.499	-27174.172	7.053
12895	-111186.092	-27178.743	8.023
12896	-111190.427	-27172.516	7.587
13044	-111183.819	-27167.940	8.038
面積	60.9089080		
地積	60.90 m ²		

108			
地番	桂上北六ノ四〇		
N O	X	Y	辺長
13045	-111188.144	-27161.690	
13044	-111183.819	-27167.940	7.601
12896	-111190.427	-27172.516	8.038
12897	-111194.736	-27166.245	7.609
13045	-111188.144	-27161.690	8.013
面積	61.0285635		
地積	61.02 m ²		

109

地番	桂上北六ノ三九		
N O	X	Y	辺長
12932	-111192.502	-27155.394	
13045	-111188.144	-27161.690	7.657
12897	-111194.736	-27166.245	8.013
12898	-111199.082	-27159.943	7.655
12932	-111192.502	-27155.394	7.999
面積	61.2955180		
地積	61.29 m ²		

110

地番	保 七三ノ一号		
N O	X	Y	辺 長
12930	-111197.703	-27147.881	
12931	-111195.989	-27150.356	3.011
12932	-111192.502	-27155.394	6.127
12898	-111199.082	-27159.943	7.999
12910	-111200.606	-27157.742	2.677
12909	-111200.677	-27157.783	0.082
13046	-111202.450	-27155.237	3.103
13047	-111203.155	-27154.230	1.229
12930	-111197.703	-27147.881	8.369
面積	65.0963650		
地積	65.09 ㎡		

111

地番	桂上北三一ノ一〇		
N O	X	Y	辺長
12929	-111200.026	-27144.527	
12930	-111197.703	-27147.881	4.080
13047	-111203.155	-27154.230	8.369
13046	-111202.450	-27155.237	1.229
12909	-111200.677	-27157.783	3.103
12908	-111201.434	-27158.551	1.078
20024	-111207.158	-27153.728	7.485
12929	-111200.026	-27144.527	11.641
面積	47.2409335		
地積	47.24 m ²		

112

地番	桂上北三一ノ九		
N O	X	Y	辺長
12928	-111202.178	-27141.421	
12929	-111200.026	-27144.527	3.779
20024	-111207.158	-27153.728	11.641
12914	-111209.912	-27151.408	3.601
12928	-111202.178	-27141.421	12.632
面積	43.6998110		
地積	43.69 m ²		

113			
地番	桂上北三一ノ一一		
N O	X	Y	辺長
12914	-111209.912	-27151.408	
20024	-111207.158	-27153.728	3.601
12908	-111201.434	-27158.551	7.485
12907	-111204.163	-27161.355	3.913
12913	-111212.301	-27154.492	10.646
12914	-111209.912	-27151.408	3.901
面積	42.3808600		
地積	42.38 m ²		

114			
地番	桂上北三一ノ一二		
N O	X	Y	辺長
12913	-111212.301	-27154.492	
12907	-111204.163	-27161.355	10.646
12906	-111206.921	-27164.140	3.920
12911	-111213.723	-27158.417	8.889
12912	-111214.884	-27157.811	1.310
12913	-111212.301	-27154.492	4.206
面積	40.9235485		
地積	40.92 ㎡		

115			
地番	桂上北三一ノ八		
N O	X	Y	辺長
12925	-111204.561	-27137.979	
12928	-111202.178	-27141.421	4.186
12914	-111209.912	-27151.408	12.632
12913	-111212.301	-27154.492	3.901
12912	-111214.884	-27157.811	4.206
21115	-111215.947	-27157.282	1.187
12917	-111218.520	-27156.000	2.875
12916	-111216.889	-27153.894	2.664
12915	-111214.688	-27151.056	3.591
12927	-111212.479	-27148.201	3.610
12926	-111210.279	-27145.358	3.595
12925	-111204.561	-27137.979	9.335
面積	86.8899685		
地積	86.88 m ²		

116			
地番	桂上北三一ノ一		
N O	X	Y	辺長
12923	-111208.046	-27132.949	
12924	-111207.407	-27133.870	1.121
12925	-111204.561	-27137.979	4.998
12926	-111210.279	-27145.358	9.335
20036	-111214.875	-27141.793	5.817
12923	-111208.046	-27132.949	11.174
面積	59.7371245		
地積	59.73 m ²		

117			
地番	桂上東五ノ三		
N O	X	Y	辺長
12922	-111211.207	-27128.393	
12923	-111208.046	-27132.949	5.545
20036	-111214.875	-27141.793	11.174
20027	-111219.104	-27138.512	5.353
20037	-111217.482	-27136.482	2.598
20025	-111215.186	-27133.492	3.770
12922	-111211.207	-27128.393	6.468
面積	63.7899570		
地積	63.78 m ²		

131			
地番	桂上北三二ノ一〇		
N O	X	Y	辺長
20031	-111220.245	-27133.609	
20030	-111220.002	-27133.862	0.351
20026	-111217.503	-27136.460	3.605
20027	-111219.104	-27138.512	2.603
20028	-111221.321	-27141.353	3.604
12975	-111223.539	-27144.195	3.605
12974	-111223.688	-27144.392	0.247
12976	-111226.500	-27141.626	3.944
20031	-111220.245	-27133.609	10.168
面積	39.5966820		
地積	39.59㎡		

132			
地番	桂上東五ノ五		
N O	X	Y	辺長
20026	-111217.503	-27136.460	
20037	-111217.482	-27136.482	0.030
20027	-111219.104	-27138.512	2.598
20026	-111217.503	-27136.460	2.603
面積	0.0391570		
地積	0.03㎡		

133			
地番	桂上北三一ノ七		
N O	X	Y	辺長
12972	-111224.890	-27144.624	
12973	-111224.276	-27145.142	0.803
12971	-111225.596	-27147.147	2.401
12970	-111228.205	-27151.168	4.793
12969	-111229.070	-27150.732	0.969
12972	-111224.890	-27144.624	7.401
面積	6.3822055		
地積	6.38㎡		

134			
地番	桂上北三一ノ六		
N O	X	Y	辺長
12971	-111225.596	-27147.147	
12916	-111216.889	-27153.894	11.015
12917	-111218.520	-27156.000	2.664
12970	-111228.205	-27151.168	10.823
12971	-111225.596	-27147.147	4.793
面積	40.4456860		
地積	40.44㎡		

135			
地番	桂上北三一ノ五		
N O	X	Y	辺長
12975	-111223.539	-27144.195	
12915	-111214.688	-27151.056	11.199
12916	-111216.889	-27153.894	3.591
12971	-111225.596	-27147.147	11.015
12973	-111224.276	-27145.142	2.401
12974	-111223.688	-27144.392	0.953
12975	-111223.539	-27144.195	0.247
面積	40.0127005		
地積	40.01㎡		

136			
地番	桂上北三一ノ四		
N O	X	Y	辺長
20028	-111221.321	-27141.353	
12927	-111212.479	-27148.201	11.184
12915	-111214.688	-27151.056	3.610
12975	-111223.539	-27144.195	11.199
20028	-111221.321	-27141.353	3.605
面積	40.3716910		
地積	40.37㎡		

137			
地番	桂上北三一ノ三		
N O	X	Y	辺長
20027	-111219.104	-27138.512	
20036	-111214.875	-27141.793	5.353
12926	-111210.279	-27145.358	5.817
12927	-111212.479	-27148.201	3.595
20028	-111221.321	-27141.353	11.184
20027	-111219.104	-27138.512	3.604
面積	40.2248610		
地積	40.22㎡		

138			
地番	桂上北六ノ一三		
N O	X	Y	辺長
12969	-111229.070	-27150.732	
12970	-111228.205	-27151.168	0.969
12917	-111218.520	-27156.000	10.823
21115	-111215.947	-27157.282	2.875
21116	-111225.468	-27169.562	15.539
21118	-111228.508	-27167.204	3.847
21120	-111229.398	-27166.514	1.126
12966	-111234.096	-27162.872	5.944
13039	-111233.489	-27162.167	0.930
12967	-111231.169	-27155.608	6.957
12968	-111229.111	-27150.792	5.237
12969	-111229.070	-27150.732	0.073
面積	180.2521445		
地積	180.25㎡		

139			
地番	桂上北二九		
N O	X	Y	辺長
21115	-111215.947	-27157.282	
12912	-111214.884	-27157.811	1.187
12911	-111213.723	-27158.417	1.310
12906	-111206.921	-27164.140	8.889
12905	-111200.796	-27169.264	7.986
12904	-111201.158	-27169.895	0.727
12903	-111199.438	-27172.068	2.771
12937	-111210.057	-27190.566	21.329
12981	-111213.250	-27188.742	3.677
12982	-111214.011	-27190.028	1.494
12991	-111213.972	-27187.088	2.940
12992	-111211.189	-27182.461	5.399
20023	-111214.851	-27178.777	5.194
12993	-111215.069	-27178.557	0.310
20041	-111219.557	-27174.377	6.133
12994	-111221.050	-27172.987	2.040
21116	-111225.468	-27169.562	5.590
21115	-111215.947	-27157.282	15.539
面積	404.1196280		
地積	404.11㎡		

140			
地番	桂上北二八ノ三		
N O	X	Y	辺長
21119	-111238.650	-27177.778	
13007	-111241.374	-27175.541	3.525
13008	-111253.118	-27165.892	15.199
13036	-111249.609	-27167.116	3.716
13037	-111244.832	-27166.418	4.828
13038	-111235.878	-27164.941	9.075
12966	-111234.096	-27162.872	2.731
21120	-111229.398	-27166.514	5.944
21119	-111238.650	-27177.778	14.577
面積	148.5980110		
地積	148.59㎡		

141			
地番	桂上北二八ノ二		
N O	X	Y	辺長
21117	-111237.779	-27178.493	
21119	-111238.650	-27177.778	1.127
21120	-111229.398	-27166.514	14.577
21118	-111228.508	-27167.204	1.126
21117	-111237.779	-27178.493	14.608
面積	16.4351620		
地積	16.43㎡		



142			
地番	桂上北二八ノ一		
N O	X	Y	辺長
20022	-111228.188	-27186.343	
12996	-111229.010	-27185.695	1.047
21117	-111237.779	-27178.493	11.347
21118	-111228.508	-27167.204	14.608
21116	-111225.468	-27169.562	3.847
12994	-111221.050	-27172.987	5.590
20041	-111219.557	-27174.377	2.040
20043	-111224.267	-27180.597	7.802
20042	-111223.871	-27180.892	0.494
20022	-111228.188	-27186.343	6.953
面積	176.3948690		
地積	176.39㎡		

143			
地番	桂上北二八ノ七		
N O	X	Y	辺長
20041	-111219.557	-27174.377	
12993	-111215.069	-27178.557	6.133
20023	-111214.851	-27178.777	0.310
20021	-111223.660	-27189.915	14.200
20022	-111228.188	-27186.343	5.767
20042	-111223.871	-27180.892	6.953
20043	-111224.267	-27180.597	0.494
20041	-111219.557	-27174.377	7.802
面積	87.7530285		
地積	87.75㎡		

144			
地番	桂上南三一ノ二		
N O	X	Y	辺長
20023	-111214.851	-27178.777	
12992	-111211.189	-27182.461	5.194
12991	-111213.972	-27187.088	5.399
12982	-111214.011	-27190.028	2.940
12995	-111217.035	-27195.140	5.939
20021	-111223.660	-27189.915	8.437
20023	-111214.851	-27178.777	14.200
面積	94.1192070		
地積	94.11㎡		

145			
地番	桂上北三〇		
N O	X	Y	辺長
12903	-111199.438	-27172.068	
12901	-111196.061	-27176.355	5.457
12900	-111195.247	-27177.376	1.306
12902	-111196.016	-27178.653	1.491
12890	-111204.671	-27193.644	17.310
12891	-111204.690	-27193.633	0.022
12937	-111210.057	-27190.566	6.182
12903	-111199.438	-27172.068	21.329
面積	124.9995905		
地積	124.99㎡		

図面の種類	画 地 面 積 求 積 表				
街 区 番 号	73	番号	$\frac{2}{2}$	縮 尺	
町 名	桂 上 野 北 町				
京 都 市 洛 西 第 二 土 地 区 画 整 理 組 合					

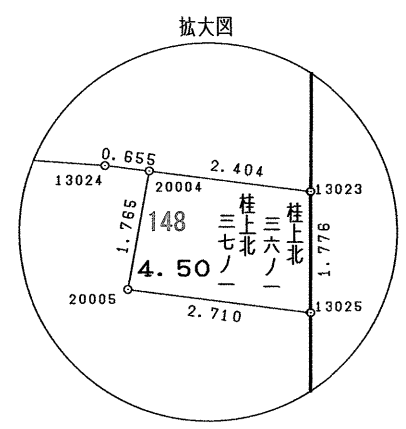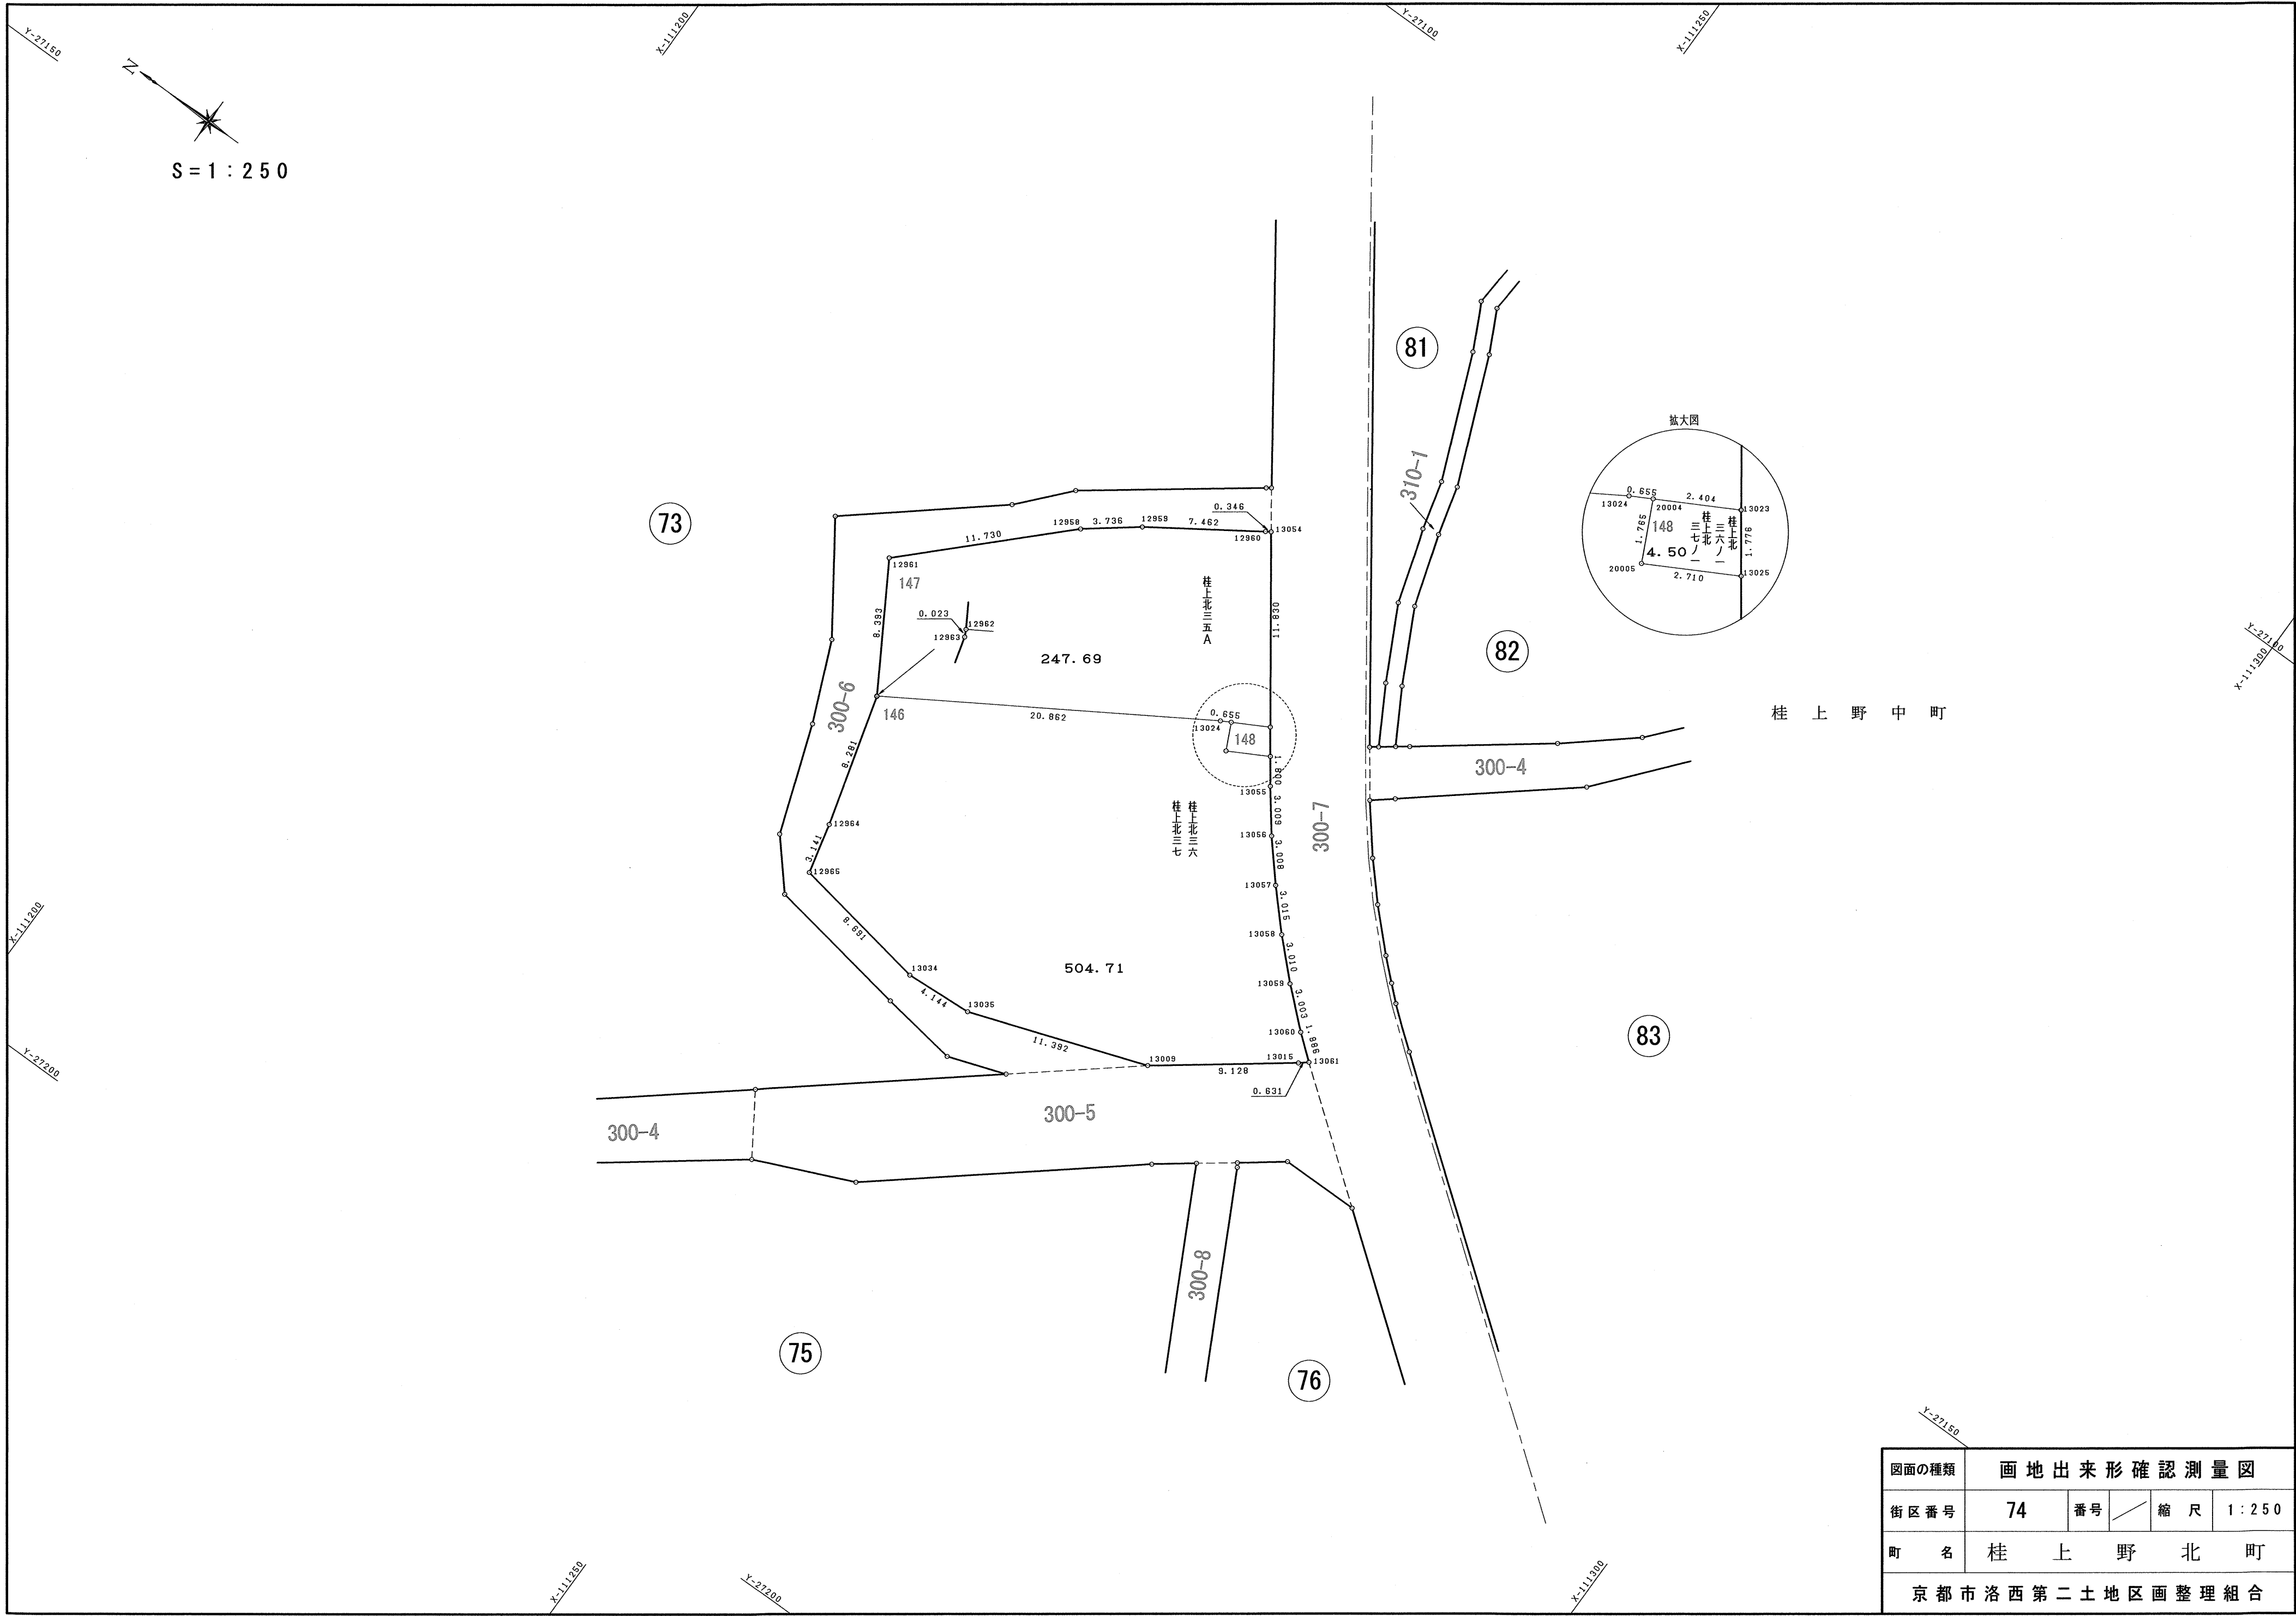

桂 上 野 中 町

Y-27150

図面の種類	画 地 出 来 形 確 認 測 量 図			
街 区 番 号	74	番 号	縮 尺	1 : 250
町 名	桂 上 野 北 町			
京 都 市 洛 西 第 二 土 地 区 画 整 理 組 合				

146

地番	桂上北三六、桂上北三七		
N O	X	Y	辺長
20004	-111251.633	-27140.639	
13024	-111251.059	-27140.954	0.655
12962	-111233.333	-27151.954	20.862
12963	-111233.345	-27151.974	0.023
12964	-111235.572	-27159.950	8.281
12965	-111236.308	-27163.004	3.141
13034	-111244.877	-27164.453	8.691
13035	-111249.013	-27164.197	4.144
13009	-111259.763	-27160.428	11.392
13015	-111267.058	-27154.942	9.128
13061	-111267.544	-27154.540	0.631
13060	-111266.076	-27153.356	1.886
13059	-111263.830	-27151.362	3.003
13058	-111261.679	-27149.257	3.010
13057	-111259.620	-27147.054	3.015
13056	-111257.664	-27144.769	3.008
13055	-111255.832	-27142.382	3.009
13025	-111254.779	-27140.922	1.800
20005	-111252.404	-27142.227	2.710
20004	-111251.633	-27140.639	1.765
面積	504.7115780		
地積	504.71㎡		

147

地番	桂上北三五A		
N O	X	Y	辺長
13054	-111246.818	-27129.888	
12960	-111246.531	-27130.081	0.346
12959	-111240.328	-27134.229	7.462
12958	-111237.374	-27136.517	3.736
12961	-111229.021	-27144.753	11.730
12962	-111233.333	-27151.954	8.393
13024	-111251.059	-27140.954	20.862
20004	-111251.633	-27140.639	0.655
13023	-111253.740	-27139.482	2.404
13054	-111246.818	-27129.888	11.830
面積	247.6999770		
地積	247.69㎡		

148

地番	桂上北三六ノ一、桂上北三七ノ一		
N O	X	Y	辺長
13023	-111253.740	-27139.482	
20004	-111251.633	-27140.639	2.404
20005	-111252.404	-27142.227	1.765
13025	-111254.779	-27140.922	2.710
13023	-111253.740	-27139.482	1.776
面積	4.5069290		
地積	4.50㎡		

図面の種類	画 地 面 積 求 積 表			
街区 番号	74	番号	縮 尺	
町 名	桂 上 野 北 町			
京 都 市 洛 西 第 二 土 地 区 画 整 理 組 合				

N
S = 1 : 250

公 9

73

74

83

桂
上
野
中
町

76

78

図面の種類	画地出来形確認測量図				
街区番号	75	番号	／	縮尺	1：250
町名	桂上野北町				
京都市洛西第二土地区画整理組合					

160

地番	桂上北二四ノ一〇		
N O	X	Y	辺長
13003	-111245.497	-27208.497	
13119	-111234.391	-27217.938	14.577
13121	-111237.319	-27221.712	4.777
13122	-111240.286	-27218.522	4.357
13123	-111244.023	-27214.678	5.361
13125	-111247.618	-27210.976	5.160
13178	-111247.047	-27210.336	0.858
13003	-111245.497	-27208.497	2.405
面積	58.4082980		
地積	58.40㎡		

161

地番	桂上北二四ノ九		
N O	X	Y	辺長
13002	-111243.224	-27205.971	
13118	-111232.343	-27215.299	14.332
13119	-111234.391	-27217.938	3.340
13003	-111245.497	-27208.497	14.577
13002	-111243.224	-27205.971	3.398
面積	48.6659260		
地積	48.66㎡		

162

地番	桂上北二四ノ八		
N O	X	Y	辺長
13001	-111240.656	-27202.905	
13117	-111229.851	-27212.086	14.179
13118	-111232.343	-27215.299	4.066
13002	-111243.224	-27205.971	14.332
13001	-111240.656	-27202.905	3.999
面積	57.4554835		
地積	57.45㎡		

163

地番	桂上北二四ノ七		
N O	X	Y	辺長
13000	-111238.592	-27200.299	
13115	-111227.799	-27209.442	14.145
13116	-111228.219	-27209.983	0.685
13117	-111229.851	-27212.086	2.662
13001	-111240.656	-27202.905	14.179
13000	-111238.592	-27200.299	3.324
面積	47.2025970		
地積	47.20㎡		

164

地番	桂上北二四ノ六		
N O	X	Y	辺長
12999	-111235.243	-27196.202	
13114	-111224.028	-27204.578	13.998
13115	-111227.799	-27209.442	6.155
13000	-111238.592	-27200.299	14.145
12999	-111235.243	-27196.202	5.292
面積	80.4872420		
地積	80.48㎡		

165

地番	桂上北二四ノ五		
N O	X	Y	辺長
12988	-111229.948	-27189.559	
12987	-111219.029	-27198.131	13.882
13114	-111224.028	-27204.578	8.158
12999	-111235.243	-27196.202	13.998
12988	-111229.948	-27189.559	8.495
面積	116.0491930		
地積	116.04㎡		

166

地番	桂上北二四ノ一三		
N O	X	Y	辺長
12989	-111231.026	-27188.712	
12988	-111229.948	-27189.559	1.371
12999	-111235.243	-27196.202	8.495
13000	-111238.592	-27200.299	5.292
13001	-111240.656	-27202.905	3.324
13002	-111243.224	-27205.971	3.999
13003	-111245.497	-27208.497	3.398
13178	-111247.047	-27210.336	2.405
13125	-111247.618	-27210.976	0.858
13124	-111247.716	-27210.875	0.141
13131	-111256.029	-27202.510	11.793
13138	-111255.617	-27202.105	0.578
13179	-111249.136	-27194.147	10.263
13004	-111240.769	-27201.103	10.881
13005	-111236.779	-27196.041	6.445
13006	-111233.620	-27192.131	5.027
12989	-111231.026	-27188.712	4.292
面積	156.9799035		
地積	156.97㎡		

167

地番	桂上北二四ノ一		
N O	X	Y	辺長
12997	-111235.023	-27185.680	
12990	-111231.048	-27188.695	4.989
12989	-111231.026	-27188.712	0.028
13006	-111233.620	-27192.131	4.292
13005	-111236.779	-27196.041	5.027
13181	-111240.702	-27192.645	5.189
12997	-111235.023	-27185.680	8.987
面積	47.0030070		
地積	47.00㎡		

168

地番	桂上北二四ノ一三		
N O	X	Y	辺長
12998	-111239.003	-27182.662	
12997	-111235.023	-27185.680	4.995
13181	-111240.702	-27192.645	8.987
13180	-111244.478	-27189.374	4.996
12998	-111239.003	-27182.662	8.662
面積	44.0565795		
地積	44.05㎡		

169

地番	桂上北二四ノ二		
N O	X	Y	辺長
13012	-111255.532	-27171.655	
13011	-111249.616	-27176.523	7.661
13010	-111243.693	-27179.105	6.461
12998	-111239.003	-27182.662	5.886
13180	-111244.478	-27189.374	8.662
20006	-111260.259	-27176.393	20.434
13012	-111255.532	-27171.655	6.693
面積	150.4751545		
地積	150.47㎡		



170

地番	桂上北二四ノ一、桂上北二四ノ三		
N O	X	Y	辺長
13264	-111262.640	-27165.805	
13012	-111255.532	-27171.655	9.206
20006	-111260.259	-27176.393	6.693
13180	-111244.478	-27189.374	20.434
13181	-111240.702	-27192.645	4.996
13005	-111236.779	-27196.041	5.189
13004	-111240.769	-27201.103	6.445
13179	-111249.136	-27194.147	10.881
13138	-111255.617	-27202.105	10.263
13131	-111256.029	-27202.510	0.578
13132	-111257.938	-27200.590	2.708
13133	-111259.633	-27198.475	2.710
13134	-111261.547	-27196.614	2.670
13135	-111264.449	-27195.150	3.250
13136	-111273.732	-27191.546	9.958
13137	-111278.016	-27191.304	4.291
13143	-111273.578	-27178.703	13.360
13263	-111267.018	-27166.144	14.169
20007	-111263.935	-27168.482	3.869
13264	-111262.640	-27165.805	2.974
面積	666.7805385		
地積	666.78㎡		

171

地番	桂上南三一ノ三		
N O	X	Y	辺長
13014	-111265.629	-27163.484	
13013	-111263.476	-27165.117	2.702
13264	-111262.640	-27165.805	1.083
20007	-111263.935	-27168.482	2.974
13263	-111267.018	-27166.144	3.869
13014	-111265.629	-27163.484	3.001
面積	11.2857930		
地積	11.28㎡		

図面の種類	画 地 面 積 求 積 表				
街区 番号	75	番号	／	縮 尺	
町 名	桂 上 野 北 町				
京 都 市 洛 西 第 二 土 地 区 画 整 理 組 合					

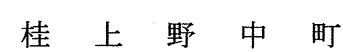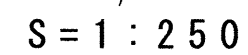

図面の種類	画地出来形確認測量図				
街区番号	76	番号	／	縮尺	1:250
町名	桂上野北町				
京都市洛西第二土地区画整理組合					

149

地番	桂上北一九		
N O	X	Y	辺長
13155	-111284.846	-27213.010	
13169	-111286.644	-27218.620	5.891
13170	-111288.103	-27220.566	2.432
13171	-111288.883	-27220.885	0.843
13173	-111297.810	-27220.579	8.932
13202	-111297.488	-27212.441	8.144
13155	-111284.846	-27213.010	12.655
面積	92.0700200		
地積	92.07㎡		

150

地番	桂上北二〇、桂上北二〇ノ一		
N O	X	Y	辺長
13153	-111282.463	-27203.912	
13154	-111284.828	-27212.953	9.345
13155	-111284.846	-27213.010	0.060
13202	-111297.488	-27212.441	12.655
13257	-111304.153	-27212.144	6.672
13258	-111303.925	-27202.053	10.094
20018	-111296.943	-27202.657	7.008
13153	-111282.463	-27203.912	14.534
面積	197.3611850		
地積	197.36㎡		

151

地番	桂上北二一		
N O	X	Y	辺長
13166	-111283.567	-27191.468	
13184	-111284.435	-27198.311	6.898
13183	-111283.364	-27198.499	1.087
13182	-111283.934	-27202.929	4.467
13151	-111282.280	-27203.207	1.677
13152	-111282.283	-27203.225	0.018
13153	-111282.463	-27203.912	0.710
20018	-111296.943	-27202.657	14.534
20019	-111296.707	-27199.932	2.735
21121	-111296.512	-27197.679	2.261
20020	-111296.451	-27196.967	0.715
13186	-111302.813	-27196.505	6.379
13187	-111299.462	-27182.108	14.782
13199	-111292.251	-27183.627	7.369
13200	-111291.379	-27183.832	0.896
13201	-111290.806	-27183.970	0.589
13167	-111284.456	-27188.854	8.011
13168	-111284.477	-27189.633	0.779
13166	-111283.567	-27191.468	2.048
面積	297.5874690		
地積	297.58㎡		

152

地番	桂上北二五B		
N O	X	Y	辺長
13149	-111280.347	-27192.059	
13150	-111282.196	-27202.623	10.725
13151	-111282.280	-27203.207	0.590
13182	-111283.934	-27202.929	1.677
13183	-111283.364	-27198.499	4.467
13184	-111284.435	-27198.311	1.087
13166	-111283.567	-27191.468	6.898
13149	-111280.347	-27192.059	3.274
面積	29.2450600		
地積	29.24㎡		

153

地番	桂上北二三		
N O	X	Y	辺長
13145	-111274.436	-27175.015	
13146	-111275.867	-27177.725	3.065
13147	-111278.211	-27185.124	7.761
13148	-111280.220	-27191.333	6.526
13149	-111280.347	-27192.059	0.737
13166	-111283.567	-27191.468	3.274
13168	-111284.477	-27189.633	2.048
13167	-111284.456	-27188.854	0.779
13201	-111290.806	-27183.970	8.011
13200	-111291.379	-27183.832	0.589
13199	-111292.251	-27183.627	0.896
13198	-111292.342	-27181.857	1.772
13197	-111292.010	-27178.410	3.463
13190	-111291.342	-27172.742	5.707
13063	-111283.804	-27166.989	9.483
13196	-111282.741	-27166.177	1.338
13145	-111274.436	-27175.015	12.128
面積	281.5666390		
地積	281.56㎡		

154

地番	桂上北三九		
N O	X	Y	辺長
13017	-111267.623	-27162.009	
13018	-111267.784	-27162.245	0.286
13144	-111274.412	-27174.970	14.348
13145	-111274.436	-27175.015	0.051
13196	-111282.741	-27166.177	12.128
13062	-111274.860	-27160.158	9.917
13016	-111270.039	-27160.177	4.821
13017	-111267.623	-27162.009	3.032
面積	117.3412840		
地積	117.34㎡		

155

地番	桂上北二二ノ三		
N O	X	Y	辺長
13190	-111291.342	-27172.742	
13197	-111292.010	-27178.410	5.707
13198	-111292.342	-27181.857	3.463
13199	-111292.251	-27183.627	1.772
13187	-111299.462	-27182.108	7.369
13188	-111299.383	-27181.767	0.350
13189	-111299.032	-27180.220	1.586
13064	-111296.902	-27176.986	3.872
13190	-111291.342	-27172.742	6.995
面積	48.5470995		
地積	48.54㎡		

156

地番	桂上北二三ノ二		
N O	X	Y	辺長
13186	-111302.813	-27196.505	
20020	-111296.451	-27196.967	6.379
21121	-111296.512	-27197.679	0.715
21122	-111302.977	-27197.209	6.482
13186	-111302.813	-27196.505	0.723
面積	4.5931830		
地積	4.59㎡		

157

地番	桂上北二二、桂上北二二ノ一		
N O	X	Y	辺長
21121	-111296.512	-27197.679	
20019	-111296.707	-27199.932	2.261
13185	-111303.475	-27199.352	6.793
21122	-111302.977	-27197.209	2.200
21121	-111296.512	-27197.679	6.482
面積	14.7249795		
地積	14.72㎡		

158

地番	桂上西一八A		
N O	X	Y	辺長
13185	-111303.475	-27199.352	
20019	-111296.707	-27199.932	6.793
20018	-111296.943	-27202.657	2.735
13258	-111303.925	-27202.053	7.008
13259	-111303.906	-27201.204	0.849
13185	-111303.475	-27199.352	1.901
面積	19.0202965		
地積	19.02㎡		

159

地番	桂上北一八		
N O	X	Y	辺長
13202	-111297.488	-27212.441	
13173	-111297.810	-27220.579	8.144
13172	-111303.772	-27220.375	5.965
13256	-111304.247	-27216.335	4.068
13257	-111304.153	-27212.144	4.192
13202	-111297.488	-27212.441	6.672
面積	52.8506935		
地積	52.85㎡		

図面の種類	画 地 面 積 求 積 表				
街区 番号	76	番号		縮 尺	
町 名	桂 上 野 北 町				
京 都 市 洛 西 第 二 土 地 区 画 整 理 組 合					

S = 1 : 250

桂上野西町 400-1

200-1

桂上野今井町

300-1

72

78

公 9

図面の種類	画地出来形確認測量図				
街区番号	77	番号	／	縮尺	1 : 250
町名	桂上野北町				
京都市洛西第二土地区画整理組合					

202

地番	桂上北三ノ二五		
N O	X	Y	辺 長
13441	-111173.130	-27281.492	
13442	-111172.592	-27284.831	3.382
13443	-111175.068	-27288.313	4.273
13444	-111175.844	-27288.445	0.787
13445	-111180.348	-27289.186	4.565
20049	-111181.374	-27282.850	6.419
13441	-111173.130	-27281.492	8.355
面積	49.0552450		
地積	49.05　㎡		

203

地番	桂上北三ノ二六		
N O	X	Y	辺 長
13440	-111173.926	-27276.554	
13441	-111173.130	-27281.492	5.002
20049	-111181.374	-27282.850	8.355
13697	-111182.173	-27277.914	5.000
13440	-111173.926	-27276.554	8.358
面積	41.7918360		
地積	41.79　㎡		

204

地番	桂上北三ノ二七		
N O	X	Y	辺 長
13439	-111174.540	-27272.744	
13440	-111173.926	-27276.554	3.859
13697	-111182.173	-27277.914	8.358
13696	-111184.942	-27278.362	2.805
13698	-111185.551	-27274.562	3.848
13439	-111174.540	-27272.744	11.160
面積	43.0506090		
地積	43.05　㎡		

205

地番	桂上北三ノ二八		
N O	X	Y	辺 長
13438	-111174.858	-27270.772	
13439	-111174.540	-27272.744	1.997
13698	-111185.551	-27274.562	11.160
13696	-111184.942	-27278.362	3.848
13695	-111185.977	-27278.531	1.049
13691	-111189.775	-27279.144	3.847
13690	-111190.709	-27273.359	5.860
13438	-111174.858	-27270.772	16.061
面積	51.1343940		
地積	51.13　㎡		

206

地番	桂上北三ノ二九		
N O	X	Y	辺 長
13437	-111175.176	-27268.797	
13438	-111174.858	-27270.772	2.000
13690	-111190.709	-27273.359	16.061
13689	-111191.027	-27271.386	1.998
13702	-111186.191	-27270.571	4.904
13437	-111175.176	-27268.797	11.157
面積	32.3119385		
地積	32.31　㎡		

207

地番	桂上北三ノ六		
N O	X	Y	辺 長
13435	-111175.798	-27264.982	
13436	-111175.256	-27268.301	3.363
13437	-111175.176	-27268.797	0.502
13702	-111186.191	-27270.571	11.157
13699	-111186.808	-27266.777	3.844
13435	-111175.798	-27264.982	11.155
面積	43.0042100		
地積	43.00　㎡		

208

地番	桂上北三ノ二三		
N O	X	Y	辺 長
13699	-111186.808	-27266.777	
13702	-111186.191	-27270.571	3.844
13689	-111191.027	-27271.386	4.904
13688	-111191.645	-27267.573	3.863
13699	-111186.808	-27266.777	4.902
面積	18.8930240		
地積	18.89　㎡		

209

地番	桂上北六ノ五一		
N O	X	Y	辺 長
16179	-111176.639	-27259.828	
13435	-111175.798	-27264.982	5.222
13699	-111186.808	-27266.777	11.155
13688	-111191.645	-27267.573	4.902
13703	-111192.150	-27264.452	3.162
16180	-111192.488	-27262.419	2.061
16179	-111176.639	-27259.828	16.059
面積	83.8073250		
地積	83.80　㎡		

210

地番	桂上北六ノ一六		
N O	X	Y	辺 長
13434	-111177.480	-27254.673	
16179	-111176.639	-27259.828	5.223
16180	-111192.488	-27262.419	16.059
13704	-111193.333	-27257.264	5.224
13434	-111177.480	-27254.673	16.063
面積	83.8961180		
地積	83.89　㎡		

211

地番	桂上北六ノ一七		
N O	X	Y	辺 長
13432	-111178.906	-27245.902	
13433	-111178.083	-27250.980	5.144
13434	-111177.480	-27254.673	3.742
13704	-111193.333	-27257.264	16.063
13705	-111194.756	-27248.480	8.899
13708	-111190.163	-27247.738	4.653
13707	-111190.024	-27247.703	0.143
13701	-111186.236	-27247.074	3.840
13432	-111178.906	-27245.902	7.423
面積	142.9216995		
地積	142.92　㎡		

212

地番	保　七七ノ一号		
N O	X	Y	辺 長
13431	-111179.677	-27241.144	
13432	-111178.906	-27245.902	4.820
13701	-111186.236	-27247.074	7.423
13706	-111187.015	-27242.335	4.803
13431	-111179.677	-27241.144	7.434
面積	35.7411615		
地積	35.74　㎡		

213

地番	保　七七ノ三号		
N O	X	Y	辺 長
13430	-111180.170	-27238.106	
13431	-111179.677	-27241.144	3.078
13706	-111187.015	-27242.335	7.434
13428	-111187.994	-27236.355	6.060
13429	-111183.618	-27235.642	4.434
13430	-111180.170	-27238.106	4.238
面積	40.5970930		
地積	40.59　㎡		

214

地番	保　七七ノ四号		
N O	X	Y	辺 長
13428	-111187.994	-27236.355	
13706	-111187.015	-27242.335	6.060
13701	-111186.236	-27247.074	4.803
13707	-111190.024	-27247.703	3.840
13427	-111191.758	-27236.969	10.873
13428	-111187.994	-27236.355	3.814
面積	41.5789335		
地積	41.57　㎡		

215

地番	保　七七ノ二号		
N O	X	Y	辺 長
13427	-111191.758	-27236.969	
13707	-111190.024	-27247.703	10.873
13708	-111190.163	-27247.738	0.143
13426	-111191.904	-27236.993	10.885
13427	-111191.758	-27236.969	0.148
面積	1.5816350		
地積	1.58　㎡		

216

地番	桂上北三八		
N O	X	Y	辺 長
13426	-111191.904	-27236.993	
13708	-111190.163	-27247.738	10.885
13705	-111194.756	-27248.480	4.653
13425	-111196.495	-27237.741	10.879
13426	-111191.904	-27236.993	4.652
面積	50.6235640		
地積	50.62　㎡		

217

地番	桂上北六ノ一五、桂上北六ノ二七		
N O	X	Y	辺 長
13425	-111196.495	-27237.741	
13705	-111194.756	-27248.480	10.879
13704	-111193.333	-27257.264	8.899
16180	-111192.488	-27262.419	5.224
13703	-111192.150	-27264.452	2.061
13700	-111196.063	-27265.083	3.964
13712	-111200.855	-27265.851	4.853
13711	-111202.249	-27266.059	1.409
13423	-111206.571	-27239.382	27.025
13424	-111203.316	-27238.853	3.298
13425	-111196.495	-27237.741	6.911
面積	276.1877810		
地積	276.18　㎡		

218

地番	桂上北九		
N O	X	Y	辺 長
13423	-111206.571	-27239.382	
13711	-111202.249	-27266.059	27.025
13710	-111205.658	-27266.628	3.456
13709	-111210.841	-27267.480	5.253
13422	-111215.169	-27240.779	27.049
13423	-111206.571	-27239.382	8.711
面積	235.5082095		
地積	235.50　㎡		

219

地番	桂上北二八ノ四		
N O	X	Y	辺 長
13422	-111215.169	-27240.779	
13709	-111210.841	-27267.480	27.049
21123	-111211.364	-27267.566	0.530
21124	-111215.693	-27240.864	27.051
13422	-111215.169	-27240.779	0.531
面積	14.3483220		
地積	14.34　㎡		

220

地番	桂上北二四ノ四		
N O	X	Y	辺 長
21123	-111211.364	-27267.566	
21125	-111215.006	-27268.161	3.690
21126	-111219.335	-27241.456	27.054
21124	-111215.693	-27240.864	3.690
21123	-111211.364	-27267.566	27.051
面積	99.8234085		
地積	99.82　㎡		

221

地番	桂上北一〇、一二、二八ノ六		
N O	X	Y	辺 長
21125	-111215.006	-27268.161	
13687	-111216.684	-27268.435	1.700
13716	-111231.131	-27270.784	14.637
13715	-111231.941	-27265.747	5.102
13714	-111232.760	-27260.715	5.098
13713	-111233.606	-27255.486	5.297
13420	-111235.252	-27245.244	10.373
13419	-111232.693	-27243.625	3.028
13421	-111225.911	-27242.524	6.871
21126	-111219.335	-27241.456	6.662
21125	-111215.006	-27268.161	27.054
面積	440.1561665		
地積	440.15　㎡		

222

地番	桂上北二ノ一四		
N O	X	Y	辺 長
13713	-111233.606	-27255.486	
13416	-111244.236	-27257.230	10.772
13417	-111243.756	-27255.477	1.818
13418	-111237.382	-27246.592	10.935
13420	-111235.252	-27245.244	2.521
13713	-111233.606	-27255.486	10.373
面積	66.0358270		
地積	66.03　㎡		

223

地番	桂上北二ノ一五		
N O	X	Y	辺 長
13714	-111232.760	-27260.715	
13415	-111245.773	-27262.837	13.185
13416	-111244.236	-27257.230	5.814
13713	-111233.606	-27255.486	10.772
13714	-111232.760	-27260.715	5.297
面積	63.3810355		
地積	63.38 m ²		

230

地番	桂上北三ノ四九		
N O	X	Y	辺 長
13712	-111200.855	-27265.851	
13453	-111196.656	-27291.755	26.242
13454	-111200.160	-27292.267	3.541
13455	-111201.465	-27292.443	1.317
13710	-111205.658	-27266.628	26.153
13711	-111202.249	-27266.059	3.456
13712	-111200.855	-27265.851	1.409
面積	127.4221120		
地積	127.42 m ²		

231

地番	桂上北三ノ四八		
N O	X	Y	辺 長
13700	-111196.063	-27265.083	
13451	-111191.859	-27291.030	26.285
13452	-111195.343	-27291.563	3.525
13453	-111196.656	-27291.755	1.327
13712	-111200.855	-27265.851	26.242
13700	-111196.063	-27265.083	4.853
面積	127.4516800		
地積	127.45 m ²		

232

地番	桂上北三ノ四五		
N O	X	Y	辺 長
13703	-111192.150	-27264.452	
13688	-111191.645	-27267.573	3.162
13689	-111191.027	-27271.386	3.863
13690	-111190.709	-27273.359	1.998
13691	-111189.775	-27279.144	5.860
13449	-111187.952	-27290.416	11.418
13450	-111190.513	-27290.824	2.593
13451	-111191.859	-27291.030	1.362
13700	-111196.063	-27265.083	26.285
13703	-111192.150	-27264.452	3.964
面積	104.1179210		
地積	104.11 m ²		

233

地番	桂上北三ノ一六		
N O	X	Y	辺 長
13695	-111185.977	-27278.531	
13447	-111184.144	-27289.804	11.421
13448	-111185.652	-27290.049	1.528
13449	-111187.952	-27290.416	2.329
13691	-111189.775	-27279.144	11.418
13695	-111185.977	-27278.531	3.847
面積	43.9939995		
地積	43.99 m ²		

234

地番	桂上北三ノ二四		
N O	X	Y	辺 長
13697	-111182.173	-27277.914	
20049	-111181.374	-27282.850	5.000
13445	-111180.348	-27289.186	6.419
13446	-111180.763	-27289.254	0.421
13447	-111184.144	-27289.804	3.425
13695	-111185.977	-27278.531	11.421
13696	-111184.942	-27278.362	1.049
13697	-111182.173	-27277.914	2.805
面積	43.9669410		
地積	43.96 m ²		

図面の種類	画 地 面 積 求 積 表				
街区 番号	77	番号	$\frac{2}{2}$	縮 尺	
町 名	桂 上 野 北 町				
京 都 市 洛 西 第 二 土 地 区 画 整 理 組 合					



図面の種類	画地出来形確認測量図				
街区番号	78	番号	／	縮尺	1：250
町名	桂上野北町				
京都市洛西第二土地区画整理組合					

172

地番	桂上北二ノ二		
N O	X	Y	辺 長
13376	-111256.875	-27280.637	
13375	-111260.042	-27292.211	11.999
13374	-111263.808	-27294.885	4.619
13373	-111265.574	-27294.765	1.770
13372	-111270.200	-27294.284	4.651
13371	-111272.064	-27294.034	1.881
13491	-111276.721	-27291.497	5.303
20221	-111273.214	-27280.860	11.200
20190	-111271.797	-27276.563	4.525
13376	-111256.875	-27280.637	15.468
面積	251.6277775		
地積	251.62　㎡		

173

地番	桂上東三四ノ一		
N O	X	Y	辺 長
13377	-111256.628	-27279.735	
13376	-111256.875	-27280.637	0.935
20190	-111271.797	-27276.563	15.468
20191	-111271.504	-27275.675	0.935
13377	-111256.628	-27279.735	15.420
面積	14.4326950		
地積	14.43　㎡		

174

地番	桂上中五九ノ三		
N O	X	Y	辺 長
13378	-111256.283	-27278.473	
13377	-111256.628	-27279.735	1.308
20191	-111271.504	-27275.675	15.420
20192	-111271.094	-27274.432	1.309
21127	-111257.248	-27278.210	14.352
13378	-111256.283	-27278.473	1.000
面積	20.1184115		
地積	20.11　㎡		

175

地番	桂上中六〇ノ一		
N O	X	Y	辺 長
13378	-111256.283	-27278.473	
21127	-111257.248	-27278.210	1.000
21128	-111256.847	-27276.744	1.520
21129	-111255.882	-27277.007	1.000
13378	-111256.283	-27278.473	1.520
面積	1.5201530		
地積	1.52　㎡		

176

地番	桂上北一一		
N O	X	Y	辺 長
13380	-111252.494	-27264.615	
13379	-111254.543	-27272.115	7.775
21129	-111255.882	-27277.007	5.072
21128	-111256.847	-27276.744	1.000
21127	-111257.248	-27278.210	1.520
20192	-111271.094	-27274.432	14.352
20189	-111267.715	-27264.184	10.791
13531	-111270.608	-27263.054	3.106
20179	-111270.962	-27259.569	3.503
13380	-111252.494	-27264.615	19.145
面積	226.7580145		
地積	226.75　㎡		

177

地番	桂上北二ノ五		
N O	X	Y	辺 長
13381	-111249.392	-27253.262	
13380	-111252.494	-27264.615	11.769
20179	-111270.962	-27259.569	19.145
13530	-111270.971	-27259.481	0.088
13528	-111272.770	-27257.035	3.036
13529	-111270.151	-27258.190	2.862
13527	-111268.697	-27254.484	3.981
13525	-111265.735	-27246.911	8.132
13524	-111265.515	-27245.922	1.013
13523	-111265.944	-27245.056	0.966
13504	-111255.897	-27248.913	10.762
20180	-111250.348	-27251.793	6.252
20181	-111250.742	-27252.552	0.855
13381	-111249.392	-27253.262	1.525
面積	258.8896170		
地積	258.88　㎡		

178

地番	桂上北三五ノ一		
N O	X	Y	辺 長
13383	-111249.023	-27252.481	
13382	-111249.273	-27252.828	0.428
13381	-111249.392	-27253.262	0.450
20181	-111250.742	-27252.552	1.525
20180	-111250.348	-27251.793	0.855
13383	-111249.023	-27252.481	1.493
面積	1.2629400		
地積	1.26　㎡		

179

地番	桂上北一五		
N O	X	Y	辺 長
13384	-111245.969	-27248.233	
13383	-111249.023	-27252.481	5.232
20180	-111250.348	-27251.793	1.493
13504	-111255.897	-27248.913	6.252
13523	-111265.944	-27245.056	10.762
13521	-111267.012	-27242.935	2.375
13520	-111267.207	-27242.086	0.871
13519	-111267.312	-27241.344	0.749
13518	-111268.728	-27240.041	1.924
13517	-111262.224	-27233.387	9.305
13388	-111248.488	-27238.377	14.614
13503	-111251.170	-27245.337	7.459
13384	-111245.969	-27248.233	5.953
面積	228.8799490		
地積	228.87　㎡		

180

地番	桂上北一四ノ一、桂上北一四ノ二		
N O	X	Y	辺 長
13386	-111237.259	-27236.480	
13385	-111239.069	-27238.635	2.814
13384	-111245.969	-27248.233	11.821
13503	-111251.170	-27245.337	5.953
13388	-111248.488	-27238.377	7.459
13517	-111262.224	-27233.387	14.614
13518	-111268.728	-27240.041	9.305
13516	-111268.159	-27232.188	7.874
13515	-111267.419	-27229.406	2.879
13176	-111278.441	-27227.321	11.217
13157	-111285.113	-27224.177	7.376
13158	-111284.862	-27223.001	1.202
13177	-111278.093	-27226.273	7.518
13514	-111267.133	-27228.356	11.156
13512	-111265.283	-27217.365	11.146
13509	-111249.736	-27222.355	16.328
13508	-111249.617	-27222.246	0.161
13506	-111242.205	-27229.124	10.112
13505	-111240.650	-27231.662	2.976
13386	-111237.259	-27236.480	5.892
面積	492.5480760		
地積	492.54　㎡		

181

地番	保　七八ノ一号		
N O	X	Y	辺 長
13387	-111236.085	-27235.082	
13386	-111237.259	-27236.480	1.826
13505	-111240.650	-27231.662	5.892
13506	-111242.205	-27229.124	2.976
13507	-111239.078	-27224.978	5.193
13110	-111237.731	-27224.762	1.364
13387	-111236.085	-27235.082	10.450
面積	37.4627910		
地積	37.46　㎡		

182

地番	桂上北一三ノ二		
N O	X	Y	辺 長
13110	-111237.731	-27224.762	
13507	-111239.078	-27224.978	1.364
13506	-111242.205	-27229.124	5.193
13508	-111249.617	-27222.246	10.112
13510	-111247.590	-27220.117	2.940
13511	-111247.942	-27219.760	0.501
13126	-111244.489	-27215.621	5.390
13120	-111241.004	-27219.209	5.002
13108	-111237.939	-27222.517	4.510
13109	-111238.062	-27222.690	0.212
13110	-111237.731	-27224.762	2.098
面積	81.7542965		
地積	81.75　㎡		

183

地番	桂上北一三ノ一、桂上北二六		
N O	X	Y	辺 長
13126	-111244.489	-27215.621	
13511	-111247.942	-27219.760	5.390
13510	-111247.590	-27220.117	0.501
13508	-111249.617	-27222.246	2.940
13509	-111249.736	-27222.355	0.161
13512	-111265.283	-27217.365	16.328
13513	-111265.180	-27216.869	0.507
13522	-111276.126	-27214.312	11.241
13159	-111282.570	-27212.291	6.753
13160	-111282.548	-27212.187	0.106
13161	-111280.630	-27204.893	7.542
13162	-111280.515	-27203.733	1.168
13532	-111269.545	-27206.559	11.328
13533	-111261.730	-27208.379	8.024
13129	-111258.523	-27201.416	7.666
13128	-111248.474	-27211.533	14.260
13127	-111244.726	-27215.377	5.369
13126	-111244.489	-27215.621	0.340
面積	396.1864885		
地積	396.18　㎡		

184

地番	桂上北二五A		
N O	X	Y	辺 長
13129	-111258.523	-27201.416	
13533	-111261.730	-27208.379	7.666
13532	-111269.545	-27206.559	8.024
13162	-111280.515	-27203.733	11.328
13163	-111280.432	-27202.901	0.836
13534	-111278.993	-27194.997	8.034
20178	-111260.198	-27199.363	19.295
13130	-111258.661	-27201.277	2.455
13129	-111258.523	-27201.416	0.196
面積	184.0894585		
地積	184.08　㎡		

185

地番	桂上北四〇		
N O	X	Y	辺 長
20178	-111260.198	-27199.363	
13534	-111278.993	-27194.997	19.295
13164	-111278.549	-27192.556	2.481
13165	-111278.414	-27192.272	0.314
13142	-111274.030	-27192.523	4.391
13141	-111264.855	-27196.069	9.836
13140	-111262.192	-27197.391	2.973
13139	-111260.379	-27199.138	2.518
20178	-111260.198	-27199.363	0.289
面積	48.4391350		
地積	48.43　㎡		

186

地番	桂上北二七		
N O	X	Y	辺 長
13513	-111265.180	-27216.869	
13512	-111265.283	-27217.365	0.507
13514	-111267.133	-27228.356	11.146
13177	-111278.093	-27226.273	11.156
13158	-111284.862	-27223.001	7.518
13159	-111282.570	-27212.291	10.953
13522	-111276.126	-27214.312	6.753
13513	-111265.180	-27216.869	11.241
面積	213.3766380		
地積	213.37　㎡		

187

地番	桂上北一六ノ三		
N O	X	Y	辺 長
13515	-111267.419	-27229.406	
13516	-111268.159	-27232.188	2.879
13518	-111268.728	-27240.041	7.874
13519	-111267.312	-27241.344	1.924
13520	-111267.207	-27242.086	0.749
20183	-111268.854	-27241.363	1.799
20182	-111290.719	-27231.690	23.909
13174	-111289.644	-27223.488	8.272
13156	-111285.363	-27225.344	4.666
13157	-111285.113	-27224.177	1.193
13176	-111278.441	-27227.321	7.376
13515	-111267.419	-27229.406	11.217
面積	223.9174285		

193			
地番	桂上北一ノ二		
N O	X	Y	辺 長
20221	-111273.214	-27280.860	
20222	-111279.459	-27278.432	6.700
20223	-111277.067	-27272.281	6.600
20224	-111305.537	-27261.060	30.601
13405	-111305.016	-27258.903	2.219
20220	-111304.022	-27251.999	6.975
20219	-111298.255	-27253.532	5.967
20218	-111289.646	-27257.306	9.400
20217	-111286.827	-27250.875	7.022
13528	-111272.770	-27257.035	15.347
13530	-111270.971	-27259.481	3.036
20179	-111270.962	-27259.569	0.088
13531	-111270.608	-27263.054	3.503
20189	-111267.715	-27264.184	3.106
20192	-111271.094	-27274.432	10.791
20191	-111271.504	-27275.675	1.309
20190	-111271.797	-27276.563	0.935
20221	-111273.214	-27280.860	4.525
面積	524.2544620		
地積	524.25㎡		

194			
地番	桂上北一ノ一		
N O	X	Y	辺 長
13491	-111276.721	-27291.497	
13492	-111277.628	-27290.993	1.038
13535	-111282.624	-27288.907	5.414
13494	-111291.828	-27284.445	10.229
13495	-111295.262	-27282.731	3.838
13499	-111296.508	-27280.444	2.604
13498	-111295.791	-27276.184	4.320
13500	-111296.353	-27274.703	1.584
13501	-111297.312	-27273.702	1.386
20216	-111295.398	-27270.905	3.389
13404	-111306.139	-27263.553	13.016
20224	-111305.537	-27261.060	2.565
20223	-111277.067	-27272.281	30.601
20222	-111279.459	-27278.432	6.600
20221	-111273.214	-27280.860	6.700
13491	-111276.721	-27291.497	11.200
面積	409.2144620		
地積	409.21㎡		

195			
地番	桂上北二ノ四		
N O	X	Y	辺 長
13401	-111307.443	-27266.604	
13402	-111306.866	-27265.735	1.043
13403	-111306.541	-27265.216	0.612
13404	-111306.139	-27263.553	1.711
20216	-111295.398	-27270.905	13.016
13501	-111297.312	-27273.702	3.389
13502	-111297.804	-27273.202	0.701
13401	-111307.443	-27266.604	11.681
面積	40.8737030		
地積	40.87㎡		

196			
地番	桂上西一九		
N O	X	Y	辺 長
13499	-111296.508	-27280.444	
13497	-111297.896	-27282.268	2.292
13496	-111298.998	-27284.529	2.515
13399	-111314.386	-27277.399	16.960
13400	-111312.254	-27273.849	4.141
13401	-111307.443	-27266.604	8.697
13502	-111297.804	-27273.202	11.681
13501	-111297.312	-27273.702	0.701
13500	-111296.353	-27274.703	1.386
13498	-111295.791	-27276.184	1.584
13499	-111296.508	-27280.444	4.320
面積	184.2695400		
地積	184.26㎡		

197			
地番	桂上西二〇ノ一		
N O	X	Y	辺 長
13496	-111298.998	-27284.529	
13493	-111301.239	-27289.824	5.750
13397	-111317.503	-27282.289	17.925
13398	-111315.846	-27279.831	2.964
13399	-111314.386	-27277.399	2.837
13496	-111298.998	-27284.529	16.960
面積	100.0171005		
地積	100.01㎡		


198			
地番	桂上西二〇ノ二		
N O	X	Y	辺 長
13493	-111301.239	-27289.824	
13368	-111302.859	-27293.589	4.099
20187	-111313.986	-27288.456	12.254
13396	-111313.767	-27287.978	0.526
13395	-111319.537	-27285.305	6.359
13397	-111317.503	-27282.289	3.638
13493	-111301.239	-27289.824	17.925
面積	71.9078055		
地積	71.90㎡		

199			
地番	保 七八ノ三号		
N O	X	Y	辺 長
13391	-111315.076	-27290.827	
13392	-111317.228	-27290.151	2.256
13393	-111319.831	-27289.265	2.750
13394	-111320.642	-27286.944	2.459
13395	-111319.537	-27285.305	1.977
13396	-111313.767	-27287.978	6.359
20187	-111313.986	-27288.456	0.526
13391	-111315.076	-27290.827	2.610
面積	21.6347320		
地積	21.63㎡		

200			
地番	保 七八ノ二号		
N O	X	Y	辺 長
13367	-111303.142	-27294.255	
13369	-111303.558	-27294.151	0.429
13389	-111308.141	-27292.903	4.750
13390	-111312.699	-27291.574	4.748
13391	-111315.076	-27290.827	2.492
20187	-111313.986	-27288.456	2.610
13368	-111302.859	-27293.589	12.254
13367	-111303.142	-27294.255	0.724
面積	21.0926940		
地積	21.09㎡		

201			
地番	桂上西一八B		
N O	X	Y	辺 長
13371	-111272.064	-27294.034	
13370	-111274.823	-27293.665	2.784
13363	-111284.989	-27298.158	11.115
13364	-111289.662	-27297.306	4.750
13365	-111294.319	-27296.356	4.753
13366	-111298.951	-27295.300	4.751
13367	-111303.142	-27294.255	4.319
13368	-111302.859	-27293.589	0.724
13493	-111301.239	-27289.824	4.099
13496	-111298.998	-27284.529	5.750
13497	-111297.896	-27282.268	2.515
13499	-111296.508	-27280.444	2.292
13495	-111295.262	-27282.731	2.604
13494	-111291.828	-27284.445	3.838
13535	-111282.624	-27288.907	10.229
13492	-111277.628	-27290.993	5.414
13491	-111276.721	-27291.497	1.038
13371	-111272.064	-27294.034	5.303
面積	256.7407440		
地積	256.74㎡		

図面の種類	画 地 面 積 求 積 表			
街区 番号	78	番号	$\frac{2}{2}$	縮 尺
町 名	桂 上 野 北 町			
京都市洛西第二土地区画整理組合				

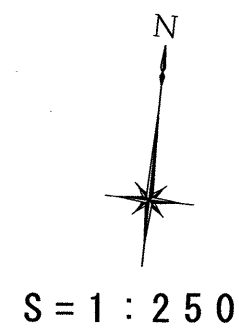

桂上野北町

78


76

84

80

87

図面の種類	画地出来形確認測量図				
街区番号	79	番号	／	縮尺	1：250
町名	桂上野中町				
京都市洛西第二土地区画整理組合					

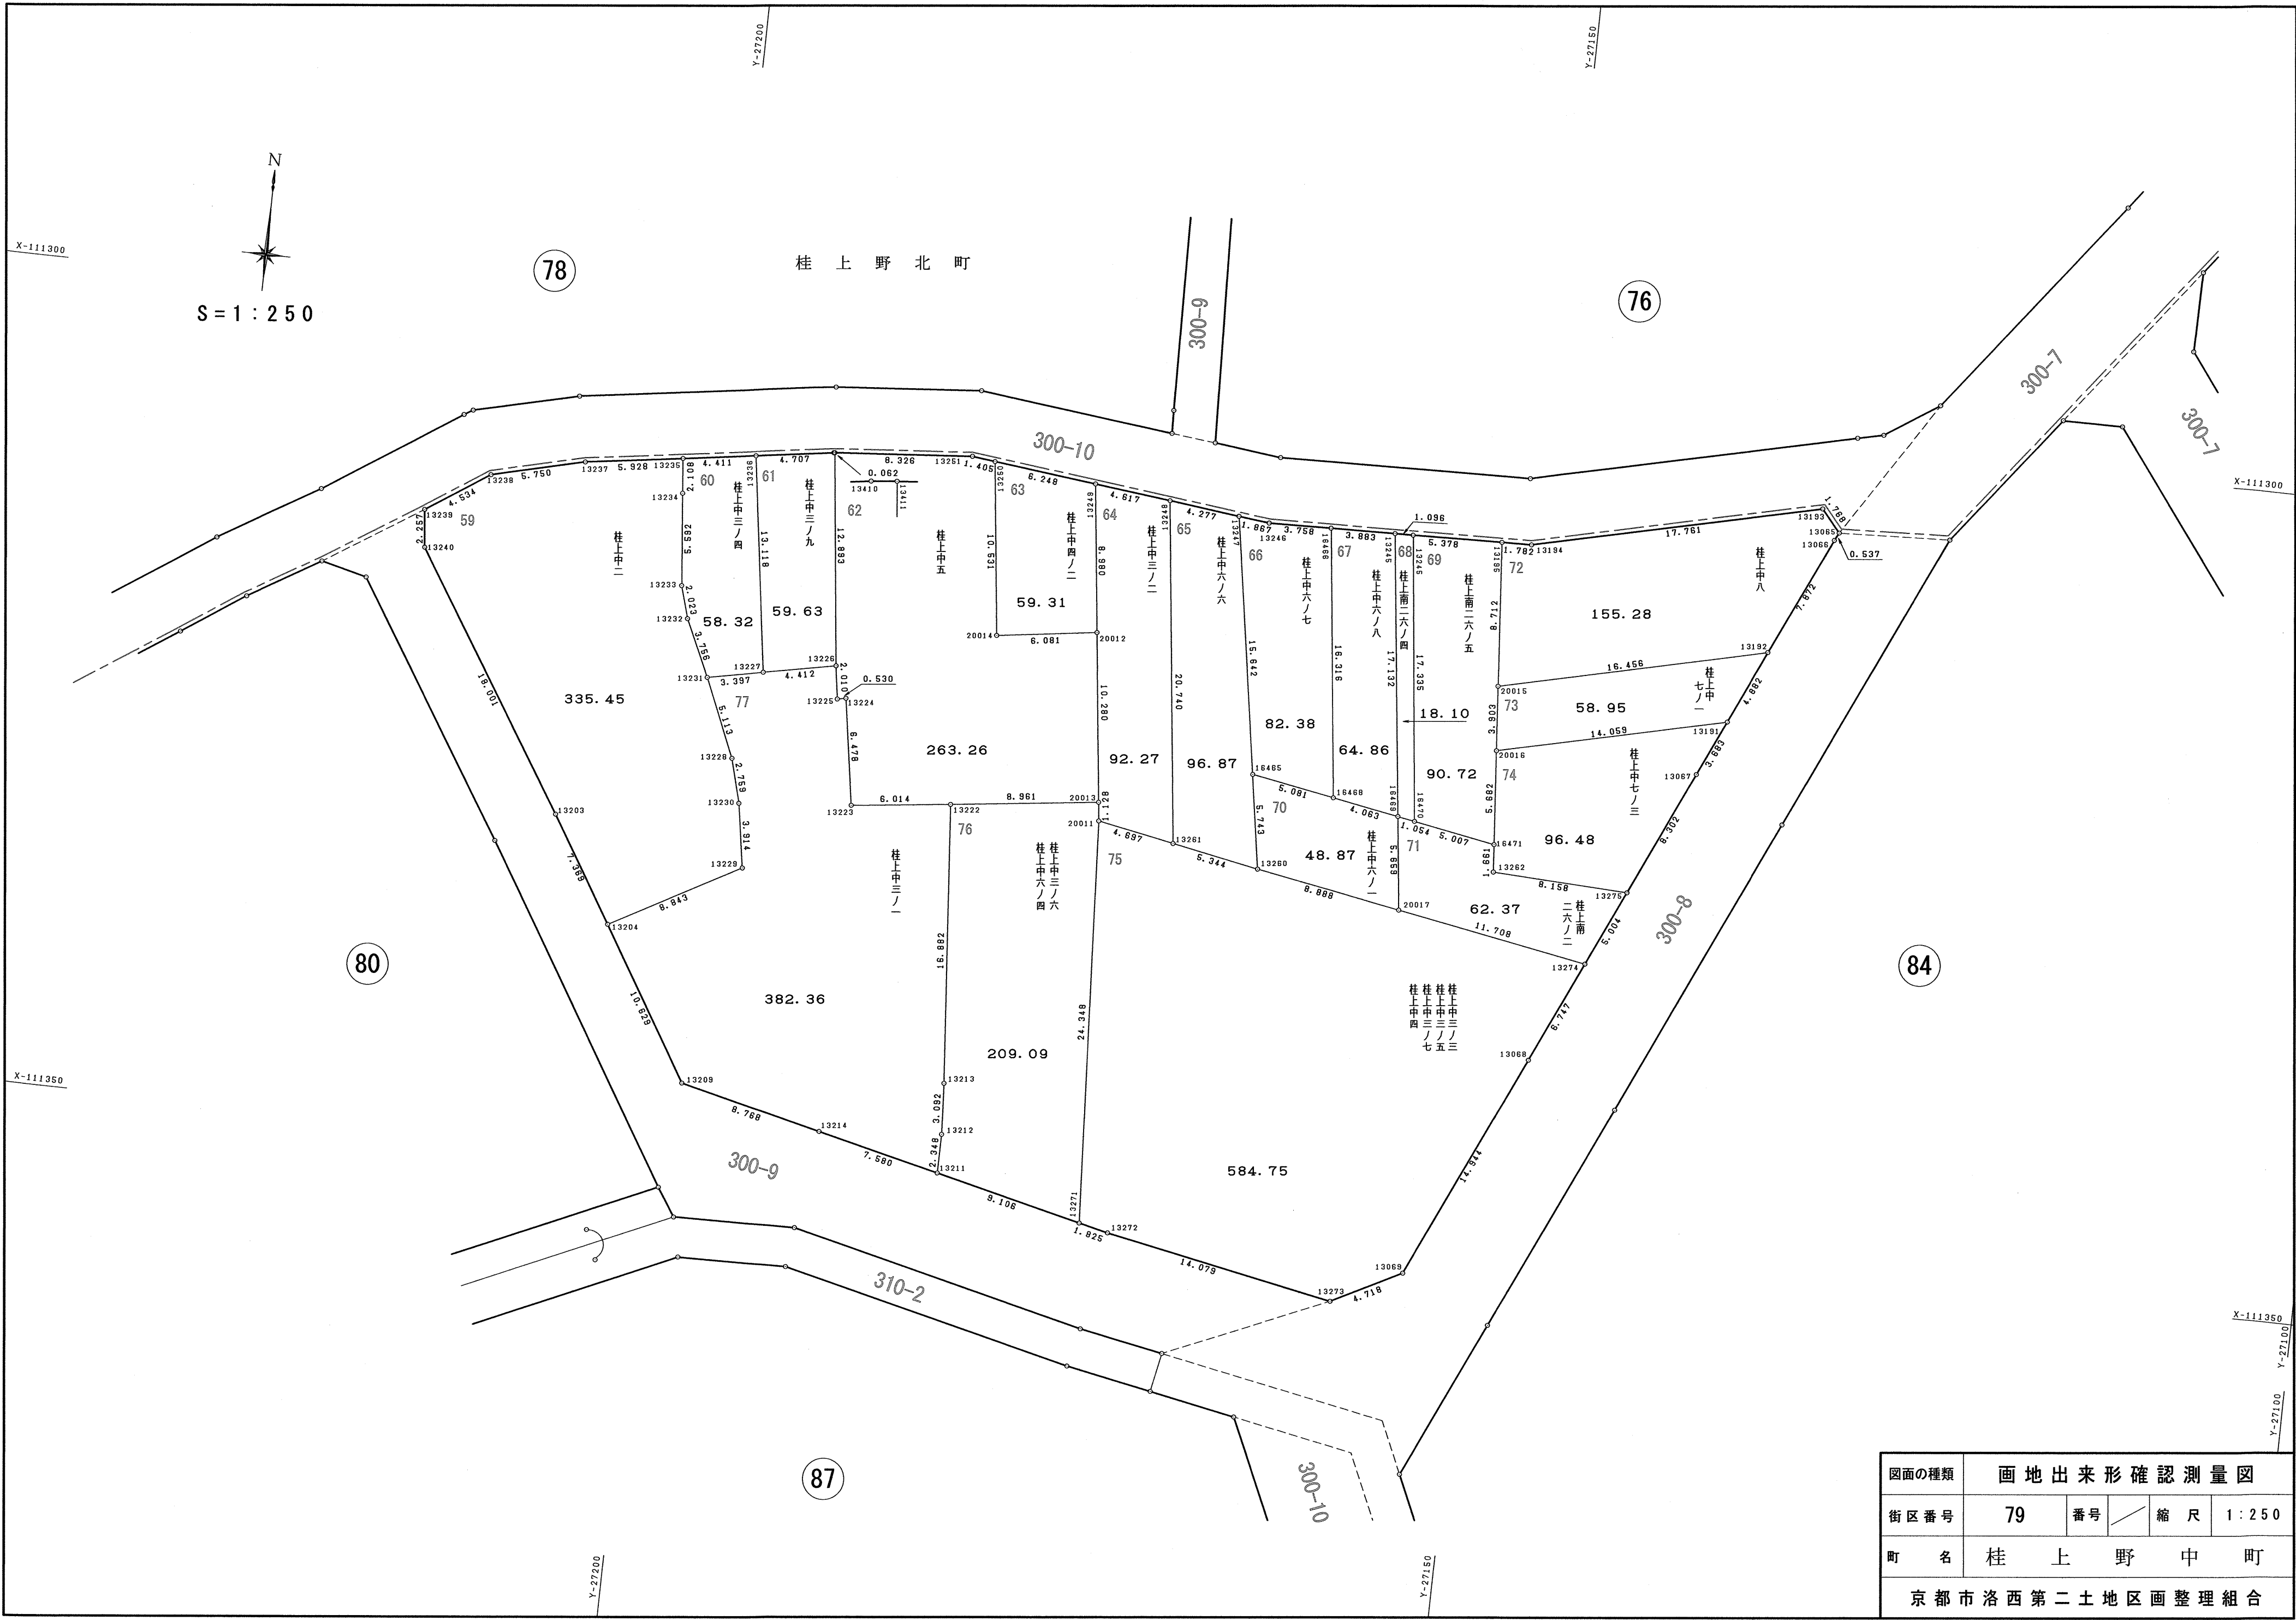

地番	桂上中二		
N O	X	Y	辺長
13235	-111308.093	-27252.281	
13237	-111308.933	-27258.149	5.928
13238	-111310.308	-27263.732	5.750
13239	-111312.838	-27267.494	4.534
13240	-111315.080	-27267.230	2.257
13203	-111330.329	-27257.664	18.001
13204	-111336.622	-27253.830	7.369
13229	-111332.352	-27246.086	8.843
13230	-111328.486	-27246.699	3.914
13228	-111325.821	-27247.413	2.759
13231	-111321.116	-27249.415	5.113
13232	-111317.701	-27250.978	3.756
13233	-111315.757	-27251.538	2.023
13234	-111310.192	-27252.089	5.592
13235	-111308.093	-27252.281	2.108
面積	335.4592385		
地積	335.45㎡		

地番	桂上中三ノ四		
N O	X	Y	辺長
13236	-111307.467	-27247.915	
13235	-111308.093	-27252.281	4.411
13234	-111310.192	-27252.089	2.108
13233	-111315.757	-27251.538	5.592
13232	-111317.701	-27250.978	2.023
13231	-111321.116	-27249.415	3.756
13227	-111320.456	-27246.083	3.397
13236	-111307.467	-27247.915	13.118
面積	58.3220390		
地積	58.32㎡		

地番	桂上中三ノ九		
N O	X	Y	辺長
13411	-111306.795	-27243.194	
13410	-111306.800	-27243.256	0.062
13236	-111307.467	-27247.915	4.707
13227	-111320.456	-27246.083	13.118
13226	-111319.607	-27241.753	4.412
13411	-111306.795	-27243.194	12.893
面積	59.6348005		
地積	59.63㎡		

地番	桂上中五		
N O	X	Y	辺長
13250	-111306.293	-27233.499	
13251	-111306.131	-27234.895	1.405
13411	-111306.795	-27243.194	8.326
13226	-111319.607	-27241.753	12.893
13225	-111321.595	-27241.458	2.010
13224	-111321.507	-27240.935	0.530
13223	-111327.908	-27239.936	6.478
13222	-111327.220	-27239.961	6.014
20013	-111326.147	-27225.064	8.961
20012	-111315.936	-27226.254	10.280
20014	-111316.753	-27232.280	6.081
13250	-111306.293	-27233.499	10.531
面積	263.2656330		
地積	263.26㎡		

地番	桂上中四ノ二		
N O	X	Y	辺長
20012	-111315.936	-27226.254	
13249	-111307.016	-27227.293	8.980
13250	-111306.293	-27233.499	6.248
20014	-111316.753	-27232.280	10.531
20012	-111315.936	-27226.254	6.081
面積	59.3171030		
地積	59.31㎡		

地番	桂上中三ノ二		
N O	X	Y	辺長
13248	-111307.550	-27222.707	
13249	-111307.016	-27227.293	4.617
20012	-111315.936	-27226.254	8.980
20013	-111326.147	-27225.064	10.280
20011	-111327.267	-27224.933	1.128
13261	-111328.152	-27220.320	4.697
13248	-111307.550	-27222.707	20.740
面積	92.2753145		
地積	92.27㎡		

地番	桂上中六ノ六		
N O	X	Y	辺長
13247	-111308.044	-27218.459	
13248	-111307.550	-27222.707	4.277
13261	-111328.152	-27220.320	20.740
13260	-111329.159	-27215.072	5.344
16465	-111323.488	-27215.981	5.743
13247	-111308.044	-27218.459	15.642
面積	96.8765355		
地積	96.87㎡		

地番	桂上中六ノ七		
N O	X	Y	辺長
13247	-111308.044	-27218.459	
16465	-111323.488	-27215.981	15.642
16468	-111324.381	-27210.979	5.081
16466	-111308.172	-27212.848	16.316
13246	-111308.260	-27216.605	3.758
13247	-111308.044	-27218.459	1.867
面積	82.3864185		
地積	82.38㎡		

地番	桂上中六ノ八		
N O	X	Y	辺長
16466	-111308.172	-27212.848	
16468	-111324.381	-27210.979	16.316
16469	-111325.098	-27206.980	4.063
13245	-111308.081	-27208.966	17.132
16466	-111308.172	-27212.848	3.883
面積	64.8602190		
地積	64.86㎡		

地番	桂上南二六ノ四		
N O	X	Y	辺長
13245	-111308.081	-27208.966	
16469	-111325.098	-27206.980	17.132
16470	-111325.284	-27205.943	1.054
16467	-111308.056	-27207.870	17.335
13245	-111308.081	-27208.966	1.096
面積	18.1036480		
地積	18.10㎡		

地番	桂上南二六ノ五		
N O	X	Y	辺長
16467	-111308.056	-27207.870	
16470	-111325.284	-27205.943	17.335
16471	-111326.167	-27201.014	5.007
20016	-111320.504	-27201.474	5.682
20015	-111316.614	-27201.789	3.903
13195	-111307.930	-27202.493	8.712
16467	-111308.056	-27207.870	5.378
面積	90.7258155		
地積	90.72㎡		

地番	桂上中六ノ一		
N O	X	Y	辺長
16465	-111323.488	-27215.981	
13260	-111329.159	-27215.072	5.743
20017	-111330.719	-27206.322	8.888
16469	-111325.098	-27206.980	5.659
16468	-111324.381	-27210.979	4.063
16465	-111323.488	-27215.981	5.081
面積	48.8768890		
地積	48.87㎡		

地番	桂上南二六ノ二		
N O	X	Y	辺長
16469	-111325.098	-27206.980	
20017	-111330.719	-27206.322	5.659
13274	-111332.775	-27194.796	11.708
13275	-111328.217	-27192.732	5.004
13262	-111327.823	-27200.880	8.158
16471	-111326.167	-27201.014	1.661
16470	-111325.284	-27205.943	5.007
16469	-111325.098	-27206.980	1.054
面積	62.3751125		
地積	62.37㎡		

地番	桂上中八		
N O	X	Y	辺長
13193	-111303.861	-27183.413	
13194	-111307.888	-27200.711	17.761
13195	-111307.930	-27202.493	1.782
20015	-111316.614	-27201.789	8.712
13192	-111312.854	-27185.768	16.456
13066	-111305.686	-27182.515	7.872
13065	-111305.209	-27182.269	0.537
13193	-111303.861	-27183.413	1.768
面積	155.2893180		
地積	155.28㎡		

地番	桂上中七ノ一		
N O	X	Y	辺長
13192	-111312.854	-27185.768	
20015	-111316.614	-27201.789	16.456
20016	-111320.504	-27201.474	3.903
13191	-111317.300	-27187.785	14.059
13192	-111312.854	-27185.768	4.882
面積	58.9524580		
地積	58.95㎡		

地番	桂上中七ノ三		
N O	X	Y	辺長
13191	-111317.300	-27187.785	
20016	-111320.504	-27201.474	14.059
16471	-111326.167	-27201.014	5.682
13262	-111327.823	-27200.880	1.661
13275	-111328.217	-27192.732	8.158
13067	-111320.654	-27189.307	8.302
13191	-111317.300	-27187.785	3.683
面積	96.4837235		
地積	96.48㎡		

地番	桂上中三ノ三、三ノ五、三ノ七、四		
N O	X	Y	辺長
13274	-111332.775	-27194.796	
20017	-111330.719	-27206.322	11.708
13260	-111329.159	-27215.072	8.888
13261	-111328.152	-27220.320	5.344
20011	-111327.267	-27224.933	4.697
13271	-111351.575	-27223.534	24.348
13272	-111351.995	-27221.758	1.825
13273	-111354.705	-27207.942	14.079
13069	-111352.528	-27203.756	4.718
13068	-111338.921	-27197.580	14.944
13274	-111332.775	-27194.796	6.747
面積	584.7527735		
地積	584.75㎡		

地番	桂上中三ノ六、桂上北六ノ四		
N O	X	Y	辺長
20013	-111326.147	-27225.064	
13222	-111327.220	-27233.961	8.961
13213	-111344.044	-27232.564	16.882
13212	-111347.130	-27232.377	3.092
13211	-111349.478	-27232.395	2.348
13271	-111351.575	-27223.534	9.106
20011	-111327.267	-27224.933	24.348
20013	-111326.147	-27225.064	1.128
面積	209.0968220		
地積	209.09㎡		

地番	桂上中三ノ一		
N O	X	Y	辺 長
3222	-111327. 220	-27233. 961	
3223	-111327. 908	-27239. 936	6. 014
3224	-111321. 507	-27240. 935	6. 478
3225	-111321. 595	-27241. 458	0. 530
3226	-111319. 607	-27241. 753	2. 010
3227	-111320. 456	-27246. 083	4. 412
3231	-111321. 116	-27249. 415	3. 397
3228	-111325. 821	-27247. 413	5. 113
3230	-111328. 486	-27246. 699	2. 759
3229	-111332. 352	-27246. 086	3. 914
3204	-111336. 622	-27253. 830	8. 843
3209	-111345. 699	-27248. 300	10. 629
3214	-111347. 732	-27239. 771	8. 768
3211	-111349. 478	-27232. 395	7. 580
3212	-111347. 130	-27232. 377	2. 348
3213	-111344. 044	-27232. 564	3. 092
3222	-111327. 220	-27233. 961	16. 882
面積	382. 3608910		
地積	382. 36 m ²		



図面の種類	画地出来形確認測量図				
街区番号	80	番号		縮尺	1 : 250
町名	桂上野中町				
京都市洛西第二土地区画整理組合					

51-1

地番	桂上中一ノ一		
N O	X	Y	辺長
13242	-111316.603	-27273.338	
13243	-111319.189	-27277.662	5.038
21244	-111321.634	-27281.248	4.340
20152	-111332.076	-27274.943	12.198
16063	-111336.203	-27272.287	4.908
13205	-111330.227	-27262.446	11.513
13241	-111317.276	-27270.576	15.291
13242	-111316.603	-27273.338	2.843
面積	196.3995650		
地積	196.39㎡		

51-2

地番	桂上中一ノ七		
N O	X	Y	辺長
21244	-111321.634	-27281.248	
13244	-111321.747	-27281.413	0.200
14170	-111324.270	-27285.179	4.533
14171	-111324.654	-27285.032	0.411
14177	-111325.504	-27284.733	0.901
14178	-111329.996	-27283.083	4.785
14179	-111334.480	-27281.365	4.802
14180	-111335.685	-27280.884	1.297
20152	-111332.076	-27274.943	6.951
21244	-111321.634	-27281.248	12.198
面積	70.8759335		
地積	70.87㎡		

52

地番	桂上中一ノ六		
N O	X	Y	辺長
14180	-111335.685	-27280.884	
14181	-111338.964	-27279.575	3.531
14182	-111340.295	-27279.021	1.442
16063	-111336.203	-27272.287	7.880
20152	-111332.076	-27274.943	4.908
14180	-111335.685	-27280.884	6.951
面積	36.4227170		
地積	36.42㎡		

53

地番	桂上中一ノ四		
N O	X	Y	辺長
13205	-111330.227	-27262.446	
16063	-111336.203	-27272.287	11.513
14182	-111340.295	-27279.021	7.880
14183	-111341.759	-27278.412	1.586
20090	-111336.634	-27270.260	9.629
13206	-111331.300	-27261.772	10.025
13205	-111330.227	-27262.446	1.267
面積	27.6550270		
地積	27.65㎡		

54

地番	桂上西二四		
N O	X	Y	辺長
20090	-111336.634	-27270.260	
14192	-111343.904	-27265.840	8.508
14193	-111342.865	-27264.142	1.991
13208	-111338.682	-27257.258	8.055
13207	-111332.294	-27261.148	7.479
13206	-111331.300	-27261.772	1.174
20090	-111336.634	-27270.260	10.025
面積	86.1390910		
地積	86.13㎡		

55

地番	桂上東三三		
N O	X	Y	辺長
13208	-111338.682	-27257.258	
14193	-111342.865	-27264.142	8.055
14199	-111351.442	-27260.297	9.399
13215	-111347.654	-27251.794	9.309
13208	-111338.682	-27257.258	10.505
面積	86.0571255		
地積	86.05㎡		

56

地番	桂上中一ノ三		
N O	X	Y	辺長
13215	-111347.654	-27251.794	
14199	-111351.442	-27260.297	9.309
14198	-111356.169	-27258.175	5.181
13216	-111352.096	-27249.089	9.957
13215	-111347.654	-27251.794	5.201
面積	49.8046470		
地積	49.80㎡		

57

地番	上北ノ口四〇ノ二A		
N O	X	Y	辺長
14193	-111342.865	-27264.142	
14192	-111343.904	-27265.840	1.991
14191	-111349.523	-27275.097	10.829
14194	-111352.423	-27273.849	3.157
14195	-111356.915	-27271.896	4.898
14196	-111361.428	-27269.904	4.933
14198	-111356.169	-27258.175	12.854
14199	-111351.442	-27260.297	5.181
14193	-111342.865	-27264.142	9.399
面積	176.3258665		
地積	176.32㎡		

58

地番	桂上西二四ノ一七		
N O	X	Y	辺長
14183	-111341.759	-27278.412	
14184	-111343.433	-27277.716	1.813
14185	-111347.917	-27275.788	4.881
14191	-111349.523	-27275.097	1.748
14192	-111343.904	-27265.840	10.829
20090	-111336.634	-27270.260	8.508
14183	-111341.759	-27278.412	9.629
面積	86.2817575		
地積	86.28㎡		

図面の種類	画 地 面 積 求 積 表				
街区 番 号	80	番号	／	縮 尺	
町 名	桂 上 野 中 町				
京 都 市 洛 西 第 二 土 地 区 画 整 理 組 合					

S = 1 : 250

桂
上
野
北
町

桂
上
野
東
町



図面の種類	画地出来形確認測量図				
街区番号	81	番号		縮尺	1 : 250
町名	桂上野中町				
京都市洛西第二土地区画整理組合					

130			
地番	桂上北三五B		
N O	X	Y	辺長
16088	-111251.820	-27126.584	
13102	-111259.306	-27136.925	12.766
13033	-111259.739	-27136.598	0.543
13967	-111257.812	-27133.210	3.898
13968	-111255.564	-27128.837	4.917
13969	-111254.386	-27125.085	3.933
16088	-111251.820	-27126.584	2.972
面積	18.5796955		
地積	18.57㎡		

131			
地番	桂上中二七、桂上中二七ノ一		
N O	X	Y	辺長
14044	-111249.138	-27111.611	
12951	-111243.868	-27115.294	6.429
16088	-111251.820	-27126.584	13.809
13969	-111254.386	-27125.085	2.972
13970	-111254.152	-27124.338	0.783
13999	-111253.378	-27121.369	3.068
14043	-111250.290	-27113.903	8.079
14044	-111249.138	-27111.611	2.565
面積	69.2764480		
地積	69.27㎡		

132			
地番	桂上中二八ノ六		
N O	X	Y	辺長
12948	-111239.997	-27100.511	
12947	-111238.114	-27101.908	2.345
12950	-111237.432	-27106.152	4.298
13103	-111238.469	-27107.628	1.804
12951	-111243.868	-27115.294	9.376
14044	-111249.138	-27111.611	6.429
14008	-111248.894	-27111.125	0.544
14009	-111249.140	-27107.093	4.039
14014	-111249.447	-27106.606	0.576
14012	-111245.368	-27109.147	4.806
12948	-111239.997	-27100.511	10.170
面積	78.3966115		
地積	78.39㎡		

133			
地番	桂上中二八ノ一		
N O	X	Y	辺長
12939	-111230.499	-27096.281	
12950	-111237.432	-27106.152	12.062
12947	-111238.114	-27101.908	4.298
12948	-111239.997	-27100.511	2.345
12949	-111243.866	-27097.634	4.821
13981	-111247.723	-27094.753	4.814
13982	-111250.257	-27092.867	3.159
13983	-111251.500	-27091.934	1.554
13984	-111255.365	-27089.063	4.815
13985	-111261.807	-27084.269	8.030
13987	-111258.634	-27079.144	6.028
13990	-111257.423	-27080.038	1.505
13986	-111254.377	-27082.315	3.803
12946	-111251.390	-27084.531	3.719
12945	-111248.417	-27086.762	3.717
12944	-111246.665	-27088.047	2.173
12943	-111245.428	-27088.972	1.545
12942	-111242.449	-27091.187	3.712
12941	-111239.391	-27093.471	3.817
12940	-111234.698	-27096.967	5.852
12939	-111230.499	-27096.281	4.255
面積	205.6278300		
地積	205.62㎡		

134			
地番	桂上中二八ノ七		
N O	X	Y	辺長
13979	-111236.048	-27088.077	
12938	-111228.642	-27093.637	9.261
12939	-111230.499	-27096.281	3.231
12940	-111234.698	-27096.967	4.255
12941	-111239.391	-27093.471	5.852
13979	-111236.048	-27088.077	6.346
面積	52.5813820		
地積	52.58㎡		

135			
地番	桂上中二八ノ一四		
N O	X	Y	辺長
13980	-111233.068	-27083.243	
12936	-111225.365	-27088.968	9.597
13104	-111226.980	-27091.270	2.812
12938	-111228.642	-27093.637	2.892
13979	-111236.048	-27088.077	9.261
13980	-111233.068	-27083.243	5.679
面積	53.5493775		
地積	53.54㎡		

136			
地番	桂上中二八ノ一五		
N O	X	Y	辺長
13996	-111236.123	-27080.966	
13980	-111233.068	-27083.243	3.810
13979	-111236.048	-27088.077	5.679
12941	-111239.391	-27093.471	6.346
12942	-111242.449	-27091.187	3.817
13996	-111236.123	-27080.966	12.020
面積	45.7171775		
地積	45.71㎡		

137			
地番	桂上中二八ノ一六		
N O	X	Y	辺長
13995	-111239.102	-27078.748	
13996	-111236.123	-27080.966	3.714
12942	-111242.449	-27091.187	12.020
12943	-111245.428	-27088.972	3.712
13995	-111239.102	-27078.748	12.023
面積	44.4744065		
地積	44.47㎡		

138			
地番	桂上中二八ノ一七		
N O	X	Y	辺長
13994	-111242.079	-27076.525	
13995	-111239.102	-27078.748	3.715
12943	-111245.428	-27088.972	12.023
12944	-111246.665	-27088.047	1.545
12945	-111248.417	-27086.762	2.173
13994	-111242.079	-27076.525	12.040
面積	44.5369320		
地積	44.53㎡		

139			
地番	桂上中二八ノ一八		
N O	X	Y	辺長
13993	-111245.059	-27074.303	
13994	-111242.079	-27076.525	3.717
12945	-111248.417	-27086.762	12.040
12946	-111251.390	-27084.531	3.717
13993	-111245.059	-27074.303	12.029
面積	44.5608005		
地積	44.56㎡		

140			
地番	桂上中二八ノ一九		
N O	X	Y	辺長
13992	-111248.040	-27072.087	
13993	-111245.059	-27074.303	3.714
12946	-111251.390	-27084.531	12.029
13986	-111254.377	-27082.315	3.719
13992	-111248.040	-27072.087	12.032
面積	44.5564960		
地積	44.55㎡		

141			
地番	桂上中二八ノ二〇		
N O	X	Y	辺長
13989	-111250.997	-27069.675	
13991	-111249.083	-27071.310	2.517
13992	-111248.040	-27072.087	1.301
13986	-111254.377	-27082.315	12.032
13990	-111257.423	-27080.038	3.803
13989	-111250.997	-27069.675	12.194
面積	45.7543065		
地積	45.75㎡		

142			
地番	桂上中二八ノ八		
N O	X	Y	辺長
13988	-111252.159	-27068.690	
13989	-111250.997	-27069.675	1.523
13990	-111257.423	-27080.038	12.194
13987	-111258.634	-27079.144	1.505
13988	-111252.159	-27068.690	12.297
面積	18.4099300		
地積	18.40㎡		

143			
地番	桂上中二八ノ四		
N O	X	Y	辺長
13998	-111220.389	-27081.876	
12936	-111225.365	-27088.968	8.664
13980	-111233.068	-27083.243	9.597
13996	-111236.123	-27080.966	3.810
13995	-111239.102	-27078.748	3.714
13994	-111242.079	-27076.525	3.715
13993	-111245.059	-27074.303	3.717
13992	-111248.040	-27072.087	3.714
13991	-111249.083	-27071.310	1.301
20055	-111247.315	-27068.448	3.364
20056	-111245.122	-27065.210	3.911
13998	-111220.389	-27081.876	29.824
面積	236.8461120		
地積	236.84㎡		


144			
地番	桂上中二八ノ三		
N O	X	Y	辺長
13105	-111215.446	-27074.831	
13998	-111220.389	-27081.876	8.606
20056	-111245.122	-27065.210	29.824
20054	-111244.473	-27064.248	1.160
14040	-111240.422	-27060.154	5.759
12249	-111234.353	-27060.160	6.069
12250	-111233.712	-27060.648	0.806
16087	-111216.319	-27073.670	21.728
13105	-111215.446	-27074.831	1.453
面積	275.5260270		
地積	275.52㎡		

145			
地番	桂上中二八ノ五		
N O	X	Y	辺長
14040	-111240.422	-27060.154	
20054	-111244.473	-27064.248	5.759
20056	-111245.122	-27065.210	1.160
20055	-111247.315	-27068.448	3.911
13991	-111249.083	-27071.310	3.364
13989	-111250.997	-27069.675	2.517
13988	-111252.159	-27068.690	1.523
13997	-111246.842	-27060.148	10.062
14040	-111240.422	-27060.154	6.420
面積	50.7149080		
地積	50.71㎡		

146			
地番	桂上中三一 桂上中三二）合地A		
N O	X	Y	辺長
12246	-111297.971	-27060.054	
12247	-111273.987	-27060.098	23.984
12248	-111250.485	-27060.144	23.502
13997	-111246.842	-27060.148	3.643
13988	-111252.159	-27068.690	10.062
13987	-111258.634	-27079.144	12.297
13985	-111261.807	-27084.269	6.028
14022	-111265.401	-27090.031	6.791
14023	-111275.714	-27080.439	14.084
14032	-111284.674	-27074.039	11.011
12246	-111297.971	-27060.054	19.297
面積	783.2691240		
地積	783.26㎡		

147			
地番	桂上中二八ノ一一		
N O	X	Y	辺長
13985	-111261.807	-27084.269	
13984	-111255.365	-27089.063	8.030
14020	-111259.451	-27095.617	7.723
14021	-111264.244	-27091.107	6.581
14022	-111265.401	-27090.031	1.580
13985	-111261.807	-27084.269	6.791
面積	58.0541670		
地積	58.05㎡		

148			
地番	桂上中二八ノ一〇		
N O	X	Y	辺長
13984	-111255.365	-27089.063	
13983	-111251.500	-27091.934	4.815
14018	-111255.903	-27099.005	8.330
14019	-111257.935	-27097.043	2.825
14020	-111259.451	-27095.617	2.081
13984	-111255.365	-27089.063	7.723
面積	38.4953140		
地積	38.49 m ²		

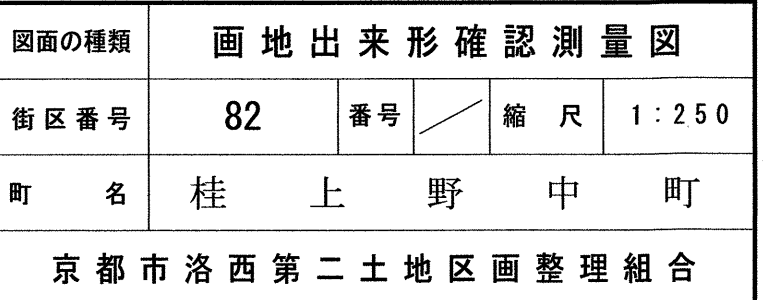

118

地番	桂上中二五ノ一		
N O	X	Y	辺 長
13972	-111270.164	-27109.153	
13976	-111258.690	-27114.824	12.799
14013	-111255.861	-27110.885	4.850
14001	-111251.368	-27113.890	5.405
14002	-111254.334	-27121.070	7.768
14003	-111255.120	-27124.065	3.096
14004	-111256.491	-27128.431	4.576
14005	-111258.715	-27132.786	4.890
13032	-111260.550	-27135.987	3.690
13031	-111261.246	-27135.480	0.861
13030	-111268.361	-27130.078	8.933
13029	-111272.302	-27126.771	5.145
13558	-111277.904	-27120.298	8.560
13972	-111270.164	-27109.153	13.569
面積	395.1427620		
地積	395.14㎡		

119

地番	桂上中二五ノ二、桂上中二六		
N O	X	Y	辺 長
14028	-111262.651	-27093.969	
14029	-111258.615	-27097.768	5.543
14030	-111254.951	-27101.314	5.099
14031	-111251.992	-27104.447	4.309
14010	-111250.123	-27107.419	3.511
14011	-111249.909	-27110.908	3.496
14000	-111251.191	-27113.462	2.858
14001	-111251.368	-27113.890	0.463
14013	-111255.861	-27110.885	5.405
13976	-111258.690	-27114.824	4.850
13972	-111270.164	-27109.153	12.799
13558	-111277.904	-27120.298	13.569
13536	-111278.648	-27119.439	1.136
13973	-111269.583	-27105.718	16.445
13974	-111270.361	-27105.249	0.908
13975	-111269.592	-27103.973	1.490
14028	-111262.651	-27093.969	12.176
面積	266.9996580		
地積	266.99㎡		

120

地番	桂上中二三ノ一、桂上中二四		
N O	X	Y	辺 長
21130	-111270.009	-27087.107	
14026	-111266.064	-27090.769	5.383
14027	-111264.950	-27091.805	1.521
14028	-111262.651	-27093.969	3.157
13975	-111269.592	-27103.973	12.176
13974	-111270.361	-27105.249	1.490
13971	-111273.171	-27109.991	5.512
20061	-111275.507	-27113.498	4.214
20062	-111278.162	-27111.747	3.180
13555	-111281.265	-27116.414	5.604
13538	-111283.238	-27114.135	3.014
21131	-111285.896	-27112.184	3.297
21130	-111270.009	-27087.107	29.686
面積	262.9005910		
地積	262.90㎡		

121

地番	桂上中二三ノ二		
N O	X	Y	辺 長
14038	-111282.870	-27091.103	
14025	-111276.335	-27081.233	11.837
21130	-111270.009	-27087.107	8.633
21131	-111285.896	-27112.184	29.686
13539	-111287.272	-27111.174	1.707
13540	-111287.293	-27111.158	0.026
20059	-111284.606	-27106.916	5.021
13977	-111277.268	-27095.334	13.711
14039	-111280.114	-27093.450	3.413
14038	-111282.870	-27091.103	3.620
面積	131.4215455		
地積	131.42㎡		

122

地番	桂上中二一		
N O	X	Y	辺 長
14037	-111282.935	-27076.488	
14024	-111276.403	-27081.170	8.037
14025	-111276.335	-27081.233	0.093
14038	-111282.870	-27091.103	11.837
14039	-111280.114	-27093.450	3.620
13977	-111277.268	-27095.334	3.413
20059	-111284.606	-27106.916	13.711
20060	-111288.606	-27104.376	4.738
13556	-111291.066	-27108.259	4.597
13541	-111293.866	-27106.108	3.531
13557	-111299.109	-27102.199	6.540
14037	-111282.935	-27076.488	30.375
面積	347.0506155		
地積	347.05㎡		

123

地番	桂上中二二		
N O	X	Y	辺 長
14033	-111285.470	-27074.621	
14034	-111285.321	-27074.778	0.216
14037	-111282.935	-27076.488	2.935
13557	-111299.109	-27102.199	30.375
21184	-111300.992	-27100.795	2.349
13542	-111301.112	-27100.706	0.149
14041	-111292.890	-27084.961	17.762
14035	-111291.551	-27084.371	1.463
14036	-111288.427	-27079.073	6.150
14033	-111285.470	-27074.621	5.345
面積	97.4791985		
地積	97.47㎡		

124

地番	桂上中二〇		
N O	X	Y	辺 長
12245	-111299.358	-27060.062	
14033	-111285.470	-27074.621	20.121
14036	-111288.427	-27079.073	5.345
14035	-111291.551	-27084.371	6.150
14041	-111292.890	-27084.961	1.463
13542	-111301.112	-27100.706	17.762
13543	-111303.484	-27098.937	2.959
13564	-111315.151	-27092.356	13.395
20063	-111310.028	-27075.667	17.458
20064	-111314.391	-27073.722	4.777
14042	-111309.078	-27060.043	14.675
12245	-111299.358	-27060.062	9.720
面積	733.0706460		
地積	733.07㎡		

125

地番	桂上中四六B		
N O	X	Y	辺 長
14042	-111309.078	-27060.043	
20064	-111314.391	-27073.722	14.675
20057	-111315.218	-27075.850	2.283
20058	-111318.249	-27085.721	10.326
13563	-111319.448	-27089.933	4.379
13562	-111319.839	-27089.712	0.449
13565	-111319.721	-27087.506	2.209
13566	-111328.490	-27083.604	9.598
13567	-111329.511	-27080.952	2.842
13568	-111321.356	-27062.719	19.974
12244	-111317.330	-27060.027	4.843
14042	-111309.078	-27060.043	8.252
面積	297.9475160		
地積	297.94㎡		

126

地番	桂上中四六A		
N O	X	Y	辺 長
20063	-111310.028	-27075.667	
13564	-111315.151	-27092.356	17.458
13563	-111319.448	-27089.933	4.933
20058	-111318.249	-27085.721	4.379
20057	-111315.218	-27075.850	10.326
20064	-111314.391	-27073.722	2.283
20063	-111310.028	-27075.667	4.777
面積	84.1332820		
地積	84.13㎡		

127

地番	桂上中一二ノ一		
N O	X	Y	辺 長
20059	-111284.606	-27106.916	
13540	-111287.293	-27111.158	5.021
13556	-111291.066	-27108.259	4.758
20060	-111288.606	-27104.376	4.597
20059	-111284.606	-27106.916	4.738
面積	22.7875395		
地積	22.78㎡		

128

地番	桂上南一九ノ一		
N O	X	Y	辺 長
20061	-111275.507	-27113.498	
13537	-111279.108	-27118.907	6.498
13555	-111281.265	-27116.414	3.297
20062	-111278.162	-27111.747	5.604
20061	-111275.507	-27113.498	3.180
面積	19.2343720		
地積	19.23㎡		

129

地番	桂上中四九A		
N O	X	Y	辺 長
13974	-111270.361	-27105.249	
13973	-111269.583	-27105.718	0.908
13536	-111278.648	-27119.439	16.445
13537	-111279.108	-27118.907	0.703
20061	-111275.507	-27113.498	6.498
13971	-111273.171	-27109.991	4.214
13974	-111270.361	-27105.249	5.512
面積	11.3849650		
地積	11.38㎡		

図面の種類	画 地 面 積 求 積 表				
街区 番号	82	番号		縮 尺	
町 名	桂 上 野 中 町				
京 都 市 洛 西 第 二 土 地 区 画 整 理 組 合					

90

地番	桂上中一三ノ二		
N O	X	Y	辺長
13961	-111284.441	-27159.915	
13095	-111287.221	-27162.044	3.502
13604	-111292.035	-27162.106	4.814
13603	-111298.647	-27157.175	8.248
20070	-111294.864	-27152.093	6.335
20071	-111285.558	-27159.077	11.635
13961	-111284.441	-27159.915	1.396
面積	72.2835820		
地積	72.28㎡		

91

地番	桂上中一三ノ三		
N O	X	Y	辺長
13962	-111283.877	-27159.484	
13961	-111284.441	-27159.915	0.710
20071	-111285.558	-27159.077	1.396
20072	-111285.147	-27158.530	0.684
13962	-111283.877	-27159.484	1.588
面積	1.0204215		
地積	1.02㎡		

92

地番	桂上中一三ノ一		
N O	X	Y	辺長
13978	-111287.971	-27142.925	
13022	-111276.655	-27153.953	15.801
13962	-111283.877	-27159.484	9.097
20072	-111285.147	-27158.530	1.588
20071	-111285.558	-27159.077	0.684
20070	-111294.864	-27152.093	11.635
13944	-111293.693	-27150.519	1.962
13978	-111287.971	-27142.925	9.508
面積	150.4438115		
地積	150.44㎡		

93

地番	桂上中一六ノ四		
N O	X	Y	辺長
13952	-111288.077	-27137.142	
13953	-111284.787	-27140.357	4.600
13954	-111280.009	-27145.011	6.670
13021	-111275.572	-27149.344	6.202
13020	-111270.973	-27149.571	4.605
13096	-111272.095	-27150.461	1.432
13022	-111276.655	-27153.953	5.743
13978	-111287.971	-27142.925	15.801
13966	-111287.941	-27142.877	0.057
13951	-111288.678	-27142.162	1.027
13950	-111288.459	-27140.715	1.463
13947	-111289.994	-27139.127	2.209
13948	-111289.482	-27138.596	0.738
13952	-111288.077	-27137.142	2.022
面積	83.2564910		
地積	83.25㎡		

94

地番	桂上中一六ノ二		
N O	X	Y	辺長
13960	-111275.741	-27140.655	
13019	-111268.776	-27147.718	9.920
13097	-111269.714	-27148.573	1.269
13020	-111270.973	-27149.571	1.607
13021	-111275.572	-27149.344	4.605
13954	-111280.009	-27145.011	6.202
13960	-111275.741	-27140.655	6.098
面積	53.1535205		
地積	53.15㎡		

95

地番	桂上中一六ノ七		
N O	X	Y	辺長
13955	-111280.012	-27136.210	
13957	-111277.632	-27138.373	3.216
13956	-111277.819	-27138.590	0.286
13960	-111275.741	-27140.655	2.930
13954	-111280.009	-27145.011	6.098
13953	-111284.787	-27140.357	6.670
13955	-111280.012	-27136.210	6.324
面積	40.0583990		
地積	40.05㎡		

96

地番	桂上中一七		
N O	X	Y	辺長
13027	-111271.270	-27131.235	
13026	-111262.397	-27138.551	11.500
13101	-111261.206	-27139.536	1.546
13100	-111263.408	-27142.265	3.507
13099	-111265.309	-27144.369	2.836
13098	-111267.523	-27146.574	3.125
13019	-111268.776	-27147.718	1.697
13960	-111275.741	-27140.655	9.920
13956	-111277.819	-27138.590	2.930
13957	-111277.632	-27138.373	0.286
13958	-111275.710	-27136.259	2.857
13027	-111271.270	-27131.235	6.705
面積	137.3904145		
地積	137.39㎡		

97

地番	桂上中一六ノ一		
N O	X	Y	辺長
13554	-111277.723	-27123.562	
13028	-111271.348	-27131.171	9.927
13027	-111271.270	-27131.235	0.101
13958	-111275.710	-27136.259	6.705
13959	-111277.827	-27134.365	2.841
13552	-111283.460	-27129.304	7.573
13551	-111283.539	-27129.242	0.100
13554	-111277.723	-27123.562	8.129
面積	75.7791860		
地積	75.77㎡		

98

地番	桂上中一六ノ三		
N O	X	Y	辺長
13959	-111277.827	-27134.365	
13958	-111275.710	-27136.259	2.841
13957	-111277.632	-27138.373	2.857
13955	-111280.012	-27136.210	3.216
13959	-111277.827	-27134.365	2.860
面積	8.6164305		
地積	8.61㎡		

99

地番	桂上中一六ノ五		
N O	X	Y	辺長
13552	-111283.460	-27129.304	
13959	-111277.827	-27134.365	7.573
13955	-111280.012	-27136.210	2.860
13953	-111284.787	-27140.357	6.324
13952	-111288.077	-27137.142	4.600
13948	-111289.482	-27138.596	2.022
13945	-111291.729	-27136.397	3.144
16370	-111287.342	-27132.597	5.804
13552	-111283.460	-27129.304	5.091
面積	74.0414170		
地積	74.04㎡		

100

地番	桂上中一八ノ三		
N O	X	Y	辺長
13554	-111277.723	-27123.562	
13551	-111283.539	-27129.242	8.129
13552	-111283.460	-27129.304	0.100
16370	-111287.342	-27132.597	5.091
16369	-111292.884	-27126.980	7.891
20067	-111291.308	-27125.560	2.121
13550	-111285.384	-27120.240	7.962
16368	-111283.029	-27118.125	3.165
13553	-111279.422	-27121.534	4.963
13554	-111277.723	-27123.562	2.646
面積	104.4092070		
地積	104.40㎡		

101

地番	桂上中一八ノ二		
N O	X	Y	辺長
16370	-111287.342	-27132.597	
13945	-111291.729	-27136.397	5.804
13946	-111292.216	-27136.822	0.646
13941	-111294.068	-27134.943	2.638
13937	-111297.677	-27131.280	5.142
16369	-111292.884	-27126.980	6.439
16370	-111287.342	-27132.597	7.891
面積	50.4130020		
地積	50.41㎡		

102

地番	桂上中一八ノ六		
N O	X	Y	辺長
16368	-111283.029	-27118.125	
13550	-111285.384	-27120.240	3.165
13549	-111287.751	-27117.817	3.387
13548	-111285.730	-27115.574	3.019
16368	-111283.029	-27118.125	3.715
面積	10.9631420		
地積	10.96㎡		

103

地番	桂上中一八ノ四		
N O	X	Y	辺長
13545	-111294.742	-27107.817	
13546	-111291.517	-27110.566	4.238
13547	-111285.758	-27115.547	7.614
13548	-111285.730	-27115.574	0.039
13549	-111287.751	-27117.817	3.019
13550	-111285.384	-27120.240	3.387
20067	-111291.308	-27125.560	7.962
20068	-111296.739	-27120.360	7.519
13932	-111295.340	-27118.514	2.316
13963	-111299.242	-27113.820	6.104
13545	-111294.742	-27107.817	7.502
面積	130.9938620		
地積	130.99㎡		

104

地番	桂上中一八ノ五		
N O	X	Y	辺長
20067	-111291.308	-27125.560	
16369	-111292.884	-27126.980	2.121
13937	-111297.677	-27131.280	6.439
13940	-111301.934	-27127.214	5.887
20068	-111296.739	-27120.360	8.600
20067	-111291.308	-27125.560	7.519
面積	57.2568640		
地積	57.25㎡		

105

地番	桂上中一八ノ一		
N O	X	Y	辺長
13963	-111299.242	-27113.820	
13932	-111295.340	-27118.514	6.104
20068	-111296.739	-27120.360	2.316
13940	-111301.934	-27127.214	8.600
13933	-111302.707	-27126.276	1.215
13934	-111306.064	-27122.183	5.294
13963	-111299.242	-27113.820	10.793
面積	66.8882775		
地積	66.88㎡		

106

地番	桂上中一九		
N O	X	Y	辺長
13569	-111324.350	-27089.830	
21185	-111321.353	-27091.166	3.281
13561	-111319.242	-27092.107	2.311
13560	-111308.152	-27098.633	12.868
13559	-111302.482	-27102.793	7.032
13544	-111294.773	-27107.791	9.187
13545	-111294.742	-27107.817	0.040
13963	-111299.242	-27113.820	7.502
13934	-111306.064	-27122.183	10.793
13935	-111308.182	-27119.607	3.335
13936	-111310.920	-27117.556	3.421
13964	-111326.507	-27105.836	19.502
13965	-111323.978	-27100.861	5.581
20066	-111324.800	-27098.964	2.067
20065	-111328.437	-27097.166	4.057
13569	-111324.350	-27089.830	8.398
面積	512.3214700		
地積	512.32㎡		

107

地番	桂上中四七B		
N O	X	Y	辺長
13570	-111330.114	-27087.261	
13569	-111324.350	-27089.830	6.311
20065	-111328.437	-27097.166	8.398
20066	-111324.800	-27098.964	4.057
13965	-111323.978	-27100.861	2.067
13964	-111326.507	-27105.836	5.581
13585	-111337.089	-27097.892	13.232
13571	-111332.776	-27088.261	10.553
13570	-111330.114	-27087.261	2.844
面積	137.1940620		
地積	137.19㎡		

115

地 番	桂上中一三ノ六		
N O	X	Y	辺 長
13949	-111290.875	-27140.029	
13951	-111288.678	-27142.162	3.062
20069	-111288.684	-27142.202	0.040
13978	-111287.971	-27142.925	1.015
13944	-111293.693	-27150.519	9.508
13942	-111296.942	-27148.078	4.064
13938	-111296.367	-27147.339	0.936
13949	-111290.875	-27140.029	9.143
面積	39.7876980		
地積	39.78 m ²		


116

地 番	桂上中一三		
N O	X	Y	辺 長
13947	-111289.994	-27139.127	
13950	-111288.459	-27140.715	2.209
13951	-111288.678	-27142.162	1.463
13949	-111290.875	-27140.029	3.062
13947	-111289.994	-27139.127	1.261
面積	3.2148920		
地積	3.21 m ²		

117

地 番	桂上中一六		
N O	X	Y	辺 長
13951	-111288.678	-27142.162	
13966	-111287.941	-27142.877	1.027
13978	-111287.971	-27142.925	0.057
20069	-111288.684	-27142.202	1.015
13951	-111288.678	-27142.162	0.040
面積	0.0448420		
地積	0.04 m ²		

図面の種類	画 地 面 積 求 積 表				
街区 番号	83	番号	$\frac{2}{2}$	縮 尺	
町 名	桂 上 野 中 町				
京 都 市 洛 西 第 二 土 地 区 画 整 理 組 合					

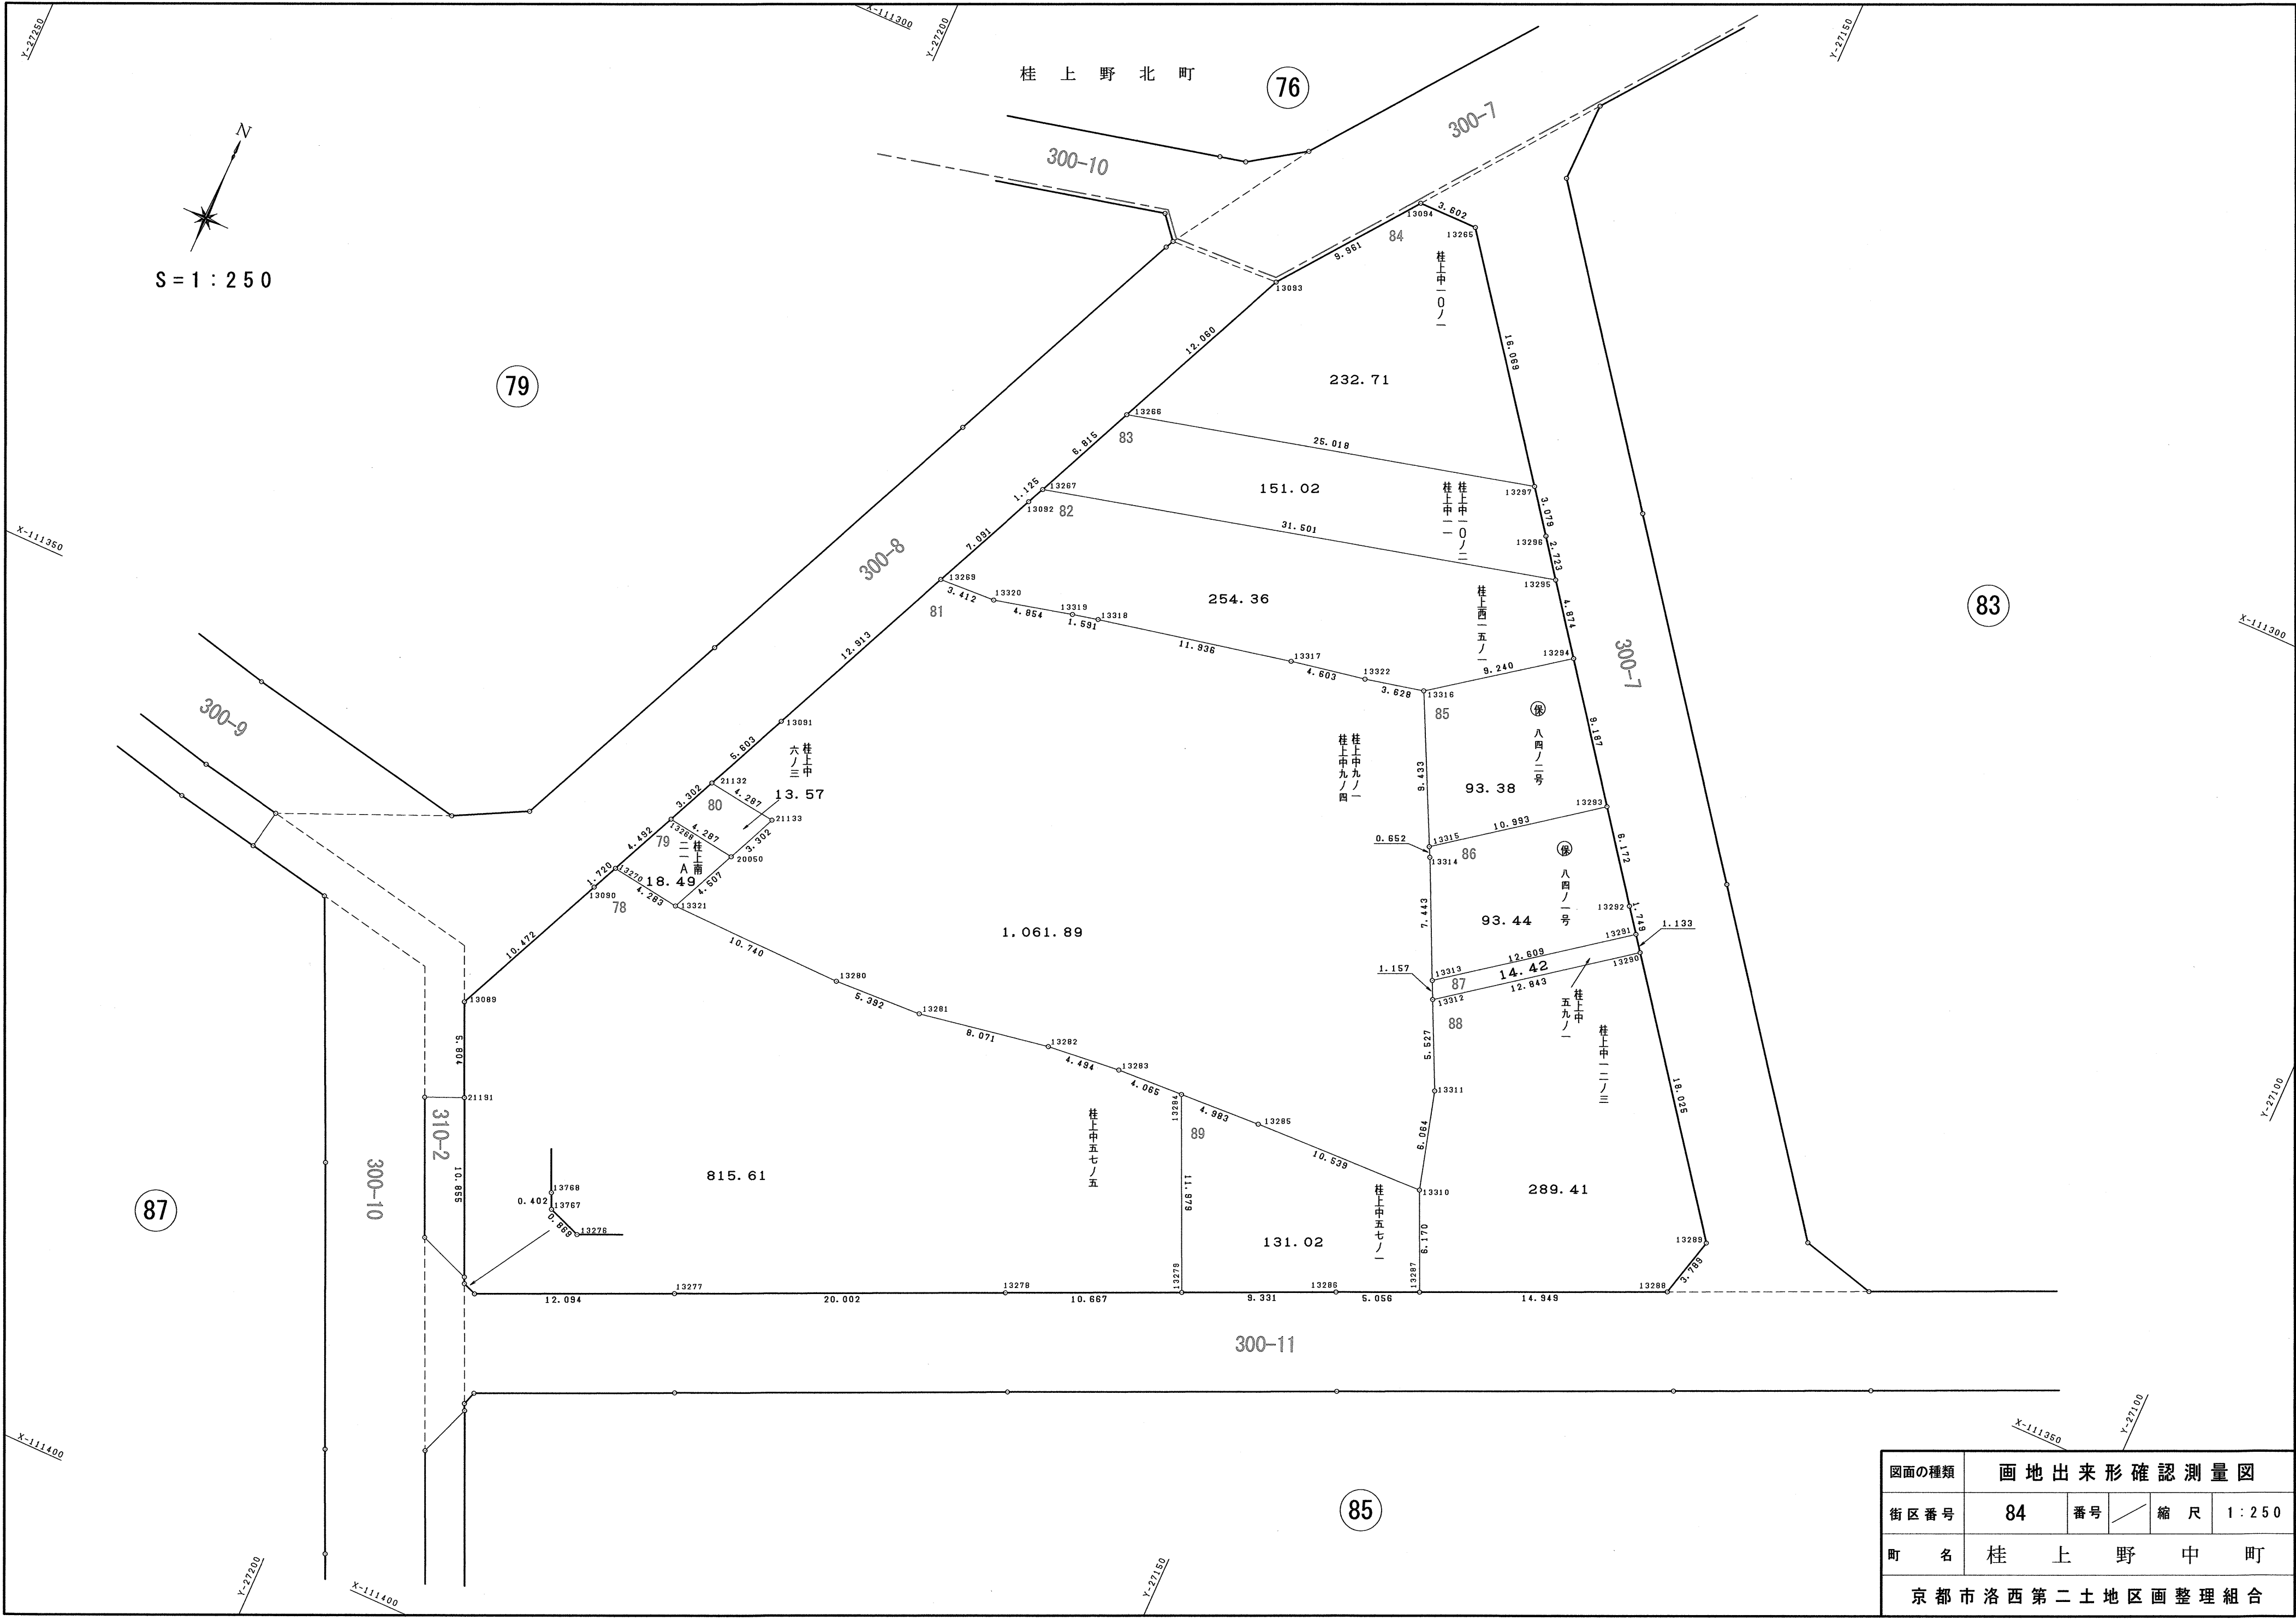

図面の種類	画 地 出 来 形 確 認 測 量 図				
街 区 番 号	84	番 号		縮 尺	1 : 2 5 0
町 名	桂 上 野 中 町				
京 都 市 洛 西 第 二 土 地 区 画 整 理 組 合					

78

地番	桂上中五七ノ五		
N O	X	Y	辺 長
13284	-111352.125	-27160.757	
13283	-111352.316	-27164.818	4.065
13282	-111352.758	-27169.290	4.494
13281	-111354.131	-27177.243	8.071
13280	-111354.375	-27182.629	5.392
13321	-111354.166	-27193.367	10.740
13270	-111353.564	-27197.607	4.283
13090	-111355.130	-27198.318	1.720
13089	-111364.663	-27202.653	10.472
21191	-111369.863	-27200.287	5.804
13768	-111378.877	-27195.867	10.855
13767	-111380.242	-27195.699	0.402
13276	-111380.550	-27194.886	0.869
13277	-111375.603	-27183.850	12.094
13278	-111367.418	-27165.599	20.002
13279	-111363.059	-27155.863	10.667
13284	-111352.125	-27160.757	11.979
面積	815.6181250		
地積	815.61㎡		

79

地番	桂上南二一A		
N O	X	Y	辺 長
13268	-111349.473	-27195.751	
13270	-111353.564	-27197.607	4.492
13321	-111354.166	-27193.367	4.283
20050	-111350.062	-27191.505	4.507
13268	-111349.473	-27195.751	4.287
面積	18.4927270		
地積	18.49㎡		

80

地番	桂上中六ノ三		
N O	X	Y	辺 長
13268	-111349.473	-27195.751	
20050	-111350.062	-27191.505	4.287
21133	-111347.055	-27190.141	3.302
21132	-111346.466	-27194.387	4.287
13268	-111349.473	-27195.751	3.302
面積	13.5711180		
地積	13.57㎡		

81

地番	桂上中九ノ一、桂上中九ノ四		
N O	X	Y	辺 長
13316	-111323.870	-27157.324	
13322	-111324.668	-27160.863	3.628
13317	-111325.505	-27165.389	4.603
13318	-111327.942	-27177.074	11.936
13319	-111328.287	-27178.627	1.591
13320	-111329.439	-27183.342	4.854
13269	-111329.599	-27186.750	3.412
13091	-111341.364	-27192.072	12.913
21132	-111346.466	-27194.387	5.603
21133	-111347.055	-27190.141	4.287
20050	-111350.062	-27191.505	3.302
13321	-111354.166	-27193.367	4.507
13280	-111354.375	-27182.629	10.740
13281	-111354.131	-27177.243	5.392
13282	-111352.758	-27169.290	8.071
13283	-111352.316	-27164.818	4.494
13284	-111352.125	-27160.757	4.065
13285	-111351.883	-27155.780	4.983
13310	-111351.548	-27145.246	10.539
13311	-111345.703	-27146.861	6.064
13312	-111340.706	-27149.222	5.527
13313	-111339.660	-27149.716	1.157
13314	-111332.922	-27152.879	7.443
13315	-111332.342	-27153.176	0.652
13316	-111323.870	-27157.324	9.433
面積	1061.8991110		
地積	1061.89㎡		

82

地番	桂上西一五ノ一		
N O	X	Y	辺 長
13295	-111314.494	-27152.798	
13267	-111322.113	-27183.364	31.501
13092	-111323.138	-27183.828	1.125
13269	-111329.599	-27186.750	7.091
13320	-111329.439	-27183.342	3.412
13319	-111328.287	-27178.627	4.854
13318	-111327.942	-27177.074	1.591
13317	-111325.505	-27165.389	11.936
13322	-111324.668	-27160.863	4.603
13316	-111323.870	-27157.324	3.628
13294	-111318.397	-27149.879	9.240
13295	-111314.494	-27152.798	4.874
面積	254.3679260		
地積	254.36㎡		

83

地番	桂上中一〇ノ二、桂上中一一		
N O	X	Y	辺 長
13297	-111309.851	-27156.276	
13266	-111315.906	-27180.550	25.018
13267	-111322.113	-27183.364	6.815
13295	-111314.494	-27152.798	31.501
13296	-111312.314	-27154.429	2.723
13297	-111309.851	-27156.276	3.079
面積	151.0280375		
地積	151.02㎡		

84

地番	桂上中一〇ノ一		
N O	X	Y	辺 長
13094	-111297.010	-27169.519	
13093	-111304.921	-27175.572	9.961
13266	-111315.906	-27180.550	12.060
13297	-111309.851	-27156.276	25.018
13265	-111296.996	-27165.917	16.069
13094	-111297.010	-27169.519	3.602
面積	232.7193650		
地積	232.71㎡		

85

地番	保 八四ノ二号		
N O	X	Y	辺 長
13294	-111318.397	-27149.879	
13316	-111323.870	-27157.324	9.240
13315	-111332.342	-27153.176	9.433
13293	-111325.753	-27144.376	10.993
13294	-111318.397	-27149.879	9.187
面積	93.3840555		
地積	93.38㎡		

86

地番	保 八四ノ一号		
N O	X	Y	辺 長
13293	-111325.753	-27144.376	
13315	-111332.342	-27153.176	10.993
13314	-111332.922	-27152.879	0.652
13313	-111339.660	-27149.716	7.443
13291	-111332.094	-27139.629	12.609
13292	-111330.695	-27140.679	1.749
13293	-111325.753	-27144.376	6.172
面積	93.4450830		
地積	93.44㎡		

87

地番	桂上中五九ノ一		
N O	X	Y	辺 長
13291	-111332.094	-27139.629	
13313	-111339.660	-27149.716	12.609
13312	-111340.706	-27149.222	1.157
13290	-111333.000	-27138.948	12.843
13291	-111332.094	-27139.629	1.133
面積	14.4223180		
地積	14.42㎡		


88

地番	桂上中一二ノ三		
N O	X	Y	辺 長
13290	-111333.000	-27138.948	
13312	-111340.706	-27149.222	12.843
13311	-111345.703	-27146.861	5.527
13310	-111351.548	-27145.246	6.064
13287	-111357.182	-27142.731	6.170
13288	-111351.081	-27129.084	14.949
13289	-111347.415	-27128.127	3.789
13290	-111333.000	-27138.948	18.025
面積	289.4138190		
地積	289.41㎡		

89

地番	桂上中五七ノ一		
N O	X	Y	辺 長
13310	-111351.548	-27145.246	
13285	-111351.883	-27155.780	10.539
13284	-111352.125	-27160.757	4.983
13279	-111363.059	-27155.863	11.979
13286	-111359.246	-27147.347	9.331
13287	-111357.182	-27142.731	5.056
13310	-111351.548	-27145.246	6.170
面積	131.0228020		
地積	131.02㎡		

図面の種類		画 地 面 積 求 積 表				
街区 番号		84	番号		縮 尺	
町 名		桂 上 野 中 町				
京 都 市 洛 西 第 二 土 地 区 画 整 理 組 合						

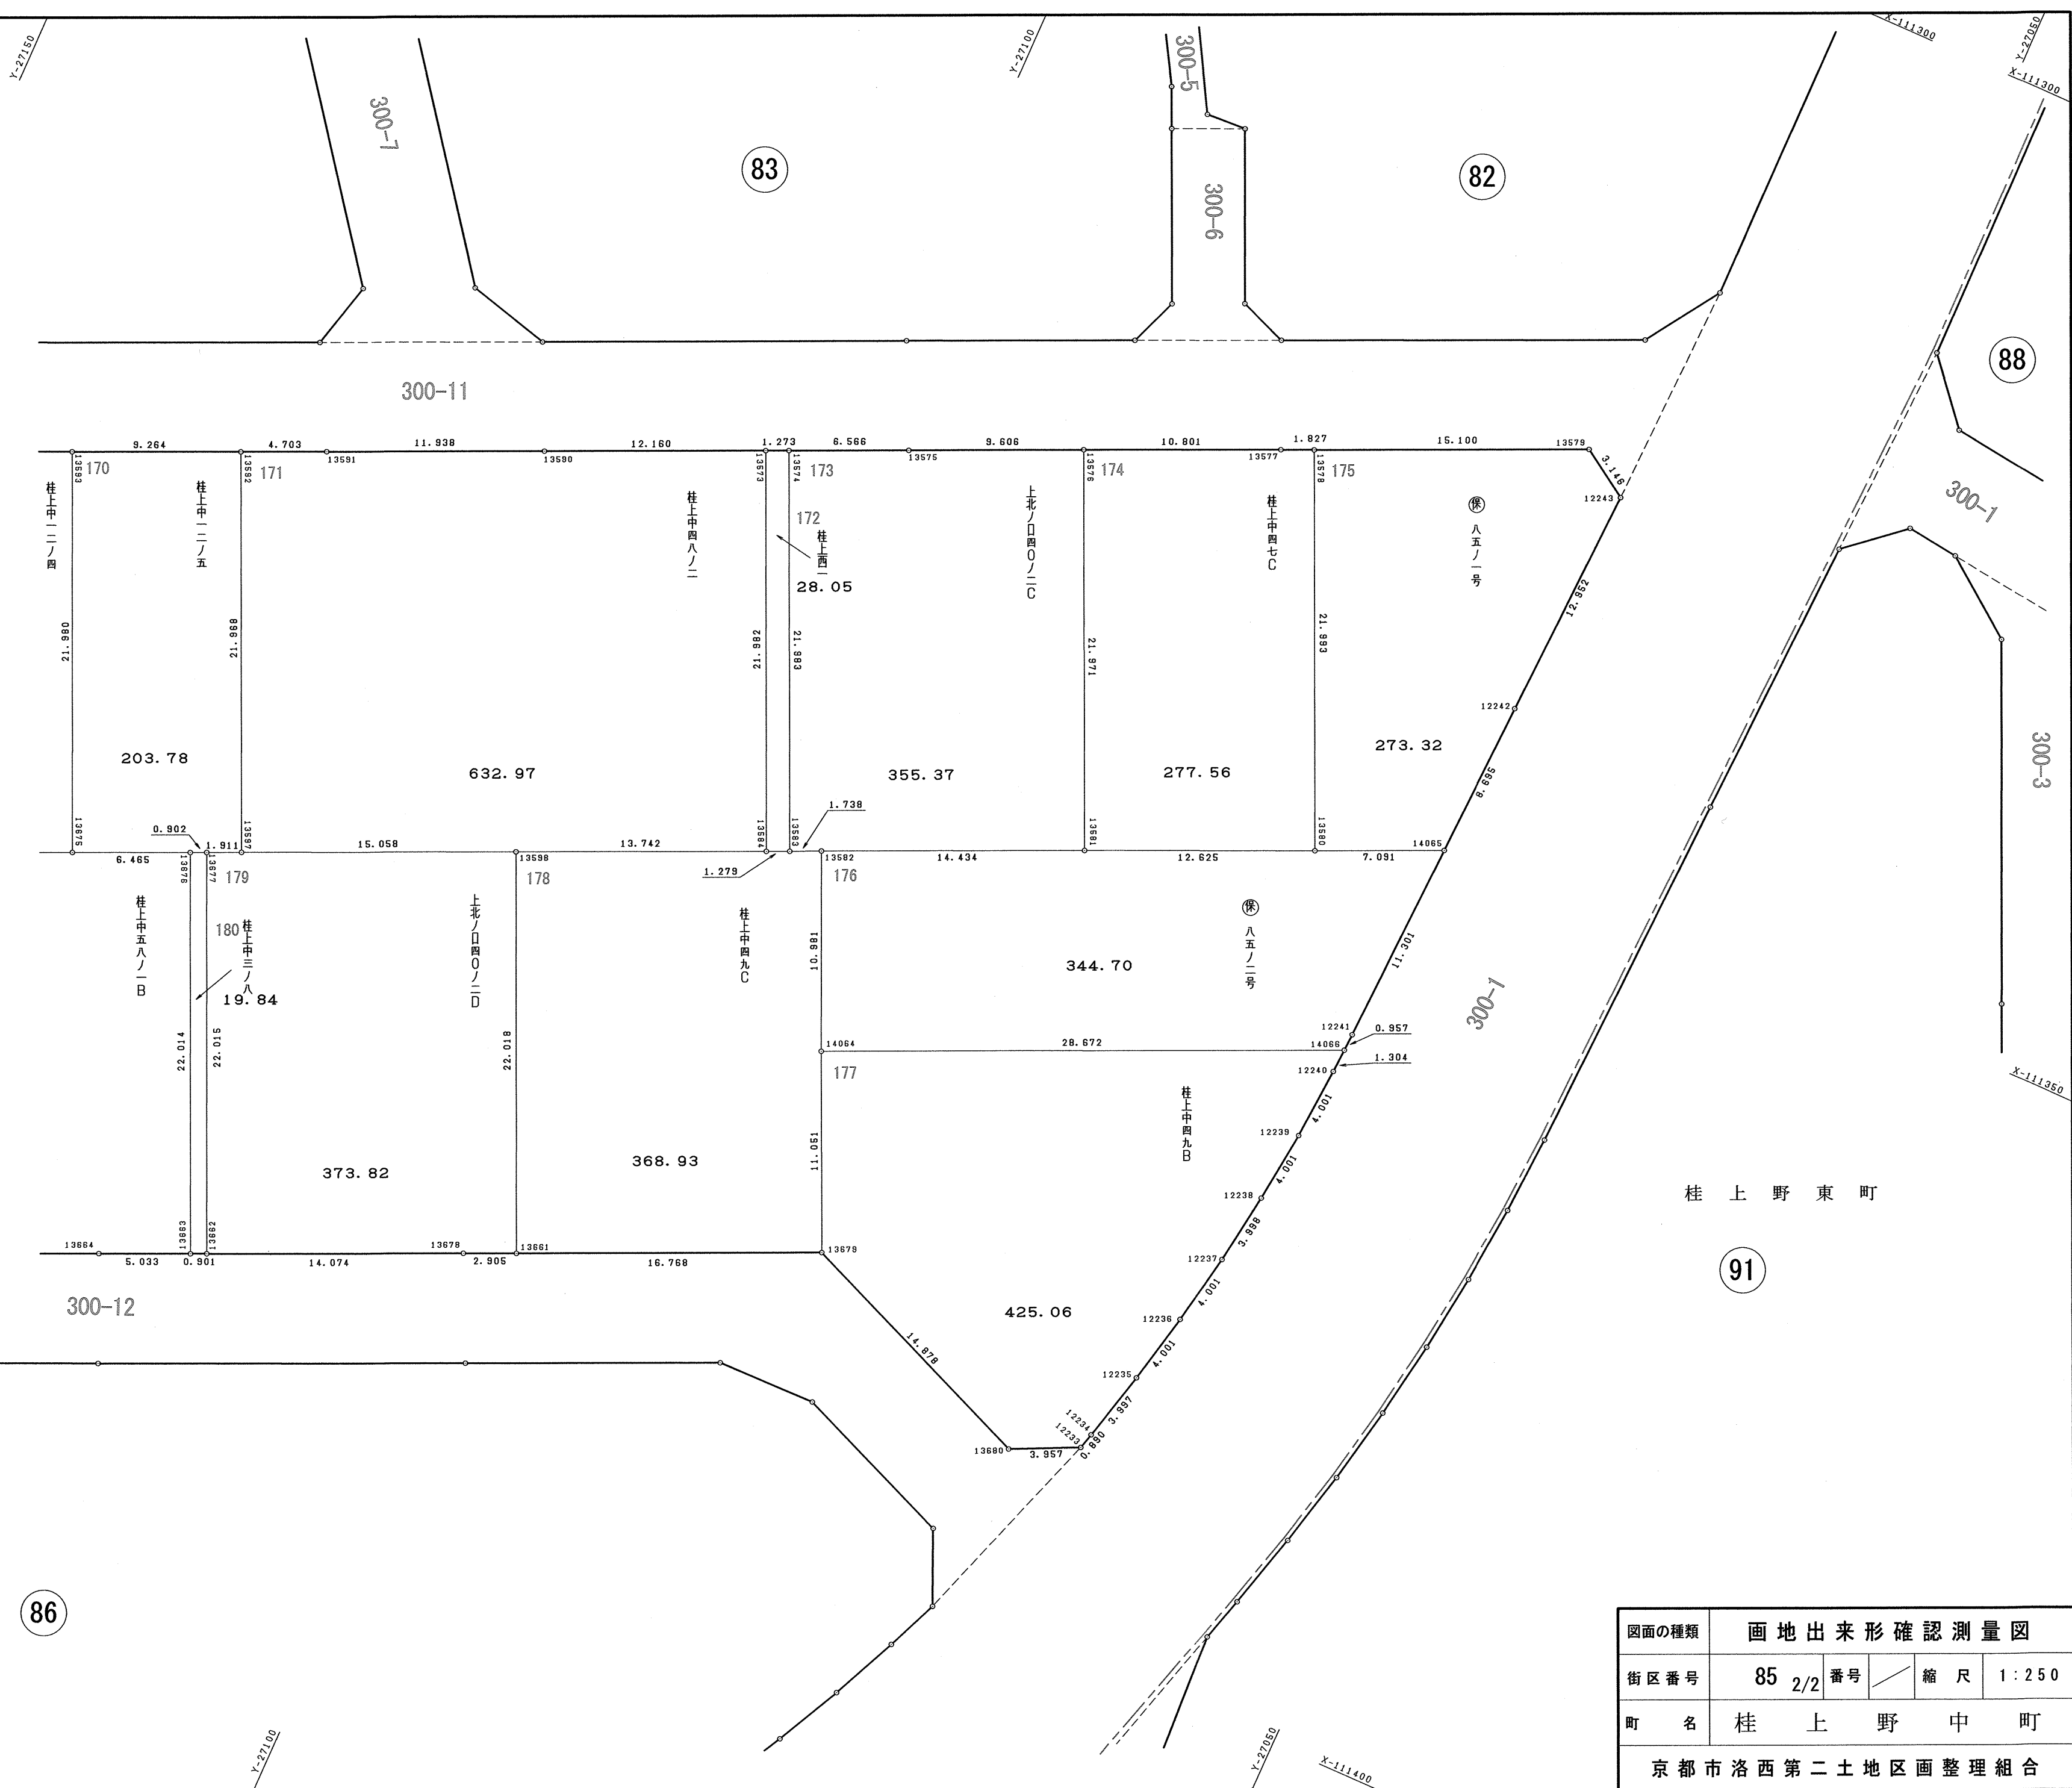

図面の種類	画地出来形確認測量図				
街区番号	85	2/2	番号		縮尺 1:250
町名	桂上野中町				
京都市洛西第二土地区画整理組合					

152

地番	桂上中五六ノ九		
N O	X	Y	辺 長
13615	-111386.055	-27192.478	
13616	-111386.865	-27192.739	0.851
13629	-111387.258	-27192.559	0.432
13630	-111399.042	-27187.271	12.916
20140	-111397.417	-27183.633	3.984
13614	-111384.649	-27189.344	13.987
13615	-111386.055	-27192.478	3.435
面積	55.6585000		
地積	55.65 ㎡		

153

地番	桂上中五六ノ一〇		
N O	X	Y	辺長
13614	-111384.649	-27189.344	
20140	-111397.417	-27183.633	13.987
20139	-111395.786	-27179.980	4.001
13613	-111383.014	-27185.699	13.994
13614	-111384.649	-27189.344	3.995
面積	55.9303250		
地積	55.93 ㎡		

154			
地番	桂上中五六ノ一一		
N O	X	Y	辺 長
13613	-111383.014	-27185.699	
20139	-111395.786	-27179.980	13.994
14053	-111394.150	-27176.318	4.011
14054	-111392.320	-27177.129	2.002
13612	-111381.370	-27182.036	11.999
13613	-111383.014	-27185.699	4.015
面積	56.2201200		
地積	56.22 ㎡		

155			
地番	桂上中五六ノ一二		
N O	X	Y	辺 長
13610	-111380.207	-27179.443	
13611	-111381.085	-27181.401	2.146
13612	-111381.370	-27182.036	0.696
14054	-111392.320	-27177.129	11.999
13618	-111389.915	-27171.803	5.844
13617	-111381.716	-27175.469	8.981
13610	-111380.207	-27179.443	4.251
面積	65.6152655		
地積	65.61 ㎡		

156			
地番	桂上中五六ノ一三		
N O	X	Y	辺 長
13618	-111389.915	-27171.803	
14054	-111392.320	-27177.129	5.844
14053	-111394.150	-27176.318	2.002
14052	-111397.428	-27174.852	3.591
14050	-111397.291	-27174.483	0.394
14046	-111400.883	-27172.877	3.935
13619	-111398.641	-27167.912	5.448
13618	-111389.915	-27171.803	9.554
面積	54.2904635		
地積	54.29 ㎡		

157			
地番	桂上中五六ノ一		
N O	X	Y	辺長
13628	-111377.338	-27173.046	
13610	-111380.207	-27179.443	7.011
13617	-111381.716	-27175.469	4.251
13618	-111389.915	-27171.803	8.981
13619	-111398.641	-27167.912	9.554
13620	-111398.921	-27167.788	0.306
13624	-111397.292	-27164.126	4.008
13625	-111393.777	-27165.694	3.849
13626	-111390.127	-27167.326	3.998
13628	-111377.338	-27173.046	14.010
面積	91.9698265		
地積	91.96 m ²		

158

地番	桂上中五六ノ一四		
N O	X	Y	辺 長
13628	-111377.338	-27173.046	
13626	-111390.127	-27167.326	14.010
14056	-111390.068	-27167.183	0.155
13627	-111377.277	-27172.910	14.015
13628	-111377.338	-27173.046	0.149
面積	2.1276150		
地積	2.12 ㎡		

159

地番	桂上中五四ノ一		
N O	X	Y	辺 長
13627	-111377.277	-27172.910	
14056	-111390.068	-27167.183	14.015
20143	-111388.275	-27163.181	4.385
13609	-111375.484	-27168.910	14.015
13627	-111377.277	-27172.910	4.383
面積	61.4470950		
地積	61.44 m ²		

160

地番	桂上中五六ノ一六		
N O	X	Y	辺 長
14056	-111390.068	-27167.183	
13626	-111390.127	-27167.326	0.155
13625	-111393.777	-27165.694	3.998
20146	-111393.714	-27165.553	0.154
14056	-111390.068	-27167.183	3.994
面積	0.6175070		
地積	0.61 ㎡		

161			
地番	桂上中五四ノ一三		
N O	X	Y	辺長
14056	-111390.068	-27167.183	
20146	-111393.714	-27165.553	3.994
14063	-111387.015	-27150.618	16.369
14062	-111383.372	-27152.241	3.988
20145	-111385.006	-27155.888	3.996
20144	-111386.641	-27159.534	3.996
20143	-111388.275	-27163.181	3.996
14056	-111390.068	-27167.183	4.385
面積	65.3336540		
地積	65.33 m ²		

162

地番	桂上中五六ノ一七		
N O	X	Y	辺長
20146	-111393.714	-27165.553	
13625	-111393.777	-27165.694	0.154
13624	-111397.292	-27164.126	3.849
13623	-111397.418	-27164.077	0.135
20147	-111397.355	-27163.936	0.154
20146	-111393.714	-27165.553	3.984
面積	0.6025855		
地積	0.60 m ²		

163

地番	桂上中五四ノ一四		
N O	X	Y	辺長
20146	-111393.714	-27165.553	
20147	-111397.355	-27163.936	3.984
13671	-111392.130	-27152.300	12.755
13672	-111390.668	-27148.974	3.633
14063	-111387.015	-27150.618	4.006
20146	-111393.714	-27165.553	16.369
面積	65.2468570		
地積	65.24 m ²		

164

地番	桂上中五四ノ一二		
N O	X	Y	辺長
13609	-111375.484	-27168.910	
20143	-111388.275	-27163.181	14.015
20144	-111386.641	-27159.534	3.996
13608	-111373.847	-27165.261	14.017
13609	-111375.484	-27168.910	3.999
面積	56.0351840		
地積	56.03 m ²		

165

地番	桂上中五四ノ一一		
N O	X	Y	辺 長
13608	-111373.847	-27165.261	
20144	-111386.641	-27159.534	14.017
20145	-111385.006	-27155.888	3.996
13606	-111372.211	-27161.608	14.015
13607	-111372.850	-27163.037	1.565
13608	-111373.847	-27165.261	2.437
面積	56.0561005		
地積	56.05 m ²		

166

地番	桂上中五四ノ一〇		
N O	X	Y	辺 長
13606	-111372.211	-27161.608	
20145	-111385.006	-27155.888	14.015
14062	-111383.372	-27152.241	3.996
13605	-111370.581	-27157.964	14.013
13606	-111372.211	-27161.608	3.992
面積	55.9743695		
地積	55.97 m ²		

167

地番	桂上中五七ノ四		
N O	X	Y	辺 長
13596	-111366.342	-27148.490	
13605	-111370.581	-27157.964	10.379
14062	-111383.372	-27152.241	14.013
14063	-111387.015	-27150.618	3.988
13672	-111390.668	-27148.974	4.006
13673	-111386.419	-27139.497	10.386
13596	-111366.342	-27148.490	21.999
面積	228.4936480		
地積	228.49 m ²		

168			
地番	桂上中五七ノ六		
N O	X	Y	辺 長
13594	-111363.522	-27142.189	
13595	-111364.717	-27144.857	2.923
13596	-111366.342	-27148.490	3.980
13673	-111366.419	-27139.497	21.999
13674	-111383.585	-27133.196	6.909
13594	-111363.522	-27142.189	21.986
面積	151.8813135		
地積	151.88 m ²		

181			
地番	桂上中五八ノ一B		
N O	X	Y	辺 長
13676	-111379.532	-27124.149	
13675	-111382.171	-27130.051	6.465
13674	-111383.585	-27133.196	3.448
13673	-111386.419	-27139.497	6.909
13672	-111390.668	-27148.974	10.386
13671	-111392.130	-27152.300	3.633
13670	-111395.786	-27150.655	4.009
13669	-111399.448	-27149.021	4.010
13666	-111412.232	-27143.301	14.005
13665	-111409.865	-27138.016	5.791
13664	-111401.687	-27119.763	20.001
13663	-111399.631	-27115.169	5.033
13676	-111379.532	-27124.149	22.014
面積	678.5238260		
地積	678.52㎡		

182			
地番	桂上中五四ノ三		
N O	X	Y	辺 長
13669	-111399.448	-27149.021	
14060	-111401.095	-27152.663	3.997
13667	-111413.865	-27146.949	13.990
13666	-111412.232	-27143.301	3.997
13669	-111399.448	-27149.021	14.005
面積	55.9480450		
地積	55.94㎡		

183			
地番	桂上中五四ノ七		
N O	X	Y	辺 長
14060	-111401.095	-27152.663	
14061	-111402.683	-27156.222	3.897
13668	-111415.467	-27150.524	13.996
13667	-111413.865	-27146.949	3.918
14060	-111401.095	-27152.663	13.990
面積	54.6766290		
地積	54.67㎡		

184			
地番	桂上中五四ノ八		
N O	X	Y	辺 長
14061	-111402.683	-27156.222	
14048	-111404.274	-27159.782	3.899
13642	-111417.058	-27154.077	13.999
13668	-111415.467	-27150.524	3.893
14061	-111402.683	-27156.222	13.996
面積	54.5373825		
地積	54.53㎡		

185			
地番	桂上中五四ノ九		
N O	X	Y	辺 長
14048	-111404.274	-27159.782	
14049	-111406.431	-27164.627	5.303
20138	-111408.898	-27163.523	2.703
13640	-111419.220	-27158.903	11.309
13641	-111418.035	-27156.259	2.897
13642	-111417.058	-27154.077	2.391
14048	-111404.274	-27159.782	13.999
面積	74.1693685		
地積	74.16㎡		

186			
地番	桂上中五四ノ一六		
N O	X	Y	辺 長
13670	-111395.786	-27150.655	
13622	-111401.171	-27162.620	13.121
14047	-111402.784	-27166.267	3.988
14049	-111406.431	-27164.627	3.999
14048	-111404.274	-27159.782	5.303
14061	-111402.683	-27156.222	3.899
14060	-111401.095	-27152.663	3.897
13669	-111399.448	-27149.021	3.997
13670	-111395.786	-27150.655	4.010
面積	68.4710035		
地積	68.47㎡		

187			
地番	桂上中五四ノ一五		
N O	X	Y	辺 長
13623	-111397.418	-27164.077	
13622	-111401.171	-27162.620	4.026
13670	-111395.786	-27150.655	13.121
13671	-111392.130	-27152.300	4.009
20147	-111397.355	-27163.936	12.755
13623	-111397.418	-27164.077	0.154
面積	52.2512025		
地積	52.25㎡		

188			
地番	桂上中五四ノ二		
N O	X	Y	辺 長
13623	-111397.418	-27164.077	
13621	-111399.054	-27167.725	3.998
14045	-111399.141	-27167.914	0.208
14047	-111402.784	-27166.267	3.998
13622	-111401.171	-27162.620	3.988
13623	-111397.418	-27164.077	4.026
面積	16.4307380		
地積	16.43㎡		

189			
地番	桂上中五六ノ一八		
N O	X	Y	辺 長
13624	-111397.292	-27164.126	
13620	-111398.921	-27167.788	4.008
13621	-111399.054	-27167.725	0.147
13623	-111397.418	-27164.077	3.998
13624	-111397.292	-27164.126	0.135
面積	0.5647425		
地積	0.56㎡		

190			
地番	桂上中五三ノ一		
N O	X	Y	辺 長
13636	-111410.622	-27182.087	
13637	-111425.501	-27175.438	16.297
13638	-111425.903	-27175.274	0.434
13639	-111426.214	-27174.511	0.824
13640	-111419.220	-27158.903	17.103
20138	-111408.898	-27163.523	11.309
20151	-111411.955	-27170.749	7.846
20150	-111411.296	-27170.995	0.703
20149	-111414.273	-27177.103	6.795
20148	-111409.377	-27179.262	5.351
13636	-111410.622	-27182.087	3.087
面積	223.7347825		
地積	223.73㎡		


191			
地番	桂上中五三ノ二		
N O	X	Y	辺 長
13633	-111406.348	-27183.997	
13636	-111410.622	-27182.087	4.681
20148	-111409.377	-27179.262	3.087
20149	-111414.273	-27177.103	5.351
20150	-111411.296	-27170.995	6.795
20151	-111411.955	-27170.749	0.703
20138	-111408.898	-27163.523	7.846
14049	-111406.431	-27164.627	2.703
14047	-111402.784	-27166.267	3.999
14045	-111399.141	-27167.914	3.998
14055	-111401.450	-27173.054	5.635
13633	-111406.348	-27183.997	11.989
面積	164.4858280		
地積	164.48㎡		

192			
地番	桂上中五六ノ七		
N O	X	Y	辺 長
14051	-111397.796	-27174.692	
13631	-111402.693	-27185.633	11.987
13632	-111404.056	-27185.021	1.494
13633	-111406.348	-27183.997	2.510
14055	-111401.450	-27173.054	11.989
14051	-111397.796	-27174.692	4.004
面積	48.0012505		
地積	48.00㎡		

193			
地番	桂上中五六ノ一五		
N O	X	Y	辺 長
14050	-111397.291	-27174.483	
14052	-111397.428	-27174.852	0.394
14051	-111397.796	-27174.692	0.401
14055	-111401.450	-27173.054	4.004
14045	-111399.141	-27167.914	5.635
13621	-111399.054	-27167.725	0.208
13620	-111398.921	-27167.788	0.147
13619	-111398.641	-27167.912	0.306
14046	-111400.883	-27172.877	5.448
14050	-111397.291	-27174.483	3.935
面積	4.1859275		
地積	4.18㎡		

194			
地番	桂上中五六ノ八		
N O	X	Y	辺 長
14053	-111394.150	-27176.318	
20139	-111395.786	-27179.980	4.011
20140	-111397.417	-27183.633	4.001
13630	-111399.042	-27187.271	3.984
13631	-111402.693	-27185.633	4.002
14051	-111397.796	-27174.692	11.987
14052	-111397.428	-27174.852	0.401
14053	-111394.150	-27176.318	3.591
面積	47.9344290		
地積	47.93㎡		

図面の種類	画 地 面 積 求 積 表				
街区 番号	85	番号	$\frac{2}{2}$	縮 尺	
町 名	桂 上 野 中 町				
京 都 市 洛 西 第 二 土 地 区 画 整 理 組 合					

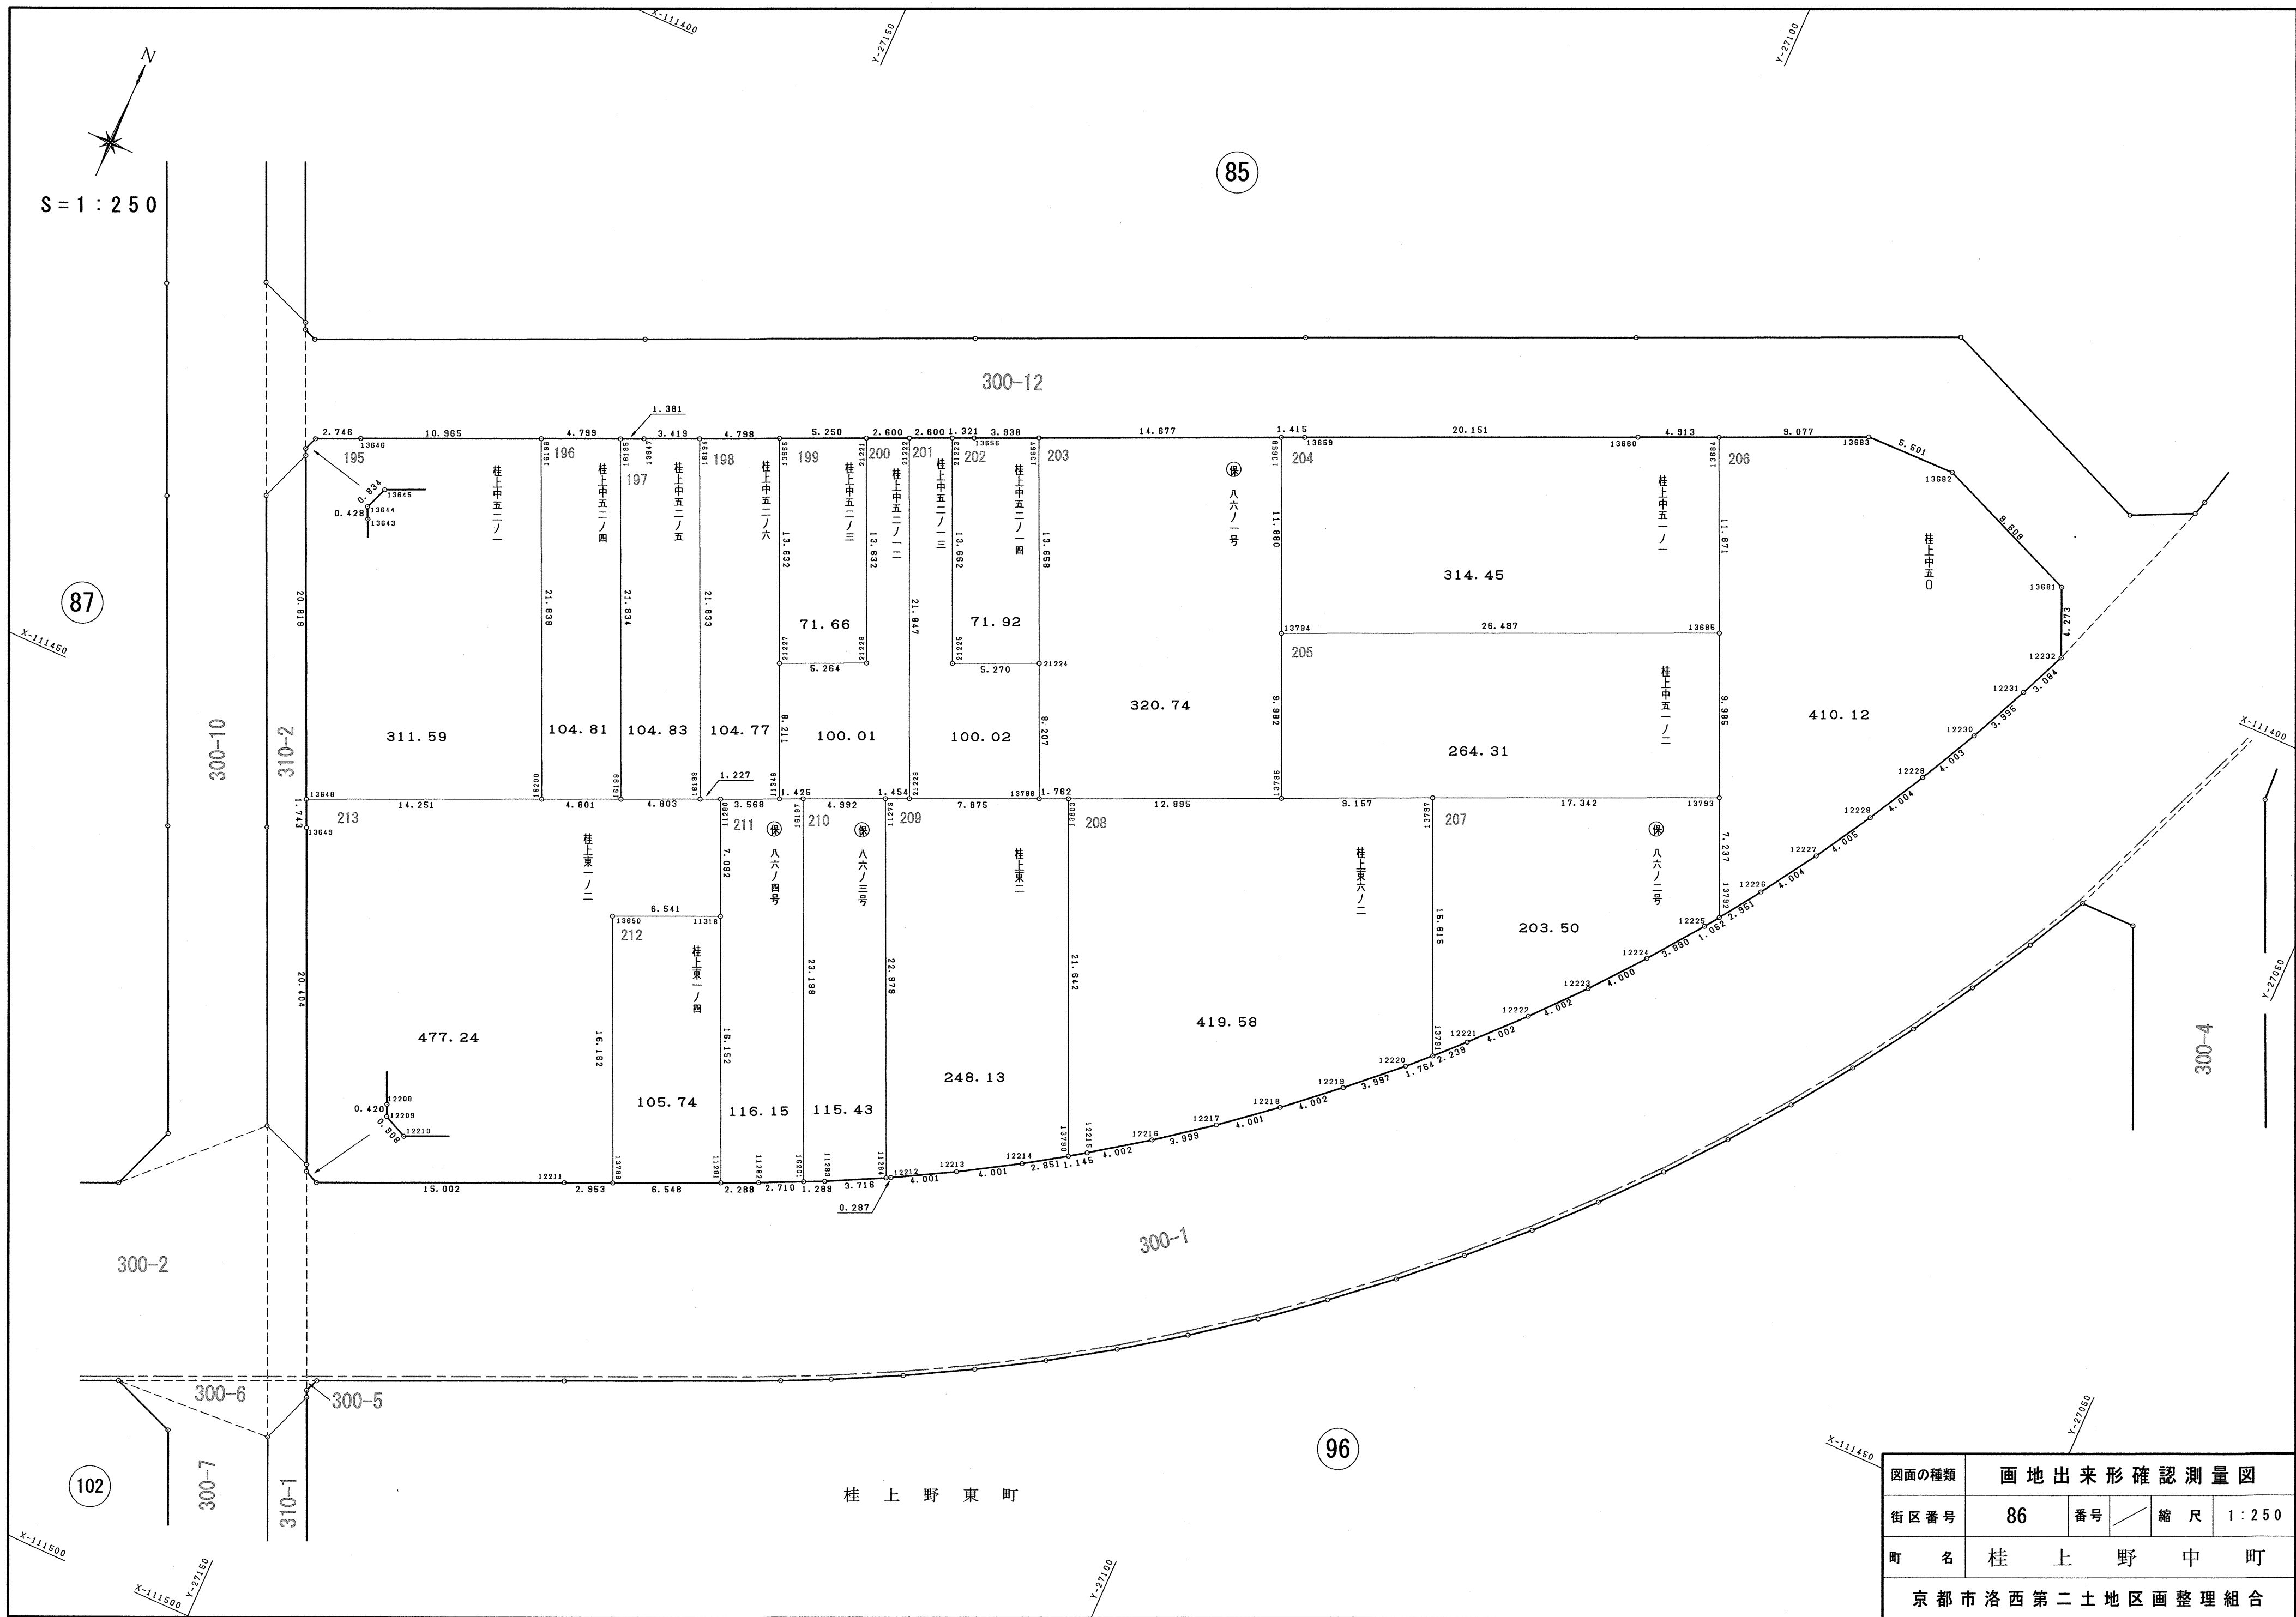

図面の種類	画 地 出 来 形 確 認 測 量 図				
街区 番号	86	番号		縮 尺	1 : 2 5 0
町 名	桂 上 野 中 町				
京 都 市 洛 西 第 二 土 地 区 画 整 理 組 合					

195

地番	桂上中五二ノ一		
N O	X	Y	辺長
13645	-111431.693	-27172.021	
13644	-111432.471	-27172.322	0.834
13643	-111432.858	-27172.140	0.428
13648	-111451.855	-27163.623	20.819
16200	-111446.032	-27150.616	14.251
16196	-111426.087	-27159.509	21.838
13646	-111430.558	-27169.521	10.965
13645	-111431.693	-27172.021	2.746
面積	311.5909185		
地積	311.59㎡		

196

地番	桂上中五二ノ四		
N O	X	Y	辺長
16196	-111426.087	-27159.509	
16200	-111446.032	-27150.616	21.838
16199	-111444.071	-27146.234	4.801
16195	-111424.130	-27155.127	21.834
16196	-111426.087	-27159.509	4.799
面積	104.8116130		
地積	104.81㎡		

197

地番	桂上中五二ノ五		
N O	X	Y	辺長
16195	-111424.130	-27155.127	
16199	-111444.071	-27146.234	21.834
16198	-111442.107	-27141.851	4.803
16194	-111422.168	-27150.746	21.833
13647	-111423.567	-27153.866	3.419
16195	-111424.130	-27155.127	1.381
面積	104.8322125		
地積	104.83㎡		

198

地番	桂上中五二ノ六		
N O	X	Y	辺長
16194	-111422.168	-27150.746	
16198	-111442.107	-27141.851	21.833
11280	-111441.612	-27140.728	1.227
11346	-111440.154	-27137.471	3.568
21227	-111432.655	-27140.815	8.211
13655	-111420.205	-27146.368	13.632
16194	-111422.168	-27150.746	4.798
面積	104.7702770		
地積	104.77㎡		

199

地番	桂上中五二ノ三		
N O	X	Y	辺長
21221	-111418.058	-27141.577	
13655	-111420.205	-27146.368	5.250
21227	-111432.655	-27140.815	13.632
21228	-111430.502	-27136.011	5.264
21221	-111418.058	-27141.577	13.632
面積	71.6674075		
地積	71.66㎡		

200

地番	桂上中五二ノ一二		
N O	X	Y	辺長
21221	-111418.058	-27141.577	
21228	-111430.502	-27136.011	13.632
21227	-111432.655	-27140.815	5.264
11346	-111440.154	-27137.471	8.211
16197	-111439.573	-27136.170	1.425
11279	-111437.529	-27131.616	4.992
21226	-111436.938	-27130.288	1.454
21222	-111416.994	-27139.205	21.847
21221	-111418.058	-27141.577	2.600
面積	100.0182755		
地積	100.01㎡		

201

地番	桂上中五二ノ一三		
N O	X	Y	辺長
21222	-111416.994	-27139.205	
21226	-111436.938	-27130.288	21.847
13796	-111433.736	-27123.093	7.875
21224	-111426.247	-27126.449	8.207
21225	-111428.403	-27131.258	5.270
21223	-111415.930	-27136.833	13.662
21222	-111416.994	-27139.205	2.600
面積	100.0220365		
地積	100.02㎡		

202

地番	桂上中五二ノ一四		
N O	X	Y	辺長
21223	-111415.930	-27136.833	
21225	-111428.403	-27131.258	13.662
21224	-111426.247	-27126.449	5.270
13657	-111413.782	-27132.032	13.658
13656	-111415.390	-27135.627	3.938
21223	-111415.930	-27136.833	1.321
面積	71.9205790		
地積	71.92㎡		

203

地番	保 八六ノ一号		
N O	X	Y	辺長
13658	-111407.789	-27118.634	
13657	-111413.782	-27132.032	14.677
21224	-111426.247	-27126.449	13.658
13796	-111433.736	-27123.093	8.207
13803	-111433.018	-27121.484	1.762
13795	-111427.749	-27109.715	12.895
13794	-111418.633	-27113.783	9.982
13658	-111407.789	-27118.634	11.880
面積	320.7477540		
地積	320.74㎡		

204

地番	桂上中五一ノ一		
N O	X	Y	辺長
13684	-111396.974	-27094.464	
13660	-111398.984	-27098.947	4.913
13659	-111407.211	-27117.342	20.151
13658	-111407.789	-27118.634	1.415
13794	-111418.633	-27113.783	11.880
13685	-111407.807	-27089.609	26.487
13684	-111396.974	-27094.464	11.871
面積	314.4525940		
地積	314.45㎡		

205

地番	桂上中五一ノ二		
N O	X	Y	辺長
13685	-111407.807	-27089.609	
13794	-111418.633	-27113.783	26.487
13795	-111427.749	-27109.715	9.982
13797	-111423.994	-27101.363	9.157
13793	-111416.920	-27085.529	17.342
13685	-111407.807	-27089.609	9.985
面積	264.3125340		
地積	264.31㎡		

206

地番	桂上中五〇		
N O	X	Y	辺長
13681	-111396.818	-27071.792	
13682	-111393.174	-27080.682	9.608
13683	-111393.259	-27086.182	5.501
13684	-111396.974	-27094.464	9.077
13685	-111407.807	-27089.609	11.871
13793	-111416.920	-27085.529	9.985
13792	-111423.528	-27082.578	7.237
12226	-111421.101	-27080.899	2.951
12227	-111417.732	-27078.736	4.004
12228	-111414.289	-27076.690	4.005
12229	-111410.773	-27074.775	4.004
12230	-111407.203	-27072.965	4.003
12231	-111403.571	-27071.301	3.995
12232	-111400.736	-27070.086	3.084
13681	-111396.818	-27071.792	4.273
面積	410.1234100		
地積	410.12㎡		

207

地番	保 八六ノ二号		
N O	X	Y	辺長
13793	-111416.920	-27085.529	
13797	-111423.994	-27101.363	17.342
13791	-111438.251	-27094.995	15.615
12221	-111436.657	-27093.422	2.239
12222	-111433.732	-27090.691	4.002
12223	-111430.708	-27088.069	4.002
12224	-111427.589	-27085.565	4.000
12225	-111424.393	-27083.177	3.990
13792	-111423.528	-27082.578	1.052
13793	-111416.920	-27085.529	7.237
面積	203.5097710		
地積	203.50㎡		

208

地番	桂上東六ノ二		
N O	X	Y	辺長
13797	-111423.994	-27101.363	
13795	-111427.749	-27109.715	9.157
13803	-111433.018	-27121.484	12.895
13790	-111452.778	-27112.657	21.642
12215	-111452.147	-27111.702	1.145
12216	-111449.843	-27108.430	4.002
12217	-111447.428	-27105.242	3.999
12218	-111444.889	-27102.150	4.001
12219	-111442.239	-27099.151	4.002
12220	-111439.507	-27096.234	3.997
13791	-111438.251	-27094.995	1.764
13797	-111423.994	-27101.363	15.615
面積	419.5858280		
地積	419.58㎡		

209

地番	桂上東二		
N O	X	Y	辺長
13803	-111433.018	-27121.484	
13796	-111433.736	-27123.093	1.762
21226	-111436.938	-27130.288	7.875
11279	-111437.529	-27131.616	1.454
11284	-111458.496	-27122.212	22.979
12212	-111458.365	-27121.957	0.287
12213	-111456.424	-27118.458	4.001
12214	-111454.350	-27115.036	4.001
13790	-111452.778	-27112.657	2.851
13803	-111433.018	-27121.484	21.642
面積	248.1357110		
地積	248.13㎡		

210

地番	保 八六ノ三号		
N O	X	Y	辺長
11279	-111437.529	-27131.616	
16197	-111439.573	-27136.170	4.992
16201	-111460.743	-27126.684	23.198
11283	-111460.197	-27125.516	1.289
11284	-111458.496	-27122.212	3.716
11279	-111437.529	-27131.616	22.979
面積	115.4377800		
地積	115.43㎡		

211


地番	保 八六ノ四号		
N O	X	Y	辺長
11280	-111441.612	-27140.728	
11318	-111448.088	-27137.837	7.092
11281	-111462.826	-27131.227	16.152
11282	-111461.891	-27129.139	2.288
16201	-111460.743	-27126.684	2.710
16197	-111439.573	-27136.170	23.198
11346	-111440.154	-27137.471	1.425
11280	-111441.612	-27140.728	3.568
面積	116.1527705		
地積	116.15㎡		

212


地番	桂上東一ノ四		
N O	X	Y	辺長
11318	-111448.088	-27137.837	
13650	-111450.753	-27143.811	6.541
13788	-111465.502	-27137.203	16.162
11281	-111462.826	-27131.227	6.548
11318	-111448.088	-27137.837	16.152
面積	105.7417470		
地積	105.74㎡		

213


地番	桂上東一ノ二		
N O	X	Y	辺長
1280	-111441.612	-27140.728	
16198	-111442.107	-27141.851	1.227
16199	-111444.071	-27146.234	4.803
16200	-111446.032	-27150.616	4.801
13648	-111451.855	-27163.623	14.251
13649	-111453.446	-27162.910	1.743
12208	-111472.071	-27154.577	20.404
12209	-111472.458	-27154.413	0.420
12210	-111472.841	-27153.590	0.908
12211	-111466.709	-27139.898	15.002
3788	-111465.502	-27137.203	2.953
13650	-111450.753	-27143.811	16.162
1318	-111448.088	-27137.837	6.541
1280	-111441.612	-27140.728	7.092
面積	477.2410400		
地積	477.24 m ²		

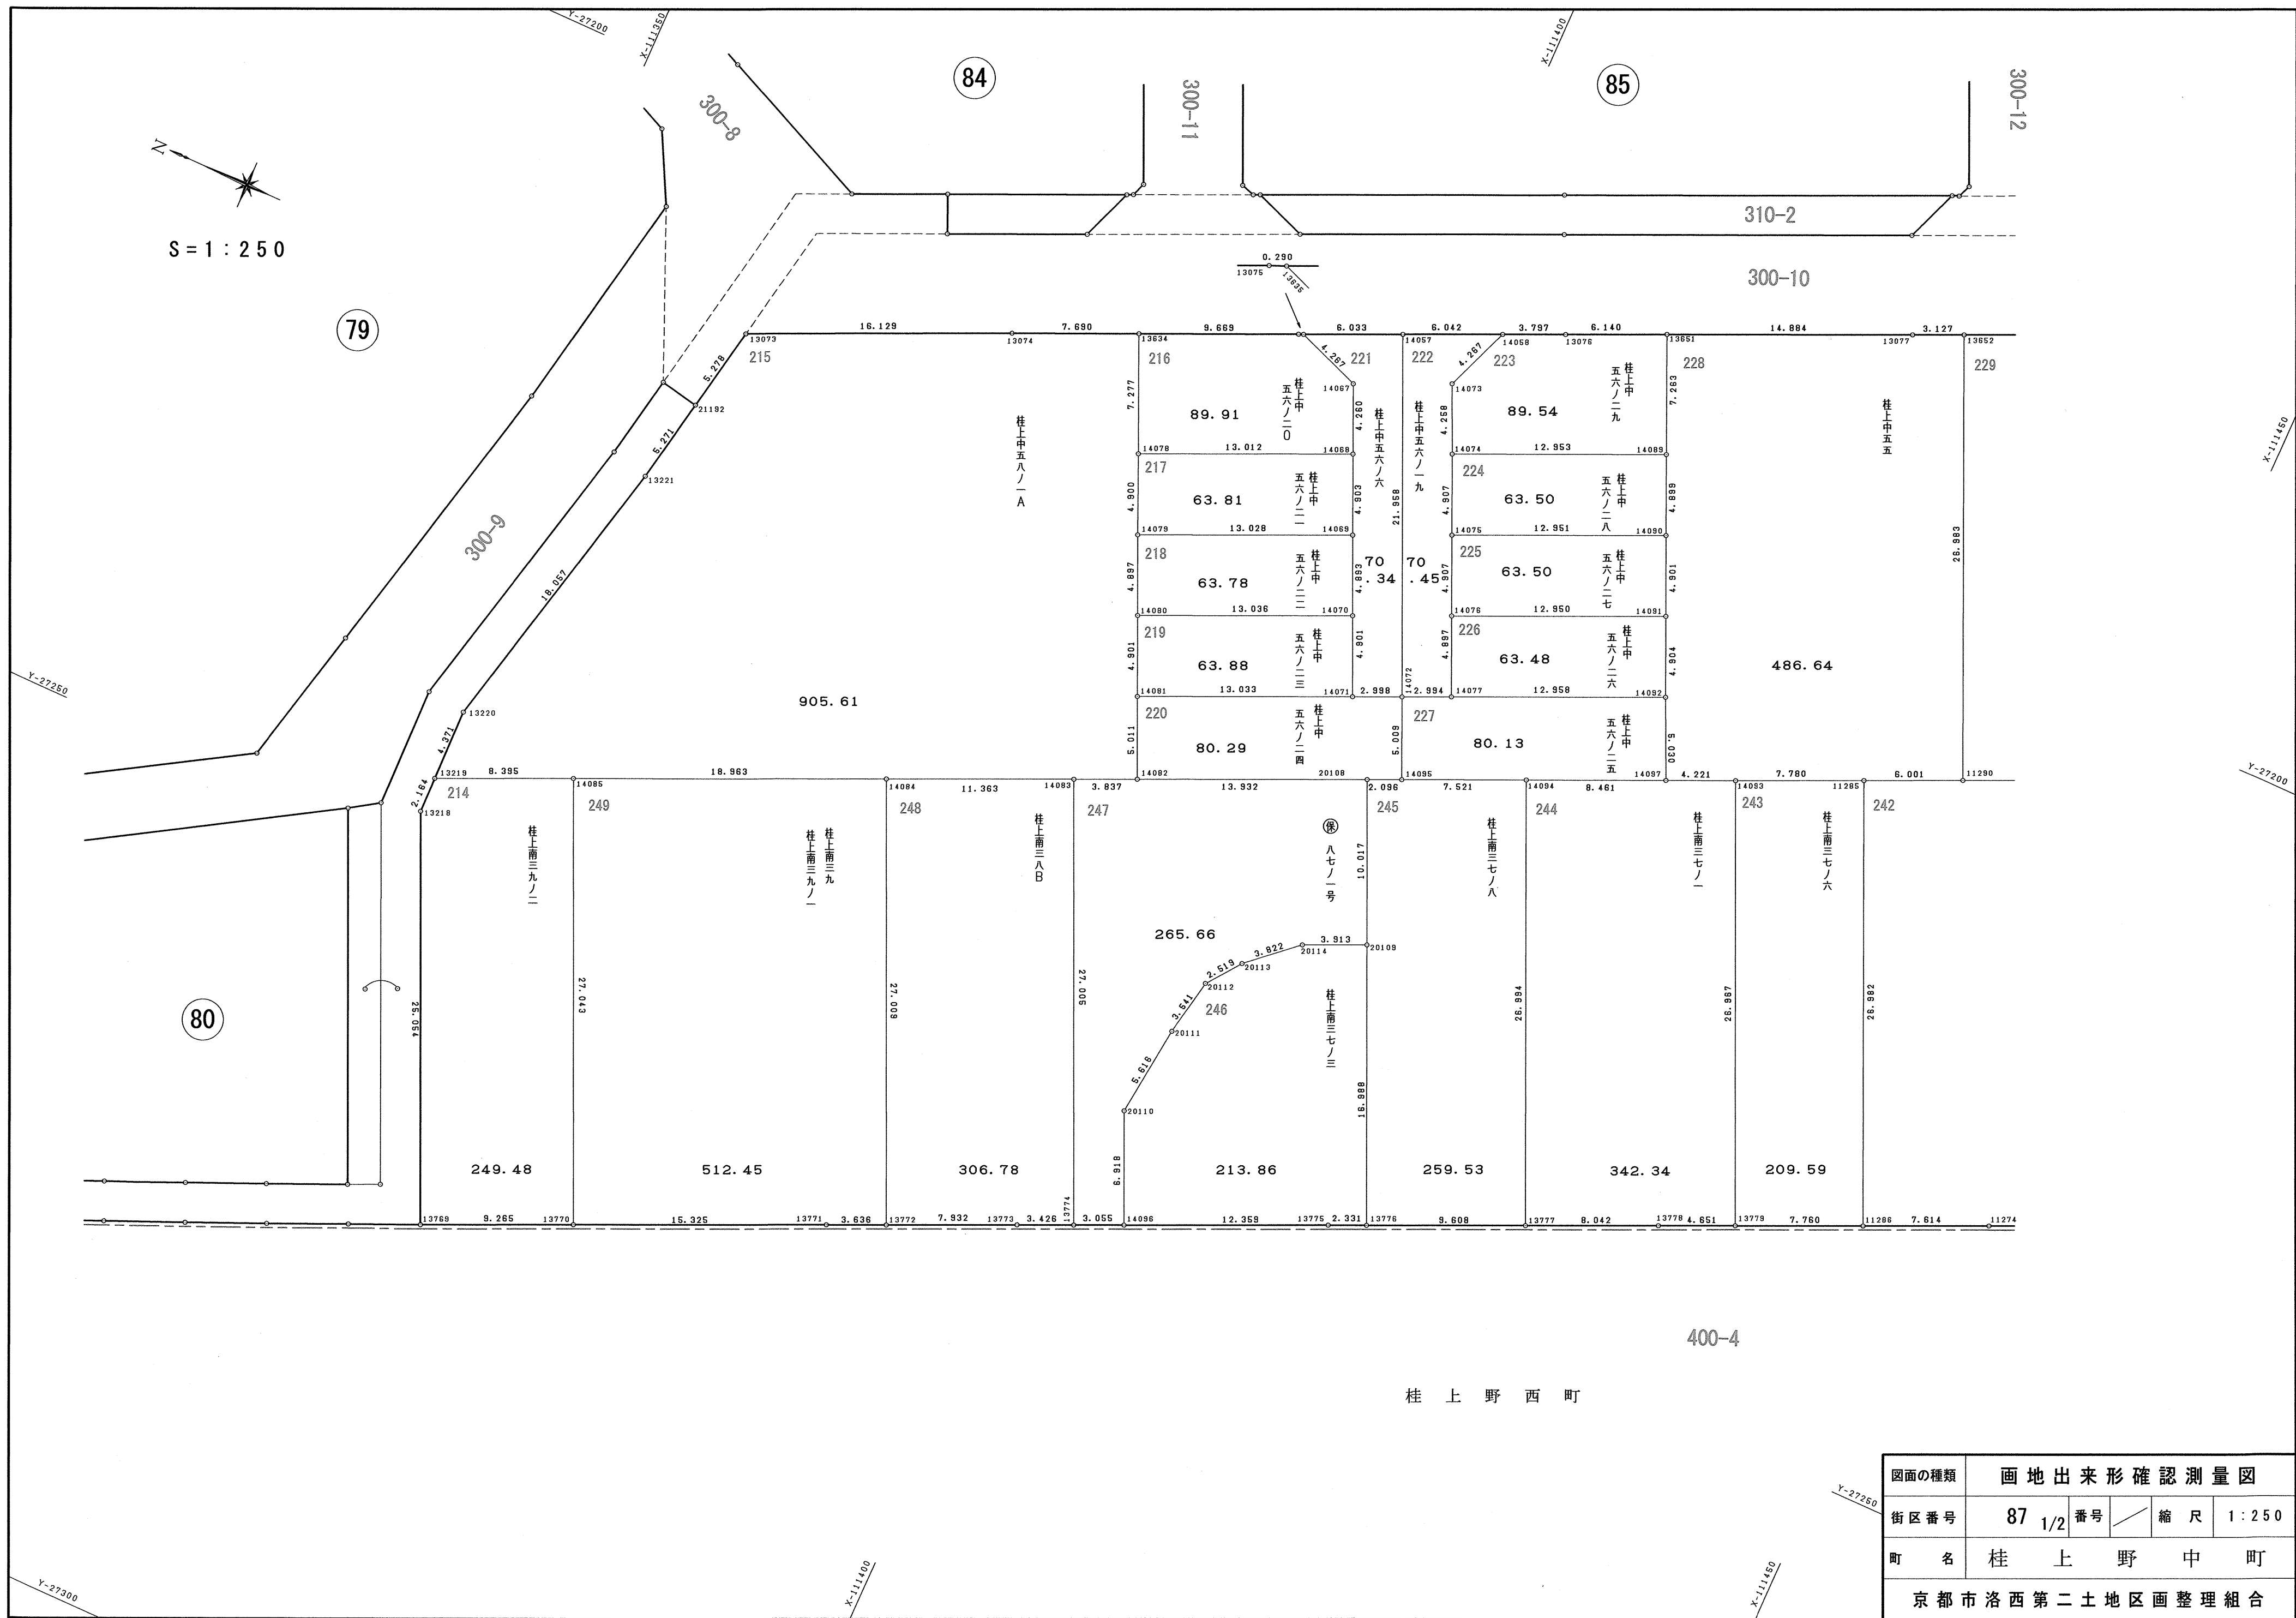

図面の種類	画地出来形確認測量図				
街区番号	87	1/2	番号		縮尺 1 : 250
町名	桂上野中町				
京都市洛西第二土地区画整理組合					

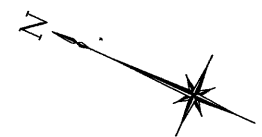

S = 1 : 250

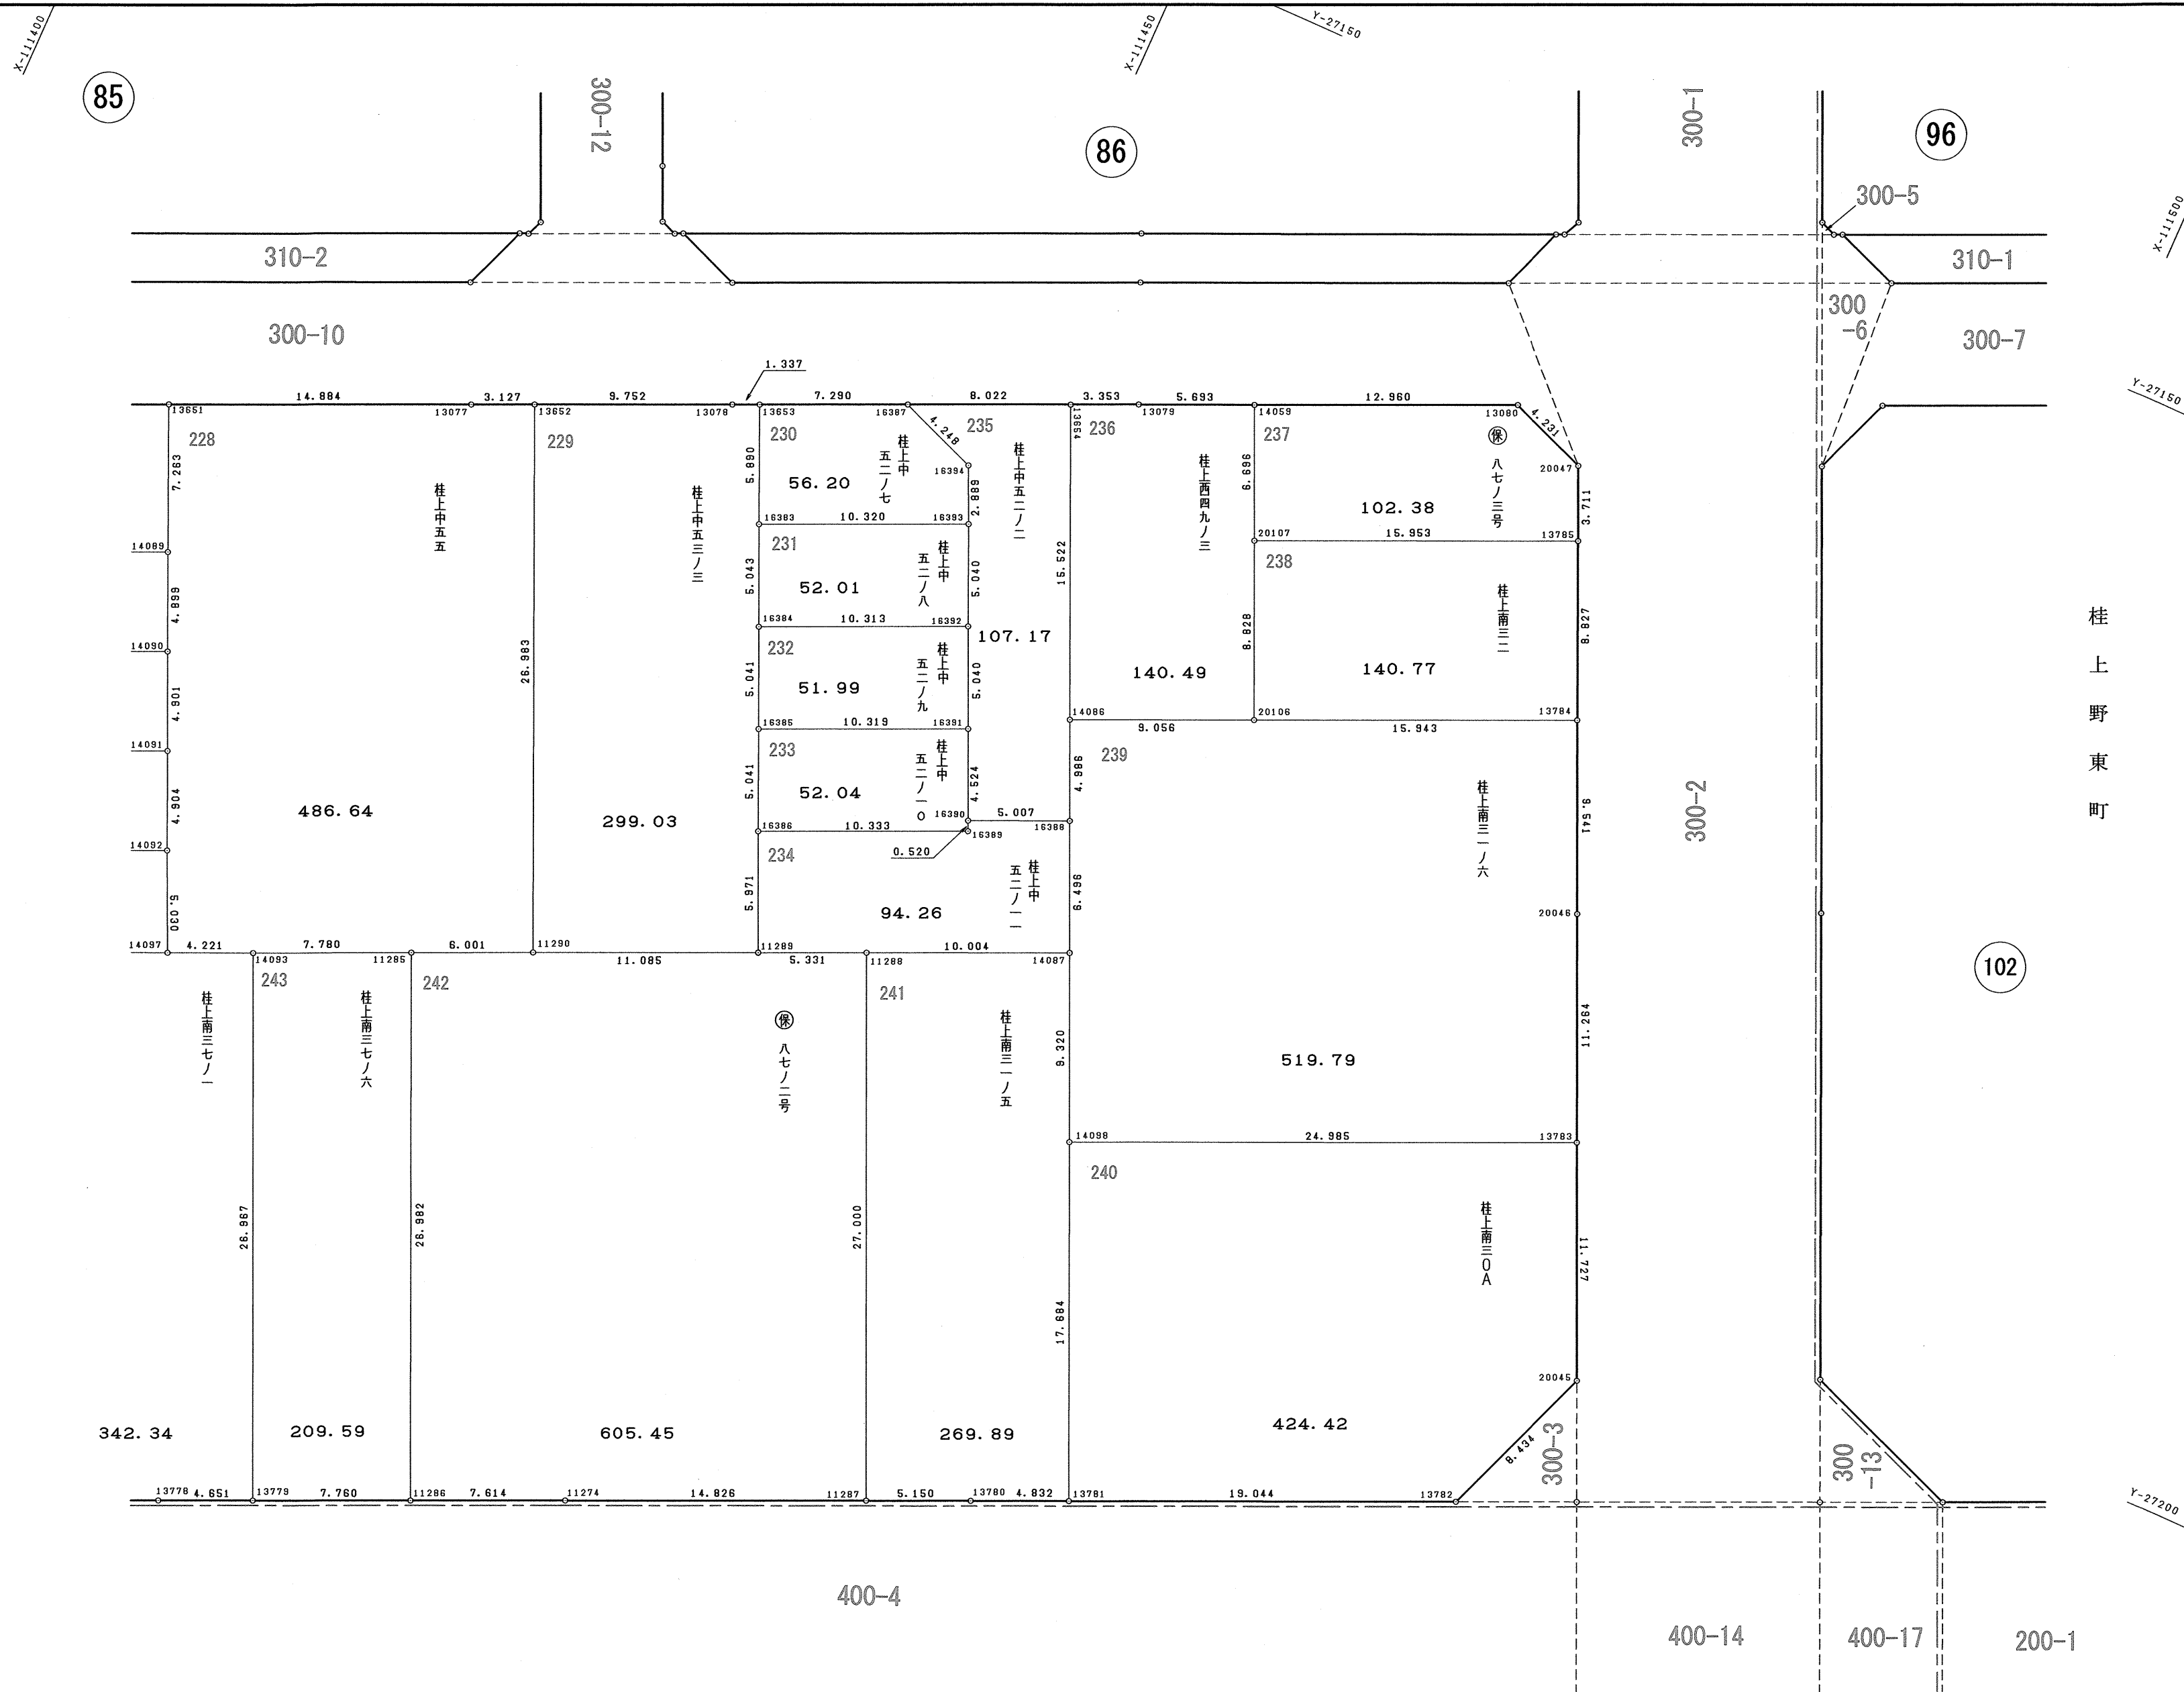

図面の種類	画 地 出 来 形 確 認 測 量 図				
街区番号	87	2/2	番号	縮 尺	1 : 2 5 0
町 名	桂 上 野 中 町				
京 都 市 洛 西 第 二 土 地 区 画 整 理 組 合					

214

地番	桂上南三九ノ二		
N O	X	Y	辺長
13219	-111356.151	-27245.288	
13218	-111356.186	-27247.452	2.164
13769	-111366.450	-27270.307	25.054
13770	-111374.900	-27266.508	9.265
14085	-111363.807	-27241.845	27.043
13219	-111356.151	-27245.288	8.395
面積	249.4804745		
地積	249.48㎡		

215

地番	桂上中五八ノ一A		
N O	X	Y	辺長
13073	-111362.272	-27212.997	
21192	-111361.269	-27218.179	5.278
13221	-111360.264	-27223.353	5.271
13220	-111356.079	-27240.918	18.057
13219	-111356.151	-27245.288	4.371
14085	-111363.807	-27241.845	8.395
14084	-111381.117	-27234.101	18.963
14083	-111391.486	-27229.454	11.363
14082	-111394.989	-27227.888	3.837
14081	-111392.943	-27223.314	5.011
14080	-111390.940	-27218.841	4.901
14079	-111388.943	-27214.370	4.897
14078	-111386.959	-27209.890	4.900
13634	-111384.001	-27203.241	7.277
13074	-111376.973	-27206.362	7.690
13073	-111362.272	-27212.997	16.129
面積	905.6159165		
地積	905.61㎡		

216

地番	桂上中五六ノ二〇		
N O	X	Y	辺長
13634	-111384.001	-27203.241	
14078	-111386.959	-27209.890	7.277
14088	-111398.838	-27204.579	13.012
14067	-111397.101	-27200.689	4.260
13635	-111393.103	-27199.197	4.267
13075	-111392.838	-27199.316	0.290
13634	-111384.001	-27203.241	9.669
面積	89.9109255		
地積	89.91㎡		

217

地番	桂上中五六ノ二一		
N O	X	Y	辺長
14078	-111386.959	-27209.890	
14079	-111388.943	-27214.370	4.900
14069	-111400.838	-27209.056	13.028
14068	-111398.838	-27204.579	4.903
14078	-111386.959	-27209.890	13.012
面積	63.8184295		
地積	63.81㎡		

218

地番	桂上中五六ノ二二		
N O	X	Y	辺長
14079	-111388.943	-27214.370	
14080	-111390.940	-27218.841	4.897
14070	-111402.841	-27213.520	13.036
14069	-111400.838	-27209.056	4.893
14079	-111388.943	-27214.370	13.028
面積	63.7893150		
地積	63.78㎡		

219

地番	桂上中五六ノ二三		
N O	X	Y	辺長
14080	-111390.940	-27218.841	
14081	-111392.943	-27223.314	4.901
14071	-111404.841	-27217.994	13.033
14070	-111402.841	-27213.520	4.901
14080	-111390.940	-27218.841	13.036
面積	63.8813940		
地積	63.88㎡		

220

地番	桂上中五六ノ二四		
N O	X	Y	辺長
14081	-111392.943	-27223.314	
14082	-111394.989	-27227.888	5.011
20108	-111407.706	-27222.199	13.932
14095	-111409.619	-27221.343	2.096
14072	-111407.577	-27216.769	5.009
14071	-111404.841	-27217.994	2.998
14081	-111392.943	-27223.314	13.033
面積	80.2963305		
地積	80.29㎡		

221

地番	桂上中五六ノ六		
N O	X	Y	辺長
13635	-111393.103	-27199.197	
14067	-111397.101	-27200.689	4.267
14068	-111398.838	-27204.579	4.260
14069	-111400.838	-27209.056	4.903
14070	-111402.841	-27213.520	4.893
14071	-111404.841	-27217.994	4.901
14072	-111407.577	-27216.769	2.998
14057	-111398.607	-27196.727	21.958
13635	-111393.103	-27199.197	6.033
面積	70.3496120		
地積	70.34㎡		

222

地番	桂上中五六ノ一九		
N O	X	Y	辺長
14057	-111398.607	-27196.727	
14072	-111407.577	-27216.769	21.958
14077	-111410.309	-27215.544	2.994
14076	-111408.313	-27211.072	4.897
14075	-111406.312	-27206.592	4.907
14074	-111404.312	-27202.111	4.907
14073	-111402.566	-27198.227	4.258
14058	-111404.119	-27194.253	4.267
14057	-111398.607	-27196.727	6.042
面積	70.4552840		
地積	70.45㎡		

223

地番	桂上中五六ノ二九		
N O	X	Y	辺長
14058	-111404.119	-27194.253	
14073	-111402.566	-27198.227	4.267
14074	-111404.312	-27202.111	4.258
14089	-111416.136	-27196.823	12.953
13651	-111413.186	-27190.186	7.263
13076	-111407.583	-27192.698	6.140
14058	-111404.119	-27194.253	3.797
面積	89.5452290		
地積	89.54㎡		

224

地番	桂上中五六ノ二八		
N O	X	Y	辺長
14074	-111404.312	-27202.111	
14075	-111406.312	-27206.592	4.907
14090	-111418.131	-27201.297	12.951
14089	-111416.136	-27196.823	4.899
14074	-111404.312	-27202.111	12.953
面積	63.5005375		
地積	63.50㎡		

225

地番	桂上中五六ノ二七		
N O	X	Y	辺長
14075	-111406.312	-27206.592	
14076	-111408.313	-27211.072	4.907
14091	-111420.129	-27205.772	12.950
14090	-111418.131	-27201.297	4.901
14075	-111406.312	-27206.592	12.951
面積	63.5052075		
地積	63.50㎡		

226

地番	桂上中五六ノ二六		
N O	X	Y	辺長
14076	-111408.313	-27211.072	
14077	-111410.309	-27215.544	4.897
14092	-111422.135	-27210.247	12.958
14091	-111420.129	-27205.772	4.904
14076	-111408.313	-27211.072	12.950
面積	63.4835420		
地積	63.48㎡		

227

地番	桂上中五六ノ二五		
N O	X	Y	辺長
14072	-111407.577	-27216.769	
14095	-111409.619	-27221.343	5.009
14094	-111416.486	-27218.275	7.521
14097	-111424.213	-27214.828	8.461
14092	-111422.135	-27210.247	5.030
14077	-111410.309	-27215.544	12.958
14072	-111407.577	-27216.769	2.994
面積	80.1395295		
地積	80.13㎡		

228

地番	桂上中五五		
N O	X	Y	辺長
13651	-111413.186	-27190.186	
14089	-111416.136	-27196.823	7.263
14090	-111418.131	-27201.297	4.899
14091	-111420.129	-27205.772	4.901
14092	-111422.135	-27210.247	4.904
14097	-111424.213	-27214.828	5.030
14093	-111428.070	-27213.113	4.221
11285	-111435.163	-27209.916	7.780
11290	-111440.634	-27207.450	6.001
13652	-111429.620	-27182.817	26.983
13077	-111426.767	-27184.096	3.127
13651	-111413.186	-27190.186	14.884
面積	486.6424635		
地積	486.64㎡		

229

地番	桂上中五三ノ三		
N O	X	Y	辺長
13652	-111429.620	-27182.817	
11290	-111440.634	-27207.450	26.983
11289	-111450.750	-27202.918	11.085
16386	-111448.310	-27197.468	5.971
16385	-111446.251	-27192.867	5.041
16384	-111444.196	-27188.264	5.041
16383	-111442.132	-27183.663	5.043
13653	-111439.739	-27178.281	5.890
13078	-111438.519	-27178.828	1.337
13652	-111429.620	-27182.817	9.752
面積	299.0382305		
地積	299.03㎡		

230

地番	桂上中五二ノ七		
N O	X	Y	辺長
13653	-111439.739	-27178.281	
16383	-111442.132	-27183.663	5.890
16393	-111451.548	-27179.438	10.320
16394	-111450.361	-27176.804	2.889
16387	-111446.390	-27175.296	4.248
13653	-111439.739	-27178.281	7.290
面積	56.2010135		
地積	56.20㎡		

231

地番	桂上中五二ノ八		
N O	X	Y	辺長
16383	-111442.132	-27183.663	
16384	-111444.196	-27188.264	5.043
16392	-111453.604	-27184.040	10.313
16393	-111451.548	-27179.438	5.040
16383	-111442.132	-27183.663	10.320
面積	52.0117880		
地積	52.01㎡		

232

地番	桂上中五二ノ九		
N O	X	Y	辺長
16384	-111444.196	-27188.264	
16385	-111446.251	-27192.867	5.041
16391	-111455.664	-27188.640	10.319
16392	-111453.604	-27184.040	5.040
16384	-111444.196	-27188.264	10.313
面積	51.9963820		
地積	51.99㎡		

233

地番	桂上中五二ノ一〇		
N O	X	Y	辺長
16385	-111446.251	-27192.867	
16386	-111448.310	-27197.468	5.041
16389	-111457.737	-27193.238	10.333
16390	-111457.517	-27192.767	0.520
16391	-111455.664	-27188.640	4.524
16385	-111446.251	-27192.867	10.319
面積	52.0457825		
地積	52.04㎡		

234

地番	
----	--

242

地番	保 八七ノ二号		
N O	X	Y	辺 長
11285	-111435.163	-27209.916	
11286	-111446.187	-27234.543	26.982
11274	-111453.135	-27231.428	7.614
11287	-111466.669	-27225.376	14.826
11288	-111455.617	-27200.742	27.000
11289	-111450.750	-27202.918	5.331
11290	-111440.634	-27207.450	11.085
11285	-111435.163	-27209.916	6.001
面積	605.4532150		
地積	605.45 m ²		

243

地番	桂上南三七ノ六		
N O	X	Y	辺 長
14093	-111428.070	-27213.113	
13779	-111439.106	-27237.718	26.967
11286	-111446.187	-27234.543	7.760
11285	-111435.163	-27209.916	26.982
14093	-111428.070	-27213.113	7.780
面積	209.5951720		
地積	209.59 m ²		

244

地番	桂上南三七ノ一		
N O	X	Y	辺 長
14094	-111416.486	-27218.275	
13777	-111427.523	-27242.910	26.994
13778	-111434.862	-27239.621	8.042
13779	-111439.106	-27237.718	4.651
14093	-111428.070	-27213.113	26.967
14097	-111424.213	-27214.828	4.221
14094	-111416.486	-27218.275	8.461
面積	342.3471680		
地積	342.34 m ²		

245

地番	桂上南三七ノ八		
N O	X	Y	辺 長
20108	-111407.706	-27222.199	
20109	-111411.805	-27231.339	10.017
13776	-111418.755	-27246.840	16.988
13777	-111427.523	-27242.910	9.608
14094	-111416.486	-27218.275	26.994
14095	-111409.619	-27221.343	7.521
20108	-111407.706	-27222.199	2.096
面積	259.5364075		
地積	259.53 m ²		

246

地番	桂上南三七ノ三		
N O	X	Y	辺 長
14096	-111405.346	-27252.838	
13775	-111416.628	-27247.793	12.359
13776	-111418.755	-27246.840	2.331
20109	-111411.805	-27231.339	16.988
20114	-111408.234	-27232.938	3.913
20113	-111405.367	-27235.466	3.822
20112	-111403.847	-27237.475	2.519
20111	-111403.170	-27240.951	3.541
20110	-111402.509	-27246.528	5.616
14096	-111405.346	-27252.838	6.918
面積	213.8624245		
地積	213.86 m ²		

247

地番	保 八七ノ一号		
N O	X	Y	辺 長
13774	-111402.557	-27254.085	
14096	-111405.346	-27252.838	3.055
20110	-111402.509	-27246.528	6.918
20111	-111403.170	-27240.951	5.616
20112	-111403.847	-27237.475	3.541
20113	-111405.367	-27235.466	2.519
20114	-111408.234	-27232.938	3.822
20109	-111411.805	-27231.339	3.913
20108	-111407.706	-27222.199	10.017
14082	-111394.989	-27227.888	13.932
14083	-111391.486	-27229.454	3.837
13774	-111402.557	-27254.085	27.005
面積	265.6626415		
地積	265.66 m ²		


248

地番	桂上南三八B		
N O	X	Y	辺 長
14084	-111381.117	-27234.101	
13772	-111392.194	-27258.734	27.009
13773	-111399.430	-27255.484	7.932
13774	-111402.557	-27254.085	3.426
14083	-111391.486	-27229.454	27.005
14084	-111381.117	-27234.101	11.363
面積	306.7874710		
地積	306.78 m ²		

249

地番	桂上南三九、桂上南三九ノ一		
N O	X	Y	辺 長
14085	-111363.807	-27241.845	
13770	-111374.900	-27266.508	27.043
13771	-111388.877	-27260.224	15.325
13772	-111392.194	-27258.734	3.636
14084	-111381.117	-27234.101	27.009
14085	-111363.807	-27241.845	18.963
面積	512.4590620		
地積	512.45 m ²		

図面の種類	画 地 面 積 求 積 表				
街区番号	87	番号	$\frac{2}{2}$	縮 尺	
町 名	桂 上 野 中 町				
京都市洛西第二土地区画整理組合					

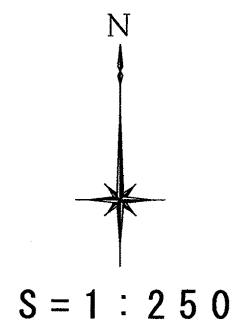

桂
上
野
中
町

310-1

300-1

82

300-11

85

91

300-3

89

桂
上
野
中
町
合
計

上
前
川
四
ノ
二

上
前
川
四
ノ
〇

上
前
川
四
ノ
三

上
前
川
四
ノ
八

上
前
川
四
ノ
七

図面の種類	画地出来形確認測量図				
街区番号	88	番号	／	縮尺	1：250
町名	桂上野東町				
京都市洛西第二土地区画整理組合					

103

地番	桂上中三三		
N O	X	Y	辺 長
13907	-111280.143	-27047.973	
12253	-111297.757	-27047.889	17.614
12254	-111315.493	-27047.803	17.736
13908	-111318.866	-27044.958	4.413
14265	-111320.997	-27028.690	16.407
14266	-111321.171	-27027.350	1.351
14260	-111280.141	-27027.414	41.030
13907	-111280.143	-27047.973	20.559
面積	809.2340675		
地積	809.23㎡		

104

地番	桂上中三一、三二 合地B		
N O	X	Y	辺 長
16055	-111250.610	-27048.171	
12251	-111250.617	-27048.171	0.007
12252	-111274.620	-27047.999	24.004
13907	-111280.143	-27047.973	5.523
14260	-111280.141	-27027.414	20.559
14259	-111280.134	-27026.363	1.051
14261	-111274.010	-27031.141	7.767
14264	-111258.291	-27042.582	19.442
14262	-111254.799	-27045.132	4.324
14263	-111250.636	-27048.152	5.143
16055	-111250.610	-27048.171	0.032
面積	315.2098680		
地積	315.20㎡		

105

地番	上前川二〇ノ二		
N O	X	Y	辺 長
14260	-111280.141	-27027.414	
14266	-111321.171	-27027.350	41.030
14267	-111321.640	-27023.722	3.658
30001	-111300.700	-27023.751	20.940
14258	-111283.454	-27023.774	17.246
14259	-111280.134	-27026.363	4.210
14260	-111280.141	-27027.414	1.051
面積	145.5702585		
地積	145.57㎡		

106-1

地番	上前川四三		
N O	X	Y	辺 長
30001	-111300.700	-27023.751	
14267	-111321.640	-27023.722	20.940
14268	-111322.322	-27018.457	5.309
30002	-111301.381	-27018.498	20.941
30001	-111300.700	-27023.751	5.297
面積	110.1022370		
地積	110.10㎡		

106-2

地番	上前川四〇		
N O	X	Y	辺 長
14258	-111283.454	-27023.774	
30001	-111300.700	-27023.751	17.246
30002	-111301.381	-27018.498	5.297
14255	-111290.299	-27018.520	11.082
14256	-111287.178	-27020.991	3.981
14257	-111283.873	-27023.447	4.118
14258	-111283.454	-27023.774	0.531
面積	74.0936115		
地積	74.09㎡		


107

地番	上前川四七ノ八		
N O	X	Y	辺 長
14255	-111290.299	-27018.520	
30002	-111301.381	-27018.498	11.082
14268	-111322.322	-27018.457	20.941
21134	-111323.450	-27009.746	8.784
21135	-111301.325	-27009.790	22.125
14255	-111290.299	-27018.520	14.064
面積	235.7705275		
地積	235.77㎡		

108

地番	上前川四七ノ一		
N O	X	Y	辺 長
21134	-111323.450	-27009.746	
14269	-111323.659	-27008.908	0.845
14270	-111325.826	-26991.393	17.661
14253	-111309.836	-27003.417	20.006
14254	-111304.665	-27007.145	6.375
21135	-111301.325	-27009.790	4.260
21134	-111323.450	-27009.746	22.125
面積	203.3793755		
地積	203.37㎡		

図面の種類	画 地 面 積 求 積 表				
街区 番号	88	番号	／	縮 尺	
町 名	桂 上 野 東 町				
京都市洛西第二土地区画整理組合					

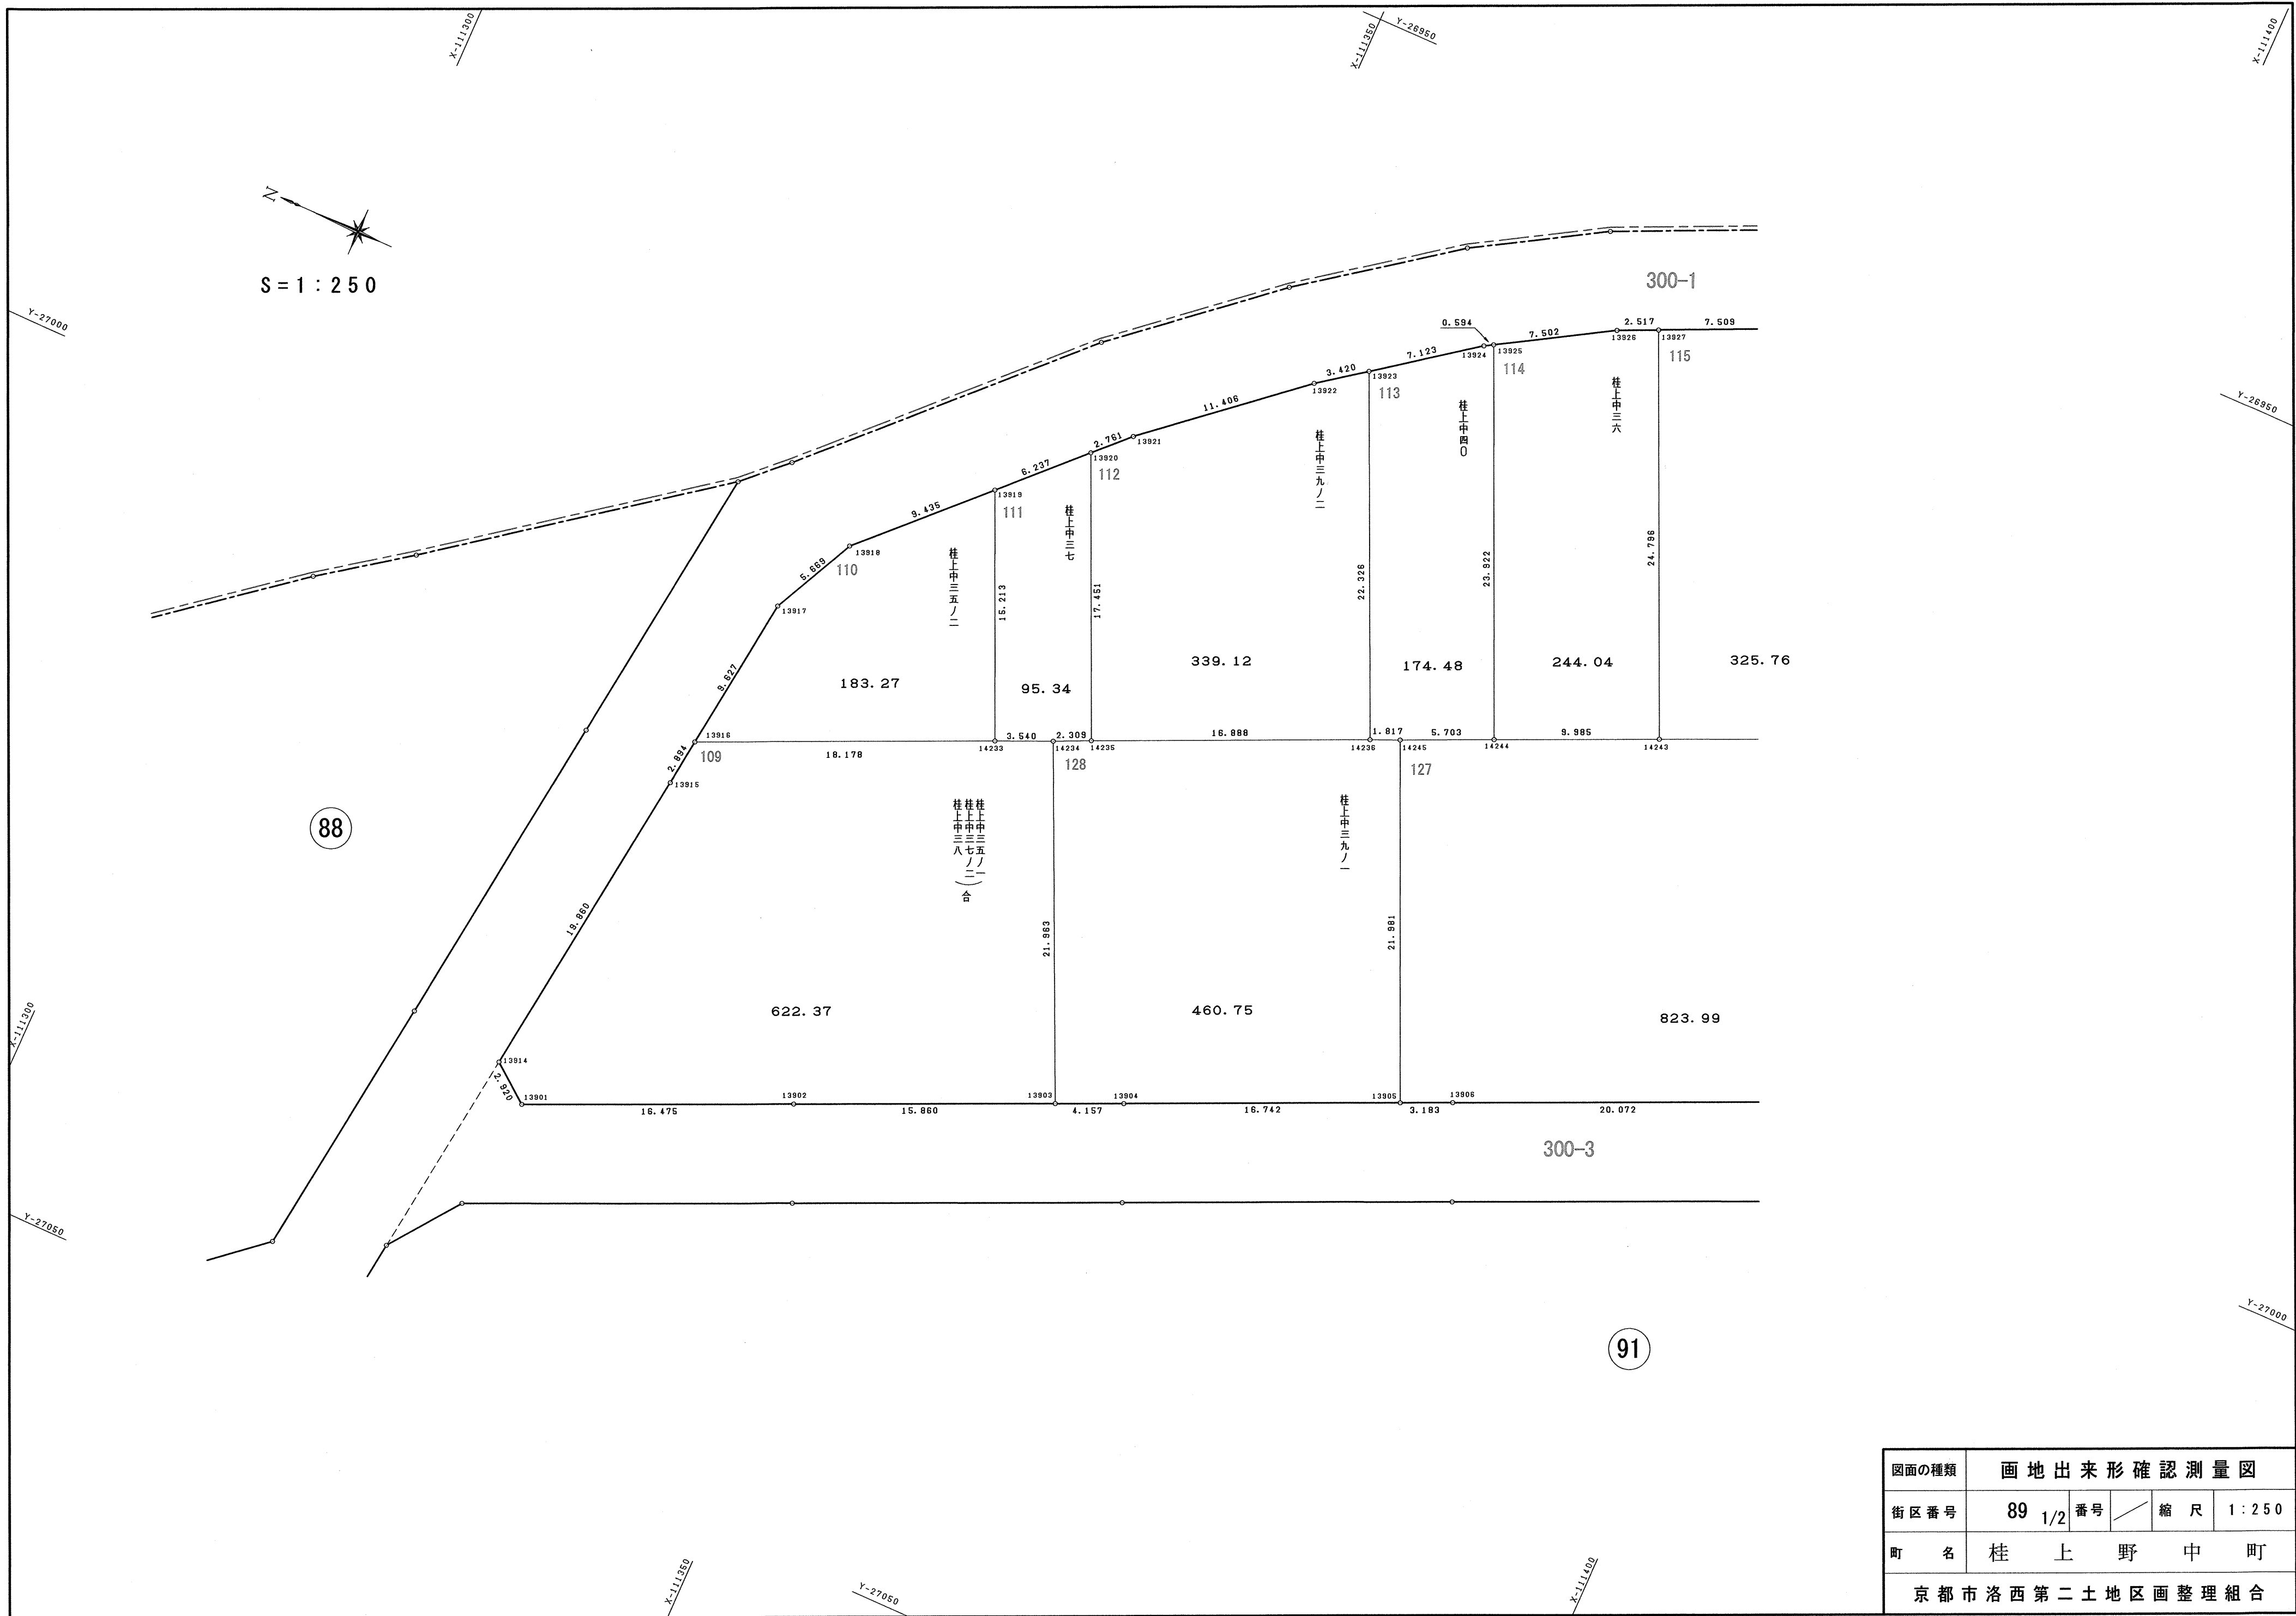

図面の種類	画地出来形確認測量図				
街区番号	89	1/2	番号		縮尺 1 : 250
町名	桂上野中町				
京都市洛西第二土地区画整理組合					

S = 1 : 250



図面の種類	画地出来形確認測量図				
街区番号	89	2/2	番号	縮尺	1 : 250
町名	桂上野中町				
京都市洛西第二土地区画整理組合					

109			
地番	桂上中三五ノ一、三七ノ二、三八 合地		
N O	X	Y	辺長
13916	-111329.876	-27006.860	
13915	-111329.507	-27009.730	2.894
13914	-111326.942	-27029.424	19.860
13901	-111329.251	-27031.212	2.920
13902	-111344.285	-27024.473	16.475
13903	-111358.759	-27017.990	15.860
14234	-111349.697	-26997.984	21.963
14233	-111346.461	-26999.419	3.540
13916	-111329.876	-27006.860	18.178
面積	622.3724225		
地積	622.37 m ²		

110			
地番	桂上中三五ノ二		
N O	X	Y	辺長
13918	-111333.602	-26992.222	
13917	-111331.105	-26997.312	5.669
13916	-111329.876	-27006.860	9.627
14233	-111346.461	-26999.419	18.178
13919	-111340.253	-26985.530	15.213
13918	-111333.602	-26992.222	9.435
面積	183.2757425		
地積	183.27 m ²		

111			
地番	桂上中三七		
N O	X	Y	辺長
13919	-111340.253	-26985.530	
14233	-111346.461	-26999.419	15.213
14234	-111349.697	-26997.984	3.540
14235	-111351.798	-26997.026	2.309
13920	-111344.650	-26981.106	17.451
13919	-111340.253	-26985.530	6.237
面積	95.3447410		
地積	95.34 m ²		

112			
地番	桂上中三九ノ二		
N O	X	Y	辺長
13920	-111344.650	-26981.106	
14235	-111351.798	-26997.026	17.451
14236	-111367.201	-26990.102	16.888
13923	-111358.047	-26969.739	22.326
13922	-111355.297	-26971.773	3.420
13921	-111346.596	-26979.148	11.406
13920	-111344.650	-26981.106	2.761
面積	339.1298505		
地積	339.12 m ²		

113			
地番	桂上中四〇		
N O	X	Y	辺長
13923	-111358.047	-26969.739	
14236	-111367.201	-26990.102	22.326
14245	-111368.866	-26989.374	1.817
14244	-111374.065	-26987.031	5.703
13925	-111364.284	-26965.200	23.922
13924	-111363.774	-26965.504	0.594
13923	-111358.047	-26969.739	7.123
面積	174.4872685		
地積	174.48 m ²		

114			
地番	桂上中三六		
N O	X	Y	辺長
13925	-111364.284	-26965.200	
14244	-111374.065	-26987.031	23.922
14243	-111383.173	-26982.939	9.985
13927	-111373.020	-26960.317	24.796
13926	-111370.731	-26961.364	2.517
13925	-111364.284	-26965.200	7.502
面積	244.0470430		
地積	244.04 m ²		

115			
地番	桂上中四三ノ三		
N O	X	Y	辺長
13927	-111373.020	-26960.317	
14243	-111383.173	-26982.939	24.796
14242	-111395.223	-26977.561	13.196
16308	-111392.758	-26972.091	6.000
13930	-111385.387	-26955.541	18.117
13929	-111382.876	-26956.386	2.649
13928	-111379.848	-26957.192	3.133
13927	-111373.020	-26960.317	7.509
面積	325.7605915		
地積	325.76 m ²		

116			
地番	桂上中四一ノ九		
N O	X	Y	辺長
16308	-111392.758	-26972.091	
16316	-111397.290	-26970.041	4.974
16309	-111390.075	-26953.962	17.624
13930	-111385.387	-26955.541	4.947
16308	-111392.758	-26972.091	18.117
面積	88.4429935		
地積	88.44 m ²		

117			
地番	桂上中四一ノ八		
N O	X	Y	辺長
16316	-111397.290	-26970.041	
16317	-111401.808	-26968.018	4.950
16310	-111394.788	-26952.375	17.146
16309	-111390.075	-26953.962	4.973
16316	-111397.290	-26970.041	17.624
面積	86.0535330		
地積	86.05 m ²		

118			
地番	桂上中四一ノ七		
N O	X	Y	辺長
14242	-111395.223	-26977.561	
14241	-111403.058	-26974.071	8.577
16315	-111407.018	-26972.284	4.345
16311	-111397.646	-26951.413	22.879
16310	-111394.788	-26952.375	3.016
16317	-111401.808	-26968.018	17.146
16316	-111397.290	-26970.041	4.950
16308	-111392.758	-26972.091	4.974
14242	-111395.223	-26977.561	6.000
面積	128.9231930		
地積	128.92 m ²		

119			
地番	桂上中四一ノ六		
N O	X	Y	辺長
16315	-111407.018	-26972.284	
16314	-111418.778	-26966.996	12.894
16321	-111416.315	-26961.519	6.005
16319	-111411.794	-26963.543	4.953
16318	-111407.279	-26965.571	4.950
16312	-111400.507	-26950.450	16.568
16311	-111397.646	-26951.413	3.019
16315	-111407.018	-26972.284	22.879
面積	127.6046860		
地積	127.60 m ²		

120			
地番	桂上中四一ノ五		
N O	X	Y	辺長
16318	-111407.279	-26965.571	
16319	-111411.794	-26963.543	4.950
16313	-111405.311	-26949.086	15.844
21107	-111405.069	-26949.150	0.250
21108	-111405.843	-26950.894	1.908
21109	-111403.652	-26951.873	2.400
21110	-111402.716	-26949.777	2.295
16271	-111401.712	-26950.044	1.039
16312	-111400.507	-26950.450	1.272
16318	-111407.279	-26965.571	16.568
面積	75.2543040		
地積	75.25 m ²		

121			
地番	桂上西五五ノ一		
N O	X	Y	辺長
21107	-111405.069	-26949.150	
21110	-111402.716	-26949.777	2.435
21109	-111403.652	-26951.873	2.295
21108	-111405.843	-26950.894	2.400
21107	-111405.069	-26949.150	1.908
面積	5.0488050		
地積	5.04 m ²		

122			
地番	桂上中四一ノ四		
N O	X	Y	辺長
16321	-111416.315	-26961.519	
16322	-111413.709	-26955.710	6.367
16320	-111410.155	-26947.797	8.674
16313	-111405.311	-26949.086	5.013
16319	-111411.794	-26963.543	15.844
16321	-111416.315	-26961.519	4.953
面積	76.4576025		
地積	76.45 m ²		

123			
地番	桂上中四一ノ三		
N O	X	Y	辺長
16322	-111413.709	-26955.710	
16324	-111423.703	-26951.171	10.976
13848	-111420.887	-26947.771	4.415
13849	-111416.072	-26946.222	5.058
16320	-111410.155	-26947.797	6.123
16322	-111413.709	-26955.710	8.674
面積	74.2626010		
地積	74.26 m ²		

124			
地番	桂上中四一ノ二		
N O	X	Y	辺長
16321	-111416.315	-26961.519	
16323	-111427.940	-26956.287	12.748
16324	-111423.703	-26951.171	6.643
16322	-111413.709	-26955.710	10.976
16321	-111416.315	-26961.519	6.367
面積	75.7626320		
地積	75.76 m ²		

125			
地番	桂上中四一ノ一		
N O	X	Y	辺長
16314	-111418.778	-26966.996	
13846	-111431.422	-26961.305	13.866
13847	-111427.977	-26956.332	6.050
16323	-111427.940	-26956.287	0.058
16321	-111416.315	-26961.519	12.748
16314	-111418.778	-26966.996	6.005
面積	79.9245855		
地積	79.92 m ²		

126			
地番	桂上東五ノ二		
N O	X	Y	辺長
14241	-111403.058	-26974.071	
13840	-111412.043	-26994.110	21.961
13841	-111417.192	-26991.803	5.642
13842	-111435.600	-26983.566	20.167
13843	-111441.467	-26980.936	6.430
13844	-111442.469	-26977.237	3.832
13845	-111433.442	-26964.222	15.839
13846	-111431.422	-26961.305	3.548
16314	-111418.778	-26966.996	13.866
16315	-111407.018	-26972.284	12.894
14241	-111403.058	-26974.071	4.345
面積	724.9680385		
地積	724.96 m ²		

127			
地番	桂上中四三ノ四		
N O	X	Y	辺長
14245	-111368.866	-26989.374	
13905	-111377.831	-27009.444	21.981
13906	-111380.736	-27008.142	3.183
13889	-111399.052	-26999.932	20.072
13840	-111412.043	-26994.110	14.236
14241	-111403.058	-26974.071	21.961
14242	-111395.223	-26977.561	8.577
14243	-111383.173	-26982.939	13.196
14244	-111374.065	-26987.031	9.985
14245	-111368.866	-26989.374	5.703
面積	823.9946730		
地積	823.99 m ²		

128			
地番	桂上中三九ノ一		
N O	X	Y	辺長
14234	-111349.697	-26997.984	
13903	-111358.759	-27017.990	21.963
13904	-111362.553	-27016.291	4.157
13905	-111377.831	-27009.444	16.742
14245	-111368.866	-26989.374	21.981
14236	-111367.201	-26990.102	1.817
14235	-111351.798	-26997.026	16.888
14234	-111349.697	-26997.984	2.309
面積	460.7591640		
地積	460.75 m ²		