


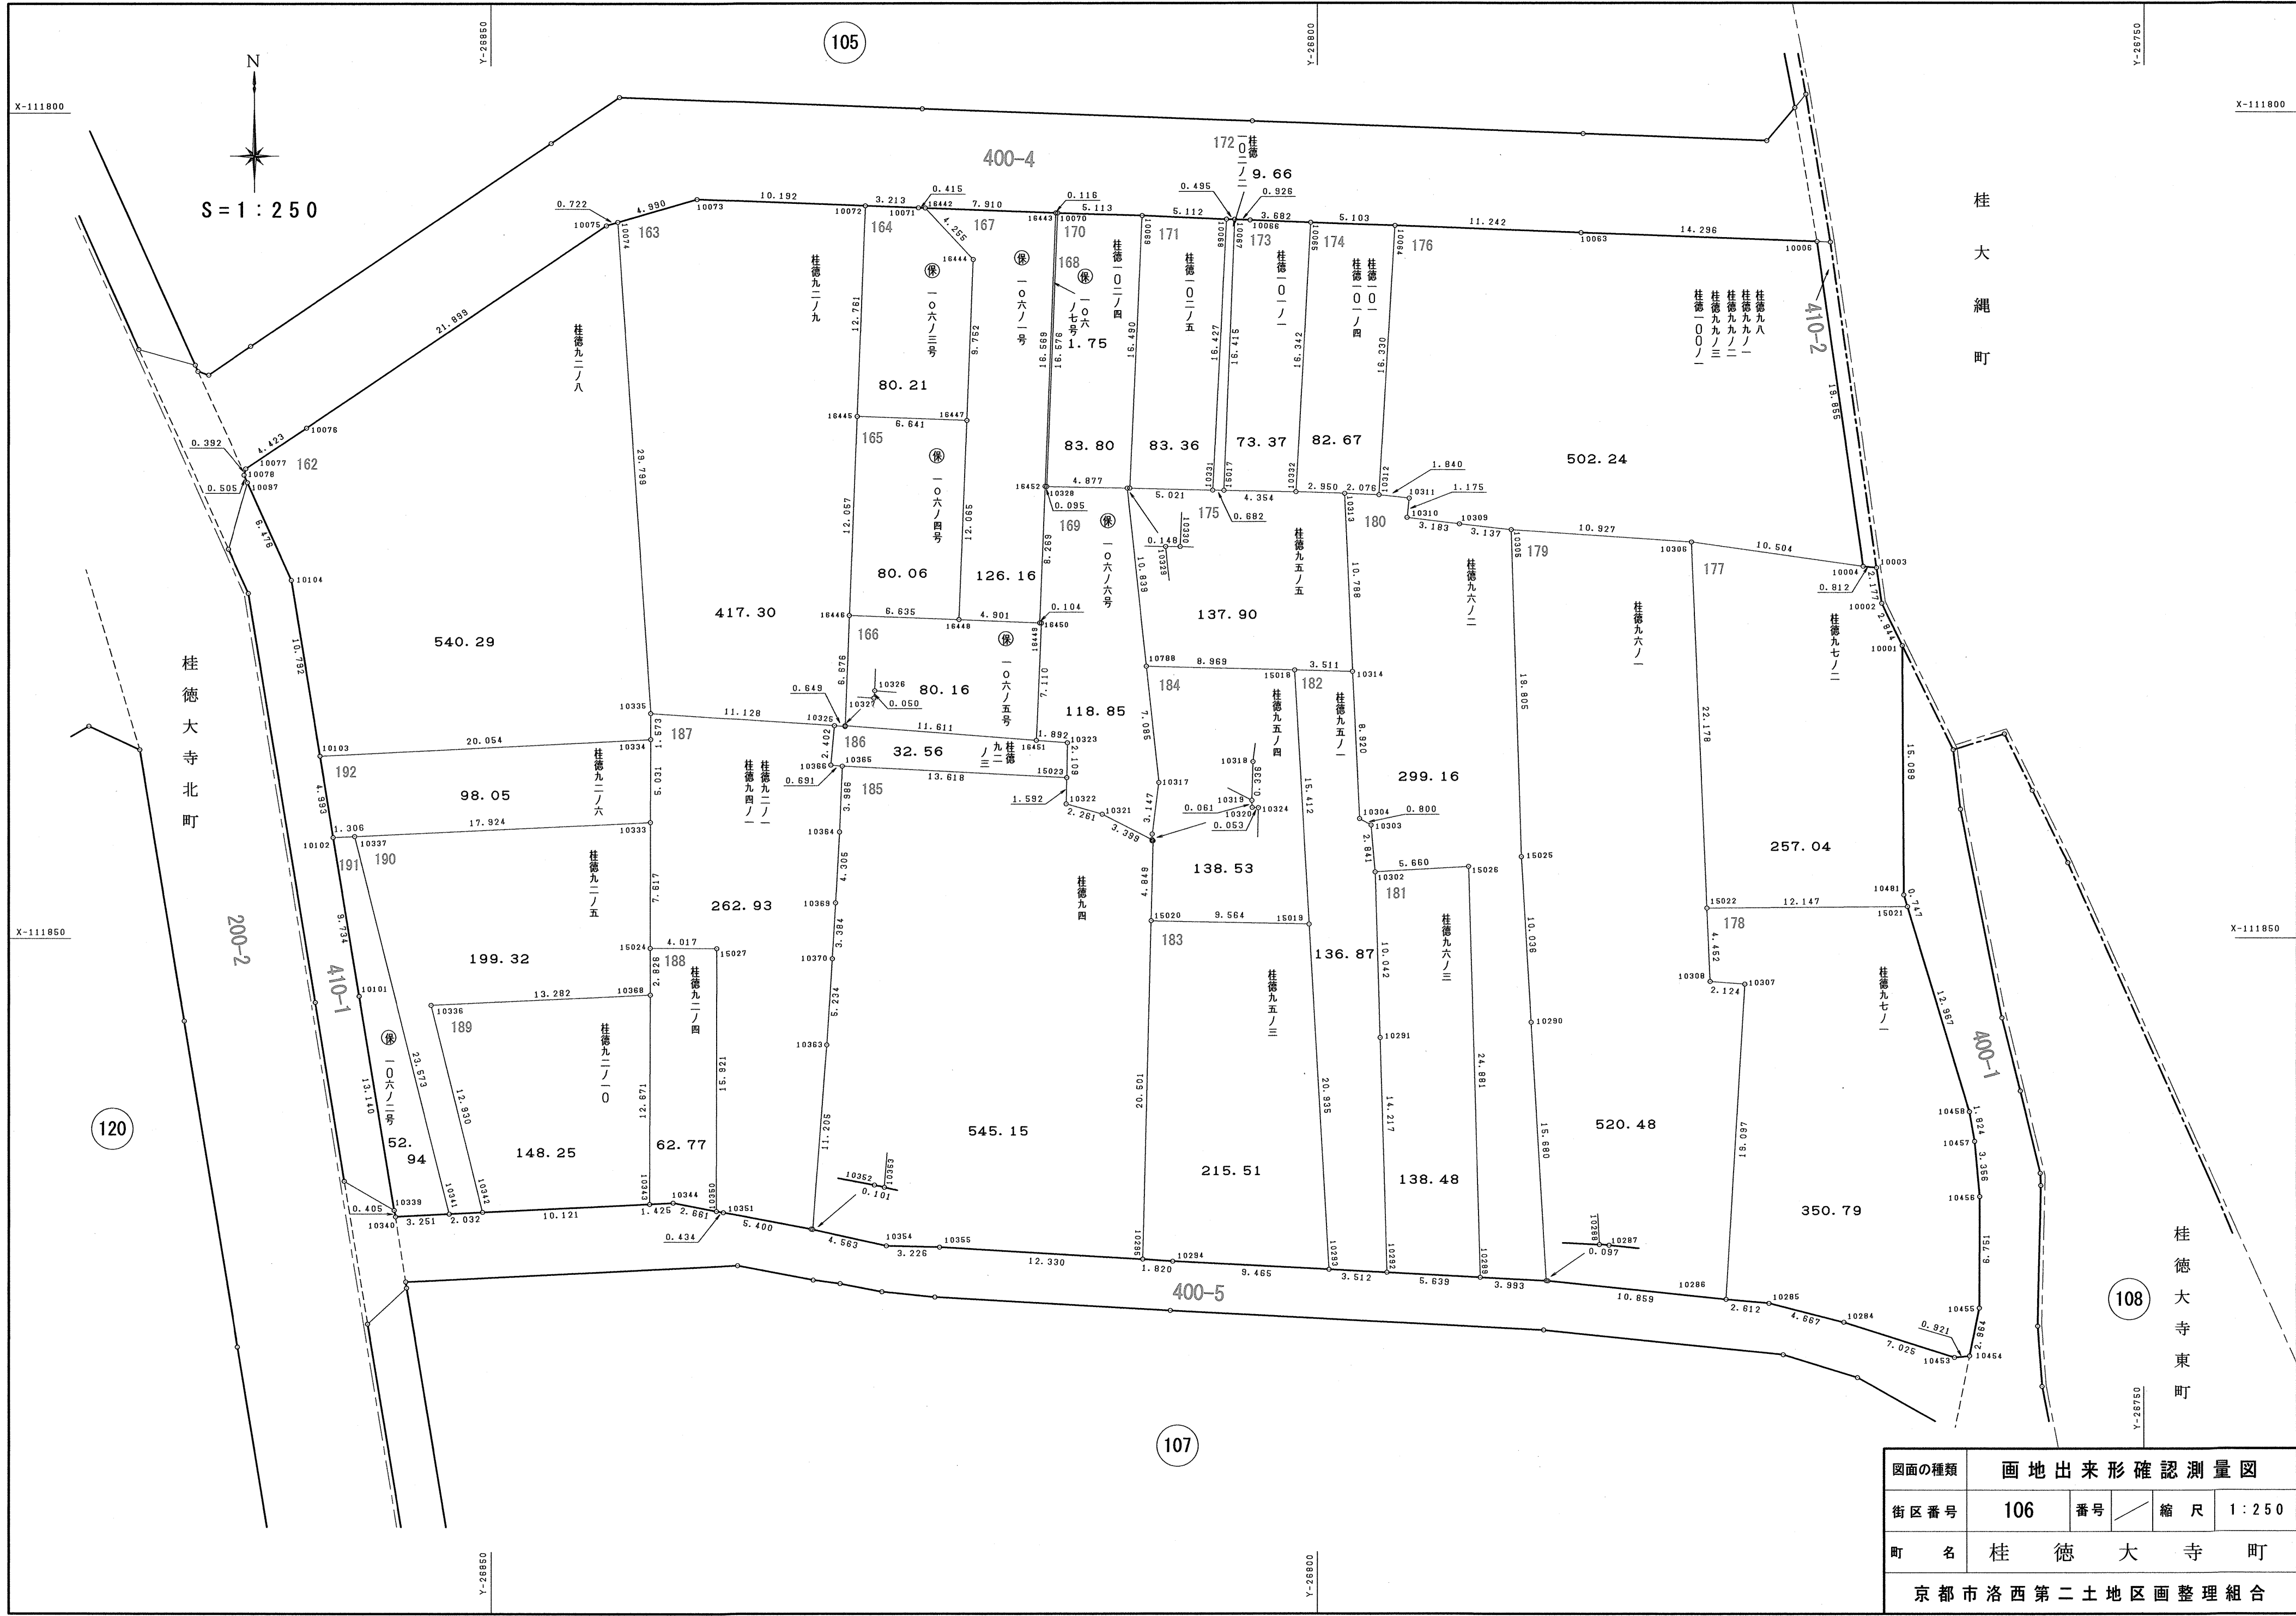

図面の種類	画地出来形確認測量図				
街区番号	106	番号		縮尺	1：250
町名	桂 徳 大 寺 町				
京都市洛西第二土地区画整理組合					

162

地番	桂徳九二ノ八		
N O	X	Y	辺 長
10074	-111806.620	-26842.341	
10075	-111806.822	-26843.034	0.722
10076	-111819.079	-26861.181	21.899
10077	-111821.545	-26864.853	4.423
10078	-111821.922	-26864.959	0.392
10097	-111822.385	-26864.757	0.505
10104	-111828.292	-26862.102	6.476
10103	-111838.944	-26860.371	10.792
10334	-111837.925	-26840.343	20.054
10335	-111836.352	-26840.338	1.573
10074	-111806.620	-26842.341	29.799
面積	540.2970915		
地積	540.29㎡		

163

地番	桂徳九二ノ九		
N O	X	Y	辺 長
10072	-111805.629	-26827.365	
10073	-111805.227	-26837.549	10.192
10074	-111806.620	-26842.341	4.990
10335	-111836.352	-26840.338	29.799
10325	-111837.103	-26829.235	11.128
10327	-111837.149	-26828.588	0.649
10326	-111837.099	-26828.583	0.050
16446	-111830.428	-26828.330	6.676
16445	-111818.380	-26827.861	12.057
10072	-111805.629	-26827.365	12.761
面積	417.3057420		
地積	417.30㎡		

164

地番	保 一〇六ノ三号		
N O	X	Y	辺 長
10072	-111805.629	-26827.365	
16445	-111818.380	-26827.861	12.761
16447	-111818.631	-26821.225	6.641
16444	-111808.887	-26820.842	9.752
16442	-111805.772	-26823.740	4.255
10071	-111805.756	-26824.155	0.415
10072	-111805.629	-26827.365	3.213
面積	80.2120870		
地積	80.21㎡		

165

地番	保 一〇六ノ四号		
N O	X	Y	辺 長
16445	-111818.380	-26827.861	
16446	-111830.428	-26828.330	12.057
16448	-111830.687	-26821.700	6.635
16447	-111818.631	-26821.225	12.065
16445	-111818.380	-26827.861	6.641
面積	80.0612760		
地積	80.06㎡		

166

地番	保 一〇六ノ五号		
N O	X	Y	辺 長
16446	-111830.428	-26828.330	
10326	-111837.099	-26828.583	6.676
16451	-111838.002	-26817.007	11.611
16450	-111830.899	-26816.699	7.110
16449	-111830.893	-26816.803	0.104
16448	-111830.687	-26821.700	4.901
16446	-111830.428	-26828.330	6.635
面積	80.1651375		
地積	80.16㎡		

167

地番	保 一〇六ノ一号		
N O	X	Y	辺 長
16443	-111806.073	-26815.836	
16442	-111805.772	-26823.740	7.910
16444	-111808.887	-26820.842	4.255
16447	-111818.631	-26821.225	9.752
16448	-111830.687	-26821.700	12.065
16449	-111830.893	-26816.803	4.901
16452	-111822.630	-26816.476	8.269
16443	-111806.073	-26815.836	16.569
面積	126.1613295		
地積	126.16㎡		

168

地番	保 一〇六ノ七号		
N O	X	Y	辺 長
10070	-111806.075	-26815.720	
16443	-111806.073	-26815.836	0.116
16452	-111822.630	-26816.476	16.569
10328	-111822.638	-26816.381	0.095
10070	-111806.075	-26815.720	16.576
面積	1.7503325		
地積	1.75㎡		

169

地番	保 一〇六ノ六号		
N O	X	Y	辺 長
16452	-111822.630	-26816.476	
16449	-111830.893	-26816.803	8.269
16450	-111830.899	-26816.699	0.104
16451	-111838.002	-26817.007	7.110
10323	-111838.148	-26815.121	1.892
15023	-111840.257	-26815.163	2.109
10322	-111841.849	-26815.195	1.592
10321	-111842.470	-26813.021	2.261
10319	-111844.021	-26809.997	3.399
10318	-111843.685	-26809.988	0.336
10317	-111840.563	-26809.593	3.147
10788	-111833.518	-26810.349	7.085
10329	-111822.741	-26811.505	10.839
10328	-111822.638	-26816.381	4.877
16452	-111822.630	-26816.476	0.095
面積	118.8589185		
地積	118.85㎡		

170

地番	桂徳一〇二ノ四		
N O	X	Y	辺 長
10069	-111806.268	-26810.611	
10070	-111806.075	-26815.720	5.113
10328	-111822.638	-26816.381	16.576
10329	-111822.741	-26811.505	4.877
10330	-111822.741	-26811.357	0.148
10069	-111806.268	-26810.611	16.490
面積	83.8001870		
地積	83.80㎡		

171

地番	桂徳一〇二ノ五		
N O	X	Y	辺 長
10068	-111806.461	-26805.503	
10069	-111806.268	-26810.611	5.112
10330	-111822.741	-26811.357	16.490
10331	-111822.867	-26806.338	5.021
10068	-111806.461	-26805.503	16.427
面積	83.3674930		
地積	83.36㎡		

172

地番	桂徳一〇二ノ二		
N O	X	Y	辺 長
10067	-111806.480	-26805.008	
10068	-111806.461	-26805.503	0.495
10331	-111822.867	-26806.338	16.427
15017	-111822.882	-26805.656	0.682
10067	-111806.480	-26805.008	16.415
面積	9.6663595		
地積	9.66㎡		

173

地番	桂徳一〇一ノ一		
N O	X	Y	辺 長
10065	-111806.657	-26800.404	
10066	-111806.515	-26804.083	3.682
10067	-111806.480	-26805.008	0.926
15017	-111822.882	-26805.656	16.415
10332	-111822.974	-26801.303	4.354
10065	-111806.657	-26800.404	16.342
面積	73.3713490		
地積	73.37㎡		

174

地番	桂徳一〇一、桂徳一〇一ノ四		
N O	X	Y	辺 長
10064	-111806.855	-26795.305	
10065	-111806.657	-26800.404	5.103
10332	-111822.974	-26801.303	16.342
10313	-111823.064	-26798.354	2.950
10312	-111823.156	-26796.280	2.076
10064	-111806.855	-26795.305	16.330
面積	82.6755550		
地積	82.67㎡		

175

地番	桂徳九五ノ五		
N O	X	Y	辺 長
10329	-111822.741	-26811.505	
10788	-111833.518	-26810.349	10.839
15018	-111833.750	-26801.383	8.969
10314	-111833.841	-26797.873	3.511
10313	-111823.064	-26798.354	10.788
10332	-111822.974	-26801.303	2.950
15017	-111822.882	-26805.656	4.354
10331	-111822.867	-26806.338	0.682
10330	-111822.741	-26811.357	5.021
10329	-111822.741	-26811.505	0.148
面積	137.9087305		
地積	137.90㎡		

176

地番	桂徳九八、九九ノ一、九九ノ二 九九ノ三、一〇〇ノ一		
N O	X	Y	辺 長
10006	-111807.826	-26769.785	
10063	-111807.290	-26784.071	14.296
10064	-111806.855	-26795.305	11.242
10312	-111823.156	-26796.280	16.330
10311	-111823.361	-26794.451	1.840
10310	-111824.530	-26794.572	1.175
10309	-111824.916	-26791.412	3.183
10305	-111825.263	-26788.294	3.137
10306	-111826.006	-26777.392	10.927
10004	-111827.484	-26766.992	10.504
10006	-111807.826	-26769.785	19.855
面積	502.2446205		
地積	502.24㎡		

177

地番	桂徳九七ノ二		
N O	X	Y	辺 長
10306	-111826.006	-26777.392	
15022	-111848.164	-26776.448	22.178
15021	-111848.084	-26764.301	12.147
10481	-111847.369	-26764.517	0.747
10001	-111832.280	-26764.619	15.089
10002	-111829.723	-26765.864	2.844
10003	-111827.570	-26766.185	2.177
10004	-111827.484	-26766.992	0.812
10306	-111826.006	-26777.392	10.504
面積	257.0447620		
地積	257.04㎡		

178

地番	桂徳九七ノ一		
N O	X	Y	辺 長
15022	-111848.164	-26776.448	
10308	-111852.612	-26776.259	4.452
10307	-111852.771	-26774.141	2.124
10286	-111871.834	-26775.274	19.097
10285	-111872.098	-26772.675	2.612
10284	-111873.250	-26768.152	4.667
10453	-111875.382	-26761.458	7.025
10454	-111875.292	-26760.541	0.921
10455	-111872.387	-26759.951	2.964
10456	-111865.636	-26759.925	6.751
10457	-111862.294	-26760.233	3.356
10458	-111860.498	-26760.554	1.824
15021	-111848.084	-26764.301	12.967
15022	-111848.164	-26776.448	12.147
面積	350.7943285		
地積	350.79㎡		

179

地番	桂徳九六ノ一		
N O	X	Y	辺 長
10306	-111826.006	-26777.392	
10305	-111825.263	-26788.294	10.927
15025	-111845.058	-26787.670	19.805
10290	-111855.077	-26787.086	10.036
10288	-111870.730	-26786.174	15.680
10287	-111870.735	-26786.077	0.097
10286	-111871.834	-26775.274	10.859
10307	-111852.771	-26774.141	19.097
10308	-111852.612	-26776.259	2.124
15022	-111848.164	-26776.448	4.452
10306	-111826.006	-26777.392	22.178
面積	520.4843145		
地積	520.48㎡		

186

地番	桂徳九二ノ三		
N O	X	Y	辺 長
10325	-111837.103	-26829.235	
10366	-111839.495	-26829.452	2.402
10365	-111839.552	-26828.763	0.691
15023	-111840.257	-26815.163	13.618
10323	-111838.148	-26815.121	2.109
16451	-111838.002	-26817.007	1.892
10326	-111837.099	-26828.583	11.611
10327	-111837.149	-26828.588	0.050
10325	-111837.103	-26829.235	0.649
面積	32.5683335		
地積	32.56㎡		

187

地番	桂徳九二ノ一、桂徳九四ノ一		
N O	X	Y	辺 長
10325	-111837.103	-26829.235	
10335	-111836.352	-26840.338	11.128
10334	-111837.925	-26840.343	1.573
10333	-111842.956	-26840.362	5.031
15024	-111850.573	-26840.372	7.617
15027	-111850.578	-26836.355	4.017
10350	-111866.499	-26836.386	15.921
10351	-111866.581	-26835.960	0.434
10352	-111867.585	-26830.654	5.400
10353	-111867.607	-26830.555	0.101
10363	-111856.435	-26829.693	11.205
10370	-111851.211	-26829.364	5.234
10369	-111847.833	-26829.165	3.384
10364	-111843.535	-26828.921	4.305
10365	-111839.552	-26828.763	3.986
10366	-111839.495	-26829.452	0.691
10325	-111837.103	-26829.235	2.402
面積	262.9351000		
地積	262.93㎡		

188

地番	桂徳九二ノ四		
N O	X	Y	辺 長
15024	-111850.573	-26840.372	
10368	-111853.399	-26840.376	2.826
10343	-111866.070	-26840.422	12.671
10344	-111865.998	-26838.999	1.425
10350	-111866.499	-26836.386	2.661
15027	-111850.578	-26836.355	15.921
15024	-111850.573	-26840.372	4.017
面積	62.7708915		
地積	62.77㎡		

189

地番	桂徳九二ノ一〇		
N O	X	Y	辺 長
10368	-111853.399	-26840.376	
10336	-111854.028	-26853.643	13.282
10342	-111866.578	-26850.530	12.930
10343	-111866.070	-26840.422	10.121
10368	-111853.399	-26840.376	12.671
面積	148.2570135		
地積	148.25㎡		

190

地番	桂徳九二ノ五		
N O	X	Y	辺 長
10333	-111842.956	-26840.362	
10337	-111843.809	-26858.266	17.924
10341	-111866.681	-26852.559	23.573
10342	-111866.578	-26850.530	2.032
10336	-111854.028	-26853.643	12.930
10368	-111853.399	-26840.376	13.282
15024	-111850.573	-26840.372	2.826
10333	-111842.956	-26840.362	7.617
面積	199.3235450		
地積	199.32㎡		

191

地番	保 一〇六ノ二号		
N O	X	Y	辺 長
10337	-111843.809	-26858.266	
10102	-111843.872	-26859.570	1.306
10101	-111853.480	-26858.009	9.734
10339	-111866.447	-26855.886	13.140
10340	-111866.844	-26855.806	0.405
10341	-111866.681	-26852.559	3.251
10337	-111843.809	-26858.266	23.573
面積	52.9439970		
地積	52.94㎡		

192

地番	桂徳九二ノ六		
N O	X	Y	辺 長
10334	-111837.925	-26840.343	
10103	-111838.944	-26860.371	20.054
10102	-111843.872	-26859.570	4.993
10337	-111843.809	-26858.266	1.306
10333	-111842.956	-26840.362	17.924
10334	-111837.925	-26840.343	5.031
面積	98.0583035		
地積	98.05㎡		

図面の種類	画 地 面 積 求 積 表				
街区番号	106	番号	$\frac{2}{2}$	縮 尺	
町 名	桂 徳 大 寺 町				
京 都 市 洛 西 第 二 土 地 区 画 整 理 組 合					



S = 1 : 250

桂 徳 大 寺 北 町

120

200-2

410-1

831.40

189.56

395.66

400-5

106

桂 徳 七 五 ノ 二

桂 徳 七 五 ノ 一

桂 徳 七 四 ノ 二

桂 徳 七 三 ノ 二

桂 徳 七 二 ノ 二

桂 徳 七 一 ノ 二

桂 徳 七 〇 ノ 二

桂 徳 六 九 ノ 二

桂 徳 六 八 ノ 二

桂 徳 六 七 ノ 二

桂 徳 六 六 ノ 二

桂 徳 六 五 ノ 二

桂 徳 六 四 ノ 二

桂 徳 六 三 ノ 二

桂 徳 六 二 ノ 二

桂 徳 六 一 ノ 二

桂 徳 六 〇 ノ 二

桂 徳 五 九 ノ 二

桂 徳 五 八 ノ 二

桂 徳 五 七 ノ 二

桂 徳 五 六 ノ 二

桂 徳 五 五 ノ 二

桂 徳 五 四 ノ 二

桂 徳 五 三 ノ 二

桂 徳 五 二 ノ 二

桂 徳 五 一 ノ 二

桂 徳 五 〇 ノ 二

桂 徳 四 九 ノ 二

桂 徳 四 八 ノ 二

桂 徳 四 七 ノ 二

桂 徳 四 六 ノ 二

桂 徳 四 五 ノ 二

桂 徳 四 四 ノ 二

桂 徳 四 三 ノ 二

桂 徳 四 二 ノ 二

桂 徳 四 一 ノ 二

桂 徳 四 〇 ノ 二

桂 徳 三 九 ノ 二

桂 徳 三 八 ノ 二

桂 徳 三 七 ノ 二

桂 徳 三 六 ノ 二

桂 徳 三 五 ノ 二

桂 徳 三 四 ノ 二

桂 徳 三 三 ノ 二

桂 徳 三 二 ノ 二

桂 徳 三 一 ノ 二

桂 徳 三 〇 ノ 二

桂 徳 二 九 ノ 二

桂 徳 二 八 ノ 二

桂 徳 二 七 ノ 二

桂 徳 二 六 ノ 二

400-6

110 B

400-2

110 A

108

桂 徳 大 寺 東 町

109

図面の種類	画 地 出 来 形 確 認 測 量 図				
街区番号	107	番号	／	縮 尺	1 : 250
町 名	桂 徳 大 寺 町				
京 都 市 洛 西 第 二 土 地 区 画 整 理 組 合					

193

地番	桂徳七六		
N O	X	Y	辺 長
10345	-111870.795	-26855.181	
10346	-111871.158	-26855.126	0.367
10347	-111892.506	-26851.621	21.634
10348	-111906.220	-26849.383	13.895
10447	-111916.216	-26847.717	10.134
10448	-111916.629	-26847.646	0.419
10449	-111916.853	-26847.298	0.414
10450	-111914.147	-26829.773	17.733
15041	-111905.254	-26831.157	9.000
15038	-111904.622	-26827.092	4.114
15039	-111900.472	-26827.736	4.200
11063	-111894.487	-26828.666	6.057
11062	-111891.556	-26828.787	2.933
11061	-111889.483	-26828.882	2.075
11060	-111889.458	-26833.066	4.184
11059	-111885.331	-26838.878	7.128
11058	-111879.755	-26839.611	5.624
10362	-111870.010	-26839.444	9.746
10345	-111870.795	-26855.181	15.757
面積	831.4099460		
地積	831.40㎡		

194

地番	桂徳九三		
N O	X	Y	辺 長
10362	-111870.010	-26839.444	
11058	-111879.755	-26839.611	9.746
11059	-111885.331	-26838.878	5.624
11060	-111889.458	-26833.066	7.128
11061	-111889.483	-26828.882	4.184
11064	-111888.500	-26828.935	0.984
10358	-111870.917	-26828.765	17.584
10359	-111870.891	-26828.898	0.136
10360	-111870.670	-26830.520	1.637
10361	-111868.793	-26835.096	4.659
10362	-111870.010	-26839.444	4.353
面積	189.5666740		
地積	189.56㎡		

195

地番	桂徳七五ノ一		
N O	X	Y	辺 長
10358	-111870.917	-26828.765	
11064	-111888.500	-26828.935	17.584
11061	-111889.483	-26828.882	0.984
11062	-111891.556	-26828.787	2.075
15037	-111892.512	-26809.515	19.990
10296	-111872.531	-26808.903	19.990
10356	-111871.709	-26823.159	14.280
10357	-111871.384	-26826.365	3.222
10358	-111870.917	-26828.765	2.445
面積	395.6658640		
地積	395.66㎡		

196

地番	桂徳七三、桂徳七四ノ二		
N O	X	Y	辺 長
10296	-111872.531	-26808.903	
15037	-111892.512	-26809.515	19.990
10548	-111901.376	-26809.787	8.868
10549	-111901.388	-26805.273	4.514
10525	-111886.835	-26804.767	14.562
15045	-111886.874	-26803.638	1.130
10297	-111872.832	-26803.165	14.050
10296	-111872.531	-26808.903	5.746
面積	147.1695935		
地積	147.16㎡		

197

地番	桂徳七二ノ二		
N O	X	Y	辺 長
10297	-111872.832	-26803.165	
15045	-111886.874	-26803.638	14.050
10528	-111886.914	-26802.487	1.152
10524	-111886.921	-26802.131	0.356
10298	-111872.911	-26801.666	14.018
10297	-111872.832	-26803.165	1.501
面積	21.1137165		
地積	21.11㎡		

198

地番	桂徳七二ノ一		
N O	X	Y	辺 長
10298	-111872.911	-26801.666	
10524	-111886.921	-26802.131	14.018
15035	-111887.299	-26790.845	11.292
10526	-111887.504	-26784.711	6.137
10527	-111887.604	-26781.997	2.716
10513	-111881.581	-26781.365	6.056
10300	-111874.359	-26780.098	7.332
10299	-111873.717	-26786.326	6.261
10298	-111872.911	-26801.666	15.361
面積	286.2099030		
地積	286.20㎡		

199

地番	桂徳六九、七一、一〇八		
N O	X	Y	辺 長
10300	-111874.359	-26780.098	
10513	-111881.581	-26781.365	7.332
10527	-111887.604	-26781.997	6.056
10526	-111887.504	-26784.711	2.716
10522	-111895.848	-26784.496	8.347
10523	-111896.093	-26780.347	4.156
10516	-111907.576	-26782.414	11.668
10517	-111907.572	-26782.356	0.058
10503	-111908.181	-26774.578	7.802
15034	-111896.837	-26773.678	11.380
10511	-111897.450	-26768.361	5.352
10509	-111893.662	-26768.429	3.789
15031	-111892.067	-26768.459	1.595
10506	-111889.130	-26768.513	2.937
15030	-111886.634	-26768.558	2.496
10507	-111884.618	-26768.595	2.016
10508	-111882.763	-26768.629	1.855
10512	-111880.058	-26768.331	2.721
10459	-111876.596	-26767.323	3.606
10301	-111875.212	-26771.824	4.709
10300	-111874.359	-26780.098	8.318
面積	390.2512485		
地積	390.25㎡		

200

地番	桂徳七〇ノ八		
N O	X	Y	辺 長
10459	-111876.596	-26767.323	
10512	-111880.058	-26768.331	3.606
10508	-111882.763	-26768.629	2.721
10507	-111884.618	-26768.595	1.855
10462	-111883.571	-26759.664	8.992
10461	-111880.479	-26760.911	3.334
10460	-111879.934	-26761.383	0.721
10459	-111876.596	-26767.323	6.814
面積	45.6427685		
地積	45.64㎡		

201

地番	桂徳七〇ノ五		
N O	X	Y	辺 長
10462	-111883.571	-26759.664	
10507	-111884.618	-26768.595	8.992
15030	-111886.634	-26768.558	2.016
10463	-111885.373	-26758.937	9.703
10462	-111883.571	-26759.664	1.943
面積	18.1487120		
地積	18.14㎡		

202

地番	桂徳七〇ノ七		
N O	X	Y	辺 長
10463	-111885.373	-26758.937	
15030	-111886.634	-26768.558	9.703
10506	-111889.130	-26768.513	2.496
10464	-111887.955	-26758.403	10.178
10463	-111885.373	-26758.937	2.637
面積	25.4011155		
地積	25.40㎡		

203

地番	桂徳七〇ノ四		
N O	X	Y	辺 長
10464	-111887.955	-26758.403	
10506	-111889.130	-26768.513	10.178
15031	-111892.067	-26768.459	2.937
10465	-111890.813	-26757.812	10.721
10464	-111887.955	-26758.403	2.918
面積	30.4633800		
地積	30.46㎡		

204

地番	桂徳七〇ノ六		
N O	X	Y	辺 長
10465	-111890.813	-26757.812	
15031	-111892.067	-26768.459	10.721
10509	-111893.662	-26768.429	1.595
10466	-111892.390	-26757.486	11.017
10465	-111890.813	-26757.812	1.610
面積	17.3456840		
地積	17.34㎡		

205

地番	桂徳七〇ノ三		
N O	X	Y	辺 長
10466	-111892.390	-26757.486	
10509	-111893.662	-26768.429	11.017
10511	-111897.450	-26768.361	3.789
10510	-111897.450	-26768.151	0.210
10467	-111896.123	-26756.714	11.514
10466	-111892.390	-26757.486	3.812
面積	43.1599725		
地積	43.15㎡		

206

地番	桂徳七〇		
N O	X	Y	辺 長
10467	-111896.123	-26756.714	
10510	-111897.450	-26768.151	11.514
15032	-111902.040	-26767.621	4.620
15033	-111901.697	-26764.644	2.997
10499	-111909.036	-26763.806	7.387
10500	-111909.606	-26756.725	7.104
10501	-111906.913	-26754.375	3.574
10468	-111896.920	-26756.549	10.227
10467	-111896.123	-26756.714	0.814
面積	128.4966085		
地積	128.49㎡		

207

地番	桂徳九二ノ二		
N O	X	Y	辺 長
15032	-111902.040	-26767.621	
10498	-111908.791	-26766.842	6.796
10499	-111909.036	-26763.806	3.046
15033	-111901.697	-26764.644	7.387
15032	-111902.040	-26767.621	2.997
面積	21.2204090		
地積	21.22㎡		

208



地番	桂上東三九A		
N O	X	Y	辺 長
15034	-111896.837	-26773.678	
10503	-111908.181	-26774.578	11.380
10504	-111908.618	-26768.993	5.602
10498	-111908.791	-26766.842	2.158
15032	-111902.040	-26767.621	6.796
10510	-111897.450	-26768.151	4.620
10511	-111897.450	-26768.361	0.210
15034	-111896.837	-26773.678	5.352
面積	75.0164730		
地積	75.01㎡		

209

地番	上東ノ口六九ノ二		
N O	X	Y	辺 長
15035	-111887.299	-26790.845	
10515	-111908.080	-26790.283	20.789
10516	-111907.576	-26782.414	7.885
10523	-111896.093	-26780.347	11.668
10522	-111895.848	-26784.496	4.156
10526	-111887.504	-26784.711	8.347
15035	-111887.299	-26790.845	6.137
面積	159.8791970		
地積	159.87㎡		

210

地番	桂徳六八、七四ノ一		
N O	X	Y	辺 長
10525	-111886.835	-26804.767	
10549	-111901.388	-26805.273	14.562
10550	-111903.534	-26805.375	2.148
15036	-111902.511	-26799.084	6.374
10544	-111909.262	-26798.041	6.831
10514	-111908.086	-26790.379	7.752
10515	-111908.080	-26790.283	0.096
15035	-111887.299	-26790.845	20.789
10524	-111886.921	-26802.131	11.292
10528	-111886.914	-26802.487	0.356
15045	-111886.874	-26803.638	1.152
10525	-111886.835	-26804.767	1.130
面積	276.4775685		
地積	276.47 m ²		

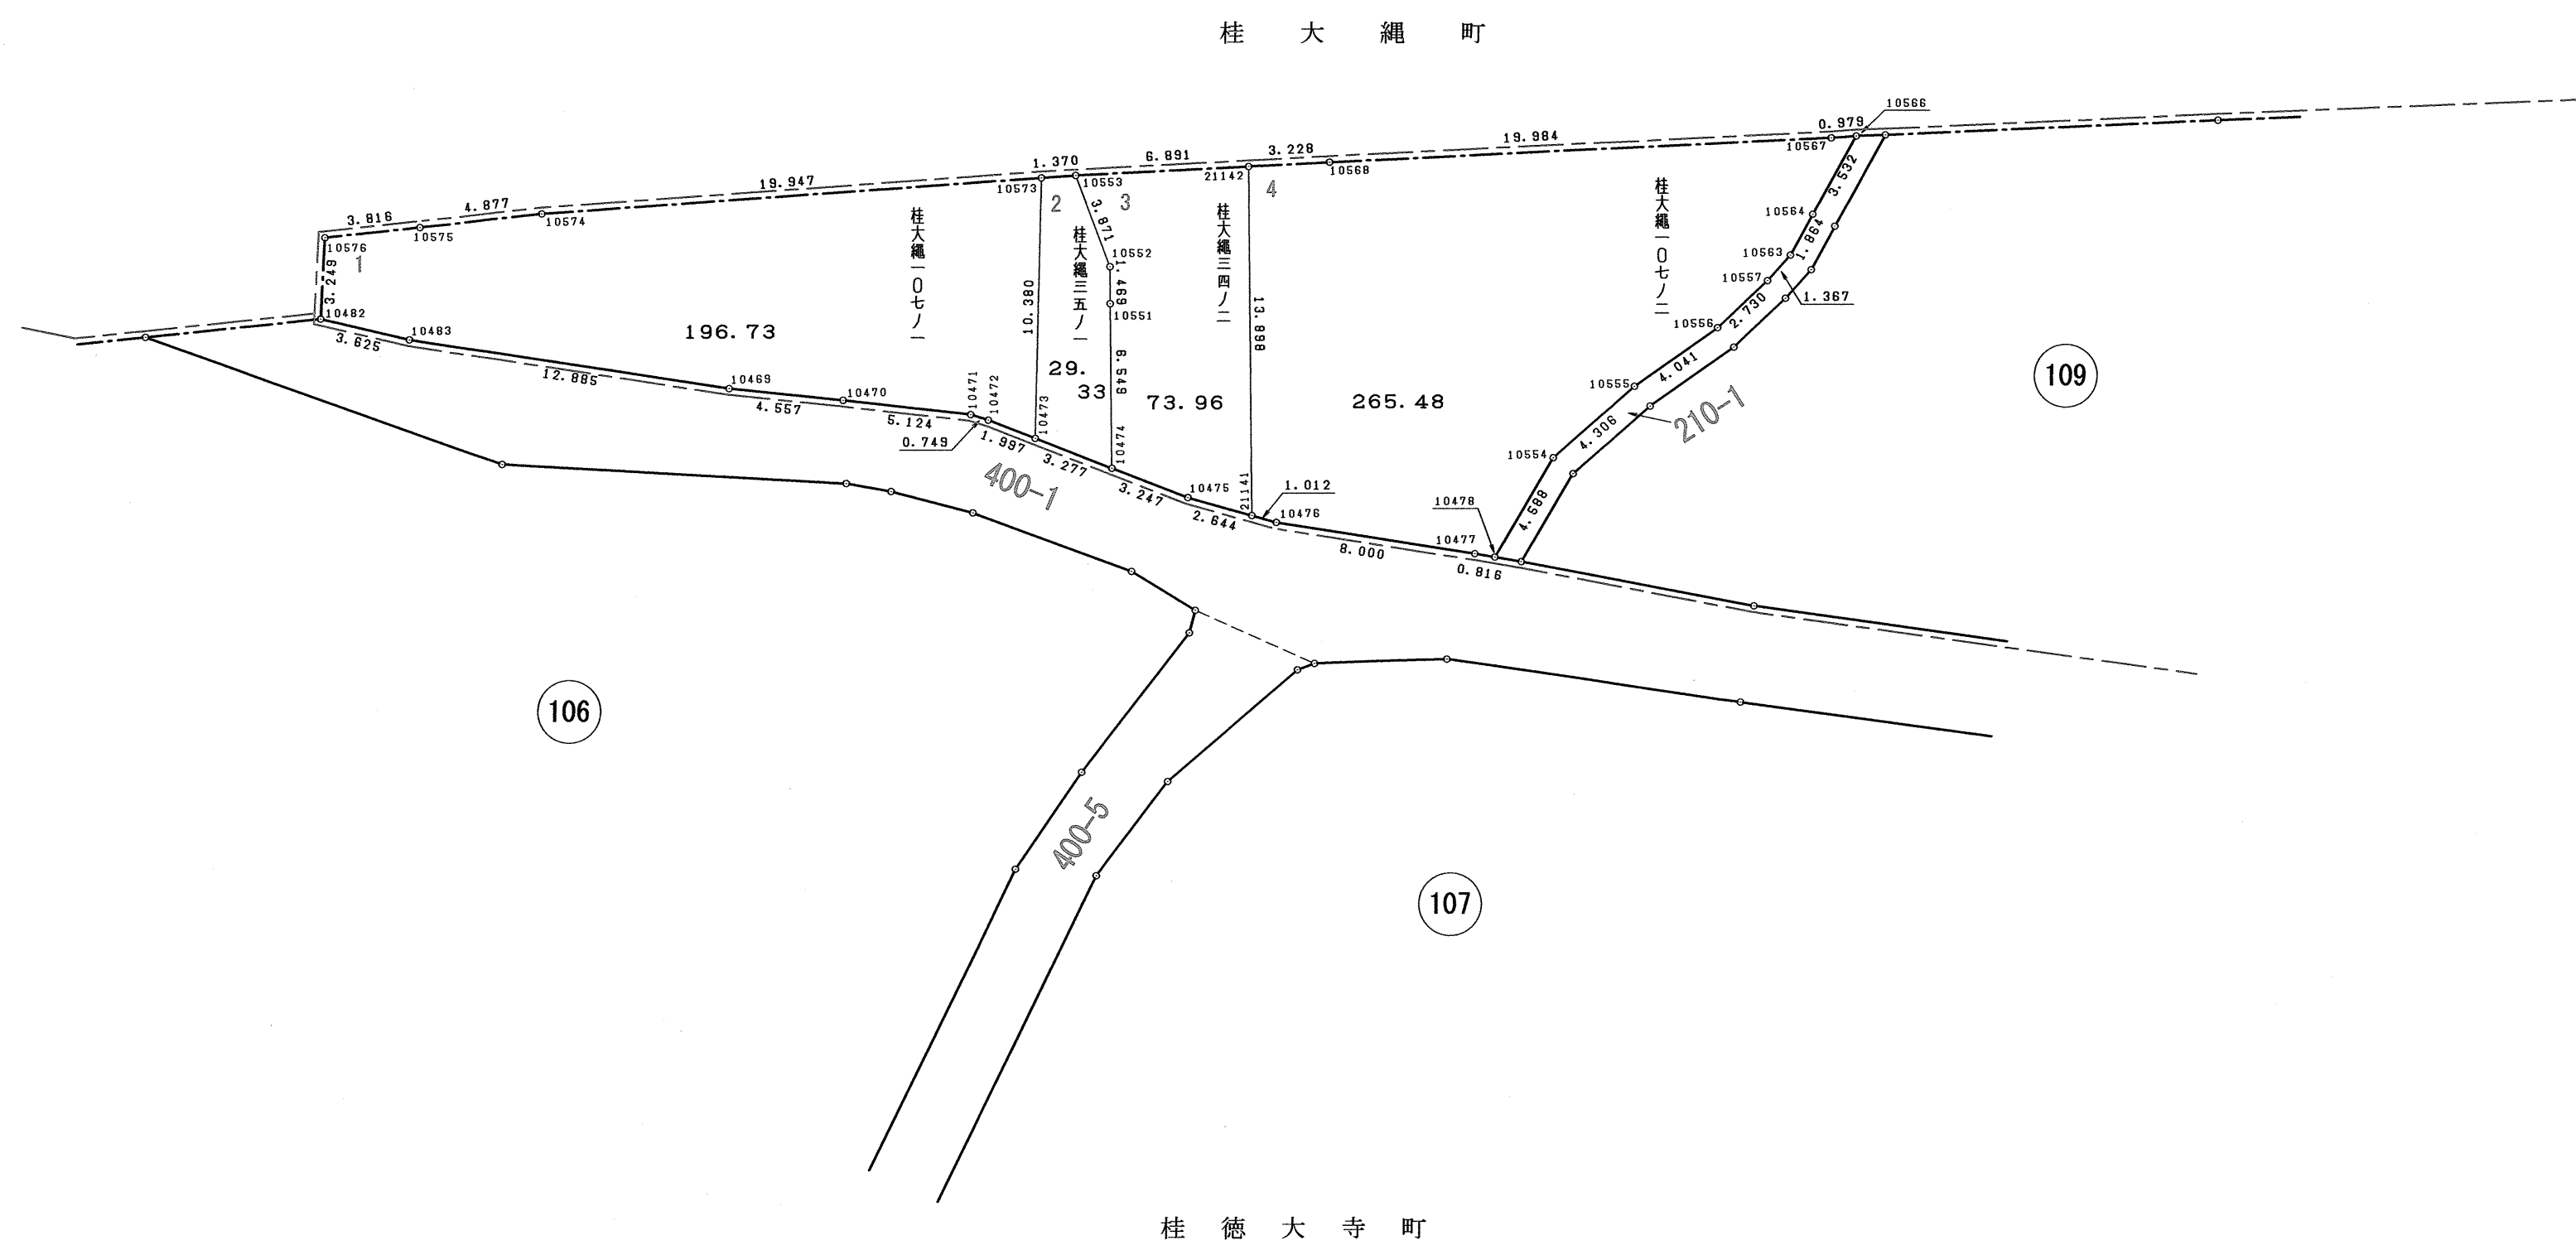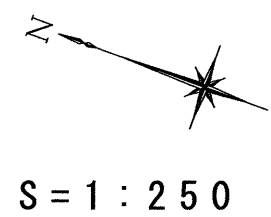

図面の種類	画地出来形確認測量図				
街区番号	108	番号		縮尺	1:250
町名	桂徳大寺東町				
京都市洛西第二土地区画整理組合					

1

地番	桂大縄一〇七ノ一		
N O	X	Y	辺 長
10482	-111838.582	-26761.538	
10483	-111842.181	-26761.104	3.625
10469	-111854.818	-26758.587	12.885
10470	-111859.237	-26757.473	4.557
10471	-111864.217	-26756.265	5.124
10472	-111864.965	-26756.233	0.749
10473	-111866.961	-26756.278	1.997
10573	-111863.632	-26746.446	10.380
10574	-111845.426	-26754.596	19.947
10575	-111841.050	-26756.748	4.877
10576	-111837.626	-26758.433	3.816
10482	-111838.582	-26761.538	3.249
面積	196.7304525		
地積	196.73 m ²		

2

地番	桂大縄三五ノ一		
N O	X	Y	辺 長
10473	-111866.961	-26756.278	
10474	-111870.237	-26756.352	3.277
10551	-111867.936	-26750.221	6.549
10552	-111867.415	-26748.848	1.469
10553	-111864.893	-26745.911	3.871
10573	-111863.632	-26746.446	1.370
10473	-111866.961	-26756.278	10.380
面積	29.3301395		
地積	29.33 m ²		


3


地番	桂大縄三四ノ二		
N O	X	Y	辺 長
10553	-111864.893	-26745.911	
10552	-111867.415	-26748.848	3.871
10551	-111867.936	-26750.221	1.469
10474	-111870.237	-26756.352	6.549
10475	-111873.483	-26756.426	3.247
21141	-111876.120	-26756.230	2.644
21142	-111871.236	-26743.218	13.898
10553	-111864.893	-26745.911	6.891
面積	73.9618005		
地積	73.96 m ²		

4

地番	桂大縄一〇七ノ二		
N O	X	Y	辺 長
21141	-111876.120	-26756.230	
10476	-111877.129	-26756.155	1.012
10477	-111884.979	-26754.614	8.000
10478	-111885.782	-26754.467	0.816
10554	-111886.607	-26749.954	4.588
10555	-111888.655	-26746.166	4.306
10556	-111890.961	-26742.847	4.041
10557	-111892.184	-26740.406	2.730
10563	-111892.698	-26739.139	1.367
10564	-111892.976	-26737.296	1.864
10566	-111893.521	-26733.806	3.532
10567	-111892.617	-26734.183	0.979
10568	-111874.207	-26741.956	19.984
21142	-111871.236	-26743.218	3.228
21141	-111876.120	-26756.230	13.898
面積	265.4826610		
地積	265.48 m ²		

図面の種類	画 地 面 積 求 積 表				
街区 番号	108	番号	／	縮 尺	
町 名	桂 徳 大 寺 東 町				
京 都 市 洛 西 第 二 土 地 区 画 整 理 組 合					

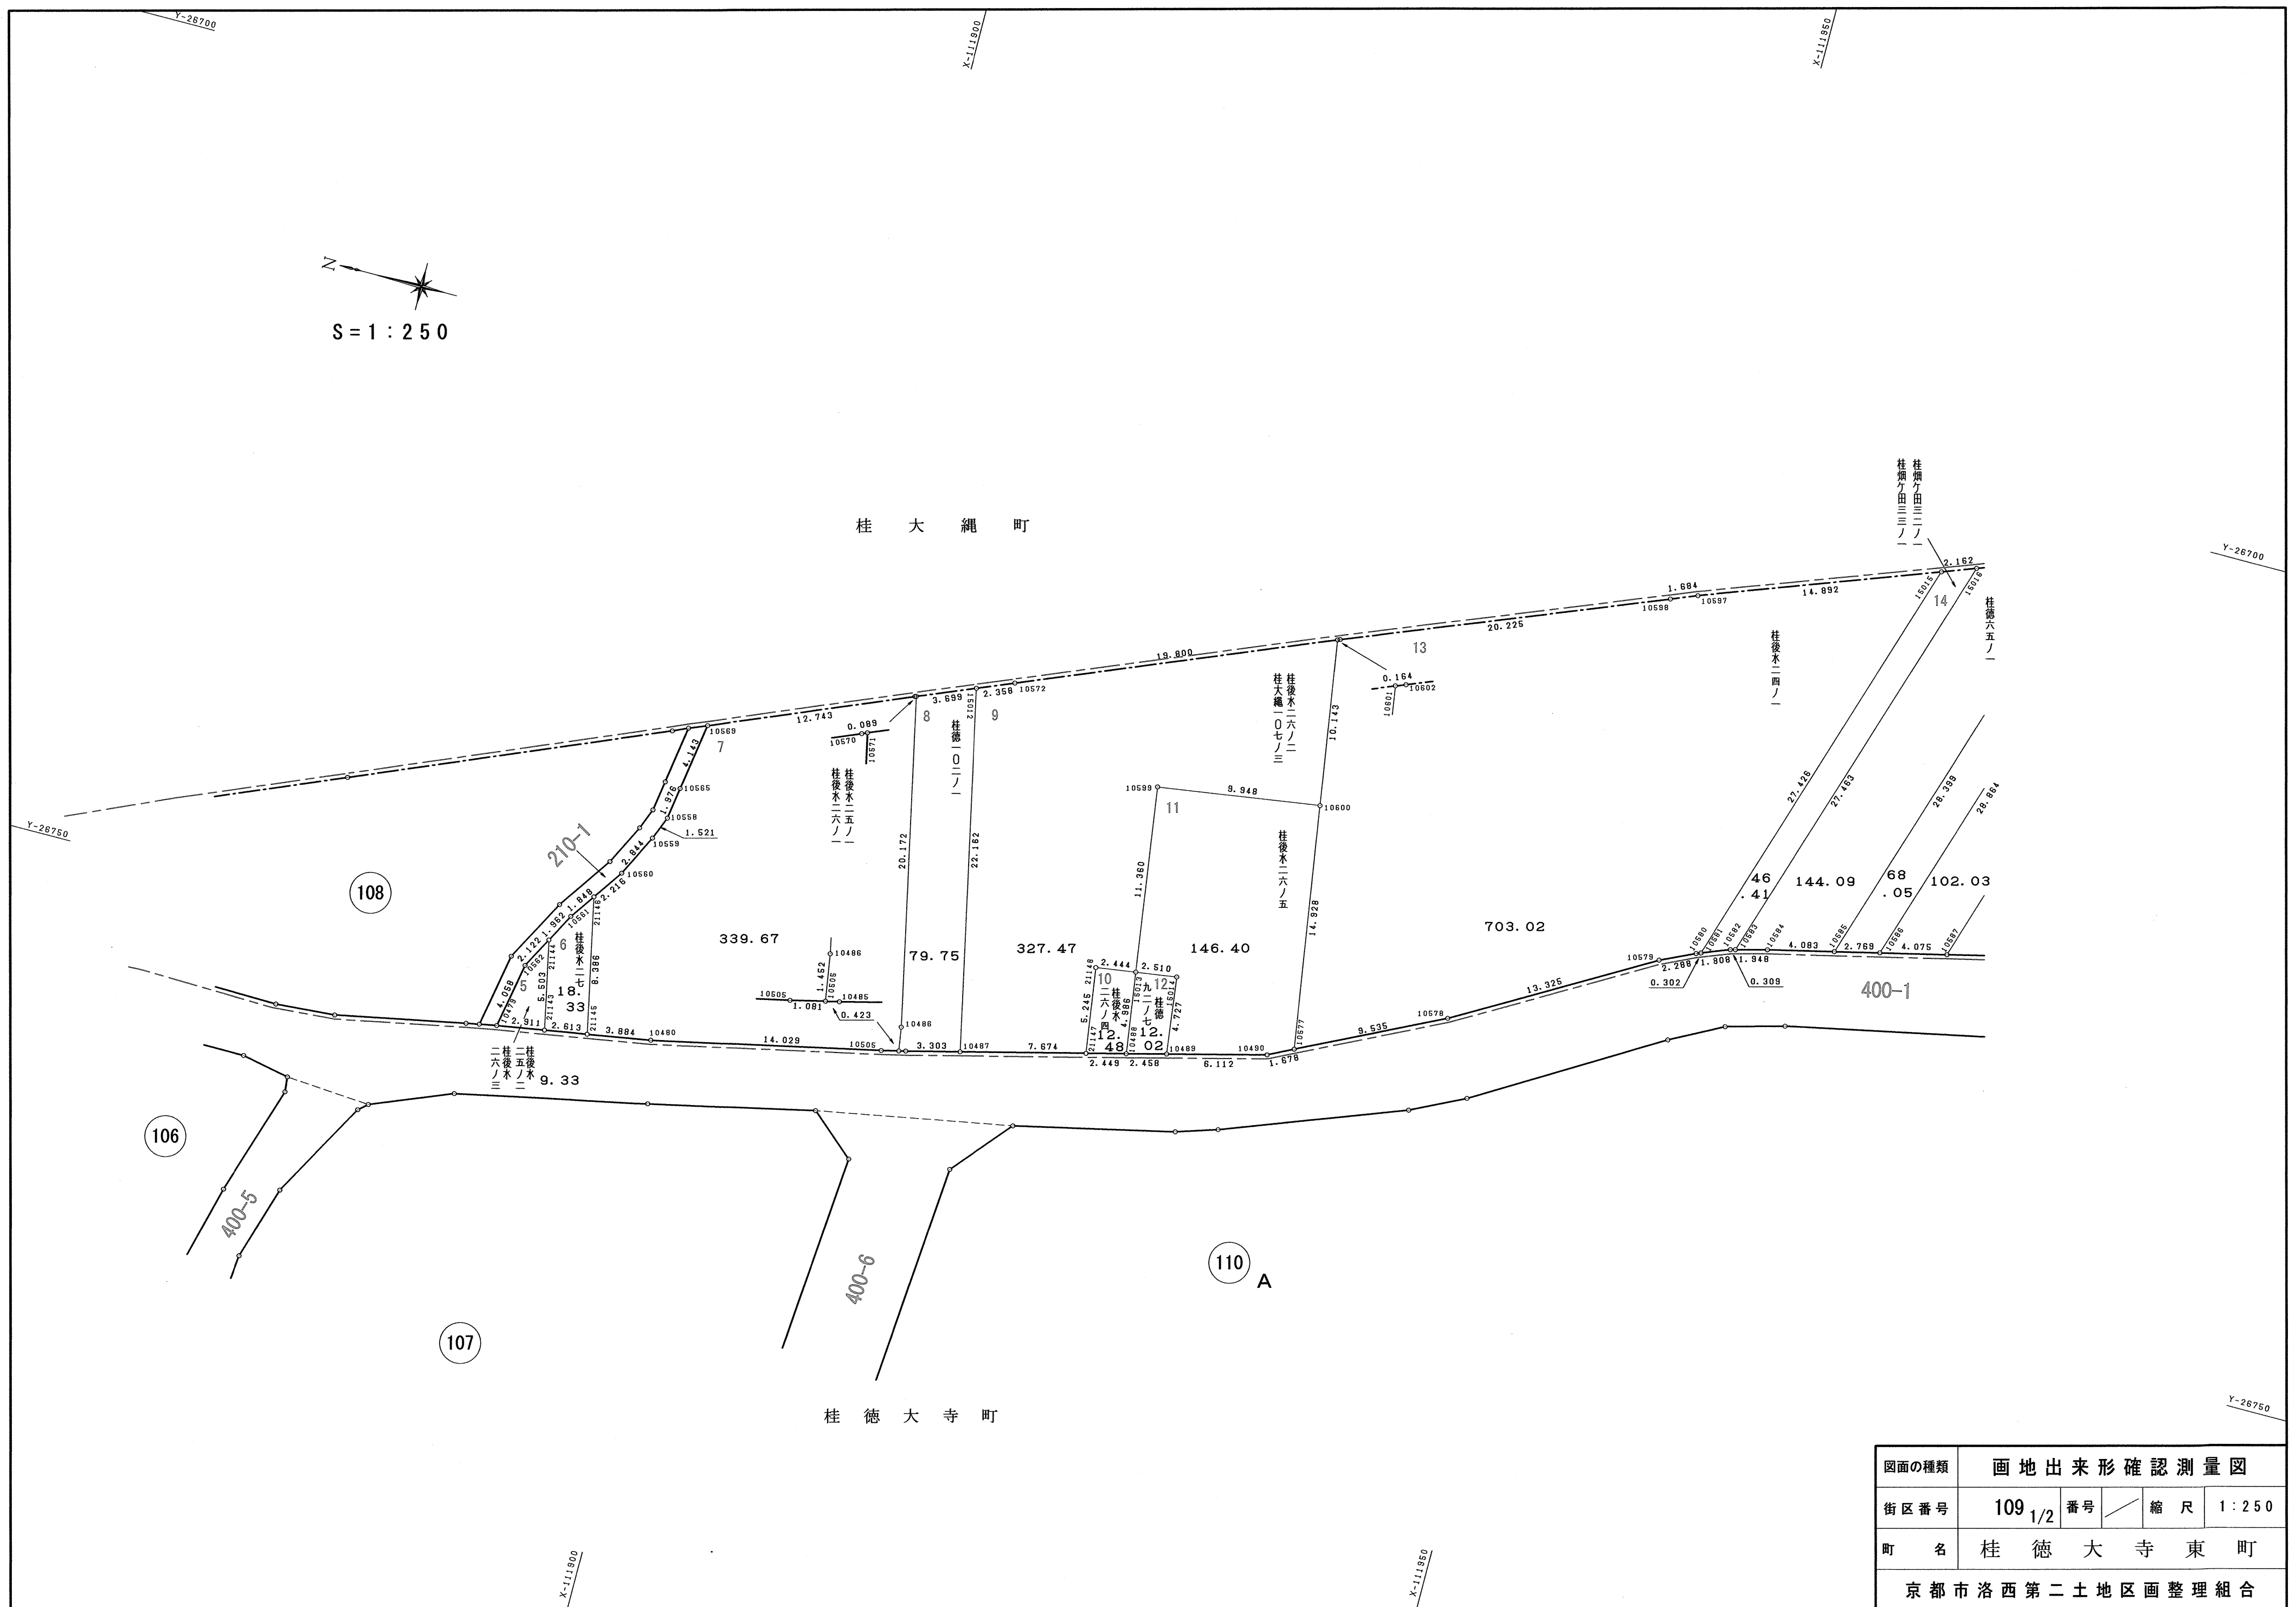

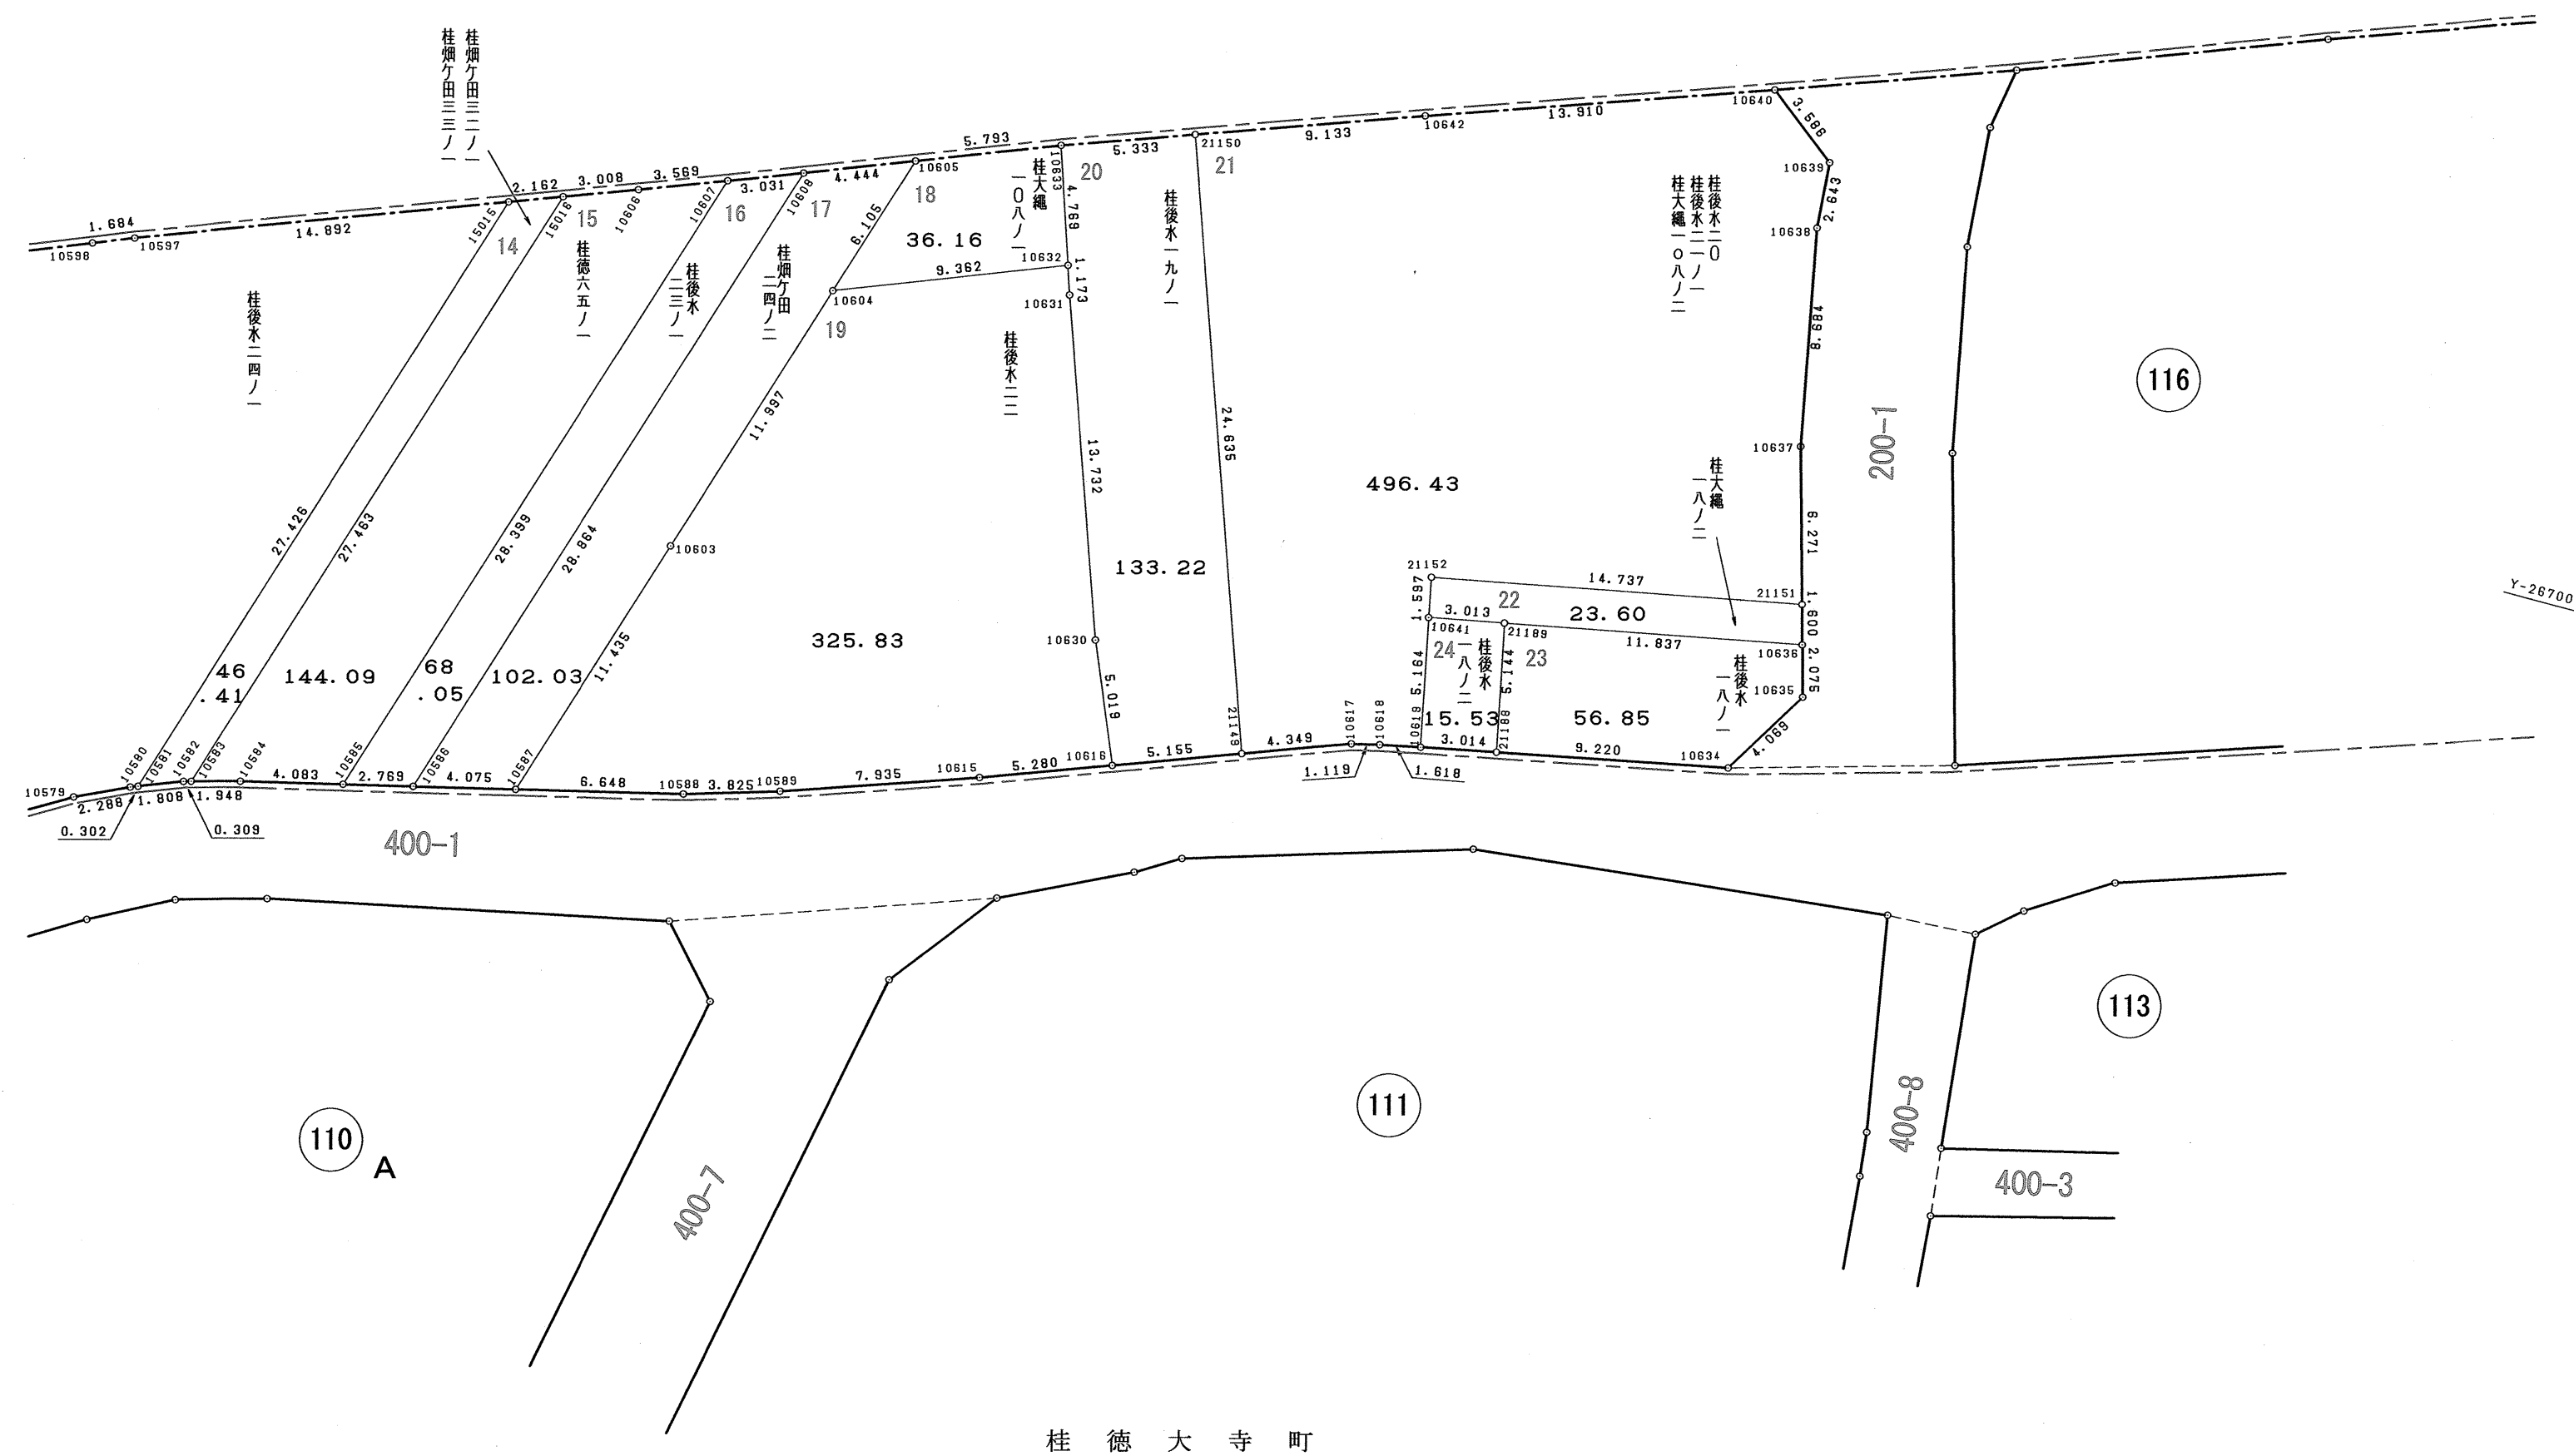

図面の種類	画地出来形確認測量図				
街区番号	109	2/2	番号	縮尺	1:250
町名	桂 徳 大 寺 東 町				
京都市洛西第二土地区画整理組合					

5

地番	桂後水二五ノ二、桂後水二六ノ三		
N O	X	Y	辺長
10479	-111886.834	-26754.277	
21143	-111889.706	-26753.805	2.911
21144	-111888.575	-26748.419	5.503
10562	-111887.566	-26750.286	2.122
10479	-111886.834	-26754.277	4.058
面積	9.3313495		
地積	9.33㎡		

6

地番	桂後水二七		
N O	X	Y	辺長
21144	-111888.575	-26748.419	
21143	-111889.706	-26753.805	5.503
21145	-111892.285	-26753.382	2.613
21146	-111890.561	-26745.175	8.386
10561	-111889.507	-26746.693	1.848
21144	-111888.575	-26748.419	1.962
面積	18.3325465		
地積	18.33㎡		

7

地番	桂後水二五ノ一、桂後水二六ノ一		
N O	X	Y	辺長
21145	-111892.285	-26753.382	
10480	-111896.118	-26752.752	3.884
10505	-111909.837	-26749.819	14.029
10484	-111910.891	-26749.577	1.081
10486	-111910.669	-26748.142	1.452
10571	-111906.448	-26728.417	20.172
10570	-111906.366	-26728.451	0.089
10569	-111894.604	-26733.355	12.743
10565	-111893.964	-26737.448	4.143
10558	-111893.667	-26739.402	1.976
10559	-111893.100	-26740.813	1.521
10560	-111891.825	-26743.355	2.844
21146	-111890.561	-26745.175	2.216
21145	-111892.285	-26753.382	8.386
面積	339.6739615		
地積	339.67㎡		

8

地番	桂徳一〇二ノ一		
N O	X	Y	辺長
10484	-111910.891	-26749.577	
10485	-111911.303	-26749.483	0.423
10487	-111914.507	-26748.681	3.303
15012	-111909.869	-26727.010	22.162
10571	-111906.448	-26728.417	3.699
10486	-111910.669	-26748.142	20.172
10484	-111910.891	-26749.577	1.452
面積	79.7543540		
地積	79.75㎡		

9

地番	桂後水二六ノ二、桂大縄一〇七ノ三		
N O	X	Y	辺長
10487	-111914.507	-26748.681	
21147	-111921.951	-26746.818	7.674
21148	-111921.214	-26741.625	5.245
15013	-111923.634	-26741.285	2.444
10599	-111922.056	-26730.035	11.360
10600	-111931.906	-26728.645	9.948
10601	-111930.377	-26718.618	10.143
10572	-111912.050	-26726.113	19.800
15012	-111909.869	-26727.010	2.359
10487	-111914.507	-26748.681	22.162
面積	327.4763680		
地積	327.47㎡		

10

地番	桂後水二六ノ四		
N O	X	Y	辺長
21147	-111921.951	-26746.818	
10488	-111924.327	-26746.223	2.449
15013	-111923.634	-26741.285	4.986
21148	-111921.214	-26741.625	2.444
21147	-111921.951	-26746.818	5.245
面積	12.4813315		
地積	12.48㎡		

11

地番	桂後水二六ノ五		
N O	X	Y	辺長
10489	-111926.711	-26745.626	
10490	-111932.640	-26744.142	6.112
10577	-111934.147	-26743.404	1.678
10600	-111931.906	-26728.645	14.928
10599	-111922.056	-26730.035	9.948
15013	-111923.634	-26741.285	11.360
15014	-111926.120	-26740.936	2.510
10489	-111926.711	-26745.626	4.727
面積	146.4044965		
地積	146.40㎡		

12

地番	桂徳九二ノ七		
N O	X	Y	辺長
10488	-111924.327	-26746.223	
10489	-111926.711	-26745.626	2.458
15014	-111926.120	-26740.936	4.727
15013	-111923.634	-26741.285	2.510
10488	-111924.327	-26746.223	4.986
面積	12.0257560		
地積	12.02㎡		

13

地番	桂後水二四ノ一		
N O	X	Y	辺長
10577	-111934.147	-26743.404	
10578	-111942.711	-26739.212	9.535
10579	-111954.234	-26732.521	13.325
10580	-111956.305	-26731.548	2.288
10581	-111956.587	-26731.440	0.302
15015	-111964.852	-26705.289	27.426
10597	-111950.881	-26710.446	14.892
10598	-111949.318	-26711.072	1.684
10602	-111930.529	-26718.556	20.225
10601	-111930.377	-26718.618	0.164
10600	-111931.906	-26728.645	10.143
10577	-111934.147	-26743.404	14.928
面積	703.0235800		
地積	703.02㎡		

14

地番	桂畑ヶ田三二ノ一、桂畑ヶ田三三ノ一		
N O	X	Y	辺長
10581	-111956.587	-26731.440	
10582	-111958.276	-26730.795	1.808
10583	-111958.575	-26730.718	0.309
15016	-111966.880	-26704.541	27.463
15015	-111964.852	-26705.289	2.162
10581	-111956.587	-26731.440	27.426
面積	46.4184360		
地積	46.41㎡		

15

地番	桂徳六五ノ一		
N O	X	Y	辺長
10583	-111958.575	-26730.718	
10584	-111960.461	-26730.229	1.948
10585	-111964.436	-26729.298	4.083
10607	-111973.039	-26702.233	28.399
10606	-111969.702	-26703.499	3.569
15016	-111966.880	-26704.541	3.008
10583	-111958.575	-26730.718	27.463
面積	144.0922505		
地積	144.09㎡		

16

地番	桂後水二三ノ一		
N O	X	Y	辺長
10585	-111964.436	-26729.298	
10586	-111967.132	-26728.667	2.769
10608	-111975.873	-26701.158	28.864
10607	-111973.039	-26702.233	3.031
10585	-111964.436	-26729.298	28.399
面積	68.0513390		
地積	68.05㎡		

17

地番	桂畑ヶ田二四ノ二		
N O	X	Y	辺長
10586	-111967.132	-26728.667	
10587	-111971.100	-26727.738	4.075
10603	-111974.560	-26716.839	11.435
10604	-111978.184	-26705.402	11.997
10605	-111980.028	-26699.582	6.105
10608	-111975.873	-26701.158	4.444
10586	-111967.132	-26728.667	28.864
面積	102.0341575		
地積	102.03㎡		

18

地番	桂大縄一〇八ノ一		
N O	X	Y	辺長
10604	-111978.184	-26705.402	
10632	-111986.929	-26702.059	9.362
10633	-111985.444	-26697.527	4.769
10605	-111980.028	-26699.582	5.793
10604	-111978.184	-26705.402	6.105
面積	36.1641975		
地積	36.16㎡		

19

地番	桂後水二二		
N O	X	Y	辺長
10587	-111971.100	-26727.738	
10598	-111977.573	-26726.222	6.648
10589	-111981.243	-26725.144	3.825
10615	-111988.758	-26722.596	7.935
10616	-111993.717	-26720.784	5.280
10630	-111991.796	-26716.147	5.019
10631	-111987.288	-26703.176	13.732
10632	-111986.929	-26702.059	1.173
10604	-111978.184	-26705.402	9.362
10603	-111974.560	-26716.839	11.997
10587	-111971.100	-26727.738	11.435
面積	325.8338355		
地積	325.83㎡		

20

地番	桂後水一九ノ一		
N O	X	Y	辺長
10631	-111987.288	-26703.176	
10630	-111991.796	-26716.147	13.732
10616	-111993.717	-26720.784	5.019
21149	-111998.559	-26719.015	5.155
21150	-111990.471	-26695.746	24.635
10633	-111985.444	-26697.527	5.333
10632	-111986.929	-26702.059	4.769
10631	-111987.288	-26703.176	1.173
面積	133.2267645		
地積	133.22㎡		

21

地番	桂後水二〇、桂後水二一ノ一 桂大縄一〇八ノ二		
N O	X	Y	辺長
21149	-111998.559	-26719.015	
10617	-112002.644	-26717.523	4.349
10618	-112003.733	-26717.267	1.119
10619	-112005.321	-26716.956	1.618
10641	-112004.315	-26711.891	5.164
21152	-112004.004	-26710.325	1.597
21151	-112018.486	-26707.597	14.737
10637	-112016.831	-26701.548	6.271
10638	-112015.293	-26693.012	8.684
10639	-112015.048	-26690.375	2.643
10640	-112012.229	-26688.159	3.586
10642	-111999.080	-26692.696	13.910
21150	-111990.471	-26695.746	9.133
21149	-111998.559	-26719.015	24.635
面積	496.4394545		
地積	496.43㎡		

22

地番	桂大縄一八ノ二		
N O	X	Y	辺長
10641	-112004.315	-26711.891	
21189	-112007.276	-26711.333	3.013
10636	-112018.908	-26709.140	11.837
21151	-112018.486	-26707.597	1.600
21152	-112004.004	-26710.325	14.737
10641	-112004.315	-26711.891	1.597
面積	23.6039790		
地積	23.60㎡		

23

地番	桂後水一八ノ一		
N O	X	Y	辺長
21188	-112008.279	-26716.378	
10634	-112017.327	-26714.608	9.220
10635	-112019.456	-26711.141	4.069
10636	-112018.908	-26709.140	2.075
21189	-112007.276	-26711.333	11.837
21188	-112008.279	-26716.378	5.144
面積	56.8595790		
地積	56.85㎡		



S = 1 : 250

桂 徳 大 寺 東 町

109

111

107

110

B

公

6

図面の種類	画地出来形確認測量図				
街区番号	110A	番号	／	縮尺	1：250
町名	桂徳大寺町				
京都市洛西第二土地区画整理組合					

216

地番	桂徳六七ノ一		
N O	X	Y	辺 長
10529	-111915.385	-26798.337	
10530	-111918.788	-26800.870	4.242
10545	-111926.078	-26799.771	7.372
15005	-111924.319	-26787.907	11.994
10520	-111914.044	-26789.436	10.388
10521	-111914.057	-26789.644	0.208
10529	-111915.385	-26798.337	8.794
面積	120.1080960		
地積	120.10 ㎡		

217-1

地番	桂徳六七ノ二		
N O	X	Y	辺 長
7330	-111913.701	-26784.142	
10520	-111914.044	-26789.436	5.305
15005	-111924.319	-26787.907	10.388
7329	-111923.620	-26783.191	4.768
7330	-111913.701	-26784.142	9.964
面積	51.1815250		
地積	51.18 ㎡		

217-2

地番	桂徳六七ノ四			
N O	X	Y	辺 長	
7330	-111913.701	-26784.142		
7329	-111923.620	-26783.191	9.964	
15004	-111923.324	-26781.193	2.020	
10519	-111913.604	-26782.639	9.827	
7330	-111913.701	-26784.142	1.506	
面積	17.4245400			
地積	17.42 ㎡			

218			
地 番	桂徳六四ノ一		
N O	X	Y	辺 長
10492	-111930.609	-26749.402	
10493	-111928.423	-26750.091	2.292
10496	-111918.762	-26752.231	9.895
10497	-111915.716	-26755.781	4.678
10502	-111914.615	-26769.446	13.709
10518	-111913.589	-26782.406	13.001
10519	-111913.604	-26782.639	0.233
15004	-111923.324	-26781.193	9.827
10682	-111933.588	-26779.666	10.377
21169	-111932.622	-26769.563	10.149
21167	-111932.298	-26766.181	3.397
10681	-111932.062	-26763.714	2.478
10680	-111931.623	-26758.936	4.798
10495	-111931.155	-26754.161	4.798
10494	-111930.939	-26751.755	2.416
10492	-111930.609	-26749.402	2.376
面積	517.7257090		
地積	517.72 ㎡		

219			
地番	桂徳六一ノ三、桂徳六二ノ七		
N O	X	Y	辺 長
10596	-111935.817	-26747.470	
10491	-111930.913	-26749.306	5.236
10492	-111930.609	-26749.402	0.319
10494	-111930.939	-26751.755	2.376
10495	-111931.155	-26754.161	2.416
10690	-111941.367	-26752.689	10.318
10691	-111939.828	-26749.144	3.865
10596	-111935.817	-26747.470	4.346
面積	49.2876945		
地積	49.28 ㎡		

220

地番	桂徳六一ノ二			
N O	X	Y	辺 長	
10690	-111941.367	-26752.689		
10495	-111931.155	-26754.161	10.318	
10680	-111931.623	-26758.936	4.798	
10688	-111941.912	-26757.464	10.394	
10689	-111941.495	-26752.976	4.507	
10690	-111941.367	-26752.689	0.314	
面積	49.9190980			
地積	49.91 m ²			

221			
地番	桂徳六一ノ一		
N O	X	Y	辺長
10687	-111943.884	-26757.159	
10688	-111941.912	-26757.464	1.995
10680	-111931.623	-26758.936	10.394
10681	-111932.062	-26763.714	4.798
10655	-111941.006	-26762.346	9.048
10693	-111944.317	-26761.950	3.335
10687	-111943.884	-26757.159	4.811
面積	58.8088465		
地積	58.80 m ²		

222			
地番	桂徳六二ノ八、桂徳六三ノ五		
N O	X	Y	辺 長
10594	-111942.383	-26744.947	
10595	-111941.831	-26745.218	0.615
10596	-111935.817	-26747.470	6.422
10691	-111939.828	-26749.144	4.346
10690	-111941.367	-26752.689	3.865
10689	-111941.495	-26752.976	0.314
10688	-111941.912	-26757.464	4.507
10687	-111943.884	-26757.159	1.995
10686	-111945.863	-26756.880	1.999
10685	-111945.462	-26752.048	4.849
10594	-111942.383	-26744.947	7.740
面積	53.0068165		
地積	53.00 ㎡		

223			
地番	桂徳六三ノ一		
N O	X	Y	辺長
10590	-111959.332	-26735.371	
10591	-111959.169	-26735.415	0.169
10592	-111955.979	-26737.080	3.598
10593	-111945.067	-26743.628	12.726
10594	-111942.383	-26744.947	2.991
10685	-111945.462	-26752.048	7.740
10658	-111954.721	-26750.398	9.405
10659	-111960.113	-26749.472	5.471
10590	-111959.332	-26735.371	14.123
面積	179.1068060		
地積	179.10 ㎡		

224

地 番	桂徳六二ノ六		
N O	X	Y	辺 長
10658	-111954.721	-26750.398	
10685	-111945.462	-26752.048	9.405
10686	-111945.863	-26756.880	4.849
10656	-111954.967	-26755.514	9.206
21159	-111954.904	-26754.194	1.322
21157	-111954.805	-26752.140	2.056
10658	-111954.721	-26750.398	1.744
面積	46.1578640		
地積	46.15 ㎡		

225			
地番	桂徳六二ノ一		
N O	X	Y	辺 長
10656	-111954.967	-26755.514	
10686	-111945.863	-26756.880	9.206
10687	-111943.884	-26757.159	1.999
10693	-111944.317	-26761.950	4.811
10692	-111946.258	-26761.720	1.955
21165	-111951.852	-26760.862	5.659
10657	-111955.182	-26760.351	3.369
21163	-111955.103	-26758.575	1.778
21161	-111955.000	-26756.256	2.321
10656	-111954.967	-26755.514	0.743
面積	53.5756755		
地積	53.57 m ²		


226			
地番	桂徳六〇ノ一		
N O	X	Y	辺長
10609	-111962.677	-26734.460	
10590	-111959.332	-26735.371	3.467
10659	-111960.113	-26749.472	14.123
10658	-111954.721	-26750.398	5.471
21157	-111954.805	-26752.140	1.744
21158	-111977.158	-26751.459	22.363
21155	-111977.283	-26750.827	0.644
21156	-111963.535	-26751.246	13.754
10660	-111963.452	-26749.624	1.624
10609	-111962.677	-26734.460	15.184
面積	77.2445615		
地積	77.24 m ²		

227			
地番	桂徳三九ノ六		
N O	X	Y	辺 長
10660	-111963.452	-26749.624	
21156	-111963.535	-26751.246	1.624
21155	-111977.283	-26750.827	13.754
10614	-111977.478	-26749.843	1.003
10613	-111977.610	-26749.192	0.664
21153	-111965.615	-26749.558	12.001
10660	-111963.452	-26749.624	2.164
面積	22.6690840		
地積	22.66 m ²		

228

地番	桂徳六二ノ五		
N O	X	Y	辺長
21158	-111977.158	-26751.459	
21157	-111954.805	-26752.140	22.363
21159	-111954.804	-26754.194	2.056
21160	-111976.747	-26753.529	21.853
21158	-111977.158	-26751.459	2.110
面積	45.4610880		
地積	45.46 m ²		

229			
地番	桂徳一一〇		
N O	X	Y	辺長
21159	-111954.904	-26754.194	
10656	-111954.967	-26755.514	1.322
21161	-111955.000	-26756.256	0.743
21162	-111976.334	-26755.607	21.344
21160	-111976.747	-26753.529	2.119
21159	-111954.904	-26754.194	21.853
面積	44.5824675		
地積	44.58 m ²		

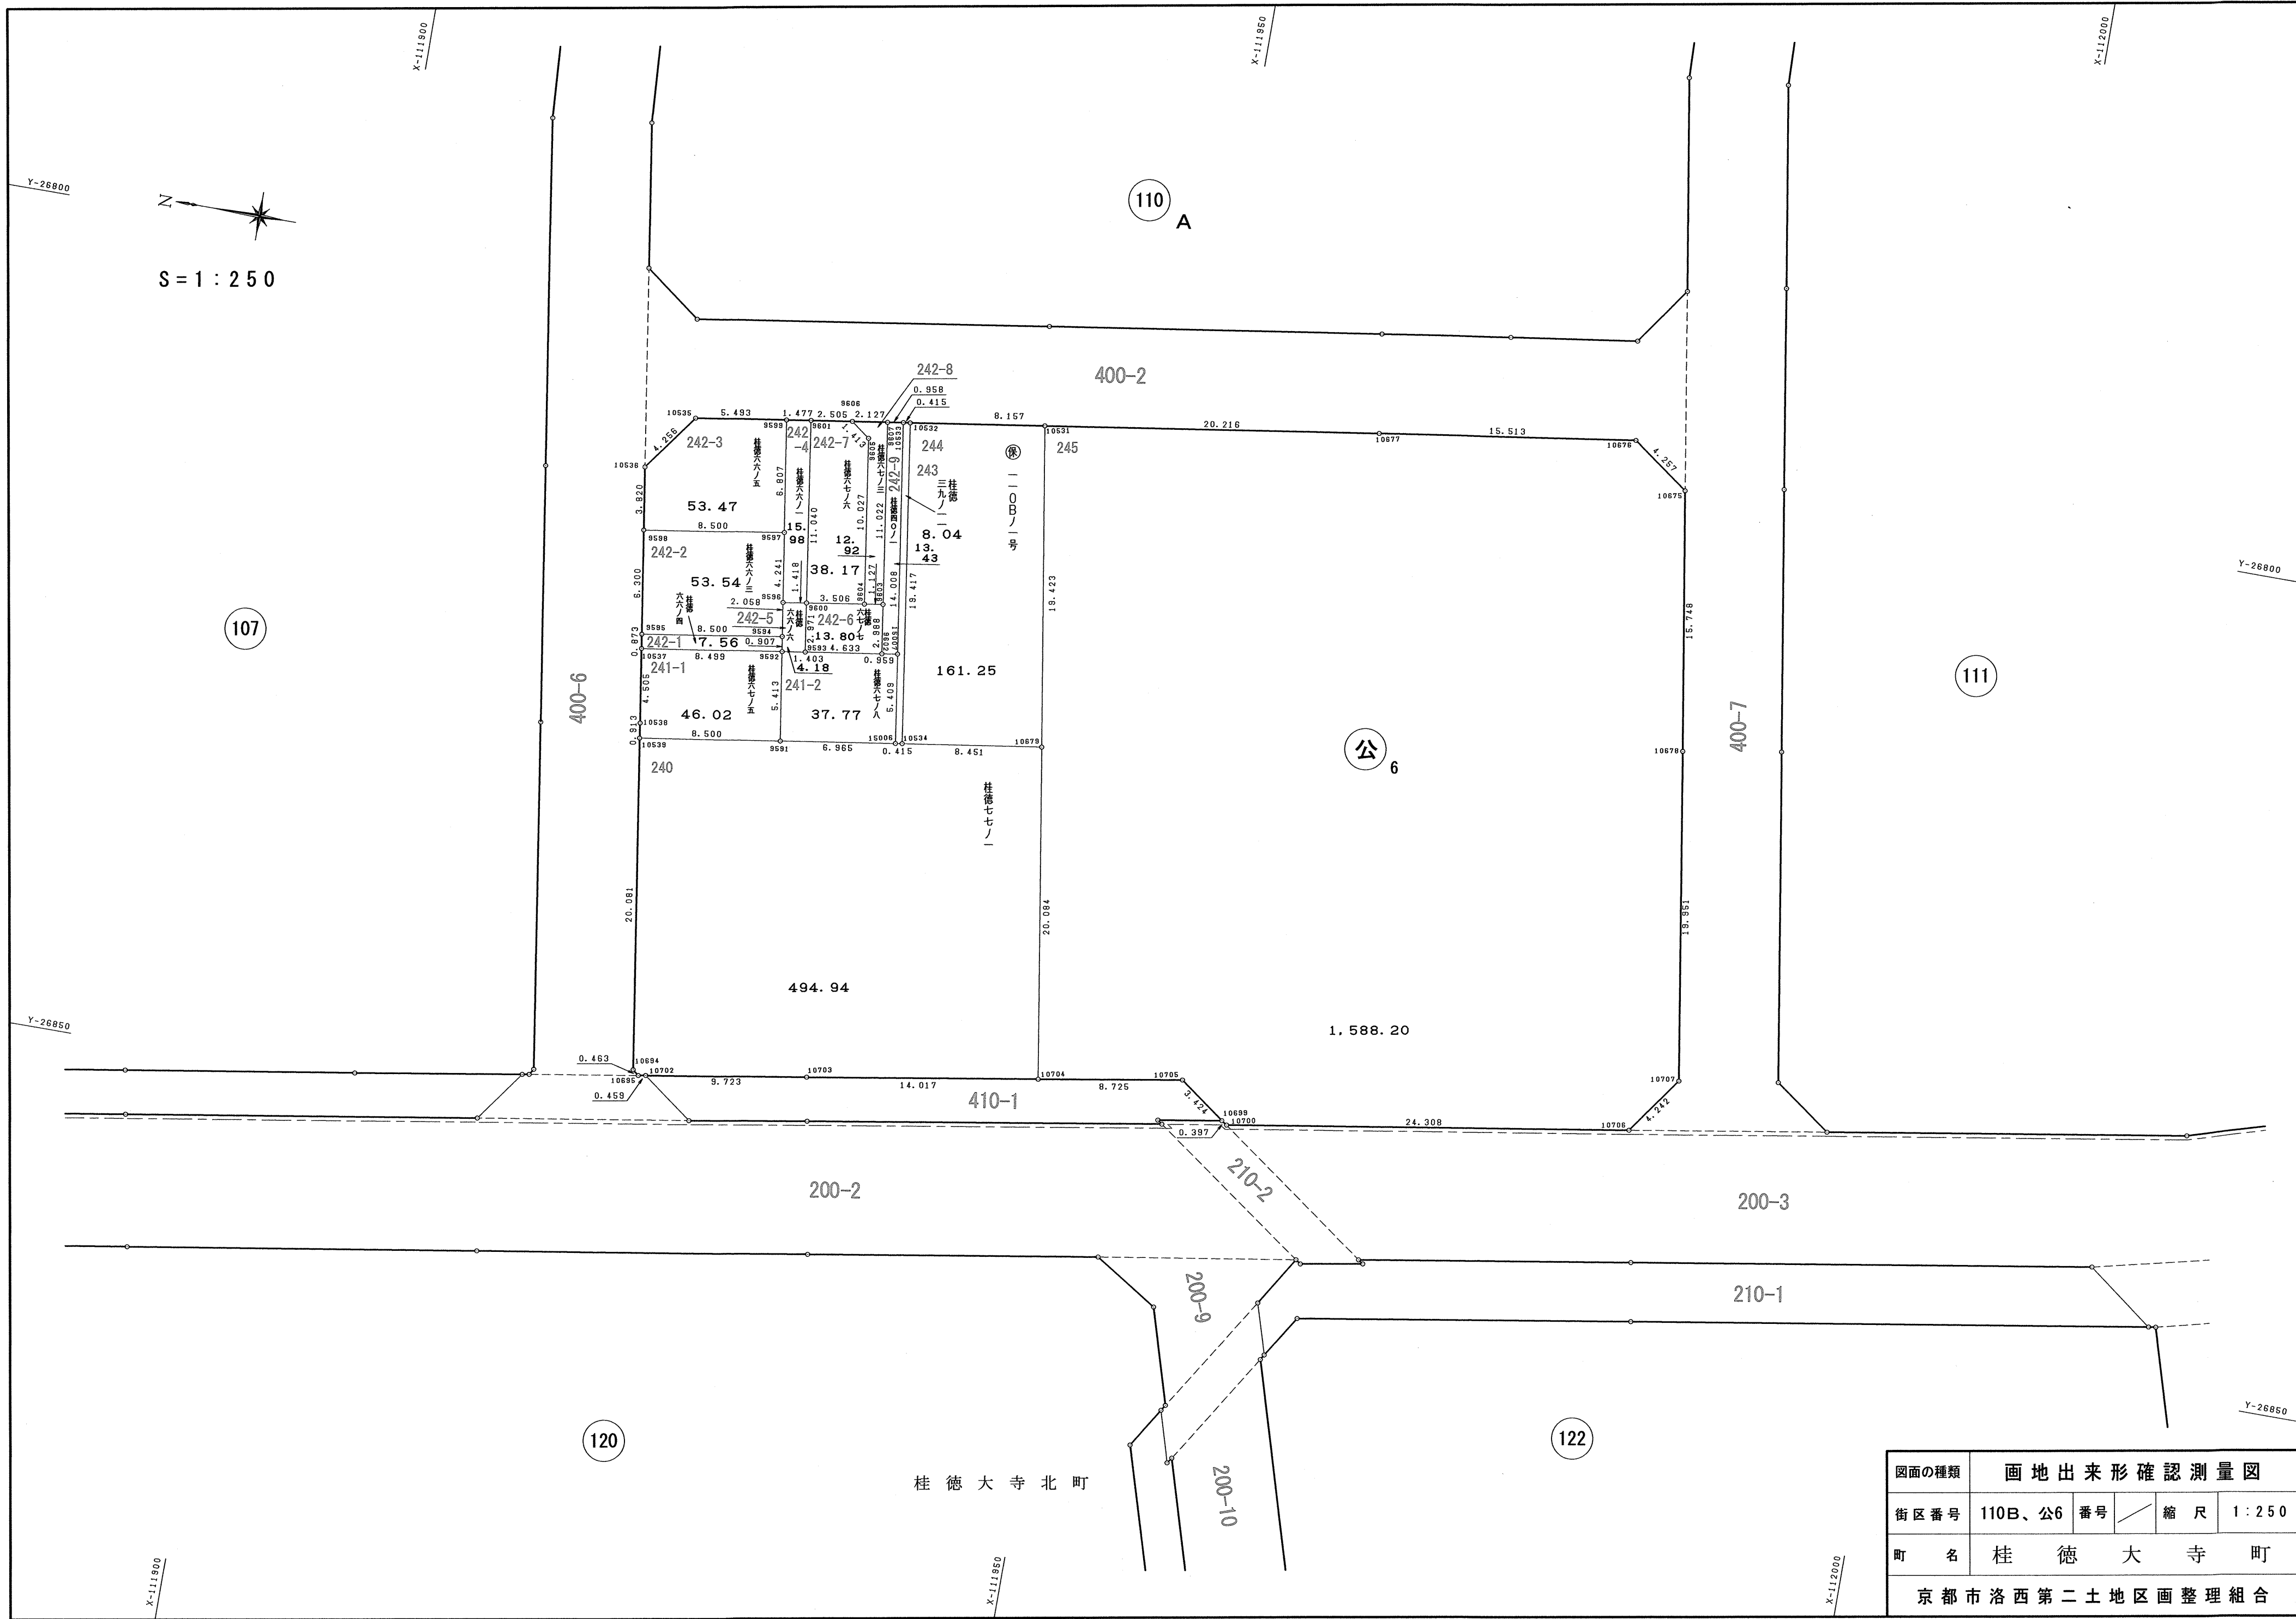

図面の種類	画地出来形確認測量図				
街区番号	110B、公6	番号		縮尺	1：250
町名	桂 徳 大 寺 町				
京都市洛西第二土地区画整理組合					

240

地 番	桂徳七七ノ一		
N O	X	Y	辺 長
10694	-111922.772	-26846.291	
10695	-111923.134	-26846.579	0.463
10702	-111923.586	-26846.502	0.459
10703	-111933.184	-26844.950	9.723
10704	-111947.012	-26842.653	14.017
10679	-111943.774	-26822.832	20.084
10534	-111935.415	-26824.077	8.451
15006	-111935.005	-26824.139	0.415
9591	-111928.118	-26825.177	6.965
10539	-111919.713	-26826.444	8.500
10694	-111922.772	-26846.291	20.081
面積	494.9416895		
地積	494.94㎡		

241-1

地 番	桂徳六七ノ五		
N O	X	Y	辺 長
10539	-111919.713	-26826.444	
9591	-111928.118	-26825.177	8.500
9592	-111927.292	-26819.827	5.413
10537	-111918.887	-26821.090	8.499
10538	-111919.574	-26825.542	4.505
10539	-111919.713	-26826.444	0.913
面積	46.0280270		
地積	46.02㎡		

241-2

地 番	桂徳六七ノ八		
N O	X	Y	辺 長
9591	-111928.118	-26825.177	
15006	-111935.005	-26824.139	6.965
15007	-111934.209	-26818.789	5.409
9602	-111933.260	-26818.929	0.959
9593	-111928.679	-26819.619	4.633
9592	-111927.292	-26819.827	1.403
9591	-111928.118	-26825.177	5.413
面積	37.7737680		
地積	37.77㎡		

242-1

地 番	桂徳六六ノ四		
N O	X	Y	辺 長
10537	-111918.887	-26821.090	
9592	-111927.292	-26819.827	8.499
9594	-111927.154	-26818.931	0.907
9595	-111918.753	-26820.227	8.500
10537	-111918.887	-26821.090	0.873
面積	7.5644505		
地積	7.56㎡		

242-2

地 番	桂徳六六ノ三		
N O	X	Y	辺 長
9595	-111918.753	-26820.227	
9594	-111927.154	-26818.931	8.500
9596	-111926.840	-26816.897	2.058
9597	-111926.194	-26812.705	4.241
9598	-111917.793	-26814.001	8.500
9595	-111918.753	-26820.227	6.300
面積	53.5476240		
地積	53.54㎡		

242-3

地 番	桂徳六六ノ五		
N O	X	Y	辺 長
9598	-111917.793	-26814.001	
9597	-111926.194	-26812.705	8.500
9599	-111925.156	-26805.978	6.807
10535	-111919.723	-26806.791	5.493
10536	-111917.211	-26810.226	4.256
9598	-111917.793	-26814.001	3.820
面積	53.4717925		
地積	53.47㎡		

242-4

地 番	桂徳六六ノ一		
N O	X	Y	辺 長
9596	-111926.840	-26816.897	
9600	-111928.241	-26816.680	1.418
9601	-111926.617	-26805.760	11.040
9599	-111925.156	-26805.978	1.477
9597	-111926.194	-26812.705	6.807
9596	-111926.840	-26816.897	4.241
面積	15.9827225		
地積	15.98㎡		

242-5

地 番	桂徳六六ノ六		
N O	X	Y	辺 長
9592	-111927.292	-26819.827	
9593	-111928.679	-26819.619	1.403
9600	-111928.241	-26816.680	2.971
9596	-111926.840	-26816.897	1.418
9594	-111927.154	-26818.931	2.058
9592	-111927.292	-26819.827	0.907
面積	4.1849295		
地積	4.18㎡		

242-6

地 番	桂徳六七ノ七		
N O	X	Y	辺 長
9593	-111928.679	-26819.619	
9602	-111933.260	-26818.929	4.633
9603	-111932.820	-26815.974	2.988
9604	-111931.706	-26816.146	1.127
9600	-111928.241	-26816.680	3.506
9593	-111928.679	-26819.619	2.971
面積	13.8031300		
地積	13.80㎡		

242-7

地 番	桂徳六七ノ六		
N O	X	Y	辺 長
9600	-111928.241	-26816.680	
9604	-111931.706	-26816.146	3.506
9605	-111930.230	-26806.228	10.027
9606	-111929.094	-26805.387	1.413
9601	-111926.617	-26805.760	2.505
9600	-111928.241	-26816.680	11.040
面積	38.1774335		
地積	38.17㎡		

242-8

地 番	桂徳六七ノ三		
N O	X	Y	辺 長
9604	-111931.706	-26816.146	
9603	-111932.820	-26815.974	1.127
9607	-111931.198	-26805.072	11.022
9606	-111929.094	-26805.387	2.127
9605	-111930.230	-26806.228	1.413
9604	-111931.706	-26816.146	10.027
面積	12.9289980		
地積	12.92㎡		

242-9

地 番	桂徳四〇ノ一		
N O	X	Y	辺 長
9602	-111933.260	-26818.929	
15007	-111934.209	-26818.789	0.959
10533	-111932.146	-26804.934	14.008
9607	-111931.198	-26805.072	0.958
9603	-111932.820	-26815.974	11.022
9602	-111933.260	-26818.929	2.988
面積	13.4310385		
地積	13.43㎡		

243

地 番	桂徳三九ノ一一		
N O	X	Y	辺 長
15006	-111935.005	-26824.139	
10534	-111935.415	-26824.077	0.415
10532	-111932.556	-26804.872	19.417
10533	-111932.146	-26804.934	0.415
15007	-111934.209	-26818.789	14.008
15006	-111935.005	-26824.139	5.409
面積	8.0470730		
地積	8.04㎡		

244

地 番	保 一一〇Bノ一号		
N O	X	Y	辺 長
10531	-111940.623	-26803.666	
10532	-111932.556	-26804.872	8.157
10534	-111935.415	-26824.077	19.417
10679	-111943.774	-26822.832	8.451
10531	-111940.623	-26803.666	19.423
面積	161.2531390		
地積	161.25㎡		

図面の種類	画 地 面 積 求 積 表			
街区 番号	110B	番号	／	縮 尺
町 名	桂 徳 大 寺 町			
京 都 市 洛 西 第 二 土 地 区 画 整 理 組 合				

地 番	公園6		
N O	X	Y	辺 長
10704	-111947.012	-26842.653	
10705	-111955.619	-26841.224	8.725
10699	-111958.385	-26843.243	3.424
10700	-111958.722	-26843.453	0.397
10706	-111982.720	-26839.583	24.308
10707	-111985.186	-26836.132	4.242
10678	-111981.986	-26816.439	19.951
10675	-111979.422	-26800.901	15.748
10676	-111975.964	-26798.418	4.257
10677	-111960.617	-26800.678	15.513
10531	-111940.623	-26803.666	20.216
10679	-111943.774	-26822.832	19.423
10704	-111947.012	-26842.653	20.084
面積	1588.2080245		
地積	1588.20 m ²		

図面の種類	画 地 面 積 求 積 表			
街区番号	公6	番号	縮 尺	
町 名	桂 徳 大 寺 町			
京 都 市 洛 西 第 二 土 地 区 画 整 理 組 合				



図面の種類	画地出来形確認測量図				
街区番号	111	番号	／	縮尺	1:250
町名	桂徳大寺町				
京都市洛西第二土地区画整理組合					

246

地番	桂徳五三ノ一		
N O	X	Y	辺 長
10708	-111991.136	-26835.186	
10709	-111994.554	-26837.637	4.206
10986	-112004.689	-26835.976	10.270
10976	-112002.690	-26823.474	12.661
10674	-111989.563	-26825.606	13.299
10708	-111991.136	-26835.186	9.708
面積	163.7444375		
地積	163.74 m ²		

247

地番	桂徳五七		
N O	X	Y	辺 長
10674	-111989.563	-26825.606	
10976	-112002.690	-26823.474	13.299
10975	-112008.783	-26822.463	6.176
15098	-112007.419	-26815.563	7.034
10673	-111988.425	-26818.678	19.248
10674	-111989.563	-26825.606	7.021
面積	136.1607375		
地積	136.16 m ²		

248

地番	桂徳三九ノ一二		
N O	X	Y	辺 長
10673	-111988.425	-26818.678	
15098	-112007.419	-26815.563	19.248
10974	-112007.120	-26814.053	1.539
10973	-112007.205	-26813.457	0.602
10972	-112007.022	-26812.873	0.612
10971	-112005.650	-26809.109	4.006
10970	-112003.867	-26807.470	2.422
10969	-112003.137	-26807.407	0.733
10968	-111997.923	-26808.809	5.399
10967	-111996.208	-26800.841	8.150
15091	-111995.523	-26797.819	3.099
10670	-111985.268	-26799.489	10.390
10671	-111985.319	-26799.800	0.315
10672	-111987.895	-26815.451	15.862
10673	-111988.425	-26818.678	3.270
面積	276.6107650		
地積	276.61 m ²		

249

地 番		桂徳三九ノ一〇	
N O	X	Y	辺 長
10670	-111985.268	-26799.489	
15091	-111995.523	-26797.819	10.390
10966	-111993.944	-26790.851	7.145
15090	-111990.046	-26789.185	4.239
10669	-111983.760	-26790.208	6.369
10670	-111985.268	-26799.489	9.403
面積			91.0509800
地積			91.05 ㎡

250

桂徳三六ノ二				
地番	N O	X	Y	辺 長
	10669	-111983.760	-26790.208	
	15090	-111990.046	-26789.185	6.369
	10966	-111993.944	-26790.851	4.239
	10965	-111998.709	-26789.364	4.992
	10964	-111998.830	-26784.955	4.411
	10963	-112000.081	-26783.411	1.987
	10962	-112002.426	-26781.801	2.844
	10961	-112005.881	-26780.379	3.736
	10960	-112004.409	-26772.194	8.316
	15097	-112001.534	-26764.746	7.984
	10666	-111981.147	-26768.353	20.704
	10667	-111981.383	-26775.696	7.347
	10668	-111983.372	-26787.818	12.284
	10669	-111983.760	-26790.208	2.421
面積				482.0807175
地積				482.08 ㎡

251

地番	桂徳三九ノ五			
N O	X	Y	辺 長	
10666	-111981.147	-26768.353		
15097	-112001.534	-26764.746	20.704	
15096	-112000.499	-26758.009	6.816	
10653	-111981.331	-26761.377	19.462	
10654	-111980.979	-26763.143	1.801	
10666	-111981.147	-26768.353	5.213	
面積			138.1536640	
地積			138.15	㎡

252

地番	桂徳三九ノ四		
N O	X	Y	辺 長
10653	-111981.331	-26761.377	
15096	-112000.499	-26758.009	19.462
10925	-111998.584	-26745.537	12.618
10926	-111998.446	-26743.680	1.862
10927	-111991.598	-26745.009	6.976
10913	-111990.254	-26736.097	9.013
10621	-111989.066	-26729.061	7.136
10620	-111987.345	-26731.257	2.790
10652	-111983.395	-26751.036	20.170
10653	-111981.331	-26761.377	10.545
面積	311.5734060		
地積	311.57㎡		

253

地番	桂徳三八ノ九		
N O	X	Y	辺 長
10913	-111990.254	-26736.097	
10912	-111995.011	-26735.178	4.845
10623	-111993.426	-26725.716	9.594
10622	-111990.647	-26727.044	3.080
10621	-111989.066	-26729.061	2.563
10913	-111990.254	-26736.097	7.136
面積	42.3119220		
地積	42.31 m ²		

254

地番	桂徳三八ノ八		
N O	X	Y	辺 長
10912	-111995.011	-26735.178	
10911	-111997.638	-26734.654	2.679
10910	-111998.060	-26734.208	0.614
10897	-111998.710	-26734.011	0.679
10625	-111996.964	-26723.862	10.298
10624	-111995.643	-26724.657	1.542
10623	-111993.426	-26725.716	2.457
10912	-111995.011	-26735.178	9.594
面積	38.2754850		
地積	38.27 ㎡		

255

地番	桂徳三九ノ八			
N O	X	Y	辺 長	
10927	-111991.598	-26745.009		
10926	-111998.446	-26743.680	6.976	
10925	-111998.584	-26745.537	1.862	
15089	-111998.982	-26745.515	0.399	
10910	-111998.060	-26734.208	11.345	
10911	-111997.638	-26734.654	0.614	
10912	-111995.011	-26735.178	2.679	
10913	-111990.254	-26736.097	4.845	
10927	-111991.598	-26745.009	9.013	
面積	69.9155845			
地積	69.91 ㎡			

256

地番	桂徳三八ノ七		
N O	X	Y	辺 長
10897	-111998.710	-26734.011	
10898	-112002.388	-26732.926	3.835
10627	-112000.628	-26722.654	10.422
10626	-111997.325	-26723.645	3.448
10625	-111996.964	-26723.862	0.421
10897	-111998.710	-26734.011	10.298
面積	39.6720600		
地積	39.67 m ²		

257

地番				桂徳三八ノ六	
N O	X	Y	辺 長		
0898	-112002.388	-26732.926			
0899	-112006.069	-26731.837	3.839		
0628	-112004.297	-26721.552	10.437		
0627	-112000.628	-26722.654	3.831		
0898	-112002.388	-26732.926	10.422		
面積			39.7081405		
地積			39.70 ㎡		

258

地番	桂徳三八ノ五		
N O	X	Y	辺 長
10899	-112006.069	-26731.837	
10896	-112008.887	-26731.001	2.939
10895	-112009.920	-26730.796	1.053
10904	-112008.602	-26720.306	10.572
10629	-112008.373	-26720.329	0.230
10628	-112004.297	-26721.552	4.256
10899	-112006.069	-26731.837	10.437
面積	44.0771430		
地積	44.07 m ²		

259

地番	桂徳三八ノ四		
N O	X	Y	辺 長
10895	-112009.920	-26730.796	
10894	-112013.655	-26730.042	3.810
10903	-112012.390	-26719.920	10.201
10904	-112008.602	-26720.306	3.808
10895	-112009.920	-26730.796	10.572
面積	39.5021740		
地積	39.50 m ²		

260

地番	桂徳三八ノ三		
N O	X	Y	辺 長
10894	-112013.655	-26730.042	
10893	-112017.400	-26729.275	3.823
10902	-112016.178	-26719.535	9.816
10903	-112012.390	-26719.920	3.808
10894	-112013.655	-26730.042	10.201
面積	38.1213675		
地積	38.12 m ²		

261

||
||
||


270

地 番	桂河田二一ノ一		
N O	X	Y	辺 長
10987	-112015.662	-26834.177	
10988	-112016.029	-26834.117	0.372
10989	-112021.902	-26832.351	6.133
10990	-112024.269	-26831.636	2.473
15093	-112021.845	-26823.563	8.429
10992	-112013.236	-26826.124	8.982
10987	-112015.662	-26834.177	8.410
面積	75.8100790		
地積	75.81 m ²		

271

地 番	保 一ノ一		
N O	X	Y	辺 長
10986	-112004.689	-26835.976	
10987	-112015.662	-26834.177	11.119
10992	-112013.236	-26826.124	8.410
10993	-112009.493	-26825.717	3.765
10975	-112008.783	-26822.463	3.331
10976	-112002.690	-26823.474	6.176
10986	-112004.689	-26835.976	12.661
面積	117.0981945		
地積	117.09 m ²		

図面の種類	画 地 面 積 求 積 表				
街区 番号	111	番号	$\frac{2}{2}$	縮 尺	
町 名	桂 徳 大 寺 町				
京 都 市 洛 西 第 二 土 地 区 画 整 理 組 合					

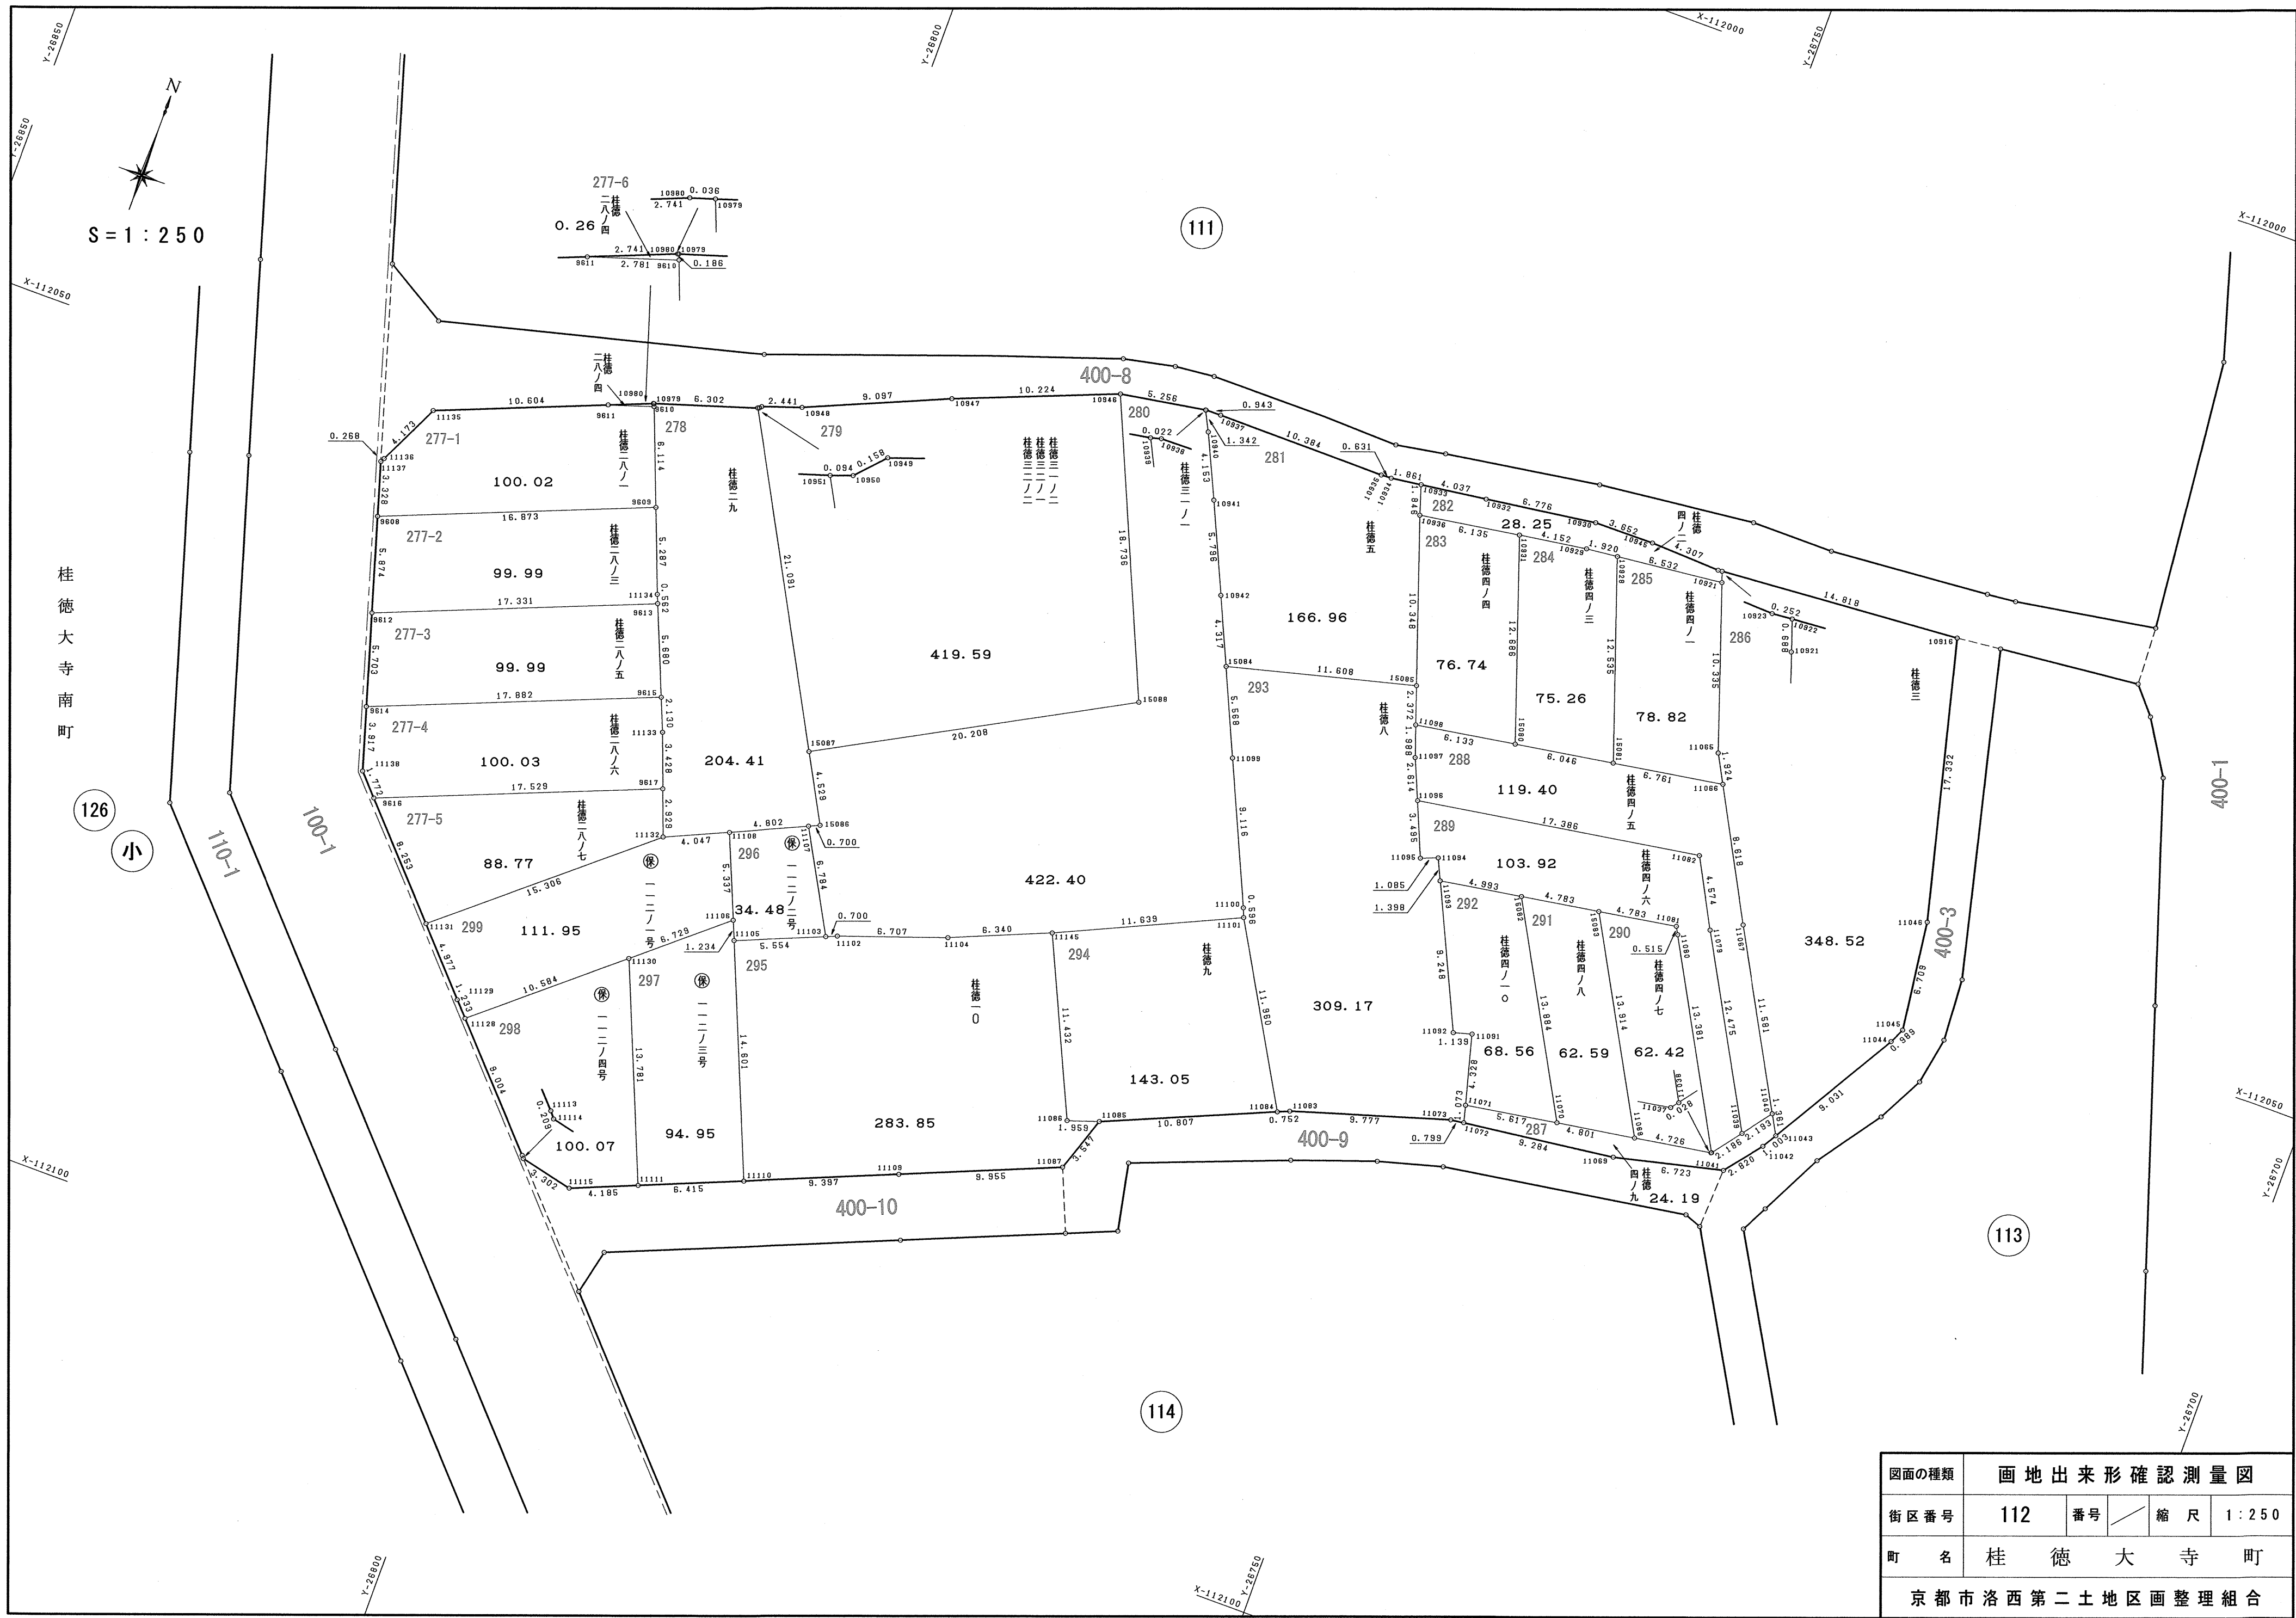

図面の種類	画地出来形確認測量図				
街区番号	112	番号	／	縮尺	1：250
町名	桂徳大寺町				
京都市洛西第二土地区画整理組合					

277-1

地番	桂徳二八ノ一		
N O	X	Y	辺 長
11135	-112048.408	-26821.214	
11136	-112052.171	-26823.017	4.173
11137	-112052.407	-26823.145	0.268
9608	-112055.594	-26822.185	3.328
9609	-112049.281	-26806.537	16.873
9610	-112043.576	-26808.737	6.114
9611	-112044.440	-26811.380	2.781
11135	-112048.408	-26821.214	10.604
面積	100.0280595		
地積	100.02　㎡		

277-2

地番	桂徳二八ノ三		
N O	X	Y	辺 長
9608	-112055.594	-26822.185	
9612	-112061.219	-26820.494	5.874
9613	-112054.734	-26804.422	17.331
11134	-112054.214	-26804.635	0.562
9609	-112049.281	-26806.537	5.287
9608	-112055.594	-26822.185	16.873
面積	99.9949925		
地積	99.99　㎡		

277-3

地番	桂徳二八ノ五		
N O	X	Y	辺 長
9612	-112061.219	-26820.494	
9614	-112066.681	-26818.852	5.703
9615	-112059.990	-26802.269	17.882
9613	-112054.734	-26804.422	5.680
9612	-112061.219	-26820.494	17.331
面積	99.9998025		
地積	99.99　㎡		

277-4

地番	桂徳二八ノ六		
N O	X	Y	辺 長
9614	-112066.681	-26818.852	
11138	-112070.432	-26817.725	3.917
9616	-112071.735	-26816.524	1.772
9617	-112065.175	-26800.269	17.529
11133	-112061.961	-26801.461	3.428
9615	-112059.990	-26802.269	2.130
9614	-112066.681	-26818.852	17.882
面積	100.0366275		
地積	100.03　㎡		

277-5

地番	桂徳二八ノ七		
N O	X	Y	辺 長
9616	-112071.735	-26816.524	
11131	-112077.807	-26810.934	8.253
11132	-112067.921	-26799.249	15.306
9617	-112065.175	-26800.269	2.929
9616	-112071.735	-26816.524	17.529
面積	88.7707450		
地積	88.77　㎡		

277-6

地番	桂徳二八ノ四		
N O	X	Y	辺 長
9611	-112044.440	-26811.380	
9610	-112043.576	-26808.737	2.781
10979	-112043.403	-26808.804	0.186
10980	-112043.414	-26808.838	0.036
9611	-112044.440	-26811.380	2.741
面積	0.2610245		
地積	0.26　㎡		

278

地番	桂徳二九		
N O	X	Y	辺 長
10979	-112043.403	-26808.804	
9610	-112043.576	-26808.737	0.186
9609	-112049.281	-26806.537	6.114
11134	-112054.214	-26804.635	5.287
9613	-112054.734	-26804.422	0.562
9615	-112059.990	-26802.269	5.680
11133	-112061.961	-26801.461	2.130
9617	-112065.175	-26800.269	3.428
11132	-112067.921	-26799.249	2.929
11108	-112066.257	-26795.560	4.047
11107	-112064.276	-26791.186	4.802
15086	-112063.987	-26790.548	0.700
15087	-112060.009	-26792.714	4.529
10951	-112041.486	-26802.801	21.091
10979	-112043.403	-26808.804	6.302
面積	204.4146645		
地積	204.41　㎡		

279

地番	桂徳三一ノ二、三二ノ一、三二ノ二		
N O	X	Y	辺 長
10951	-112041.486	-26802.801	
15087	-112060.009	-26792.714	21.091
15088	-112050.344	-26774.967	20.208
10946	-112033.165	-26782.444	18.736
10947	-112036.945	-26791.944	10.224
10948	-112040.552	-26800.295	9.097
10949	-112041.341	-26802.605	2.441
10950	-112041.457	-26802.712	0.158
10951	-112041.486	-26802.801	0.094
面積	419.5906865		
地積	419.59　㎡		

280

地番	桂徳三一ノ一		
N O	X	Y	辺 長
10939	-112032.307	-26777.258	
10946	-112033.165	-26782.444	5.256
15088	-112050.344	-26774.967	18.736
15087	-112060.009	-26792.714	20.208
15086	-112063.987	-26790.548	4.529
11107	-112064.276	-26791.186	0.700
11103	-112070.212	-26787.902	6.784
11102	-112069.942	-26787.256	0.700
11104	-112067.724	-26780.926	6.707
11145	-112065.276	-26775.078	6.340
11101	-112060.432	-26764.495	11.639
11100	-112059.882	-26764.724	0.596
11099	-112051.569	-26768.464	9.116
15084	-112046.492	-26770.750	5.568
10942	-112042.555	-26772.521	4.317
10941	-112037.273	-26774.908	5.796
10940	-112033.506	-26776.656	4.153
10939	-112032.307	-26777.258	1.342
面積	422.4022945		
地積	422.40　㎡		

281

地番	桂徳五		
N O	X	Y	辺 長
10939	-112032.307	-26777.258	
10940	-112033.506	-26776.656	1.342
10941	-112037.273	-26774.908	4.153
10942	-112042.555	-26772.521	5.796
15084	-112046.492	-26770.750	4.317
15085	-112043.627	-26759.501	11.608
10936	-112033.842	-26762.867	10.348
10933	-112032.085	-26763.434	1.846
10934	-112032.335	-26765.278	1.861
10935	-112032.359	-26765.909	0.631
10937	-112032.291	-26776.293	10.384
10938	-112032.303	-26777.236	0.943
10939	-112032.307	-26777.258	0.022
面積	166.9643015		
地積	166.96　㎡		

282

地番	桂徳四ノ二		
N O	X	Y	辺 長
10933	-112032.085	-26763.434	
10936	-112033.842	-26762.867	1.846
10931	-112032.899	-26756.805	6.135
10929	-112032.287	-26752.698	4.152
10928	-112032.082	-26750.789	1.920
10921	-112031.387	-26744.294	6.532
10922	-112030.736	-26744.516	0.688
10923	-112030.755	-26744.767	0.252
10945	-112030.585	-26749.071	4.307
10930	-112030.605	-26752.723	3.652
10932	-112031.543	-26759.434	6.776
10933	-112032.085	-26763.434	4.037
面積	28.2545070		
地積	28.25　㎡		

283

地番	桂徳四ノ四		
N O	X	Y	辺 長
10936	-112033.842	-26762.867	
15085	-112043.627	-26759.501	10.348
11098	-112045.870	-26758.729	2.372
15080	-112044.894	-26752.674	6.133
10931	-112032.899	-26756.805	12.686
10936	-112033.842	-26762.867	6.135
面積	76.7407665		
地積	76.74　㎡		

284

地番	桂徳四ノ三		
N O	X	Y	辺 長
10931	-112032.899	-26756.805	
15080	-112044.894	-26752.674	12.686
15081	-112043.933	-26746.705	6.046
10928	-112032.082	-26750.789	12.535
10929	-112032.287	-26752.698	1.920
10931	-112032.899	-26756.805	4.152
面積	75.2633315		
地積	75.26　㎡		

285

地番	桂徳四ノ一		
N O	X	Y	辺 長
10928	-112032.082	-26750.789	
15081	-112043.933	-26746.705	12.535
11066	-112042.856	-26740.030	6.761
11065	-112041.165	-26740.947	1.924
10921	-112031.387	-26744.294	10.335
10928	-112032.082	-26750.789	6.532
面積	78.8259395		
地積	78.82　㎡		

286

地番	桂徳三		
N O	X	Y	辺 長
10922	-112030.736	-26744.516	
10921	-112031.387	-26744.294	0.688
11065	-112041.165	-26740.947	10.335
11066	-112042.856	-26740.030	1.924
11067	-112050.440	-26735.938	8.618
11040	-112060.578	-26730.339	11.581
11043	-112061.764	-26729.671	1.361
11044	-112053.994	-26725.069	9.031
11045	-112053.095	-26724.656	0.989
11046	-112046.440	-26725.504	6.709
10916	-112029.633	-26729.739	17.332
10922	-112030.736	-26744.516	14.818
面積	348.5250510		
地積	348.52　㎡		

287

地番	桂徳四ノ九		
N O	X	Y	辺 長
11071	-112066.496	-26747.954	
11072	-112067.537	-26747.694	1.073
11069	-112066.376	-26738.483	9.284
11041	-112064.832	-26731.940	6.723
11042	-112062.627	-26730.182	2.820
11043	-112061.764	-26729.671	1.003
11040	-112060.578	-26730.339	1.361
11039	-112062.332	-26731.655	2.193
11038	-112064.071	-26732.980	2.186
11037	-112064.085	-26733.004	0.028
11068	-112064.840	-26737.669	4.726
11070	-112065.584	-26742.412	4.801
11071	-112066.496	-26747.954	5.617
面積	24.1973190		
地積	24.19　㎡		

288

地番	桂徳四ノ五		
N O	X	Y	辺 長
11098	-112045.870	-26758.729	
11097	-112047.747	-26758.075	1.988
11096	-112050.146	-26757.038	2.614
11082	-112047.394	-26739.871	17.386
11079	-112051.424	-26737.708	4.574
11039	-112062.332	-26731.655	12.475
11040	-112060.578	-26730.339	2.193
11067	-112050.440	-26735.938	11.581
11066	-112042.856	-26740.030	8.618
15081	-112043.933	-26746.705	6.761
15080	-112044.894	-26752.674	6.046
11098	-112045.870	-26758.729	6.133
面積	119.4048645		
地積	119.40　㎡		

294

地番	桂徳九		
N O	X	Y	辺 長
11145	-112065.276	-26775.078	
11086	-112075.670	-26770.318	11.432
11085	-112075.050	-26768.460	1.959
11084	-112070.796	-26758.526	10.807
11101	-112060.432	-26764.495	11.960
11145	-112065.276	-26775.078	11.639
面積	143.0535940		
地積	143.05㎡		

295

地番	桂徳一〇		
N O	X	Y	辺 長
11105	-112072.325	-26793.038	
11110	-112085.823	-26787.471	14.601
11109	-112082.226	-26778.790	9.397
11087	-112078.411	-26769.595	9.955
11085	-112075.050	-26768.460	3.547
11086	-112075.670	-26770.318	1.959
11145	-112065.276	-26775.078	11.432
11104	-112067.724	-26780.926	6.340
11102	-112069.942	-26787.256	6.707
11103	-112070.212	-26787.902	0.700
11105	-112072.325	-26793.038	5.554
面積	283.8593595		
地積	283.85㎡		

296

地番	保 一一二ノ二号		
N O	X	Y	辺 長
11108	-112066.257	-26795.560	
11106	-112071.186	-26793.513	5.337
11105	-112072.325	-26793.038	1.234
11103	-112070.212	-26787.902	5.554
11107	-112064.276	-26791.186	6.784
11108	-112066.257	-26795.560	4.802
面積	34.4868220		
地積	34.48㎡		

297

地番	保 一一二ノ三号		
N O	X	Y	辺 長
11130	-112075.536	-26798.647	
11111	-112088.278	-26793.398	13.781
11110	-112085.823	-26787.471	6.415
11105	-112072.325	-26793.038	14.601
11106	-112071.186	-26793.513	1.234
11130	-112075.536	-26798.647	6.729
面積	94.9539620		
地積	94.95㎡		


298

地番	保 一一二ノ四号		
N O	X	Y	辺 長
11128	-112082.374	-26806.725	
11113	-112088.988	-26800.616	9.004
11114	-112089.151	-26800.485	0.209
11115	-112089.880	-26797.264	3.302
11111	-112088.278	-26793.398	4.185
11130	-112075.536	-26798.647	13.781
11128	-112082.374	-26806.725	10.584
面積	100.0738400		
地積	100.07㎡		

299

地番	保 一一二ノ一号		
N O	X	Y	辺 長
11131	-112077.807	-26810.934	
11129	-112081.468	-26807.562	4.977
11128	-112082.374	-26806.725	1.233
11130	-112075.536	-26798.647	10.584
11106	-112071.186	-26793.513	6.729
11108	-112066.257	-26795.560	5.337
11132	-112067.921	-26799.249	4.047
11131	-112077.807	-26810.934	15.306
面積	111.9593195		
地積	111.95㎡		

図面の種類	画 地 面 積 求 積 表				
街区番号	112	番号	2 / 2	縮 尺	
町 名	桂 徳 大 寺 町				
京都市洛西第二土地区画整理組合					

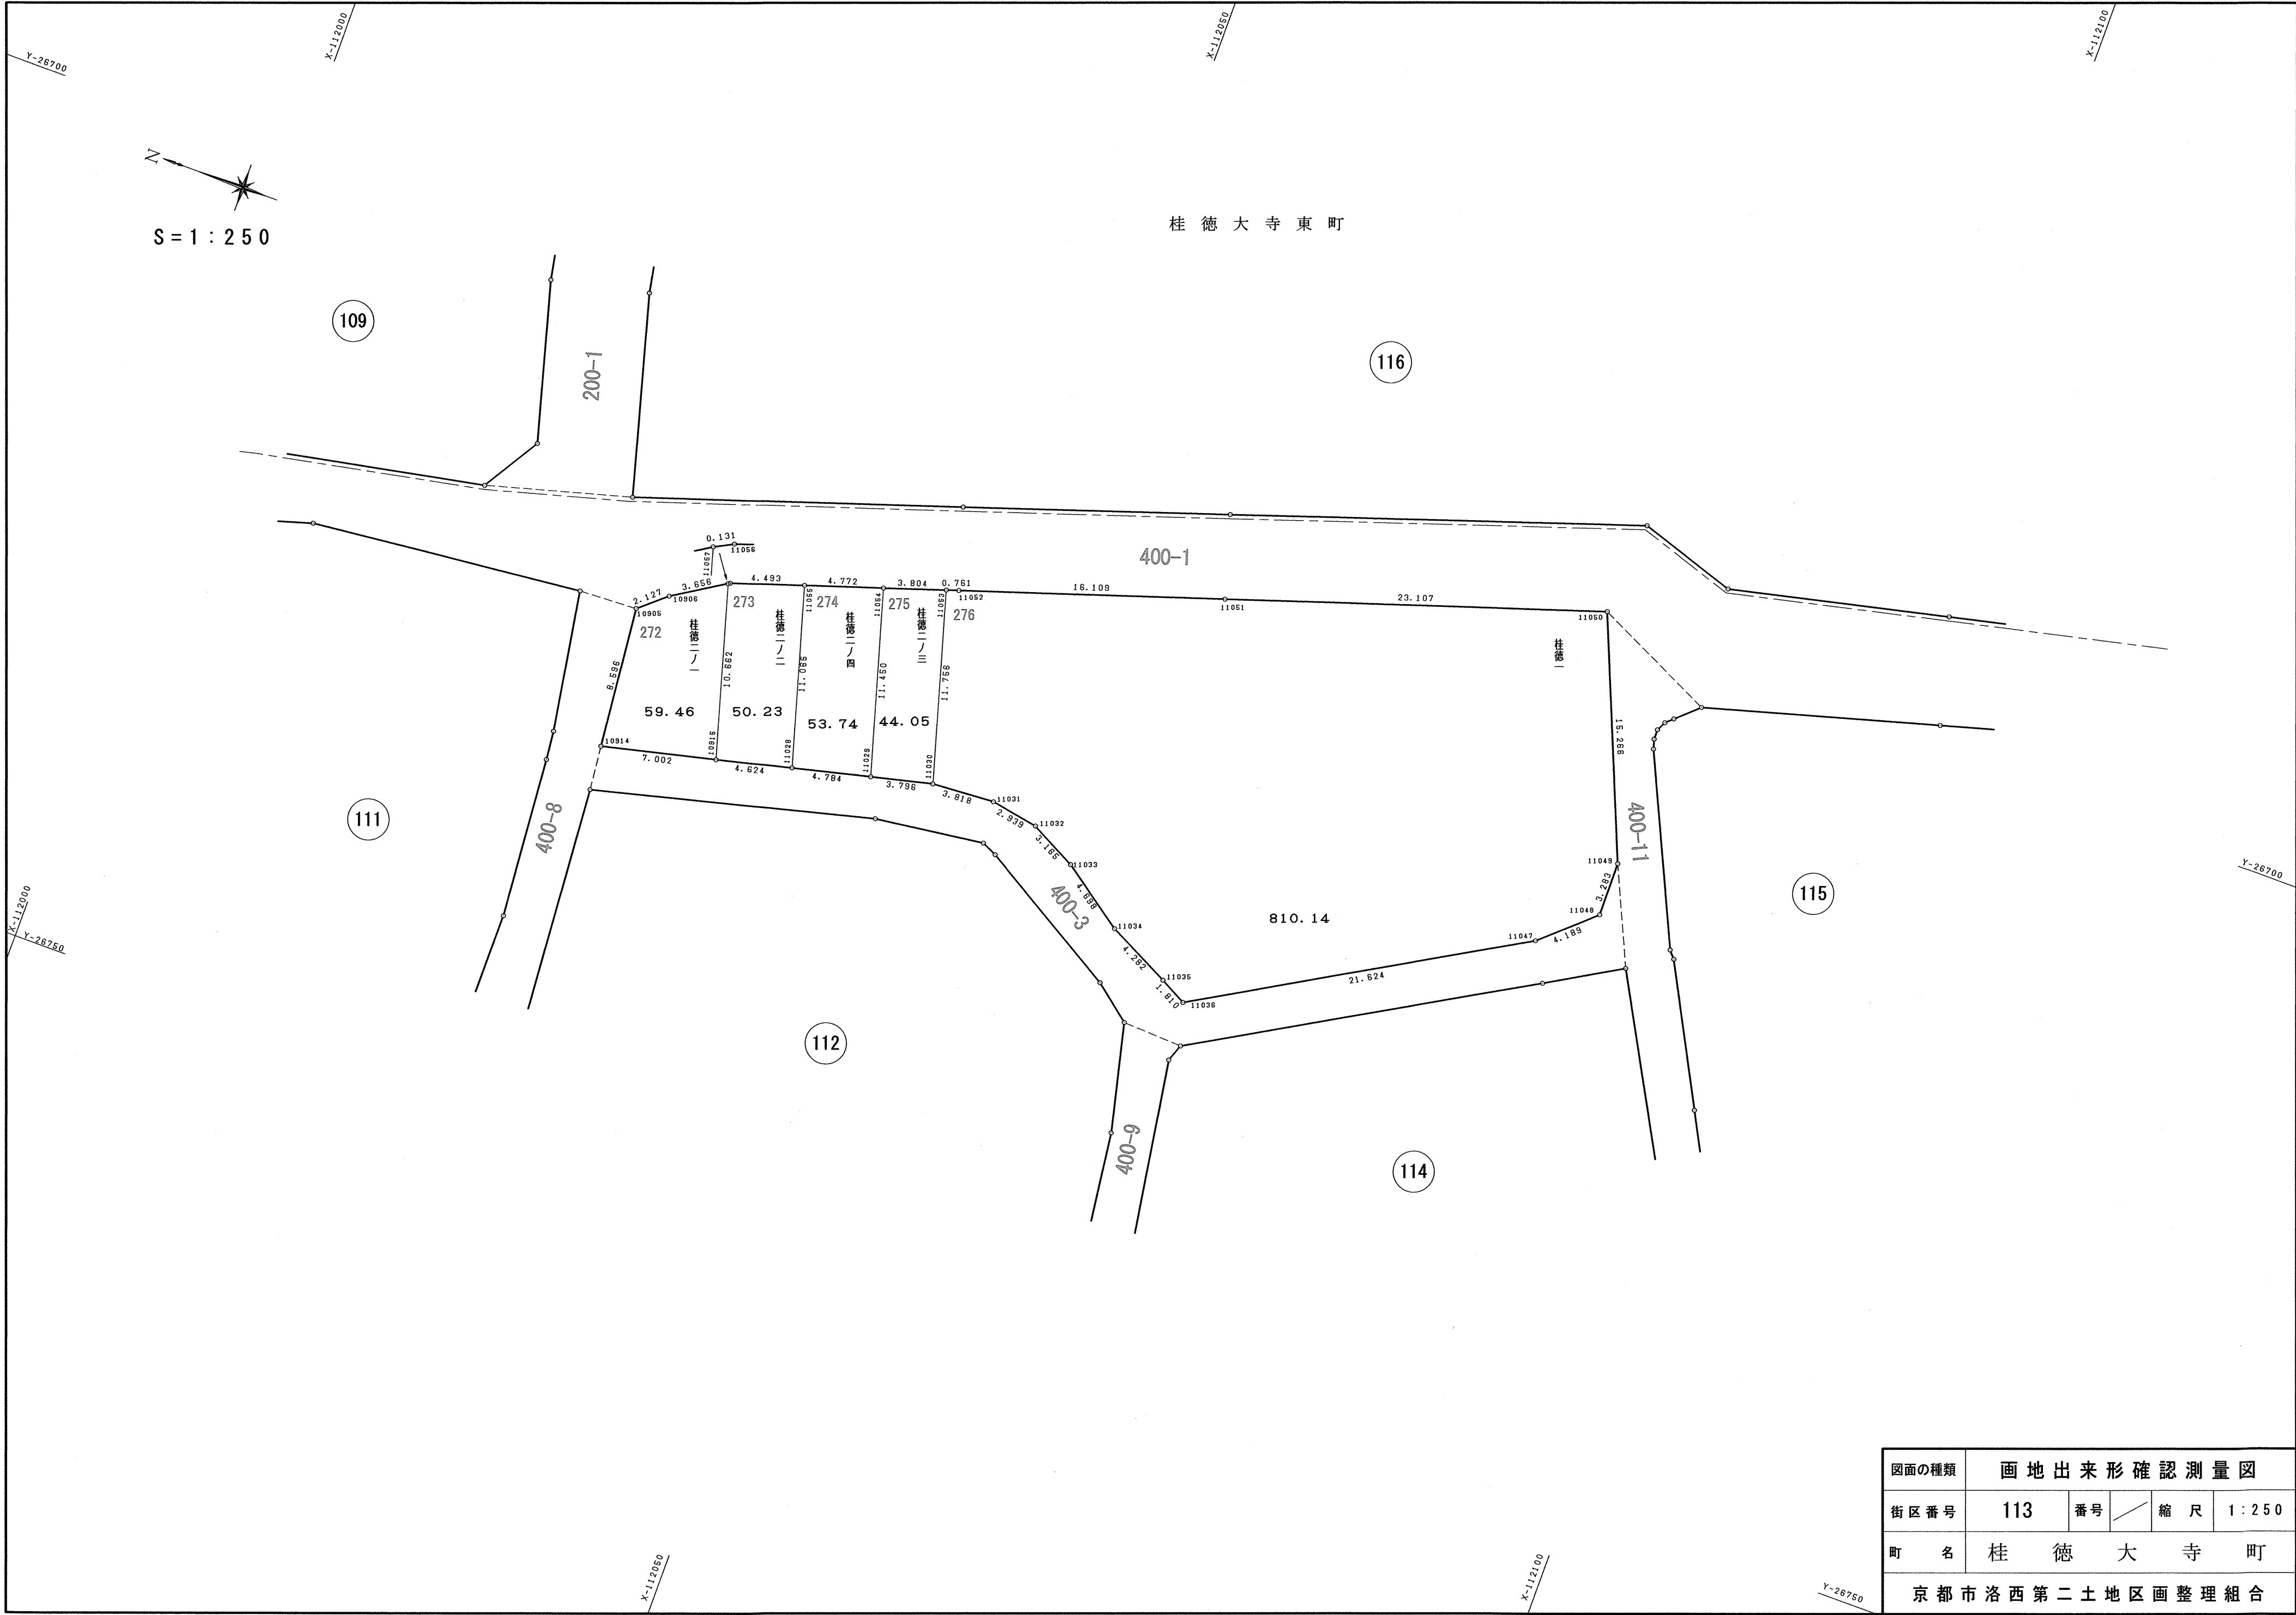

図面の種類	画 地 出 来 形 確 認 測 量 図				
街 区 番 号	113	番 号		縮 尺	1 : 2 5 0
町 名	桂 徳 大 寺 町				
京 都 市 洛 西 第 二 土 地 区 画 整 理 組 合					

272

地番	桂徳二ノ一		
N O	X	Y	辺 長
10914	-112029.347	-26727.034	
10915	-112036.156	-26725.402	7.002
11057	-112033.202	-26715.157	10.662
10906	-112030.101	-26717.093	3.656
10905	-112028.489	-26718.481	2.127
10914	-112029.347	-26727.034	8.596
面積	59.4623850		
地積	59.46㎡		

273

地番	桂徳二ノ二		
N O	X	Y	辺 長
10915	-112036.156	-26725.402	
11028	-112040.653	-26724.324	4.624
11055	-112037.584	-26713.693	11.065
11056	-112033.313	-26715.088	4.493
11057	-112033.202	-26715.157	0.131
10915	-112036.156	-26725.402	10.662
面積	50.2370445		
地積	50.23㎡		

274

地番	桂徳二ノ四		
N O	X	Y	辺 長
11028	-112040.653	-26724.324	
11029	-112045.305	-26723.209	4.784
11054	-112042.120	-26712.211	11.450
11055	-112037.584	-26713.693	4.772
11028	-112040.653	-26724.324	11.065
面積	53.7422225		
地積	53.74㎡		


275

地番	桂徳二ノ三		
N O	X	Y	辺 長
11029	-112045.305	-26723.209	
11030	-112048.996	-26722.324	3.796
11053	-112045.736	-26711.029	11.756
11054	-112042.120	-26712.211	3.804
11029	-112045.305	-26723.209	11.450
面積	44.0541915		
地積	44.05㎡		

276

地番	桂徳一		
N O	X	Y	辺 長
11030	-112048.996	-26722.324	
11031	-112052.807	-26722.087	3.818
11032	-112055.700	-26722.605	2.939
11033	-112058.502	-26724.077	3.165
11034	-112062.328	-26726.804	4.698
11035	-112066.145	-26728.745	4.282
11036	-112067.747	-26729.587	1.810
11047	-112086.483	-26718.790	21.624
11048	-112089.592	-26715.982	4.189
11049	-112089.551	-26712.699	3.283
11050	-112083.728	-26698.587	15.266
11051	-112061.770	-26705.783	23.107
11052	-112046.460	-26710.793	16.109
11053	-112045.736	-26711.029	0.761
11030	-112048.996	-26722.324	11.756
面積	810.1481485		
地積	810.14㎡		

図面の種類	画 地 面 積 求 積 表			
街区番号	113	番号	縮 尺	
町 名	桂 徳 大 寺 町			
京 都 市 洛 西 第 二 土 地 区 画 整 理 組 合				

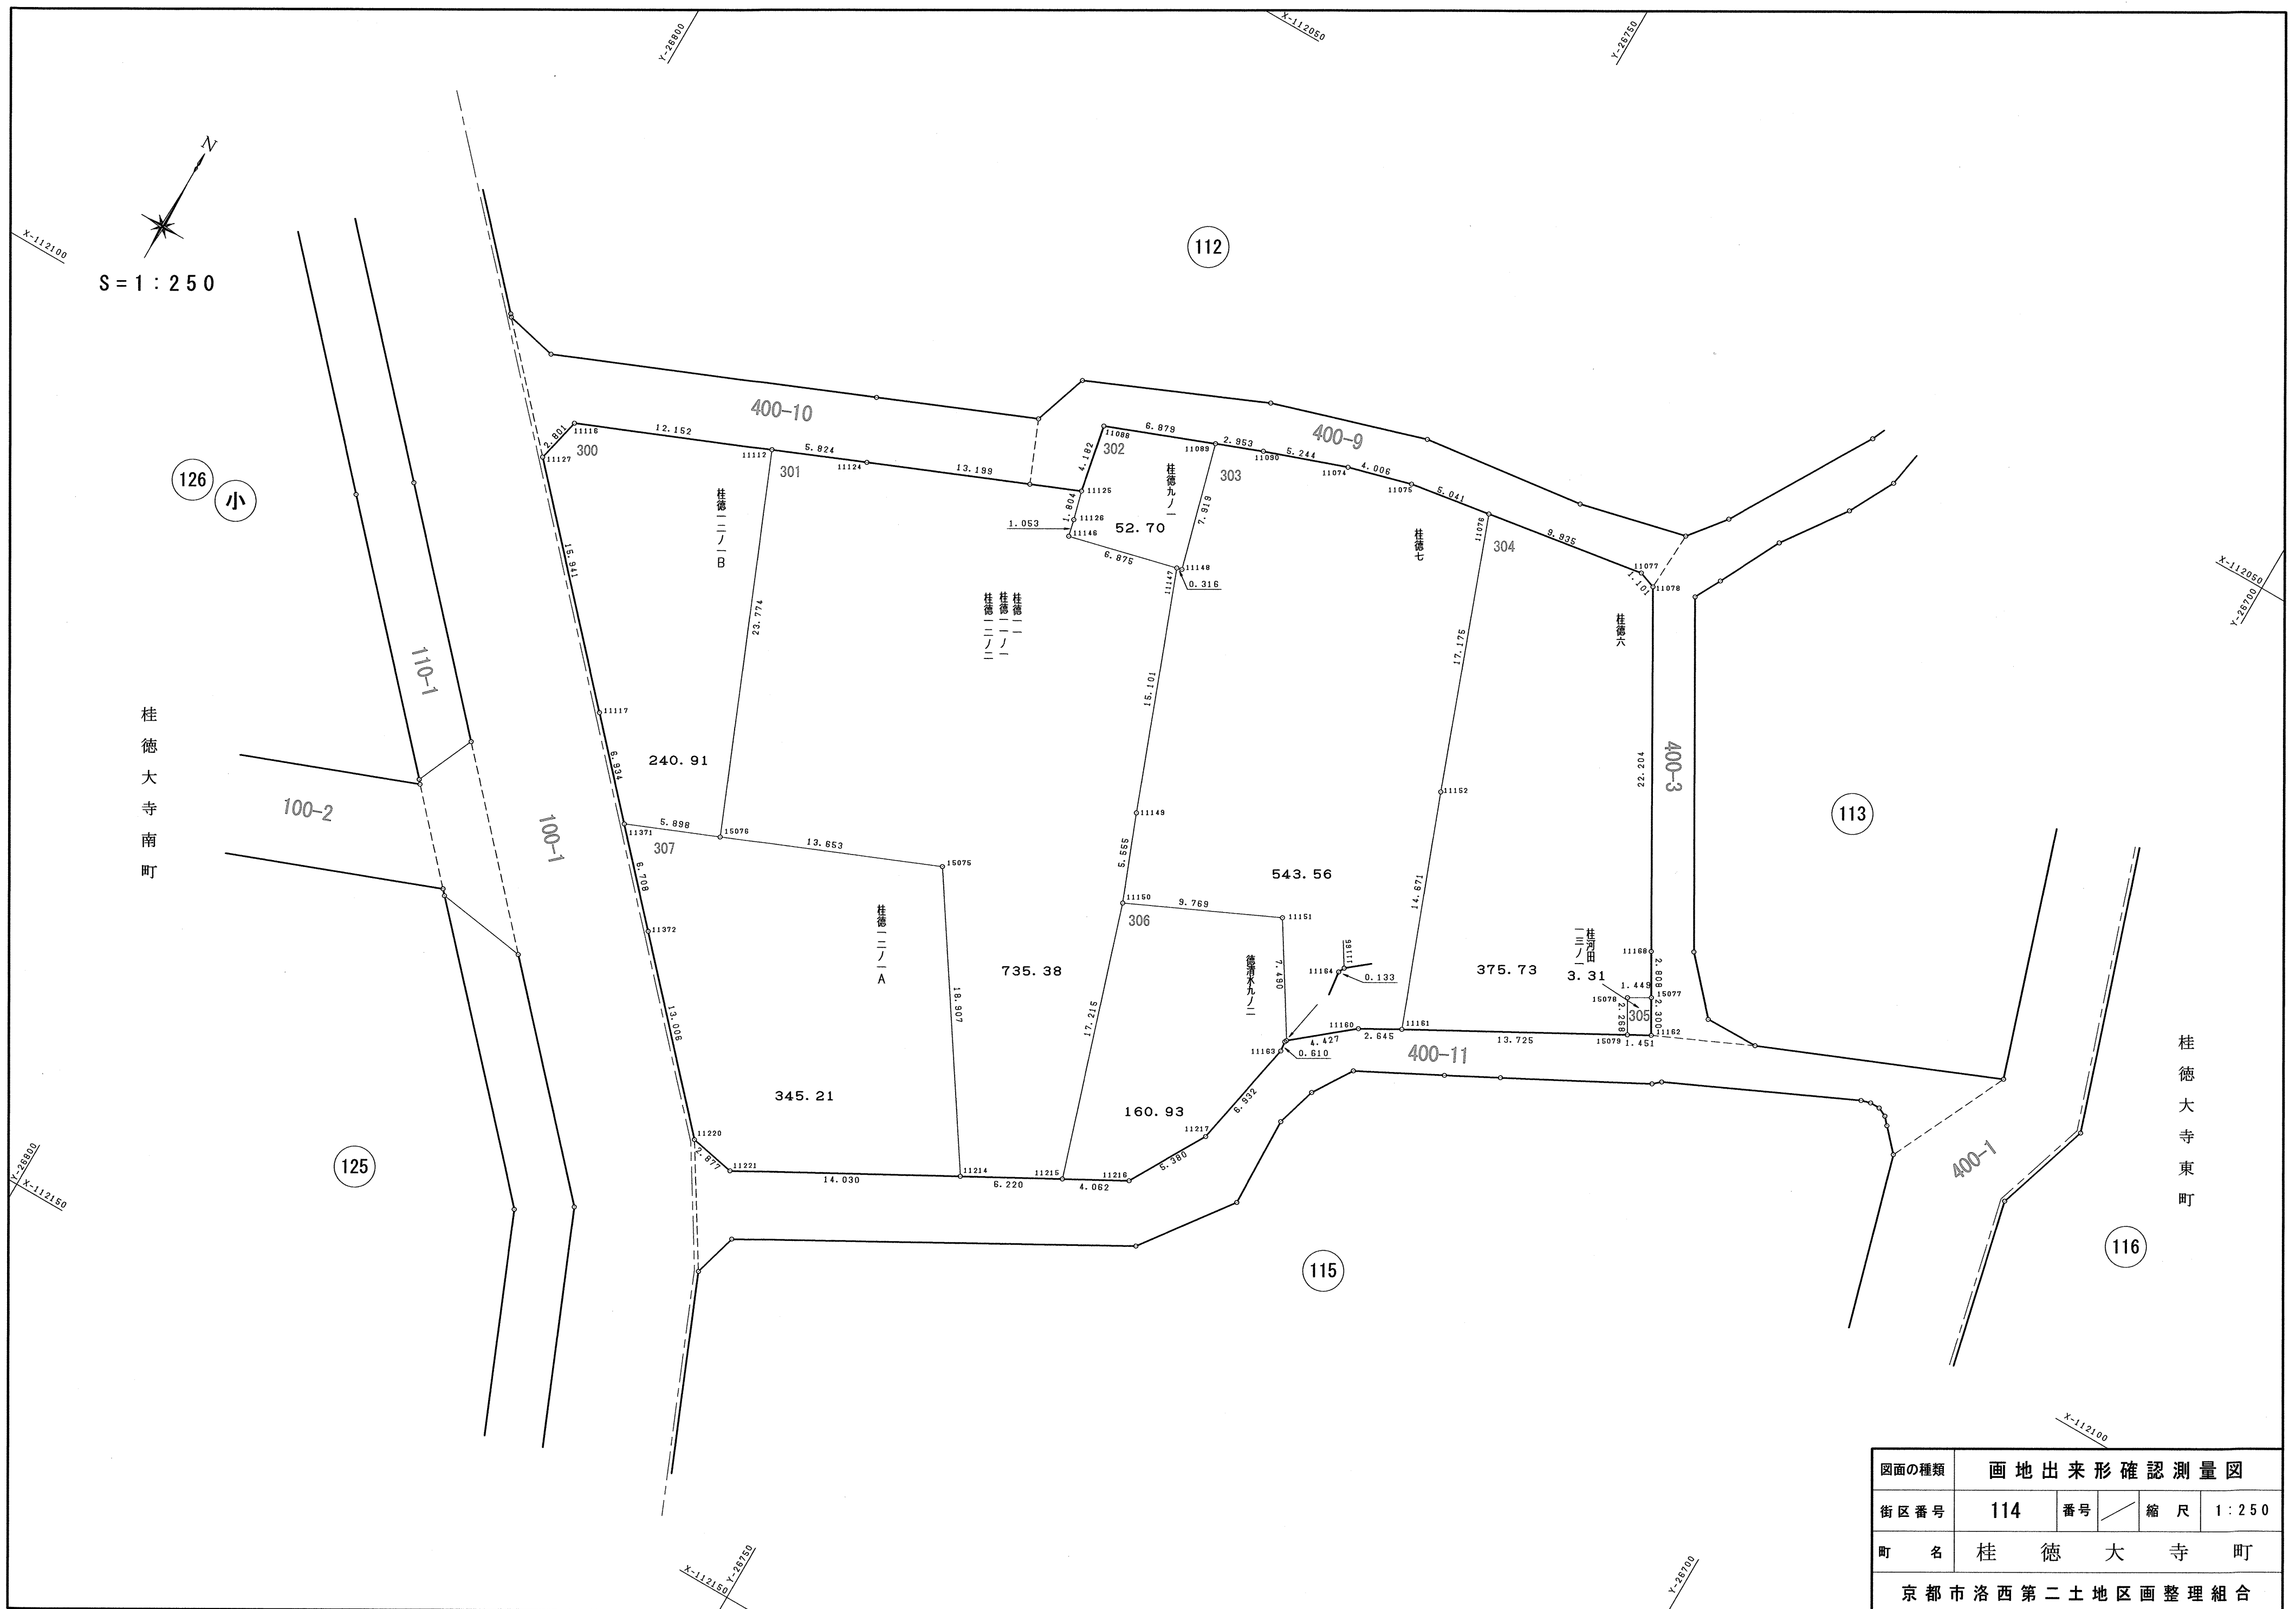

図面の種類	画地出来形確認測量図				
街区番号	114	番号	／	縮尺	1：250
町名	桂徳大寺町				
京都市洛西第二土地区画整理組合					

300

地番	桂徳一二ノ一B		
N O	X	Y	辺 長
11116	-112092.829	-26793.928	
11127	-112095.560	-26794.552	2.801
11117	-112107.287	-26783.754	15.941
11371	-112112.386	-26779.055	6.934
15076	-112110.140	-26773.601	5.898
11112	-112088.177	-26782.702	23.774
11116	-112092.829	-26793.928	12.152
面積	240.9155140		
地積	240.91㎡		

301

地番	桂徳一一、一一ノ一、一二ノ二		
N O	X	Y	辺 長
11112	-112088.177	-26782.702	
15076	-112110.140	-26773.601	23.774
15075	-112104.940	-26760.977	13.653
11214	-112120.715	-26750.555	18.907
11215	-112117.736	-26745.095	6.220
11150	-112101.346	-26750.361	17.215
11149	-112096.178	-26752.397	5.555
11147	-112082.053	-26757.738	15.101
11146	-112083.674	-26764.419	6.875
11126	-112082.648	-26764.657	1.053
11125	-112080.905	-26765.124	1.804
11124	-112085.947	-26777.322	13.199
11112	-112088.177	-26782.702	5.824
面積	735.3807850		
地積	735.38㎡		

302

地番	桂徳九ノ一		
N O	X	Y	辺 長
11125	-112080.905	-26765.124	
11126	-112082.648	-26764.657	1.804
11146	-112083.674	-26764.419	1.053
11147	-112082.053	-26757.738	6.875
11148	-112081.975	-26757.432	0.316
11089	-112074.333	-26759.508	7.919
11088	-112076.801	-26765.929	6.879
11125	-112080.905	-26765.124	4.182
面積	52.7025250		
地積	52.70㎡		

303

地番	桂徳七		
N O	X	Y	辺 長
11089	-112074.333	-26759.508	
11148	-112081.975	-26757.432	7.919
11147	-112082.053	-26757.738	0.316
11149	-112096.178	-26752.397	15.101
11150	-112101.346	-26750.361	5.555
11151	-112097.252	-26741.491	9.769
11165	-112103.600	-26737.516	7.490
11160	-112100.780	-26734.104	4.427
11161	-112099.504	-26731.787	2.645
11152	-112085.792	-26737.003	14.671
11076	-112069.684	-26742.963	17.175
11075	-112070.468	-26747.943	5.041
11074	-112071.528	-26751.806	4.006
11090	-112073.274	-26756.751	5.244
11089	-112074.333	-26759.508	2.953
面積	543.5601150		
地積	543.56㎡		

304

地番	桂徳六		
N O	X	Y	辺 長
11076	-112069.684	-26742.963	
11152	-112085.792	-26737.003	17.175
11161	-112099.504	-26731.787	14.671
15079	-112092.885	-26719.763	13.725
15078	-112090.923	-26720.900	2.268
15077	-112090.196	-26719.646	1.449
11168	-112087.767	-26721.054	2.808
11078	-112068.514	-26732.114	22.204
11077	-112068.140	-26733.149	1.101
11076	-112069.684	-26742.963	9.935
面積	375.7391860		
地積	375.73㎡		

305

地番	桂河田一三ノ一		
N O	X	Y	辺 長
15078	-112090.923	-26720.900	
15079	-112092.885	-26719.763	2.268
11162	-112092.185	-26718.492	1.451
15077	-112090.196	-26719.646	2.300
15078	-112090.923	-26720.900	1.449
面積	3.3113830		
地積	3.31㎡		


306

地番	徳清水九ノ二		
N O	X	Y	辺 長
11150	-112101.346	-26750.361	
11215	-112117.736	-26745.095	17.215
11216	-112115.790	-26741.530	4.062
11217	-112111.126	-26738.849	5.380
11163	-112104.326	-26737.502	6.932
11164	-112103.720	-26737.574	0.610
11165	-112103.600	-26737.516	0.133
11151	-112097.252	-26741.491	7.490
11150	-112101.346	-26750.361	9.769
面積	160.9379650		
地積	160.93㎡		

307

地番	桂徳一二ノ一A		
N O	X	Y	辺 長
11371	-112112.386	-26779.055	
11372	-112117.319	-26774.510	6.708
11220	-112126.880	-26765.693	13.006
11221	-112127.436	-26762.870	2.877
11214	-112120.715	-26750.555	14.030
15075	-112104.940	-26760.977	18.907
15076	-112110.140	-26773.601	13.653
11371	-112112.386	-26779.055	5.898
面積	345.2111535		
地積	345.21㎡		

図面の種類	画 地 面 積 求 積 表				
街区 番号	114	番号	／	縮 尺	
町 名	桂 徳 大 寺 町				
京 都 市 洛 西 第 二 土 地 区 画 整 理 組 合					

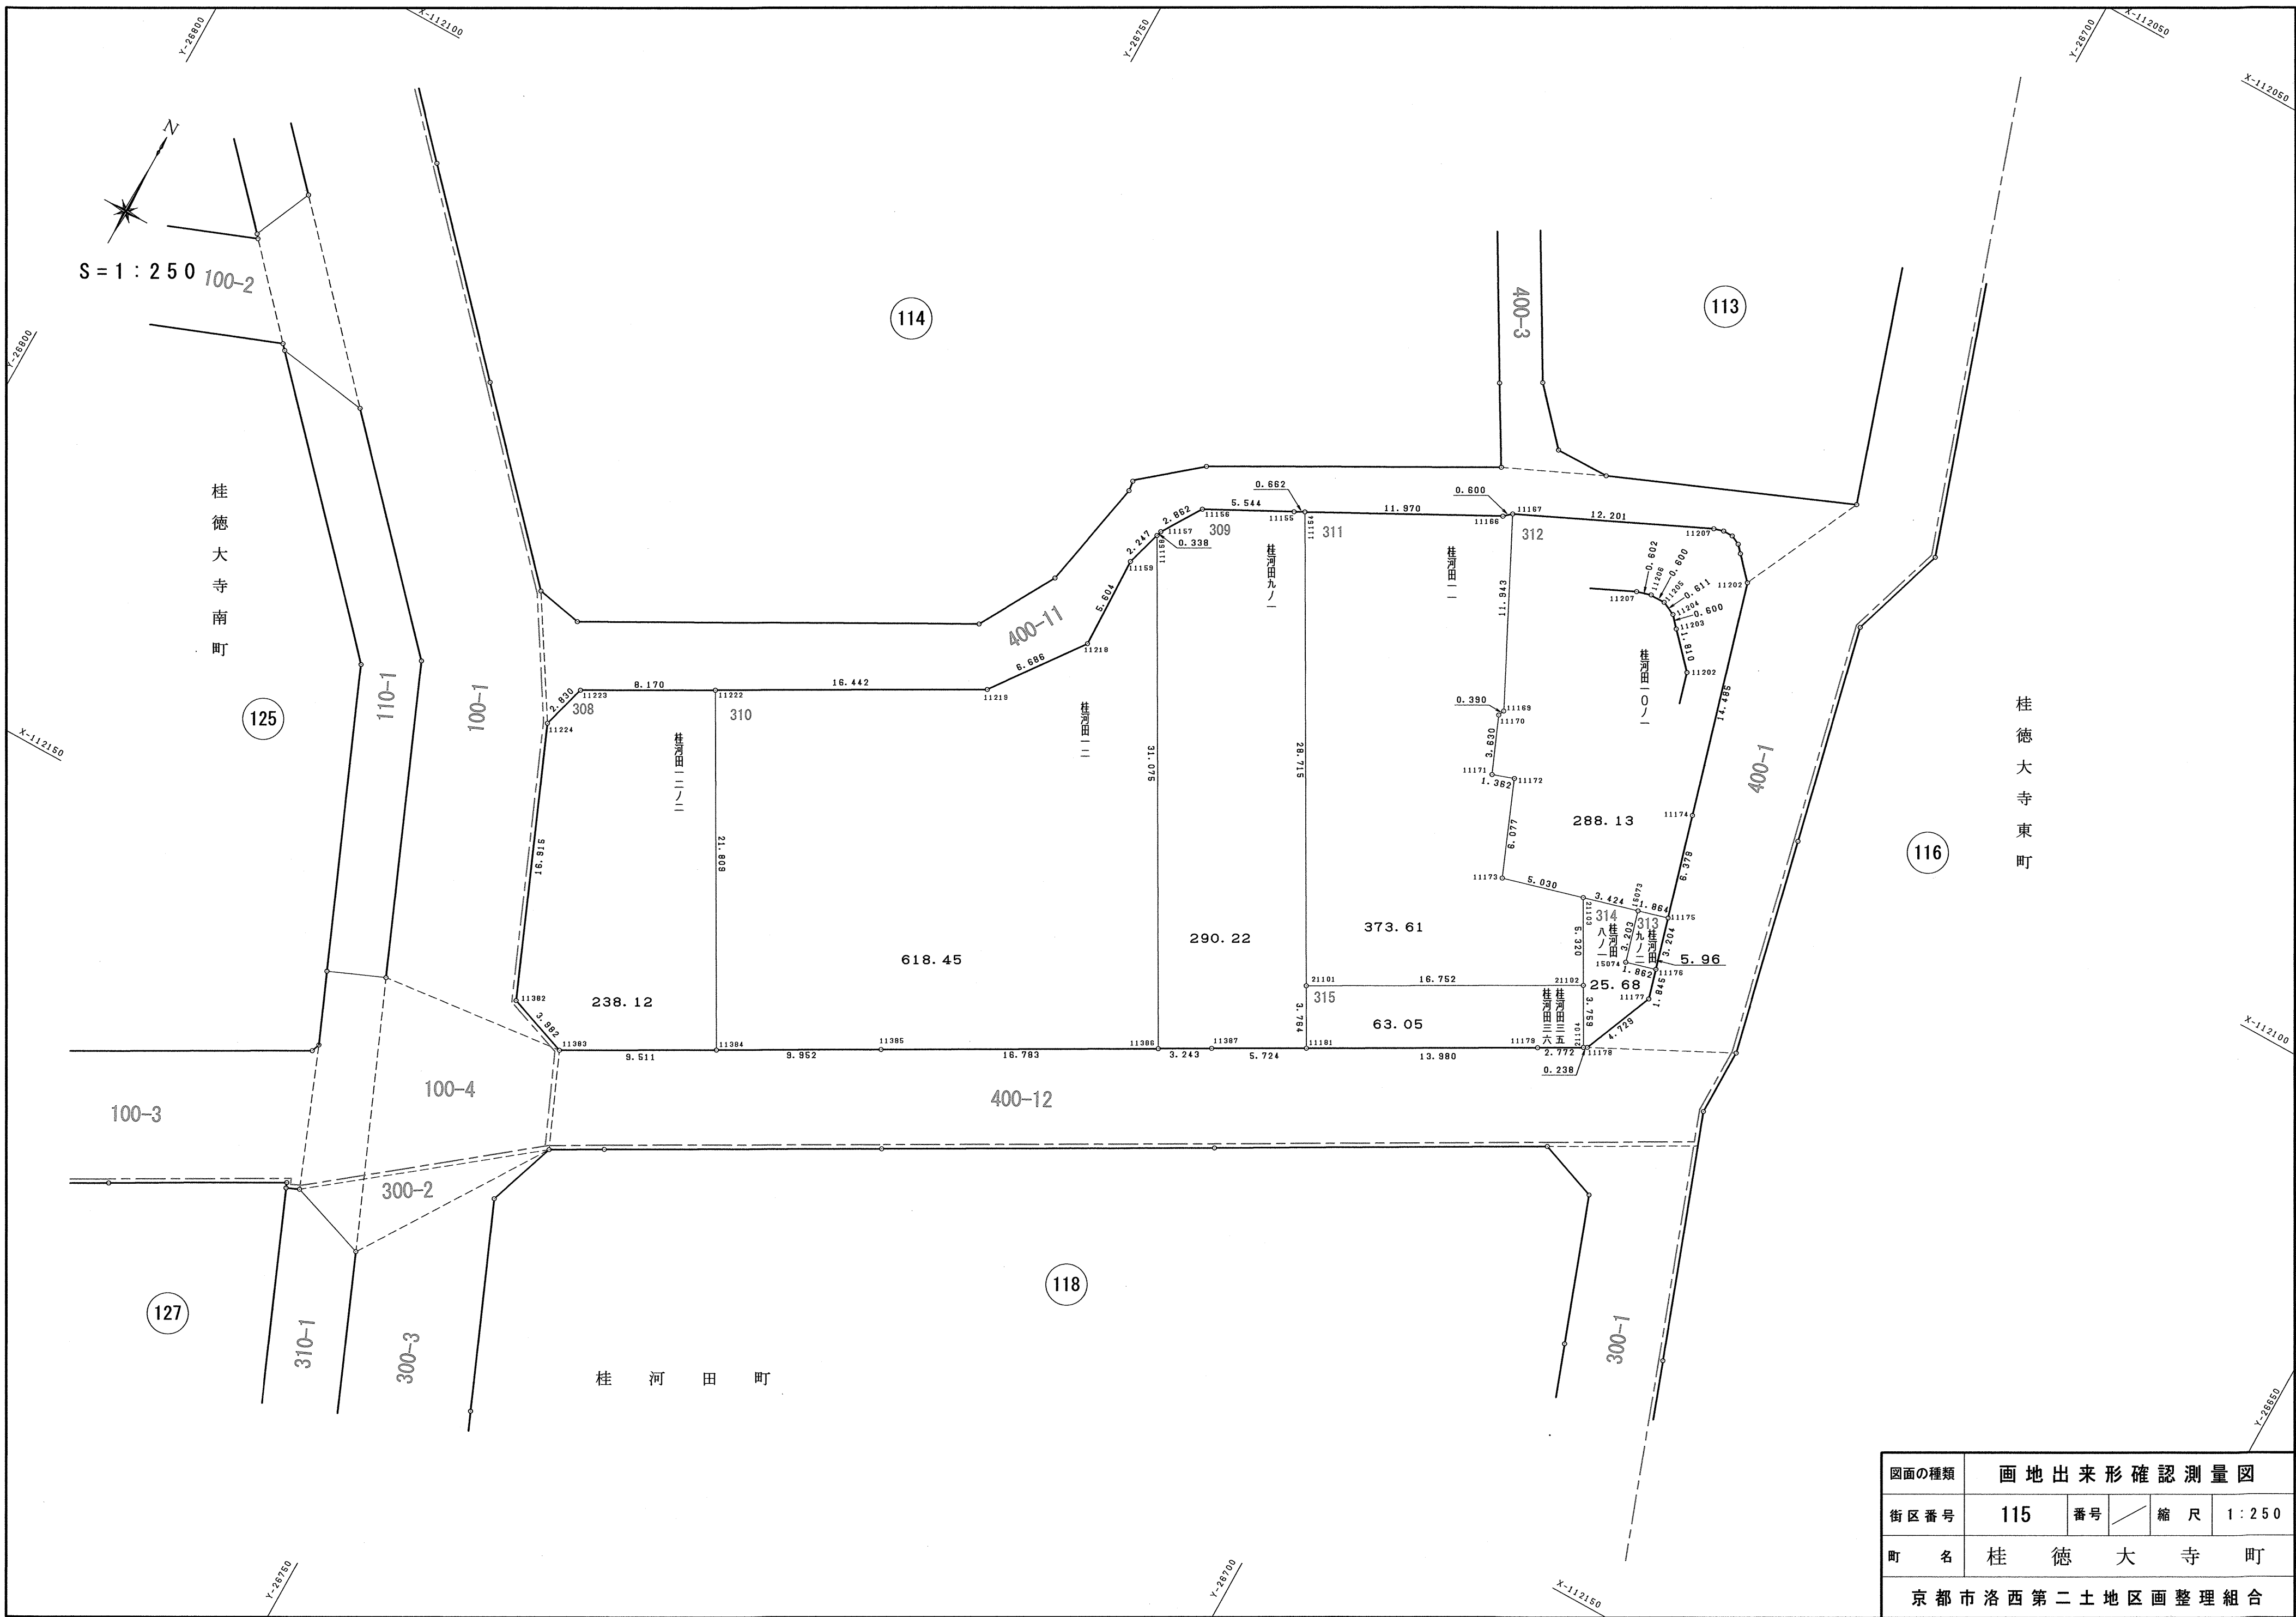

図面の種類	画地出来形確認測量図				
街区番号	115	番号		縮尺	1：250
町名	桂 徳 大 寺 町				
京都市洛西第二土地区画整理組合					

308

地番	桂河田一二ノ二		
N O	X	Y	辺 長
11224	-112133.706	-26761.455	
11382	-112149.326	-26754.965	16.915
11383	-112150.683	-26751.221	3.982
11384	-112146.054	-26742.913	9.511
11222	-112127.013	-26753.546	21.809
11223	-112130.982	-26760.687	8.170
11224	-112133.706	-26761.455	2.830
面積	238.1291410		
地積	238.12㎡		

309

地番	桂河田九ノ一		
N O	X	Y	辺 長
11158	-112105.895	-26734.703	
11386	-112133.033	-26719.564	31.075
11387	-112131.453	-26716.732	3.243
11181	-112128.665	-26711.733	5.724
21101	-112125.378	-26713.566	3.764
11154	-112100.303	-26727.558	28.715
11155	-112100.612	-26728.143	0.662
11156	-112103.159	-26733.067	5.544
11157	-112105.571	-26734.607	2.862
11158	-112105.895	-26734.703	0.338
面積	290.2236200		
地積	290.22㎡		

310

地番	桂河田一二		
N O	X	Y	辺 長
11222	-112127.013	-26753.546	
11384	-112146.054	-26742.913	21.809
11385	-112141.210	-26734.220	9.952
11386	-112133.033	-26719.564	16.783
11158	-112105.895	-26734.703	31.075
11159	-112108.049	-26735.343	2.247
11218	-112113.651	-26735.198	5.604
11219	-112119.026	-26739.174	6.686
11222	-112127.013	-26753.546	16.442
面積	618.4539295		
地積	618.45㎡		

311

地番	桂河田一一		
N O	X	Y	辺 長
21103	-112112.571	-26701.530	
11173	-112113.914	-26706.377	5.030
11172	-112108.282	-26708.660	6.077
11171	-112108.726	-26709.948	1.362
11170	-112105.375	-26711.344	3.630
11169	-112105.013	-26711.200	0.390
11167	-112094.321	-26716.521	11.943
11166	-112094.719	-26716.970	0.600
11154	-112100.303	-26727.558	11.970
21101	-112125.378	-26713.566	28.715
21102	-112117.216	-26698.937	16.752
21103	-112112.571	-26701.530	5.320
面積	373.6143430		
地積	373.61㎡		

312

地番	桂河田一〇ノ一		
N O	X	Y	辺 長
11167	-112094.321	-26716.521	
11169	-112105.013	-26711.200	11.943
11170	-112105.375	-26711.344	0.390
11171	-112108.726	-26709.948	3.630
11172	-112108.282	-26708.660	1.362
11173	-112113.914	-26706.377	6.077
21103	-112112.571	-26701.530	5.030
15073	-112111.656	-26698.231	3.424
11175	-112111.158	-26696.435	1.864
11174	-112105.015	-26698.154	6.379
11202	-112091.074	-26702.088	14.485
11203	-112089.742	-26703.314	1.810
11204	-112089.296	-26703.716	0.600
11205	-112089.036	-26704.269	0.611
11206	-112089.034	-26704.869	0.600
11207	-112089.198	-26705.448	0.602
11167	-112094.321	-26716.521	12.201
面積	288.1328530		
地積	288.13㎡		

313

地番	桂河田九ノ二		
N O	X	Y	辺 長
15073	-112111.656	-26698.231	
15074	-112114.740	-26697.365	3.203
11176	-112114.243	-26695.571	1.862
11175	-112111.158	-26696.435	3.204
15073	-112111.656	-26698.231	1.864
面積	5.9670150		
地積	5.96㎡		


314

地番	桂河田八ノ一		
N O	X	Y	辺 長
21103	-112112.571	-26701.530	
21102	-112117.216	-26698.937	5.320
21104	-112120.499	-26697.106	3.759
11178	-112120.383	-26696.898	0.238
11177	-112116.020	-26695.074	4.729
11176	-112114.243	-26695.571	1.845
15074	-112114.740	-26697.365	1.862
15073	-112111.656	-26698.231	3.203
21103	-112112.571	-26701.530	3.424
面積	25.6881810		
地積	25.68㎡		


315

地番	桂河田三五、桂河田三六		
N O	X	Y	辺 長
11181	-112128.665	-26711.733	
11179	-112121.855	-26699.524	13.980
21104	-112120.499	-26697.106	2.772
21102	-112117.216	-26698.937	3.759
21101	-112125.378	-26713.566	16.752
11181	-112128.665	-26711.733	3.764
面積	63.0538400		
地積	63.05㎡		

図面の種類	画 地 面 積 求 積 表			
街区 番号	115	番号	／	縮 尺
町 名	桂 徳 大 寺 町			
京 都 市 洛 西 第 二 土 地 区 画 整 理 組 合				

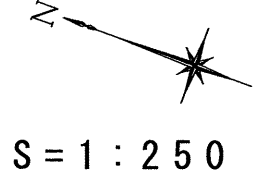

桂 大 繩 町

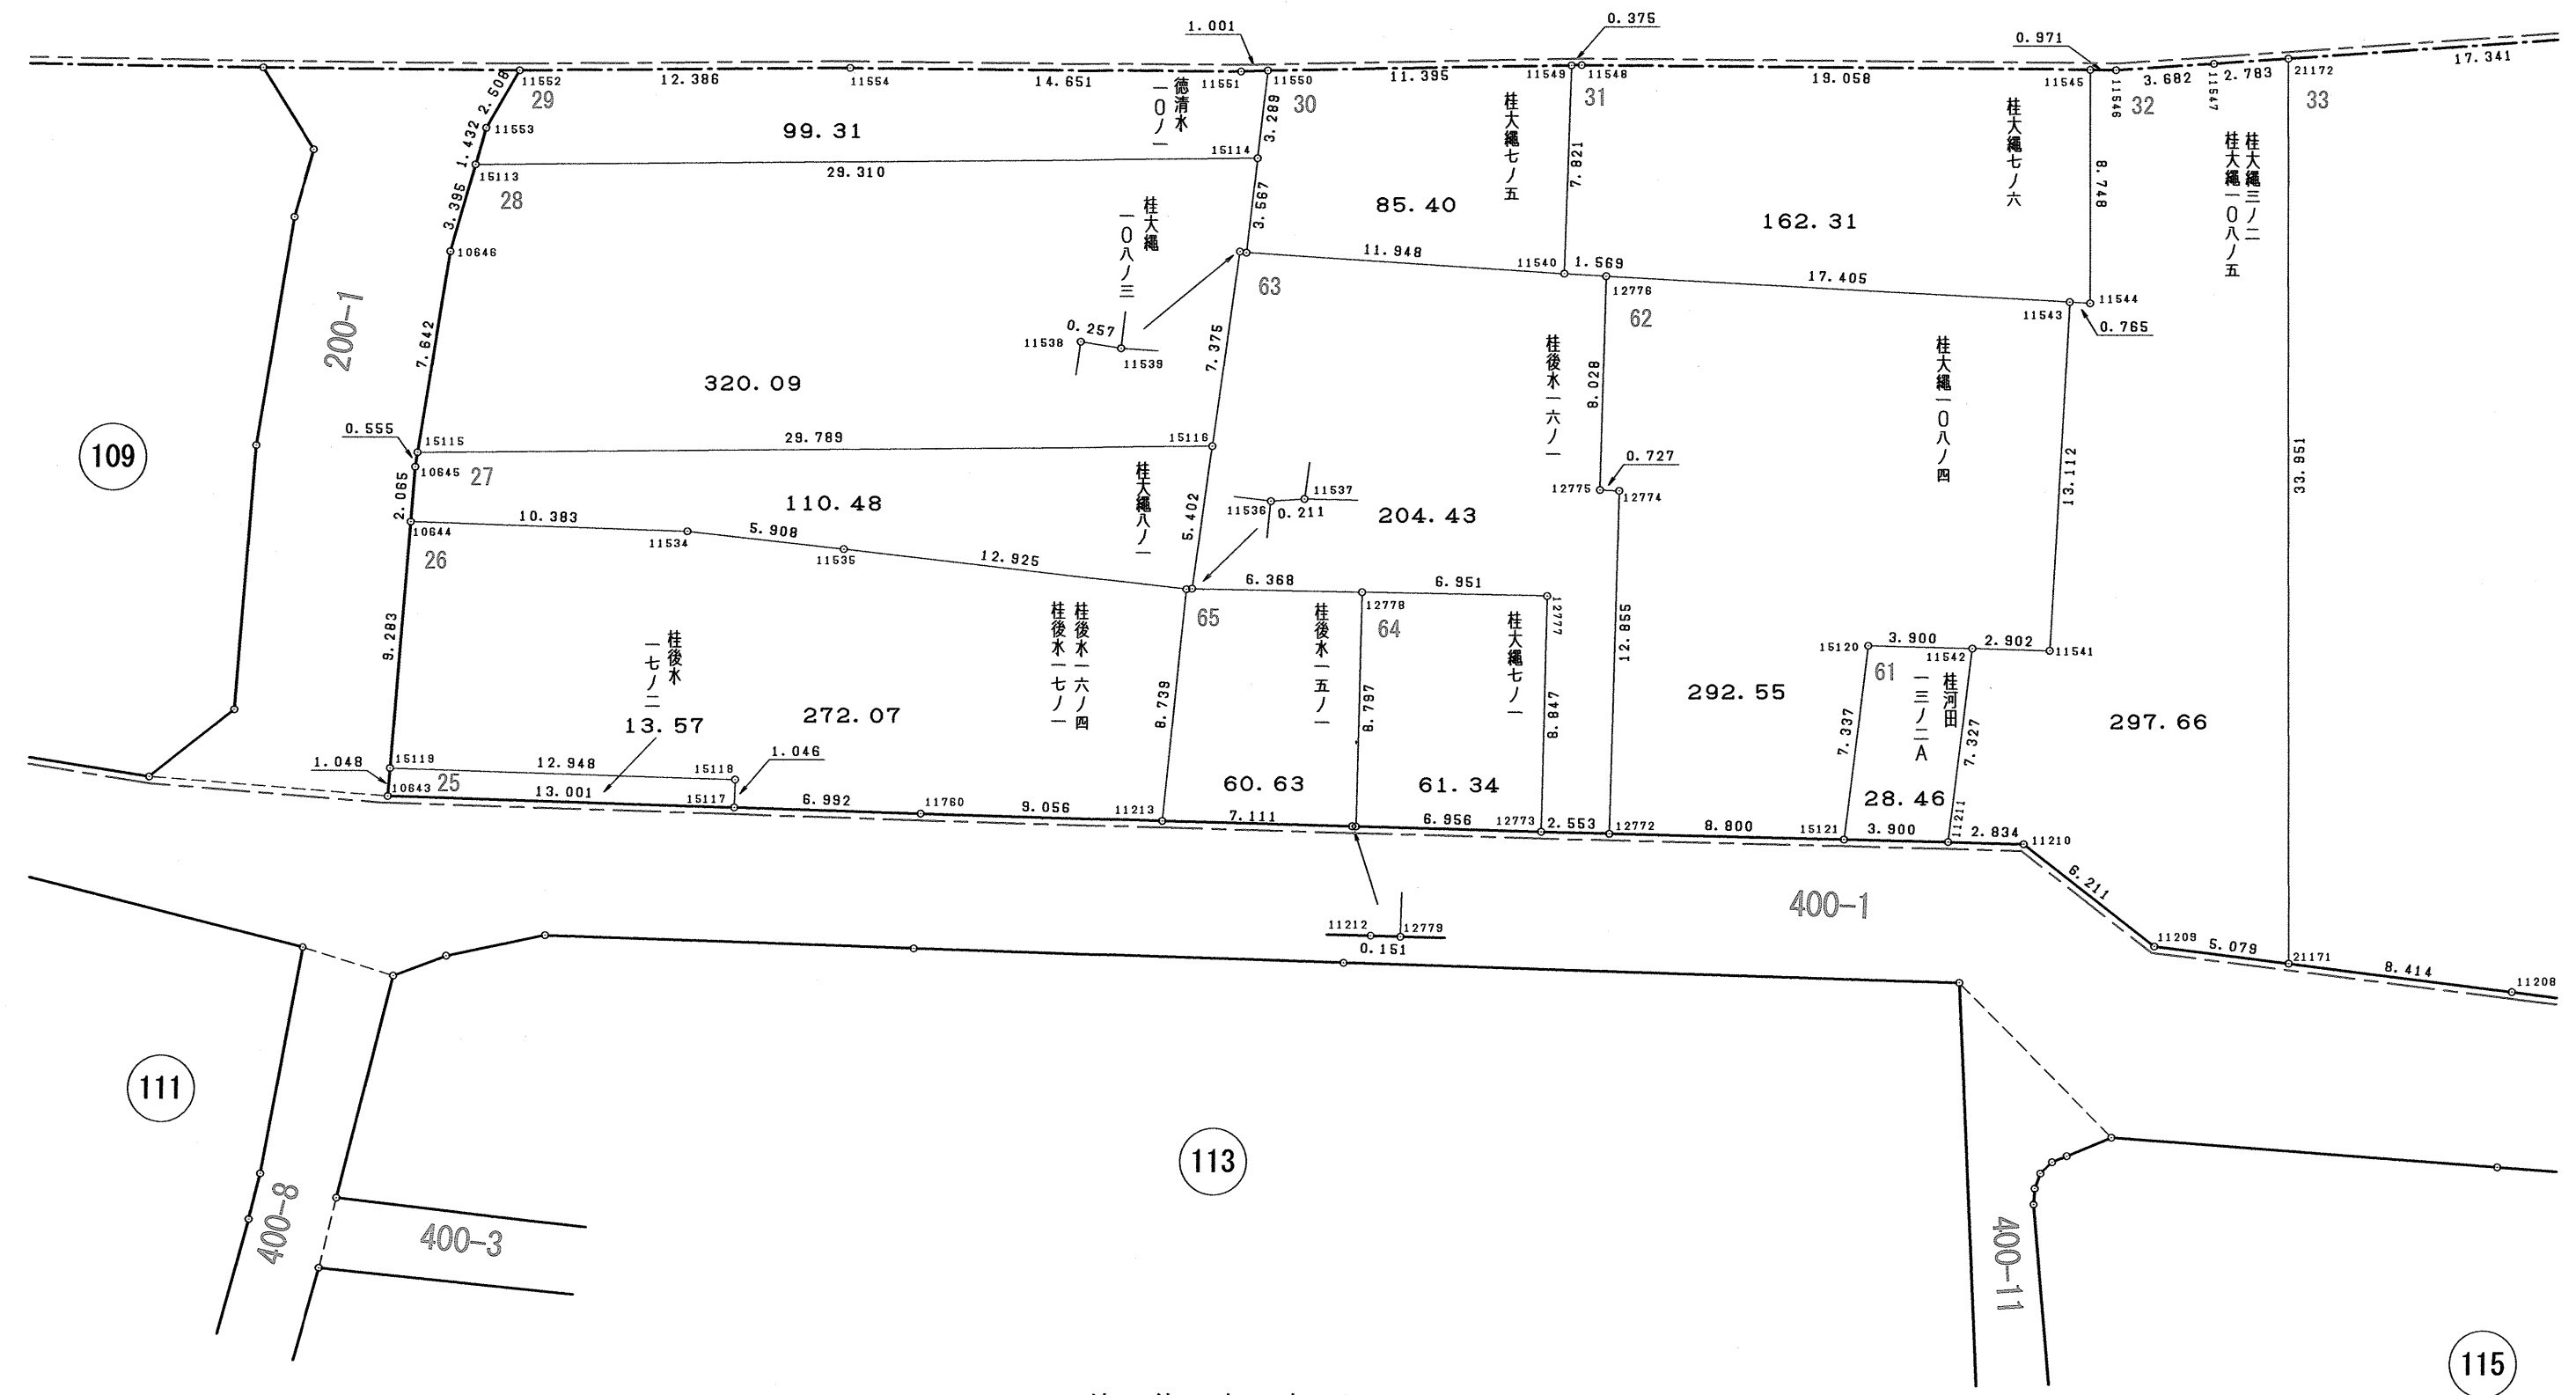



桂 徳 大 寺 町

図面の種類	画 地 出 来 形 確 認 測 量 図				
街区番号	116 _{1/3}	番号	／	縮 尺	1 : 250
町 名	桂 徳 大 寺 東 町				
京 都 市 洛 西 第 二 土 地 区 画 整 理 組 合					

S = 1 : 2 5 0

桂 大 縄 町


拡大図

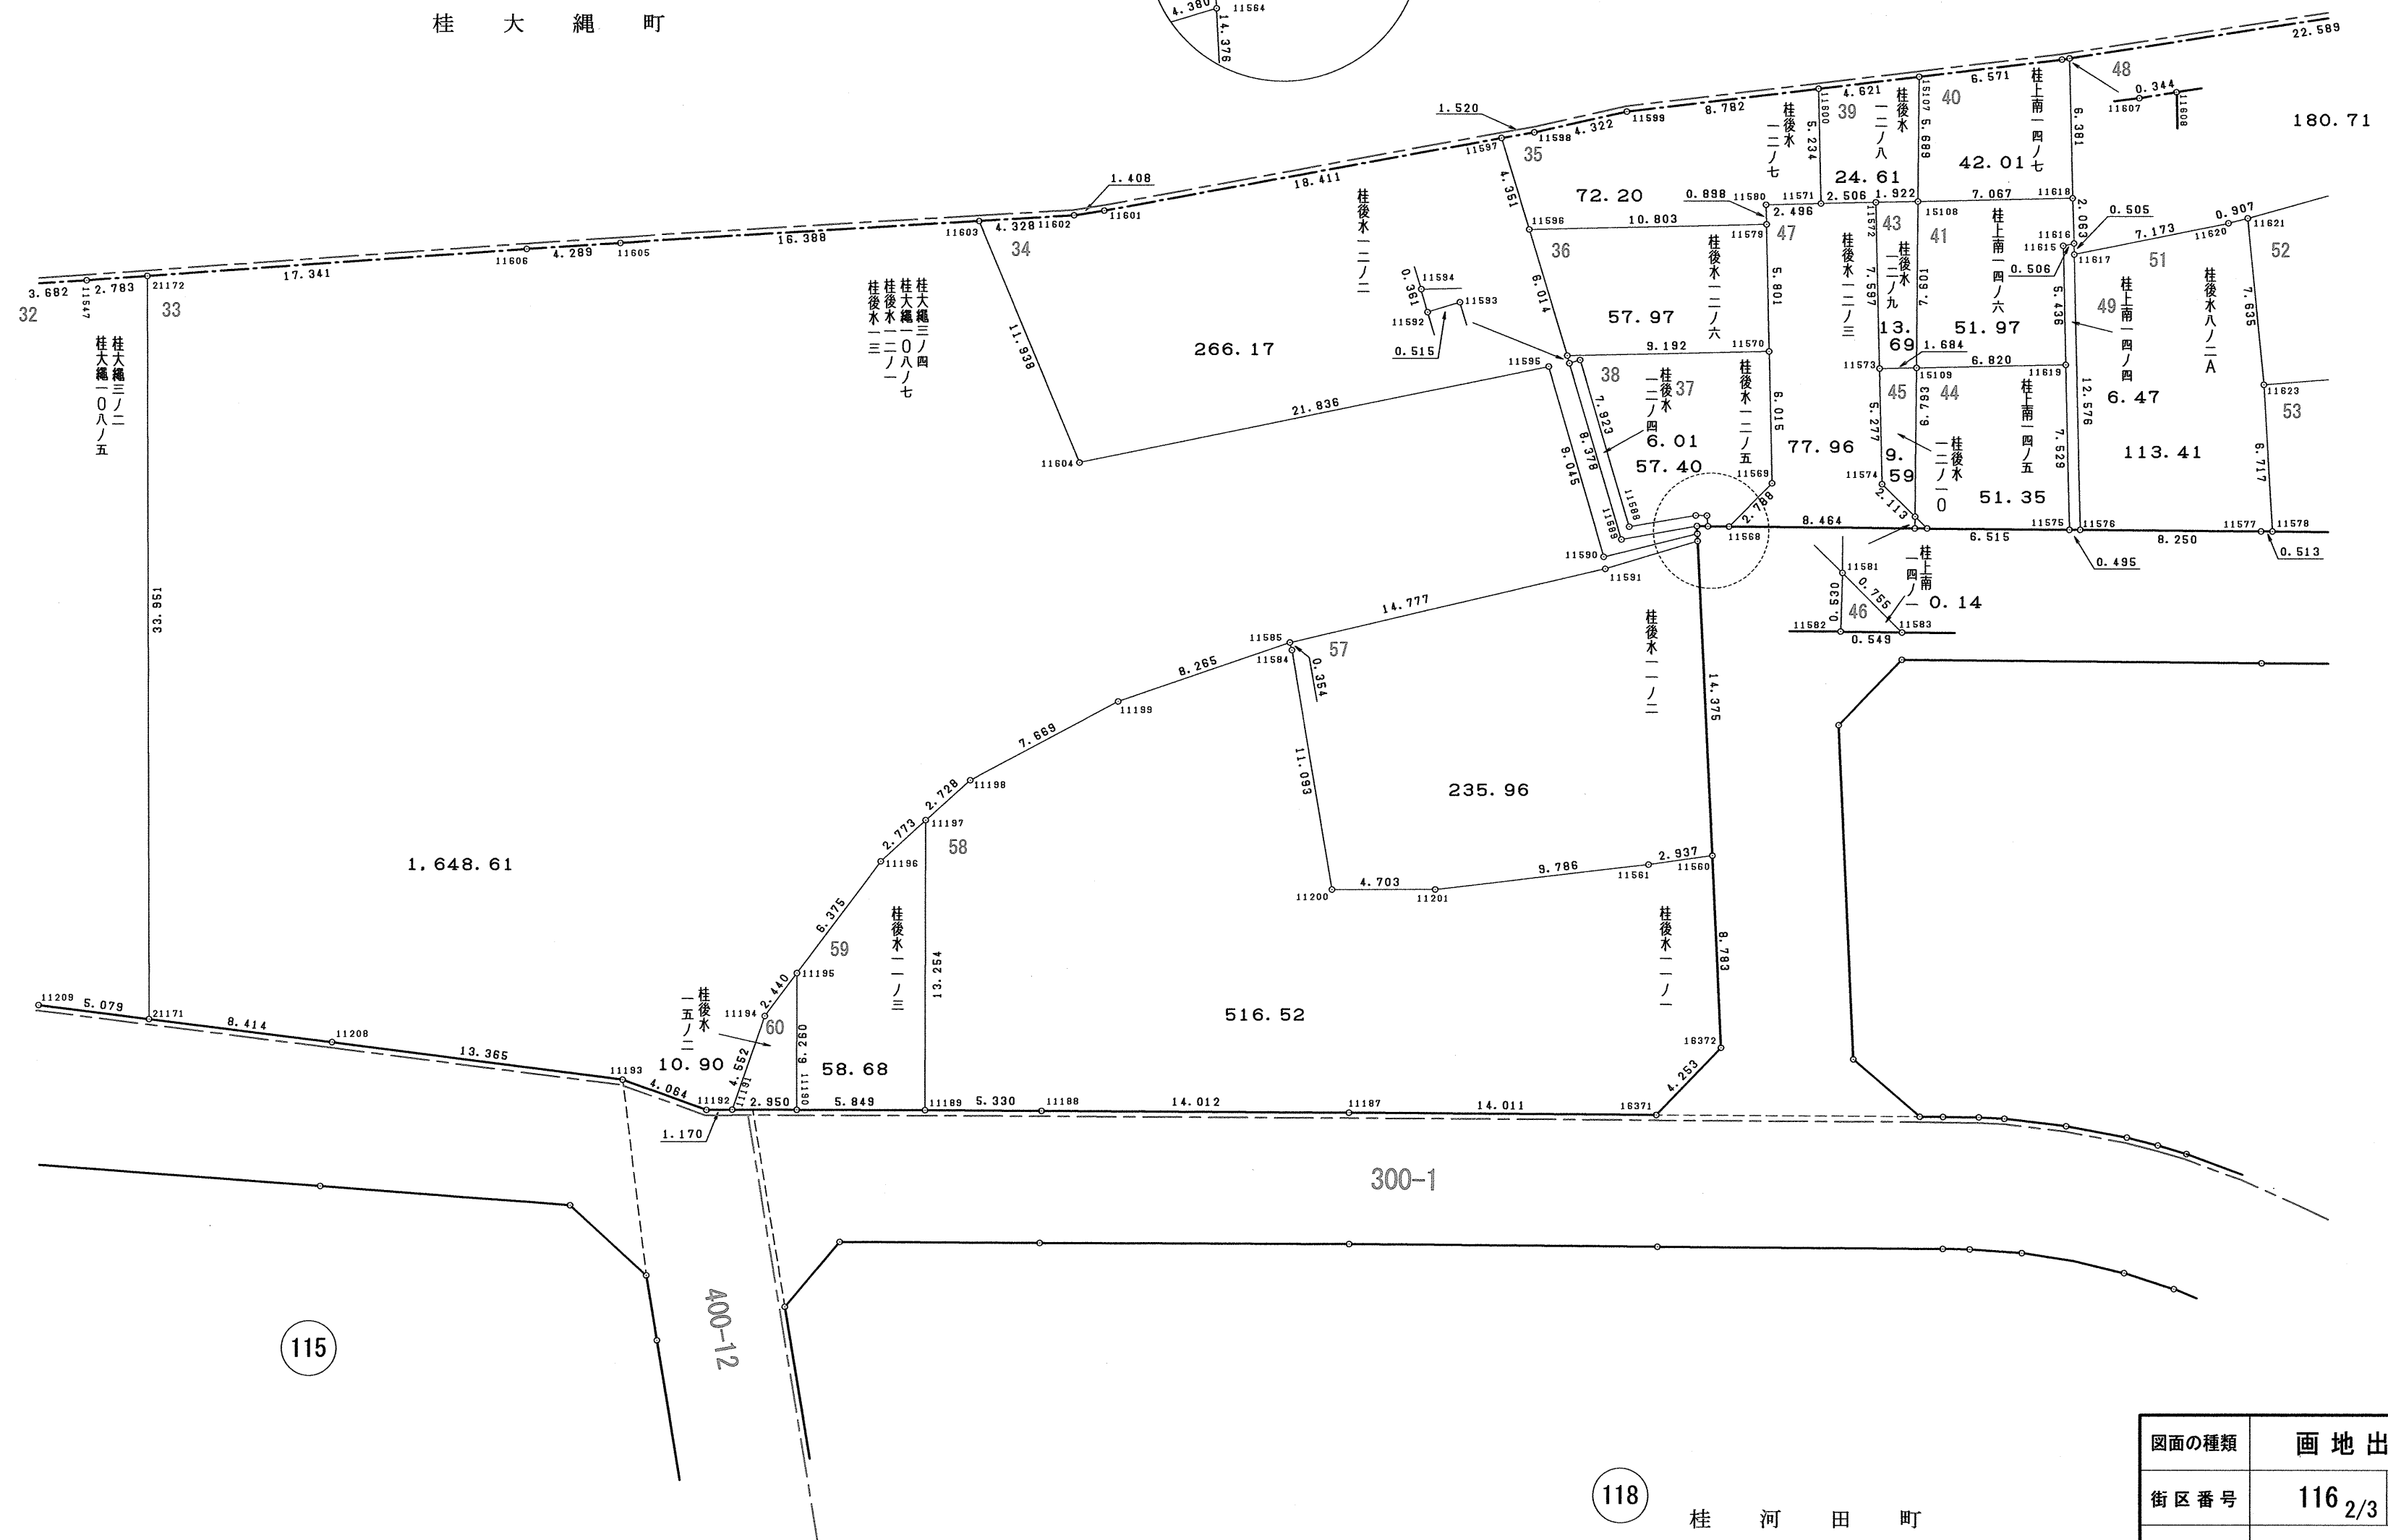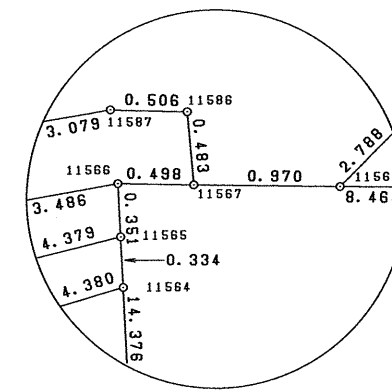

118

桂 河 田 町

図面の種類	画地出来形確認測量図			
街区番号	116 2/3	番号	縮尺	1:250
町名	桂徳大寺東町			
京都市洛西第二土地区画整理組合				

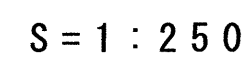

図面の種類	画地出来形確認測量図				
街区番号	116 _{3/3}	番号	／	縮尺	1:250
町名	桂徳大寺東町				
京都市洛西第二土地区画整理組合					

地番	桂後水一七ノ二		
N O	X	Y	辺 長
10643	-112025.981	-26712.215	
15117	-112038.329	-26708.148	13.001
15118	-112038.002	-26707.154	1.046
15119	-112025.704	-26711.204	12.948
10643	-112025.981	-26712.215	1.048
面積	13.5794745		
地積	13.57 m ²		

地番	桂後水一六ノ四、桂後水一七ノ一		
N O	X	Y	辺 長
15119	-112025.704	-26711.204	
15118	-112038.002	-26707.154	12.948
15117	-112038.329	-26708.148	1.046
11760	-112044.970	-26705.960	6.992
11213	-112053.566	-26703.111	9.056
11536	-112051.437	-26694.635	8.739
11535	-112038.863	-26697.627	12.925
11534	-112033.123	-26699.024	5.908
10644	-112023.254	-26702.250	10.383
15119	-112025.704	-26711.204	9.283
面積	272.0724070		
地積	272.07 m ²		

地番	桂大縄八ノ一		
N O	X	Y	辺 長
15115	-112022.605	-26699.713	
10645	-112022.709	-26700.258	0.555
10644	-112023.254	-26702.250	2.065
11534	-112033.123	-26699.024	10.383
11535	-112038.863	-26697.627	5.908
11536	-112051.437	-26694.635	12.925
11537	-112051.631	-26694.551	0.211
15116	-112050.503	-26689.268	5.402
15115	-112022.605	-26699.713	29.789
面積	110.4891960		
地積	110.48 m ²		

地番	桂大縄一〇八ノ三		
N O	X	Y	辺 長
15115	-112022.605	-26699.713	
15116	-112050.503	-26689.268	29.789
11538	-112048.964	-26682.055	7.375
11539	-112049.217	-26682.011	0.257
15114	-112048.390	-26678.541	3.567
15113	-112020.941	-26688.818	29.310
10646	-112021.178	-26692.205	3.395
15115	-112022.605	-26699.713	7.642
面積	320.0951405		
地積	320.09 m ²		

地番	徳清水一〇ノ一		
N O	X	Y	辺 長
15113	-112020.941	-26688.818	
15114	-112048.390	-26678.541	29.310
11550	-112047.629	-26675.341	3.289
11551	-112046.695	-26675.702	1.001
11554	-112032.882	-26680.586	14.651
11552	-112021.279	-26684.920	12.386
11553	-112020.841	-26687.389	2.508
15113	-112020.941	-26688.818	1.432
面積	99.3179615		
地積	99.31 m ²		

地番	桂大縄七ノ五		
N O	X	Y	辺 長
11539	-112049.217	-26682.011	
11540	-112060.687	-26678.666	11.948
11549	-112058.257	-26671.232	7.821
11550	-112047.629	-26675.341	11.395
15114	-112048.390	-26678.541	3.289
11539	-112049.217	-26682.011	3.567
面積	85.4079560		
地積	85.40 m ²		

地番	桂大縄七ノ六		
N O	X	Y	辺 長
11540	-112060.687	-26678.666	
12776	-112062.190	-26678.216	1.569
11543	-112078.849	-26673.176	17.405
11544	-112079.581	-26672.954	0.765
11545	-112076.573	-26664.739	8.748
11548	-112058.607	-26671.097	19.058
11549	-112058.257	-26671.232	0.375
11540	-112060.687	-26678.666	7.821
面積	162.3135020		
地積	162.31 m ²		

地番	桂大縄三ノ二、桂大縄一〇八ノ五		
N O	X	Y	辺 長
11211	-112081.522	-26693.783	
11210	-112084.210	-26692.884	2.834
11209	-112090.118	-26694.800	6.211
21171	-112095.070	-26693.672	5.079
21172	-112083.396	-26661.791	33.951
11547	-112080.856	-26662.928	2.783
11546	-112077.488	-26664.415	3.682
11545	-112076.573	-26664.739	0.971
11544	-112079.581	-26672.954	8.748
11543	-112078.849	-26673.176	0.765
11541	-112082.638	-26685.729	13.112
11542	-112079.883	-26686.642	2.902
11211	-112081.522	-26693.783	7.327
面積	297.6608775		
地積	297.66 m ²		

地番	桂大縄三ノ四、桂大縄一〇八ノ七 桂後水一二ノ一、桂後水一三			
N O	X	Y	辺 長	
21171	-112095.070	-26693.672		
11208	-112103.274	-26691.802	8.414	
11193	-112116.311	-26688.861	13.365	
11192	-112120.375	-26688.876	4.064	
11191	-112121.476	-26688.479	1.170	
11194	-112121.418	-26683.927	4.552	
11195	-112122.123	-26681.591	2.440	
11196	-112123.976	-26675.491	6.375	
11197	-112125.251	-26673.028	2.773	
11198	-112126.535	-26670.621	2.728	
11199	-112131.661	-26664.917	7.669	
11585	-112138.093	-26659.726	8.265	
11591	-112150.465	-26651.645	14.777	
11564	-112153.971	-26649.020	4.380	
11565	-112153.842	-26648.712	0.334	
11590	-112150.212	-26651.161	4.379	
11595	-112144.879	-26643.856	9.045	
11604	-112126.264	-26655.271	21.836	
11603	-112118.192	-26646.475	11.938	
11605	-112103.149	-26652.978	16.388	
11606	-112098.223	-26654.705	4.289	
21172	-112083.396	-26661.791	17.341	
21171	-112095.070	-26693.672	33.951	
面積	1648.6109910			
地積	1648.61 m ²			

地番	桂後水一ノ二		
N O	X	Y	辺 長
11604	-112126.264	-26655.271	
11595	-112144.879	-26643.856	21.836
11590	-112150.212	-26651.161	9.045
11565	-112153.842	-26648.712	4.379
11566	-112153.707	-26648.388	0.351
11589	-112150.691	-26650.136	3.486
11592	-112145.718	-26643.393	8.378
11594	-112145.509	-26643.099	0.361
11596	-112141.910	-26638.281	6.014
11597	-112139.299	-26634.800	4.351
11601	-112123.399	-26644.081	18.411
11602	-112122.165	-26644.758	1.408
11603	-112118.192	-26646.475	4.328
11604	-112126.264	-26655.271	11.938
面積	266.1744965		
地積	266.17 m ²		

地番	桂後水一二ノ七		
N O	X	Y	辺 長
11597	-112139.299	-26634.800	
11596	-112141.910	-26638.281	4.351
11579	-112151.974	-26634.355	10.803
11580	-112151.651	-26633.517	0.898
11571	-112153.977	-26632.611	2.496
11600	-112152.083	-26627.732	5.234
11599	-112144.248	-26631.698	8.782
11598	-112140.612	-26634.034	4.322
11597	-112139.299	-26634.800	1.520
面積	72.2049905		
地積	72.20 m ²		

地 番	桂後水一二ノ六		
N O	X	Y	辺 長
11594	-112145.509	-26643.099	
11570	-112154.074	-26639.763	9.192
11579	-112151.974	-26634.355	5.801
11596	-112141.910	-26638.281	10.803
11594	-112145.509	-26643.099	6.014
面積	57.9715730		
地積	57.97 m ²		

地番	桂後水一二ノ四		
N O	X	Y	辺 長
11592	-112145.718	-26643.393	
11589	-112150.691	-26650.136	8.378
11566	-112153.707	-26648.388	3.486
11567	-112154.177	-26648.222	0.498
11586	-112153.972	-26647.785	0.483
11587	-112153.493	-26647.947	0.506
11588	-112150.817	-26649.469	3.079
11593	-112146.128	-26643.082	7.923
11592	-112145.718	-26643.393	0.515
面積	6.0130665		
地積	6.01㎡		

51

地番	桂後水八ノ二A		
N O	X	Y	辺長
11576	-112170.201	-26642.562	
11577	-112177.980	-26639.814	8.250
11578	-112178.464	-26639.643	0.513
11623	-112175.807	-26633.474	6.717
11621	-112172.510	-26626.588	7.635
11620	-112171.763	-26627.103	0.907
11617	-112165.641	-26630.842	7.173
11576	-112170.201	-26642.562	12.576
面積	113.4197910		
地積	113.41㎡		

52

地番	桂後水九ノ四		
N O	X	Y	辺長
11623	-112175.807	-26633.474	
11632	-112180.956	-26631.120	5.662
11633	-112189.599	-26626.740	9.689
11634	-112194.487	-26621.964	6.834
11635	-112196.837	-26620.264	2.900
11627	-112202.987	-26616.604	7.157
11626	-112201.519	-26613.672	3.279
11625	-112199.547	-26609.961	4.202
11624	-112185.150	-26616.663	15.881
11622	-112178.826	-26622.051	8.308
11621	-112172.510	-26626.588	7.777
11623	-112175.807	-26633.474	7.635
面積	284.1778100		
地積	284.17㎡		

53

地番	桂後水九		
N O	X	Y	辺長
11578	-112178.464	-26639.643	
11636	-112195.308	-26633.700	17.862
11637	-112198.618	-26628.327	6.311
11638	-112206.936	-26624.359	9.216
11627	-112202.987	-26616.604	8.703
11635	-112196.837	-26620.264	7.157
11634	-112194.487	-26621.964	2.900
11633	-112189.599	-26626.740	6.834
11632	-112180.956	-26631.120	9.689
11623	-112175.807	-26633.474	5.662
11578	-112178.464	-26639.643	6.717
面積	257.3661770		
地積	257.36㎡		

54

地番	桂後水六ノ一		
N O	X	Y	辺長
11638	-112206.936	-26624.359	
11639	-112211.240	-26622.306	4.769
11647	-112222.949	-26616.668	12.996
16376	-112238.705	-26612.193	16.379
16377	-112226.977	-26586.287	28.437
11628	-112226.465	-26586.593	0.596
11613	-112219.728	-26590.452	7.764
11612	-112202.400	-26600.507	20.034
11611	-112199.293	-26602.189	3.533
11610	-112196.254	-26603.862	3.469
11625	-112199.547	-26609.961	6.931
11626	-112201.519	-26613.672	4.202
11627	-112202.987	-26616.604	3.279
11638	-112206.936	-26624.359	8.703
面積	863.2574670		
地積	863.25㎡		

55

地番	桂後水六ノ七		
N O	X	Y	辺長
16376	-112238.705	-26612.193	
11658	-112242.187	-26611.204	3.620
11660	-112251.448	-26608.528	9.640
15110	-112237.743	-26579.851	31.784
16377	-112226.977	-26586.287	12.543
16376	-112238.705	-26612.193	28.437
面積	385.1019715		
地積	385.10㎡		

56

地番	桂後水三ノ一A		
N O	X	Y	辺長
11660	-112251.448	-26608.528	
11661	-112261.313	-26605.677	10.269
11629	-112243.638	-26576.327	34.261
15110	-112237.743	-26579.851	6.868
11660	-112251.448	-26608.528	31.784
面積	278.6382550		
地積	278.63㎡		

57

地番	桂後水一ノ二		
N O	X	Y	辺長
11585	-112138.093	-26659.726	
11584	-112138.300	-26660.013	0.354
11200	-112143.763	-26669.668	11.093
11201	-112148.185	-26668.067	4.703
11561	-112156.923	-26663.662	9.786
11560	-112159.516	-26662.283	2.937
11564	-112153.971	-26649.020	14.375
11591	-112150.465	-26651.645	4.380
11585	-112138.093	-26659.726	14.777
面積	235.9660980		
地積	235.96㎡		

58

地番	桂後水一ノ一		
N O	X	Y	辺長
11189	-112129.753	-26685.494	
11188	-112134.767	-26683.686	5.330
11187	-112147.967	-26678.986	14.012
16371	-112161.164	-26674.281	14.011
16372	-112162.887	-26670.393	4.253
11560	-112159.516	-26662.283	8.783
11561	-112156.923	-26663.662	2.937
11201	-112148.185	-26668.067	9.786
11200	-112143.763	-26669.668	4.703
11584	-112138.300	-26660.013	11.093
11585	-112138.093	-26659.726	0.354
11199	-112131.661	-26664.917	8.265
11198	-112126.535	-26670.621	7.669
11197	-112125.251	-26673.028	2.728
11189	-112129.753	-26685.494	13.254
面積	516.5271780		
地積	516.52㎡		

59

地番	桂後水一ノ三		
N O	X	Y	辺長
11190	-112124.251	-26687.478	
11189	-112129.753	-26685.494	5.849
11197	-112125.251	-26673.028	13.254
11196	-112123.976	-26675.491	2.773
11195	-112122.123	-26681.591	6.375
11190	-112124.251	-26687.478	6.260
面積	58.6850305		
地積	58.68㎡		

60

地番	桂後水一五ノ二		
N O	X	Y	辺長
11191	-112121.476	-26688.479	
11190	-112124.251	-26687.478	2.950
11195	-112122.123	-26681.591	6.260
11194	-112121.418	-26683.927	2.440
11191	-112121.476	-26688.479	4.552
面積	10.9056005		
地積	10.90㎡		

61

地番	桂河田一三ノ二A		
N O	X	Y	辺長
15121	-112077.823	-26695.020	
11211	-112081.522	-26693.783	3.900
11542	-112079.883	-26686.642	7.327
15120	-112076.181	-26687.869	3.900
15121	-112077.823	-26695.020	7.337
面積	28.4648690		
地積	28.46㎡		

62

地番	桂大縄一〇八ノ四		
N O	X	Y	辺長
12772	-112069.477	-26697.810	
15121	-112077.823	-26695.020	8.800
15120	-112076.181	-26687.869	7.337
11542	-112079.883	-26686.642	3.900
11541	-112082.638	-26685.729	2.902
11543	-112078.849	-26673.176	13.112
12776	-112062.190	-26678.216	17.405
12775	-112064.722	-26685.834	8.028
12774	-112065.415	-26685.614	0.727
12772	-112069.477	-26697.810	12.855
面積	292.5516240		
地積	292.55㎡		

63

地番	桂後水一六ノ一		
N O	X	Y	辺長
11537	-112051.631	-26694.551	
12778	-112057.655	-26692.487	6.368
12777	-112064.231	-26690.236	6.951
12773	-112067.056	-26698.620	8.847
12772	-112069.477	-26697.810	2.553
12774	-112065.415	-26685.614	12.855
12775	-112064.722	-26685.834	0.727
12776	-112062.190	-26678.216	8.028
11540	-112060.687	-26678.666	1.569
11539	-112049.217	-26682.011	11.948
11538	-112048.964	-26682.055	0.257
15116	-112050.503	-26689.268	7.375
11537	-112051.631	-26694.551	5.402
面積	204.4343165		
地積	204.43㎡		

64

地番	桂大縄七ノ一		
N O	X	Y	辺長
12778	-112057.655	-26692.487	
12779	-112060.459	-26700.825	8.797
12773	-112067.056	-26698.620	6.956
12777	-112064.231	-26690.236	8.847
12778	-112057.655	-26692.487	6.951
面積	61.3404325		
地積	61.34㎡		

65

地番	桂後水一五ノ一		
N O	X	Y	辺長
11536	-112051.437	-26694.635	
11213	-112053.566	-26703.111	8.739
11212	-112060.316	-26700.873	7.111
12779	-112060.459	-26700.825	0.151
12778	-112057.655	-26692.487	8.797
11537	-112051.631	-26694.551	6.368
11536	-112051.437	-26694.635	0.211
面積	60.6351020		
地積	60.63㎡		

図面の種類	画 地 面 積 求 積 表				
街区 番号	116	番号	$\frac{2}{2}$	縮 尺	
町 名	桂 徳 大 寺 東 町				
京 都 市 洛 西 第 二 土 地 区 画 整 理 組 合					

地番	桂後水八ノ二B		
N O	X	Y	辺 長
11556	-112168.731	-26668.827	
11761	-112172.477	-26670.243	4.005
11762	-112173.468	-26669.901	1.048
11763	-112175.029	-26669.358	1.653
11764	-112176.148	-26669.013	1.171
11765	-112178.901	-26668.368	2.828
11767	-112181.689	-26667.910	2.825
11766	-112183.131	-26667.767	1.449
11768	-112184.505	-26667.683	1.377
11769	-112185.665	-26667.690	1.160
11845	-112182.067	-26657.247	11.045
15100	-112181.925	-26656.840	0.431
11557	-112166.087	-26662.439	16.799
11556	-112168.731	-26668.827	6.914
面積	160.6011825		
地積	160.60 m ²		

地番	桂後水一〇ノ二		
N O	X	Y	辺 長
11557	-112166.087	-26662.439	
15100	-112181.925	-26656.840	16.799
11630	-112178.198	-26646.119	11.350
11559	-112164.573	-26650.935	14.451
11558	-112162.891	-26654.720	4.142
11557	-112166.087	-26662.439	8.354
面積	189.8901565		
地積	189.89 m ²		

地番	保 一一七ノ一号		
N O	X	Y	辺 長
11845	-112182.067	-26657.247	
11846	-112191.947	-26653.753	10.480
11646	-112188.005	-26642.646	11.786
11631	-112180.053	-26645.463	8.436
11630	-112178.198	-26646.119	1.968
15100	-112181.925	-26656.840	11.350
11845	-112182.067	-26657.247	0.431
面積	123.0381555		
地積	123.03 m ²		

地番	桂後水一〇ノ一		
N O	X	Y	辺 長
11847	-112192.998	-26656.746	
11848	-112199.467	-26654.449	6.865
11849	-112209.835	-26650.776	10.999
11850	-112207.303	-26645.170	6.151
11641	-112202.297	-26633.886	12.345
11640	-112199.378	-26638.617	5.559
11646	-112188.005	-26642.646	12.066
11846	-112191.947	-26653.753	11.786
11847	-112192.998	-26656.746	3.172
面積	265.9512990		
地積	265.95 m ²		

地番	保 一一七ノ二号		
N O	X	Y	辺 長
11850	-112207.303	-26645.170	
11851	-112213.150	-26642.590	6.391
11642	-112207.830	-26630.604	13.114
11649	-112202.861	-26632.971	5.504
11641	-112202.297	-26633.886	1.075
11850	-112207.303	-26645.170	12.345
面積	82.9417265		
地積	82.94 m ²		

地番	桂久方一八ノ一		
N O	X	Y	辺 長
11851	-112213.150	-26642.590	
11852	-112217.080	-26640.850	4.298
11643	-112211.725	-26628.748	13.234
11642	-112207.830	-26630.604	4.315
11851	-112213.150	-26642.590	13.114
面積	56.7189750		
地積	56.71 m ²		

地番	桂後水七ノ九		
N O	X	Y	辺 長
11852	-112217.080	-26640.850	
11853	-112221.531	-26638.884	4.866
11645	-112216.064	-26626.675	13.377
11644	-112213.835	-26627.743	2.472
11643	-112211.725	-26628.748	2.337
11852	-112217.080	-26640.850	13.234
面積	64.3442695		
地積	64.34 m ²		

地番	桂後水七ノ一〇		
N O	X	Y	辺 長
11853	-112221.531	-26638.884	
11854	-112225.475	-26637.127	4.318
11855	-112226.249	-26636.784	0.847
11856	-112224.006	-26631.807	5.459
15102	-112223.239	-26632.098	0.820
15101	-112219.989	-26624.793	7.995
11645	-112216.064	-26626.675	4.353
11853	-112221.531	-26638.884	13.377
面積	62.8165765		
地積	62.81 m ²		

地番	桂久方一八ノ九		
N O	X	Y	辺 長
15102	-112223.239	-26632.098	
11856	-112224.006	-26631.807	0.820
11650	-112220.688	-26624.458	8.063
15101	-112219.989	-26624.793	0.775
15102	-112223.239	-26632.098	7.995
面積	6.3985830		
地積	6.39 m ²		

地番	桂久方一八ノ一〇		
N O	X	Y	辺 長
11856	-112224.006	-26631.807	
11857	-112225.336	-26631.302	1.423
11858	-112227.357	-26630.513	2.170
11862	-112228.609	-26629.891	1.398
11652	-112225.214	-26622.338	8.281
11651	-112224.945	-26622.417	0.280
11650	-112220.688	-26624.458	4.721
11856	-112224.006	-26631.807	8.063
面積	41.1363690		
地積	41.13 m ²		

地番	桂後水七ノ一一		
N O	X	Y	辺 長
11855	-112226.249	-26636.784	
15103	-112227.547	-26636.196	1.425
11857	-112225.336	-26631.302	5.370
11856	-112224.006	-26631.807	1.423
11855	-112226.249	-26636.784	5.459
面積	7.7023025		
地積	7.70 m ²		

地番	桂久方一八ノ一一		
N O	X	Y	辺 長
11862	-112228.609	-26629.891	
11863	-112235.106	-26627.025	7.101
11813	-112232.089	-26620.316	7.356
11652	-112225.214	-26622.338	7.166
11862	-112228.609	-26629.891	8.281
面積	55.5133300		
地積	55.51 m ²		

地番	保 一一七ノ四号		
N O	X	Y	辺 長
11863	-112235.106	-26627.025	
11864	-112236.909	-26626.211	1.978
11653	-112234.110	-26619.740	7.050
11813	-112232.089	-26620.316	2.101
11863	-112235.106	-26627.025	7.356
面積	14.6211400		
地積	14.62 m ²		

地番	桂後水七ノ七		
N O	X	Y	辺 長
11859	-112229.474	-26635.267	
11876	-112239.008	-26631.013	10.440
11864	-112236.909	-26626.211	5.241
11863	-112235.106	-26627.025	1.978
11862	-112228.609	-26629.891	7.101
11858	-112227.357	-26630.513	1.398
11859	-112229.474	-26635.267	5.204
面積	54.8315180		
地積	54.83 m ²		

地番	桂後水七ノ六		
N O	X	Y	辺 長
11860	-112231.607	-26640.054	
11875	-112241.077	-26635.782	10.389
11876	-112239.008	-26631.013	5.198
11859	-112229.474	-26635.267	10.440
11860	-112231.607	-26640.054	5.241
面積	54.3571190		
地積	54.35 m ²		

地番	桂後水七ノ五		
N O	X	Y	辺 長
11861	-112235.240	-26648.164	
11865	-112240.193	-26645.950	5.425
11868	-112244.629	-26643.983	4.853
11874	-112241.434	-26636.604	8.041
11875	-112241.077	-26635.782	0.896
11860	-112231.607	-26640.054	10.389
11861	-112235.240	-26648.164	8.887
面積	92.0506185		
地積	92.05 m ²		

地番	保 一一七ノ三号		
N O	X	Y	辺 長
11874	-112241.434	-26636.604	
11869	-112242.748	-26636.045	1.428
11870		-26635.116	2.323
11654	-112237.740	-26618.706	17.895
11653	-112234.110	-26619.740	3.774
11864	-112236.909	-26626.211	7.050
11876	-112239.008	-26631.013	5.241
11875	-112241.077	-26635.782	5.198
11874	-112241.434	-26636.604	0.896
面積	68.0233215		
地積	68.02 m ²		

地番	保 一一七ノ一一号		
N O	X	Y	辺 長
11870	-112244.877	-26635.116	
11871	-112248.182	-26633.681	3.603
11655	-112241.230	-26617.711	17.418
11654	-112237.740	-26618.706	3.629
11870	-112244.877	-26635.116	17.895
面積	63.5645925		
地積	63.56 m ²		

地番	保 一一七ノ一〇号		
N O	X	Y	辺 長
11871	-112248.182	-26633.681	
11872	-112251.480	-26632.240	3.599
11657	-112244.715	-26616.716	16.934
11656	-112243.967	-26616.931	0.778
11655	-112241.230	-26617.711	2.846
11871	-112248.182	-26633.681	17.418
面積	61.7570960		
地積	61.75 m ²		

地番	保 一一七ノ九号		
N O	X	Y	辺 長
11872	-112251.480	-26632.240	
11873	-112254.919	-26630.736	3.753
15106	-112253.421	-26627.299	3.749
15105	-112251.943	-26623.909	3.698
15104	-112250.466	-26620.519	3.698
11812	-112248.353	-26615.671	5.288
11657	-112244.715	-26616.716	3.785
11872	-112251.480	-26632.240	16.934
面積	62.6132090		
地積	62.61 m ²		

地番	保 一一七ノ八号		
N O	X	Y	辺 長
11812	-112248.353	-26615.671	
15104	-112250.466	-26620.519	5.288
11665	-112260.549	-26616.126	10.998
11663	-112260.060	-26615.311	0.950</

93

地番	桂後水七ノ四		
N O	X	Y	辺 長
11830	-112241.920	-26662.093	
11829	-112244.649	-26660.757	3.038
11828	-112246.475	-26659.758	2.081
11865	-112240.193	-26645.950	15.170
11861	-112235.240	-26648.164	5.425
11830	-112241.920	-26662.093	15.448
面積	80.8152510		
地積	80.81㎡		

94

地番	桂後水七ノ八		
N O	X	Y	辺 長
11832	-112239.690	-26663.080	
11831	-112241.502	-26662.297	1.974
11830	-112241.920	-26662.093	0.465
11861	-112235.240	-26648.164	15.448
11860	-112231.607	-26640.054	8.887
11859	-112229.474	-26635.267	5.241
11858	-112227.357	-26630.513	5.204
11857	-112225.336	-26631.302	2.170
15103	-112227.547	-26636.196	5.370
11832	-112239.690	-26663.080	29.499
面積	76.0339340		
地積	76.03㎡		

95

地番	桂後水七ノ二		
N O	X	Y	辺 長
11834	-112237.457	-26664.011	
11833	-112238.277	-26663.690	0.881
11832	-112239.690	-26663.080	1.539
15103	-112227.547	-26636.196	29.499
11855	-112226.249	-26636.784	1.425
11854	-112225.475	-26637.127	0.847
11834	-112237.457	-26664.011	29.433
面積	69.1163620		
地積	69.11㎡		

96

地番	桂後水七ノ一		
N O	X	Y	辺 長
11789	-112217.864	-26668.924	
11790	-112217.951	-26668.916	0.087
11791	-112221.428	-26668.442	3.509
11840	-112224.873	-26667.793	3.506
11839	-112228.284	-26666.992	3.504
11838	-112229.921	-26666.566	1.692
11837	-112231.665	-26666.046	1.820
11836	-112234.995	-26664.932	3.511
11835	-112236.351	-26664.444	1.441
11834	-112237.457	-26664.011	1.188
11854	-112225.475	-26637.127	29.433
11853	-112221.531	-26638.884	4.318
11852	-112217.080	-26640.850	4.866
11851	-112213.150	-26642.590	4.298
11850	-112207.303	-26645.170	6.391
11849	-112209.835	-26650.776	6.151
11789	-112217.864	-26668.924	19.845
面積	559.3371870		
地積	559.33㎡		

97

地番	桂後水八ノ四		
N O	X	Y	辺 長
11785	-112206.049	-26669.347	
11786	-112207.435	-26669.415	1.388
11787	-112210.947	-26669.429	3.512
11788	-112214.454	-26669.244	3.512
11789	-112217.864	-26668.924	3.425
11849	-112209.835	-26650.776	19.845
11848	-112199.467	-26654.449	10.999
11785	-112206.049	-26669.347	16.287
面積	200.1022615		
地積	200.10㎡		

98

地番	桂後水八ノ一		
N O	X	Y	辺 長
11782	-112197.176	-26668.595	
11783	-112202.133	-26669.083	4.981
11784	-112203.934	-26669.244	1.808
11785	-112206.049	-26669.347	2.118
11848	-112199.467	-26654.449	16.287
11847	-112192.998	-26656.746	6.865
11782	-112197.176	-26668.595	12.564
面積	107.1228545		
地積	107.12㎡		


99

地番	桂後水八ノ三		
N O	X	Y	辺 長
11769	-112185.665	-26667.690	
11780	-112187.333	-26667.700	1.668
11781	-112190.162	-26667.902	2.836
11782	-112197.176	-26668.595	7.048
11847	-112192.998	-26656.746	12.564
11846	-112191.947	-26653.753	3.172
11845	-112182.067	-26657.247	10.480
11769	-112185.665	-26667.690	11.045
面積	139.9363575		
地積	139.93㎡		

図面の種類	画 地 面 積 求 積 表				
街区 番号	117	番号	$\frac{2}{2}$	縮 尺	
町 名	桂 徳 大 寺 東 町				
京 都 市 洛 西 第 二 土 地 区 画 整 理 組 合					



図面の種類	画地出来形確認測量図			
街区番号	118 _{1/2}	番号	縮尺	1:250
町名	桂河田町			
京都市洛西第二土地区画整理組合				

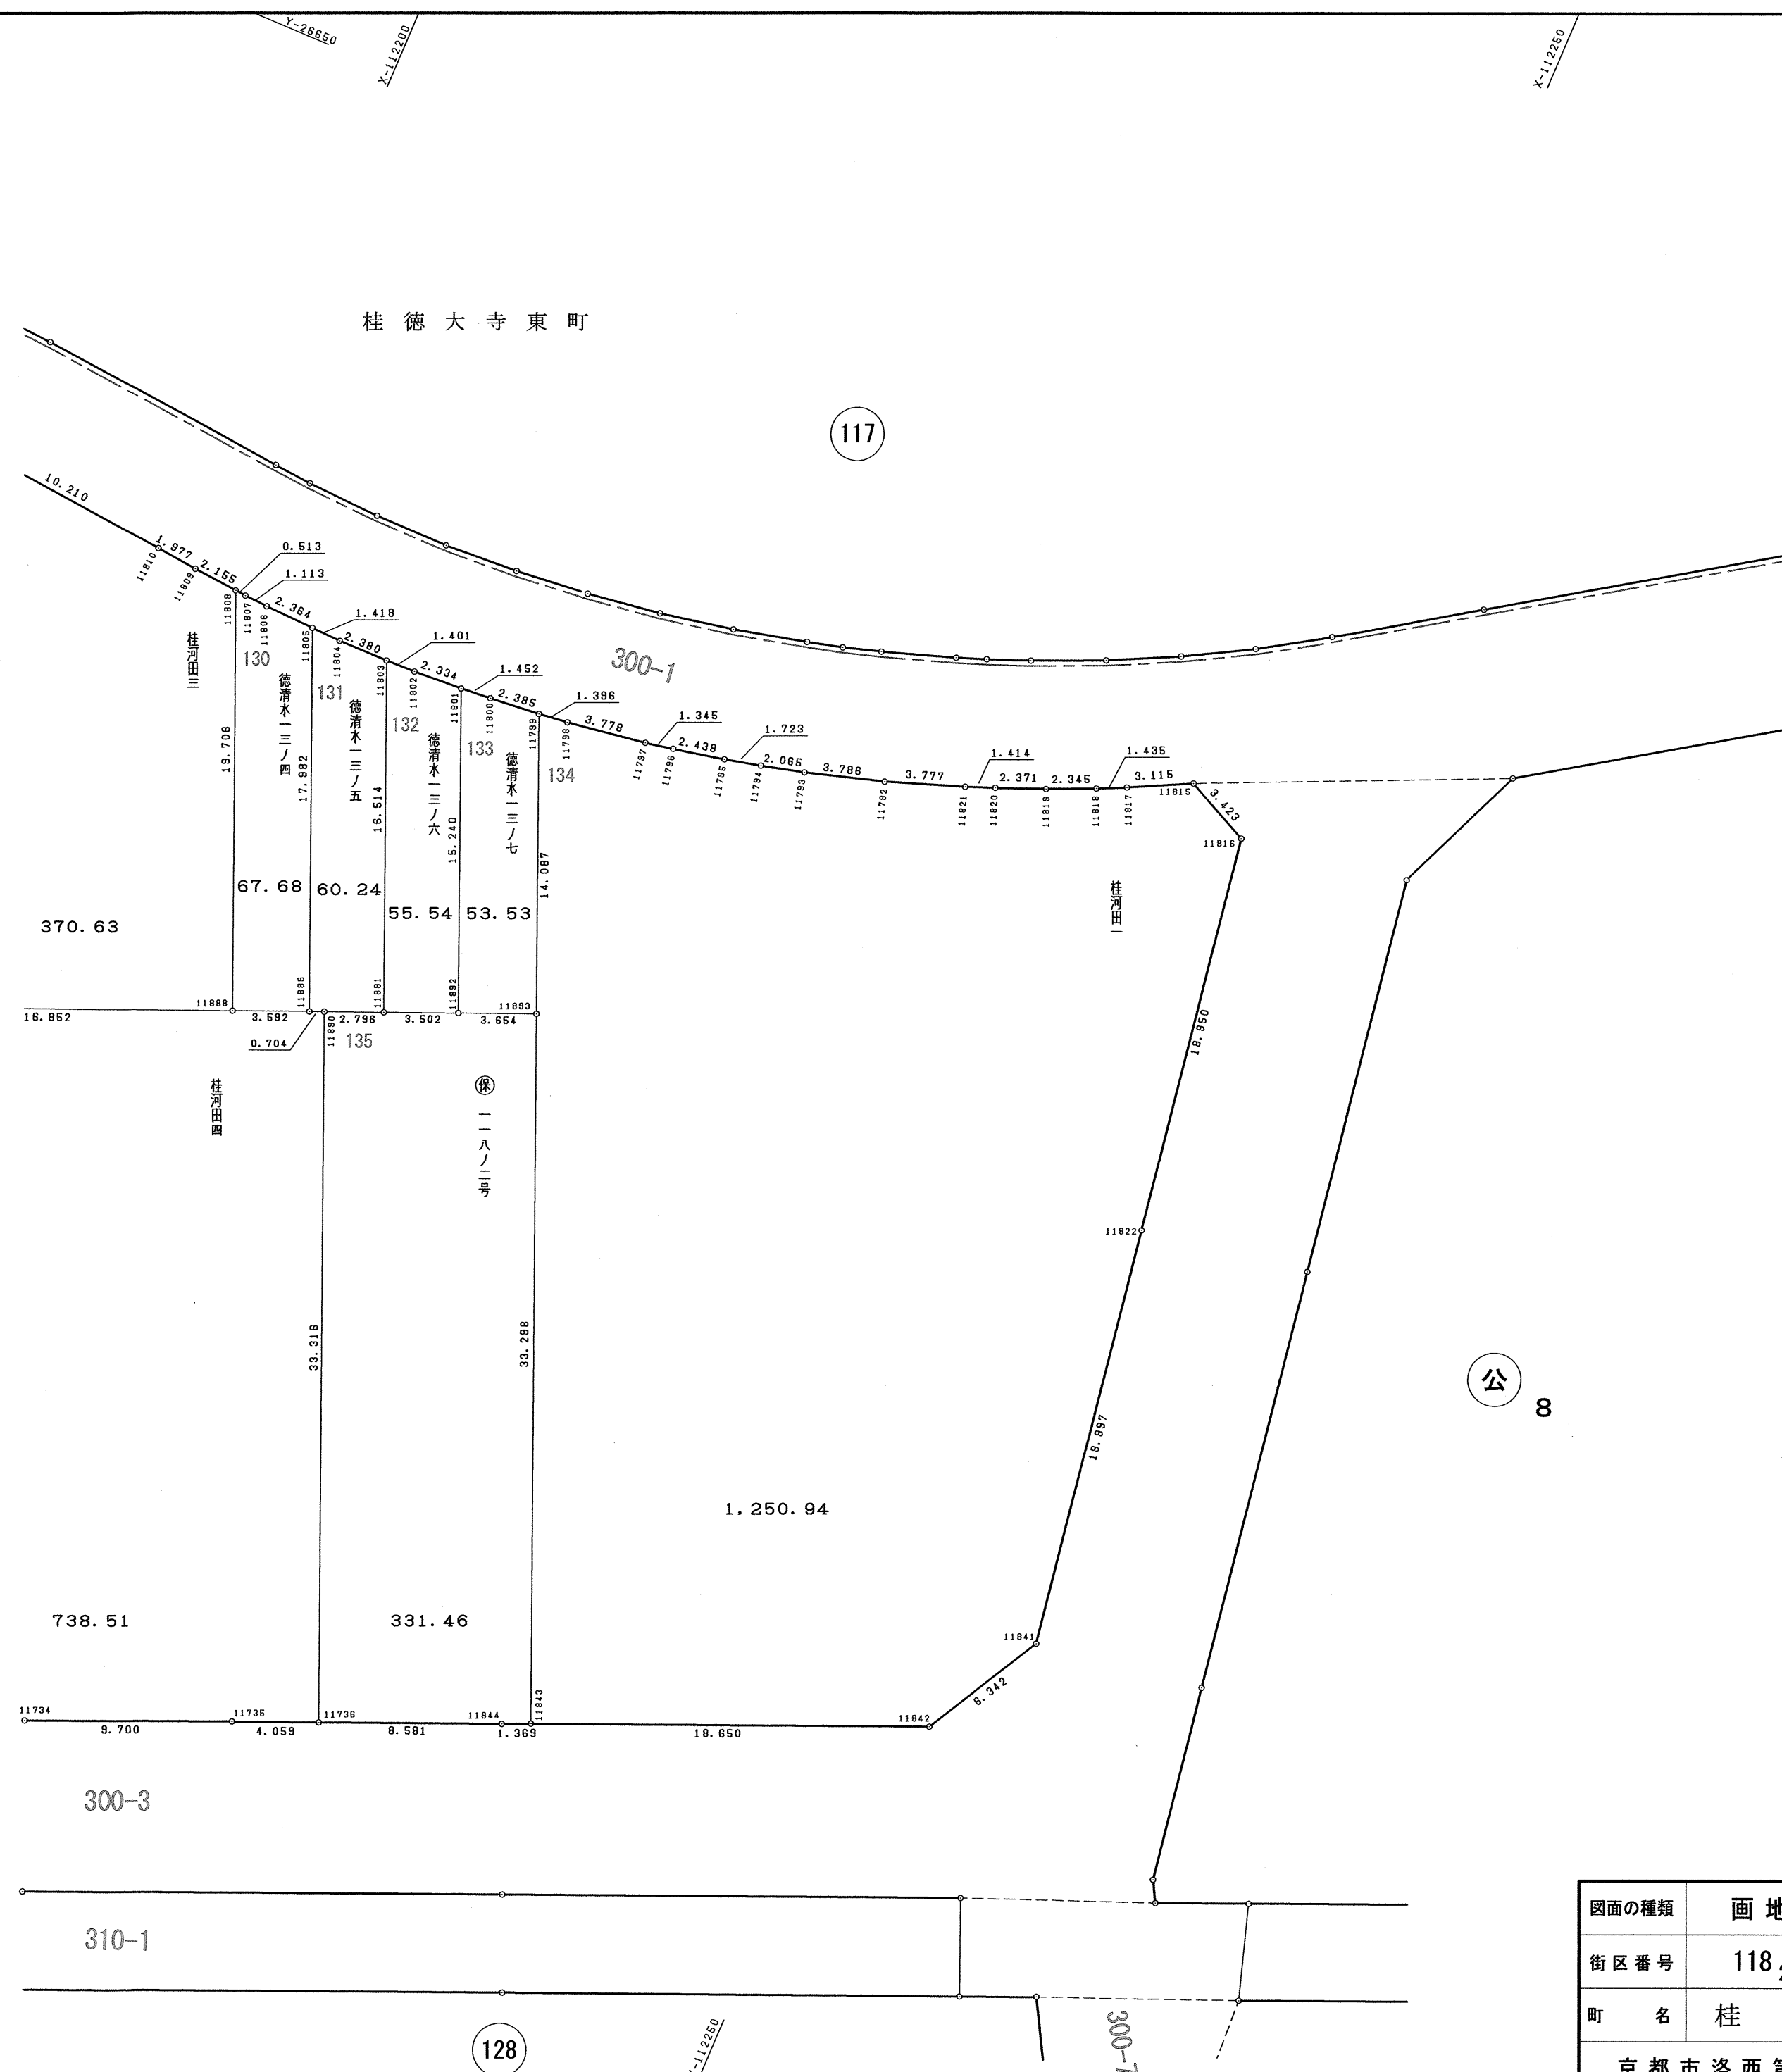

図面の種類	画地出来形確認測量図				
街区番号	118 _{2/2}	番号		縮尺	1:250
町名	桂河田町				
京都市洛西第二土地区画整理組合					

120

地番	桂河田七ノ三、桂河田八			
N O	X	Y	辺 長	
11756	-112156.266	-26748.839		
11755	-112160.473	-26750.302	4.454	
11741	-112172.416	-26745.302	12.947	
11742	-112178.922	-26742.586	7.050	
11743	-112182.956	-26740.906	4.370	
15122	-112174.123	-26719.564	23.098	
21174	-112171.401	-26720.597	2.911	
11895	-112166.567	-26722.432	5.171	
11759	-112146.347	-26731.065	21.986	
11758	-112146.457	-26731.262	0.226	
11757	-112154.620	-26745.929	16.786	
11756	-112156.266	-26748.839	3.343	
面積	663.6418840			
地積	663.64			m ²

121

地番	桂河田七ノ四、八ノ五、八ノ六			
N O	X	Y	辺 長	
11759	-112146.347	-26731.065		
11895	-112166.567	-26722.432	21.986	
11896	-112157.501	-26716.215	10.993	
11897	-112148.040	-26698.911	19.722	
11185	-112142.018	-26687.497	12.905	
11184	-112136.750	-26689.386	5.596	
11183	-112128.144	-26692.464	9.140	
11182	-112126.813	-26696.099	3.871	
11894	-112136.652	-26713.658	20.128	
11759	-112146.347	-26731.065	19.925	
面積	746.4350435			
地積	746.43			m ²

122

地番	桂河田七ノ二、桂河田八ノ四			
N O	X	Y	辺 長	
21173	-112157.683	-26681.910		
11186	-112150.032	-26684.623	8.118	
11185	-112142.018	-26687.497	8.514	
11897	-112148.040	-26698.911	12.905	
11896	-112157.501	-26716.215	19.722	
11895	-112166.567	-26722.432	10.993	
21174	-112171.401	-26720.597	5.171	
21173	-112157.683	-26681.910	41.047	
面積	532.3636305			
地積	532.36			m ²

123

地番	桂河田六ノ二、桂河田七ノ一			
N O	X	Y	辺 長	
11884	-112181.057	-26716.932		
11882	-112178.692	-26710.346	6.998	
11883	-112177.192	-26706.197	4.412	
11880	-112171.804	-26691.409	15.739	
11879	-112171.659	-26690.429	0.991	
11778	-112167.225	-26678.522	12.706	
11779	-112163.273	-26679.928	4.195	
21173	-112157.683	-26681.910	5.931	
21174	-112171.401	-26720.597	41.047	
15122	-112174.123	-26719.564	2.911	
11884	-112181.057	-26716.932	7.417	
面積	419.0901850			
地積	419.09			m ²

124

地番	桂河田六ノ三			
N O	X	Y	辺 長	
11879	-112171.659	-26690.429		
15126	-112179.577	-26687.192	8.554	
11776	-112175.953	-26675.420	12.317	
11777	-112175.528	-26675.568	0.450	
11778	-112167.225	-26678.522	8.813	
11879	-112171.659	-26690.429	12.706	
面積	111.3233770			
地積	111.32			m ²

125

地番	桂河田五ノ二、桂河田六ノ一			
N O	X	Y	辺 長	
11883	-112177.192	-26706.197		
15123	-112183.957	-26703.729	7.201	
15124	-112184.597	-26703.496	0.681	
15126	-112179.577	-26687.192	17.059	
11879	-112171.659	-26690.429	8.554	
11880	-112171.804	-26691.409	0.991	
11883	-112177.192	-26706.197	15.739	
面積	140.0920950			
地積	140.09			m ²

126

地番	桂河田五ノ八			
N O	X	Y	辺 長	
15126	-112179.577	-26687.192		
11878	-112184.869	-26685.084	5.696	
11773	-112181.329	-26674.046	11.592	
11774	-112178.989	-26674.506	2.385	
11775	-112176.702	-26675.160	2.379	
11776	-112175.953	-26675.420	0.793	
15126	-112179.577	-26687.192	12.317	
面積	67.4940190			
地積	67.49			m ²

127

地番	桂河田五ノ四			
N O	X	Y	辺 長	
15124	-112184.597	-26703.496		
15125	-112191.852	-26700.850	7.722	
11814	-112183.544	-26673.780	28.316	
11773	-112181.329	-26674.046	2.231	
11878	-112184.869	-26685.084	11.592	
15126	-112179.577	-26687.192	5.696	
15124	-112184.597	-26703.496	17.059	
面積	156.5794840			
地積	156.57			m ²

128

地番	桂河田五ノ三			
N O	X	Y	辺 長	
11886	-112193.762	-26700.153		
11887	-112194.692	-26699.825	0.986	
11877	-112190.379	-26685.968	14.513	
11770	-112186.698	-26673.712	12.797	
11771	-112186.066	-26673.684	0.633	
11772	-112183.687	-26673.763	2.380	
11814	-112183.544	-26673.780	0.144	
15125	-112191.852	-26700.850	28.316	
11886	-112193.762	-26700.153	2.033	
面積	83.2923435			
地積	83.29			m ²

129

地番	桂河田三			
N O	X	Y	辺 長	
11887	-112194.692	-26699.825		
11888	-112210.280	-26693.421	16.852	
11808	-112202.709	-26675.227	19.706	
11809	-112200.583	-26675.031	2.155	
11810	-112198.598	-26674.811	1.977	
11811	-112188.439	-26673.790	10.210	
11770	-112186.698	-26673.712	1.743	
11877	-112190.379	-26685.968	12.797	
11887	-112194.692	-26699.825	14.513	
面積	370.6300950			
地積	370.63			m ²

130

地番	徳清水一三ノ四			
N O	X	Y	辺 長	
11888	-112210.280	-26693.421		
11889	-112213.595	-26692.039	3.592	
11805	-112206.693	-26675.434	17.982	
11806	-112204.331	-26675.338	2.364	
11807	-112203.220	-26675.274	1.113	
11808	-112202.709	-26675.227	0.513	
11888	-112210.280	-26693.421	19.706	
面積	67.6879275			
地積	67.68			m ²

131

地番	徳清水一三ノ五			
N O	X	Y	辺 長	
11889	-112213.595	-26692.039		
11890	-112214.250	-26691.780	0.704	
11891	-112216.834	-26690.713	2.796	
11803	-112210.490	-26675.466	16.514	
11804	-112208.110	-26675.491	2.380	
11805	-112206.693	-26675.434	1.418	
11889	-112213.595	-26692.039	17.982	
面積	60.2420210			
地積	60.24			m ²

132


地番	徳清水一三ノ六			
N O	X	Y	辺 長	
11891	-112216.834	-26690.713		
11892	-112220.070	-26689.375	3.502	
11801	-112214.220	-26675.303	15.240	
11802	-112211.891	-26675.452	2.334	
11803	-112210.490	-26675.466	1.401	
11891	-112216.834	-26690.713	16.514	
面積	55.5467655			
地積	55.54			m ²

133

地番	徳清水一三ノ七			
N O	X	Y	辺 長	
11892	-112220.070	-26689.375		
11893	-112223.449	-26687.983	3.654	
11799	-112218.042	-26674.975	14.087	
11800	-112215.669	-26675.210	2.385	
11801	-112214.220	-26675.303	1.452	
11892	-112220.070	-26689.375	15.240	
面積	53.5313670			
地積	53.53			m ²

134

地番	桂河田一		
N O	X	Y	辺 長
11843	-112236.251	-26718.722	
11842	-112253.464	-26711.542	18.650
11841	-112256.550	-26706.002	6.342
11822	-112253.485	-26686.241	19.997
11816	-112250.588	-26667.514	18.950
11815	-112247.512	-26666.012	3.423
11817	-112244.725	-26667.404	3.115
11818	-112243.426	-26668.014	1.435
11819	-112241.278	-26668.954	2.345
11820	-112239.078	-26669.839	2.371
11821	-112237.756	-26670.340	1.414
11792	-112234.194	-26671.595	3.777
11793	-112230.563	-26672.668	3.786
11794	-112228.560	-26673.170	2.065
11795	-112226.882	-26673.562	1.723
11796	-112224.494	-26674.054	2.438
11797	-112223.171	-26674.299	3.745
11798	-112219.431	-26674.837	1.378
11799	-112218.042	-26674.975	1.396
11893	-112223.449	-26687.983	14.087
11843	-112236.251	-26718.722	33.298
面積	1250.9418410		
地積	1250.94 m ²		

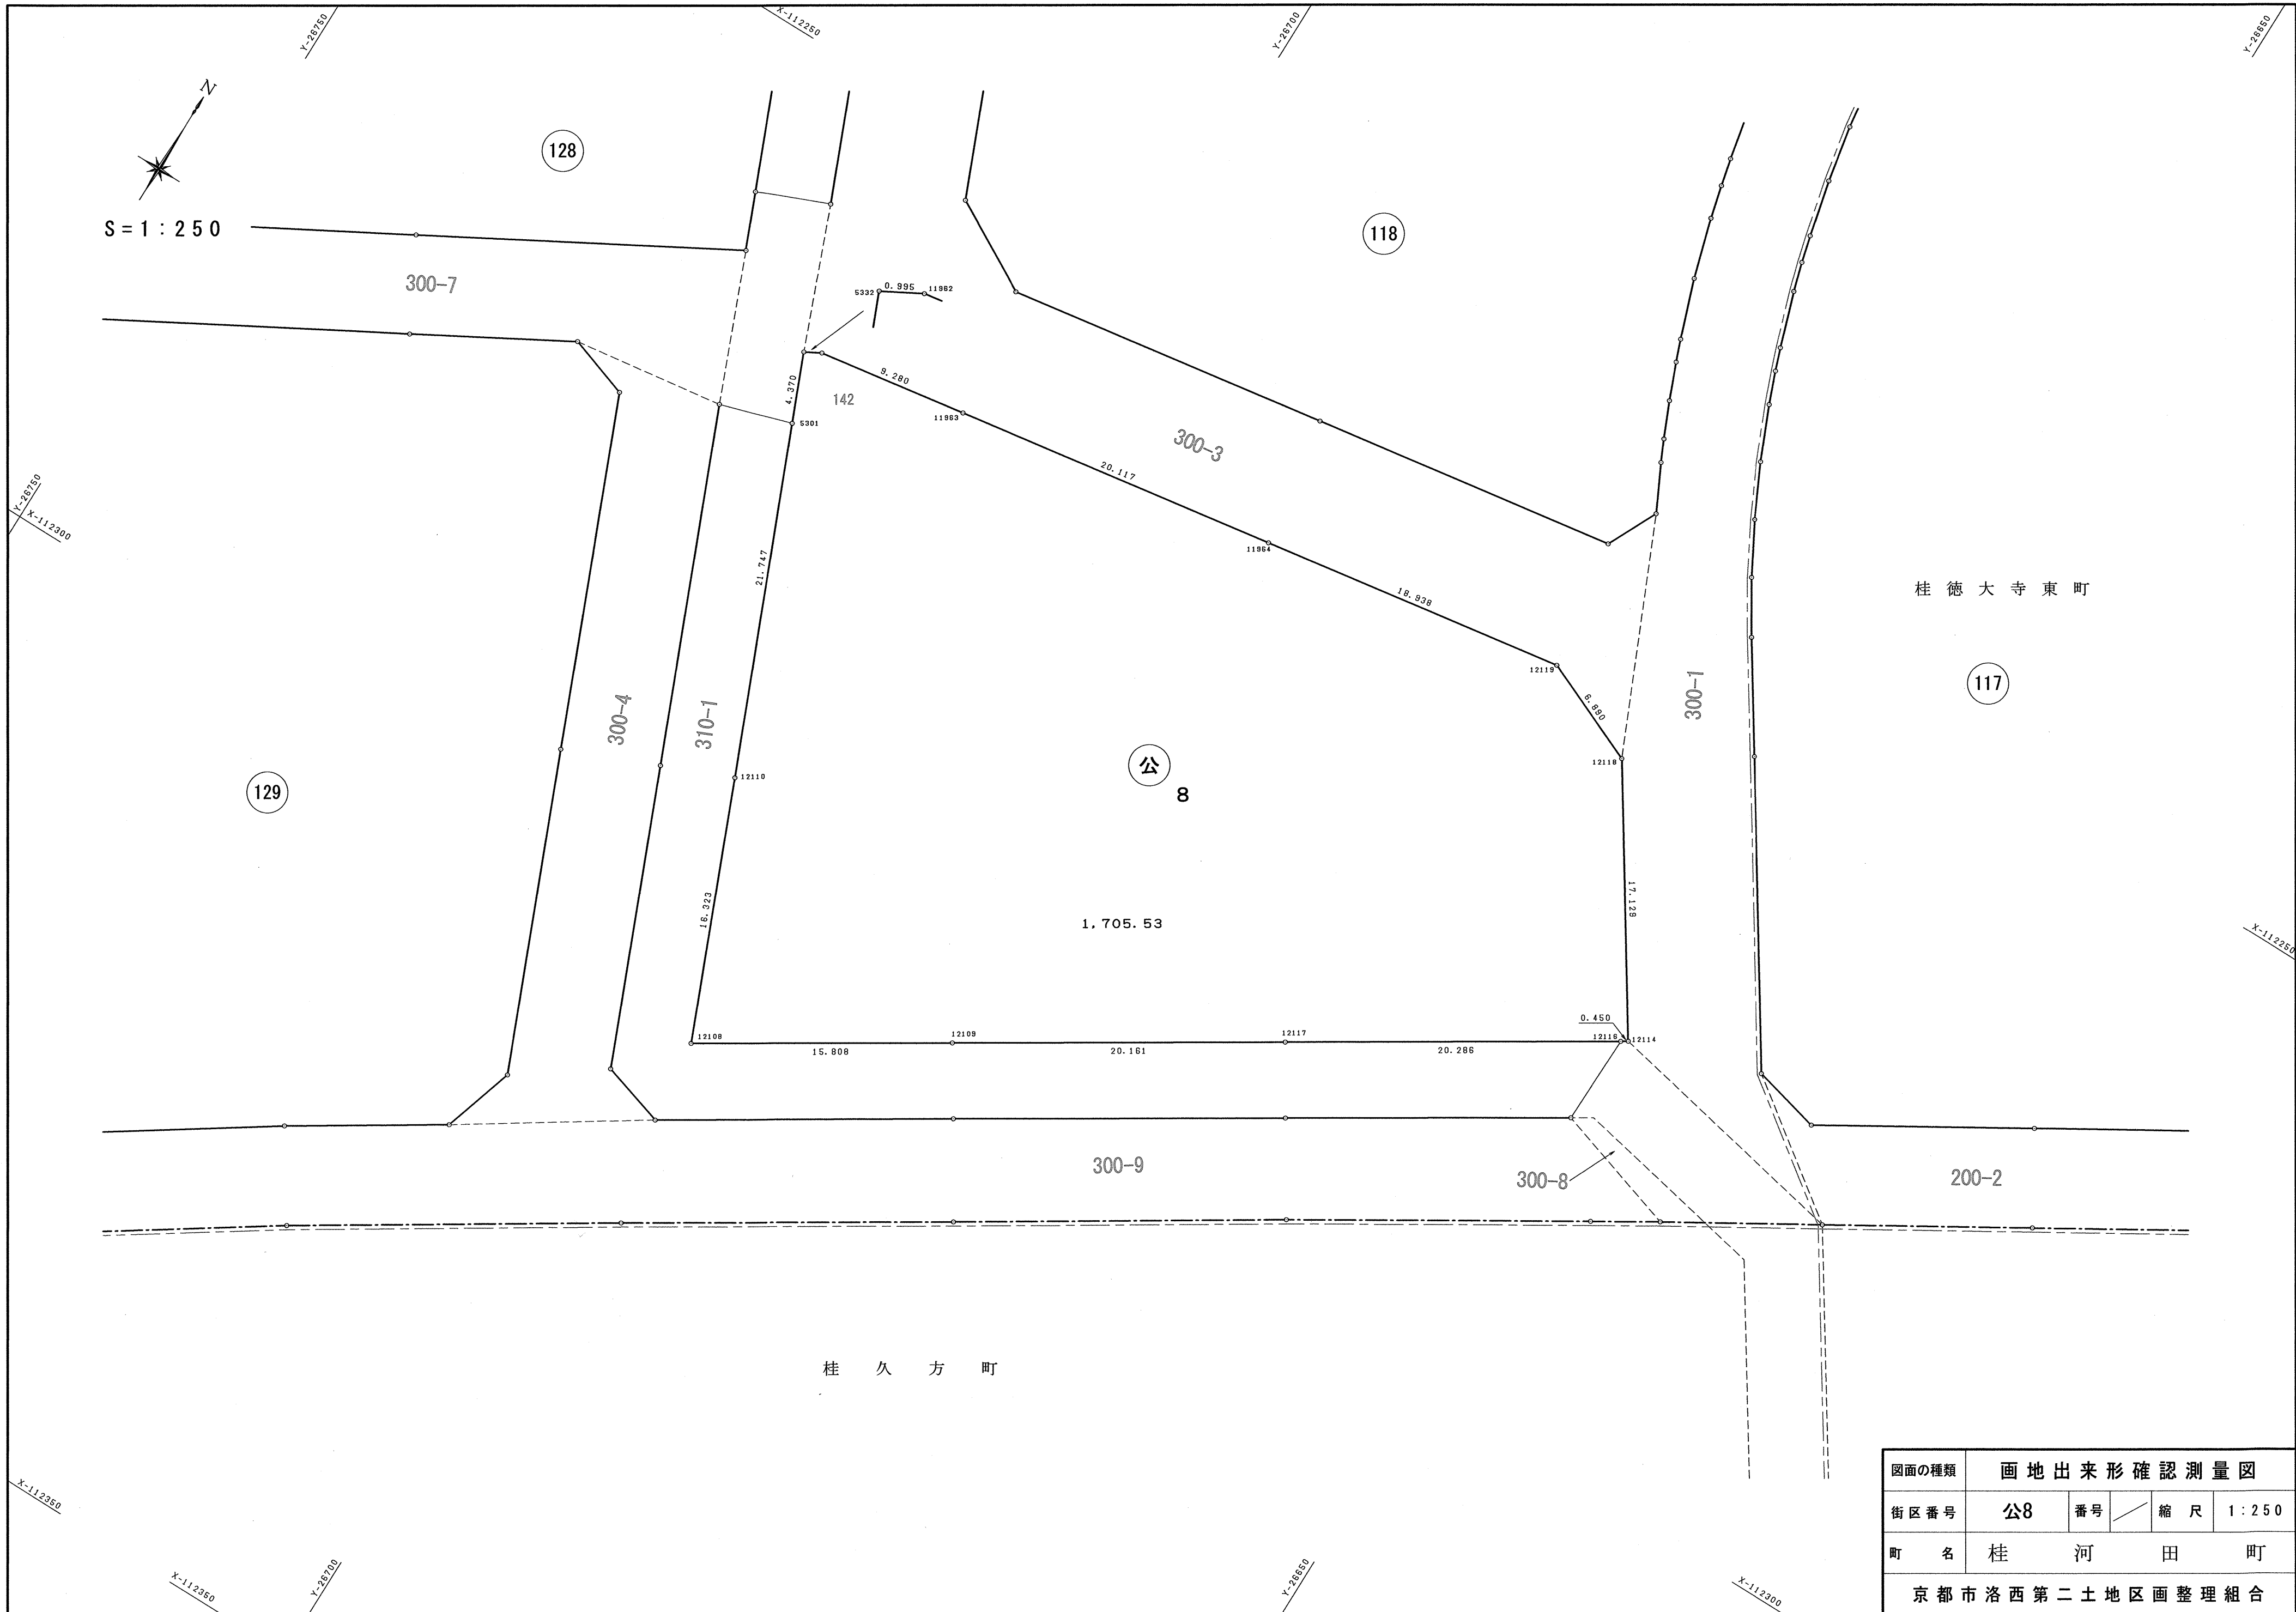

図面の種類	画 地 出 来 形 確 認 測 量 図				
街 区 番 号	公8	番 号	／	縮 尺	1 : 2 5 0
町 名	桂 河 田 町				
京 都 市 洛 西 第 二 土 地 区 画 整 理 組 合					


地 番	公園8		
N O	X	Y	辺 長
5332	-112266.384	-26714.902	
5301	-112270.429	-26713.247	4.370
12110	-112290.514	-26704.909	21.747
12108	-112305.584	-26698.637	16.323
12109	-112297.214	-26685.227	15.808
12117	-112286.530	-26668.130	20.161
12116	-112275.769	-26650.934	20.286
12114	-112275.523	-26650.557	0.450
12118	-112261.191	-26659.938	17.129
12119	-112258.474	-26666.270	6.890
11964	-112261.394	-26684.982	18.938
11963	-112264.476	-26704.862	20.117
11962	-112265.902	-26714.032	9.280
5332	-112266.384	-26714.902	0.995
面積	1705.5322155		
地 積	1705.53 m ²		

図面の種類	画 地 面 積 求 積 表			
街区番号	公8	番号	縮 尺	
町 名	桂 河 田 町			
京 都 市 洛 西 第 二 土 地 区 画 整 理 組 合				

S = 1 : 250

桂 畑 ケ 田 町

300-9

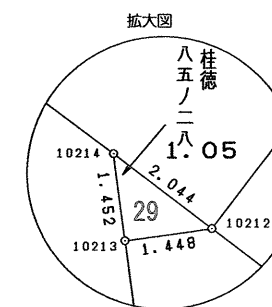

400-2

857.19

879.20

163.58

75.19

344.17

261.60

268.54

588.69

680.84

210-1

200-8

357.08


107.07

112.98

121 A

図面の種類	画地出来形確認測量図				
街区番号	119 _{1/2}	番号	縮尺	1 : 2 5 0	
町名	桂 徳 大 寺 北 町				
京都市洛西第二土地区画整理組合					

S = 1 : 250

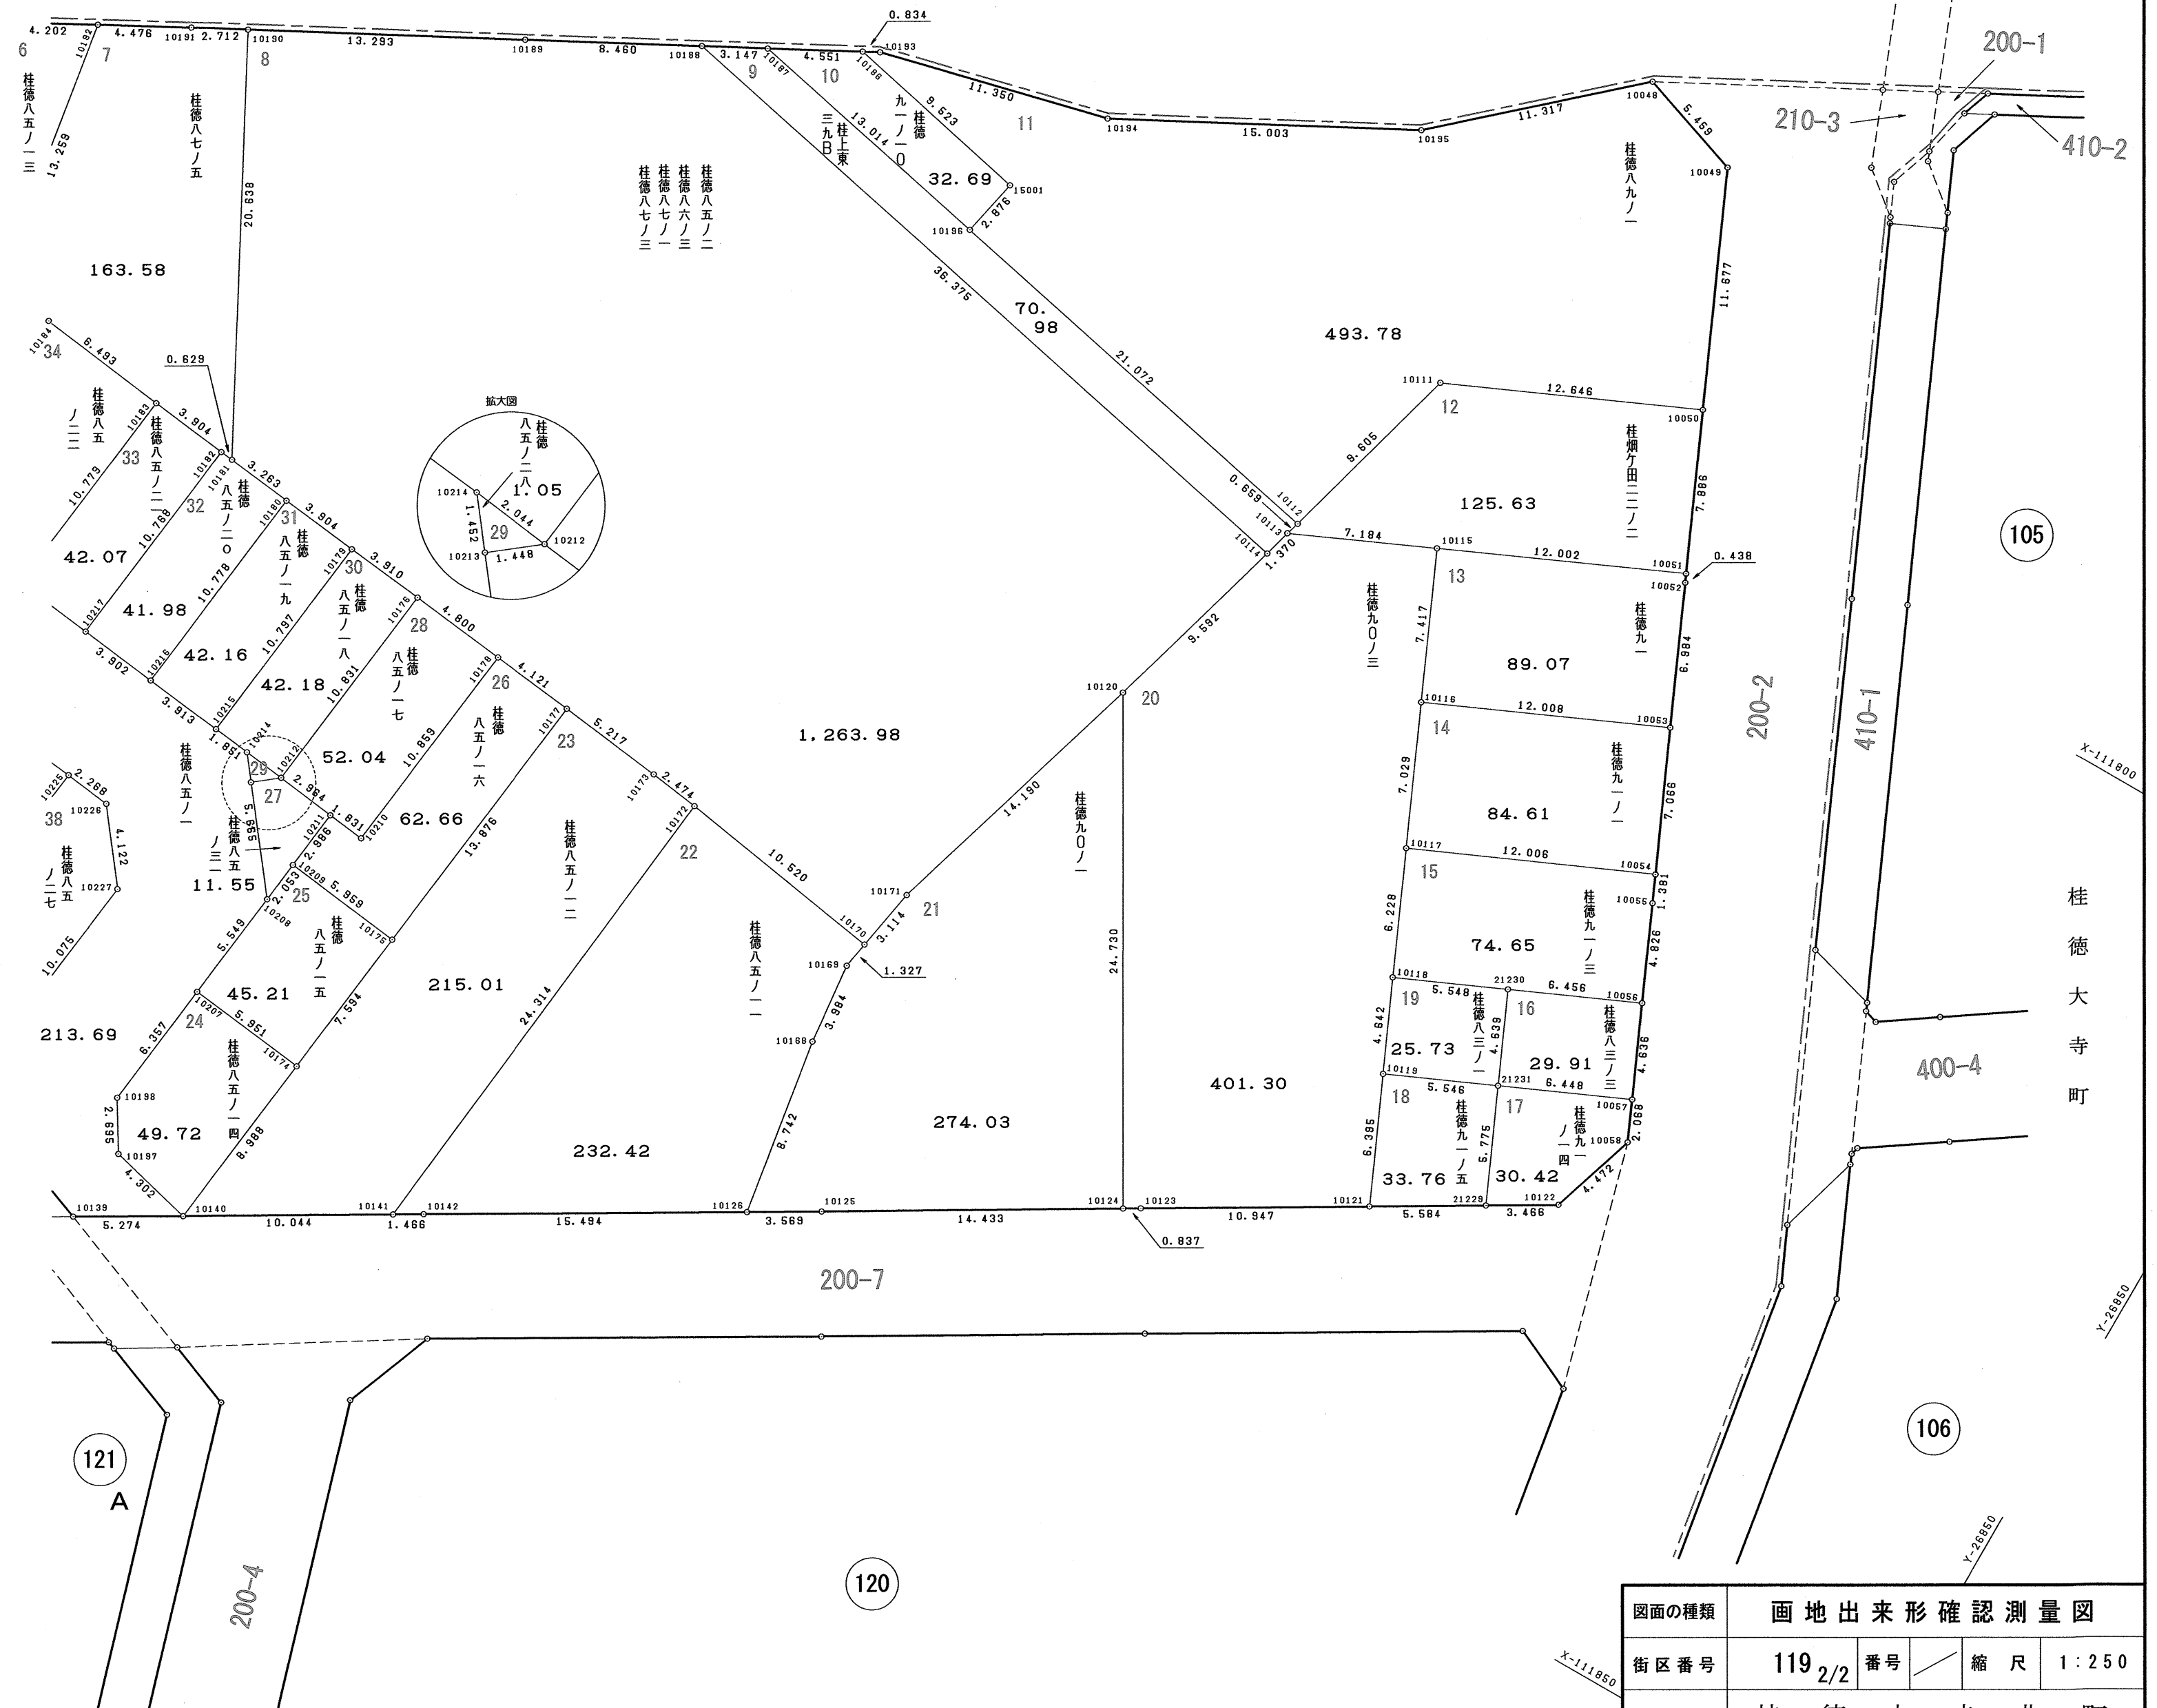

図面の種類	画地出来形確認測量図				
街区番号	119 2/2	番号	縮尺	1:250	
町名	桂徳大寺北町				
京都市洛西第二土地区画整理組合					

1

地番	上東ノ口七ーノー		
N O	X	Y	辺 長
10274	-111860.256	-27036.887	
10273	-111869.516	-27040.386	9.899
10272	-111876.342	-27027.268	14.788
10278	-111871.142	-27009.553	18.462
10253	-111869.030	-27002.295	7.559
10252	-111867.877	-26996.721	5.692
10276	-111841.363	-27004.141	27.533
10277	-111850.761	-27020.436	18.811
10274	-111860.256	-27036.887	18.994
面積	857.1990115		
地積	857.19 m ²		

2

地番	桂徳八六ノー〇 上東ノ口七ーノ三, 上東ノ口七五ノ四		
N O	X	Y	辺 長
10276	-111841.363	-27004.141	
10252	-111867.877	-26996.721	27.533
10251	-111866.845	-26991.092	5.723
10250	-111866.538	-26988.814	2.299
10249	-111865.832	-26983.803	5.060
10248	-111865.798	-26983.175	0.629
10247	-111865.422	-26977.010	6.176
10246	-111865.033	-26970.173	6.848
21176	-111829.172	-26979.730	37.113
21177	-111831.352	-26983.083	3.999
21175	-111828.240	-26983.913	3.221
10237	-111831.876	-26989.505	6.670
10275	-111841.142	-27003.757	16.999
10276	-111841.363	-27004.141	0.443
面積	879.2003060		
地積	879.20 m ²		

3

地番	桂徳八五ノー〇, 桂徳一一四ノ二		
N O	X	Y	辺 長
10236	-111826.060	-26980.559	
21175	-111828.240	-26983.913	4.000
21177	-111831.352	-26983.083	3.221
21176	-111829.172	-26979.730	3.999
10236	-111826.060	-26980.559	3.221
面積	12.2444020		
地積	12.24 m ²		

4-1

地番	桂徳八五ノ三		
N O	X	Y	辺 長
10236	-111826.060	-26980.559	
21176	-111829.172	-26979.730	3.221
10246	-111865.033	-26970.173	37.113
21178	-111861.021	-26968.213	4.465
21277	-111829.013	-26976.743	33.125
21278	-111829.852	-26978.034	1.540
21276	-111825.221	-26979.268	4.793
10236	-111826.060	-26980.559	1.540
面積	107.5108825		
地積	107.51 m ²		

4-2

地番	桂徳一一四ノー		
N O	X	Y	辺 長
21276	-111825.221	-26979.268	
21278	-111829.852	-26978.034	4.793
21277	-111829.013	-26976.743	1.540
21179	-111824.382	-26977.977	4.793
21276	-111825.221	-26979.268	1.540
面積	7.0139470		
地積	7.01 m ²		

5-1

地番	桂徳八六ノ二		
N O	X	Y	辺 長
21178	-111861.021	-26968.213	
10245	-111856.475	-26965.992	5.060
21279	-111821.364	-26973.070	35.817
10235	-111822.158	-26974.557	1.686
21179	-111824.382	-26977.977	4.080
21277	-111829.013	-26976.743	4.793
21178	-111861.021	-26968.213	33.125
面積	160.0048050		
地積	160.00 m ²		

5-2

地番	上東ノ口七五ノー		
N O	X	Y	辺 長
21279	-111821.364	-26973.070	
10245	-111856.475	-26965.992	35.817
10244	-111857.057	-26963.555	2.506
10229	-111845.746	-26963.935	11.317
10230	-111843.787	-26964.243	1.983
10231	-111834.204	-26965.875	9.721
21281	-111829.344	-26966.686	4.927
21282	-111830.576	-26968.996	2.618
21280	-111820.129	-26970.759	10.595
21279	-111821.364	-26973.070	2.620
面積	129.2317220		
地積	129.23 m ²		

5-3

地番	上東ノ口七ーノ四		
N O	X	Y	辺 長
21280	-111820.129	-26970.759	
21282	-111830.576	-26968.996	10.595
21281	-111829.344	-26966.686	2.618
10232	-111827.602	-26966.977	1.766
10234	-111818.894	-26968.447	8.831
21280	-111820.129	-26970.759	2.621
面積	26.3332665		
地積	26.33 m ²		

6

地番	桂徳八五ノー三		
N O	X	Y	辺 長
10231	-111834.204	-26965.875	
10233	-111834.693	-26960.282	5.614
10184	-111830.403	-26959.701	4.329
10185	-111830.009	-26962.669	2.994
10192	-111816.913	-26964.741	13.259
10234	-111818.894	-26968.447	4.202
10232	-111827.602	-26966.977	8.831
21281	-111829.344	-26966.686	1.766
10231	-111834.204	-26965.875	4.927
面積	75.1967945		
地積	75.19 m ²		

7

地番	桂徳八七ノ五		
N O	X	Y	辺 長
10192	-111816.913	-26964.741	
10185	-111830.009	-26962.669	13.259
10184	-111830.403	-26959.701	2.994
10183	-111831.236	-26953.262	6.493
10182	-111831.723	-26948.388	3.904
10181	-111831.796	-26948.763	0.629
10190	-111813.542	-26958.393	20.638
10191	-111814.804	-26960.793	2.712
10192	-111816.913	-26964.741	4.476
面積	163.5836030		
地積	163.58 m ²		

8

地番	桂徳八五ノ二、八六ノ三 八七ノ一、八七ノ三		
N O	X	Y	辺 長
10190	-111813.542	-26958.393	
10181	-111831.796	-26948.763	20.638
10180	-111832.189	-26945.524	3.263
10179	-111832.642	-26941.646	3.904
10176	-111833.085	-26937.761	3.910
10178	-111833.648	-26932.994	4.800
10177	-111834.131	-26928.901	4.121
10173	-111834.782	-26923.725	5.217
10172	-111835.127	-26921.275	2.474
10170	-111836.824	-26910.893	10.520
10171	-111833.761	-26910.333	3.114
10120	-111820.183	-26906.211	14.190
10114	-111810.962	-26903.568	9.592
10188	-111803.401	-26939.149	36.375
10189	-111807.355	-26946.628	8.460
10190	-111813.542	-26958.393	13.293
面積	1263.9859085		
地積	1263.98 m ²		

9

地番	桂上東三九B		
N O	X	Y	辺 長
10114	-111810.962	-26903.568	
10113	-111809.639	-26903.211	1.370
10112	-111809.007	-26903.024	0.659
10196	-111804.644	-26923.639	21.072
10187	-111801.930	-26936.367	13.014
10188	-111803.401	-26939.149	3.147
10114	-111810.962	-26903.568	36.375
面積	70.9855915		
地積	70.98 m ²		

10

地番	桂徳九一ノー〇		
N O	X	Y	辺 長
10186	-111799.803	-26932.344	
10187	-111801.930	-26936.367	4.551
10196	-111804.644	-26923.639	13.014
15001	-111801.831	-26923.039	2.876
10186	-111799.803	-26932.344	9.523
面積	32.6913215		
地積	32.69 m ²		

11

地番	桂徳八九ノー		
N O	X	Y	辺 長
10112	-111809.007	-26903.024	
10111	-111799.744	-26900.483	9.605
10050	-111794.589	-26888.935	12.646
10049	-111783.935	-26893.715	11.677
10048	-111782.168	-26898.880	5.459
10195	-111789.712	-26907.316	11.317
10194	-111796.724	-26920.580	15.003
10193	-111799.413	-26931.607	11.350
10186	-111799.803	-26932.344	0.834
15001	-111801.831	-26923.039	9.523
10196	-111804.644	-26923.639	2.876
10112	-111809.007	-26903.024	21.072
面積	493.7850600		
地積	493.78 m ²		

12

地番	桂畑ヶ田二二ノ二		
N O	X	Y	辺 長
10112	-111809.007	-26903.024	
10113	-111809.639	-26903.211	0.659
10115	-111806.693	-26896.659	7.184
10051	-111801.784	-26885.707	12.002
10050	-111794.589	-26888.935	7.886
10111	-111799.744	-26900.483	12.646
10112	-111809.007	-26903.024	9.605
面積	125.6373735		
地積	125.63 m ²		

13

地番	桂徳九一		
N O	X	Y	辺 長
10116	-111813.464	-26893.631	
10053	-111808.557	-26882.671	12.008
10052	-111802.184	-26885.528	6.984
10051	-111801.784	-26885.707	0.438
10115	-111806.693	-26896.659	12.002
10116	-111813.464	-26893.631	7.417
面積	89.0740715		
地積	89.07 m ²		

14

地番	桂徳九一ノー		
N O	X	Y	辺 長
10117	-111819.877	-26890.754	
10054	-111815.005	-26879.781	12.006
10053	-111808.557	-26882.671	7.066
10116	-111813.464	-26893.631	12.008
10117	-111819.877	-26890.754	7.029
面積	84.6189515		
地積	84.61 m ²		

15

地番	桂徳九一ノ三		
N O	X	Y	辺 長
10118	-111825.563	-26888.212	
21230	-111823.303	-26883.145	5.548
10056	-111820.672	-26877.249	6.456
10055	-111816.265	-26879.216	4.826
10054	-111815.005	-26879.781	1.381
10117	-111819.877	-26890.754	12.006
10118	-111825.563	-26888.212	6.228
面積	74.6531435		
地積	74.65 m ²		

16

地番	桂徳八三ノ三
----	--------

23

地 番				桂徳八五ノ一二	
N O	X	Y	辺 長		
10177	-111834.131	-26928.901			
10175	-111847.899	-26930.625	13.876		
10174	-111855.434	-26931.568	7.594		
10140	-111864.352	-26932.687	8.988		
10141	-111859.286	-26924.014	10.044		
10172	-111835.127	-26921.275	24.314		
10173	-111834.782	-26923.725	2.474		
10177	-111834.131	-26928.901	5.217		
面積			215.0177850		
地積			215.01 m ²		

24

地 番				桂徳八五ノ一四	
N O		X		Y	
10207		-111854.708		-26937.475	
10198		-111861.017		-26938.258	
10197		-111863.324		-26936.864	
10140		-111864.352		-26932.687	
10174		-111855.434		-26931.568	
10207		-111854.708		-26937.475	
面積				49.7265355	
地積				49.72 m ²	

25

地番	桂徳八五ノ一五		
N O	X	Y	辺 長
10209	-111847.164	-26936.538	
10208	-111849.202	-26936.783	2.053
10207	-111854.708	-26937.475	5.549
10174	-111855.434	-26931.568	5.951
10175	-111847.899	-26930.625	7.594
10209	-111847.164	-26936.538	5.959
面積	45.2144520		
地積	45.21 m ²		

26

地 番				桂徳八五ノ一六	
N O	X	Y	辺 長		
10178	-111833.648	-26932.994			
10210	-111844.422	-26934.351	10.859		
10211	-111844.201	-26936.169	1.831		
10209	-111847.164	-26936.538	2.986		
10175	-111847.899	-26930.625	5.959		
10177	-111834.131	-26928.901	13.876		
10178	-111833.648	-26932.994	4.121		
面積			62.6682515		
地積			62.66 m ²		

27

地番	桂徳八五ノ三一		
N O	X	Y	辺 長
10213	-111844.723	-26940.252	
10208	-111849.202	-26936.783	5.665
10209	-111847.164	-26936.538	2.053
10211	-111844.201	-26936.169	2.986
10212	-111843.832	-26939.110	2.964
10213	-111844.723	-26940.252	1.448
面積	11.5571585		
地積	11.55 m ²		

28

地 番				桂徳八五ノ一七			
N O		X		Y		辺 長	
10176		-111833.085		-26937.761			
10212		-111843.832		-26939.110		10.831	
10211		-111844.201		-26936.169		2.964	
10210		-111844.422		-26934.351		1.831	
10178		-111833.648		-26932.994		10.859	
10176		-111833.085		-26937.761		4.800	
面積		52.0427065					
地積		52.04 m ²					

29			
地番	桂徳八五ノ二八		
N O	X	Y	辺長
10214	-111843.573	-26941.138	
10213	-111844.723	-26940.252	1.452
10212	-111843.832	-26939.110	1.448
10214	-111843.573	-26941.138	2.044
面積	1.0513630		
地積	1.05 m ²		

30

地番	桂徳八五ノ一八		
N O	X	Y	辺 長
10179	-111832.642	-26941.646	
10215	-111843.357	-26942.976	10.797
10214	-111843.573	-26941.138	1.851
10212	-111843.832	-26939.110	2.044
10176	-111833.085	-26937.761	10.831
10179	-111832.642	-26941.646	3.910
面積	42.1838240		
地積	42.18 m ²		

31

地 番				桂徳八五ノ一九			
N O		X		Y		辺 長	
10180		-111832.189		-26945.524			
10216		-111842.884		-26946.860		10.778	
10215		-111843.357		-26942.976		3.913	
10179		-111832.642		-26941.646		10.797	
10180		-111832.189		-26945.524		3.904	
面積				42.1632840			
地積				42.16 m ²			

32

地 番				桂徳八五ノ二〇			
N O		X		Y		辺 長	
10182		-111831.723		-26949.388			
10217		-111842.407		-26950.733		10.768	
10216		-111842.884		-26946.860		3.902	
10180		-111832.189		-26945.524		10.778	
10181		-111831.796		-26948.763		3.263	
10182		-111831.723		-26949.388		0.629	
面 積				41.9889655			
地 積				41.98 m ²			

33

地番	桂徳八五ノ二一		
N O	X	Y	辺 長
10183	-111831.236	-26953.262	10.779
10218	-111841.930	-26954.610	
10217	-111842.407	-26950.733	3.906
10182	-111831.723	-26949.388	10.768
10183	-111831.236	-26953.262	3.904
面積	42.0742325		
地積	42.07 m ²		

34

地 番				桂徳八五ノ二二	
N O		X		Y	辺 長
10219		-111841.393		-26959.120	
10218		-111841.930		-26954.610	4.542
10183		-111831.236		-26953.262	10.779
10184		-111830.403		-26959.701	6.493
10233		-111834.693		-26960.282	4.329
10219		-111841.393		-26959.120	6.800
面積		64.0560665			
地 積		64.05 m ²			

35			
地 番	桂徳八五ノ一		
N O	X	Y	辺 長
10223	-111847.894	-26955.321	
10224	-111848.197	-26952.845	2.494
10225	-111848.789	-26947.996	4.885
10226	-111849.070	-26945.745	2.268
10227	-111852.342	-26943.238	4.122
10228	-111862.338	-26944.497	10.075
10200	-111866.190	-26942.143	4.514
10201	-111867.400	-26942.615	1.299
10199	-111865.919	-26940.094	2.924
10139	-111867.012	-26937.241	3.055

10140	-111864.352	-26932.687	5.274
10197	-111863.324	-26936.864	4.302
10198	-111861.017	-26938.258	2.695
10207	-111854.708	-26937.475	6.357
10208	-111849.202	-26936.783	5.549
10213	-111844.723	-26940.252	5.665
10214	-111843.573	-26941.138	1.452
10215	-111843.357	-26942.976	1.851
10216	-111842.884	-26946.860	3.913
10217	-111842.407	-26950.733	3.902
10218	-111841.930	-26954.610	3.906
10221	-111845.406	-26955.033	3.502
10223	-111847.894	-26955.321	2.505
面積	213.6985185		
地積	213.69 m ²		

36			
地 番	桂徳八五ノ二九		
N O	X	Y	辺 長
10222	-111847.588	-26957.867	
10223	-111847.894	-26955.321	2.564
10221	-111845.406	-26955.033	2.505
10218	-111841.930	-26954.610	3.502
10219	-111841.393	-26959.120	4.542
10220	-111844.504	-26958.495	3.173
10222	-111847.588	-26957.867	3.147
面積	21.3216855		
地積	21.32 m ²		