

京都都市計画（京都国際文化観光都市建設計画）
 都市建設事業洛西第二地区土地区画整理事業

画地出来形確認測量図

4 / 5

洛西第二土地区画整理事業画地出来形測量図


90街区～119街区
 平成17年9月2日現在

洛西第二土地区画整理組合
 第一測量設計株式会社

嵐山	嵐山宮ノ前町	1			
桂	桂池尻町			5	
	桂上野今井町	2			
	桂上野北町		3		
	桂上野中町		3		
	桂上野西町	2			
	桂上野東町		3	4	
	桂上野南町		3		
	桂河田町		4	5	
	桂清水町			5	
	桂徳大寺町		4		
	桂徳大寺北町		4	5	
	桂徳大寺東町		4		
	桂徳大寺南町			5	
	桂畑ヶ田町		4		
	桂久方町			5	
	上桂	上桂今井町	2		
		上桂北ノ口町	2	3	
上桂北村町			3		
上桂東ノ口町				5	
上桂前川町		2			
松室	松室吾田神町	1	2		
	松室荒堀町	1			
	松室河原町	1			
	松室北河原町	1			
	松室中溝町	1			
	松尾東ノ口町		2		



S = 1 : 250

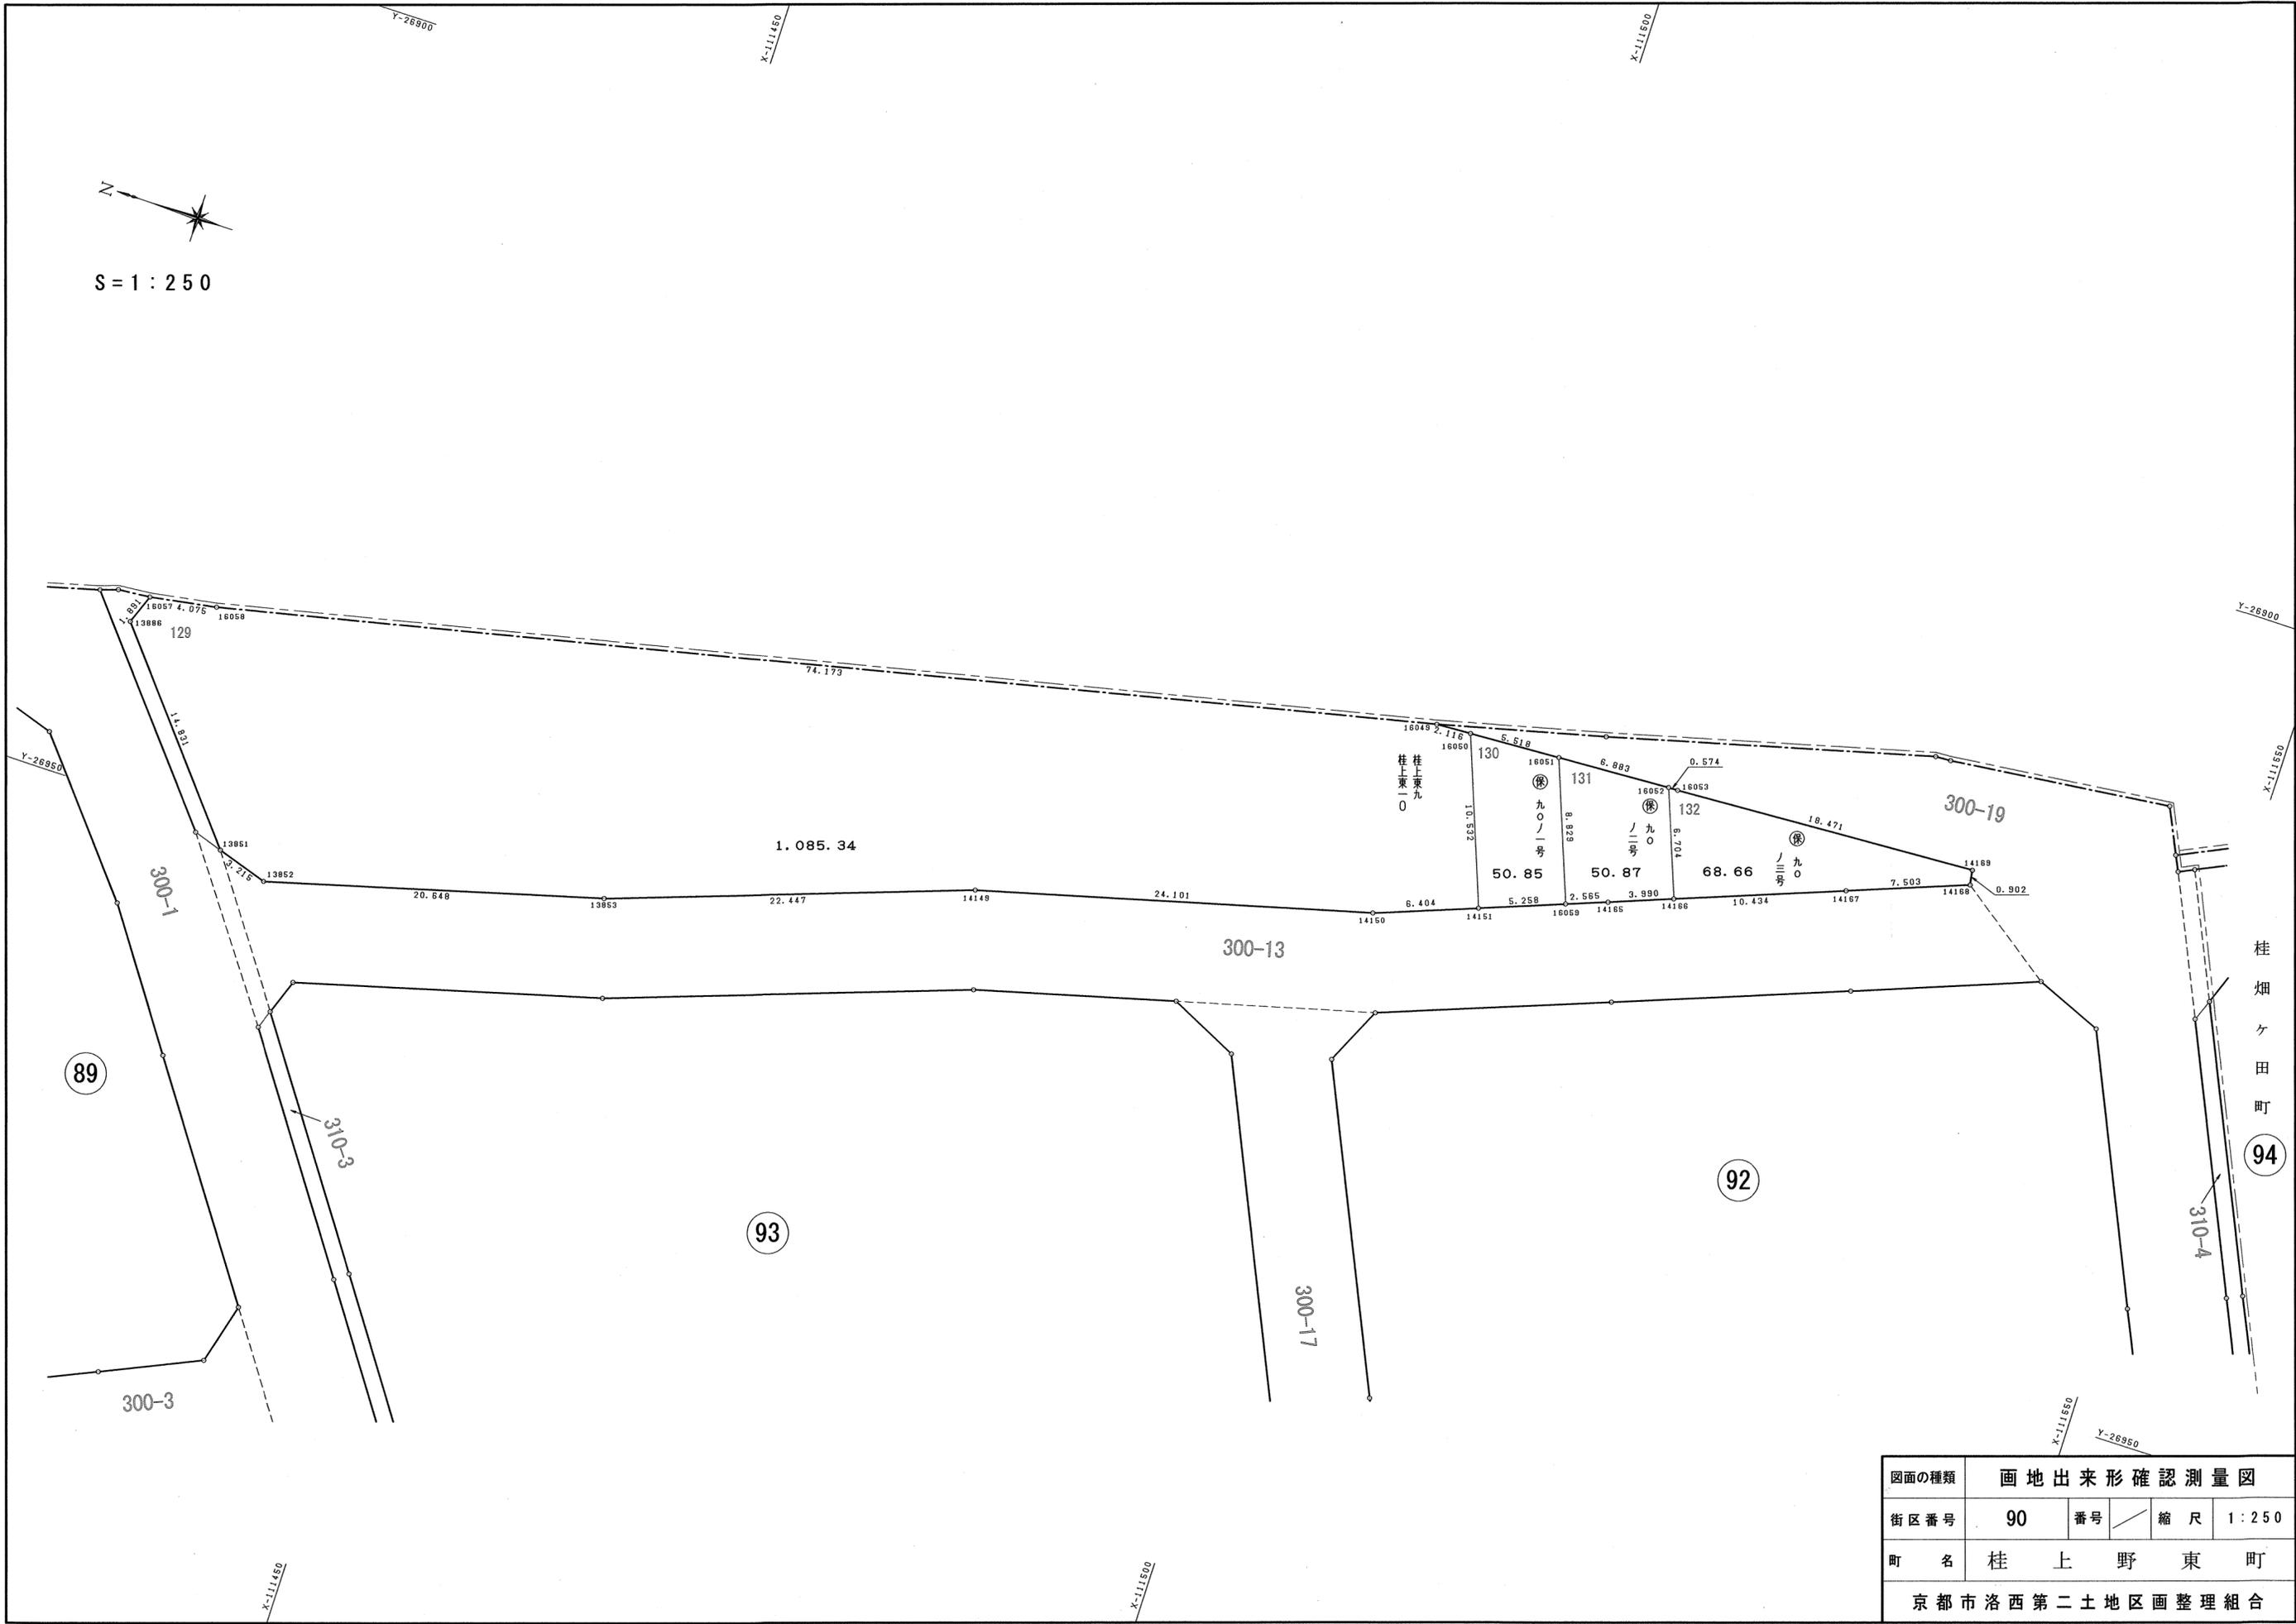

図面の種類	画地出来形確認測量図		
街区番号	90	番号	縮尺 1:250
町名	桂上野東町		
京都市洛西第二土地区画整理組合			

129

地番 桂上東九、一〇			
N O	X	Y	辺長
13851	-111432.936	-26951.384	
13852	-111435.997	-26952.366	3.215
13853	-111455.927	-26946.967	20.648
14149	-111477.124	-26939.580	22.447
14150	-111500.441	-26933.484	24.101
14151	-111506.433	-26931.225	6.404
16050	-111502.724	-26921.368	10.532
16049	-111500.610	-26921.467	2.116
16058	-111428.195	-26937.522	74.173
16057	-111424.174	-26938.183	4.075
13886	-111423.494	-26939.947	1.891
13851	-111432.936	-26951.384	14.831
面積	1085.3459250		
地積	1085.34 m ²		

130

地番 保 九〇ノ一号			
N O	X	Y	辺長
14151	-111506.433	-26931.225	
16059	-111511.353	-26929.370	5.258
16051	-111508.236	-26921.109	8.829
16050	-111502.724	-26921.368	5.518
14151	-111506.433	-26931.225	10.532
面積	50.8592850		
地積	50.85 m ²		

131


地番 保 九〇ノ二号			
N O	X	Y	辺長
16059	-111511.353	-26929.370	
14165	-111513.753	-26928.465	2.565
14166	-111517.486	-26927.056	3.990
16052	-111515.111	-26920.787	6.704
16051	-111508.236	-26921.109	6.883
16059	-111511.353	-26929.370	8.829
面積	50.8724055		
地積	50.87 m ²		

132

地番 保 九〇ノ三号			
N O	X	Y	辺長
16052	-111515.111	-26920.787	
14166	-111517.486	-26927.056	6.704
14167	-111527.248	-26923.372	10.434
14168	-111534.267	-26920.720	7.503
14169	-111534.131	-26919.828	0.902
16053	-111515.684	-26920.760	18.471
16052	-111515.111	-26920.787	0.574
面積	68.6696070		
地積	68.66 m ²		


図面の種類	画地面積求積表			
街区番号	90	番号	縮尺	
町名	桂上野東町			
京都市洛西第二土地区画整理組合				

N
S = 1 : 250

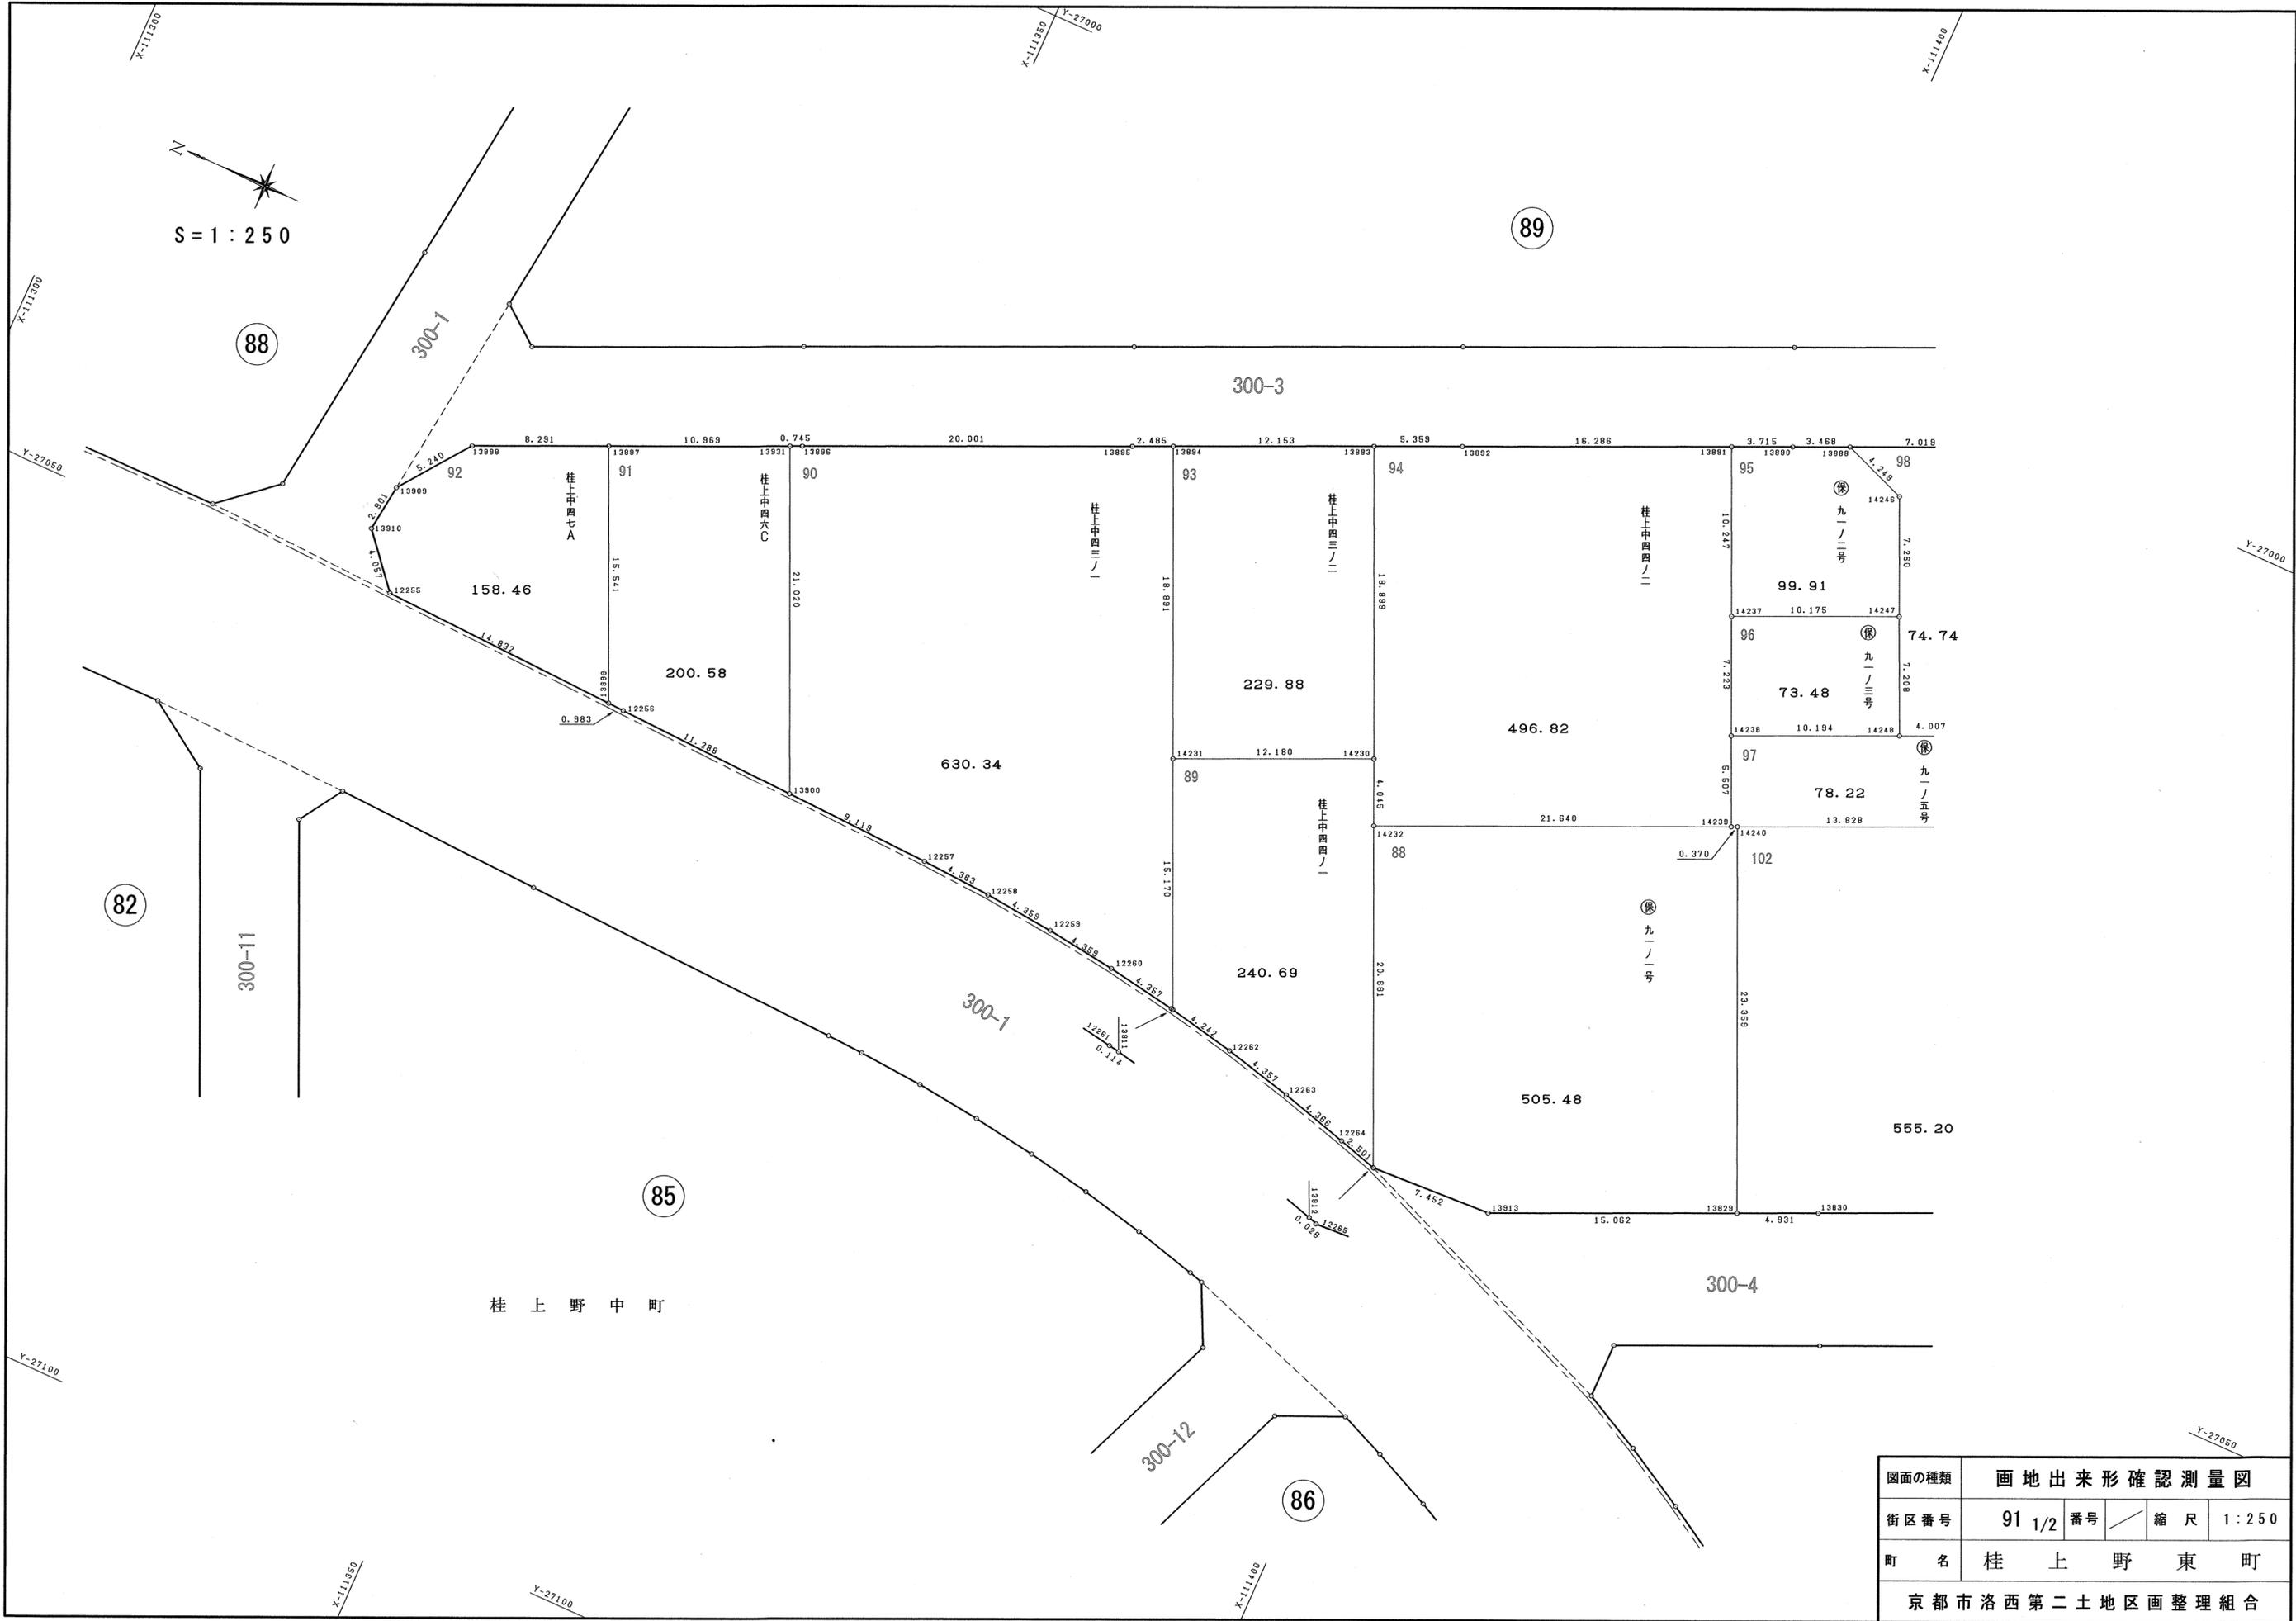


桂上野中町

図面の種類	画地出来形確認測量図			
街区番号	91 1/2	番号	縮尺	1 : 250
町名	桂上野東町			
京都市洛西第二土地区画整理組合				

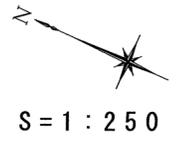

S = 1 : 250

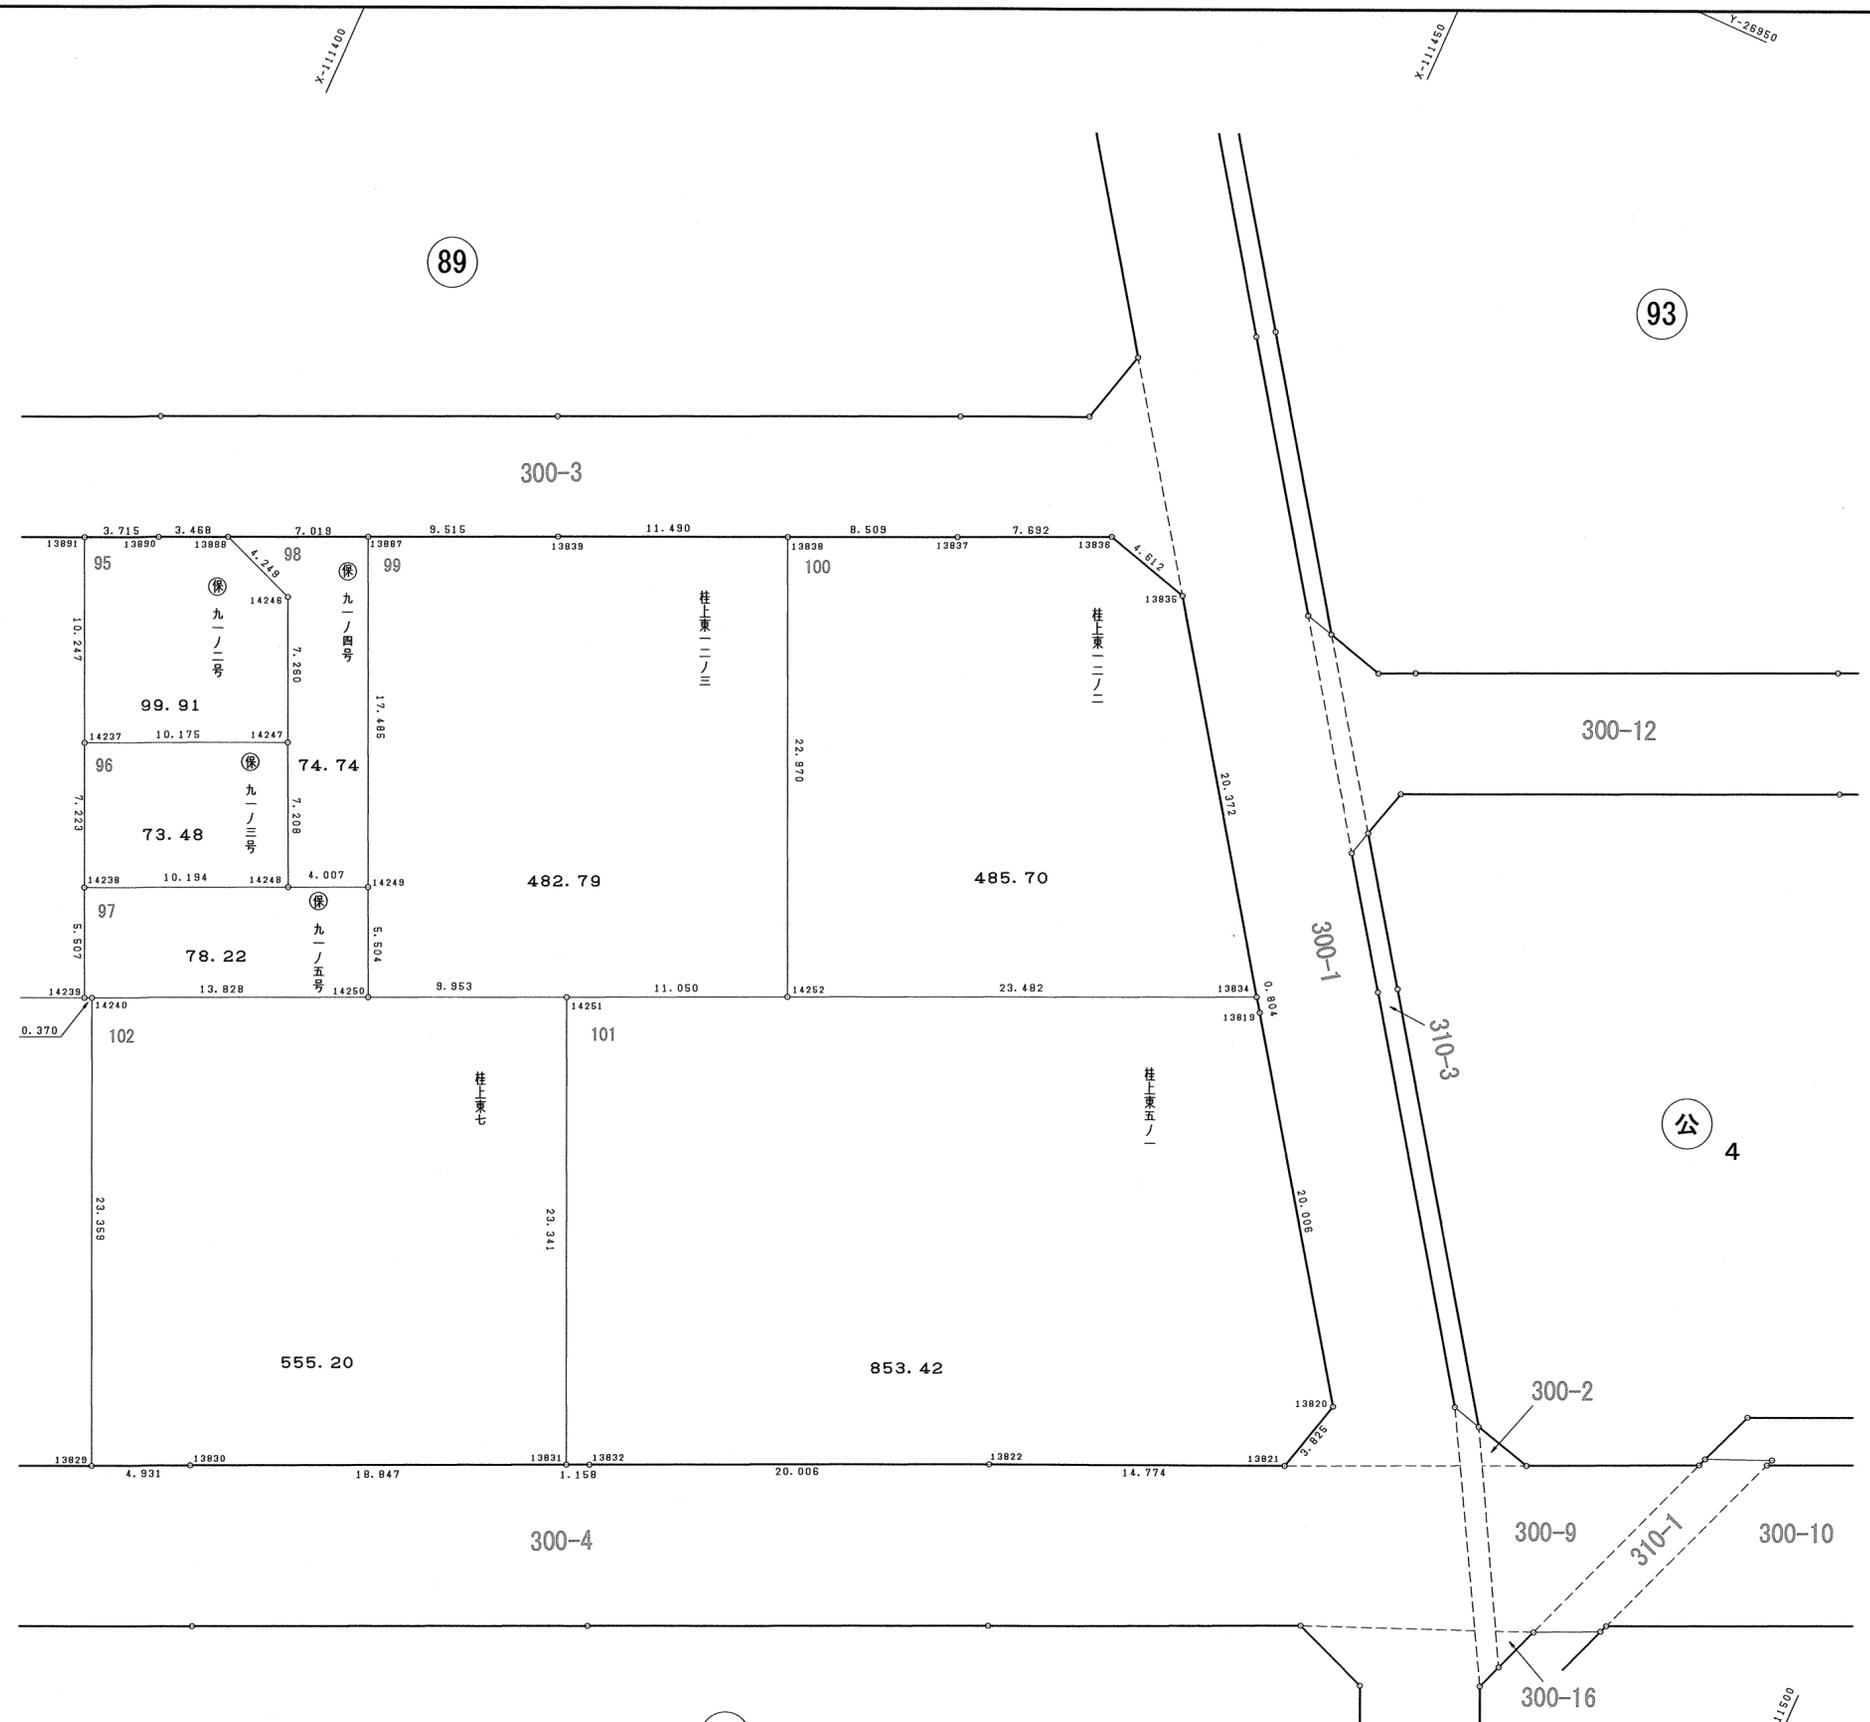

図面の種類	画地出来形確認測量図			
街区番号	91 2/2	番号	縮尺	1 : 250
町名	桂上野東町			
京都市洛西第二土地区画整理組合				

88

地番 保九一ノ一			
NO	X	Y	辺長
14232	-111387.671	-27036.770	
13912	-111396.107	-27055.652	20.681
12265	-111396.132	-27055.659	0.026
13913	-111403.575	-27055.296	7.452
13829	-111417.314	-27049.123	15.062
14240	-111407.771	-27027.802	23.359
14239	-111407.432	-27027.950	0.370
14232	-111387.671	-27036.770	21.640
面積	505.4891750		
地積	505.48 m ²		

89

地番 桂上中四四ノ一			
NO	X	Y	辺長
14231	-111374.905	-27038.049	
13911	-111381.112	-27051.891	15.170
12262	-111385.267	-27052.745	4.242
12263	-111389.497	-27053.788	4.357
12264	-111393.704	-27054.957	4.366
13912	-111396.107	-27055.652	2.501
14232	-111387.671	-27036.770	20.681
14230	-111386.023	-27033.076	4.045
14231	-111374.905	-27038.049	12.180
面積	240.6962210		
地積	240.69 m ²		

90

地番 桂上中四三ノ一			
NO	X	Y	辺長
13931	-111345.981	-27030.297	
13900	-111354.579	-27049.478	21.020
12257	-111363.690	-27049.864	9.119
12258	-111368.045	-27050.136	4.363
12259	-111372.383	-27050.563	4.359
12260	-111376.704	-27051.141	4.359
12261	-111381.000	-27051.868	4.357
13911	-111381.112	-27051.891	0.114
14231	-111374.905	-27038.049	15.170
13894	-111367.185	-27020.807	18.891
13895	-111364.917	-27021.823	2.485
13896	-111346.661	-27029.993	20.001
13931	-111345.981	-27030.297	0.745
面積	630.3462470		
地積	630.34 m ²		

91

地番 桂上中四六C			
NO	X	Y	辺長
13897	-111335.968	-27034.775	
13899	-111342.319	-27048.959	15.541
12256	-111343.301	-27049.001	0.983
13900	-111354.579	-27049.478	11.288
13931	-111345.981	-27030.297	21.020
13897	-111335.968	-27034.775	10.969
面積	200.5830650		
地積	200.58 m ²		

92

地番 桂上中四七A			
NO	X	Y	辺長
13909	-111325.249	-27042.347	
13910	-111324.880	-27045.224	2.901
12255	-111327.501	-27048.321	4.057
13899	-111342.319	-27048.959	14.832
13897	-111335.968	-27034.775	15.541
13898	-111328.399	-27038.159	8.291
13909	-111325.249	-27042.347	5.240
面積	158.4684030		
地積	158.46 m ²		

93

地番 桂上中四三ノ二			
NO	X	Y	辺長
13894	-111367.185	-27020.807	
14231	-111374.905	-27038.049	18.891
14230	-111386.023	-27033.076	12.180
13893	-111378.276	-27015.838	18.899
13894	-111367.185	-27020.807	12.153
面積	229.8848085		
地積	229.88 m ²		

94

地番 桂上中四四ノ二			
NO	X	Y	辺長
13893	-111378.276	-27015.838	
14230	-111386.023	-27033.076	18.899
14232	-111387.671	-27036.770	4.045
14239	-111407.432	-27027.950	21.640
14238	-111405.177	-27022.926	5.507
14237	-111402.225	-27016.334	7.223
13891	-111398.028	-27006.986	10.247
13892	-111383.167	-27013.647	16.286
13893	-111378.276	-27015.838	5.359
面積	496.8208990		
地積	496.82 m ²		

95

地番 保九一ノ二			
NO	X	Y	辺長
13891	-111398.028	-27006.986	
14237	-111402.225	-27016.334	10.247
14247	-111411.517	-27012.188	10.175
14246	-111408.551	-27005.561	7.260
13888	-111404.582	-27004.045	4.249
13890	-111401.418	-27005.466	3.468
13891	-111398.028	-27006.986	3.715
面積	99.9128160		
地積	99.91 m ²		

96

地番 保九一ノ三			
NO	X	Y	辺長
14237	-111402.225	-27016.334	
14238	-111405.177	-27022.926	7.223
14248	-111414.480	-27018.759	10.194
14247	-111411.517	-27012.188	7.208
14237	-111402.225	-27016.334	10.175
面積	73.4843450		
地積	73.48 m ²		

97

地番 保九一ノ五			
NO	X	Y	辺長
14238	-111405.177	-27022.926	
14239	-111407.432	-27027.950	5.507
14240	-111407.771	-27027.802	0.370
14250	-111420.390	-27022.148	13.828
14249	-111418.139	-27017.125	5.504
14248	-111414.480	-27018.759	4.007
14238	-111405.177	-27022.926	10.194
面積	78.2228620		
地積	78.22 m ²		

98

地番 保九一ノ四			
NO	X	Y	辺長
13888	-111404.582	-27004.045	
14246	-111408.551	-27005.561	4.249
14247	-111411.517	-27012.188	7.260
14248	-111414.480	-27018.759	7.208
14249	-111418.139	-27017.125	4.007
13887	-111410.985	-27001.170	17.485
13888	-111404.582	-27004.045	7.019
面積	74.7455950		
地積	74.74 m ²		

99

地番 桂上東一二ノ三			
NO	X	Y	辺長
13887	-111410.985	-27001.170	
14249	-111418.139	-27017.125	17.485
14250	-111420.390	-27022.148	5.504
14251	-111429.471	-27018.075	9.953
14252	-111439.552	-27013.551	11.050
13838	-111430.158	-26992.590	22.970
13839	-111419.665	-26997.272	11.490
13887	-111410.985	-27001.170	9.515
面積	482.7928210		
地積	482.79 m ²		

100

地番 桂上東一二ノ二			
NO	X	Y	辺長
13838	-111430.158	-26992.590	
14252	-111439.552	-27013.551	22.970
13834	-111460.978	-27003.942	23.482
13835	-111449.382	-26987.192	20.372
13836	-111444.939	-26985.956	4.612
13837	-111437.929	-26989.123	7.692
13838	-111430.158	-26992.590	8.509
面積	485.7058155		
地積	485.70 m ²		

101


地番 桂上東五ノ一			
NO	X	Y	辺長
14251	-111429.471	-27018.075	
13831	-111439.004	-27039.380	23.341
13832	-111440.060	-27038.906	1.158
13822	-111458.315	-27030.721	20.006
13821	-111471.824	-27024.740	14.774
13820	-111472.828	-27021.049	3.825
13819	-111461.436	-27004.603	20.006
13834	-111460.978	-27003.942	0.804
14252	-111439.552	-27013.551	23.482
14251	-111429.471	-27018.075	11.050
面積	853.4281515		
地積	853.42 m ²		

102

地番 桂上東七			
NO	X	Y	辺長
14240	-111407.771	-27027.802	
13829	-111417.314	-27049.123	23.359
13830	-111421.812	-27047.102	4.931
13831	-111439.004	-27039.380	18.847
14251	-111429.471	-27018.075	23.341
14250	-111420.390	-27022.148	9.953
14240	-111407.771	-27027.802	13.828
面積	555.2056205		
地積	555.20 m ²		

図面の種類	画地面積求積表			
街区番号	91	番号	縮尺	
町名	桂上野東町			
京都市洛西第二土地区画整理組合				

S = 1 : 250

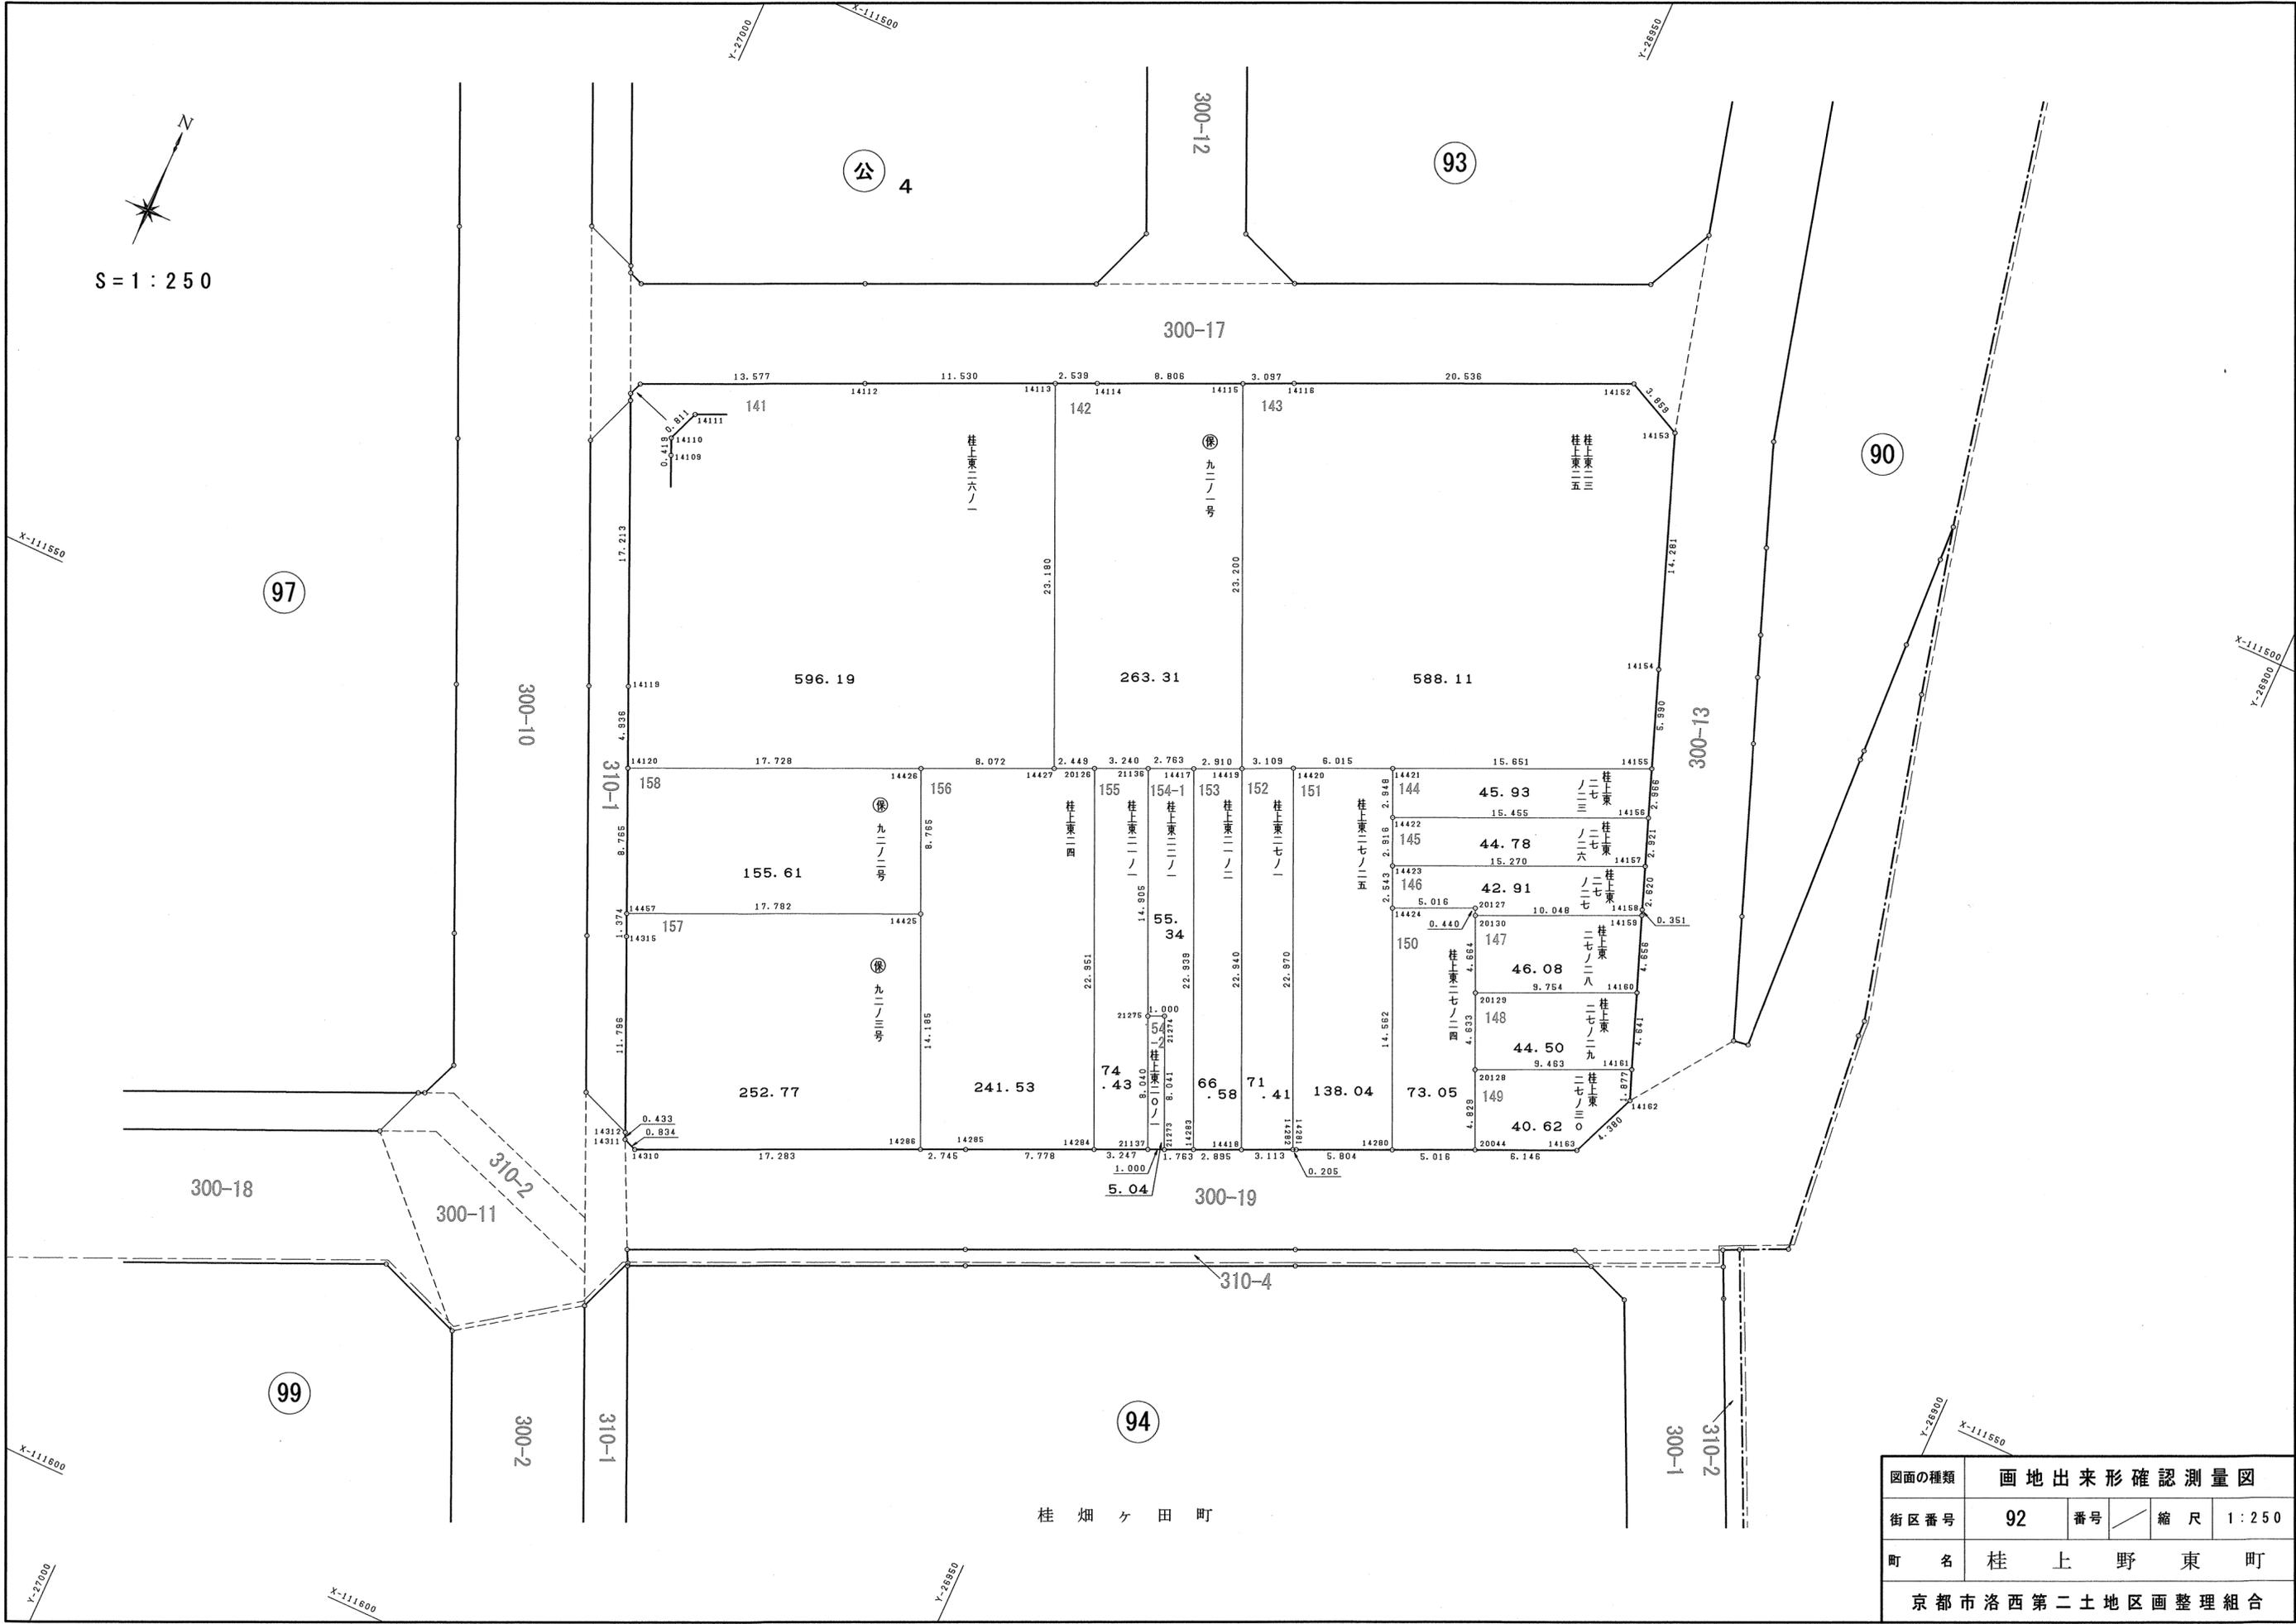

図面の種類	画地出来形確認測量図			
街区番号	92	番号	縮尺	1 : 250
町名	桂上野東町			
京都市洛西第二土地区画整理組合				

141

地番 桂上東二六ノ一			
NO	X	Y	辺長
14113	-111515.265	-26974.478	
14112	-111520.043	-26984.971	11.530
14111	-111525.685	-26997.320	13.577
14110	-111526.440	-26997.615	0.811
14109	-111526.824	-26997.447	0.419
14119	-111542.540	-26990.425	17.213
14120	-111547.046	-26988.411	4.936
14426	-111539.728	-26972.264	17.728
14427	-111536.382	-26964.918	8.072
14113	-111515.265	-26974.478	23.180
面積	596.1941455		
地積	596.19 m ²		

142

地番 保九二ノ一号			
NO	X	Y	辺長
14115	-111510.567	-26964.151	
14114	-111514.213	-26972.167	8.806
14113	-111515.265	-26974.478	2.539
14427	-111536.382	-26964.918	23.180
20126	-111535.373	-26962.687	2.449
21136	-111534.038	-26959.735	3.240
14417	-111532.900	-26957.217	2.763
14419	-111531.695	-26954.568	2.910
14115	-111510.567	-26964.151	23.200
面積	263.3185760		
地積	263.31 m ²		

143

地番 桂上東二三、桂上東二五			
NO	X	Y	辺長
14152	-111500.791	-26942.635	
14116	-111509.285	-26961.332	20.536
14115	-111510.567	-26964.151	3.097
14419	-111531.695	-26954.568	23.200
14420	-111530.381	-26951.750	3.109
14421	-111527.899	-26946.271	6.015
14155	-111521.421	-26932.024	15.651
14154	-111515.814	-26934.132	5.990
14153	-111502.443	-26939.147	14.281
14152	-111500.791	-26942.635	3.859
面積	588.1104435		
地積	588.11 m ²		

144

地番 桂上東二七ノ二三			
NO	X	Y	辺長
14155	-111521.421	-26932.024	
14421	-111527.899	-26946.271	15.651
14422	-111530.584	-26945.054	2.948
14156	-111524.197	-26930.980	15.455
14155	-111521.421	-26932.024	2.966
面積	45.9371865		
地積	45.93 m ²		

145

地番 桂上東二七ノ二六			
NO	X	Y	辺長
14156	-111524.197	-26930.980	
14422	-111530.584	-26945.054	15.455
14423	-111533.243	-26943.856	2.916
14157	-111526.931	-26929.952	15.270
14156	-111524.197	-26930.980	2.921
面積	44.7883320		
地積	44.78 m ²		

146

地番 桂上東二七ノ二七			
NO	X	Y	辺長
14157	-111526.931	-26929.952	
14423	-111533.243	-26943.856	15.270
14424	-111535.554	-26942.796	2.543
20127	-111533.479	-26938.229	5.016
20130	-111533.880	-26938.047	0.440
14159	-111529.711	-26928.905	10.048
14158	-111529.383	-26929.030	0.351
14157	-111526.931	-26929.952	2.620
面積	42.9196185		
地積	42.91 m ²		

147

地番 桂上東二七ノ二八			
NO	X	Y	辺長
14159	-111529.711	-26928.905	
20130	-111533.880	-26938.047	10.048
20129	-111538.126	-26936.118	4.664
14160	-111534.063	-26927.250	9.754
14159	-111529.711	-26928.905	4.656
面積	46.0883670		
地積	46.08 m ²		

148

地番 桂上東二七ノ二九			
NO	X	Y	辺長
14160	-111534.063	-26927.250	
20129	-111538.126	-26936.118	9.754
20128	-111542.344	-26934.202	4.633
14161	-111538.401	-26925.600	9.463
14160	-111534.063	-26927.250	4.641
面積	44.5056790		
地積	44.50 m ²		

149

地番 桂上東二七ノ三〇			
NO	X	Y	辺長
14161	-111538.401	-26925.600	
20128	-111542.344	-26934.202	9.463
20044	-111546.741	-26932.205	4.829
14163	-111544.203	-26926.607	6.146
14162	-111540.155	-26924.933	4.380
14161	-111538.401	-26925.600	1.877
面積	40.6286035		
地積	40.62 m ²		

150

地番 桂上東二七ノ二四			
NO	X	Y	辺長
14280	-111548.812	-26936.773	
20044	-111546.741	-26932.205	5.016
20128	-111542.344	-26934.202	4.829
20129	-111538.126	-26936.118	4.633
20130	-111533.880	-26938.047	4.664
20127	-111533.479	-26938.229	0.440
14424	-111535.554	-26942.796	5.016
14280	-111548.812	-26936.773	14.562
面積	73.0533170		
地積	73.05 m ²		

151

地番 桂上東二七ノ二五			
NO	X	Y	辺長
14421	-111527.899	-26946.271	
14420	-111530.381	-26951.750	6.015
14282	-111551.293	-26942.246	22.970
14281	-111551.208	-26942.059	0.205
14280	-111548.812	-26936.773	5.804
14424	-111535.554	-26942.796	14.562
14423	-111533.243	-26943.856	2.543
14422	-111530.584	-26945.054	2.916
14421	-111527.899	-26946.271	2.948
面積	138.0435940		
地積	138.04 m ²		

152

地番 桂上東二七ノ一			
NO	X	Y	辺長
14420	-111530.381	-26951.750	
14419	-111531.695	-26954.568	3.109
14418	-111552.581	-26945.080	22.940
14282	-111551.293	-26942.246	3.113
14420	-111530.381	-26951.750	22.970
面積	71.4148700		
地積	71.41 m ²		

153

地番 桂上東二一ノ二			
NO	X	Y	辺長
14419	-111531.695	-26954.568	
14417	-111532.900	-26957.217	2.910
14283	-111553.779	-26947.716	22.939
14418	-111552.581	-26945.080	2.895
14419	-111531.695	-26954.568	22.940
面積	66.5896480		
地積	66.58 m ²		

154-1

地番 桂上東二二ノ一			
NO	X	Y	辺長
14283	-111553.779	-26947.716	
14417	-111532.900	-26957.217	22.939
21136	-111534.038	-26959.735	2.763
21275	-111547.604	-26953.561	14.905
21274	-111547.189	-26952.651	1.000
21273	-111554.508	-26949.321	8.041
14283	-111553.779	-26947.716	1.763
面積	55.3419600		
地積	55.34 m ²		

154-2

地番 桂上東二〇ノ一			
NO	X	Y	辺長
21137	-111554.922	-26950.231	
21273	-111554.508	-26949.321	1.000
21274	-111547.189	-26952.651	8.041
21275	-111547.604	-26953.561	1.000
21137	-111554.922	-26950.231	8.040
面積	8.0401200		
地積	8.04 m ²		

155

地番 桂上東二一ノ一			
NO	X	Y	辺長
21136	-111534.038	-26959.735	
20126	-111535.373	-26962.687	3.240
14284	-111556.266	-26953.187	22.951
21137	-111554.922	-26950.231	3.247
21275	-111547.604	-26953.561	8.040
21136	-111534.038	-26959.735	14.905
面積	74.4358340		
地積	74.43 m ²		

156

地番 桂上東二四			
NO	X	Y	辺長
14286	-111560.620	-26962.767	
14285	-111559.484	-26960.268	2.745
14284	-111556.266	-26953.187	7.778
20126	-111535.373	-26962.687	22.951
14427	-111536.382	-26964.918	2.449
14426	-111539.728	-26972.264	8.072
14425	-111547.708	-26968.639	8.765
14286	-111560.620	-26962.767	14.185
面積	241.5315985		
地積	241.53 m ²		


157

地番 保九二ノ三号			
NO	X	Y	辺長
14425	-111547.708	-26968.639	
14457	-111555.048	-26984.835	17.782
14315	-111556.302	-26984.274	1.374
14312	-111567.063	-26979.443	11.796
14311	-111567.461	-26979.272	0.433
14310	-111567.775	-26978.499	0.834
14286	-111560.620	-26962.767	17.283
14425	-111547.708	-26968.639	14.185
面積	252.7783225		
地積	252.77 m ²		

158

地番 保九二ノ二号			
NO	X	Y	辺長
14426	-111539.728	-26972.264	
14120	-111547.046	-26988.411	17.728
14457	-111555.048	-26984.835	8.765
14425	-111547.708	-26968.639	17.782
14426	-111539.728	-26972.264	8.765
面積	155.6145210		
地積	155.61 m ²		

図面の種類	画地面積求積表		
街区番号	92	番号	縮尺
町名	桂上野東町		
京都市洛西第二土地区画整理組合			

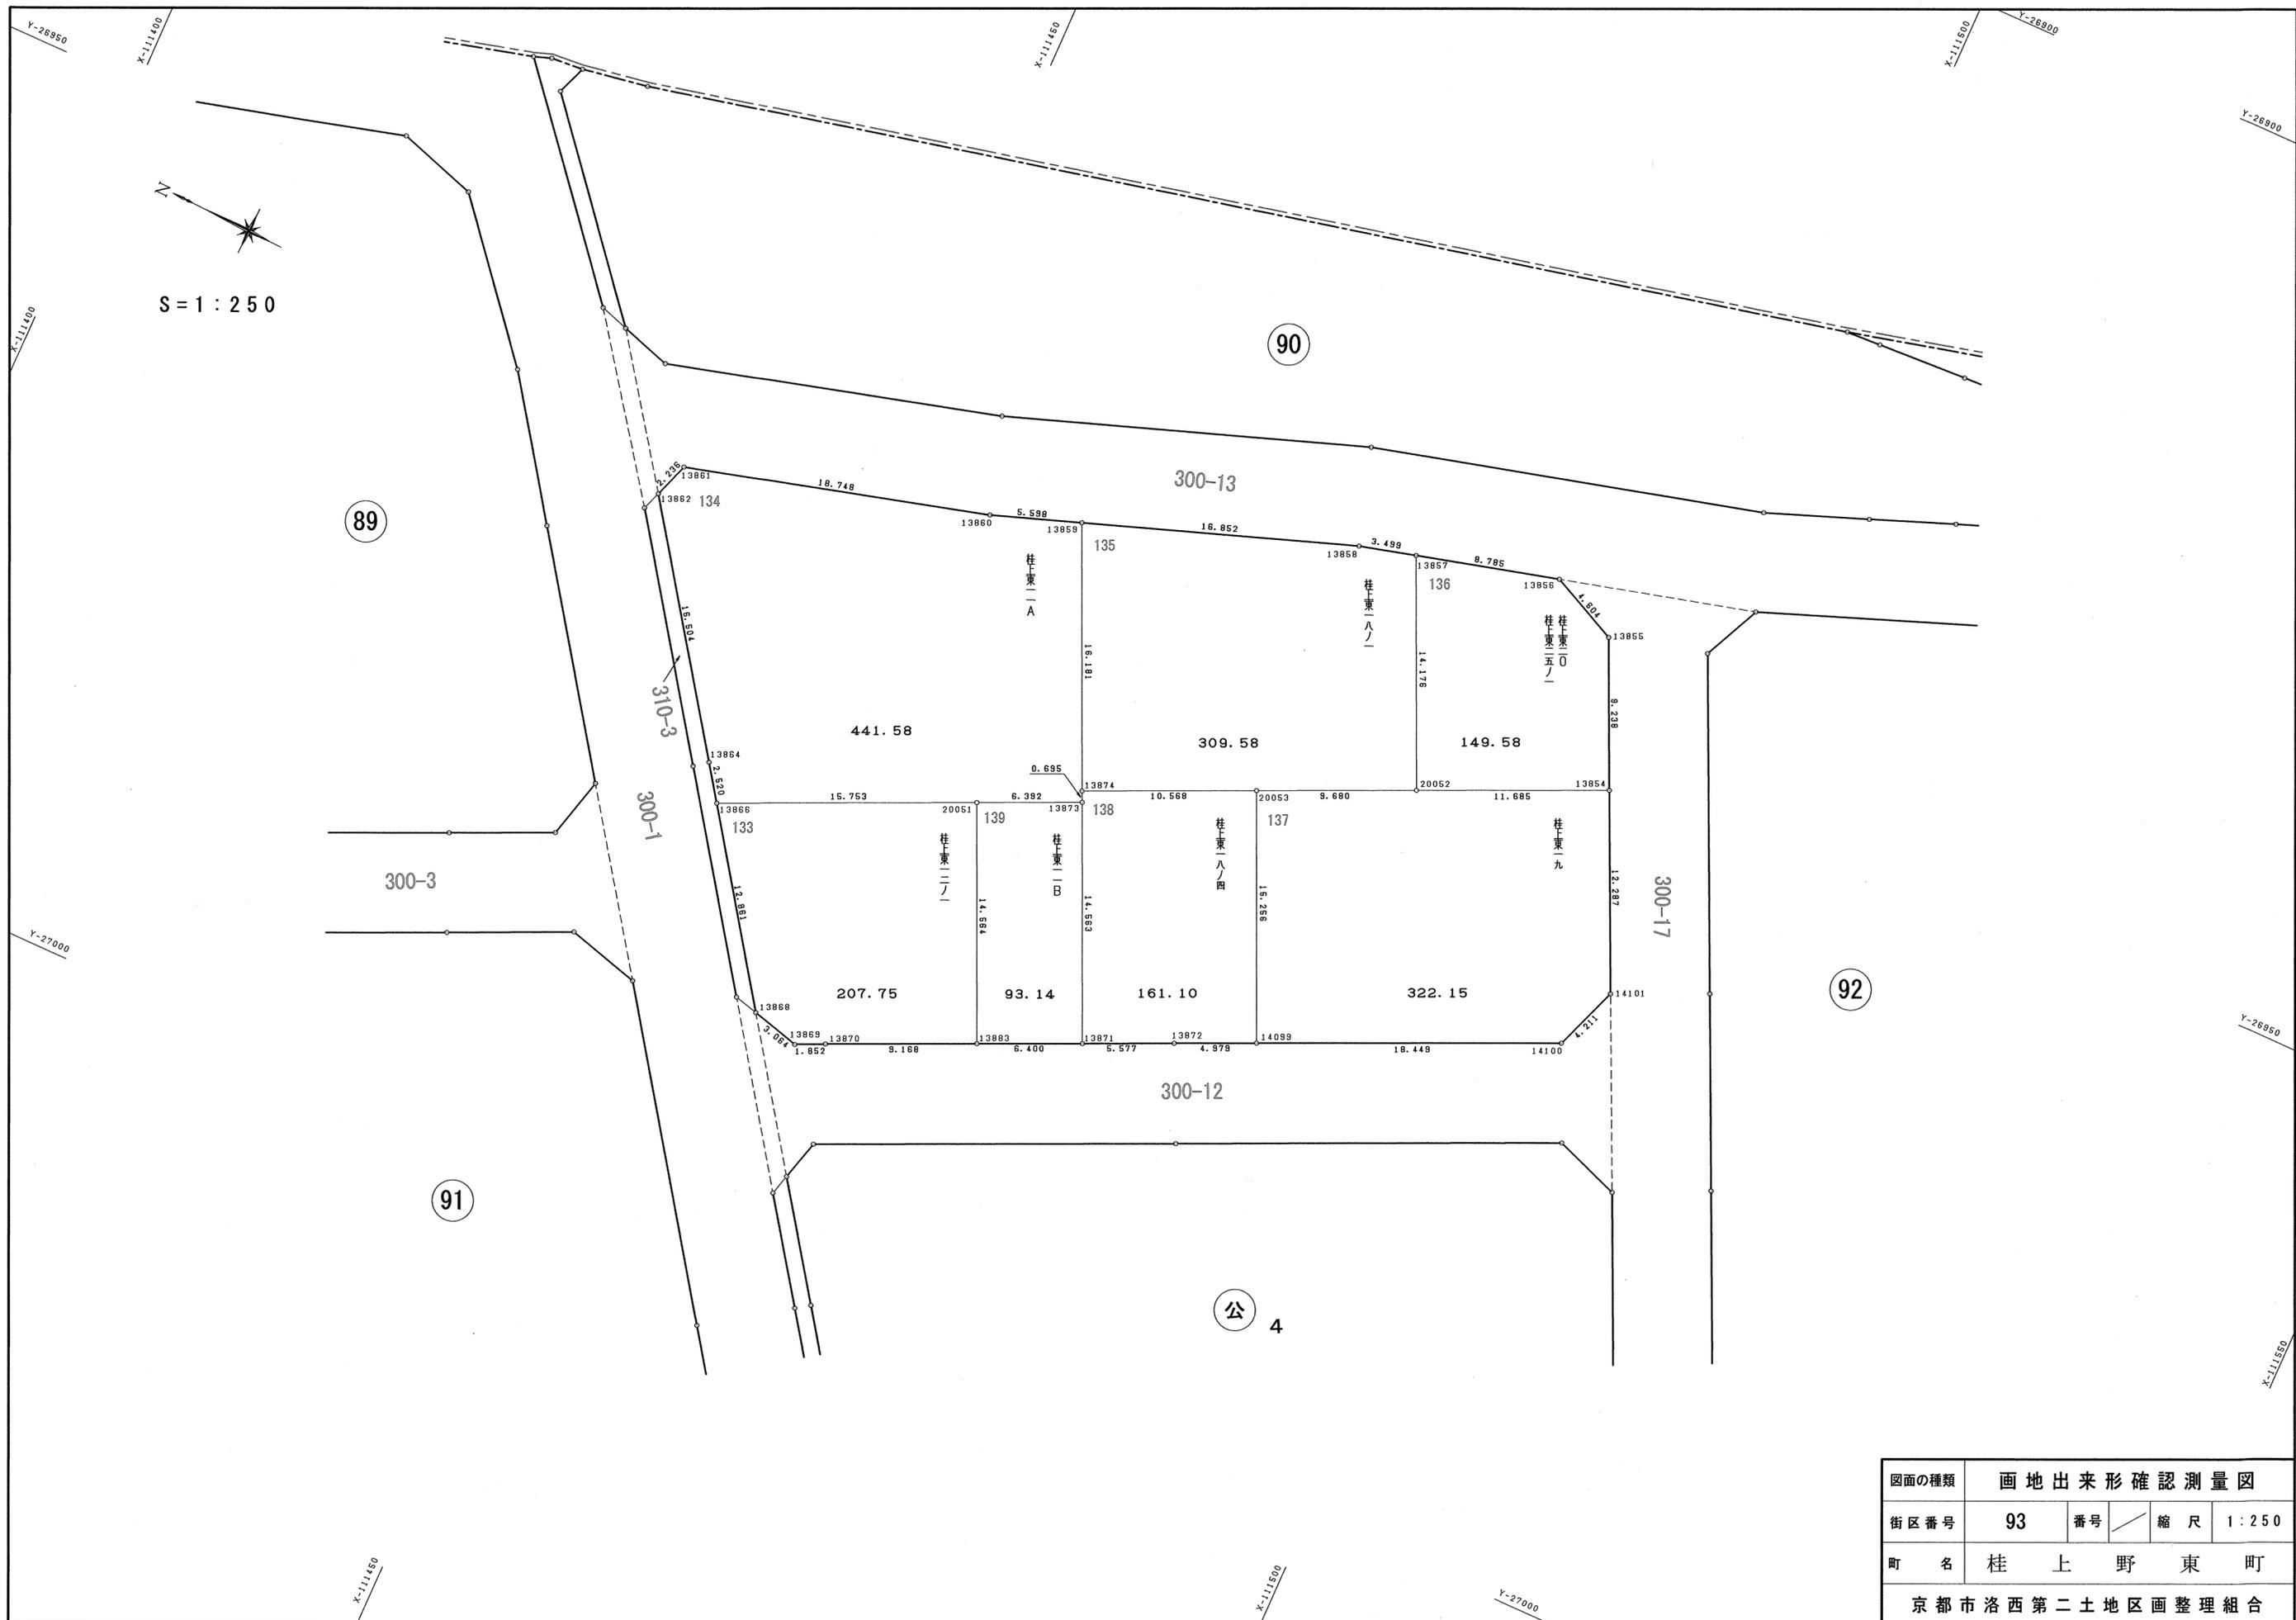

図面の種類	画地出来形確認測量図			
街区番号	93	番号	縮尺	1:250
町名	桂上野東町			
京都市洛西第二土地区画整理組合				

133

地番 桂上東一ノ一			
NO	X	Y	辺長
13866	-111449.663	-26975.328	
13868	-111456.978	-26985.906	12.861
13869	-111459.935	-26986.710	3.064
13870	-111461.617	-26985.936	1.852
13883	-111469.982	-26982.185	9.168
20051	-111464.040	-26968.888	14.564
13866	-111449.663	-26975.328	15.753
面積	207.7528805		
地積	207.75 m ²		

134

地番 桂上東一ノA			
NO	X	Y	辺長
13862	-111438.814	-26959.701	
13864	-111448.230	-26973.255	16.504
13866	-111449.663	-26975.328	2.520
20051	-111464.040	-26968.888	15.753
13873	-111469.873	-26966.275	6.392
13874	-111469.585	-26965.642	0.695
13859	-111462.971	-26950.875	16.181
13860	-111457.685	-26952.718	5.598
13861	-111439.584	-26957.602	18.748
13862	-111438.814	-26959.701	2.236
面積	441.5892920		
地積	441.58 m ²		

135

地番 桂上東一八ノ一			
NO	X	Y	辺長
13857	-111482.267	-26944.437	
13858	-111478.883	-26945.326	3.499
13859	-111462.971	-26950.875	16.852
13874	-111469.585	-26965.642	16.181
20053	-111479.231	-26961.325	10.568
20052	-111488.067	-26957.372	9.680
13857	-111482.267	-26944.437	14.176
面積	309.5866540		
地積	309.58 m ²		

136

地番 桂上東二〇、桂上東二五ノ一			
NO	X	Y	辺長
13857	-111482.267	-26944.437	
20052	-111488.067	-26957.372	14.176
13854	-111498.733	-26952.599	11.685
13855	-111494.920	-26944.185	9.238
13856	-111490.764	-26942.205	4.604
13857	-111482.267	-26944.437	8.785
面積	149.5857900		
地積	149.58 m ²		

137

地番 桂上東一九			
NO	X	Y	辺長
13854	-111498.733	-26952.599	
20052	-111488.067	-26957.372	11.685
20053	-111479.231	-26961.325	9.680
14099	-111485.457	-26975.253	15.256
14100	-111502.299	-26967.723	18.449
14101	-111503.805	-26963.790	4.211
13854	-111498.733	-26952.599	12.287
面積	322.1563060		
地積	322.15 m ²		

138

地番 桂上東一八ノ四			
NO	X	Y	辺長
13871	-111475.822	-26979.567	
13872	-111480.911	-26977.285	5.577
14099	-111485.457	-26975.253	4.979
20053	-111479.231	-26961.325	15.256
13874	-111469.585	-26965.642	10.568
13873	-111469.873	-26966.275	0.695
13871	-111475.822	-26979.567	14.563
面積	161.1027100		
地積	161.10 m ²		



139

地番 桂上東一ノB			
NO	X	Y	辺長
13883	-111469.982	-26982.185	
13871	-111475.822	-26979.567	6.400
13873	-111469.873	-26966.275	14.563
20051	-111464.040	-26968.888	6.392
13883	-111469.982	-26982.185	14.564
面積	93.1438045		
地積	93.14 m ²		

図面の種類	画地面積求積表		
街区番号	93	番号	箱尺
町名	桂上野東町		
京都市洛西第二土地区画整理組合			

地番 公園4			
NO	X	Y	辺長
13876	-111463.417	-26991.753	
13877	-111462.726	-26994.196	2.539
13880	-111467.254	-27000.702	7.927
13882	-111479.911	-27018.984	22.236
14137	-111482.875	-27019.778	3.069
14135	-111490.755	-27016.217	8.647
14136	-111490.903	-27015.826	0.418
14148	-111492.000	-27013.060	2.976
14146	-111499.173	-27009.871	7.850
14147	-111519.446	-27000.798	22.211
14107	-111519.835	-27000.628	0.425
14105	-111520.166	-26999.783	0.908
14104	-111514.567	-26987.449	13.545
14103	-111508.779	-26974.701	14.000
14102	-111504.781	-26973.215	4.265
13875	-111483.471	-26982.781	23.359
13876	-111463.417	-26991.753	21.970
面積	1499.7090420		
地積	1499.70 m ²		

図面の種類	画地面積求積表			
街区番号	公4	番号	縮尺	
町名	桂上野東町			
京都市洛西第二土地区画整理組合				

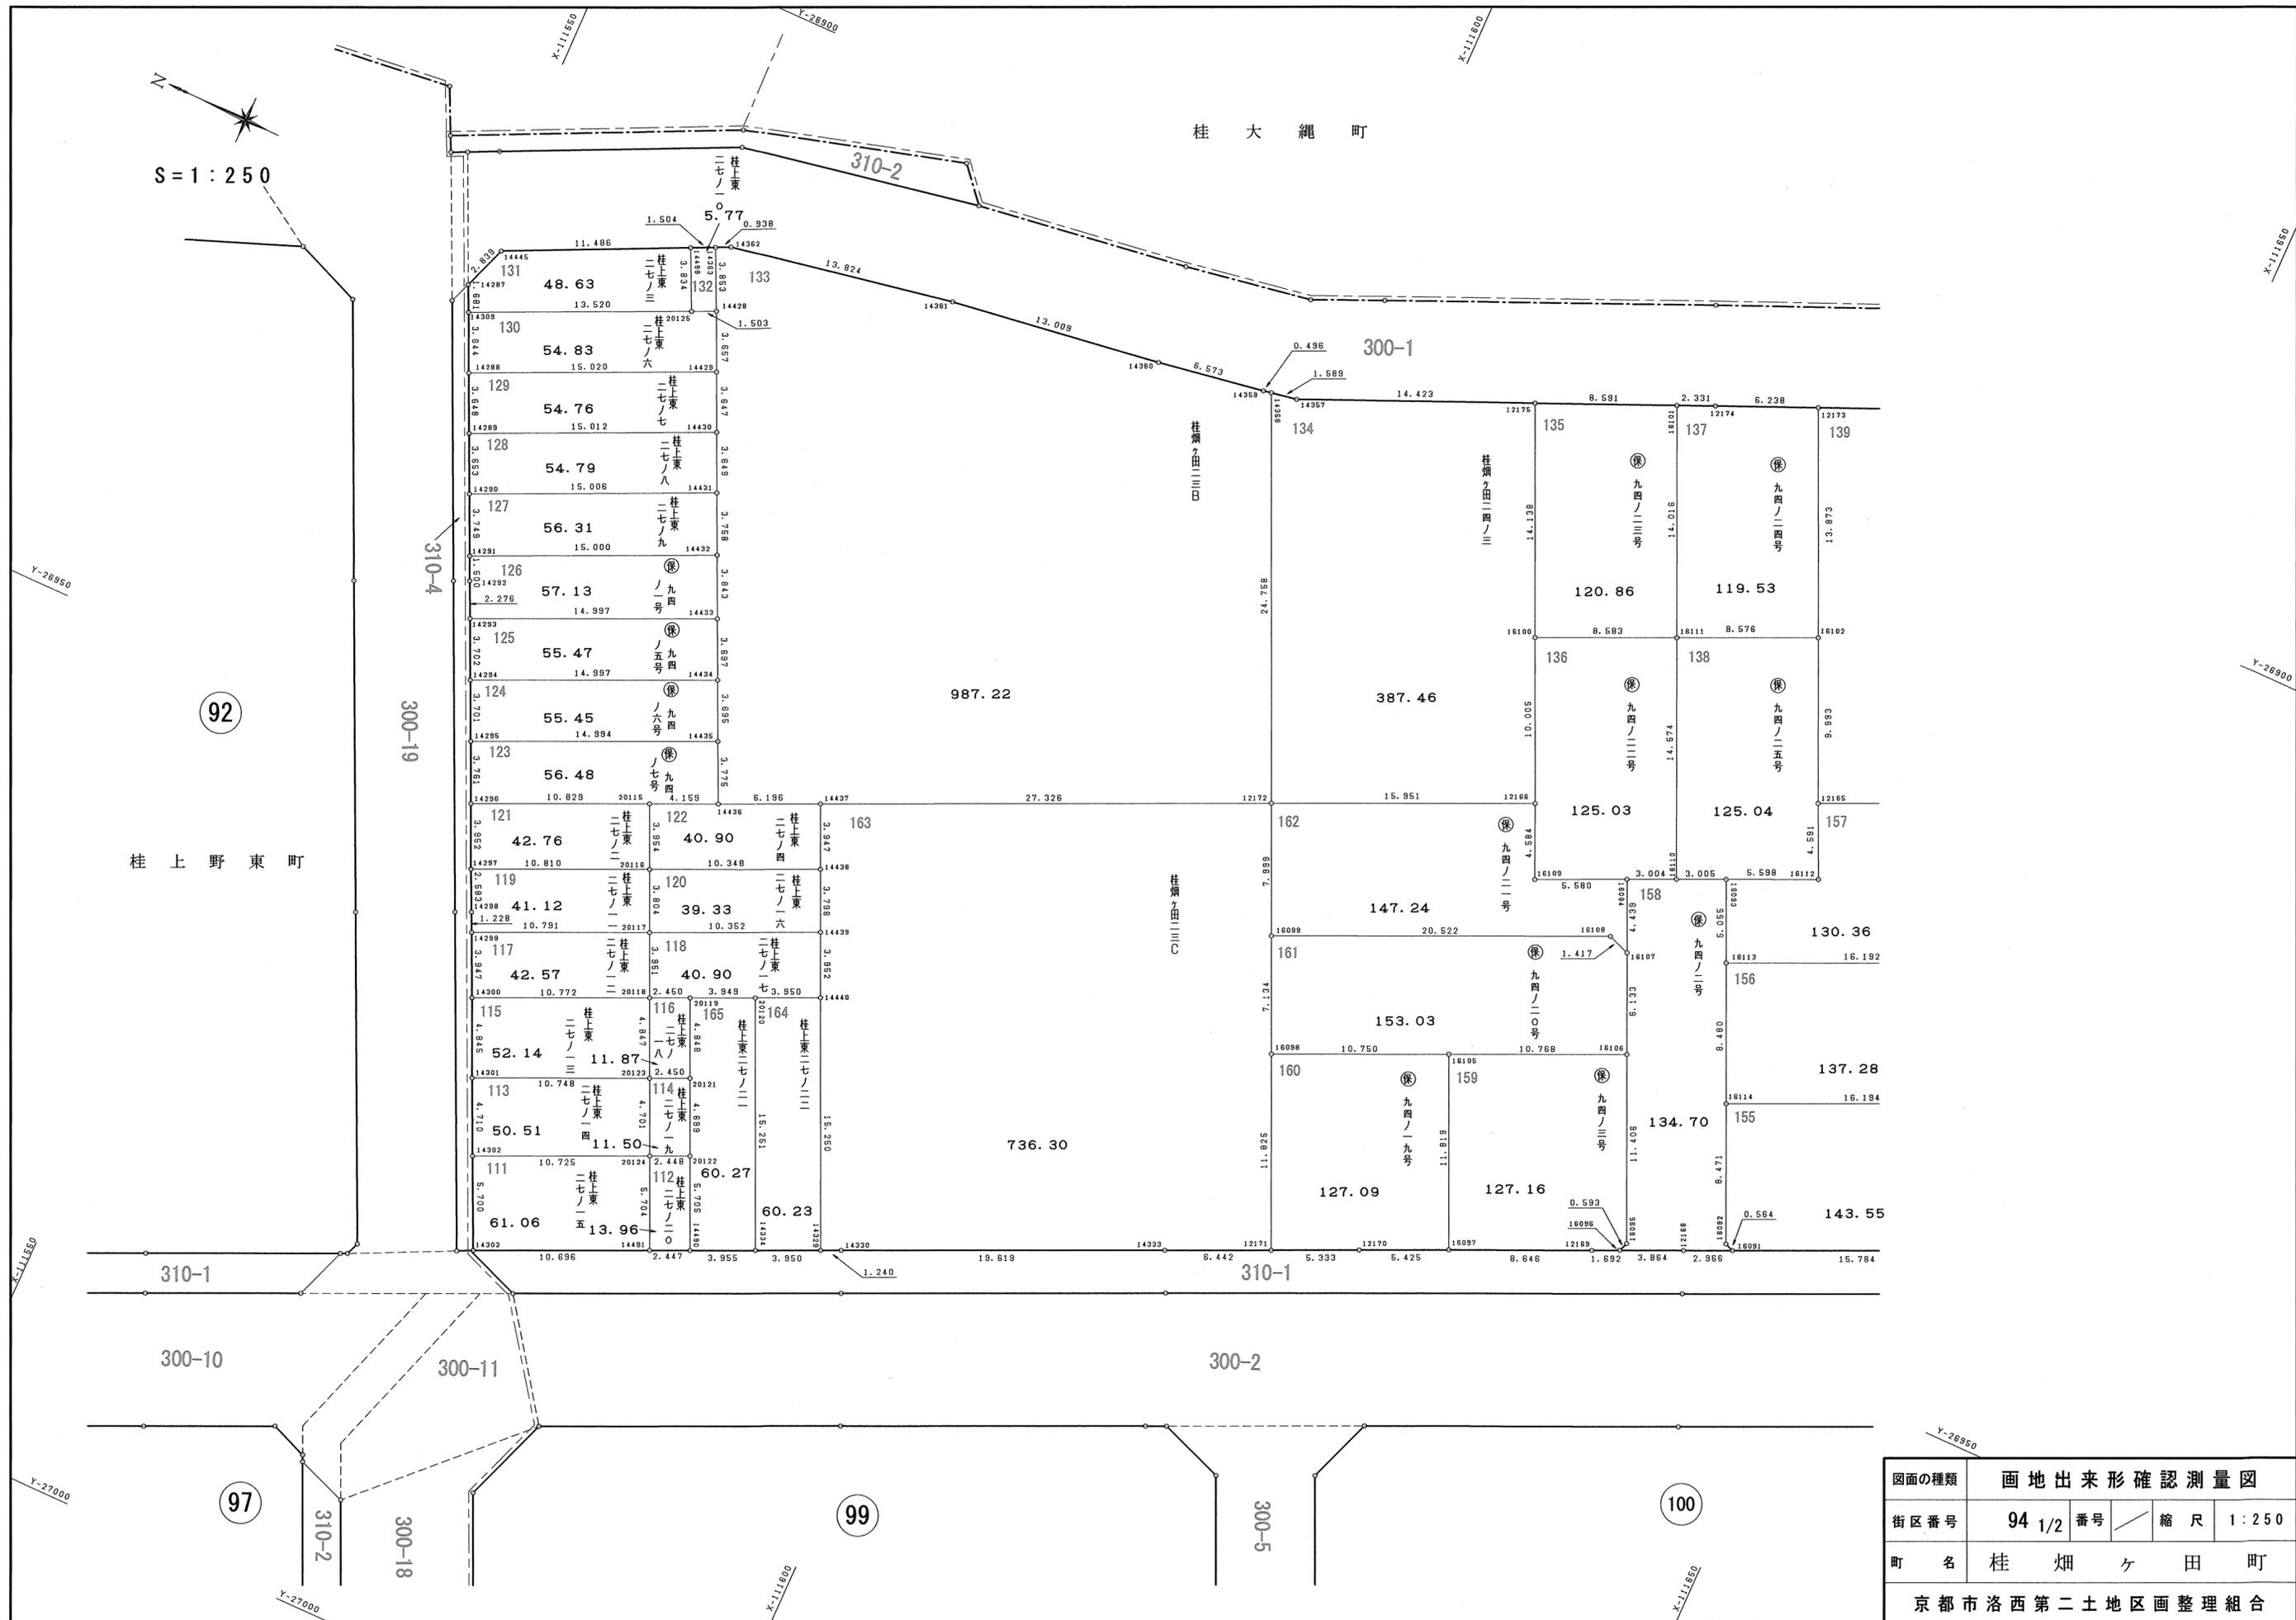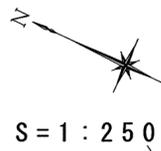


図面の種類	画地出来形確認測量図		
街区番号	94 1/2	番号	縮尺 1:250
町名	桂畑ヶ田町		
京都市洛西第二土地区画整理組合			

桂 大 網 町



S = 1 : 250

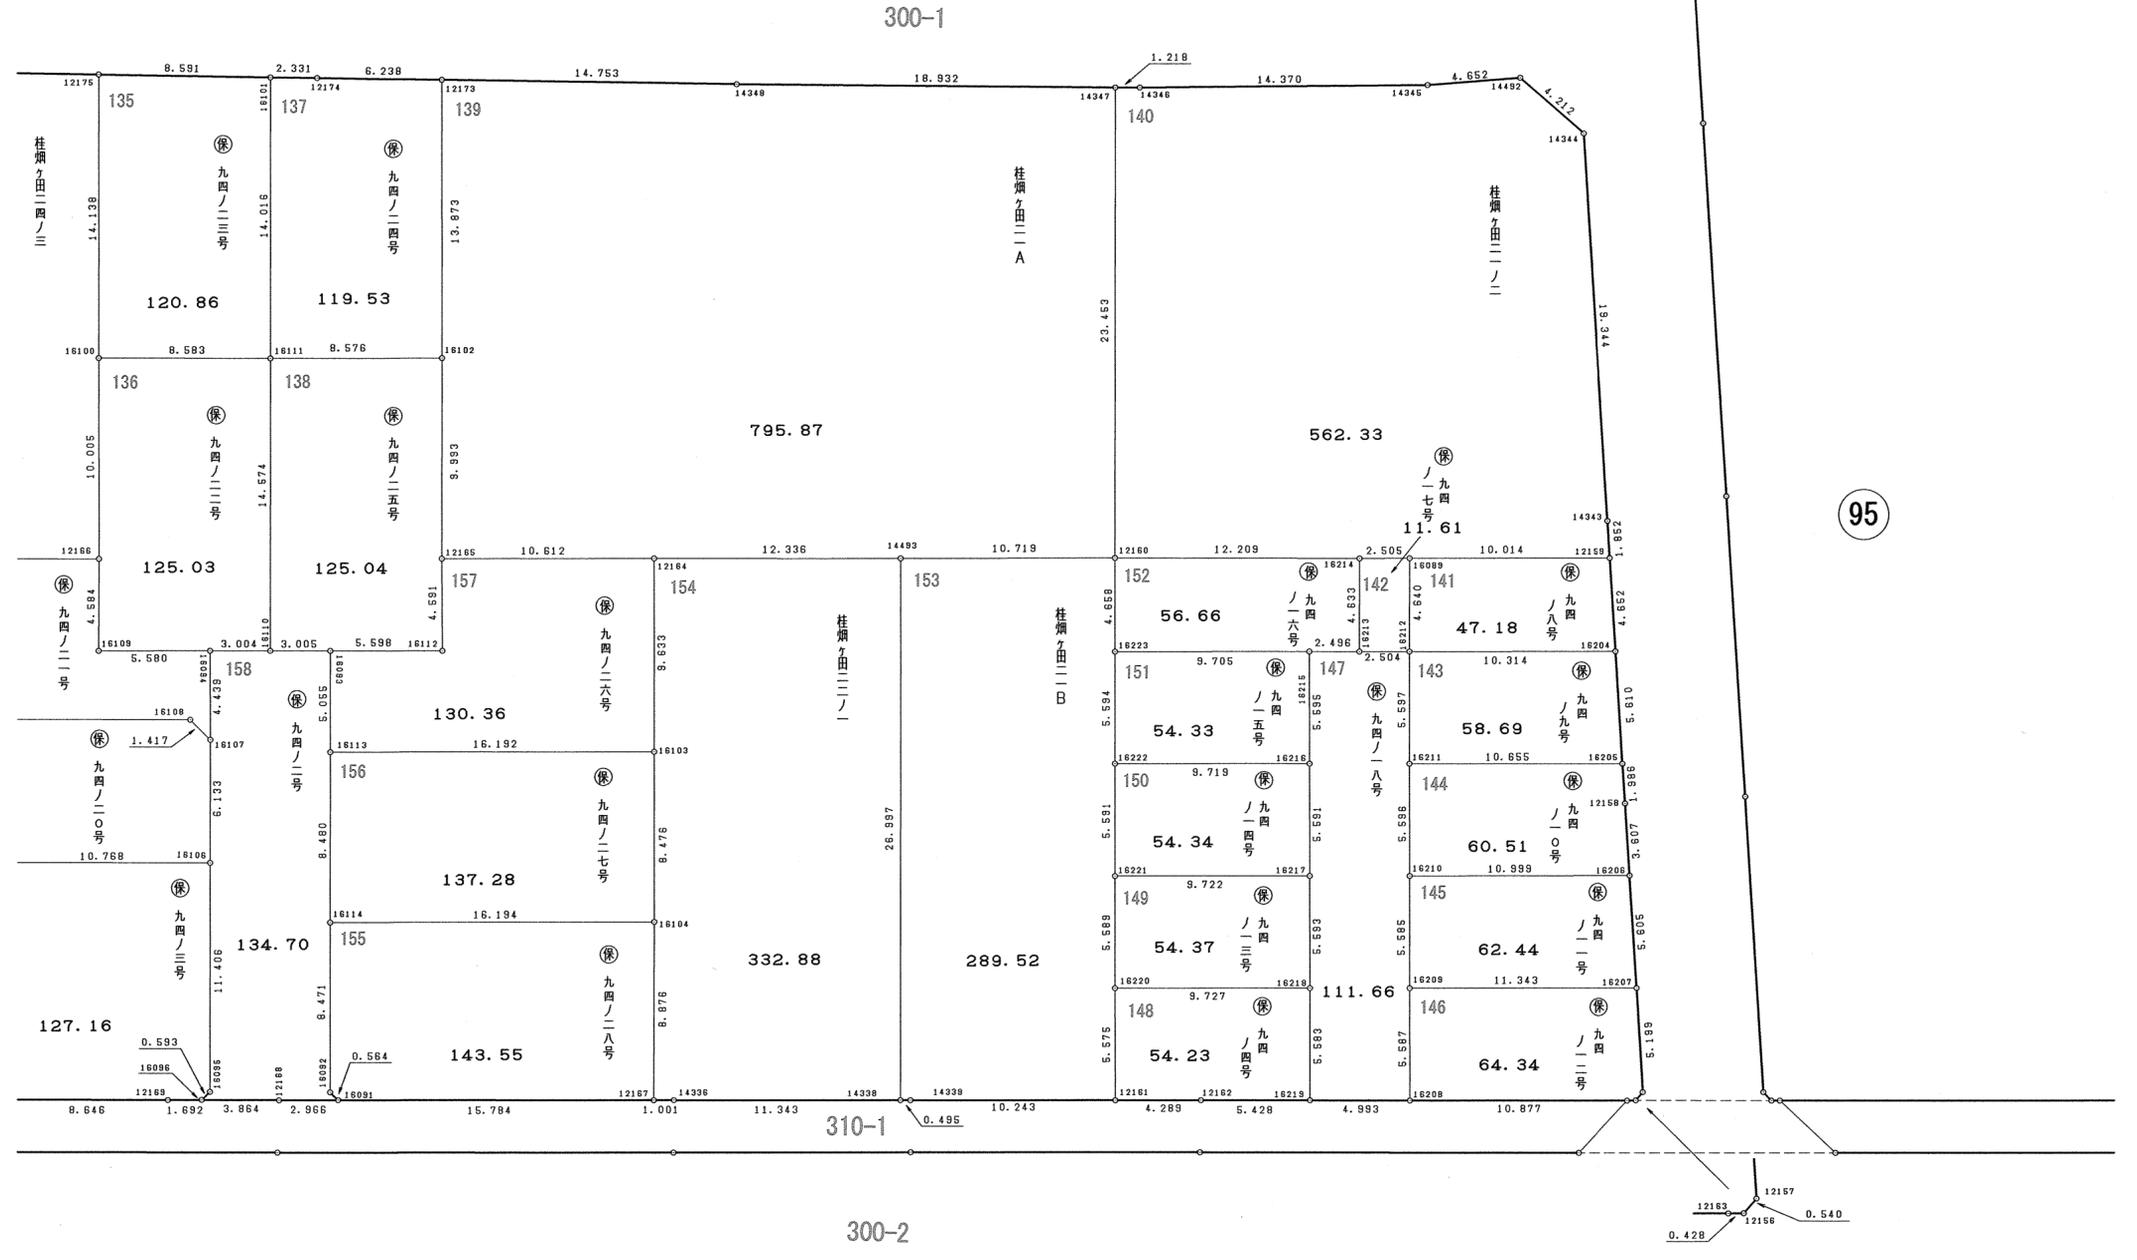

95

100

101

図面の種類	画地出来形確認測量図		
街区番号	94 2/2	番号	縮尺 1:250
町名	桂畑ケ田町		
京都市洛西第二土地区画整理組合			

111

Table with 4 columns: 地番, 桂上東二七ノ一五, NO, X, Y, 辺長. Includes area and ground area calculations.

112

Table with 4 columns: 地番, 桂上東二七ノ二〇, NO, X, Y, 辺長. Includes area and ground area calculations.

113

Table with 4 columns: 地番, 桂上東二七ノ一四, NO, X, Y, 辺長. Includes area and ground area calculations.

114

Table with 4 columns: 地番, 桂上東二七ノ一九, NO, X, Y, 辺長. Includes area and ground area calculations.

115

Table with 4 columns: 地番, 桂上東二七ノ一三, NO, X, Y, 辺長. Includes area and ground area calculations.

116

Table with 4 columns: 地番, 桂上東二七ノ一八, NO, X, Y, 辺長. Includes area and ground area calculations.

117

Table with 4 columns: 地番, 桂上東二七ノ一二, NO, X, Y, 辺長. Includes area and ground area calculations.

118

Table with 4 columns: 地番, 桂上東二七ノ一七, NO, X, Y, 辺長. Includes area and ground area calculations.

119

Table with 4 columns: 地番, 桂上東二七ノ一一, NO, X, Y, 辺長. Includes area and ground area calculations.

120

Table with 4 columns: 地番, 桂上東二七ノ一六, NO, X, Y, 辺長. Includes area and ground area calculations.

121

Table with 4 columns: 地番, 桂上東二七ノ二, NO, X, Y, 辺長. Includes area and ground area calculations.

122

Table with 4 columns: 地番, 桂上東二七ノ一八, NO, X, Y, 辺長. Includes area and ground area calculations.

122

Table with 4 columns: 地番, 桂上東二七ノ四, NO, X, Y, 辺長. Includes area and ground area calculations.

123

Table with 4 columns: 地番, 保 九四ノ七号, NO, X, Y, 辺長. Includes area and ground area calculations.

124

Table with 4 columns: 地番, 保 九四ノ六号, NO, X, Y, 辺長. Includes area and ground area calculations.

125

134

Table with 4 columns: 地番, 桂畑ケ田二四ノ三, NO, X, Y, 辺長. Includes area and ground area calculations.

135

Table with 4 columns: 地番, 保 九四ノ二三号, NO, X, Y, 辺長. Includes area and ground area calculations.

136

Table with 4 columns: 地番, 保 九四ノ二二号, NO, X, Y, 辺長. Includes area and ground area calculations.

137

Table with 4 columns: 地番, 保 九四ノ二四号, NO, X, Y, 辺長. Includes area and ground area calculations.

138

Table with 4 columns: 地番, 保 九四ノ二五号, NO, X, Y, 辺長. Includes area and ground area calculations.

139

Table with 4 columns: 地番, 桂畑ケ田二一A, NO, X, Y, 辺長. Includes area and ground area calculations.

140

Table with 4 columns: 地番, 桂畑ケ田二一ノ二, NO, X, Y, 辺長. Includes area and ground area calculations.

Summary table: 図面の種類, 画地, 面積, 求積表. Includes address: 94, 桂畑ケ田町, 京都市洛西第二土地区画整理組合.

141

地番 保 九四ノ八号			
N O	X	Y	辺長
16212	-111683.682	-26902.509	
16204	-111693.090	-26898.281	10.314
12159	-111690.927	-26894.162	4.652
16089	-111681.794	-26898.270	10.014
16212	-111683.682	-26902.509	4.640
面積	47.1837035		
地積	47.18 m ²		

142

地番 保 九四ノ一七号			
N O	X	Y	辺長
16213	-111681.398	-26903.536	
16212	-111683.682	-26902.509	2.504
16089	-111681.794	-26898.270	4.640
16214	-111679.512	-26899.304	2.505
16213	-111681.398	-26903.536	4.633
面積	11.6142000		
地積	11.61 m ²		

143

地番 保 九四ノ九号			
N O	X	Y	辺長
16211	-111685.978	-26907.613	
16205	-111695.698	-26903.248	10.655
16204	-111693.090	-26898.281	5.610
16212	-111683.682	-26902.509	10.314
16211	-111685.978	-26907.613	5.597
面積	58.6945400		
地積	58.69 m ²		

144

地番 保 九四ノ一〇号			
N O	X	Y	辺長
16210	-111688.270	-26912.718	
16206	-111698.298	-26908.200	10.999
12158	-111696.621	-26905.006	3.607
16205	-111695.698	-26903.248	1.986
16211	-111685.978	-26907.613	10.655
16210	-111688.270	-26912.718	5.596
面積	60.5152660		
地積	60.51 m ²		

145

地番 保 九四ノ一一号			
N O	X	Y	辺長
16209	-111690.557	-26917.813	
16207	-111700.903	-26913.163	11.343
16206	-111698.298	-26908.200	5.605
16210	-111688.270	-26912.718	10.999
16209	-111690.557	-26917.813	5.585
面積	62.4428870		
地積	62.44 m ²		

146

地番 保 九四ノ一二号			
N O	X	Y	辺長
16208	-111692.847	-26922.909	
12163	-111702.775	-26918.465	10.877
12156	-111703.162	-26918.282	0.428
12157	-111703.320	-26917.766	0.540
16207	-111700.903	-26913.163	5.199
16209	-111690.557	-26917.813	11.343
16208	-111692.847	-26922.909	5.587
面積	64.3490180		
地積	64.34 m ²		

147

地番 保 九四ノ一八号			
N O	X	Y	辺長
16219	-111688.290	-26924.949	
16208	-111692.847	-26922.909	4.993
16209	-111690.557	-26917.813	5.587
16210	-111688.270	-26912.718	5.585
16211	-111685.978	-26907.613	5.596
16212	-111683.682	-26902.509	5.597
16213	-111681.398	-26903.536	2.504
16215	-111679.119	-26904.554	2.496
16216	-111681.419	-26909.654	5.595
16217	-111683.710	-26914.754	5.591
16218	-111686.005	-26919.855	5.593
16219	-111688.290	-26924.949	5.583
面積	111.6651990		
地積	111.66 m ²		

148

地番 保 九四ノ四号			
N O	X	Y	辺長
12161	-111679.422	-26928.920	
12162	-111683.336	-26927.167	4.289
16219	-111688.290	-26924.949	5.428
16218	-111686.005	-26919.855	5.583
16220	-111677.131	-26923.838	9.727
12161	-111679.422	-26928.920	5.575
面積	54.2334690		
地積	54.23 m ²		

149

地番 保 九四ノ一三号			
N O	X	Y	辺長
16220	-111677.131	-26923.838	
16218	-111686.005	-26919.855	9.727
16217	-111683.710	-26914.754	5.593
16221	-111674.842	-26918.739	9.722
16220	-111677.131	-26923.838	5.589
面積	54.3734280		
地積	54.37 m ²		

150

地番 保 九四ノ一四号			
N O	X	Y	辺長
16221	-111674.842	-26918.739	
16217	-111683.710	-26914.754	9.722
16216	-111681.419	-26909.654	5.591
16222	-111672.554	-26913.638	9.719
16221	-111674.842	-26918.739	5.591
面積	54.3460960		
地積	54.34 m ²		

151

地番 保 九四ノ一五号			
N O	X	Y	辺長
16222	-111672.554	-26913.638	
16216	-111681.419	-26909.654	9.719
16215	-111679.119	-26904.554	5.595
16223	-111670.267	-26908.533	9.705
16222	-111672.554	-26913.638	5.594
面積	54.3320665		
地積	54.33 m ²		

152

地番 保 九四ノ一六号			
N O	X	Y	辺長
16223	-111670.267	-26908.533	
16215	-111679.119	-26904.554	9.705
16213	-111681.398	-26903.536	2.496
16214	-111679.512	-26899.304	4.633
12160	-111668.364	-26904.282	12.209
16223	-111670.267	-26908.533	4.658
面積	56.6686055		
地積	56.66 m ²		

153

地番 桂畑ケ田二一B			
N O	X	Y	辺長
14493	-111658.584	-26908.670	
14338	-111669.621	-26933.308	26.997
14339	-111670.073	-26933.106	0.495
12161	-111679.422	-26928.920	10.243
16220	-111677.131	-26923.838	5.575
16221	-111674.842	-26918.739	5.589
16222	-111672.554	-26913.638	5.591
16223	-111670.267	-26908.533	5.594
12160	-111668.364	-26904.282	4.658
14493	-111658.584	-26908.670	10.719
面積	289.5214495		
地積	289.52 m ²		

154

地番 桂畑ケ田二二一〇			
N O	X	Y	辺長
12164	-111647.326	-26913.714	
16103	-111651.272	-26922.502	9.633
16104	-111654.733	-26930.239	8.476
12167	-111658.351	-26938.344	8.876
14336	-111659.265	-26937.935	1.001
14338	-111669.621	-26933.308	11.343
14493	-111658.584	-26908.670	26.997
12164	-111647.326	-26913.714	12.336
面積	332.8897435		
地積	332.88 m ²		

155

地番 保 九四ノ二八号			
N O	X	Y	辺長
16114	-111639.955	-26936.862	
16092	-111643.416	-26944.594	8.471
16091	-111643.944	-26944.792	0.564
12167	-111658.351	-26938.344	15.784
16104	-111654.733	-26930.239	8.876
16114	-111639.955	-26936.862	16.194
面積	143.5517520		
地積	143.55 m ²		

156

地番 保 九四ノ二七号			
N O	X	Y	辺長
16113	-111636.494	-26929.120	
16114	-111639.955	-26936.862	8.480
16104	-111654.733	-26930.239	16.194
16103	-111651.272	-26922.502	8.476
16113	-111636.494	-26929.120	16.192
面積	137.2878815		
地積	137.28 m ²		

157

地番 保 九四ノ二六号			
N O	X	Y	辺長
16093	-111634.425	-26924.508	
16113	-111636.494	-26929.120	5.055
16103	-111651.272	-26922.502	16.192
12164	-111647.326	-26913.714	9.633
12165	-111637.640	-26918.050	10.612
16112	-111639.539	-26922.230	4.591
16093	-111634.425	-26924.508	5.598
面積	130.3626980		
地積	130.36 m ²		

158

地番 保 九四ノ二号			
N O	X	Y	辺長
16094	-111628.943	-26926.968	
16107	-111630.762	-26931.017	4.439
16106	-111633.266	-26936.615	6.133
16095	-111637.920	-26947.028	11.406
16096	-111637.710	-26947.583	0.593
12168	-111641.237	-26946.004	3.864
16091	-111643.944	-26944.792	2.968
16092	-111643.416	-26944.594	0.564
16114	-111639.955	-26936.862	8.471
16113	-111636.494	-26929.120	8.480
16093	-111634.425	-26924.508	5.055
16110	-111631.687	-26925.746	3.005
16094	-111628.943	-26926.968	3.004
面積	134.7099250		
地積	134.70 m ²		

159


地番 保 九四ノ三号			
N O	X	Y	辺長
16105	-111623.437	-26941.014	
16097	-111628.271	-26951.799	11.819
12169	-111636.166	-26948.275	8.646
16096	-111637.710	-26947.583	1.692
16095	-111637.920	-26947.028	0.593
16106	-111633.266	-26936.615	11.406
16105	-111623.437	-26941.014	10.768
面積	127.1626855		
地積	127.16 m ²		

160

地番 保 九四ノ一九号			
N O	X	Y	辺長
16098	-111613.623	-26945.402	
12171	-111618.453	-26956.196	11.825
12170	-111623.317	-26954.010	5.333
16097	-111628.271	-26951.799	5.425
16105	-111623.437	-26941.014	11.819
16098	-111613.623	-26945.402	10.750
面積	127.0967220		
地積	127.09 m ²		

161

||
||
||

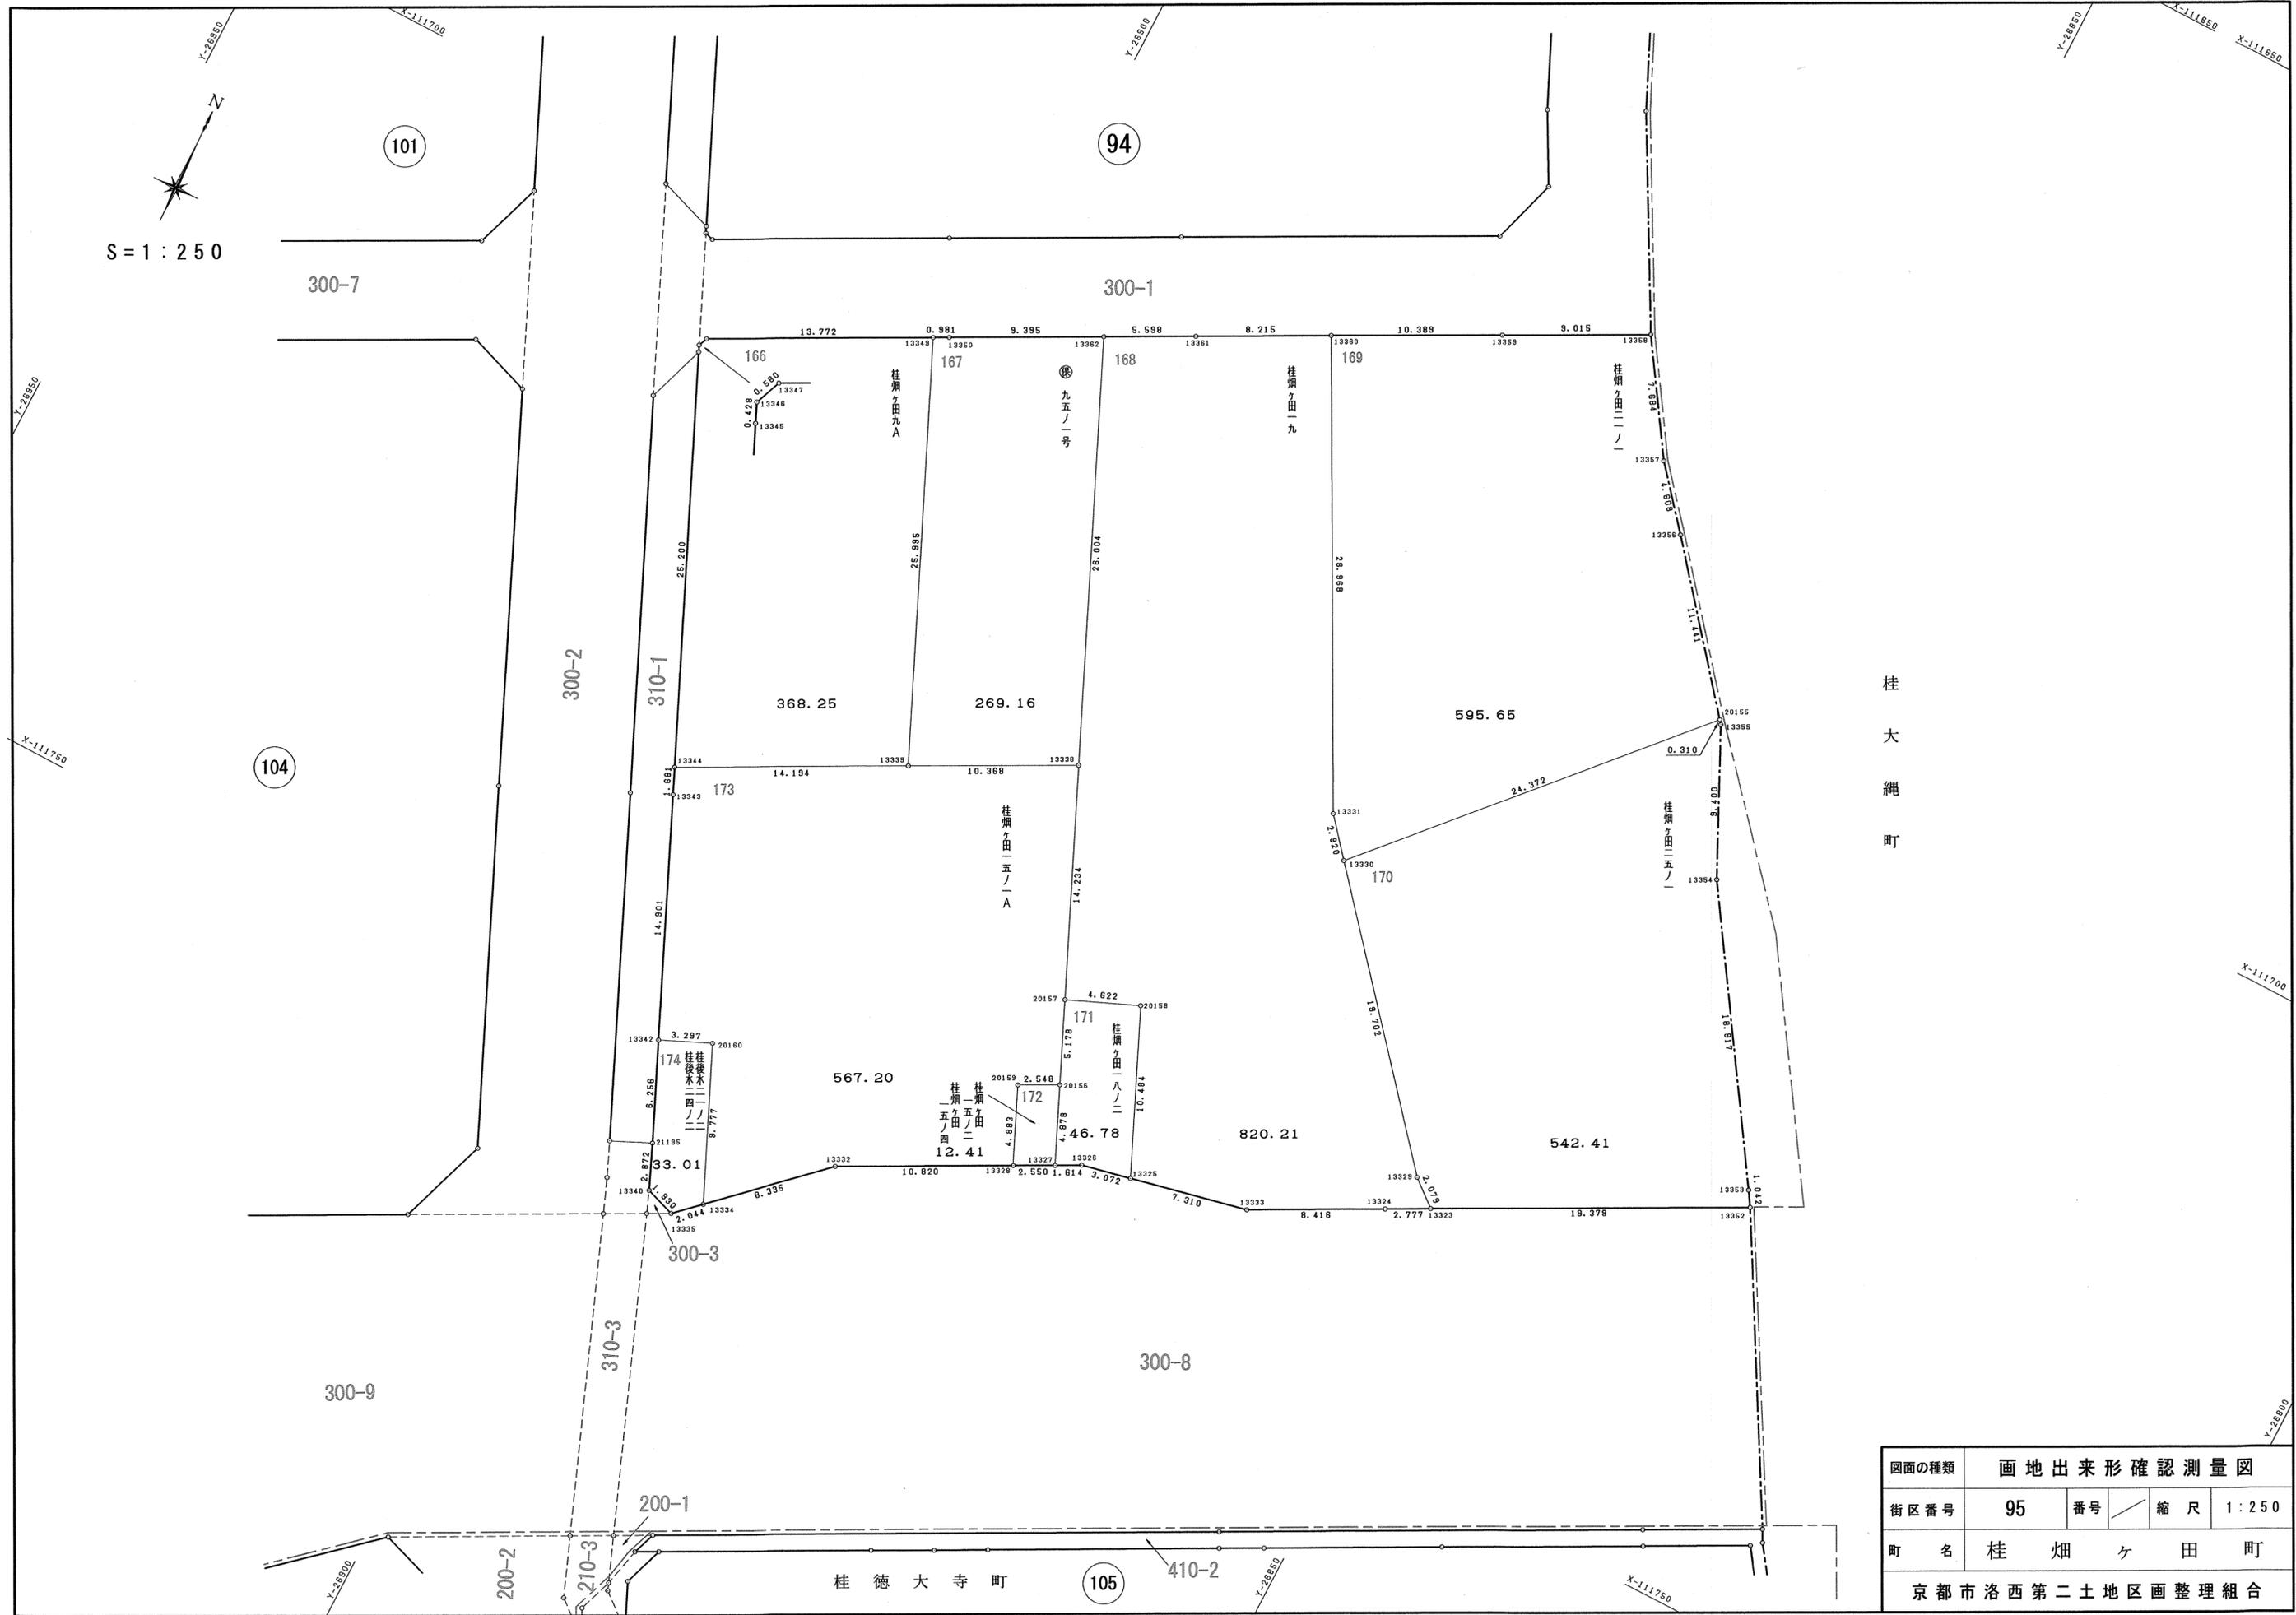

桂
大
繩
町

図面の種類	画地出来形確認測量図		
街区番号	95	番号	縮尺 1:250
町名	桂畑ヶ田町		
京都市洛西第二土地区画整理組合			

166

地番 桂畑ヶ田九A			
NO	X	Y	辺長
13349	-111702.418	-26903.107	
13347	-111708.820	-26915.300	13.772
13346	-111709.357	-26915.520	0.580
13345	-111709.748	-26915.347	0.428
13344	-111732.737	-26905.024	25.200
13339	-111726.133	-26892.460	14.194
13349	-111702.418	-26903.107	25.995
面積	368.2570645		
地積	368.25 m ²		

167

地番 保 九五ノ一号			
NO	X	Y	辺長
13362	-111697.592	-26893.921	
13350	-111701.962	-26902.238	9.395
13349	-111702.418	-26903.107	0.981
13339	-111726.133	-26892.460	25.995
13338	-111721.318	-26883.278	10.368
13362	-111697.592	-26893.921	26.004
面積	269.1608055		
地積	269.16 m ²		

168

地番 桂畑ヶ田一九			
NO	X	Y	辺長
13360	-111691.164	-26881.695	
13361	-111694.988	-26888.966	8.215
13362	-111697.592	-26893.921	5.598
13338	-111721.318	-26883.278	26.004
20157	-111734.306	-26877.453	14.234
20158	-111732.503	-26873.197	4.622
13325	-111742.070	-26868.908	10.484
13333	-111740.505	-26861.767	7.310
13324	-111736.580	-26854.322	8.416
13323	-111735.284	-26851.866	2.777
13329	-111733.979	-26853.484	2.079
13330	-111719.013	-26866.298	19.702
13331	-111716.795	-26868.197	2.920
13360	-111691.164	-26881.695	28.968
面積	820.2167135		
地積	820.21 m ²		

169

地番 桂畑ヶ田二一ノ一			
NO	X	Y	辺長
13358	-111682.135	-26864.520	
13359	-111686.328	-26872.500	9.015
13360	-111691.164	-26881.695	10.389
13331	-111716.795	-26868.197	28.968
13330	-111719.013	-26866.298	2.920
20155	-111700.878	-26850.015	24.372
13356	-111692.060	-26857.305	11.441
13357	-111688.550	-26860.290	4.608
13358	-111682.135	-26864.520	7.684
面積	595.6525135		
地積	595.65 m ²		

170

地番 桂畑ヶ田二五ノ一			
NO	X	Y	辺長
20155	-111700.878	-26850.015	
13330	-111719.013	-26866.298	24.372
13329	-111733.979	-26853.484	19.702
13323	-111735.284	-26851.866	2.079
13352	-111726.240	-26834.727	19.379
13353	-111725.358	-26835.282	1.042
13354	-111709.567	-26845.699	18.917
13355	-111701.117	-26849.818	9.400
20155	-111700.878	-26850.015	0.310
面積	542.4153395		
地積	542.41 m ²		

171

地番 桂畑ヶ田一八ノ二			
NO	X	Y	辺長
20157	-111734.306	-26877.453	
20156	-111739.030	-26875.333	5.178
13327	-111743.481	-26873.337	4.878
13326	-111742.728	-26871.909	1.614
13325	-111742.070	-26868.908	3.072
20158	-111732.503	-26873.197	10.484
20157	-111734.306	-26877.453	4.622
面積	46.7834125		
地積	46.78 m ²		

172

地番 桂畑ヶ田一五ノ二、桂畑ヶ田一五ノ四			
NO	X	Y	辺長
13328	-111744.669	-26875.593	
13327	-111743.481	-26873.337	2.550
20156	-111739.030	-26875.333	4.878
20159	-111740.213	-26877.590	2.548
13328	-111744.669	-26875.593	4.883
面積	12.4161735		
地積	12.41 m ²		

173

地番 桂畑ヶ田一五ノ一A			
NO	X	Y	辺長
13338	-111721.318	-26883.278	
13339	-111726.133	-26892.460	10.368
13344	-111732.737	-26905.024	14.194
13343	-111734.270	-26904.335	1.681
13342	-111747.868	-26898.242	14.901
20160	-111746.517	-26895.234	3.297
13334	-111755.435	-26891.226	9.777
13332	-111749.713	-26885.165	8.335
13328	-111744.669	-26875.593	10.820
20159	-111740.213	-26877.590	4.883
20156	-111739.030	-26875.333	2.548
20157	-111734.306	-26877.453	5.178
13338	-111721.318	-26883.278	14.234
面積	567.2085500		
地積	567.20 m ²		


174

地番 桂後水二一ノ二、桂後水二四ノ二			
NO	X	Y	辺長
13342	-111747.868	-26898.242	
21195	-111753.577	-26895.683	6.256
13340	-111756.211	-26894.538	2.872
13335	-111756.838	-26892.713	1.930
13334	-111755.435	-26891.226	2.044
20160	-111746.517	-26895.234	9.777
13342	-111747.868	-26898.242	3.297
面積	33.0178475		
地積	33.01 m ²		

図面の種類	画地面積求積表		
街区番号	95	番号	縮尺
町名	桂畑ヶ田町		
京都市洛西第二土地区画整理組合			



桂上野中町

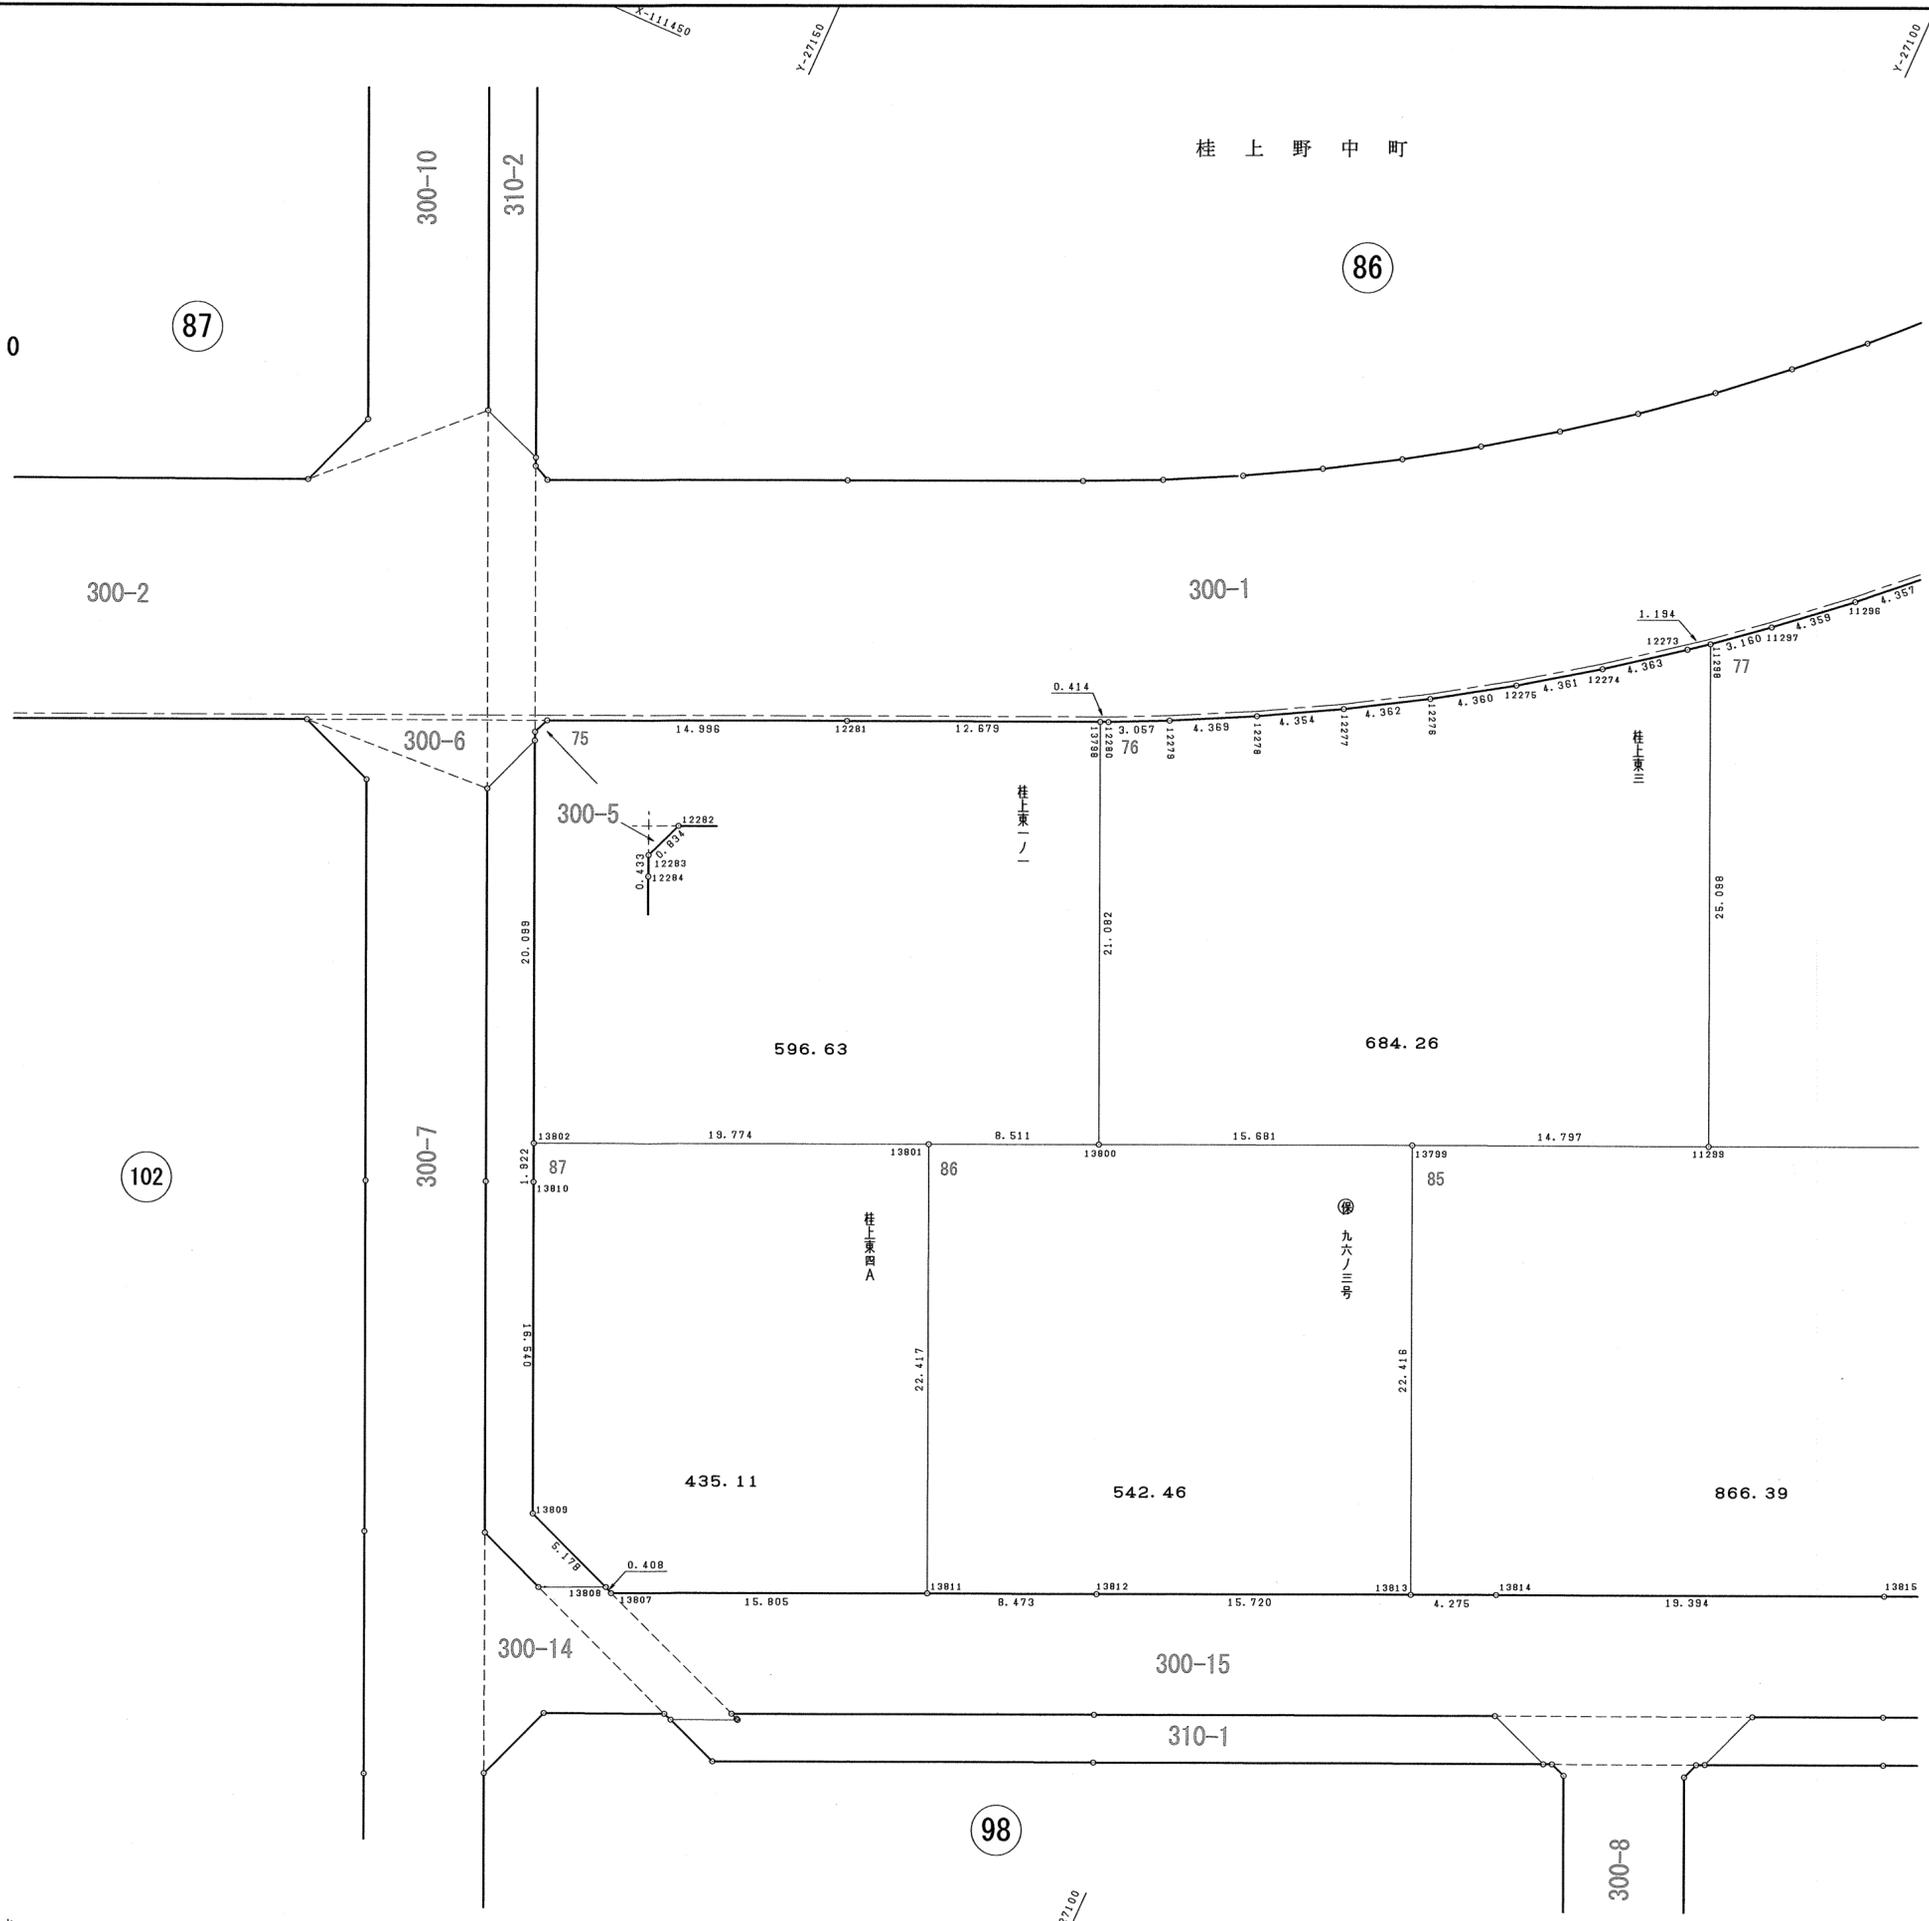


図面の種類	画地出来形確認測量図			
街区番号	96 1/2	番号	縮尺	1:250
町名	桂上野東町			
京都市洛西第二土地区画整理組合				

桂上野中町

86

S = 1 : 250

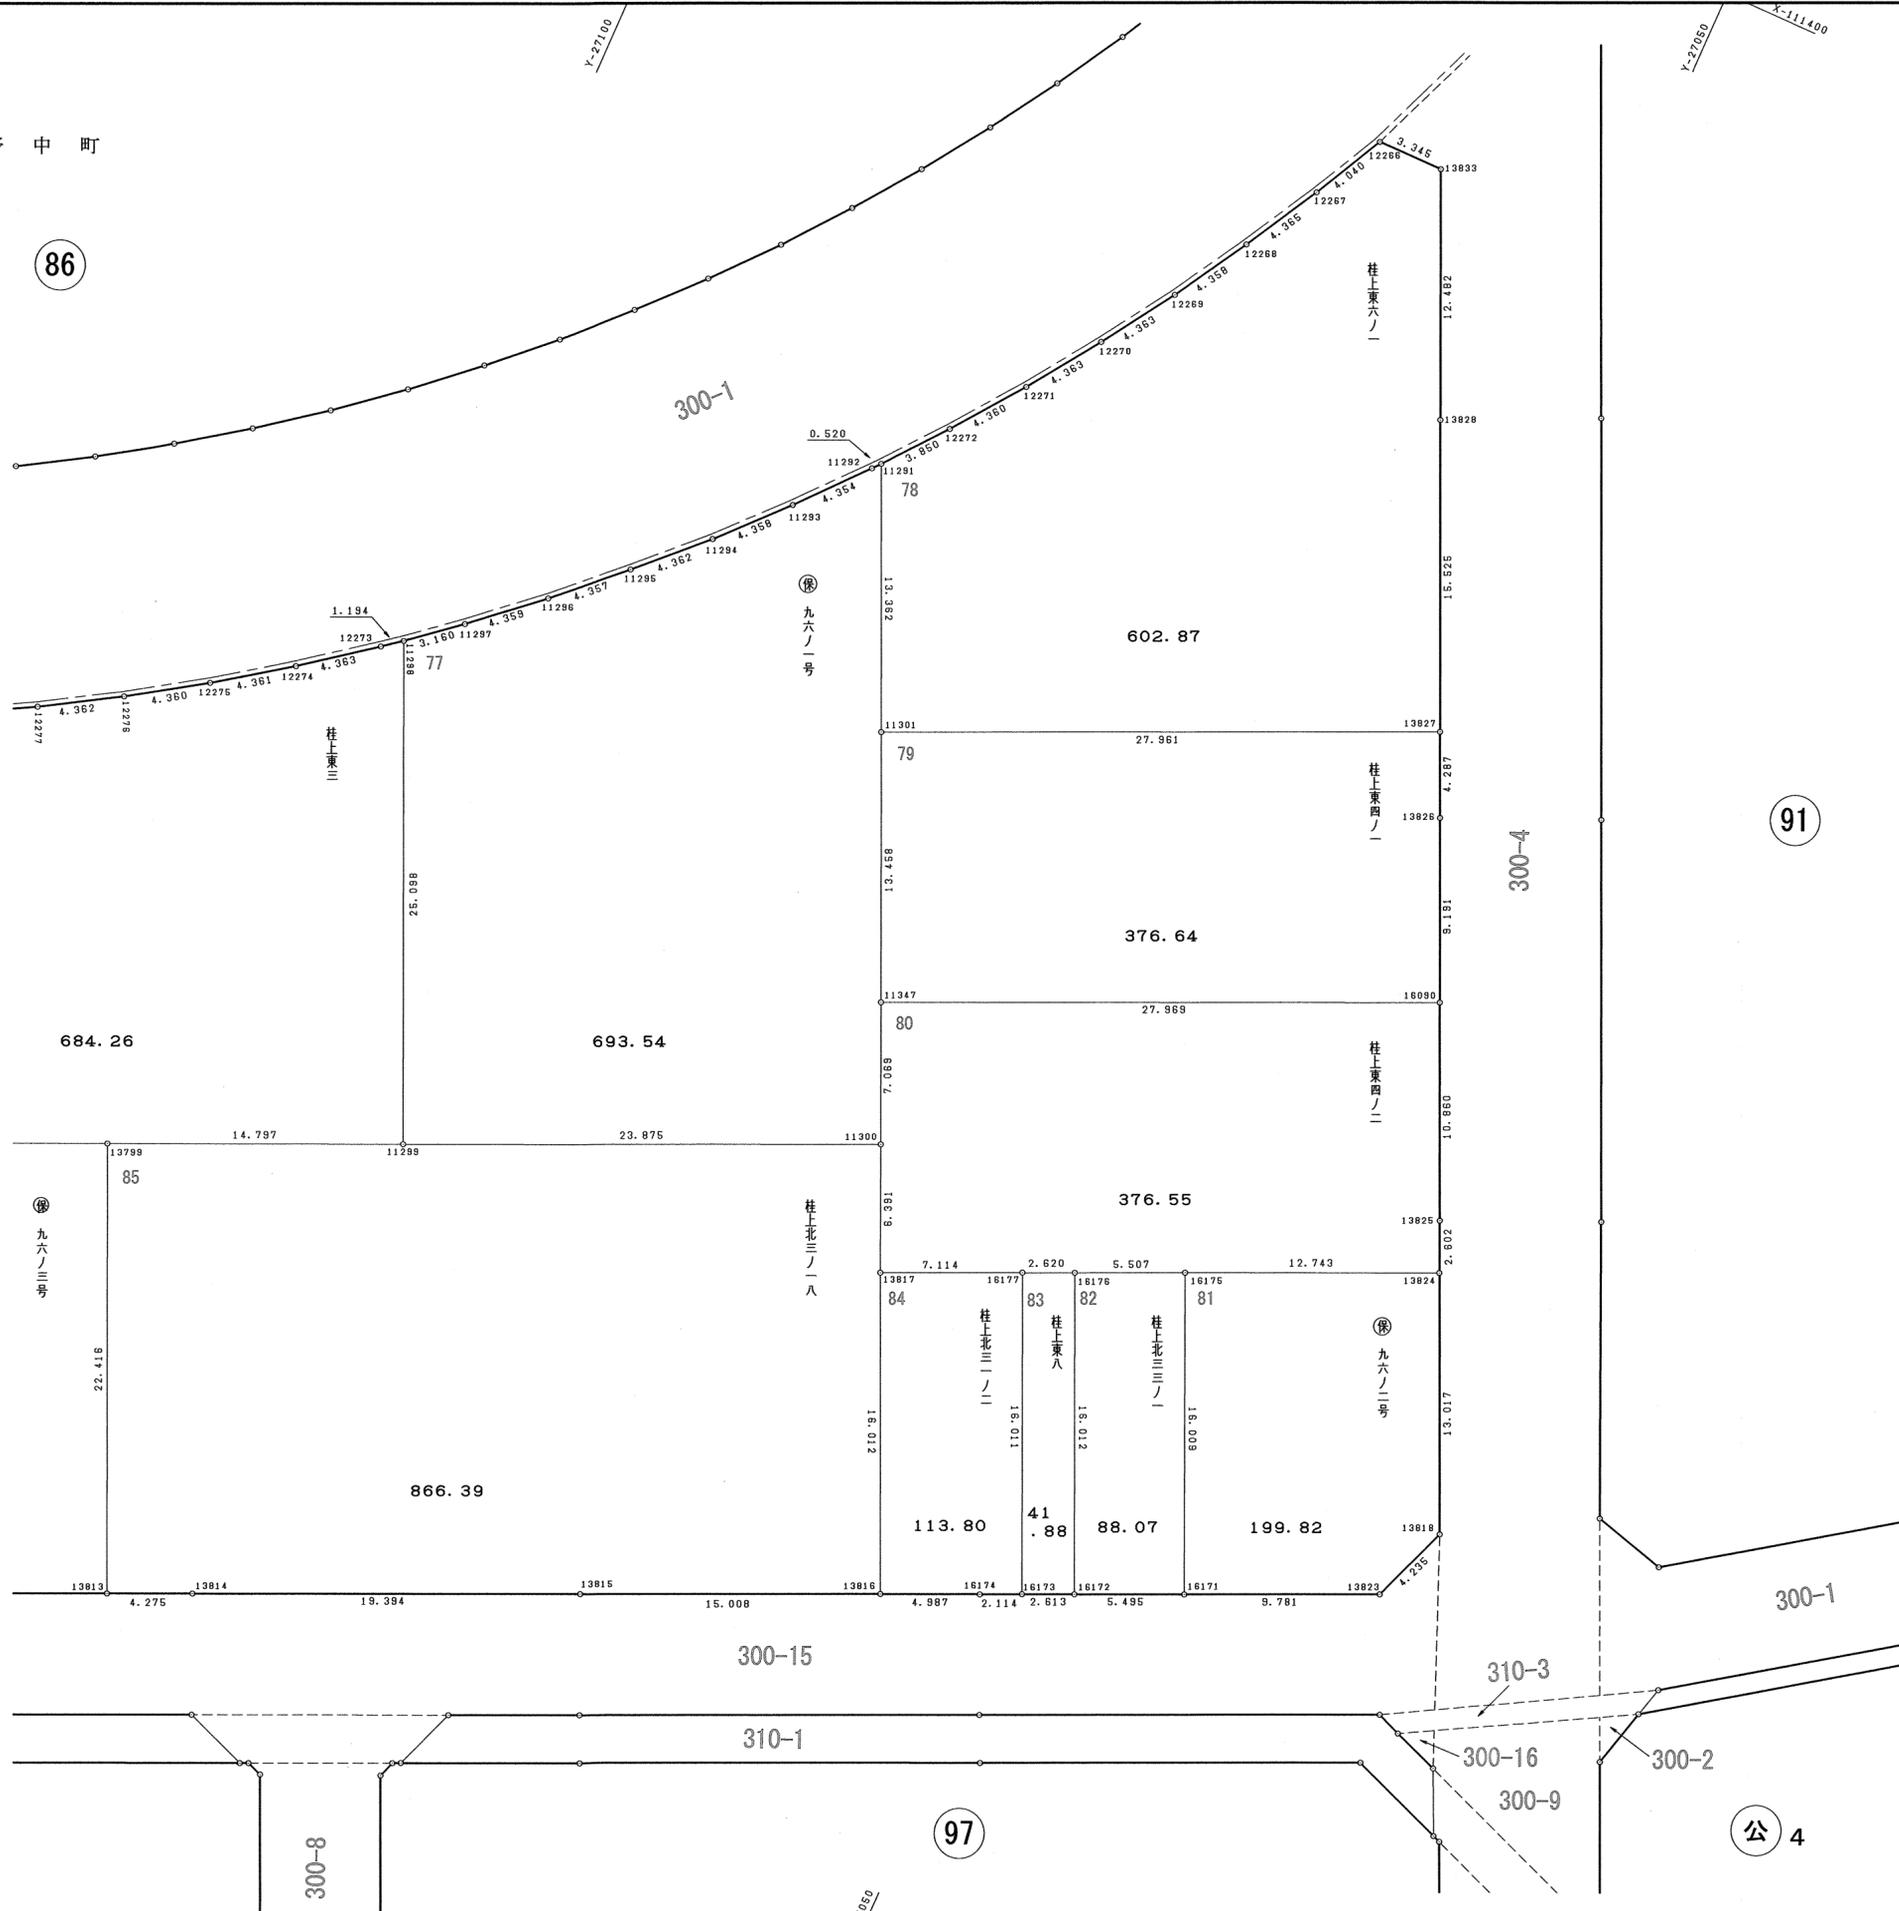

図面の種類	画地出来形確認測量図		
街区番号	96 2/2	番号	縮尺 1:250
町名	桂上野東町		
京都市洛西第二土地区画整理組合			

75

地番 桂上東一ノ一			
NO	X	Y	辺長
13798	-111472.493	-27123.411	
12281	-111477.665	-27134.987	12.679
12282	-111483.787	-27148.676	14.996
12283	-111484.560	-27148.990	0.834
12284	-111484.956	-27148.816	0.433
13802	-111503.300	-27140.603	20.099
13801	-111495.223	-27122.554	19.774
13800	-111491.733	-27114.792	8.511
13798	-111472.493	-27123.411	21.082
面積	596.6330615		
地積	596.63 m ²		

76

地番 桂上東三			
NO	X	Y	辺長
11298	-111456.374	-27097.221	
12273	-111457.127	-27098.147	1.194
12274	-111459.761	-27101.625	4.363
12275	-111462.284	-27105.182	4.361
12276	-111464.662	-27108.837	4.360
12277	-111466.908	-27112.576	4.362
12278	-111469.013	-27116.387	4.354
12279	-111471.010	-27120.273	4.369
12280	-111472.324	-27123.033	3.057
13798	-111472.493	-27123.411	0.414
13800	-111491.733	-27114.792	21.082
13799	-111485.324	-27100.480	15.681
11299	-111479.284	-27086.972	14.797
11298	-111456.374	-27097.221	25.098
面積	684.2612050		
地積	684.26 m ²		

77

地番 保 九六ノ一号			
NO	X	Y	辺長
11291	-111438.604	-27079.034	
11292	-111439.007	-27079.362	0.520
11293	-111442.283	-27082.230	4.354
11294	-111445.475	-27085.197	4.358
11295	-111448.532	-27088.308	4.362
11296	-111451.511	-27091.488	4.357
11297	-111454.380	-27094.770	4.359
11298	-111456.374	-27097.221	3.160
11299	-111479.284	-27086.972	25.098
11300	-111469.532	-27065.179	23.875
11347	-111463.079	-27068.066	7.069
11301	-111450.794	-27073.561	13.458
11291	-111438.604	-27079.034	13.362
面積	693.5458185		
地積	693.54 m ²		

78

地番 桂上東六ノ一			
NO	X	Y	辺長
12266	-111413.799	-27062.826	
12267	-111417.386	-27064.684	4.040
12268	-111421.190	-27066.824	4.365
12269	-111424.927	-27069.066	4.358
12270	-111428.574	-27071.461	4.363
12271	-111432.146	-27073.967	4.363
12272	-111435.619	-27076.603	4.360
11291	-111438.604	-27079.034	3.850
11301	-111450.794	-27073.561	13.362
13827	-111439.355	-27048.047	27.961
13828	-111425.189	-27054.398	15.525
13833	-111413.789	-27059.481	12.482
12266	-111413.799	-27062.826	3.345
面積	602.8791550		
地積	602.87 m ²		

79

地番 桂上東四ノ一			
NO	X	Y	辺長
13827	-111439.355	-27048.047	
11301	-111450.794	-27073.561	27.961
11347	-111463.079	-27068.066	13.458
16090	-111451.655	-27042.536	27.969
13826	-111443.267	-27046.293	9.191
13827	-111439.355	-27048.047	4.287
面積	376.6443135		
地積	376.64 m ²		

80

地番 桂上東四ノ二			
NO	X	Y	辺長
16090	-111451.655	-27042.536	
11347	-111463.079	-27068.066	27.969
11300	-111469.532	-27065.179	7.069
13817	-111475.368	-27062.575	6.391
16177	-111472.463	-27056.081	7.114
16176	-111471.393	-27053.690	2.620
16175	-111469.144	-27048.663	5.507
13824	-111463.940	-27037.031	12.743
13825	-111461.566	-27038.097	2.602
16090	-111451.655	-27042.536	10.860
面積	376.5589595		
地積	376.55 m ²		

81

地番 保 九六ノ二号			
NO	X	Y	辺長
16171	-111483.766	-27042.144	
13823	-111479.769	-27033.217	9.781
13818	-111475.815	-27031.700	4.235
13824	-111463.940	-27037.031	13.017
16175	-111469.144	-27048.663	12.743
16171	-111483.766	-27042.144	16.009
面積	199.8255850		
地積	199.82 m ²		

82

地番 桂上北三三ノ一			
NO	X	Y	辺長
16176	-111471.393	-27053.690	
16172	-111486.012	-27047.159	16.012
16171	-111483.766	-27042.144	5.495
16175	-111469.144	-27048.663	16.009
16176	-111471.393	-27053.690	5.507
面積	88.0744680		
地積	88.07 m ²		

83

地番 桂上東八			
NO	X	Y	辺長
16177	-111472.463	-27056.081	
16173	-111487.079	-27049.544	16.011
16172	-111486.012	-27047.159	2.613
16176	-111471.393	-27053.690	16.012
16177	-111472.463	-27056.081	2.620
面積	41.8881690		
地積	41.88 m ²		

84

地番 桂上北三一ノ二			
NO	X	Y	辺長
13817	-111475.368	-27062.575	
13816	-111489.979	-27056.025	16.012
16174	-111487.943	-27051.473	4.987
16173	-111487.079	-27049.544	2.114
16177	-111472.463	-27056.081	16.011
13817	-111475.368	-27062.575	7.114
面積	113.8003320		
地積	113.80 m ²		

85

地番 桂上北三三ノ一八			
NO	X	Y	辺長
11300	-111469.532	-27065.179	
11299	-111479.284	-27086.972	23.875
13799	-111485.324	-27100.480	14.797
13813	-111505.785	-27091.325	22.416
13814	-111504.034	-27087.425	4.275
13815	-111496.108	-27069.725	19.394
13816	-111489.979	-27056.025	15.008
13817	-111475.368	-27062.575	16.012
11300	-111469.532	-27065.179	6.391
面積	866.3939465		
地積	866.39 m ²		


86

地番 保 九六ノ三号			
NO	X	Y	辺長
13799	-111485.324	-27100.480	
13800	-111491.733	-27114.792	15.681
13801	-111495.223	-27122.554	8.511
13811	-111515.686	-27113.400	22.417
13812	-111512.222	-27105.667	8.473
13813	-111505.785	-27091.325	15.720
13799	-111485.324	-27100.480	22.416
面積	542.4673965		
地積	542.46 m ²		

87

地番 桂上東四A			
NO	X	Y	辺長
13801	-111495.223	-27122.554	
13802	-111503.300	-27140.603	19.774
13810	-111505.054	-27139.818	1.922
13809	-111520.140	-27133.037	16.540
13808	-111521.981	-27128.197	5.178
13807	-111522.147	-27127.824	0.408
13811	-111515.686	-27113.400	15.805
13801	-111495.223	-27122.554	22.417
面積	435.1121835		
地積	435.11 m ²		

図面の種類	画地面積求積表			
街区番号	96	番号	縮尺	
町名	桂上野東町			
京都市洛西第二土地区画整理組合				

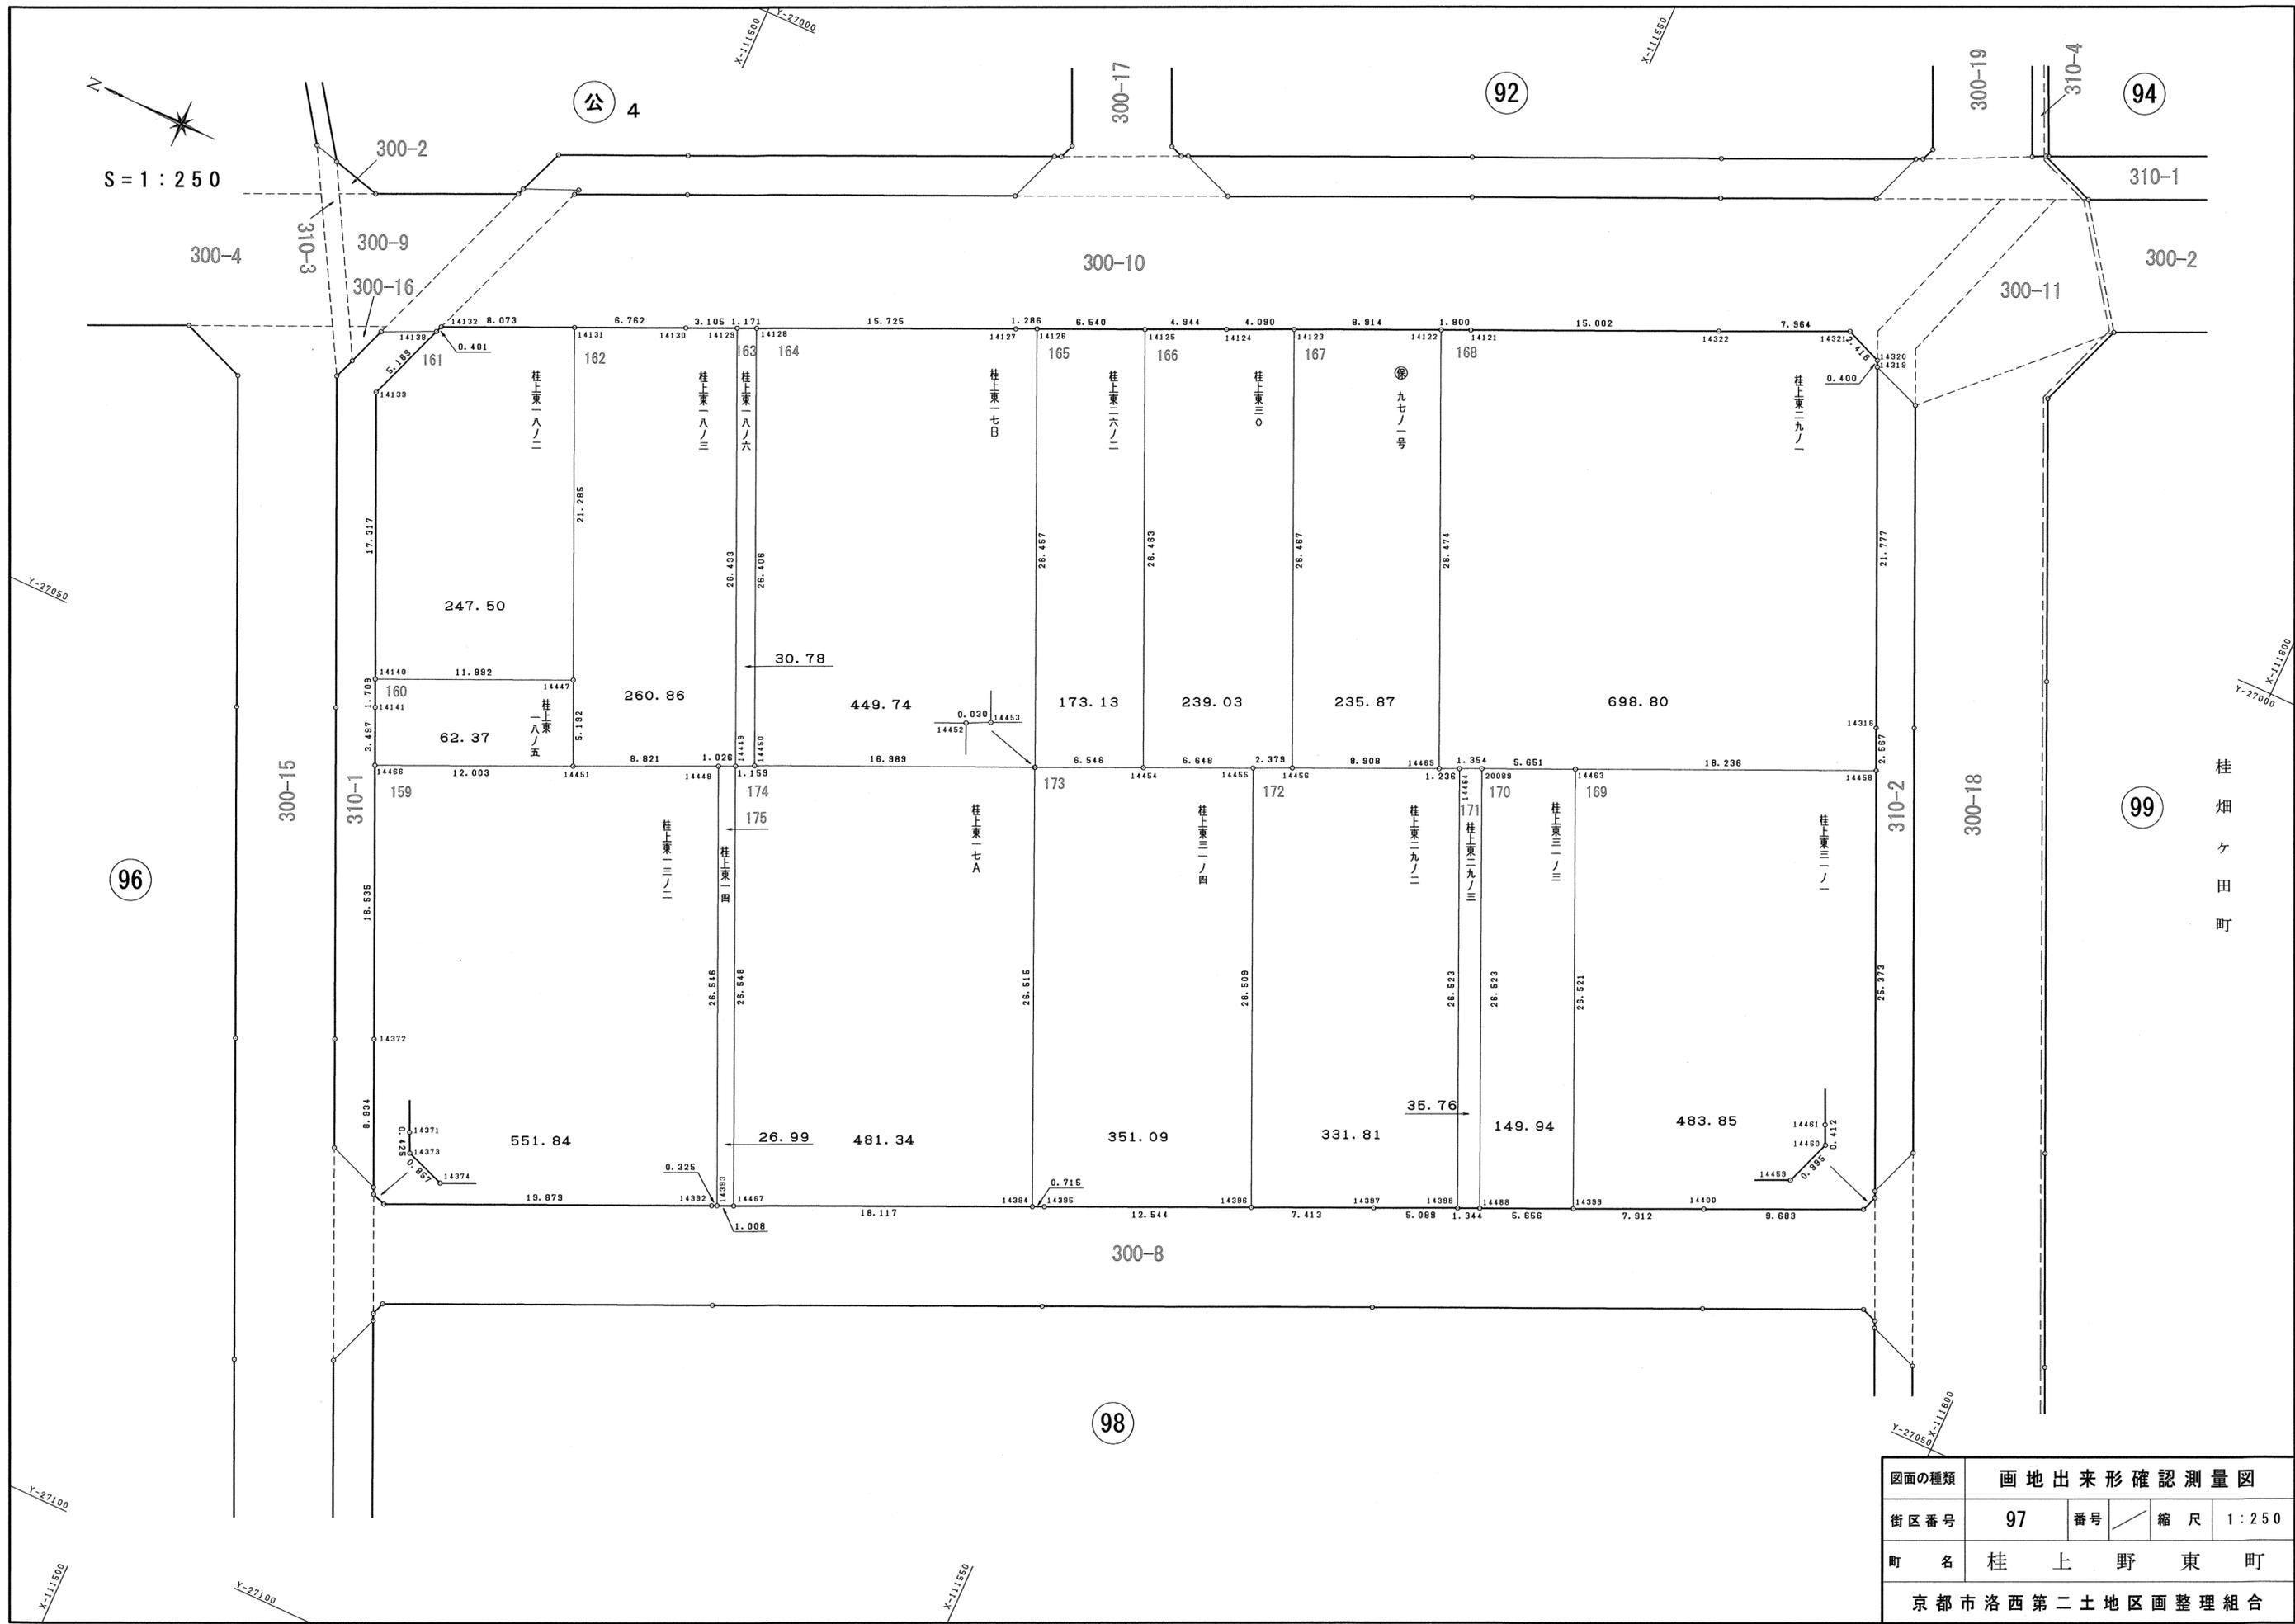

桂畑ヶ田町

図面の種類	画地出来形確認測量図		
街区番号	97	番号	縮尺 1:250
町名	桂上野東町		
京都市洛西第二土地区画整理組合			

159

地番 桂上東一三ノ二			
NO	X	Y	辺長
14466	-111497.042	-27051.217	
14372	-111503.800	-27066.308	16.535
14371	-111507.452	-27074.461	8.934
14373	-111507.635	-27074.845	0.425
14374	-111508.440	-27075.139	0.857
14392	-111526.588	-27067.025	19.879
14393	-111526.885	-27066.892	0.325
14448	-111516.030	-27042.667	26.546
14451	-111507.997	-27046.312	8.821
14466	-111497.042	-27051.217	12.003
面積	551.8433150		
地積	551.84 m ²		

160

地番 桂上東一八ノ五			
NO	X	Y	辺長
14140	-111494.914	-27046.466	
14141	-111495.613	-27048.025	1.709
14466	-111497.042	-27051.217	3.497
14451	-111507.997	-27046.312	12.003
14447	-111505.865	-27041.578	5.192
14140	-111494.914	-27046.466	11.992
面積	62.3724490		
地積	62.37 m ²		

161

地番 桂上東一八ノ二			
NO	X	Y	辺長
14139	-111487.825	-27030.666	
14140	-111494.914	-27046.466	17.317
14447	-111505.865	-27041.578	11.992
14131	-111497.160	-27022.154	21.285
14132	-111489.793	-27025.456	8.073
14138	-111489.647	-27025.829	0.401
14139	-111487.825	-27030.666	5.169
面積	247.5035810		
地積	247.50 m ²		

162

地番 桂上東一八ノ三			
NO	X	Y	辺長
14131	-111497.160	-27022.154	
14447	-111505.865	-27041.578	21.285
14451	-111507.997	-27046.312	5.192
14448	-111516.030	-27042.667	8.821
14449	-111516.966	-27042.247	1.026
14129	-111506.165	-27018.121	26.433
14130	-111503.330	-27019.388	3.105
14131	-111497.160	-27022.154	6.762
面積	260.8647140		
地積	260.86 m ²		

163

地番 桂上東一八ノ六			
NO	X	Y	辺長
14129	-111506.165	-27018.121	
14449	-111516.966	-27042.247	26.433
14450	-111518.013	-27041.749	1.159
14128	-111507.234	-27017.643	26.406
14129	-111506.165	-27018.121	1.171
面積	30.7802480		
地積	30.78 m ²		

164

地番 桂上東一七B			
NO	X	Y	辺長
14128	-111507.234	-27017.643	
14450	-111518.013	-27041.749	26.406
14452	-111533.544	-27034.864	16.989
14453	-111533.571	-27034.851	0.030
14126	-111522.765	-27010.701	26.457
14127	-111521.591	-27011.227	1.286
14128	-111507.234	-27017.643	15.725
面積	449.7401010		
地積	449.74 m ²		

165

地番 桂上東二六ノ二			
NO	X	Y	辺長
14126	-111522.765	-27010.701	
14453	-111533.571	-27034.851	26.457
14454	-111539.547	-27032.179	6.546
14125	-111528.733	-27008.026	26.463
14126	-111522.765	-27010.701	6.540
面積	173.1332930		
地積	173.13 m ²		

166

地番 桂上東三〇			
NO	X	Y	辺長
14125	-111528.733	-27008.026	
14454	-111539.547	-27032.179	26.463
14455	-111545.618	-27029.470	6.648
14456	-111547.786	-27028.490	2.379
14123	-111536.977	-27004.331	26.467
14124	-111533.245	-27006.004	4.090
14125	-111528.733	-27008.026	4.944
面積	239.0347300		
地積	239.03 m ²		

167

地番 保 九七ノ一			
NO	X	Y	辺長
14123	-111536.977	-27004.331	
14456	-111547.786	-27028.490	26.467
14465	-111555.918	-27024.853	8.908
14122	-111545.111	-27000.685	26.474
14123	-111536.977	-27004.331	8.914
面積	235.8790775		
地積	235.87 m ²		

168

地番 桂上東二九ノ一			
NO	X	Y	辺長
14122	-111545.111	-27000.685	
14465	-111555.918	-27024.853	26.474
14464	-111557.043	-27024.340	1.236
20089	-111558.278	-27023.786	1.354
14463	-111563.435	-27021.475	5.651
14458	-111580.087	-27014.040	18.236
14316	-111579.036	-27011.698	2.567
14319	-111570.119	-26991.830	21.777
14320	-111569.952	-26991.466	0.400
14321	-111567.713	-26990.559	2.416
14322	-111560.452	-26993.831	7.964
14121	-111546.754	-26999.949	15.002
14122	-111545.111	-27000.685	1.800
面積	698.8017725		
地積	698.80 m ²		

169

地番 桂上東三一ノ一			
NO	X	Y	辺長
14463	-111563.435	-27021.475	
14399	-111574.244	-27045.693	26.521
14400	-111581.463	-27042.456	7.912
14459	-111590.298	-27038.494	9.683
14460	-111590.650	-27037.563	0.995
14461	-111590.476	-27037.189	0.412
14458	-111580.087	-27014.040	25.373
14463	-111563.435	-27021.475	18.236
面積	483.8555740		
地積	483.85 m ²		

170

地番 桂上東三一ノ三			
NO	X	Y	辺長
14488	-111569.083	-27048.008	
14399	-111574.244	-27045.693	5.656
14463	-111563.435	-27021.475	26.521
20089	-111558.278	-27023.786	5.651
14488	-111569.083	-27048.008	26.523
面積	149.9475710		
地積	149.94 m ²		

171

地番 桂上東二九ノ三			
NO	X	Y	辺長
14488	-111569.083	-27048.008	
20089	-111558.278	-27023.786	26.523
14464	-111557.043	-27024.340	1.354
14398	-111567.857	-27048.558	26.523
14488	-111569.083	-27048.008	1.344
面積	35.7695540		
地積	35.76 m ²		

172

地番 桂上東二九ノ二			
NO	X	Y	辺長
14455	-111545.618	-27029.470	
14396	-111556.446	-27053.667	26.509
14397	-111563.213	-27050.640	7.413
14398	-111567.857	-27048.558	5.089
14464	-111557.043	-27024.340	26.523
14465	-111555.918	-27024.853	1.236
14456	-111547.786	-27028.490	8.908
14455	-111545.618	-27029.470	2.379
面積	331.8123820		
地積	331.81 m ²		

173

地番 桂上東三一ノ四			
NO	X	Y	辺長
14452	-111533.544	-27034.864	
14394	-111544.342	-27059.081	26.515
14395	-111544.995	-27058.789	0.715
14396	-111556.446	-27053.667	12.544
14455	-111545.618	-27029.470	26.509
14454	-111539.547	-27032.179	6.648
14453	-111533.571	-27034.851	6.546
14452	-111533.544	-27034.864	0.030
面積	351.0943880		
地積	351.09 m ²		

174

地番 桂上東一七A			
NO	X	Y	辺長
14449	-111516.966	-27042.247	
14467	-111527.805	-27066.481	26.548
14394	-111544.342	-27059.081	18.117
14452	-111533.544	-27034.864	26.515
14450	-111518.013	-27041.749	16.989
14449	-111516.966	-27042.247	1.159
面積	481.3415805		
地積	481.34 m ²		


175

地番 桂上東一四			
NO	X	Y	辺長
14448	-111516.030	-27042.667	
14393	-111526.885	-27066.892	26.546
14467	-111527.805	-27066.481	1.008
14449	-111516.966	-27042.247	26.548
14448	-111516.030	-27042.667	1.026
面積	26.9919045		
地積	26.99 m ²		

図面の種類	画地面積求積表		
街区番号	97	番号	縮尺
町名	桂上野東町		
京都市洛西第二土地区画整理組合			



S = 1 : 250

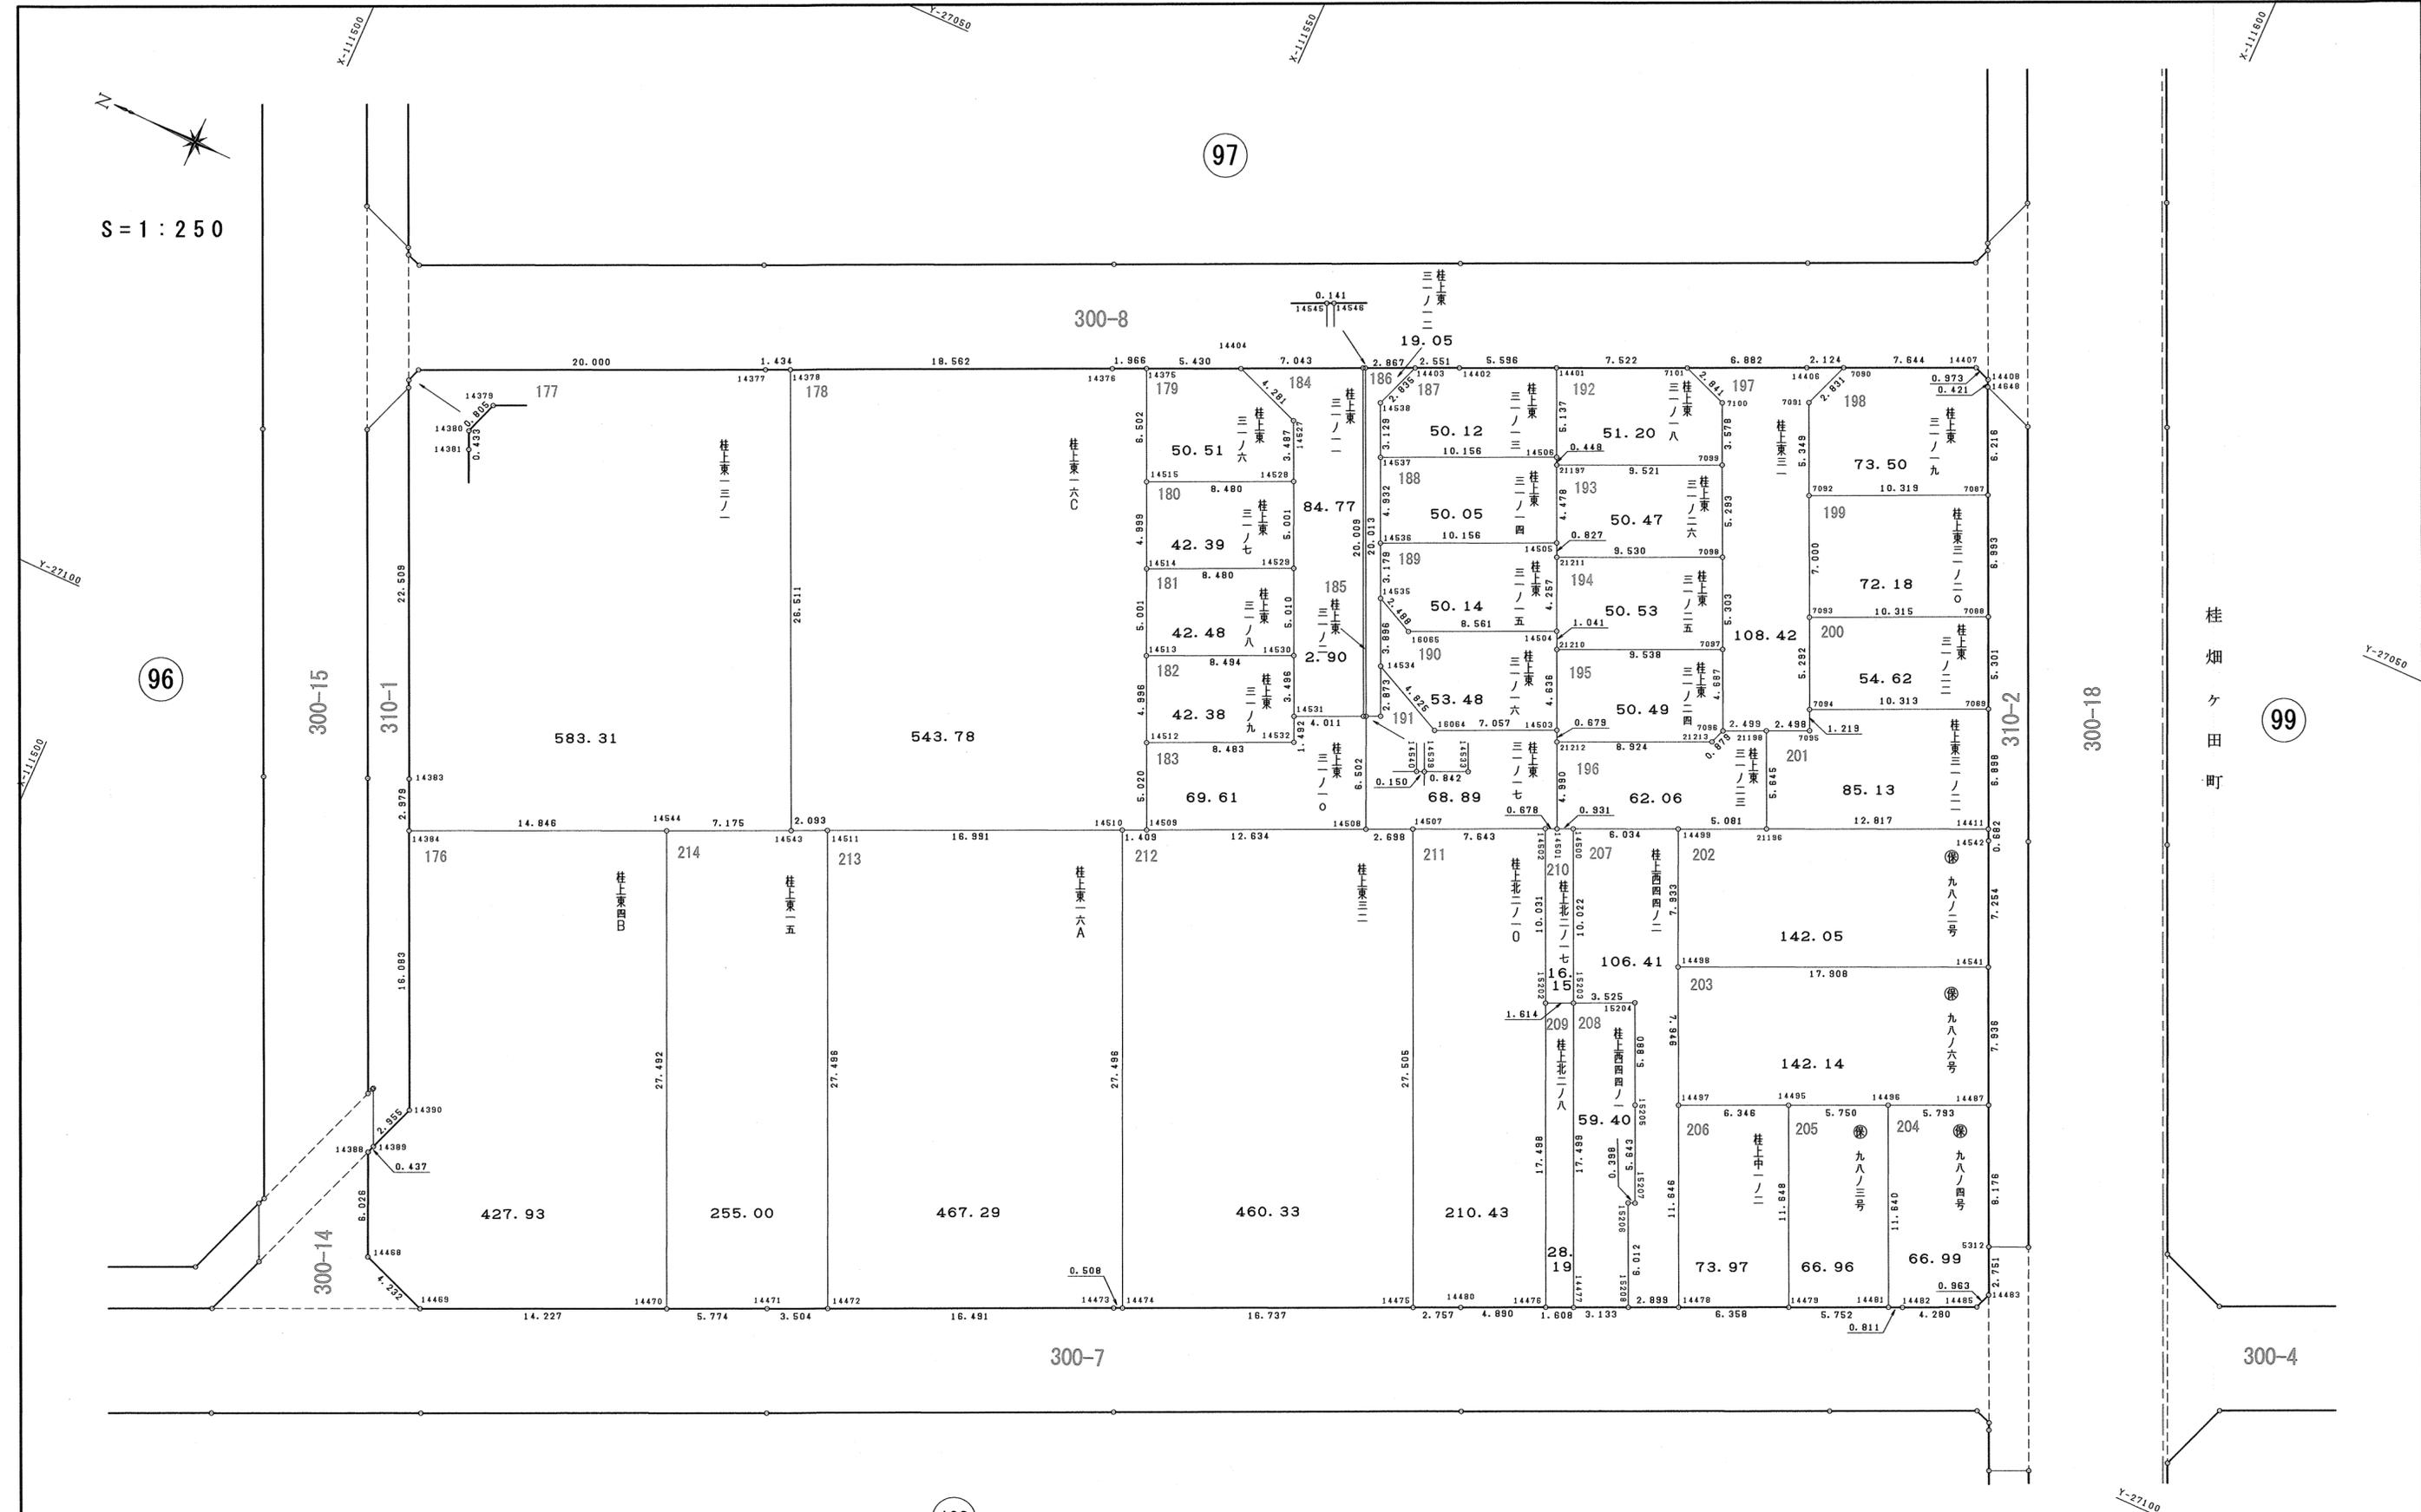

96

97

99

102

図面の種類	画地出来形確認測量図		
街区番号	98	番号	縮尺 1:250
町名	桂上野東町		
京都市洛西第二土地区画整理組合			

176

Table with 4 columns: NO, X, Y, 辺長. Title: 桂上東四B. Includes area and ground area calculations.

177

Table with 4 columns: NO, X, Y, 辺長. Title: 桂上東一三ノ一. Includes area and ground area calculations.

178

Table with 4 columns: NO, X, Y, 辺長. Title: 桂上東一六C. Includes area and ground area calculations.

179

Table with 4 columns: NO, X, Y, 辺長. Title: 桂上東三ノ一六. Includes area and ground area calculations.

180

Table with 4 columns: NO, X, Y, 辺長. Title: 桂上東三ノ一七. Includes area and ground area calculations.

181

Table with 4 columns: NO, X, Y, 辺長. Title: 桂上東三ノ一八. Includes area and ground area calculations.

182

Table with 4 columns: NO, X, Y, 辺長. Title: 桂上東三ノ一九. Includes area and ground area calculations.

183

Table with 4 columns: NO, X, Y, 辺長. Title: 桂上東三ノ一〇. Includes area and ground area calculations.

184

Table with 4 columns: NO, X, Y, 辺長. Title: 桂上東三ノ一一. Includes area and ground area calculations.

185

Table with 4 columns: NO, X, Y, 辺長. Title: 桂上東三ノ一二. Includes area and ground area calculations.

186

Table with 4 columns: NO, X, Y, 辺長. Title: 桂上東三ノ一三. Includes area and ground area calculations.

187

Table with 4 columns: NO, X, Y, 辺長. Title: 桂上東三ノ一四. Includes area and ground area calculations.

188

Table with 4 columns: NO, X, Y, 辺長. Title: 桂上東三ノ一五. Includes area and ground area calculations.

189

Table with 4 columns: NO, X, Y, 辺長. Title: 桂上東三ノ一六. Includes area and ground area calculations.

190

Table with 4 columns: NO, X, Y, 辺長. Title: 桂上東三ノ一七. Includes area and ground area calculations.

199

Table with 4 columns: NO, X, Y, 辺長. Title: 桂上東三ノ二五. Includes area and ground area calculations.

200

Table with 4 columns: NO, X, Y, 辺長. Title: 桂上東三ノ二六. Includes area and ground area calculations.

201

Table with 4 columns: NO, X, Y, 辺長. Title: 桂上東三ノ二七. Includes area and ground area calculations.

202

Table with 4 columns: NO, X, Y, 辺長. Title: 保九八ノ二号. Includes area and ground area calculations.

203

Table with 4 columns: NO, X, Y, 辺長. Title: 保九八ノ六号. Includes area and ground area calculations.

Summary table with columns: 図面の種類, 画地面積求積表, 街区番号, 番号, 縮尺, 町名, 京都市洛西第二土地区画整理組合.

204

地番 保 九八ノ四号			
NO	X	Y	辺長
14496	-111605.446	-27084.765	
14481	-111610.210	-27095.385	11.640
14482	-111610.950	-27095.054	0.811
14485	-111614.843	-27093.276	4.280
14483	-111615.186	-27092.376	0.963
5312	-111614.069	-27089.862	2.751
14487	-111610.733	-27082.398	8.176
14496	-111605.446	-27084.765	5.793
面積	66.9983995		
地積	66.99 m ²		

205

地番 保 九八ノ三号			
NO	X	Y	辺長
14495	-111600.192	-27087.102	
14479	-111604.958	-27097.730	11.648
14481	-111610.210	-27095.385	5.752
14496	-111605.446	-27084.765	11.640
14495	-111600.192	-27087.102	5.750
面積	66.9627370		
地積	66.96 m ²		

206

地番 桂上中一ノ二			
NO	X	Y	辺長
14497	-111594.399	-27089.692	
14478	-111599.153	-27100.323	11.646
14479	-111604.958	-27097.730	6.358
14495	-111600.192	-27087.102	11.648
14497	-111594.399	-27089.692	6.346
面積	73.9760105		
地積	73.97 m ²		

207

地番 桂上西四四ノ二			
NO	X	Y	辺長
15203	-111586.506	-27086.806	
15204	-111589.714	-27085.344	3.525
15205	-111592.115	-27090.711	5.880
15206	-111594.419	-27095.862	5.643
15207	-111594.052	-27096.017	0.398
15208	-111596.506	-27101.505	6.012
14478	-111599.153	-27100.323	2.899
14497	-111594.399	-27089.692	11.646
14498	-111591.138	-27082.446	7.946
14499	-111587.910	-27075.199	7.933
14500	-111582.402	-27077.663	6.034
15203	-111586.506	-27086.806	10.022
面積	106.4165250		
地積	106.41 m ²		

208

地番 桂上西四四ノ一			
NO	X	Y	辺長
15203	-111586.506	-27086.806	
14477	-111593.645	-27102.783	17.499
15208	-111596.506	-27101.505	3.133
15207	-111594.052	-27096.017	6.012
15206	-111594.419	-27095.862	0.398
15205	-111592.115	-27090.711	5.643
15204	-111589.714	-27085.344	5.880
15203	-111586.506	-27086.806	3.525
面積	59.4074985		
地積	59.40 m ²		

209

地番 桂上北二ノ八			
NO	X	Y	辺長
15202	-111585.033	-27087.466	
14476	-111592.177	-27103.439	17.498
14477	-111593.645	-27102.783	1.608
15203	-111586.506	-27086.806	17.499
15202	-111585.033	-27087.466	1.614
面積	28.1903445		
地積	28.19 m ²		

210

地番 桂上北二ノ一七			
NO	X	Y	辺長
15202	-111585.033	-27087.466	
15203	-111586.506	-27086.806	1.614
14500	-111582.402	-27077.663	10.022
14501	-111581.549	-27078.035	0.931
14502	-111580.930	-27078.312	0.678
15202	-111585.033	-27087.466	10.031
面積	16.1599135		
地積	16.15 m ²		

211

地番 桂上北二ノ一〇			
NO	X	Y	辺長
14507	-111573.962	-27081.452	
14475	-111585.195	-27106.559	27.505
14480	-111587.712	-27105.433	2.757
14476	-111592.177	-27103.439	4.890
15202	-111585.033	-27087.466	17.498
14502	-111580.930	-27078.312	10.031
14507	-111573.962	-27081.452	7.643
面積	210.4384505		
地積	210.43 m ²		

212

地番 桂上東三二			
NO	X	Y	辺長
14510	-111558.684	-27088.297	
14474	-111569.917	-27113.394	27.496
14475	-111585.195	-27106.559	16.737
14507	-111573.962	-27081.452	27.505
14508	-111571.500	-27082.556	2.698
14509	-111559.970	-27087.721	12.634
14510	-111558.684	-27088.297	1.409
面積	460.3343600		
地積	460.33 m ²		


213

地番 桂上東一六A			
NO	X	Y	辺長
14511	-111543.176	-27095.239	
14472	-111554.401	-27120.339	27.496
14473	-111569.453	-27113.602	16.491
14474	-111569.917	-27113.394	0.508
14510	-111558.684	-27088.297	27.496
14511	-111543.176	-27095.239	16.991
面積	467.2989175		
地積	467.29 m ²		

214

地番 桂上東一五			
NO	X	Y	辺長
14544	-111534.717	-27099.026	
14470	-111545.931	-27124.127	27.492
14471	-111551.203	-27121.771	5.774
14472	-111554.401	-27120.339	3.504
14511	-111543.176	-27095.239	27.496
14543	-111541.262	-27096.087	2.093
14544	-111534.717	-27099.026	7.175
面積	255.0020895		
地積	255.00 m ²		

図面の種類	画地面積求積表		
街区番号	98	番号	2/2 縮尺
町名	桂上野東町		
京都市洛西第二土地区画整理組合			

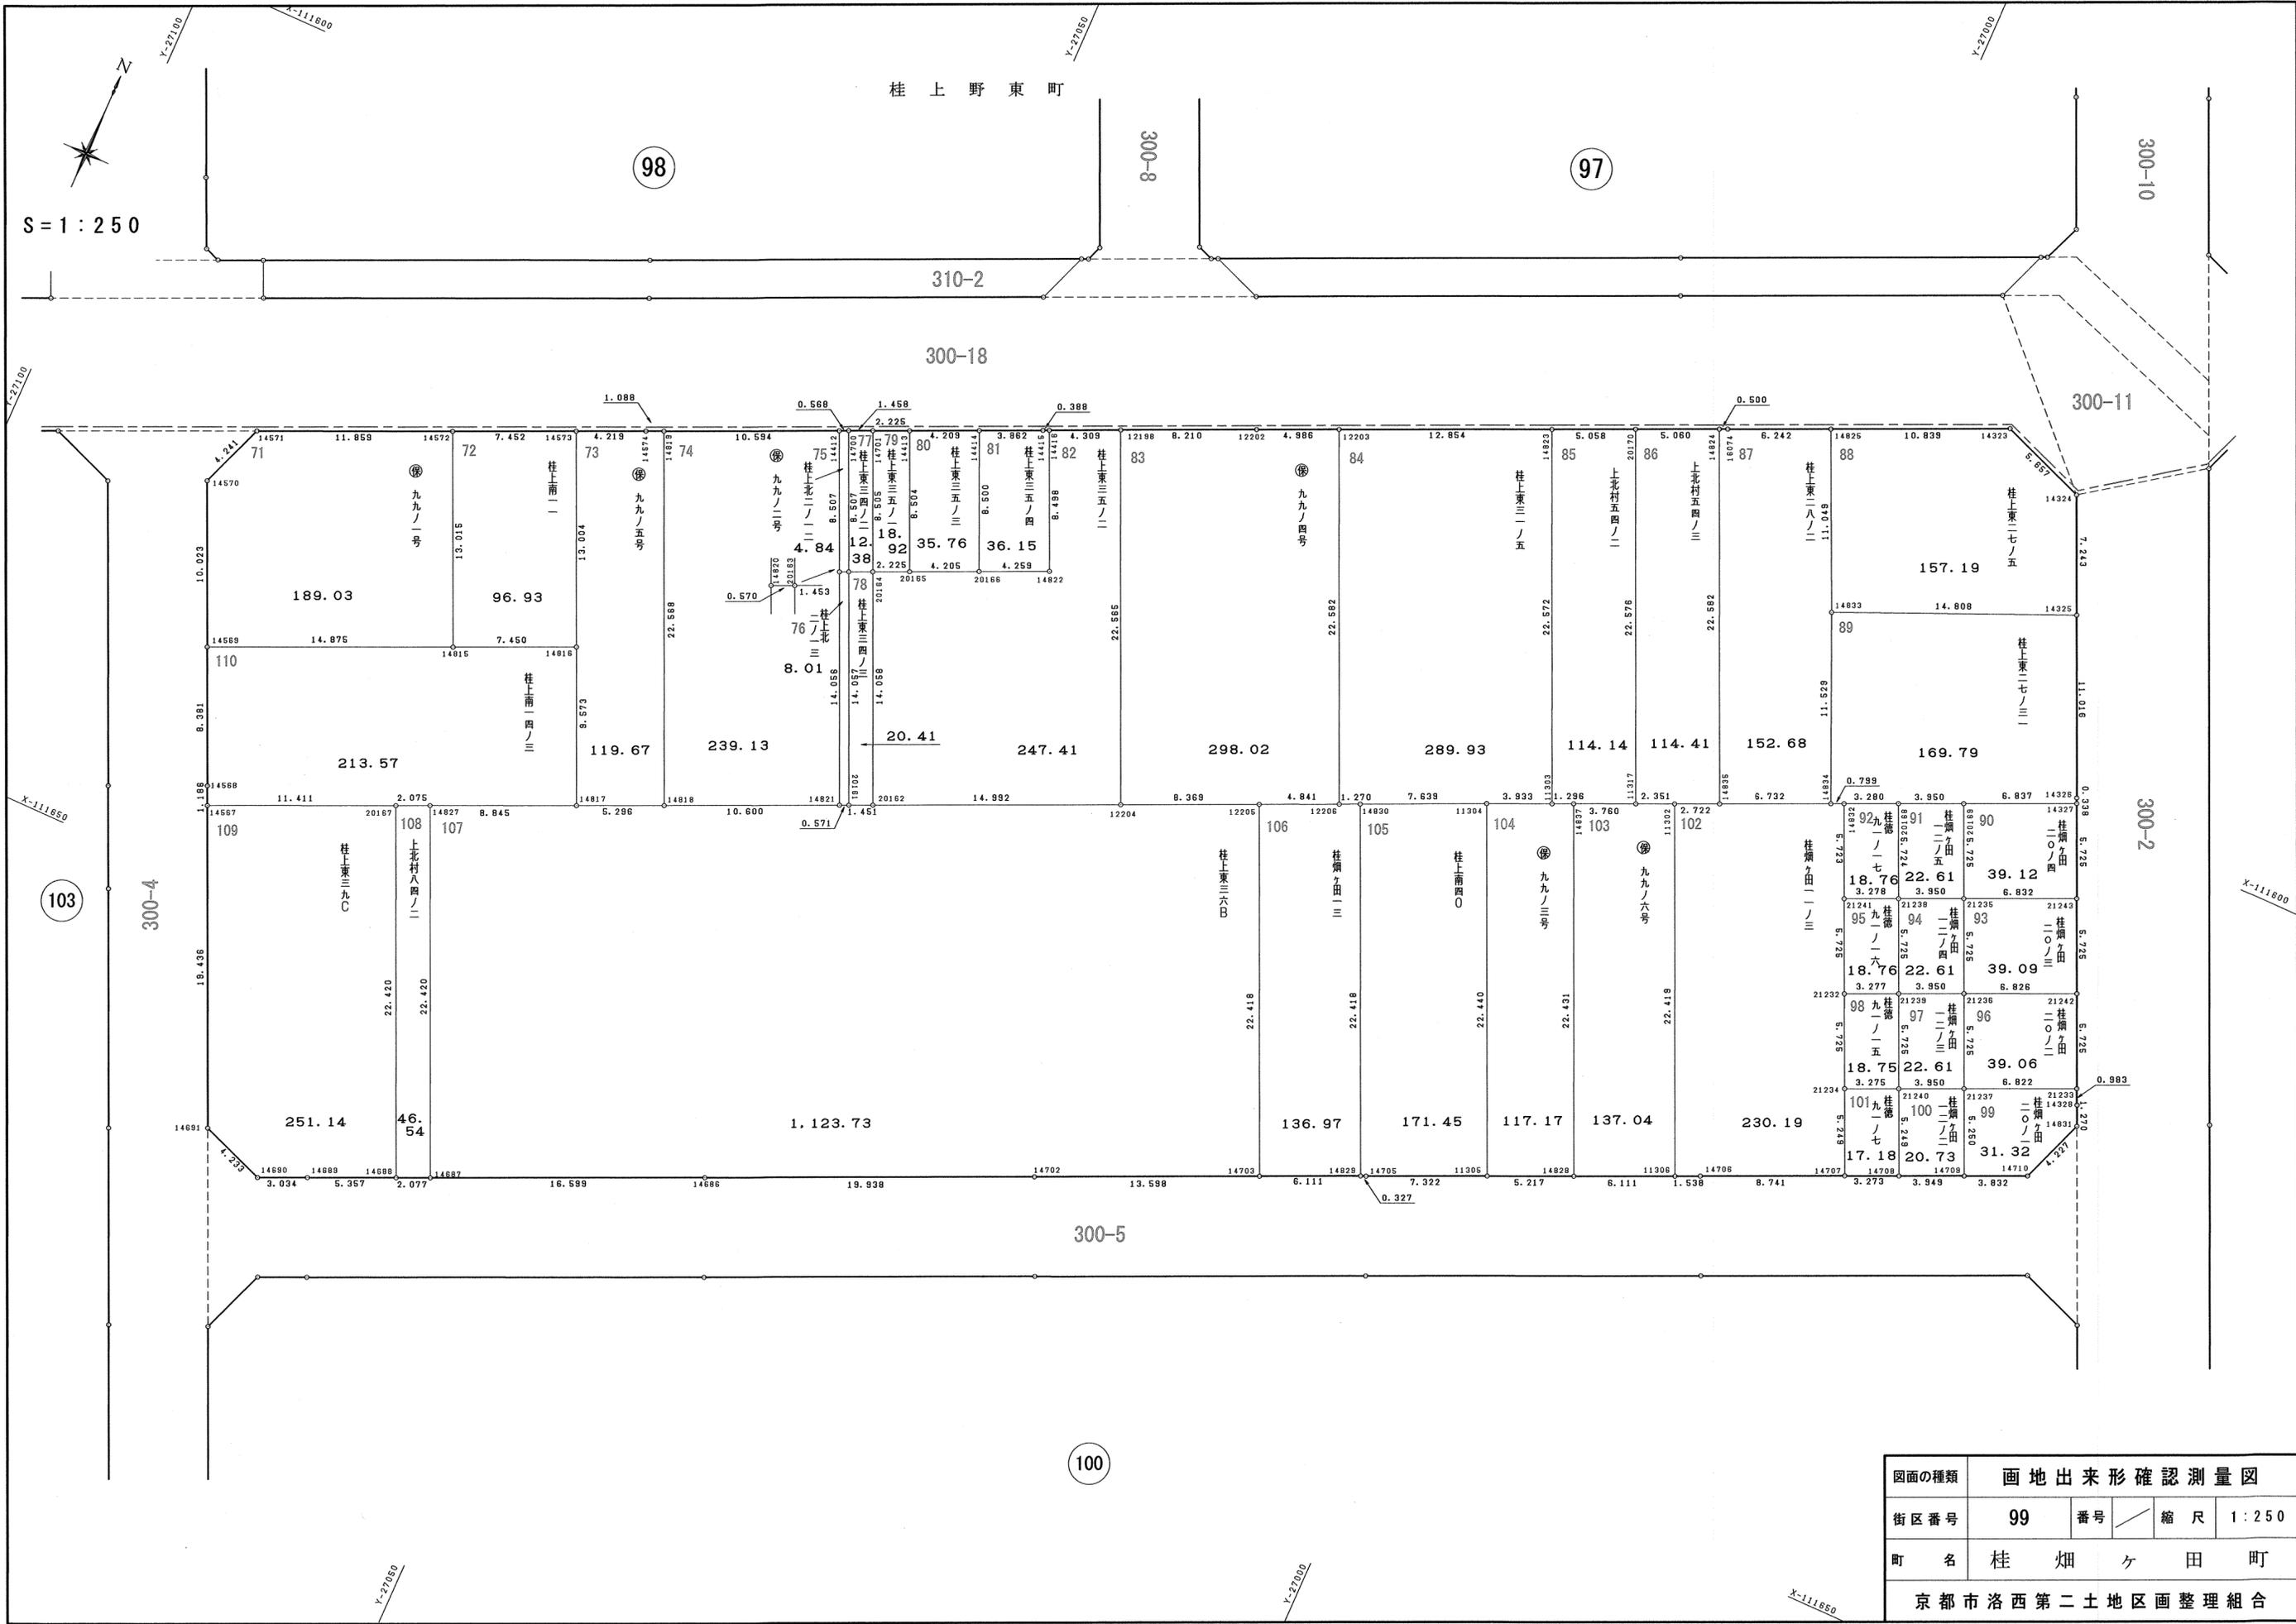

S = 1 : 250

図面の種類	画地出来形確認測量図		
街区番号	99	番号	縮尺 1:250
町名	桂畑ヶ田町		
京都市洛西第二土地区画整理組合			

71

地番 保九九ノ一号			
NO	X	Y	辺長
14572	-111618.797	-27075.202	
14571	-111623.637	-27086.028	11.859
14570	-111627.595	-27087.551	4.241
14569	-111636.745	-27083.460	10.023
14815	-111630.674	-27069.880	14.875
14572	-111618.797	-27075.202	13.015
面積	189.0317390		
地積	189.03 m ²		

72

地番 桂上南一一			
NO	X	Y	辺長
14573	-111615.756	-27068.399	
14572	-111618.797	-27075.202	7.452
14815	-111630.674	-27069.880	13.015
14816	-111627.624	-27063.083	7.450
14573	-111615.756	-27068.399	13.004
面積	96.9320145		
地積	96.93 m ²		

73

地番 保九九ノ五号			
NO	X	Y	辺長
14819	-111613.590	-27063.554	
14574	-111614.034	-27064.547	1.088
14573	-111615.756	-27068.399	4.219
14816	-111627.624	-27063.083	13.004
14817	-111636.360	-27059.169	9.573
14818	-111634.190	-27054.338	5.296
14819	-111613.590	-27063.554	22.568
面積	119.6731570		
地積	119.67 m ²		

74

地番 保九九ノ二号			
NO	X	Y	辺長
14412	-111609.262	-27053.884	
14819	-111613.590	-27063.554	10.594
14818	-111634.190	-27054.338	22.568
14821	-111629.856	-27044.665	10.600
14820	-111617.026	-27050.407	14.056
14412	-111609.262	-27053.884	8.507
面積	239.1393890		
地積	239.13 m ²		

75

地番 桂上北二ノ一二			
NO	X	Y	辺長
14412	-111609.262	-27053.884	
14820	-111617.026	-27050.407	8.507
20163	-111616.793	-27049.887	0.570
14700	-111609.030	-27053.365	8.507
14412	-111609.262	-27053.884	0.568
面積	4.8416570		
地積	4.84 m ²		

76

地番 桂上北二ノ一三			
NO	X	Y	辺長
14820	-111617.026	-27050.407	
14821	-111629.856	-27044.665	14.056
20161	-111629.623	-27044.144	0.571
20163	-111616.793	-27049.887	14.057
14820	-111617.026	-27050.407	0.570
面積	8.0160175		
地積	8.01 m ²		

77

地番 桂上東三四ノ二			
NO	X	Y	辺長
14700	-111609.030	-27053.365	
20163	-111616.793	-27049.887	8.507
20164	-111616.198	-27048.561	1.453
14701	-111608.434	-27052.034	8.505
14700	-111609.030	-27053.365	1.458
面積	12.3834700		
地積	12.38 m ²		

78

地番 桂上東三四ノ三			
NO	X	Y	辺長
20163	-111616.793	-27049.887	
20161	-111629.623	-27044.144	14.057
20162	-111629.030	-27042.820	1.451
20164	-111616.198	-27048.561	14.058
20163	-111616.793	-27049.887	1.453
面積	20.4118230		
地積	20.41 m ²		

79

地番 桂上東三五ノ一			
NO	X	Y	辺長
14413	-111607.525	-27050.003	
14701	-111608.434	-27052.034	2.225
20164	-111616.198	-27048.561	8.505
20165	-111615.288	-27046.531	2.225
14413	-111607.525	-27050.003	8.504
面積	18.9220255		
地積	18.92 m ²		

80

地番 桂上東三五ノ三			
NO	X	Y	辺長
14414	-111605.806	-27046.161	
14413	-111607.525	-27050.003	4.209
20165	-111615.288	-27046.531	8.504
20166	-111613.567	-27042.694	4.205
14414	-111605.806	-27046.161	8.500
面積	35.7697390		
地積	35.76 m ²		

81

地番 桂上東三五ノ四			
NO	X	Y	辺長
14416	-111604.069	-27042.282	
14415	-111604.228	-27042.636	0.388
14414	-111605.806	-27046.161	3.862
20166	-111613.567	-27042.694	8.500
14822	-111611.824	-27038.808	4.259
14416	-111604.069	-27042.282	8.498
面積	36.1581735		
地積	36.15 m ²		

82

地番 桂上東三五ノ二			
NO	X	Y	辺長
12198	-111602.302	-27038.352	
14416	-111604.069	-27042.282	4.309
14822	-111611.824	-27038.808	8.498
20166	-111613.567	-27042.694	4.259
20165	-111615.288	-27046.531	4.205
20164	-111616.198	-27048.561	2.225
20162	-111629.030	-27042.820	14.058
12204	-111622.900	-27029.138	14.892
12198	-111602.302	-27038.352	22.565
面積	247.4102955		
地積	247.41 m ²		

83

地番 保九九ノ四号			
NO	X	Y	辺長
12198	-111602.302	-27038.352	
12204	-111622.900	-27029.138	22.565
12205	-111619.476	-27021.502	8.369
12206	-111617.503	-27017.081	4.841
12203	-111596.895	-27026.314	22.582
12202	-111598.935	-27030.864	4.886
12198	-111602.302	-27038.352	8.210
面積	298.0263165		
地積	298.02 m ²		

84

地番 桂上東三一ノ五			
NO	X	Y	辺長
14823	-111591.637	-27014.585	
12203	-111596.895	-27026.314	12.854
12206	-111617.503	-27017.081	22.582
14830	-111616.977	-27015.925	1.270
11304	-111613.834	-27008.962	
11303	-111612.240	-27005.366	3.933
14823	-111591.637	-27014.585	22.572
面積	289.9304100		
地積	289.93 m ²		

85

地番 上北村五四ノ二			
NO	X	Y	辺長
20170	-111589.568	-27009.970	
14823	-111591.637	-27014.585	5.058
11303	-111612.240	-27005.366	22.572
14837	-111611.706	-27004.185	1.286
11317	-111610.176	-27000.750	3.760
20170	-111589.568	-27009.970	22.576
面積	114.1431020		
地積	114.14 m ²		

86

地番 上北村五四ノ三			
NO	X	Y	辺長
14824	-111587.499	-27005.352	
20170	-111589.568	-27009.970	5.060
11317	-111610.176	-27000.750	22.576
11302	-111609.220	-26998.602	2.351
14835	-111608.107	-26996.118	2.722
14824	-111587.499	-27005.352	22.582
面積	114.4106730		
地積	114.41 m ²		

87

地番 桂上東二八ノ二			
NO	X	Y	辺長
14825	-111584.741	-26999.200	
16074	-111587.294	-27004.896	6.242
14824	-111587.499	-27005.352	0.500
14835	-111608.107	-26996.118	22.582
14834	-111605.349	-26989.977	6.732
14833	-111594.806	-26994.641	11.529
14825	-111584.741	-26999.200	11.049
面積	152.6822195		
地積	152.68 m ²		

88

地番 桂上東二七ノ五			
NO	X	Y	辺長
14323	-111580.308	-26989.309	
14825	-111584.741	-26999.200	10.839
14833	-111594.806	-26994.641	11.049
14325	-111588.919	-26981.054	14.808
14324	-111582.310	-26984.018	7.243
14323	-111580.308	-26989.309	5.657
面積	157.1960475		
地積	157.19 m ²		

89

地番 桂上東二七ノ三			
NO	X	Y	辺長
14325	-111588.919	-26981.054	
14833	-111594.806	-26994.641	14.808
14834	-111605.349	-26989.977	11.529
14832	-111605.029	-26989.245	0.789
20168	-111603.688	-26986.252	3.280
20169	-111602.073	-26982.647	3.950
14327	-111599.279	-26976.407	6.837
14326	-111598.970	-26976.545	0.338
14325	-111588.919	-26981.054	11.016
面積	169.7965220		
地積	169.79 m ²		

90

地番 桂畑ヶ田二〇ノ四			
NO	X	Y	辺長
20169	-111602.073	-26982.647	
21235	-111607.296	-26980.303	5.725
21243	-111604.504	-26974.067	6.832
14327	-111599.279	-26976.407	5.725
20169	-111602.073	-26982.647	6.837
面積	39.1285180		
地積	39.12 m ²		

91

地番 桂畑ヶ田二ノ五			
NO	X	Y	辺長
20168	-111603.688	-26986.252	
21238	-111608.910	-26983.908	5.724
21235	-111607.296	-26980.303	3.950
20169	-111602.073	-26982.647	5.725
20168	-111603.688	-26986.252	3.950
面積	22.6115005		
地積	22.61 m ²		

92

地番 桂徳九一ノ一七			
NO	X	Y	辺長
14832	-111605.029	-26989.245	
21241	-111610.250	-26986.900	5.723
21238	-111608.910	-26983.908	3.278
20168	-111603.688	-26986.252	5.724
14832	-111605.029	-26989.245	3.280
面積	18.7681410		
地積	18.76 m ²		

93

地番 桂畑ヶ田二〇ノ三			
NO	X	Y	辺長
21235	-111607.296	-26980.303	
21236	-111612.519	-26977.958	5.725
21242	-111609.729	-26971.728	6.826
21243	-111604.504	-26974.067	5.725
21235	-111607.296	-26980.303	6.832
面積	39.0977140		
地積	39.09 m ²		

94

地番 桂畑ヶ田二ノ四			
NO	X	Y	辺長
21238	-111608.910	-26983.908	
21239	-111614.133	-26981.563	5.725
21236	-111612.519	-26977.958	3.950
21235	-111607.296		

102

地番 桂畑ヶ田一ノ三			
N O	X	Y	辺長
14832	-111605.029	-26989.245	
14834	-111605.349	-26989.977	0.799
14835	-111608.107	-26996.118	6.732
11302	-111609.220	-26998.602	2.722
11306	-111629.681	-26989.440	22.419
14706	-111629.052	-26988.036	1.538
14707	-111625.482	-26980.057	8.741
21234	-111620.694	-26982.208	5.249
21232	-111615.472	-26984.554	5.725
21241	-111610.250	-26986.900	5.725
14832	-111605.029	-26989.245	5.723
面積	230.1927705		
地積	230.19 m ²		

103

地番 保 九九ノ六号			
N O	X	Y	辺長
14837	-111611.706	-27004.185	
14828	-111632.178	-26995.018	22.431
11306	-111629.681	-26989.440	6.111
11302	-111609.220	-26998.602	22.419
11317	-111610.176	-27000.750	2.351
14837	-111611.706	-27004.185	3.760
面積	137.0479450		
地積	137.04 m ²		

104

地番 保 九九ノ三号			
N O	X	Y	辺長
11304	-111613.834	-27008.962	
11305	-111634.310	-26999.780	22.440
14828	-111632.178	-26995.018	5.217
14837	-111611.706	-27004.185	22.431
11303	-111612.240	-27005.366	1.296
11304	-111613.834	-27008.962	3.933
面積	117.1735530		
地積	117.17 m ²		

105

地番 桂上南四〇			
N O	X	Y	辺長
11304	-111613.834	-27008.962	
14830	-111616.977	-27015.925	7.639
14829	-111637.436	-27006.761	22.418
14705	-111637.302	-27006.463	0.327
11305	-111634.310	-26999.780	7.322
11304	-111613.834	-27008.962	22.440
面積	171.4502255		
地積	171.45 m ²		

106

地番 桂畑ヶ田一三			
N O	X	Y	辺長
14830	-111616.977	-27015.925	
12206	-111617.503	-27017.081	1.270
12205	-111619.476	-27021.502	4.841
14703	-111639.935	-27012.338	22.418
14829	-111637.436	-27006.761	6.111
14830	-111616.977	-27015.925	22.418
面積	136.9783500		
地積	136.97 m ²		

107

地番 桂上東三六B			
N O	X	Y	辺長
12205	-111619.476	-27021.502	
12204	-111622.900	-27029.138	8.369
20162	-111629.030	-27042.820	14.992
20161	-111629.623	-27044.144	1.451
14821	-111629.856	-27044.665	0.571
14818	-111634.190	-27054.338	10.600
14817	-111636.360	-27059.169	5.296
14827	-111639.969	-27067.244	8.845
14687	-111660.435	-27058.091	22.420
14686	-111653.649	-27042.942	16.599
14702	-111645.497	-27024.747	19.938
14703	-111639.935	-27012.338	13.598
12205	-111619.476	-27021.502	22.418
面積	1123.7329360		
地積	1123.73 m ²		

108

地番 上北村八四ノ二			
N O	X	Y	辺長
20167	-111640.817	-27069.138	
14688	-111661.284	-27059.987	22.420
14687	-111660.435	-27058.091	2.077
14827	-111639.969	-27067.244	22.420
20167	-111640.817	-27069.138	2.075
面積	46.5494895		
地積	46.54 m ²		

109

地番 桂上東三九C			
N O	X	Y	辺長
14567	-111645.478	-27079.554	
14691	-111663.214	-27071.605	19.436
14690	-111664.711	-27067.646	4.233
14689	-111663.474	-27064.876	3.034
14688	-111661.284	-27059.987	5.357
20167	-111640.817	-27069.138	22.420
14567	-111645.478	-27079.554	11.411
面積	251.1435620		
地積	251.14 m ²		

110

地番 桂上南一四ノ三			
N O	X	Y	辺長
14816	-111627.624	-27063.083	
14815	-111630.674	-27069.880	7.450
14569	-111636.745	-27083.460	14.875
14568	-111644.396	-27080.039	8.381
14567	-111645.478	-27079.554	1.186
20167	-111640.817	-27069.138	11.411
14827	-111639.969	-27067.244	2.075
14817	-111636.360	-27059.169	8.845
14816	-111627.624	-27063.083	9.573
面積	213.5757140		
地積	213.57 m ²		

図面の種類	画地面積求積表		
街区番号	99	番号	2/2 縮尺
町名	桂畑ヶ田町		
京都市洛西第二土地区画整理組合			



S = 1 : 250

99

300-5

103


300-4

300-2

310-1

300-6

101

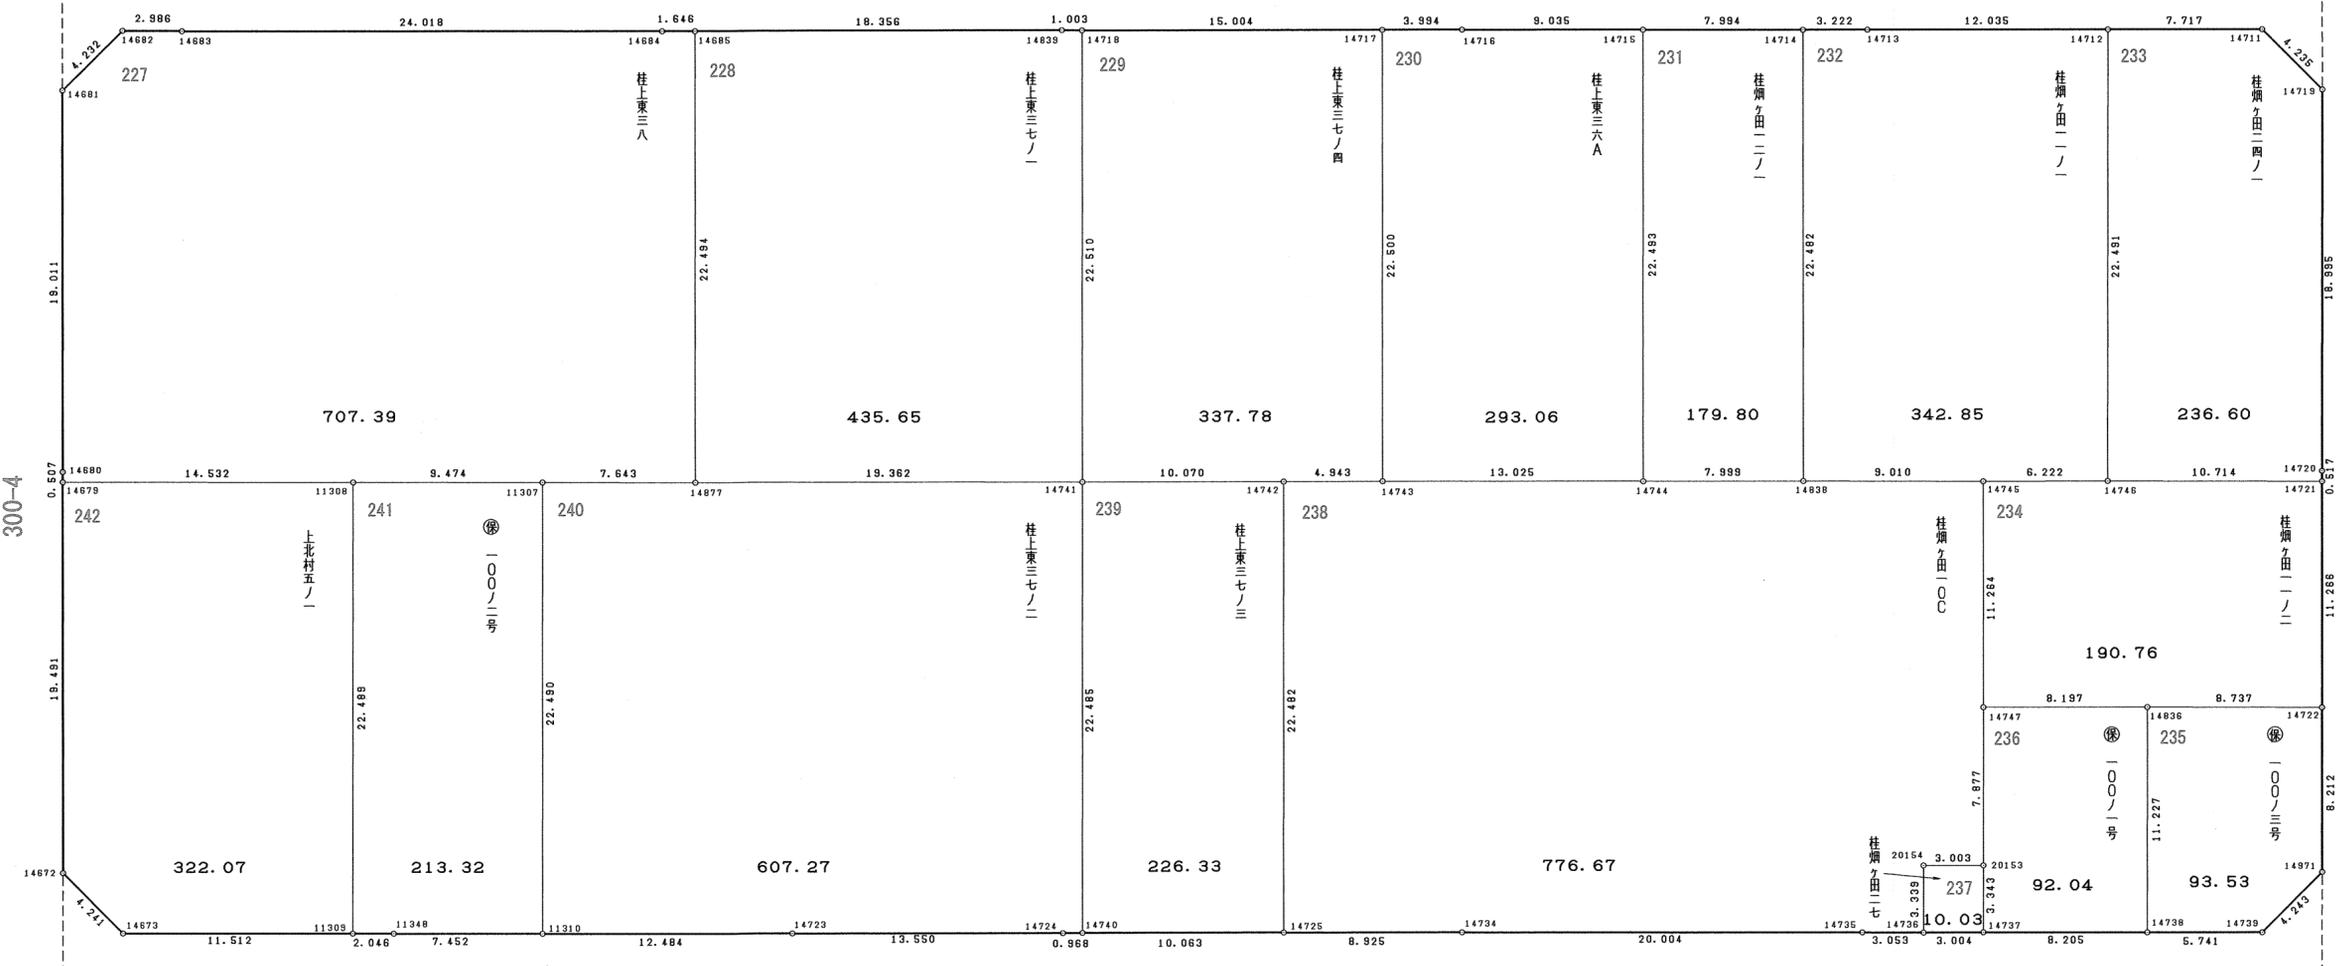

図面の種類	画地出来形確認測量図		
街区番号	100	番号	縮尺 1:250
町名	桂畑ヶ田町		
京都市洛西第二土地区画整理組合			

227

地番 桂上東三八			
N O	X	Y	辺長
14685	-111658.486	-27039.035	
14684	-111659.160	-27040.537	1.646
14683	-111668.976	-27062.458	24.018
14682	-111670.183	-27065.189	2.986
14681	-111674.133	-27066.709	4.232
14680	-111691.482	-27058.936	19.011
14679	-111691.945	-27058.729	0.507
11308	-111686.008	-27045.465	14.532
11307	-111682.138	-27036.818	9.474
14877	-111679.016	-27029.842	7.643
14685	-111658.486	-27039.035	22.494
面積	707.3995795		
地積	707.39 m ²		

228

地番 桂上東三七ノ一			
N O	X	Y	辺長
14718	-111650.564	-27021.371	
14839	-111650.974	-27022.286	1.003
14685	-111658.486	-27039.035	18.356
14877	-111679.016	-27029.842	22.494
14741	-111671.107	-27012.169	19.362
14718	-111650.564	-27021.371	22.510
面積	435.6551565		
地積	435.65 m ²		

229

地番 桂上東三七ノ四			
N O	X	Y	辺長
14717	-111644.434	-27007.676	
14718	-111650.564	-27021.371	15.004
14741	-111671.107	-27012.169	22.510
14742	-111666.989	-27002.980	10.070
14743	-111664.965	-26998.470	4.943
14717	-111644.434	-27007.676	22.500
面積	337.7842110		
地積	337.78 m ²		

230

地番 桂上東三六A			
N O	X	Y	辺長
14715	-111639.110	-26995.785	
14716	-111642.802	-27004.031	9.035
14717	-111644.434	-27007.676	3.994
14743	-111664.965	-26998.470	22.500
14744	-111659.635	-26986.585	13.025
14715	-111639.110	-26995.785	22.493
面積	293.0613110		
地積	293.06 m ²		

231

地番 桂畑ヶ田一ニノ一			
N O	X	Y	辺長
14714	-111635.844	-26988.489	
14715	-111639.110	-26995.785	7.994
14744	-111659.635	-26986.585	22.493
14838	-111656.357	-26979.289	7.999
14714	-111635.844	-26988.489	22.482
面積	179.8090240		
地積	179.80 m ²		

232

地番 桂畑ヶ田一ノ一			
N O	X	Y	辺長
14712	-111629.601	-26974.567	
14713	-111634.527	-26985.548	12.035
14714	-111635.844	-26988.489	3.222
14838	-111656.357	-26979.289	22.482
14745	-111652.683	-26971.062	9.010
14746	-111650.133	-26965.386	6.222
14712	-111629.601	-26974.567	22.491
面積	342.8581815		
地積	342.85 m ²		

233

地番 桂畑ヶ田二四ノ一			
N O	X	Y	辺長
14711	-111626.443	-26967.526	
14712	-111629.601	-26974.567	7.717
14746	-111650.133	-26965.386	22.491
14721	-111645.760	-26955.605	10.714
14720	-111645.288	-26955.817	0.517
14719	-111627.945	-26963.566	18.995
14711	-111626.443	-26967.526	4.235
面積	236.6001550		
地積	236.60 m ²		

234

地番 桂畑ヶ田一ノ二			
N O	X	Y	辺長
14721	-111645.760	-26955.605	
14746	-111650.133	-26965.386	10.714
14745	-111652.683	-26971.062	6.222
14747	-111662.961	-26966.453	11.264
14836	-111659.604	-26958.975	8.197
14722	-111656.041	-26950.998	8.737
14721	-111645.760	-26955.605	11.266
面積	190.7670875		
地積	190.76 m ²		

235

地番 保一〇〇ノ三号			
N O	X	Y	辺長
14722	-111656.041	-26950.998	
14836	-111659.604	-26958.975	8.737
14738	-111669.849	-26954.384	11.227
14739	-111667.502	-26949.145	5.741
14971	-111663.535	-26947.640	4.243
14722	-111656.041	-26950.998	8.212
面積	93.5374620		
地積	93.53 m ²		

236

地番 保一〇〇ノ一号			
N O	X	Y	辺長
14836	-111659.604	-26958.975	
14747	-111662.961	-26966.453	8.197
20153	-111670.152	-26963.237	7.877
14737	-111673.204	-26961.872	3.343
14738	-111669.849	-26954.384	8.205
14836	-111659.604	-26958.975	11.227
面積	92.0467095		
地積	92.04 m ²		

237

地番 桂畑ヶ田二七			
N O	X	Y	辺長
14736	-111674.432	-26964.613	
14737	-111673.204	-26961.872	3.004
20153	-111670.152	-26963.237	3.343
20154	-111671.384	-26965.976	3.003
14736	-111674.432	-26964.613	3.339
面積	10.0347200		
地積	10.03 m ²		

238

地番 桂畑ヶ田一〇C			
N O	X	Y	辺長
14745	-111652.683	-26971.062	
14838	-111656.357	-26979.289	9.010
14744	-111659.635	-26986.585	7.999
14743	-111664.965	-26998.470	13.025
14742	-111666.989	-27002.980	4.943
14725	-111687.511	-26993.798	22.482
14734	-111683.859	-26985.654	8.925
14735	-111675.680	-26967.399	20.004
14736	-111674.432	-26964.613	3.053
20154	-111671.384	-26965.976	3.339
20153	-111670.152	-26963.237	3.003
14747	-111662.961	-26966.453	7.877
14745	-111652.683	-26971.062	11.264
面積	776.6723985		
地積	776.67 m ²		

239

地番 桂上東三七ノ三			
N O	X	Y	辺長
14742	-111666.989	-27002.980	
14741	-111671.107	-27012.169	10.070
14740	-111691.629	-27002.980	22.485
14725	-111687.511	-26993.798	10.063
14742	-111666.989	-27002.980	22.482
面積	226.3307200		
地積	226.33 m ²		

240

地番 桂上東三七ノ二			
N O	X	Y	辺長
14741	-111671.107	-27012.169	
14877	-111679.016	-27029.842	19.362
11307	-111682.138	-27036.818	7.643
11310	-111702.663	-27027.624	22.490
14723	-111697.564	-27016.229	12.484
14724	-111692.025	-27003.863	13.550
14740	-111691.629	-27002.980	0.968
14741	-111671.107	-27012.169	22.485
面積	607.2779640		
地積	607.27 m ²		


241

地番 保一〇〇ノ二号			
N O	X	Y	辺長
11307	-111682.138	-27036.818	
11308	-111686.008	-27045.465	9.474
11309	-111706.542	-27036.293	22.489
11348	-111705.706	-27034.426	2.046
11310	-111702.663	-27027.624	7.452
11307	-111682.138	-27036.818	22.490
面積	213.3213490		
地積	213.32 m ²		

242

地番 上北村五ノ一			
N O	X	Y	辺長
11308	-111686.008	-27045.465	
14679	-111691.945	-27058.729	14.532
14672	-111709.733	-27050.762	19.491
14673	-111711.246	-27046.800	4.241
11309	-111706.542	-27036.293	11.512
11308	-111686.008	-27045.465	22.489
面積	322.0743740		
地積	322.07 m ²		

図面の種類	画地面積求積表		
街区番号	100	番号	縮尺
町名	桂畑ヶ田町		
京都市洛西第二土地区画整理組合			

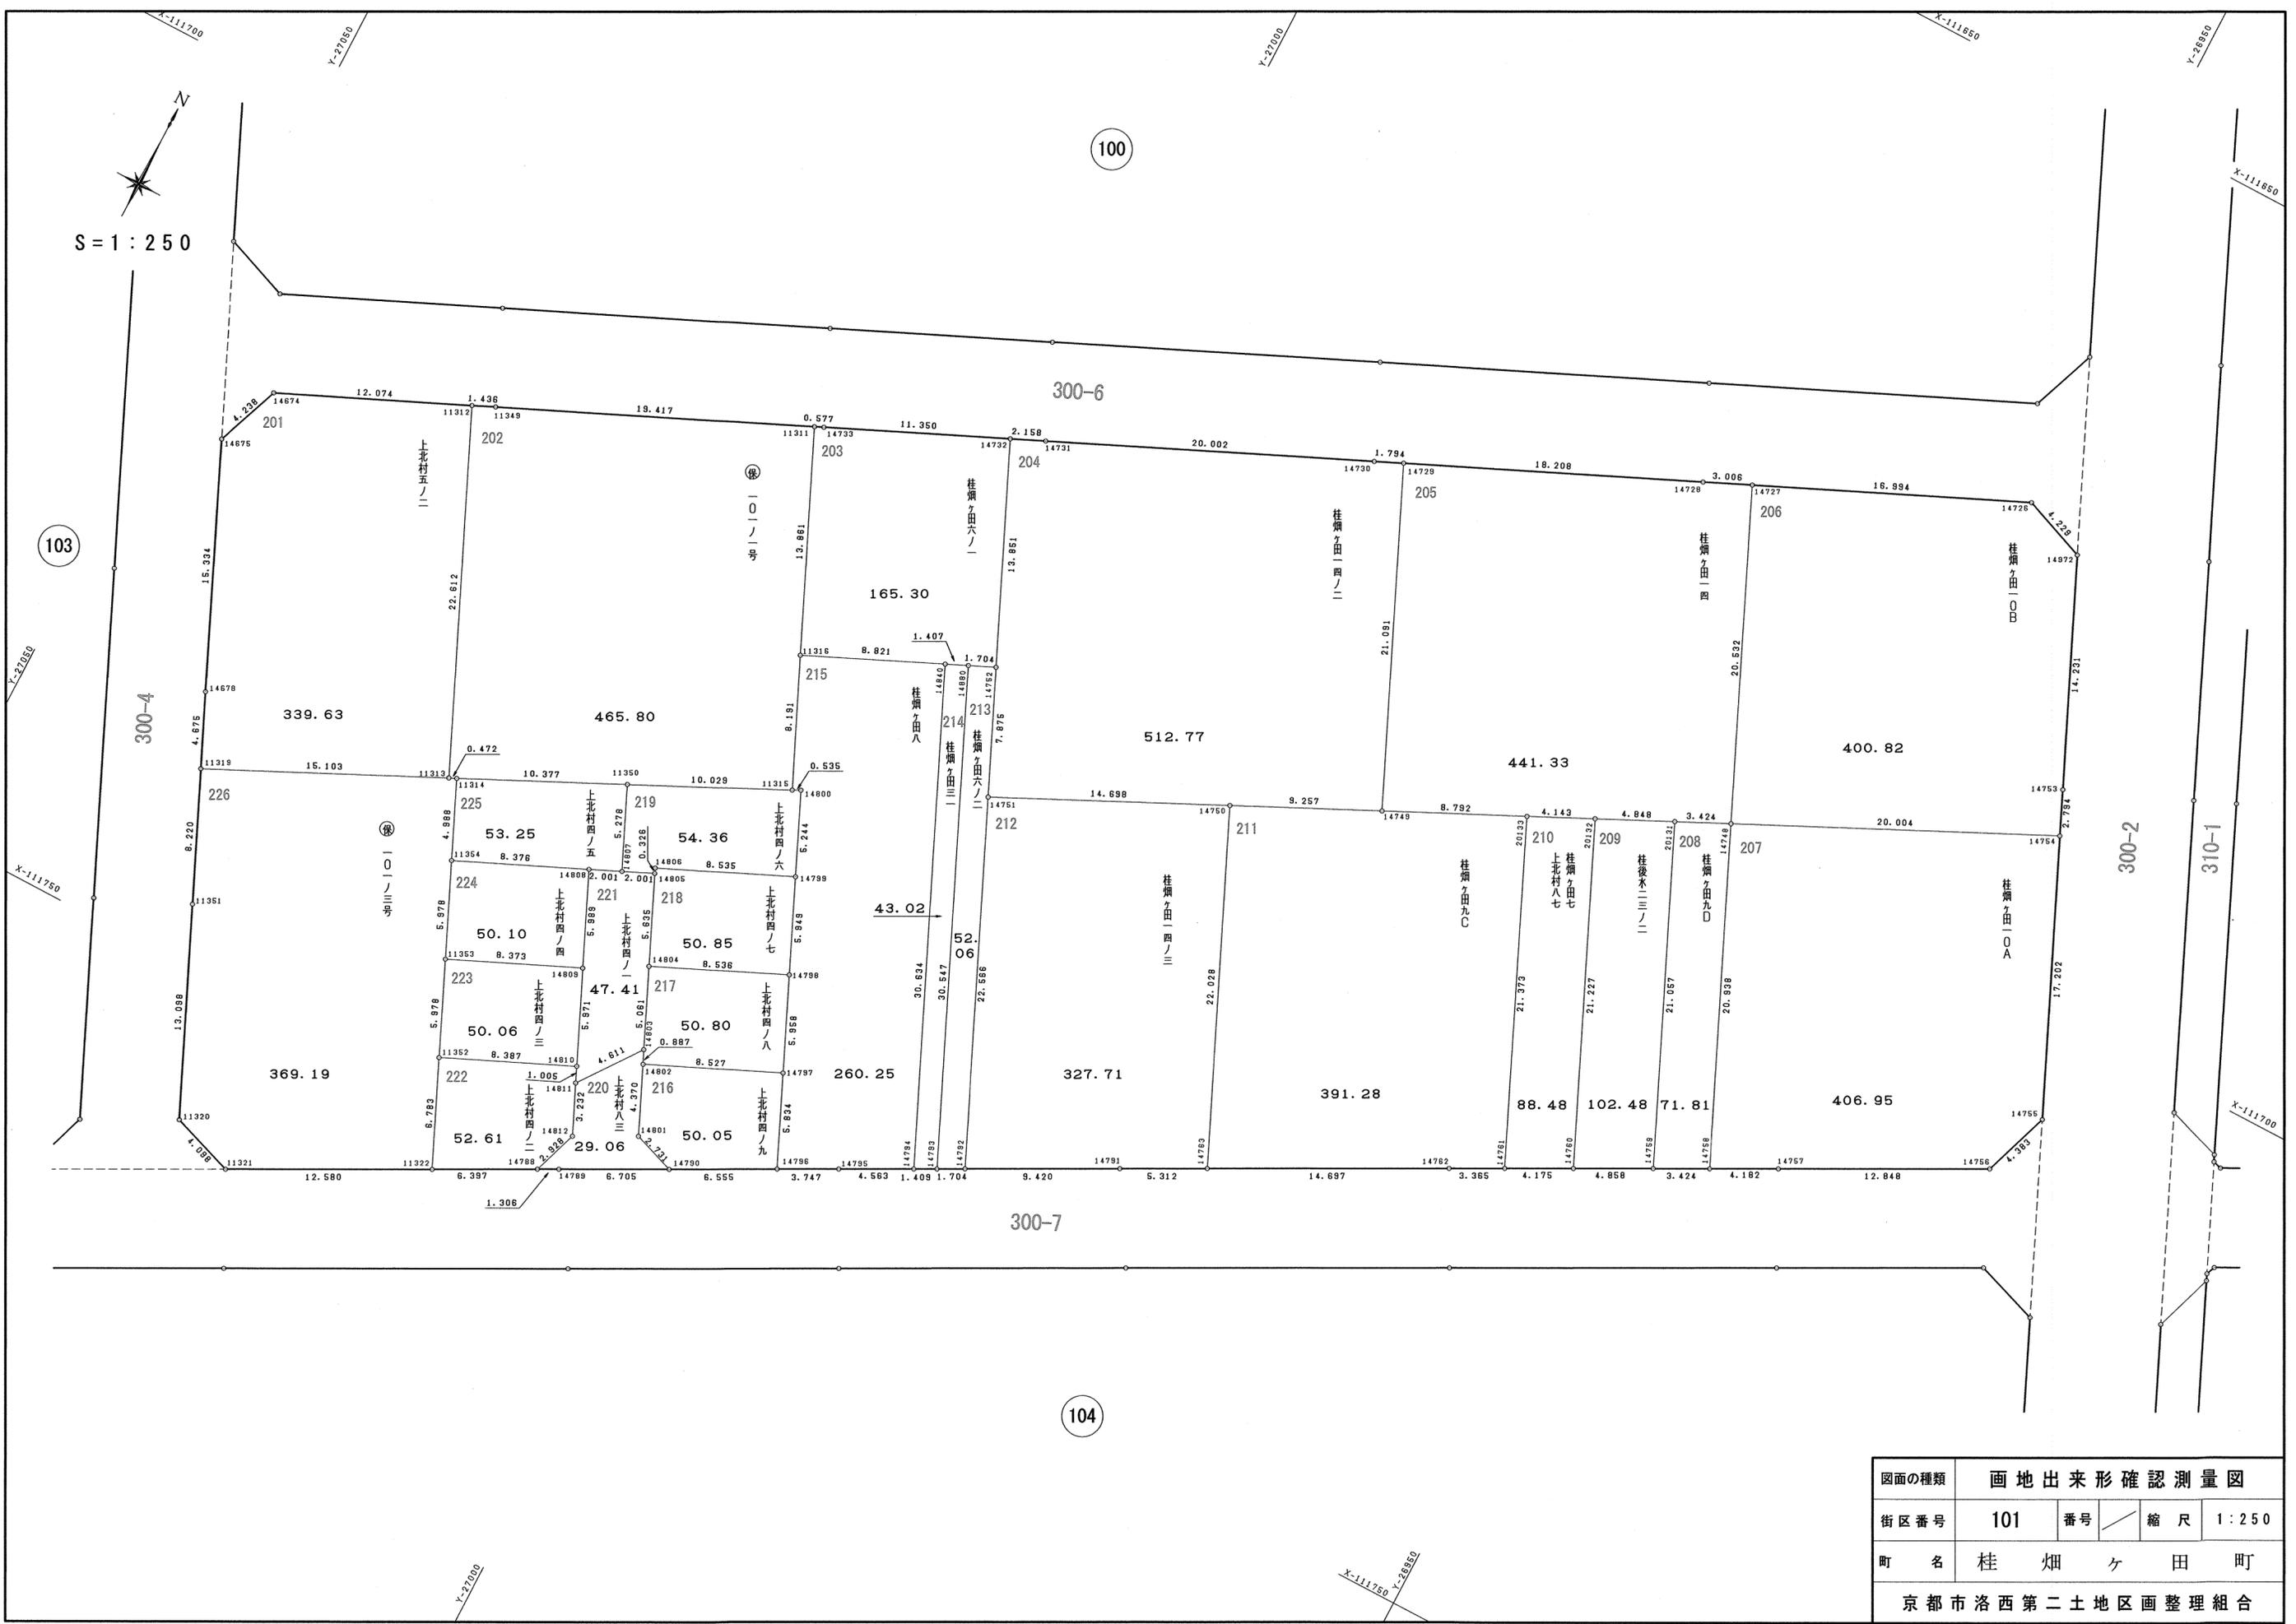

図面の種類	画地出来形確認測量図		
街区番号	101	番号	縮尺 1:250
町名	桂畑ケ田町		
京都市洛西第二土地区画整理組合			

201

地番 上北村五ノ二			
NO	X	Y	辺長
11312	-111711.786	-27033.331	
14674	-111716.723	-27044.349	12.074
14675	-111720.682	-27045.861	4.238
14678	-111734.690	-27039.623	15.334
11319	-111738.954	-27037.707	4.675
11313	-111732.423	-27024.089	15.103
11312	-111711.786	-27033.331	22.612
面積	339.6381630		
地積	339.63 m ²		

202

地番 保 一〇一ノ一			
NO	X	Y	辺長
11311	-111703.263	-27014.299	
11349	-111711.199	-27032.020	19.417
11312	-111711.786	-27033.331	1.436
11313	-111732.423	-27024.089	22.612
11314	-111732.223	-27023.661	0.472
11350	-111727.725	-27014.310	10.377
11315	-111723.382	-27005.270	10.029
11316	-111715.913	-27008.633	8.191
11311	-111703.263	-27014.299	13.861
面積	465.8071780		
地積	465.80 m ²		

203

地番 桂畑ヶ田六ノ一			
NO	X	Y	辺長
14732	-111698.392	-27003.413	
14733	-111703.027	-27013.773	11.350
11311	-111703.263	-27014.299	0.577
11316	-111715.913	-27008.633	13.861
14840	-111712.306	-27000.583	8.821
14880	-111711.729	-26999.300	1.407
14752	-111711.031	-26997.746	1.704
14732	-111698.392	-27003.413	13.851
面積	165.3052950		
地積	165.30 m ²		

204

地番 桂畑ヶ田一四ノ二			
NO	X	Y	辺長
14729	-111688.603	-26981.550	
14730	-111689.337	-26983.187	1.794
14731	-111697.511	-27001.443	20.002
14732	-111698.392	-27003.413	2.158
14752	-111711.031	-26997.746	13.851
14751	-111718.214	-26994.517	7.875
14750	-111711.853	-26981.267	14.698
14749	-111707.848	-26972.921	9.257
14729	-111688.603	-26981.550	21.091
面積	512.7775425		
地積	512.77 m ²		

205

地番 桂畑ヶ田一四			
NO	X	Y	辺長
14727	-111679.921	-26962.194	
14728	-111681.151	-26964.937	3.006
14729	-111698.603	-26981.550	18.208
14749	-111707.848	-26972.921	21.091
20133	-111704.039	-26964.997	8.792
20132	-111702.245	-26961.263	4.143
20131	-111700.145	-26956.893	4.848
14748	-111698.662	-26953.807	3.424
14727	-111679.921	-26962.194	20.532
面積	441.3380530		
地積	441.33 m ²		

206

地番 桂畑ヶ田一〇B			
NO	X	Y	辺長
14726	-111672.968	-26946.688	
14727	-111679.921	-26962.194	16.994
14748	-111698.662	-26953.807	20.532
14754	-111690.019	-26935.766	20.004
14753	-111687.469	-26936.909	2.794
14972	-111674.488	-26942.742	14.231
14726	-111672.968	-26946.688	4.229
面積	400.8236835		
地積	400.82 m ²		

207

地番 桂畑ヶ田一〇A			
NO	X	Y	辺長
14754	-111690.019	-26935.766	
14748	-111698.662	-26953.807	20.004
14758	-111717.769	-26945.243	20.938
14757	-111715.827	-26941.539	4.182
14756	-111709.858	-26930.162	12.848
14755	-111705.716	-26928.729	4.383
14754	-111690.019	-26935.766	17.202
面積	406.9546695		
地積	406.95 m ²		

208

地番 桂畑ヶ田九D			
NO	X	Y	辺長
14759	-111719.358	-26948.276	
14758	-111717.769	-26945.243	3.424
14748	-111698.662	-26953.807	20.938
20131	-111700.145	-26956.893	3.424
14759	-111719.358	-26948.276	21.057
面積	71.8150280		
地積	71.81 m ²		

209

地番 桂後水二三ノ二			
NO	X	Y	辺長
14760	-111721.614	-26952.578	
14759	-111719.358	-26948.276	4.858
20131	-111700.145	-26956.893	21.057
20132	-111702.245	-26961.263	4.848
14760	-111721.614	-26952.578	21.227
面積	102.4876540		
地積	102.48 m ²		

210

地番 桂畑ヶ田七、上北村八七			
NO	X	Y	辺長
14761	-111723.552	-26956.276	
14760	-111721.614	-26952.578	4.175
20132	-111702.245	-26961.263	21.227
20133	-111704.039	-26964.997	4.143
14761	-111723.552	-26956.276	21.373
面積	88.4825540		
地積	88.48 m ²		

211

地番 桂畑ヶ田九C			
NO	X	Y	辺長
20133	-111704.039	-26964.997	
14749	-111707.848	-26972.921	8.792
14750	-111711.853	-26981.267	9.257
14763	-111731.957	-26972.263	22.028
14762	-111725.114	-26959.256	14.697
14761	-111723.552	-26956.276	3.365
20133	-111704.039	-26964.997	21.373
面積	391.2870860		
地積	391.28 m ²		

212

地番 桂畑ヶ田一四ノ三			
NO	X	Y	辺長
14750	-111711.853	-26981.267	
14751	-111718.214	-26994.517	14.698
14792	-111738.813	-26985.302	22.566
14791	-111734.430	-26976.964	9.420
14763	-111731.957	-26972.263	5.312
14750	-111711.853	-26981.267	22.028
面積	327.7181180		
地積	327.71 m ²		

213

地番 桂畑ヶ田六ノ二			
NO	X	Y	辺長
14752	-111711.031	-26997.746	
14880	-111711.729	-26999.300	1.704
14793	-111739.606	-26986.810	30.547
14792	-111738.813	-26985.302	1.704
14751	-111718.214	-26994.517	22.566
14752	-111711.031	-26997.746	7.875
面積	52.0625260		
地積	52.06 m ²		

214

地番 桂畑ヶ田三一			
NO	X	Y	辺長
14880	-111711.729	-26999.300	
14840	-111712.306	-27000.583	1.407
14794	-111740.262	-26988.057	30.634
14793	-111739.606	-26986.810	1.409
14880	-111711.729	-26999.300	30.547
面積	43.0255545		
地積	43.02 m ²		

215

地番 桂畑ヶ田八			
NO	X	Y	辺長
14840	-111712.306	-27000.583	
11316	-111715.913	-27008.633	8.821
11315	-111723.382	-27005.270	8.191
14800	-111723.142	-27004.792	0.535
14799	-111727.931	-27002.655	5.244
14798	-111733.362	-27000.226	5.949
14797	-111738.801	-26997.794	5.958
14796	-111744.127	-26995.413	5.834
14795	-111742.385	-26992.096	3.747
14794	-111740.262	-26988.057	4.563
14840	-111712.306	-27000.583	30.634
面積	260.2525290		
地積	260.25 m ²		

216

地番 上北村四ノ九			
NO	X	Y	辺長
14797	-111738.801	-26997.794	
14802	-111742.280	-27005.579	8.527
14801	-111746.268	-27003.792	4.370
14790	-111747.175	-27001.216	2.731
14796	-111744.127	-26995.413	6.555
14797	-111738.801	-26997.794	5.834
面積	50.0513985		
地積	50.05 m ²		

217

地番 上北村四ノ八			
NO	X	Y	辺長
14798	-111733.362	-27000.226	
14804	-111736.854	-27008.015	8.536
14803	-111741.473	-27005.947	5.061
14802	-111742.280	-27005.579	0.887
14797	-111738.801	-26997.794	8.527
14798	-111733.362	-27000.226	5.958
面積	50.8020425		
地積	50.80 m ²		

218

地番 上北村四ノ七			
NO	X	Y	辺長
14799	-111727.931	-27002.655	
14806	-111731.412	-27010.448	8.535
14805	-111731.713	-27010.323	0.326
14804	-111736.854	-27008.015	5.635
14798	-111733.362	-27000.226	8.536
14799	-111727.931	-27002.655	5.949
面積	50.8574945		
地積	50.85 m ²		

219


地番 上北村四ノ六			
NO	X	Y	辺長
14800	-111723.142	-27004.792	
11315	-111723.382	-27005.270	0.535
11350	-111727.725	-27014.310	10.029
14807	-111732.539	-27012.146	5.278
14805	-111731.713	-27010.323	2.001
14806	-111731.412	-27010.448	0.326
14799	-111727.931	-27002.655	8.535
14800	-111723.142	-27004.792	5.244
面積	54.3616565		
地積	54.36 m ²		

220

地番 上北村八三			
NO	X	Y	辺長
14811	-111745.190	-27008.676	
14812	-111748.136	-27007.346	3.232
14788	-111750.901	-27008.308	2.928
14789	-111750.293	-27007.152	1.308
14790	-111747.175	-27001.216	6.705
14801	-111746.268	-27003.792	2.731
14802	-111742.280	-27005.579	4.370
14803	-111741.473	-27005.947	0.887
14811	-111745.190	-27008.676	4.611
面積	29.0657115		
地積	29.06 m ²		


221

地番 上北村四ノ一			
NO	X	Y	辺長
14805	-111731.713	-27010.323	
14807	-111732.539	-27012.146	2.001
14808	-111733.356	-27013.973	2.001
14809	-111738.824	-27011.530	5.989
14810	-111744.271	-27009.083	5.971
14811	-111745.190	-27008.676	1.005
14803	-111741.473	-27005.947	4.611
14804	-111736.854	-27008.015	5.061
14805	-111731.713	-27010.323	5.635
面積	47.4143630		
地積</			

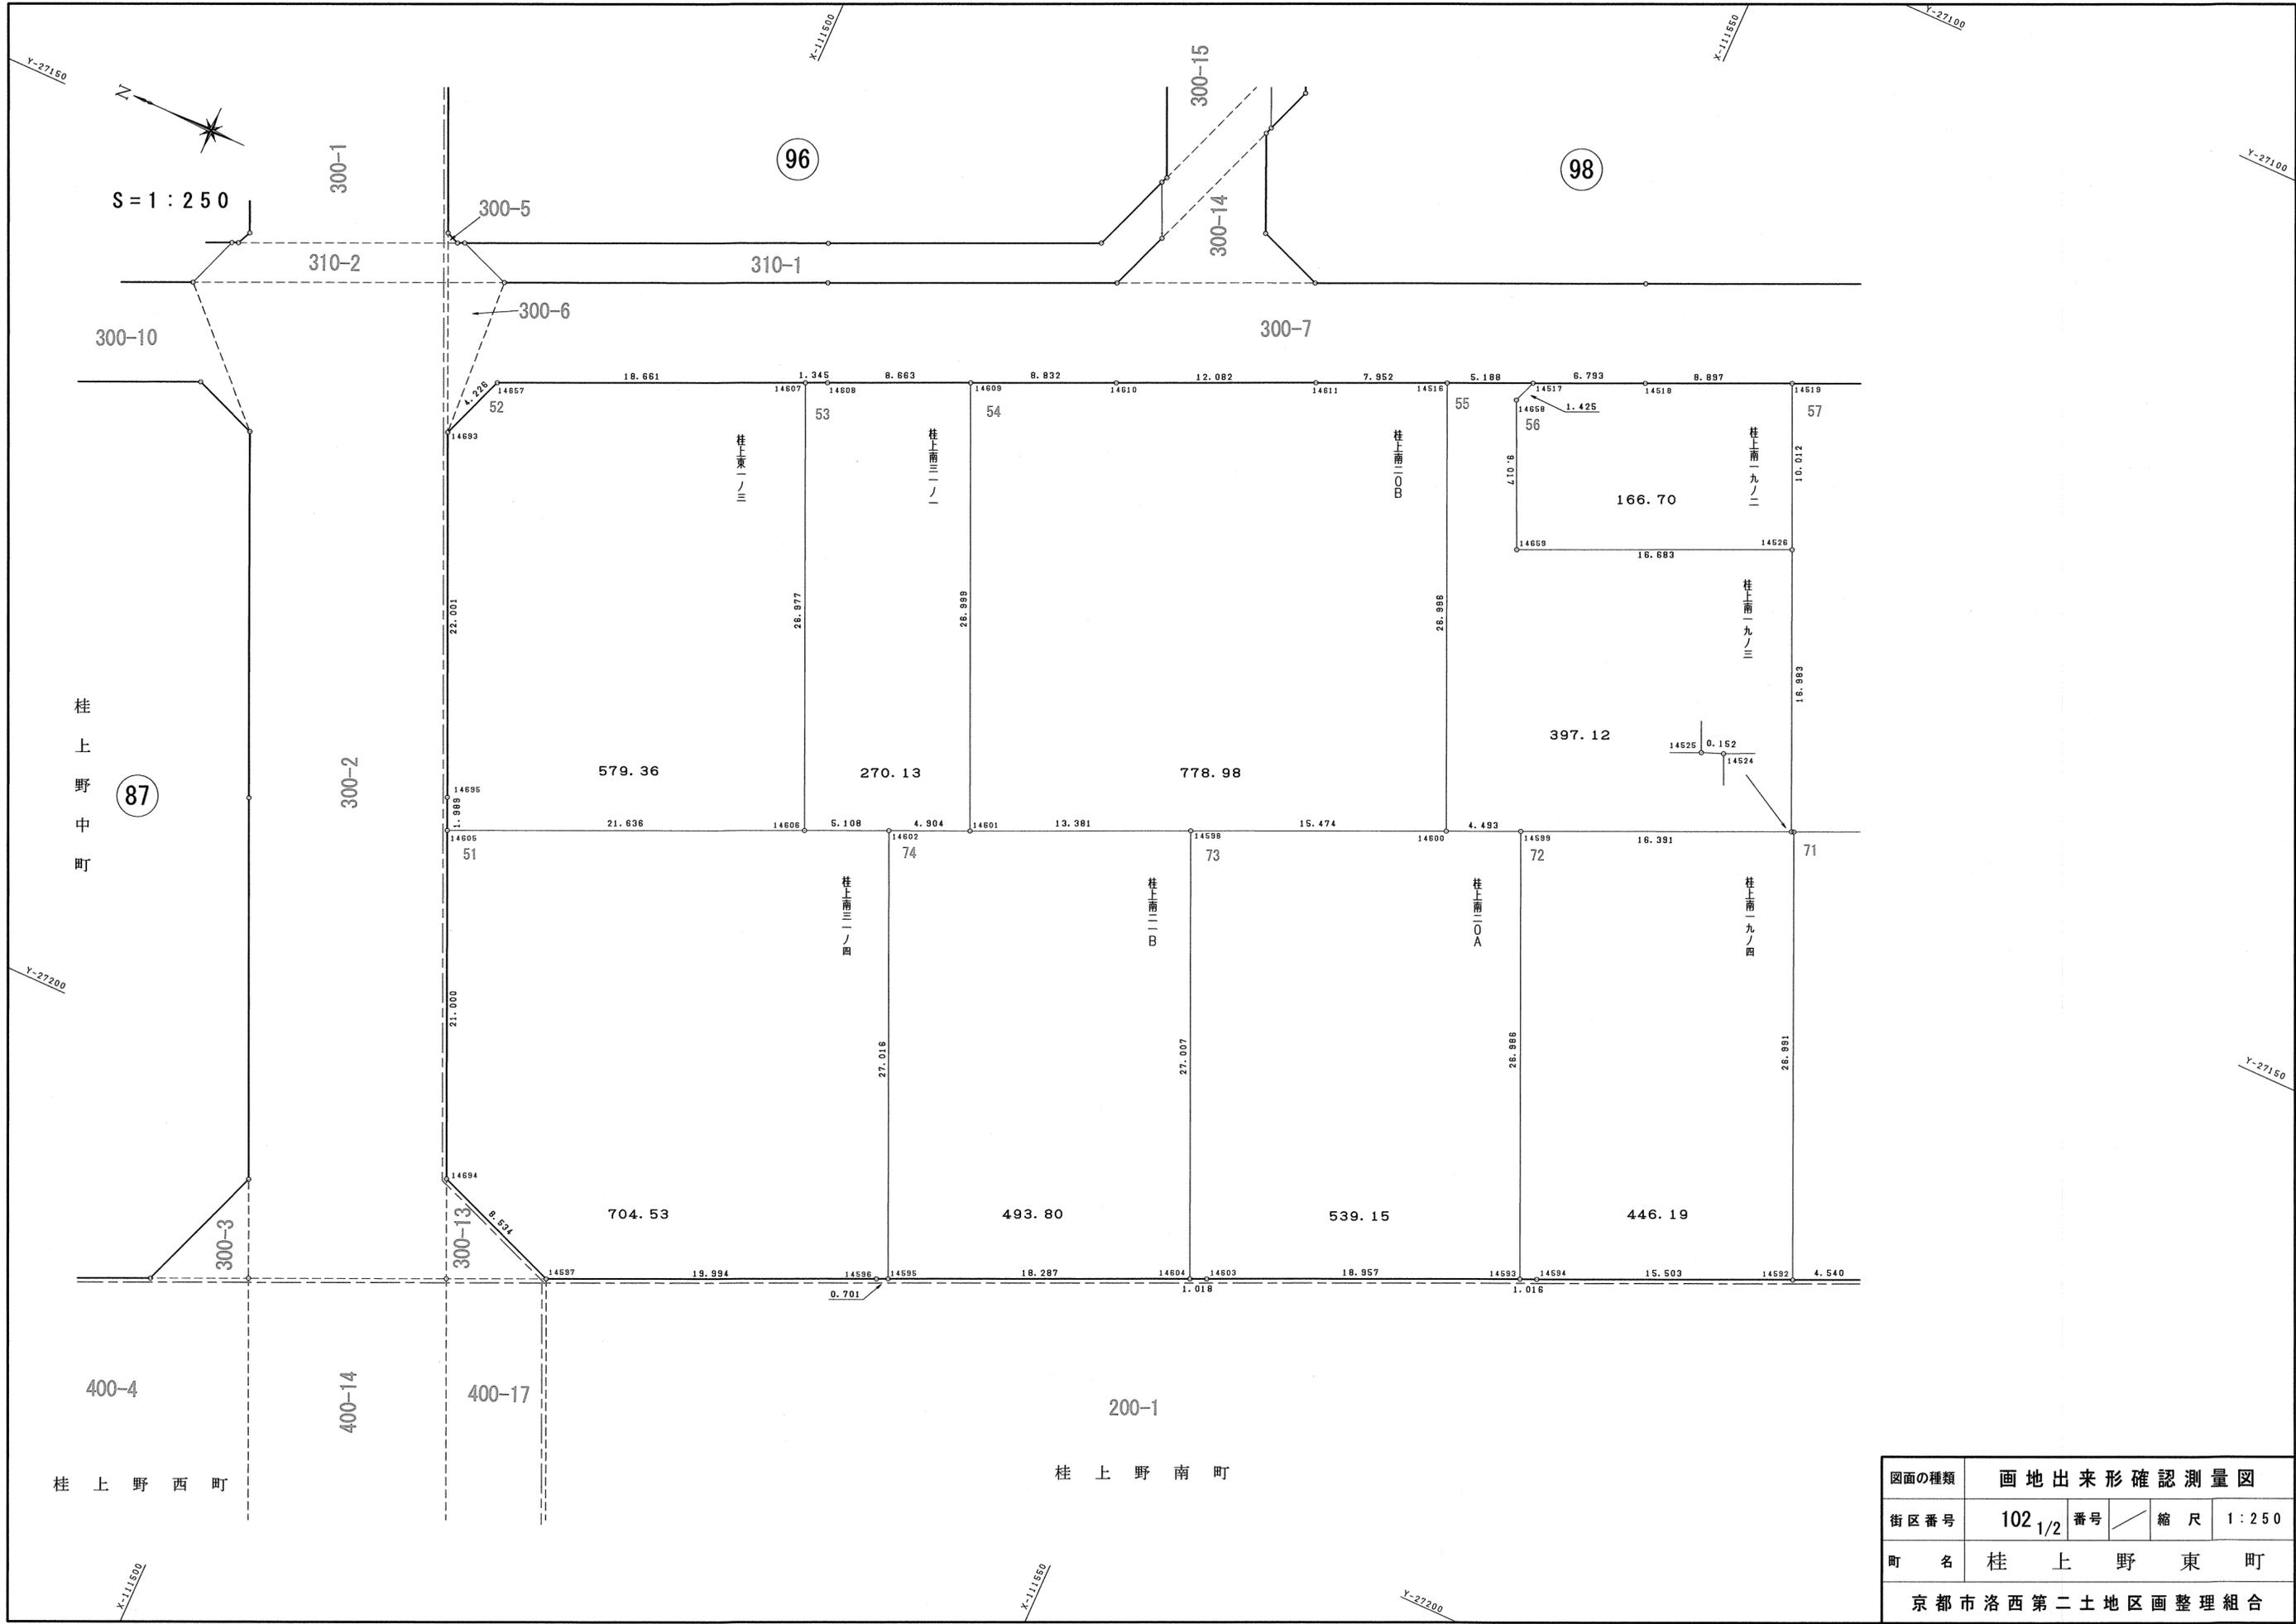

図面の種類	画地出来形確認測量図		
街区番号	102 _{1/2}	番号	縮尺 1:250
町名	桂上野東町		
京都市洛西第二土地区画整理組合			

S = 1 : 250

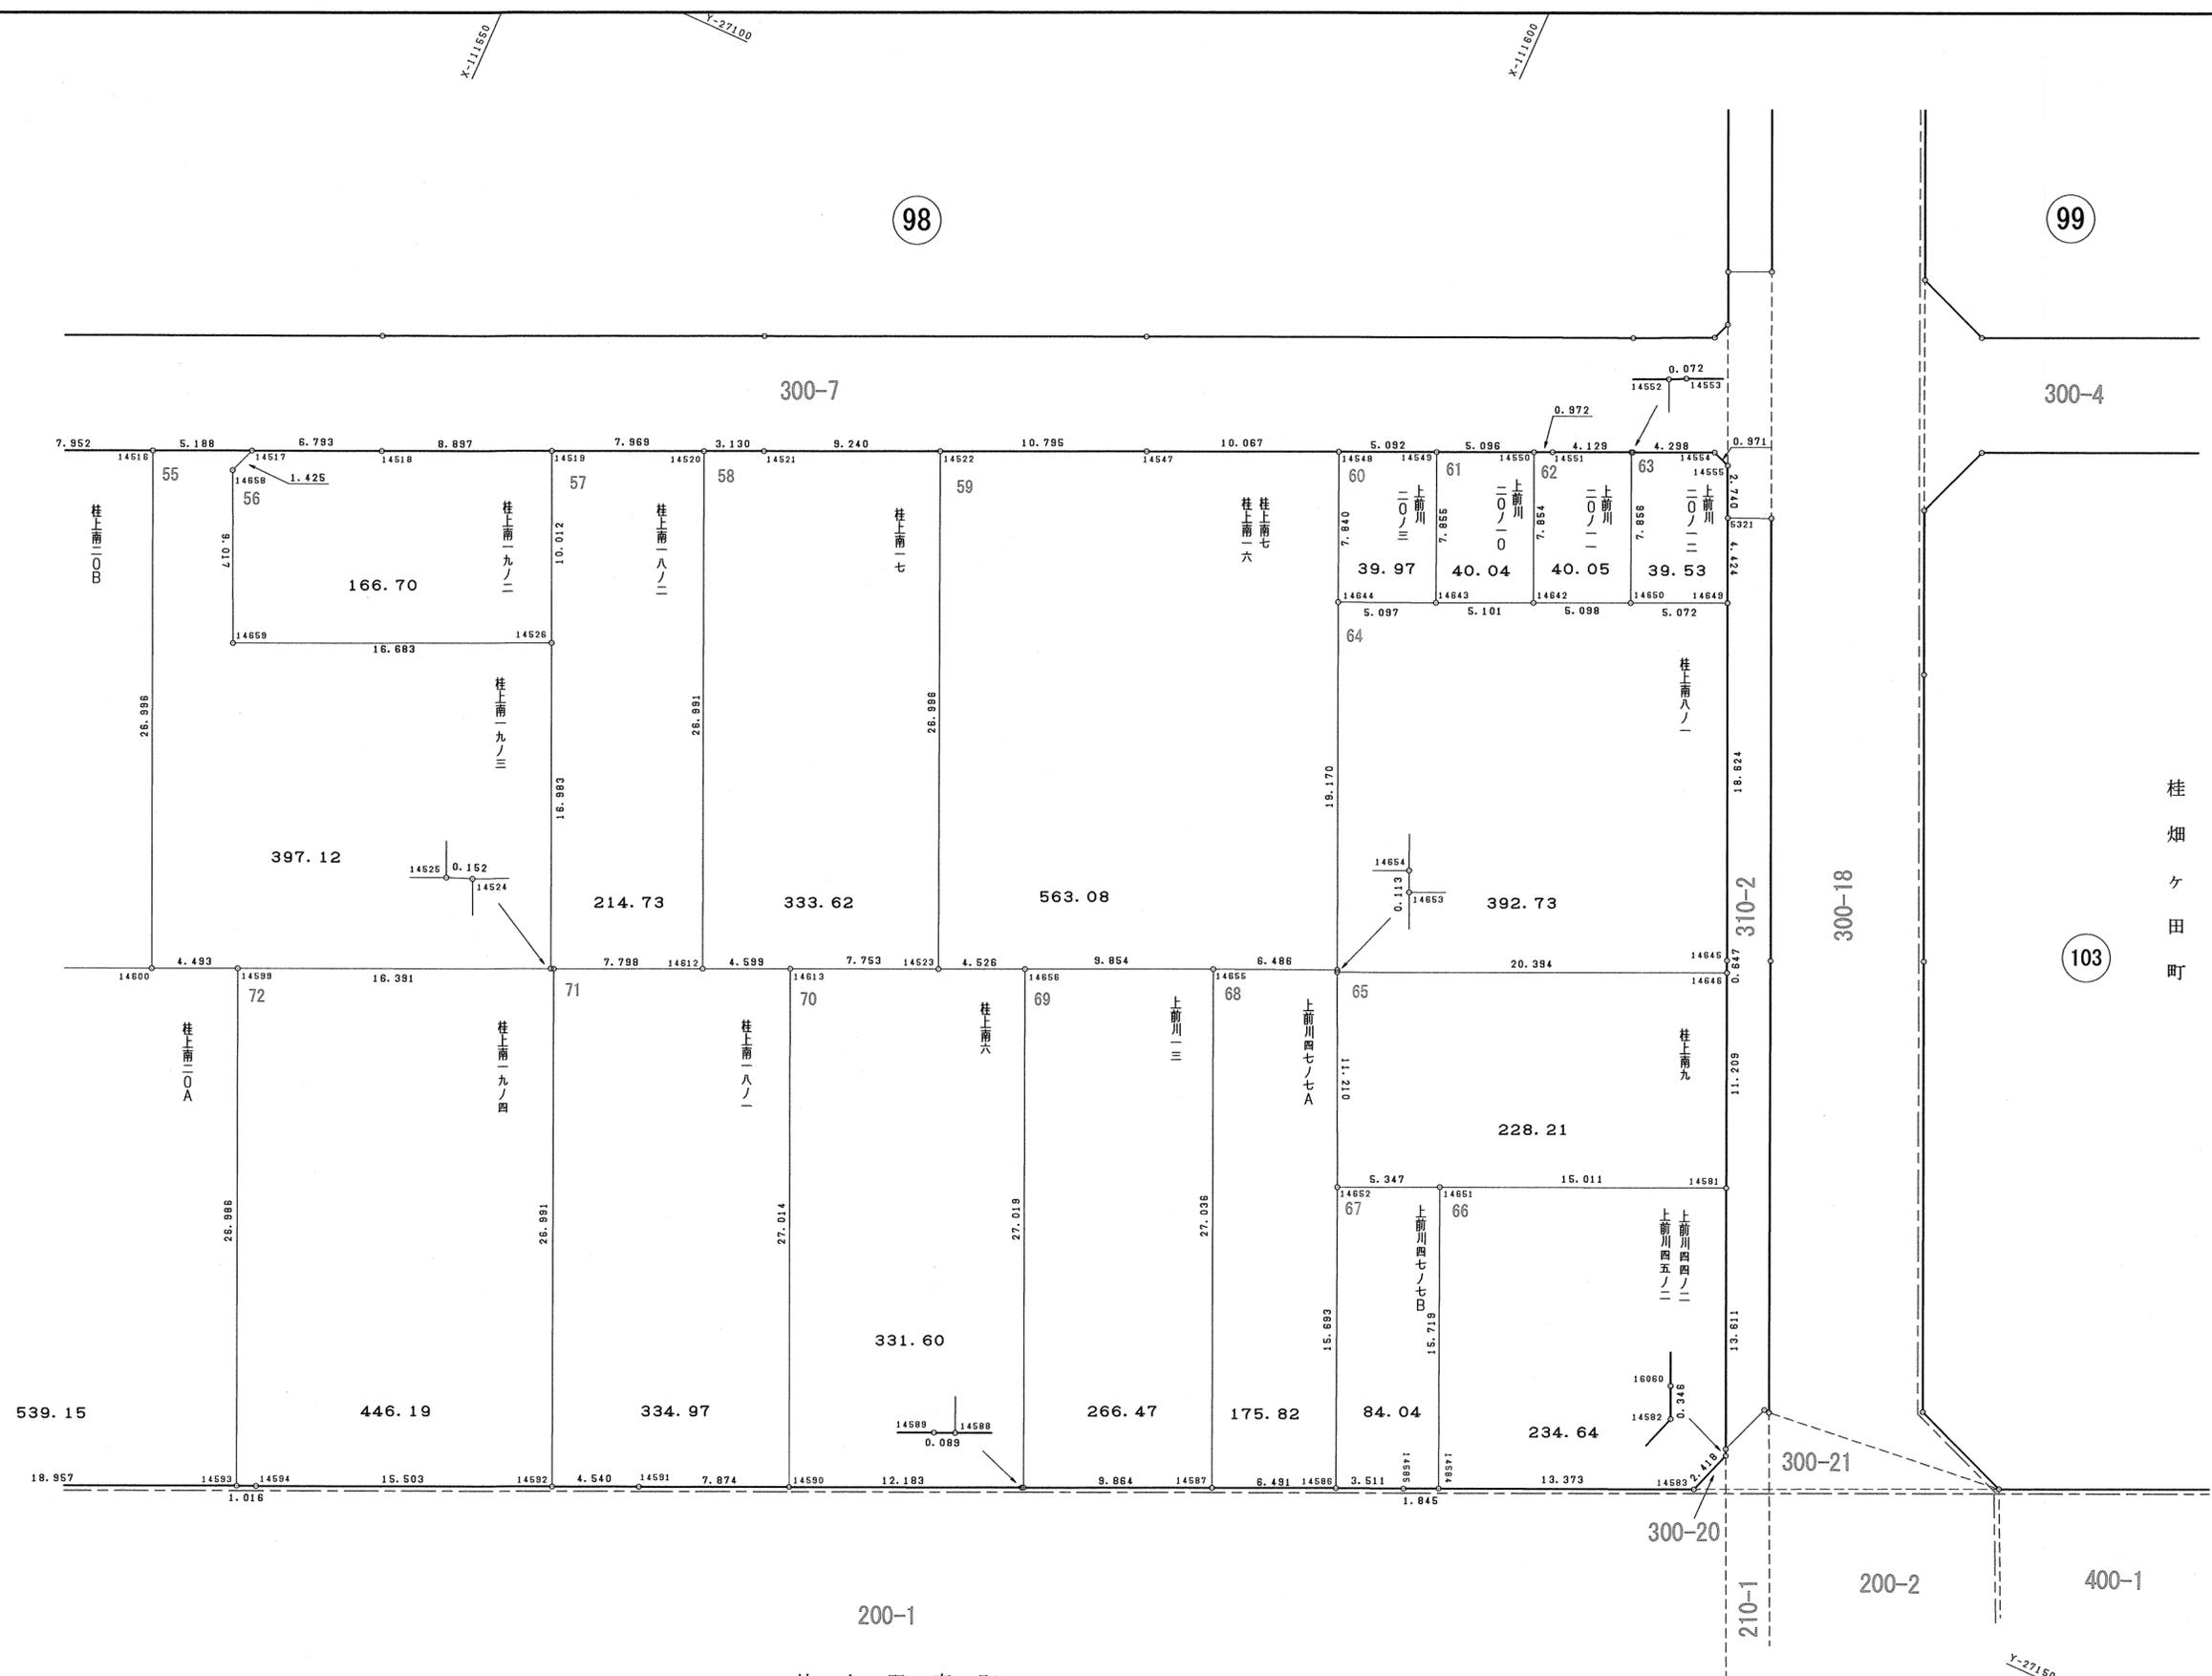

図面の種類	画地出来形確認測量図		
街区番号	102 _{2/2}	番号	縮尺 1:250
町名	桂上野東町		
京都市洛西第二土地区画整理組合			

51

地番 桂上南三一ノ四				
N O	X	Y	辺長	
14605	-111498.503	-27181.527		
14694	-111507.071	-27200.700	21.000	
14597	-111515.051	-27203.725	8.534	
14596	-111533.293	-27195.541	19.994	
14595	-111533.933	-27195.254	0.701	
14602	-111522.909	-27170.590	27.016	
14606	-111518.245	-27172.674	5.108	
14605	-111498.503	-27181.527	21.636	
面積	704.5339570			
地積	704.53 m ²			

52

地番 桂上東一ノ三				
N O	X	Y	辺長	
14657	-111490.197	-27155.687		
14693	-111488.691	-27159.636	4.226	
14695	-111497.692	-27179.711	22.001	
14605	-111498.503	-27181.527	1.989	
14606	-111518.245	-27172.674	21.636	
14607	-111507.224	-27148.051	26.977	
14657	-111490.197	-27155.687	18.661	
面積	579.3644590			
地積	579.36 m ²			

53

地番 桂上南三一ノ一				
N O	X	Y	辺長	
14607	-111507.224	-27148.051		
14606	-111518.245	-27172.674	26.977	
14602	-111522.909	-27170.590	5.108	
14601	-111527.390	-27168.597	4.904	
14609	-111516.356	-27143.956	26.999	
14608	-111508.451	-27147.501	8.663	
14607	-111507.224	-27148.051	1.345	
面積	270.1353885			
地積	270.13 m ²			

54

地番 桂上南二〇B				
N O	X	Y	辺長	
14609	-111516.356	-27143.956		
14601	-111527.390	-27168.597	26.999	
14598	-111539.595	-27163.111	13.381	
14600	-111553.721	-27156.795	15.474	
14516	-111542.698	-27132.152	26.996	
14611	-111535.440	-27135.402	7.952	
14610	-111524.415	-27140.343	12.082	
14609	-111516.356	-27143.956	8.832	
面積	778.9870595			
地積	778.98 m ²			

55

地番 桂上南一九ノ三				
N O	X	Y	辺長	
14516	-111542.698	-27132.152		
14600	-111553.721	-27156.795	26.996	
14599	-111557.823	-27154.962	4.493	
14525	-111572.780	-27148.258	16.391	
14526	-111565.851	-27132.753	16.983	
14659	-111550.631	-27139.586	16.683	
14658	-111546.927	-27131.365	9.017	
14517	-111547.433	-27130.033	1.425	
14516	-111542.698	-27132.152	5.188	
面積	397.1228225			
地積	397.12 m ²			

56

地番 桂上南一九ノ二				
N O	X	Y	辺長	
14658	-111546.927	-27131.365		
14659	-111550.631	-27139.586	9.017	
14526	-111565.851	-27132.753	16.683	
14519	-111561.752	-27123.619	10.012	
14518	-111553.633	-27127.257	8.897	
14517	-111547.433	-27130.033	6.793	
14658	-111546.927	-27131.365	1.425	
面積	166.7028120			
地積	166.70 m ²			

57

地番 桂上南一八ノ二				
N O	X	Y	辺長	
14519	-111561.752	-27123.619		
14526	-111565.851	-27132.753	10.012	
14525	-111572.780	-27148.258	16.983	
14524	-111572.921	-27148.202	0.152	
14612	-111580.033	-27145.004	7.798	
14520	-111569.024	-27120.360	26.991	
14519	-111561.752	-27123.619	7.969	
面積	214.7342075			
地積	214.73 m ²			

58

地番 桂上南一七				
N O	X	Y	辺長	
14520	-111569.024	-27120.360		
14612	-111580.033	-27145.004	26.991	
14613	-111584.228	-27143.120	4.599	
14523	-111591.307	-27139.958	7.753	
14522	-111580.312	-27115.302	26.996	
14521	-111571.880	-27119.080	9.240	
14520	-111569.024	-27120.360	3.130	
面積	333.6241270			
地積	333.62 m ²			

59

地番 桂上南七、桂上南一六				
N O	X	Y	辺長	
14522	-111580.312	-27115.302		
14523	-111591.307	-27139.958	26.996	
14656	-111585.436	-27138.104	4.526	
14655	-111604.426	-27134.068	9.854	
14654	-111610.356	-27131.441	6.486	
14644	-111602.539	-27113.937	19.170	
14548	-111599.351	-27106.774	7.840	
14547	-111590.163	-27110.888	10.067	
14522	-111580.312	-27115.302	10.795	
面積	563.0868540			
地積	563.08 m ²			

60

地番 上前川二〇ノ三				
N O	X	Y	辺長	
14548	-111599.351	-27106.774		
14644	-111602.539	-27113.937	7.840	
14643	-111607.197	-27111.867	5.097	
14549	-111603.998	-27104.693	7.855	
14548	-111599.351	-27106.774	5.092	
面積	39.9795555			
地積	39.97 m ²			

61

地番 上前川二〇ノ一〇				
N O	X	Y	辺長	
14549	-111603.998	-27104.693		
14643	-111607.197	-27111.867	7.855	
14642	-111611.852	-27109.781	5.101	
14550	-111608.649	-27102.610	7.854	
14549	-111603.998	-27104.693	5.096	
面積	40.0461270			
地積	40.04 m ²			

62

地番 上前川二〇ノ一一				
N O	X	Y	辺長	
14550	-111608.649	-27102.610		
14642	-111611.852	-27109.781	7.854	
14650	-111616.502	-27107.691	5.098	
14552	-111613.301	-27100.517	7.856	
14551	-111609.536	-27102.213	4.129	
14550	-111608.649	-27102.610	0.972	
面積	40.0514570			
地積	40.05 m ²			

63

地番 上前川二〇ノ一二				
N O	X	Y	辺長	
14552	-111613.301	-27100.517		
14650	-111616.502	-27107.691	7.856	
14649	-111621.129	-27105.614	5.072	
5321	-111619.319	-27101.577	4.424	
14555	-111618.201	-27099.076	2.740	
14554	-111617.292	-27098.736	0.971	
14553	-111613.367	-27100.487	4.298	
14552	-111613.301	-27100.517	0.072	
面積	39.5313160			
地積	39.53 m ²			

64

地番 桂上南八ノ一				
N O	X	Y	辺長	
14644	-111602.539	-27113.937		
14654	-111610.356	-27131.441	19.170	
14653	-111610.402	-27131.544	0.113	
14646	-111629.011	-27123.200	20.394	
14645	-111628.747	-27122.609	0.647	
14649	-111621.129	-27105.614	18.624	
14650	-111616.502	-27107.691	5.072	
14642	-111611.852	-27109.781	5.098	
14643	-111607.197	-27111.867	5.101	
14644	-111602.539	-27113.937	5.097	
面積	392.7391675			
地積	392.73 m ²			

65

地番 桂上南九				
N O	X	Y	辺長	
14653	-111610.402	-27131.544		
14652	-111615.013	-27141.762	11.210	
14651	-111619.884	-27139.557	5.347	
14581	-111633.588	-27133.432	15.011	
14646	-111629.011	-27123.200	11.209	
14653	-111610.402	-27131.544	20.394	
面積	228.2121555			
地積	228.21 m ²			

66

地番 上前川四四ノ二、上前川四五ノ二				
N O	X	Y	辺長	
14651	-111619.884	-27139.557		
14584	-111626.281	-27153.915	15.719	
14583	-111638.489	-27148.456	13.373	
14582	-111639.286	-27146.173	2.418	
16060	-111639.146	-27145.857	0.346	
14581	-111633.588	-27133.432	13.611	
14651	-111619.884	-27139.557	15.011	
面積	234.6455735			
地積	234.64 m ²			

67

地番 上前川四七ノ七B				
N O	X	Y	辺長	
14652	-111615.013	-27141.762		
14586	-111621.391	-27156.100	15.693	
14585	-111624.597	-27154.668	3.511	
14584	-111626.281	-27153.915	1.845	
14651	-111619.884	-27139.557	15.719	
14652	-111615.013	-27141.762	5.347	
面積	84.0472915			
地積	84.04 m ²			

68

地番 上前川四七ノ七A				
N O	X	Y	辺長	
14655	-111604.426	-27134.068		
14587	-111615.465	-27158.748	27.036	
14586	-111621.391	-27156.100	6.491	
14652	-111615.013	-27141.762	15.693	
14653	-111610.402	-27131.544	11.210	
14654	-111610.356	-27131.441	0.113	
14655	-111604.426	-27134.068	6.486	
面積	175.8207950			
地積	175.82 m ²			



69

地番 上前川一三				
N O	X	Y	辺長	
14656	-111595.436	-27138.104		
14588	-111606.459	-27162.772	27.019	
14587	-111615.465	-27158.748	9.864	
14655	-111604.426	-27134.068	27.036	
14656	-111595.436	-27138.104	9.854	
面積	266.4715820			
地積	266.47 m ²			

70

地番 桂上南六				
N O	X	Y	辺長	
14613	-111584.228	-27143.120		
14590	-111595.256	-27167.781	27.014	
14589	-111606.378	-27162.808	12.183	
14588	-111606.459	-27162.772	0.089	
14656	-111595.436	-27138.104	27.019	
14523	-111591.307	-27139.958	4.526	
14613	-111584.228	-27143.120	7.753	
面積	331.6078790			
地積	331.60 m ²			

71</

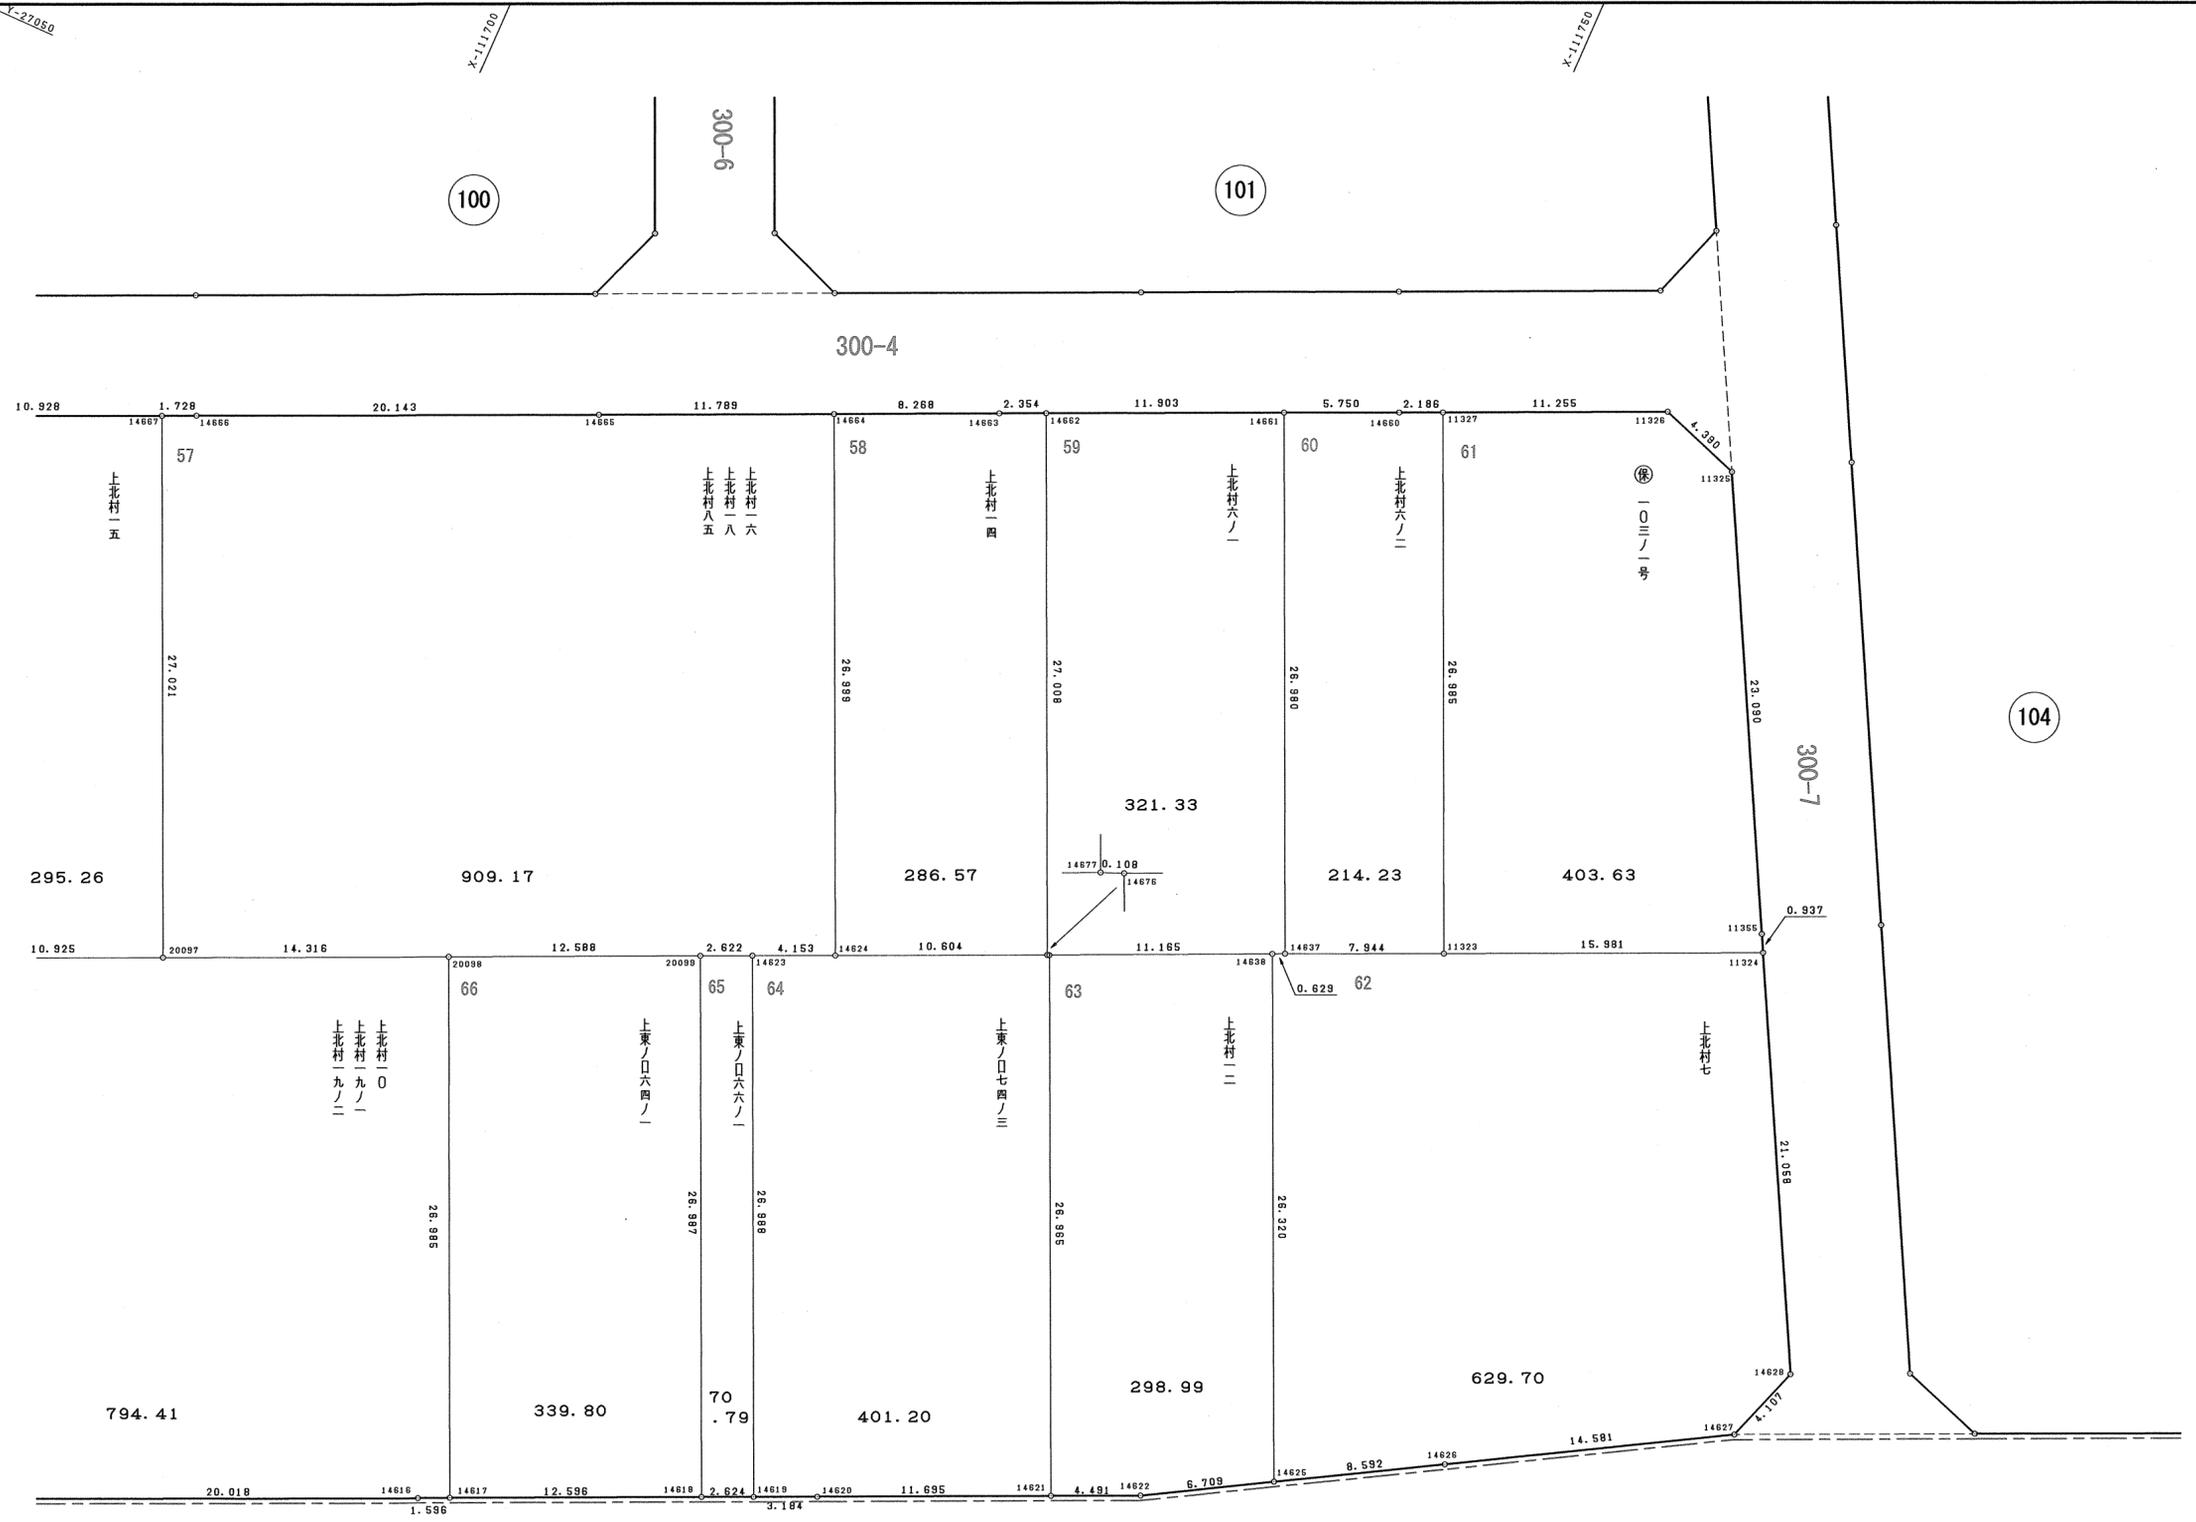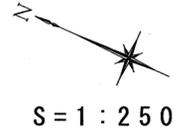

400-1
上 桂 北 村 町

図面の種類	画地出来形確認測量図		
街区番号	103 _{2/2}	番号	縮尺 1:250
町名	桂 畑 ケ 田 町		
京都市洛西第二土地区画整理組合			

51

地番 桂上南八ノ二			
NO	X	Y	辺長
20092	-111647.682	-27114.735	
20105	-111649.804	-27119.471	5.190
14558	-111640.486	-27123.637	10.207
14575	-111647.748	-27139.865	17.779
14878	-111653.034	-27141.893	5.662
14576	-111671.244	-27133.748	19.949
14577	-111673.028	-27132.949	1.955
20103	-111668.948	-27123.828	9.992
20093	-111662.014	-27108.327	16.981
20092	-111647.682	-27114.735	15.699
面積	637.7508220		
地積	637.75 m ²		

52

地番 桂上南八ノ三			
NO	X	Y	辺長
14559	-111638.366	-27118.900	
14558	-111640.486	-27123.637	5.190
20105	-111649.804	-27119.471	10.207
20092	-111647.682	-27114.735	5.190
20091	-111646.067	-27115.457	1.769
14559	-111638.366	-27118.900	8.436
面積	52.9651575		
地積	52.96 m ²		

53

地番 桂上南一三、桂上南一五			
NO	X	Y	辺長
14564	-111635.026	-27090.793	
14563	-111630.053	-27093.018	5.448
14562	-111628.530	-27096.997	4.261
14561	-111632.042	-27104.799	8.556
14560	-111638.157	-27118.433	14.943
14559	-111638.366	-27118.900	0.512
20091	-111646.067	-27115.457	8.436
14564	-111635.026	-27090.793	27.023
面積	223.7329440		
地積	223.73 m ²		

54

地番 桂上南一四ノ二			
NO	X	Y	辺長
14566	-111651.803	-27083.287	
14565	-111646.841	-27085.507	5.436
14564	-111635.026	-27090.793	12.944
20091	-111646.067	-27115.457	27.023
20092	-111647.682	-27114.735	1.769
20093	-111662.014	-27108.327	15.699
14692	-111662.841	-27107.957	0.906
14566	-111651.803	-27083.287	27.027
面積	496.6330910		
地積	496.63 m ²		

55

地番 保一〇三ノ二号			
NO	X	Y	辺長
14566	-111651.803	-27083.287	
14692	-111662.841	-27107.957	27.027
20094	-111673.172	-27103.328	11.321
20095	-111689.590	-27095.971	17.991
20096	-111693.429	-27094.250	4.207
14668	-111682.399	-27069.578	27.025
14669	-111676.484	-27072.226	6.481
14670	-111665.661	-27077.072	11.858
14671	-111652.500	-27082.975	14.424
14566	-111651.803	-27083.287	0.764
面積	906.0885365		
地積	906.08 m ²		

56

地番 上北村一五			
NO	X	Y	辺長
14668	-111682.399	-27069.578	
20096	-111693.429	-27094.250	27.025
20097	-111703.399	-27089.783	10.925
14667	-111692.374	-27065.114	27.021
14668	-111682.399	-27069.578	10.928
面積	295.2698625		
地積	295.26 m ²		

57

地番 上北村一六、一八、八五			
NO	X	Y	辺長
14667	-111692.374	-27065.114	
20097	-111703.399	-27089.783	27.021
20098	-111716.463	-27083.929	14.316
20099	-111727.950	-27078.781	12.588
14623	-111730.343	-27077.709	2.622
14624	-111734.137	-27076.019	4.153
14664	-111723.103	-27051.378	26.999
14665	-111712.343	-27056.194	11.789
14666	-111693.951	-27064.408	20.143
14667	-111692.374	-27065.114	1.728
面積	909.1729845		
地積	909.17 m ²		

58

地番 上北村一四			
NO	X	Y	辺長
14664	-111723.103	-27051.378	
14624	-111734.137	-27076.019	26.999
14677	-111743.819	-27071.695	10.604
14662	-111732.797	-27047.038	27.008
14663	-111730.649	-27048.000	2.354
14664	-111723.103	-27051.378	8.268
面積	286.5711540		
地積	286.57 m ²		

59

地番 上北村六ノ一			
NO	X	Y	辺長
14662	-111732.797	-27047.038	
14677	-111743.819	-27071.695	27.008
14676	-111743.919	-27071.654	0.108
14638	-111754.098	-27067.067	11.165
14637	-111754.670	-27066.806	0.629
14661	-111743.661	-27042.174	26.980
14662	-111732.797	-27047.038	11.903
面積	321.3332265		
地積	321.33 m ²		

60

地番 上北村六ノ二			
NO	X	Y	辺長
14661	-111743.661	-27042.174	
14637	-111754.670	-27066.806	26.980
11323	-111761.923	-27063.565	7.944
11327	-111750.904	-27038.932	26.985
14660	-111748.909	-27038.825	2.186
14661	-111743.661	-27042.174	5.750
面積	214.2381365		
地積	214.23 m ²		

61

地番 保一〇三ノ一号			
NO	X	Y	辺長
11323	-111761.923	-27063.565	
11324	-111776.506	-27057.029	15.981
11355	-111776.070	-27056.200	0.937
11325	-111765.331	-27035.759	23.090
11326	-111761.178	-27034.336	4.390
11327	-111750.904	-27038.932	11.255
11323	-111761.923	-27063.565	26.985
面積	403.6306165		
地積	403.63 m ²		

62

地番 上北村七			
NO	X	Y	辺長
14638	-111754.098	-27067.067	
14625	-111764.866	-27091.084	26.320
14626	-111772.317	-27086.806	8.592
14627	-111784.963	-27079.548	14.581
14628	-111786.307	-27075.667	4.107
11324	-111776.506	-27057.029	21.058
11323	-111761.923	-27063.565	15.981
14637	-111754.670	-27066.806	7.944
14638	-111754.098	-27067.067	0.629
面積	629.7089925		
地積	629.70 m ²		

63

地番 上北村一二			
NO	X	Y	辺長
14676	-111743.919	-27071.654	
14621	-111754.949	-27096.260	26.965
14622	-111759.048	-27094.425	4.491
14625	-111764.866	-27091.084	6.709
14638	-111754.098	-27067.067	26.320
14676	-111743.919	-27071.654	11.165
面積	298.9947850		
地積	298.99 m ²		

64

地番 上東ノ口七四ノ三			
NO	X	Y	辺長
14623	-111730.343	-27077.709	
14619	-111741.369	-27102.342	26.988
14620	-111744.275	-27101.040	3.184
14621	-111754.949	-27096.260	11.695
14676	-111743.919	-27071.654	26.965
14677	-111743.819	-27071.695	0.108
14624	-111734.137	-27076.019	10.604
14623	-111730.343	-27077.709	4.153
面積	401.2066590		
地積	401.20 m ²		

65

地番 上東ノ口六六ノ一			
NO	X	Y	辺長
14623	-111730.343	-27077.709	
20099	-111727.950	-27078.781	2.622
14618	-111738.974	-27103.414	26.987
14619	-111741.369	-27102.342	2.624
14623	-111730.343	-27077.709	26.988
面積	70.7902020		
地積	70.79 m ²		

66

地番 上東ノ口六四ノ一			
NO	X	Y	辺長
20099	-111727.950	-27078.781	
20098	-111716.463	-27083.929	12.588
14617	-111727.478	-27108.563	26.985
14618	-111738.974	-27103.414	12.596
20099	-111727.950	-27078.781	26.987
面積	339.8097610		
地積	339.80 m ²		

67

地番 上北村一〇、一九ノ一、一九ノ二			
NO	X	Y	辺長
20095	-111689.590	-27095.971	
14614	-111700.605	-27120.594	26.974
14615	-111707.750	-27117.394	7.829
14616	-111726.021	-27109.215	20.018
14617	-111727.478	-27108.563	1.596
20098	-111716.463	-27083.929	26.985
20097	-111703.399	-27089.783	14.316
20096	-111693.429	-27094.250	10.925
20095	-111689.590	-27095.971	4.207
面積	794.4114715		
地積	794.41 m ²		

68

地番 上北村二一ノ二			
NO	X	Y	辺長
20094	-111673.172	-27103.328	
14579	-111684.187	-27127.949	26.973
14580	-111689.501	-27125.568	5.823
14614	-111700.605	-27120.594	12.167
20095	-111689.590	-27095.971	26.974
20094	-111673.172	-27103.328	17.991
面積	485.2669420		
地積	485.26 m ²		



69

地番 上北村二一ノ一			
NO	X	Y	辺長
20093	-111662.014	-27108.327	
20103	-111668.948	-27123.828	16.981
20104	-111672.965	-27122.010	4.409
14578	-111677.038	-27131.152	10.008
14579	-111684.187	-27127.949	7.834
20094	-111673.172	-27103.328	26.973
14692	-111662.841	-27107.957	11.321
20093	-111662.014	-27108.327	0.906
面積	285.7837665		
地積	285.78 m ²		

70

地番 上北村八六			
NO	X	Y	辺長
20104	-111672.965	-27122.010	
20103	-111668.948	-27123.828	4.409
14577	-111673.028	-27132.949	9.992
14578	-111677.038	-27131.152	4.394
20104	-111672.965	-27122.010	10.008
面積	44.0175490		
地積	44.01 m ²		

図面の種類	画地面積求積表		
街区番号	103	番号	縮尺
町名	桂畑ヶ田町		
京都市洛西第二土地区画整理組合			

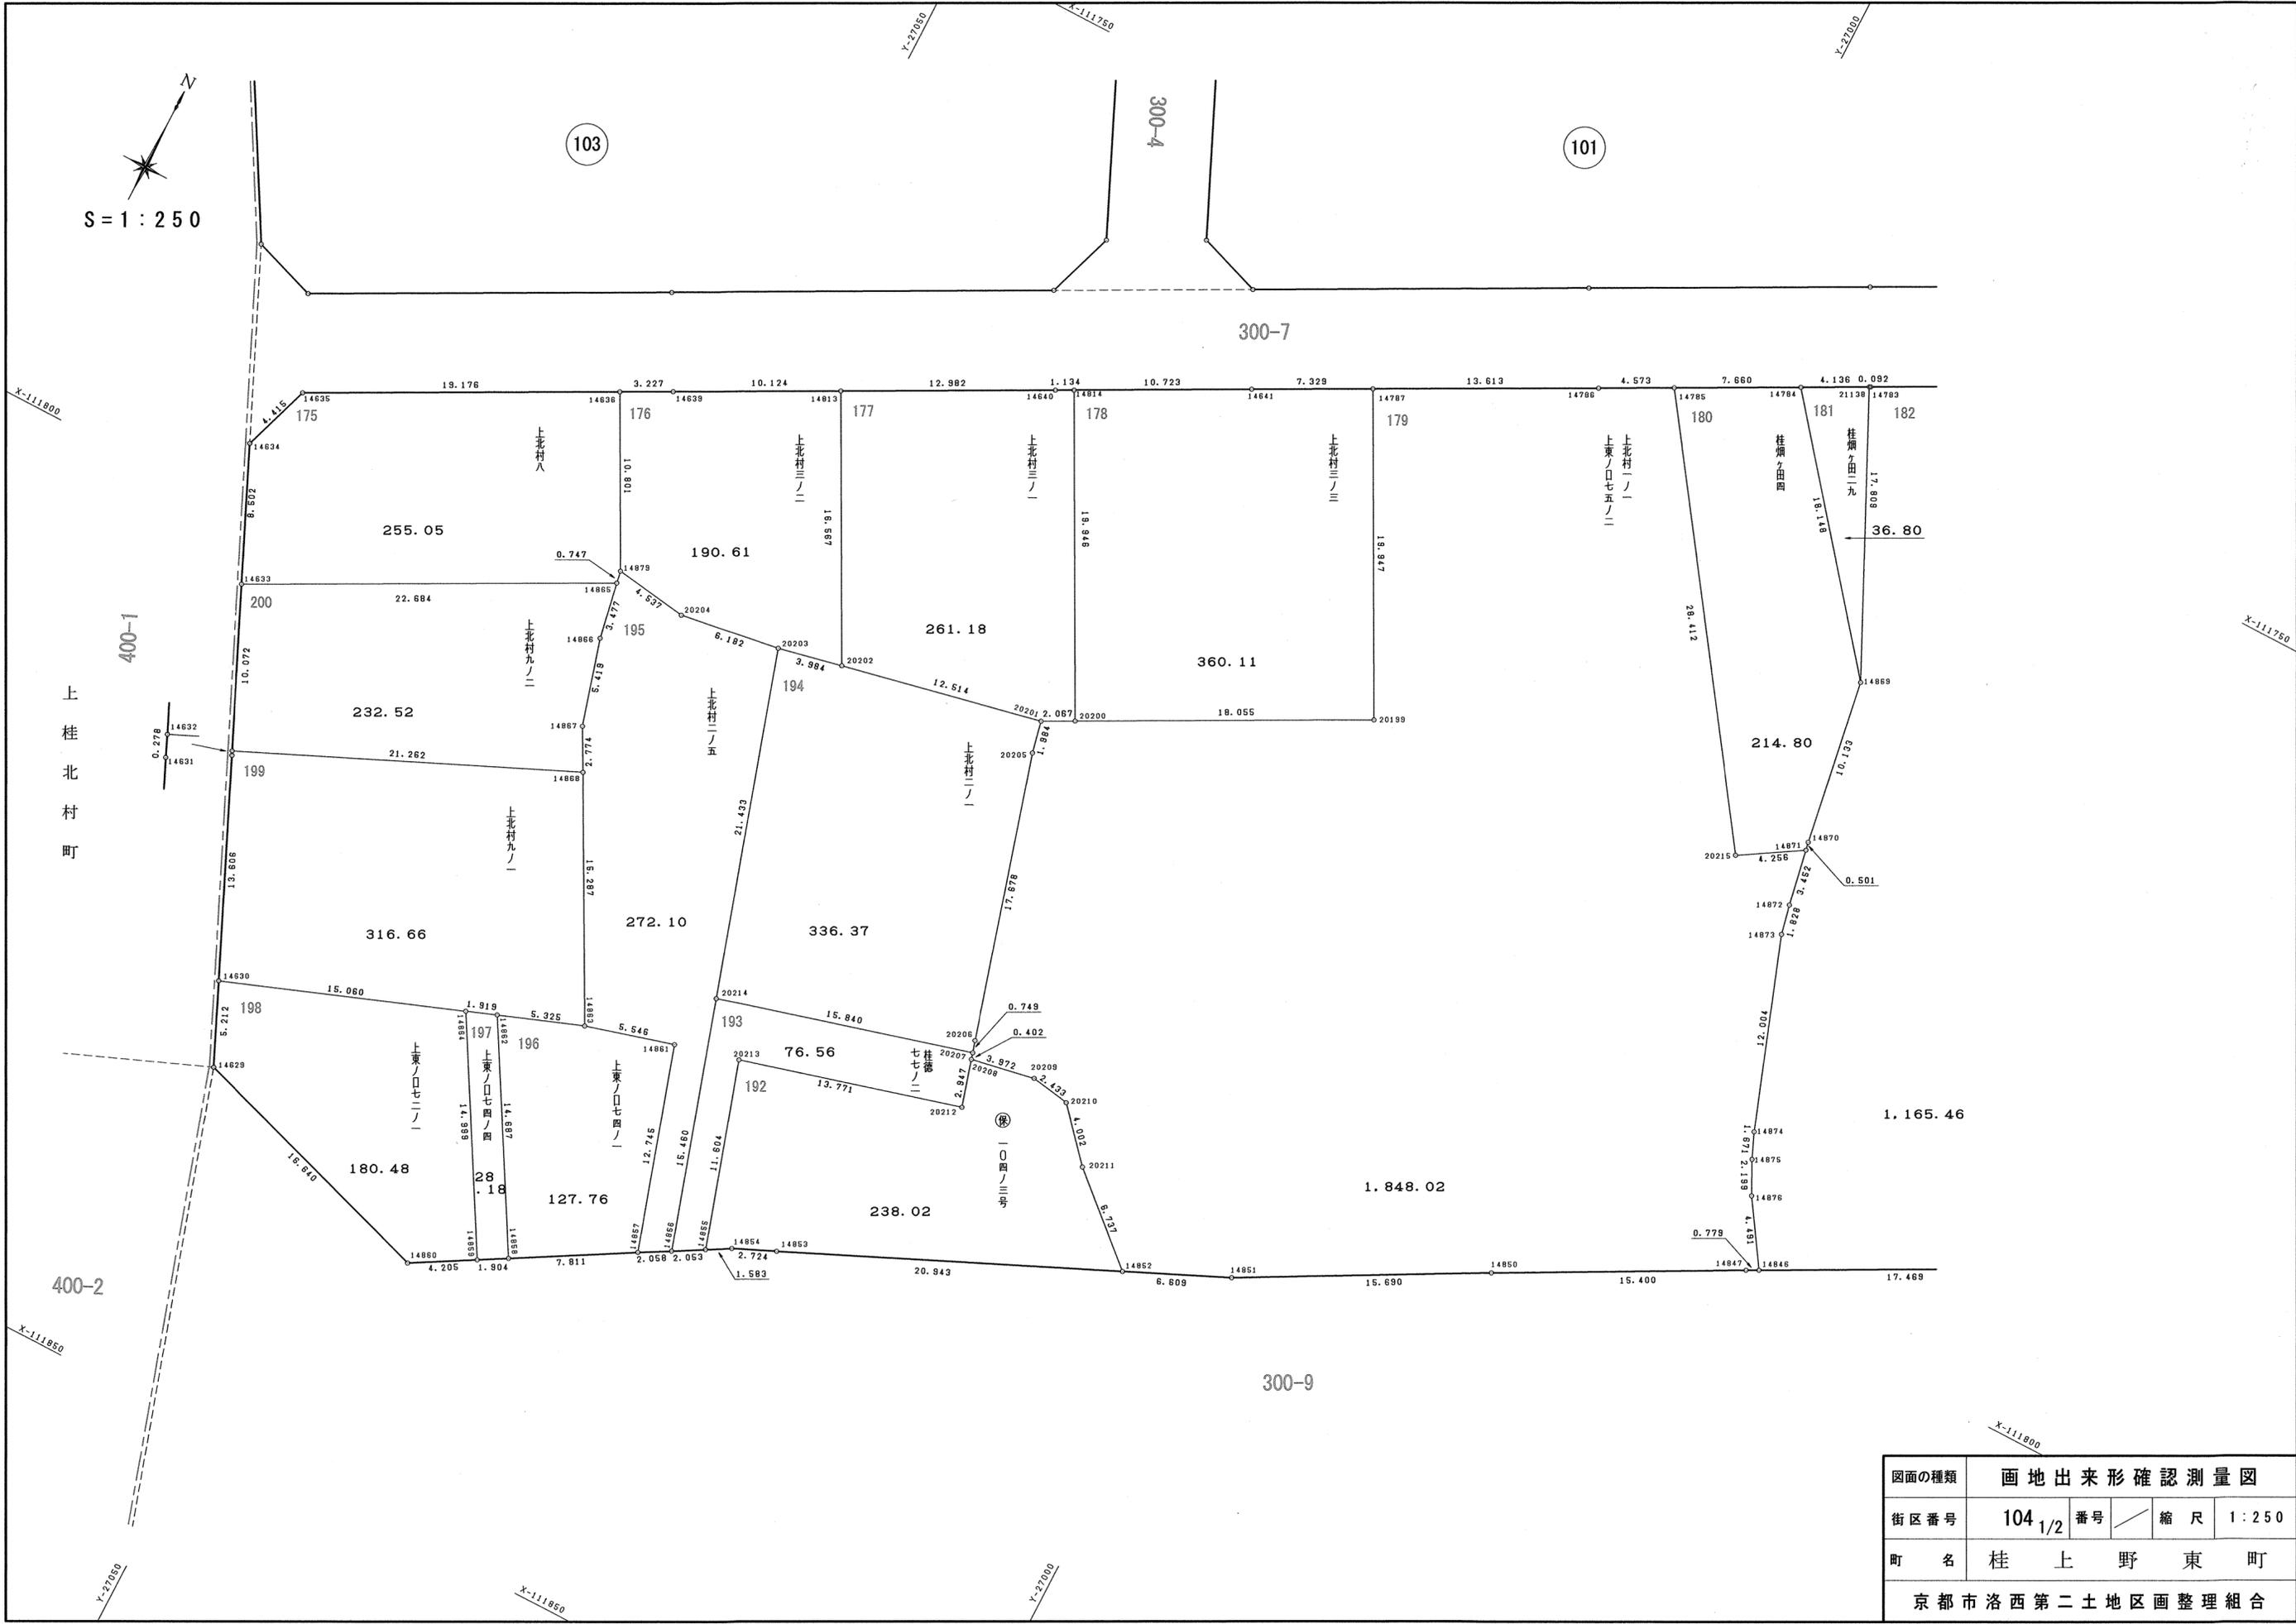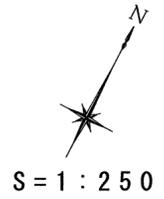

図面の種類	画地出来形確認測量図		
街区番号	104 1/2	番号	縮尺 1:250
町名	桂上野東町		
京都市洛西第二土地区画整理組合			

175

地番 上北村八			
N O	X	Y	辺長
14636	-111782.843	-27056.219	
14635	-111791.759	-27073.196	19.176
14634	-111795.936	-27074.625	4.415
14633	-111803.695	-27071.149	8.502
14865	-111793.143	-27051.068	22.684
14879	-111792.408	-27051.201	0.747
14636	-111782.843	-27056.219	10.801
面積	255.0509585		
地積	255.05 m ²		

176

地番 上北村三ノ二			
N O	X	Y	辺長
14636	-111782.843	-27056.219	
14879	-111792.408	-27051.201	10.801
20204	-111793.057	-27046.711	4.537
20203	-111792.142	-27040.597	6.182
20202	-111791.313	-27036.700	3.984
14813	-111776.642	-27044.396	16.567
14639	-111781.343	-27053.362	10.124
14636	-111782.843	-27056.219	3.227
面積	190.6117985		
地積	190.61 m ²		

177

地番 上北村三ノ一			
N O	X	Y	辺長
14813	-111776.642	-27044.396	
20202	-111791.313	-27036.700	16.567
20201	-111788.711	-27024.460	12.514
20200	-111787.751	-27022.630	2.067
14814	-111770.087	-27031.894	19.946
14640	-111770.614	-27032.898	1.134
14813	-111776.642	-27044.396	12.982
面積	261.1881880		
地積	261.18 m ²		

178

地番 上北村三ノ三			
N O	X	Y	辺長
14814	-111770.087	-27031.894	
20200	-111787.751	-27022.630	19.946
20199	-111779.361	-27006.643	18.055
14787	-111761.697	-27015.910	19.947
14641	-111765.102	-27022.400	7.329
14814	-111770.087	-27031.894	10.723
面積	360.1182070		
地積	360.11 m ²		

179

地番 上北村一ノ一、上東ノ口七五ノ二			
N O	X	Y	辺長
14785	-111753.243	-26999.808	
14786	-111755.373	-27003.855	4.573
14787	-111761.697	-27015.910	13.613
20199	-111779.361	-27006.643	18.947
20200	-111787.751	-27022.630	18.055
20201	-111788.711	-27024.460	2.067
20205	-111790.649	-27024.035	1.984
20206	-111807.630	-27019.119	17.678
20207	-111808.348	-27018.907	0.749
20208	-111808.733	-27018.793	0.402
20209	-111807.997	-27014.890	3.972
20210	-111808.395	-27012.490	2.433
20211	-111811.386	-27009.831	4.002
14852	-111815.848	-27004.784	6.737
14851	-111813.144	-26998.754	6.609
14850	-111805.637	-26984.976	15.690
14847	-111798.376	-26971.395	15.400
14846	-111798.012	-26970.706	0.779
14876	-111794.253	-26973.163	4.491
14875	-111792.292	-26974.158	2.199
14874	-111790.755	-26974.814	1.671
14873	-111779.447	-26978.841	12.004
14872	-111777.662	-26979.233	1.828
14871	-111774.269	-26979.871	3.452
20215	-111776.504	-26983.493	4.256
14785	-111753.243	-26999.808	28.412
面積	1848.0236305		
地積	1848.02 m ²		

180

地番 桂畑ヶ田四			
N O	X	Y	辺長
14785	-111753.243	-26999.808	
20215	-111776.504	-26983.493	28.412
14871	-111774.269	-26979.871	4.256
14870	-111773.777	-26979.964	0.501
14869	-111763.778	-26981.606	10.133
14784	-111749.676	-26993.029	18.148
14785	-111753.243	-26999.808	7.660
面積	214.8077900		
地積	214.80 m ²		

181

地番 桂畑ヶ田二九			
N O	X	Y	辺長
14784	-111749.676	-26993.029	
14869	-111763.778	-26981.606	18.148
21138	-111747.750	-26989.369	17.809
14784	-111749.676	-26993.029	4.136
面積	36.8070090		
地積	36.80 m ²		

182

地番 桂畑ヶ田三、桂畑ヶ田五			
N O	X	Y	辺長
11330	-111739.909	-26974.476	
14783	-111747.707	-26989.288	16.739
21138	-111747.750	-26989.369	0.092
14869	-111763.778	-26981.606	17.809
14870	-111773.777	-26979.964	10.133
14871	-111774.269	-26979.871	0.501
14872	-111777.662	-26979.233	3.452
14873	-111779.447	-26978.841	1.828
14874	-111790.755	-26974.814	12.004
14875	-111792.292	-26974.158	1.671
14876	-111794.253	-26973.163	2.199
14846	-111798.012	-26970.706	4.491
14845	-111789.861	-26955.255	17.469
14849	-111771.738	-26957.917	18.317
14848	-111762.760	-26958.877	9.029
14781	-111757.966	-26959.067	4.798
14782	-111752.158	-26959.106	5.808
11332	-111748.418	-26958.843	3.749
11331	-111744.641	-26972.004	13.692
11330	-111739.909	-26974.476	5.339
面積	1165.4631665		
地積	1165.46 m ²		

183

地番 保 一〇四ノ二号			
N O	X	Y	辺長
11328	-111734.752	-26964.650	
11329	-111739.578	-26973.847	10.386
11330	-111739.909	-26974.476	0.711
11331	-111744.641	-26972.004	5.339
11332	-111748.418	-26958.843	13.692
11333	-111747.849	-26957.787	1.200
11328	-111734.752	-26964.650	14.786
面積	117.4570275		
地積	117.45 m ²		

184

地番 桂畑ヶ田一五ノ一B			
N O	X	Y	辺長
14764	-111730.811	-26957.141	
11328	-111734.752	-26964.650	8.480
11333	-111747.849	-26957.787	14.786
11332	-111748.418	-26958.843	1.200
14782	-111752.158	-26959.106	3.749
14781	-111757.966	-26959.067	5.808
14780	-111751.681	-26947.116	13.503
14779	-111751.292	-26946.387	0.826
14764	-111730.811	-26957.141	23.133
面積	226.6432220		
地積	226.64 m ²		

185

地番 桂畑ヶ田九B			
N O	X	Y	辺長
16269	-111724.968	-26946.023	
14765	-111730.438	-26956.430	11.757
14764	-111730.811	-26957.141	0.803
14779	-111751.292	-26946.387	23.133
16270	-111745.449	-26935.270	12.559
16269	-111724.968	-26946.023	23.132
面積	290.5265385		
地積	290.52 m ²		

186

地番 桂畑ヶ田三〇			
N O	X	Y	辺長
14778	-111744.008	-26932.520	
14766	-111723.525	-26943.278	23.136
16269	-111724.968	-26946.023	3.101
16270	-111745.449	-26935.270	23.132
14778	-111744.008	-26932.520	3.105
面積	71.7837260		
地積	71.78 m ²		

187

地番 桂畑ヶ田一七B			
N O	X	Y	辺長
14768	-111715.333	-26927.708	
14767	-111721.193	-26938.841	12.581
14766	-111723.525	-26943.278	5.013
14778	-111744.008	-26932.520	23.136
14777	-111741.474	-26927.703	5.443
14770	-111735.108	-26915.578	13.695
14769	-111716.685	-26923.816	20.181
14768	-111715.333	-26927.708	4.120
面積	455.2505220		
地積	455.25 m ²		

188

地番 桂畑ヶ田一七A			
N O	X	Y	辺長
14770	-111735.108	-26915.578	
14777	-111741.474	-26927.703	13.695
14776	-111760.263	-26919.274	20.599
14772	-111753.885	-26907.152	13.698
14771	-111738.688	-26913.977	16.659
14770	-111735.108	-26915.578	3.922
面積	281.3641790		
地積	281.36 m ²		

189

地番 桂畑ヶ田一六			
N O	X	Y	辺長
14772	-111753.885	-26907.152	
14776	-111760.263	-26919.274	13.698
14775	-111768.837	-26915.436	9.394
14774	-111764.300	-26906.865	9.698
14773	-111758.776	-26904.955	5.845
14772	-111753.885	-26907.152	5.362
面積	120.2299570		
地積	120.22 m ²		

190

地番 桂畑ヶ田一ノ一、二ノ一、二八			
N O	X	Y	辺長
14777	-111741.474	-26927.703	
14778	-111744.008	-26932.520	5.443
16270	-111745.449	-26935.270	3.105
14779	-111751.292	-26946.387	12.559
14780	-111751.681	-26947.116	0.826
14843	-111778.181	-26933.138	29.961
14842	-111775.035	-26927.183	6.735
14841	-111770.301	-26918.202	10.152
14775	-111768.837	-26915.436	3.130
14776	-111760.263	-26919.274	9.394
14777	-111741.474	-26927.703	20.599
面積	628.1965545		
地積	628.19 m ²		

191

地番 桂畑ヶ田二ノ三			
N O	X	Y	辺長
14780	-111751.681	-26947.116	
14781	-111757.966	-26959.067	13.503
14848	-111762.760	-26958.877	4.798
14849	-111771.738	-26957.917	9.029
14845	-111789.861	-26955.255	18.317
14844	-111786.712	-26949.286	6.749
14843	-111778.181	-26933.138	18.263
14780	-111751.681	-26947.116	29.961
面積	586.6433130		
地積	586.64 m ²		

192

地番 保 一〇四ノ三号			
N O	X	Y	辺長
14855	-111826.308	-27027.757	
14854	-111825.514	-27026.387	1.583
14853	-111824.418	-27023.893	2.724
14852	-111815.848	-27004.784	20.943
20211	-111811.386	-27009.831	6.737
20210	-111808.395	-27012.490	4.002
20209	-111807.997	-27014.890	2.433
20208	-111808.733	-27018.793	3.972
20212	-111811.563	-27017.970	2.947
20213	-111815.239	-27031.241	13.771


地番 上北村九ノ一			
NO	X	Y	辺長
14868	-111804.213	-27047.616	
14632	-111812.886	-27067.029	21.262
14631	-111813.140	-27066.915	0.278
14630	-111825.555	-27061.348	13.606
14864	-111820.267	-27047.247	15.060
14863	-111819.587	-27045.452	1.919
14862	-111817.724	-27040.464	5.325
14868	-111804.213	-27047.616	15.287
面積	316.6634690		
地積	316.66 m ²		

地番 上北村九ノ二			
NO	X	Y	辺長
14865	-111793.143	-27051.068	
14633	-111803.695	-27071.148	22.684
14632	-111812.886	-27067.029	10.072
14868	-111804.213	-27047.616	21.262
14867	-111801.766	-27048.923	2.774
14866	-111796.560	-27050.426	5.419
14865	-111793.143	-27051.068	3.477
面積	232.5225645		
地積	232.52 m ²		

図面の種類				画地面積求積表			
街区番号	104	番号	$\frac{2}{2}$	縮尺			
町名	桂畑ケ田町						
京都市洛西第二土地区画整理組合							

桂畑ヶ田町 300-8

S = 1 : 250

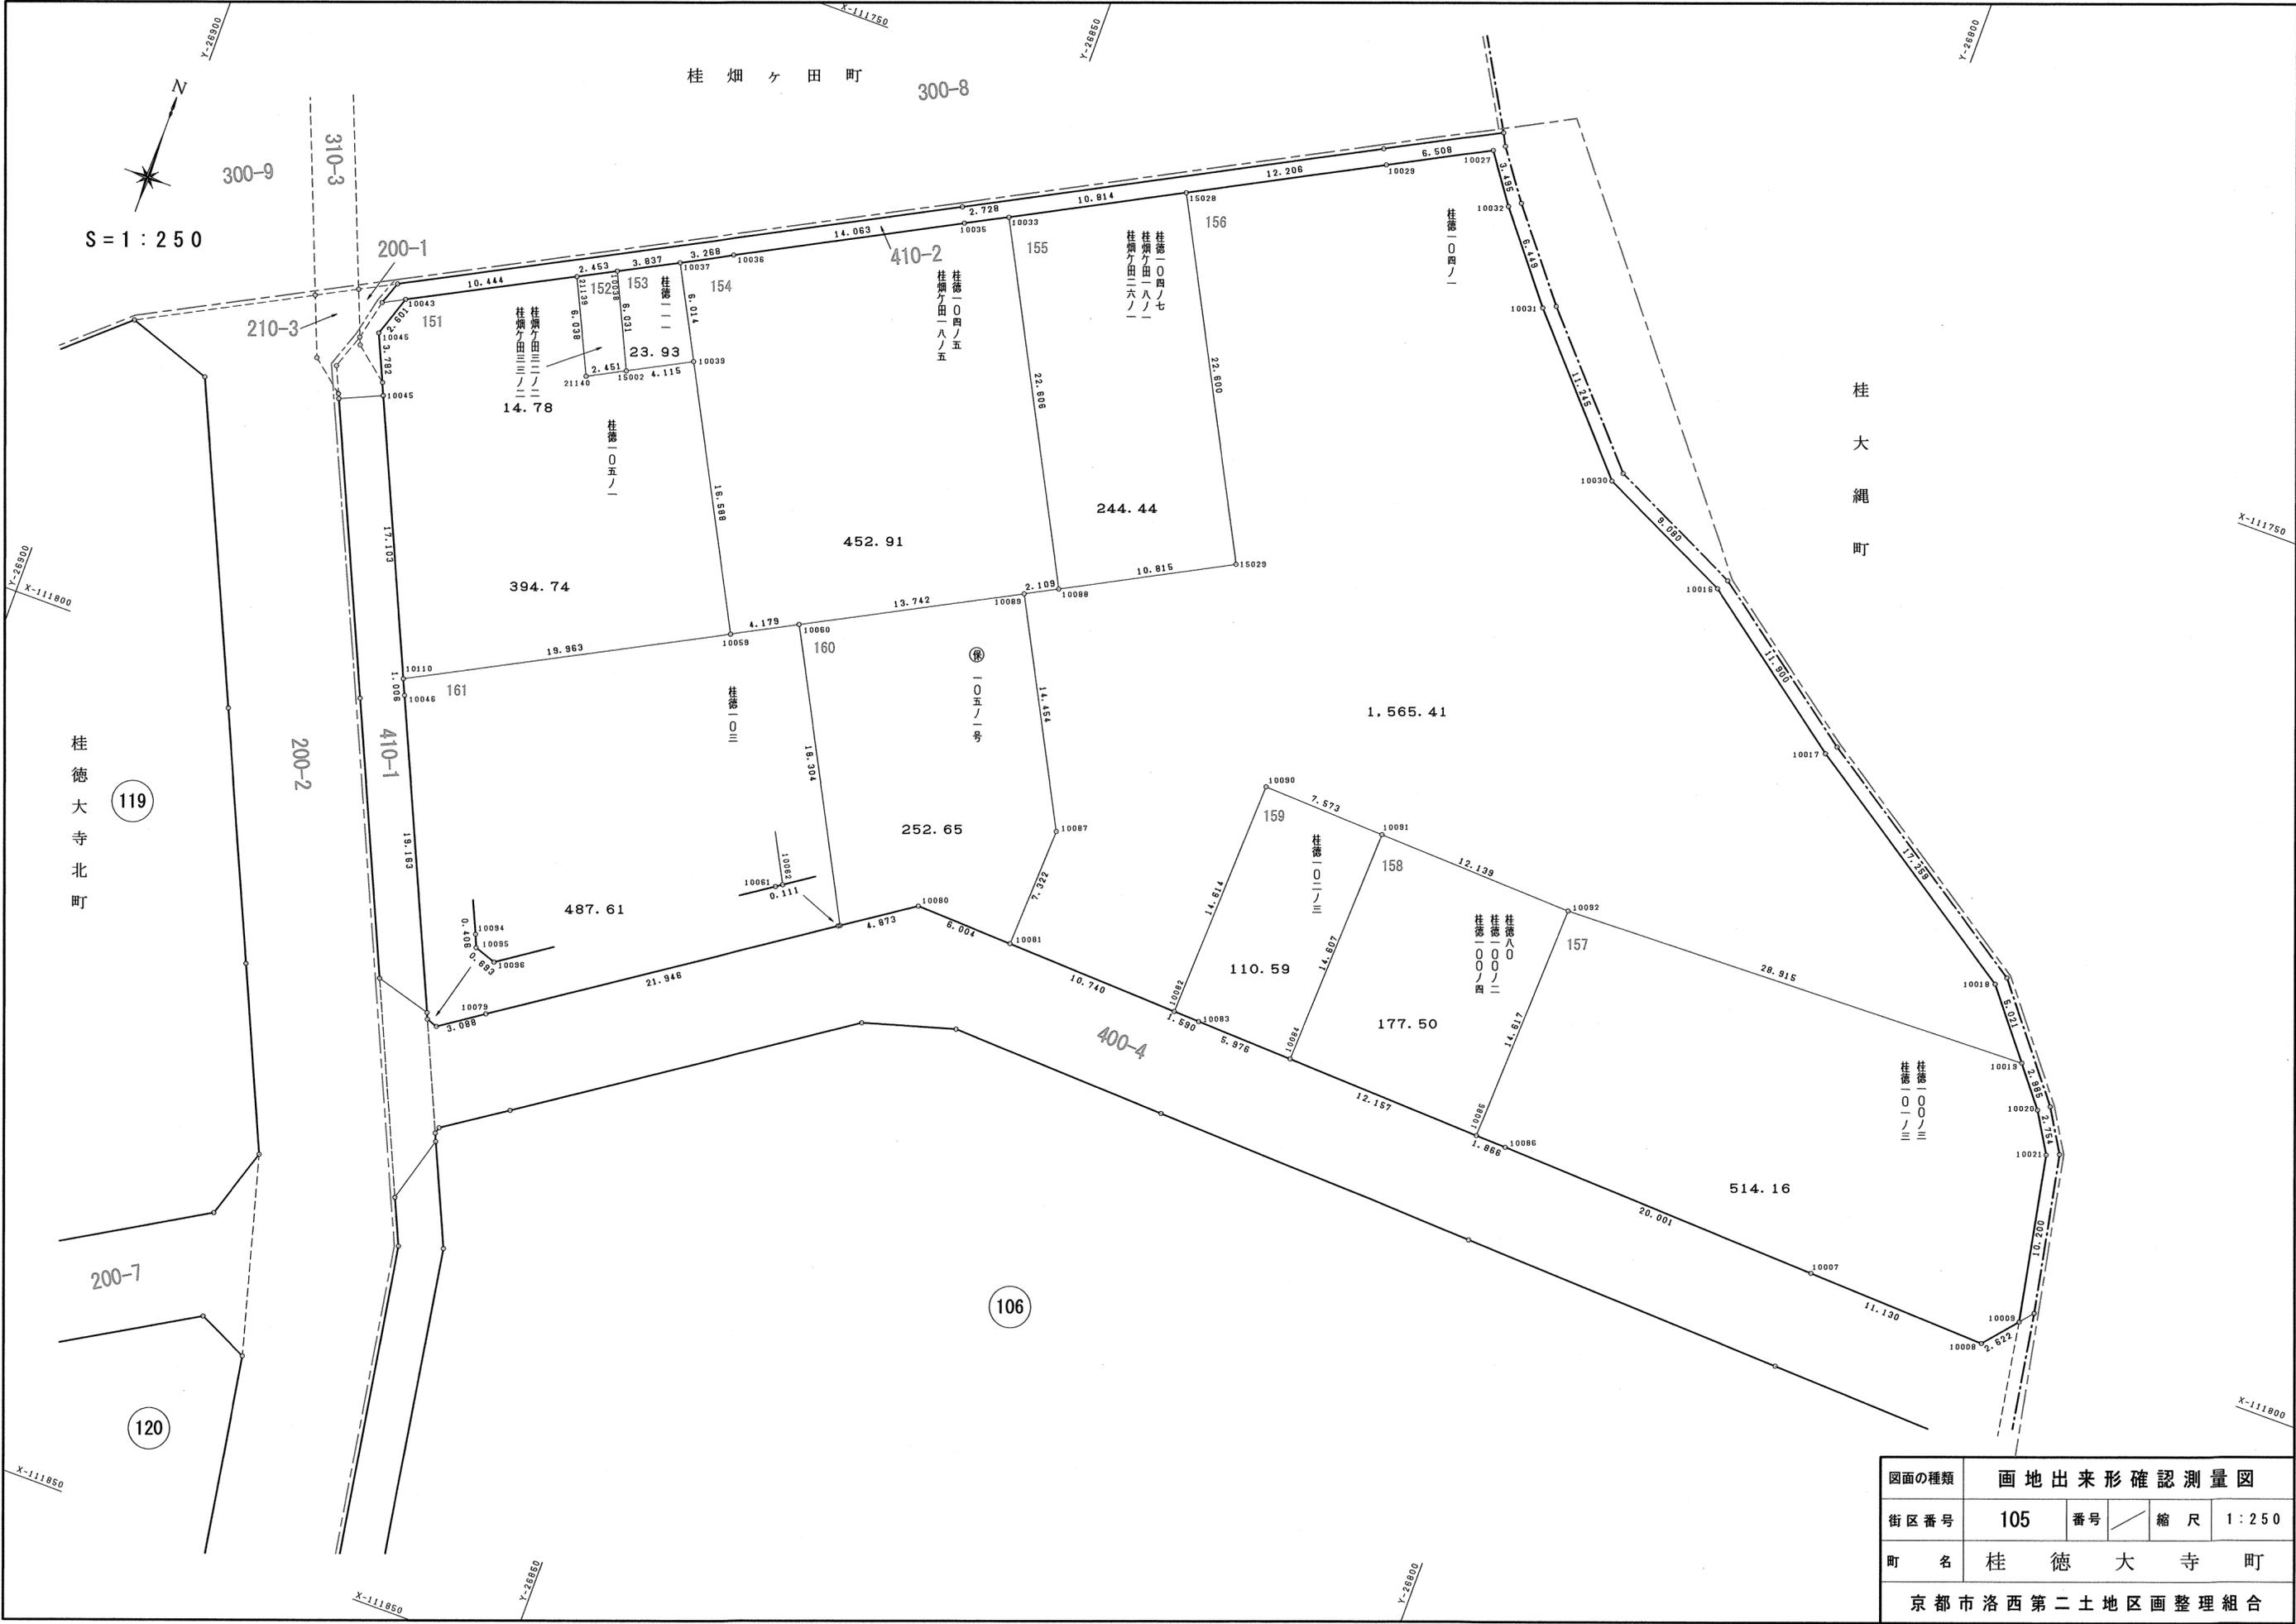

図面の種類	画地出来形確認測量図			
街区番号	105	番号	縮尺	1 : 250
町名	桂 徳 大 寺 町			
京都市洛西第二土地区画整理組合				

151

地番 桂徳一〇五ノ一			
NO	X	Y	辺長
10043	-111775.360	-26883.897	
10045	-111777.820	-26884.742	2.601
21194	-111781.266	-26883.183	3.782
10110	-111796.872	-26876.185	17.103
10059	-111787.555	-26858.530	19.963
10039	-111772.885	-26866.273	16.588
15002	-111774.811	-26869.910	4.115
21140	-111775.958	-26872.076	2.451
21139	-111770.498	-26874.654	6.038
10043	-111775.360	-26883.897	10.444
面積	394.7471975		
地積	394.74 m ²		

152

地番 桂畑ヶ田三二ノ二、桂畑ヶ田三三ノ二			
NO	X	Y	辺長
10038	-111769.356	-26872.483	
21139	-111770.498	-26874.654	2.453
21140	-111775.958	-26872.076	6.038
15002	-111774.811	-26869.910	2.451
10038	-111769.356	-26872.483	6.031
面積	14.7822485		
地積	14.78 m ²		

153

地番 桂徳一一一			
NO	X	Y	辺長
10038	-111769.356	-26872.483	
15002	-111774.811	-26869.910	6.031
10039	-111772.885	-26866.273	4.115
10037	-111767.570	-26869.087	6.014
10038	-111769.356	-26872.483	3.837
面積	23.9354885		
地積	23.93 m ²		

154

地番 桂徳一〇四ノ五、桂畑ヶ田一八ノ五			
NO	X	Y	辺長
10037	-111767.570	-26869.087	
10039	-111772.885	-26866.273	6.014
10059	-111787.555	-26858.530	16.588
10060	-111785.597	-26854.838	4.179
10089	-111779.187	-26842.683	13.742
10088	-111778.200	-26840.819	2.109
10033	-111758.198	-26851.352	22.606
10035	-111759.473	-26853.764	2.728
10036	-111766.049	-26866.195	14.063
10037	-111767.570	-26869.087	3.268
面積	452.9153230		
地積	452.91 m ²		

155

地番 桂徳一〇四ノ七 桂畑ヶ田一八ノ一、桂畑ヶ田二六ノ一			
NO	X	Y	辺長
10033	-111758.198	-26851.352	
10088	-111778.200	-26840.819	22.606
15029	-111773.141	-26831.260	10.815
15028	-111753.145	-26841.791	22.600
10033	-111758.198	-26851.352	10.814
面積	244.4402320		
地積	244.44 m ²		

156

地番 桂徳一〇四ノ一			
NO	X	Y	辺長
15028	-111753.145	-26841.791	
15029	-111773.141	-26831.260	22.600
10088	-111778.200	-26840.819	10.815
10089	-111779.187	-26842.683	2.109
10087	-111791.971	-26835.939	14.454
10081	-111799.287	-26836.242	7.322
10082	-111799.704	-26825.510	10.740
10090	-111785.101	-26824.952	14.614
10091	-111785.395	-26817.385	7.573
10092	-111785.842	-26805.254	12.139
10019	-111785.020	-26776.351	28.915
10018	-111781.105	-26779.495	5.021
10017	-111771.595	-26793.897	17.259
10016	-111764.511	-26803.459	11.900
10030	-111760.628	-26811.667	9.080
10031	-111752.265	-26819.185	11.245
10032	-111747.246	-26823.235	6.449
10027	-111744.391	-26825.251	3.495
10029	-111747.441	-26831.000	6.508
15028	-111753.145	-26841.791	12.206
面積	1565.4153150		
地積	1565.41 m ²		

157

地番 桂徳一〇〇ノ三、桂徳一〇一ノ三			
NO	X	Y	辺長
10085	-111800.449	-26805.801	
10086	-111800.519	-26803.936	1.866
10007	-111801.291	-26783.950	20.001
10008	-111801.723	-26772.828	11.130
10009	-111799.721	-26771.135	2.622
10021	-111789.703	-26773.055	10.200
10020	-111787.347	-26774.482	2.754
10019	-111785.020	-26776.351	2.985
10092	-111785.842	-26805.254	28.915
10085	-111800.449	-26805.801	14.617
面積	514.1612320		
地積	514.16 m ²		

158

地番 桂徳八〇、桂徳一〇〇ノ二 桂徳一〇〇ノ四			
NO	X	Y	辺長
10084	-111799.991	-26817.949	
10085	-111800.449	-26805.801	12.157
10092	-111785.842	-26805.254	14.617
10091	-111785.395	-26817.385	12.139
10084	-111799.991	-26817.949	14.607
面積	177.5062730		
地積	177.50 m ²		

159

地番 桂徳一〇二ノ三			
NO	X	Y	辺長
10082	-111799.704	-26825.510	
10083	-111799.766	-26823.921	1.590
10084	-111799.991	-26817.949	5.976
10091	-111785.395	-26817.385	14.607
10090	-111785.101	-26824.952	7.573
10082	-111799.704	-26825.510	14.614
面積	110.5999580		
地積	110.59 m ²		

160

地番 保一〇五ノ一			
NO	X	Y	辺長
10060	-111785.597	-26854.838	
10062	-111801.778	-26846.282	18.304
10080	-111799.054	-26842.241	4.873
10081	-111799.287	-26836.242	6.004
10087	-111791.971	-26835.939	7.322
10089	-111779.187	-26842.683	14.454
10060	-111785.597	-26854.838	13.742
面積	252.6511865		
地積	252.65 m ²		

161

地番 桂徳一〇三			
NO	X	Y	辺長
10094	-111815.271	-26867.922	
10095	-111815.646	-26867.766	0.406
10096	-111815.868	-26867.109	0.693
10079	-111814.130	-26864.556	3.088
10061	-111801.840	-26846.374	21.946
10062	-111801.778	-26846.282	0.111
10060	-111785.597	-26854.838	18.304
10059	-111787.555	-26858.530	4.179
10110	-111796.872	-26876.185	19.963
10046	-111797.790	-26875.773	1.006
10094	-111815.271	-26867.922	19.163
面積	487.6191630		
地積	487.61 m ²		

図面の種類	画地面積求積表		
街区番号	105	番号	縮尺
町名	桂徳大寺町		
京都市洛西第二土地区画整理組合			